

SR 109

O.D.O.T. DISTRICT 2 SURVEY OFFICE (USE ONLY)

PERSONNEL

REFERENCE NO. 30-A

SHEET 16 OF 35

NOTES CANTEBURY

DATE 06-15-12

ROUTE SR 109

H.C. ROUSOS

WEATHER FAIR

COUNTY FULTON

R.C. CANTERBURY

TEMP. 75°

TOWNSHIP PIKE

HARBAUGH

SECTION 10

COUTCHER

T 10 S R 3 E

TYPE MONUMENT PK NAIL


ON SURFACE - BELOW ON

LEFT - Q PAV'T - RIGHT 1.3'


9.6' TO LT EDGE PAVEMENT

S.L.M. 597+96

Grid: Northing: 715362.610 Easting: 1548148.192

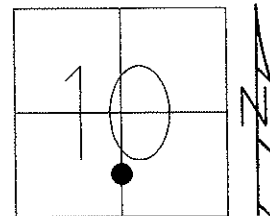

RECORD:
POSSIBLE P.C. TO CURVE
FD 0.5" I. PIPE 1.5" DOWN
IN APRIL OF 1984

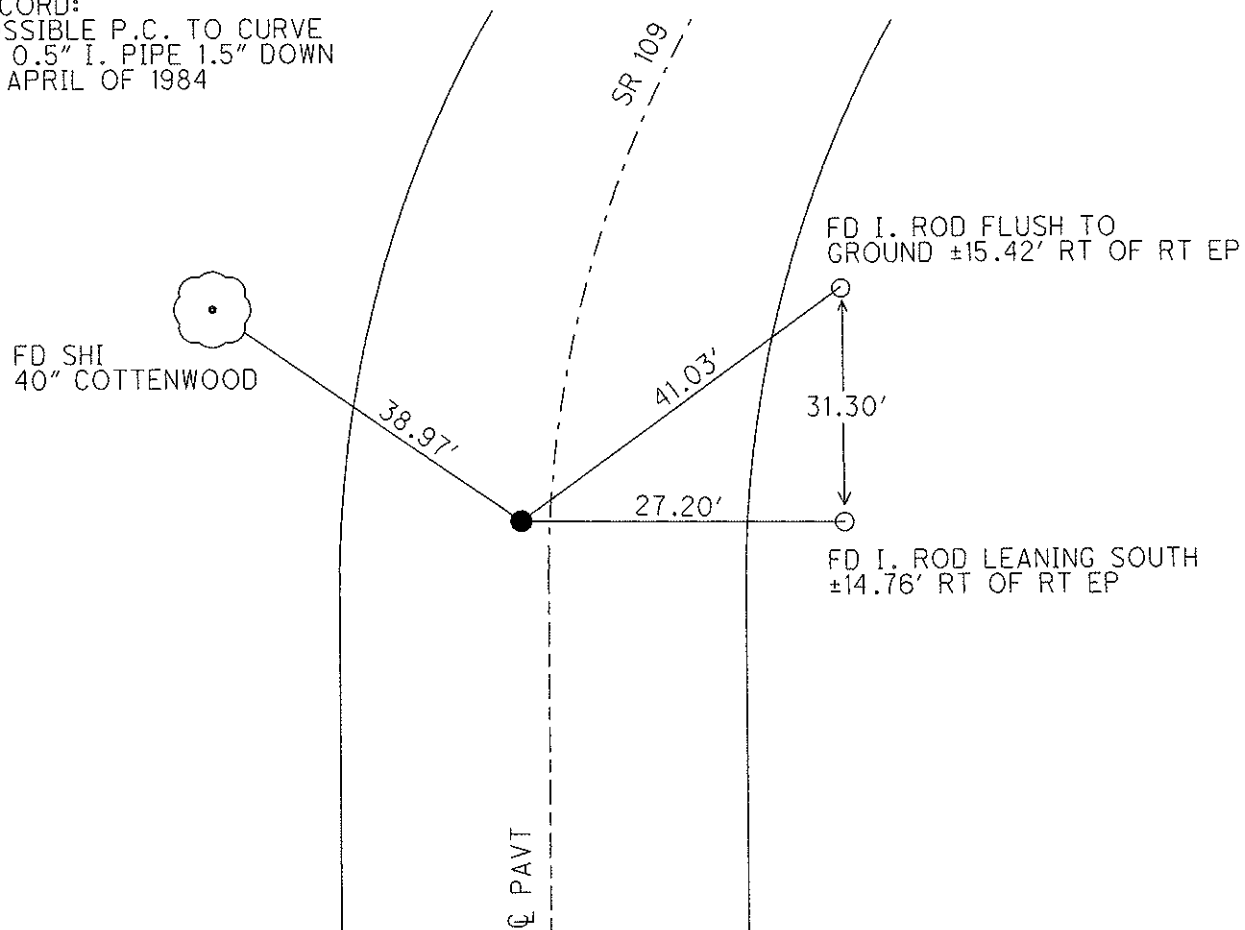

10-01-90 SET PK/WASHER, MB
03-05-13 RESET MAG/WASHER, MC

06-14-12 GPS REF A30
03-05-13 GPS FIN A30

O.D.O.T. DISTRICT 2 SURVEY OFFICE

PERSONNEL

REFERENCE NO. 30-A

SHEET 13 OF 28

NOTES CANTERBURY

H.C. _____

R.C. LOEHRKE

DATE 8/26/96

WEATHER FAIR

TEMP. +80°

Set P.K./WASHER
10-2-97

C.L.

ROUTE 109

COUNTY FULTON

TOWNSHIP PIKE

SECTION 10

T 10 S R 3 E


TYPE MONUMENT P.K. NAIL

ON SURFACE - BELOW YES

LEFT- & PAV'T. - RIGHT 0.40 LT &

2.66 TO LT EDGE PAVEMENT

S.L.M. 18+217 (597+90)

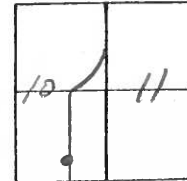

RECORD

Possible P.C. to CURVE
Fd. 1/2" I-Pipe 1 1/2" down
IN APRIL OF 1984

(SET: PK & WASHER)

10-1-90
MB

SET P.K./WASHER IN LEVELING
COURSE 11/20/96. MRC.

Fd. SHI.
80 CM COTTER WASHER



11.954 m

SR 109

12.527 m

8.318 m

9.54 m

Set I-Rod Flush to
Ground, ± 4.7 R to F R to EOP

Set I-Rod Flush to
Ground ± 4.5 m R to F
R to EOP

± P.V.M.T.

O.D.O.T. DISTRICT 2 SURVEY OFFICE

PERSONNEL

REFERENCE NO. 30-A

SHEET OF

NOTES BARNHISEL

H.C. " "

R.C. HOFFMAN

DATE 9-5-90

WEATHER clear

TEMP. +80°

ROUTE 109

COUNTY Fulton

TOWNSHIP PIKE

SECTION 10

T 10 S R 3 E


TYPE MONUMENT P.K. NAIL

ON SURFACE - BELOW yes

LEFT-℄ PAV'T. - RIGHT 1.2

9.5 TO LT EDGE PAVEMENT

S.L.M. 597+96

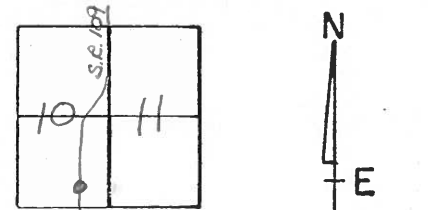

RECORD:

Possible P.C. to curve,
Fd 1/2" I. Pipe 1 1/2" down
IN APRIL OF 1984

Set P.K. & Washer
10-1-90
MB



Set 8' 1/2" SEIS
30" COTTONWOOD



39.35

S.R. 109

E Pav't

Q.D.O.T. DISTRICT 2 SURVEY OFFICE

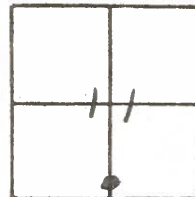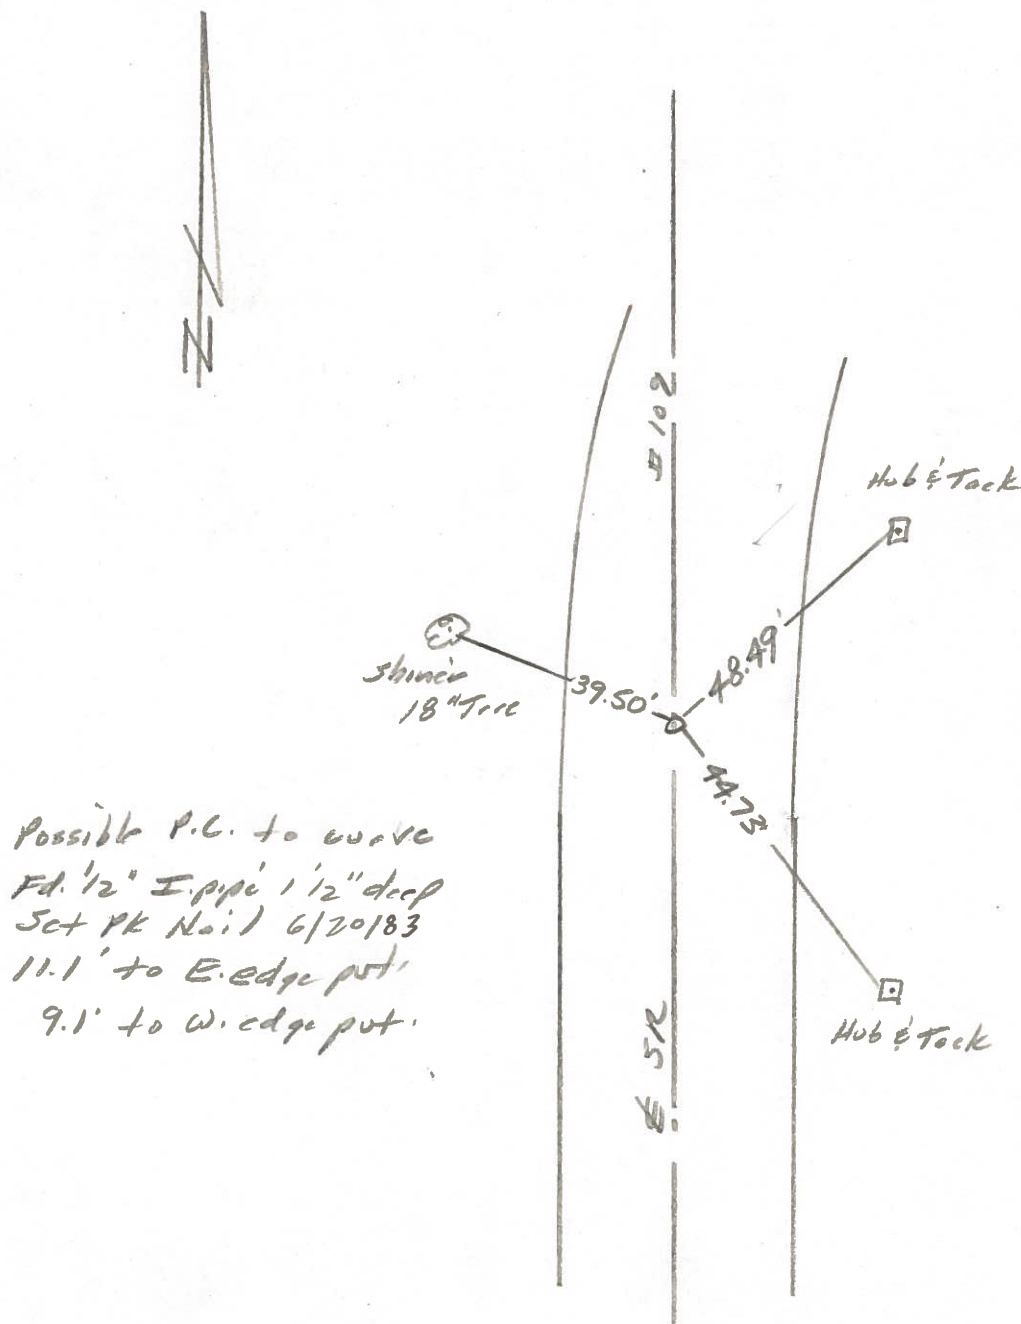
SHEET 10 OF County Fulton S.R. 109Township PIKESection 11T N, R EPersonnel I. StoneP. NusscoR. MichalakD. CurtisDate 11 April 84Weather FairTemp. 50°REF. NO. 30-A

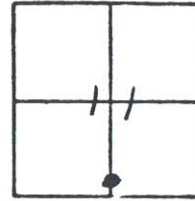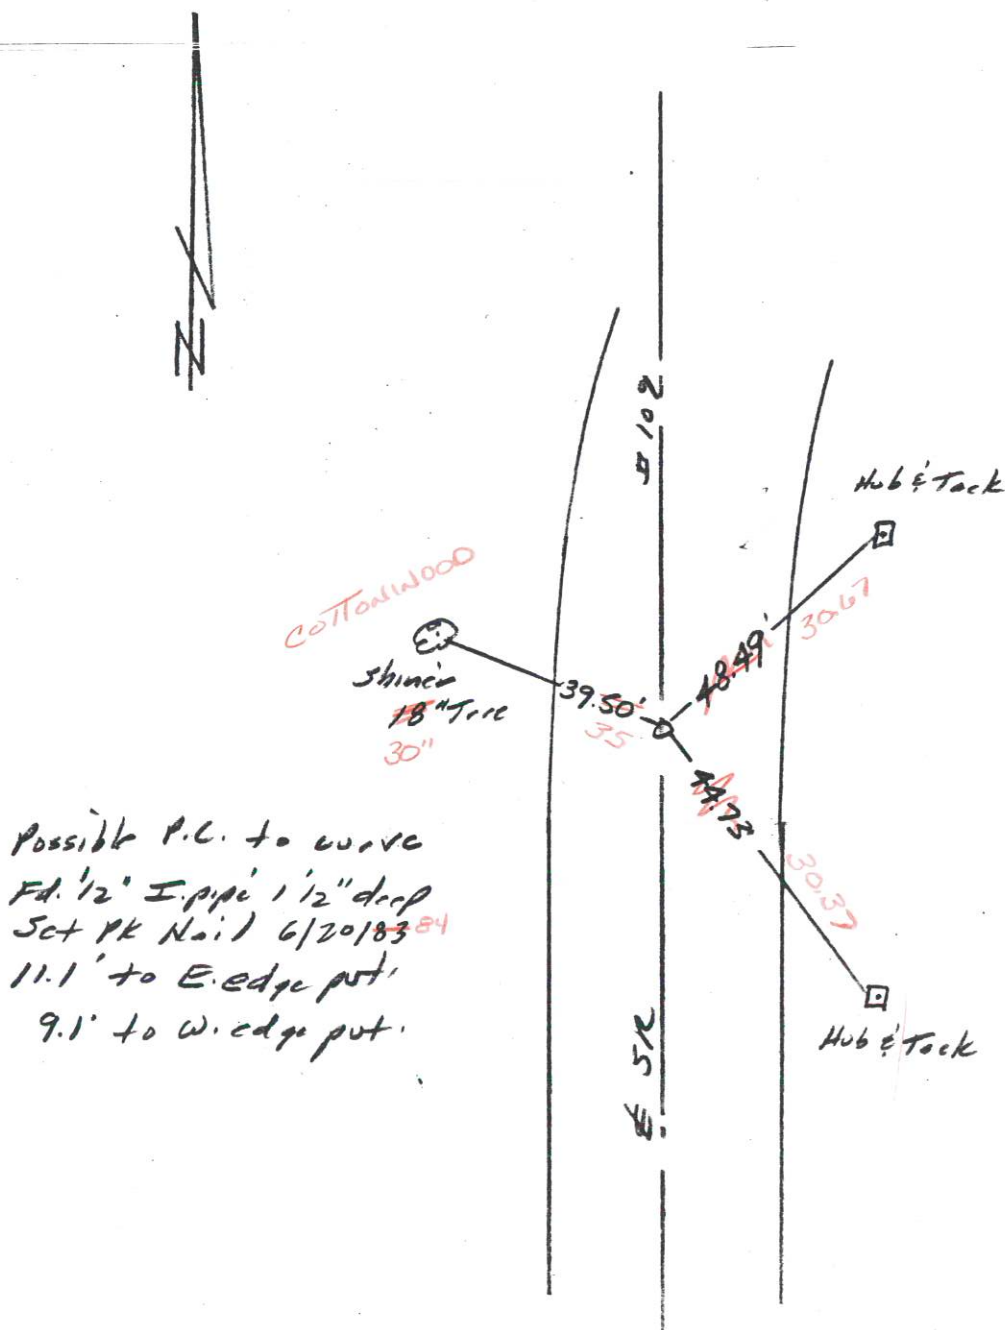County Fulton S.R. 109Township PIKESection 11T N, R EPersonnel L. StoneP. NeuseR. MichalakD. CurtisDate 11 April 84Weather FairTemp. 50°REF. NO. 30-A

PK. NAIL
 597 + 96
 1.2 LT &
 9.5 TO LT ED.

PERSONNEL	TITLE	PERSONNEL	TITLE	COUNTY	DATE	WEATHER	TEMP.	JOB NO.
Tomsic					July-19-73	clear	82°	024610
Neuser				S. R. 109				
Vanyo				SEC.				
Granata		Boyle						

DESCRIPTION MON. LEFT CENTER LINE RIGHT

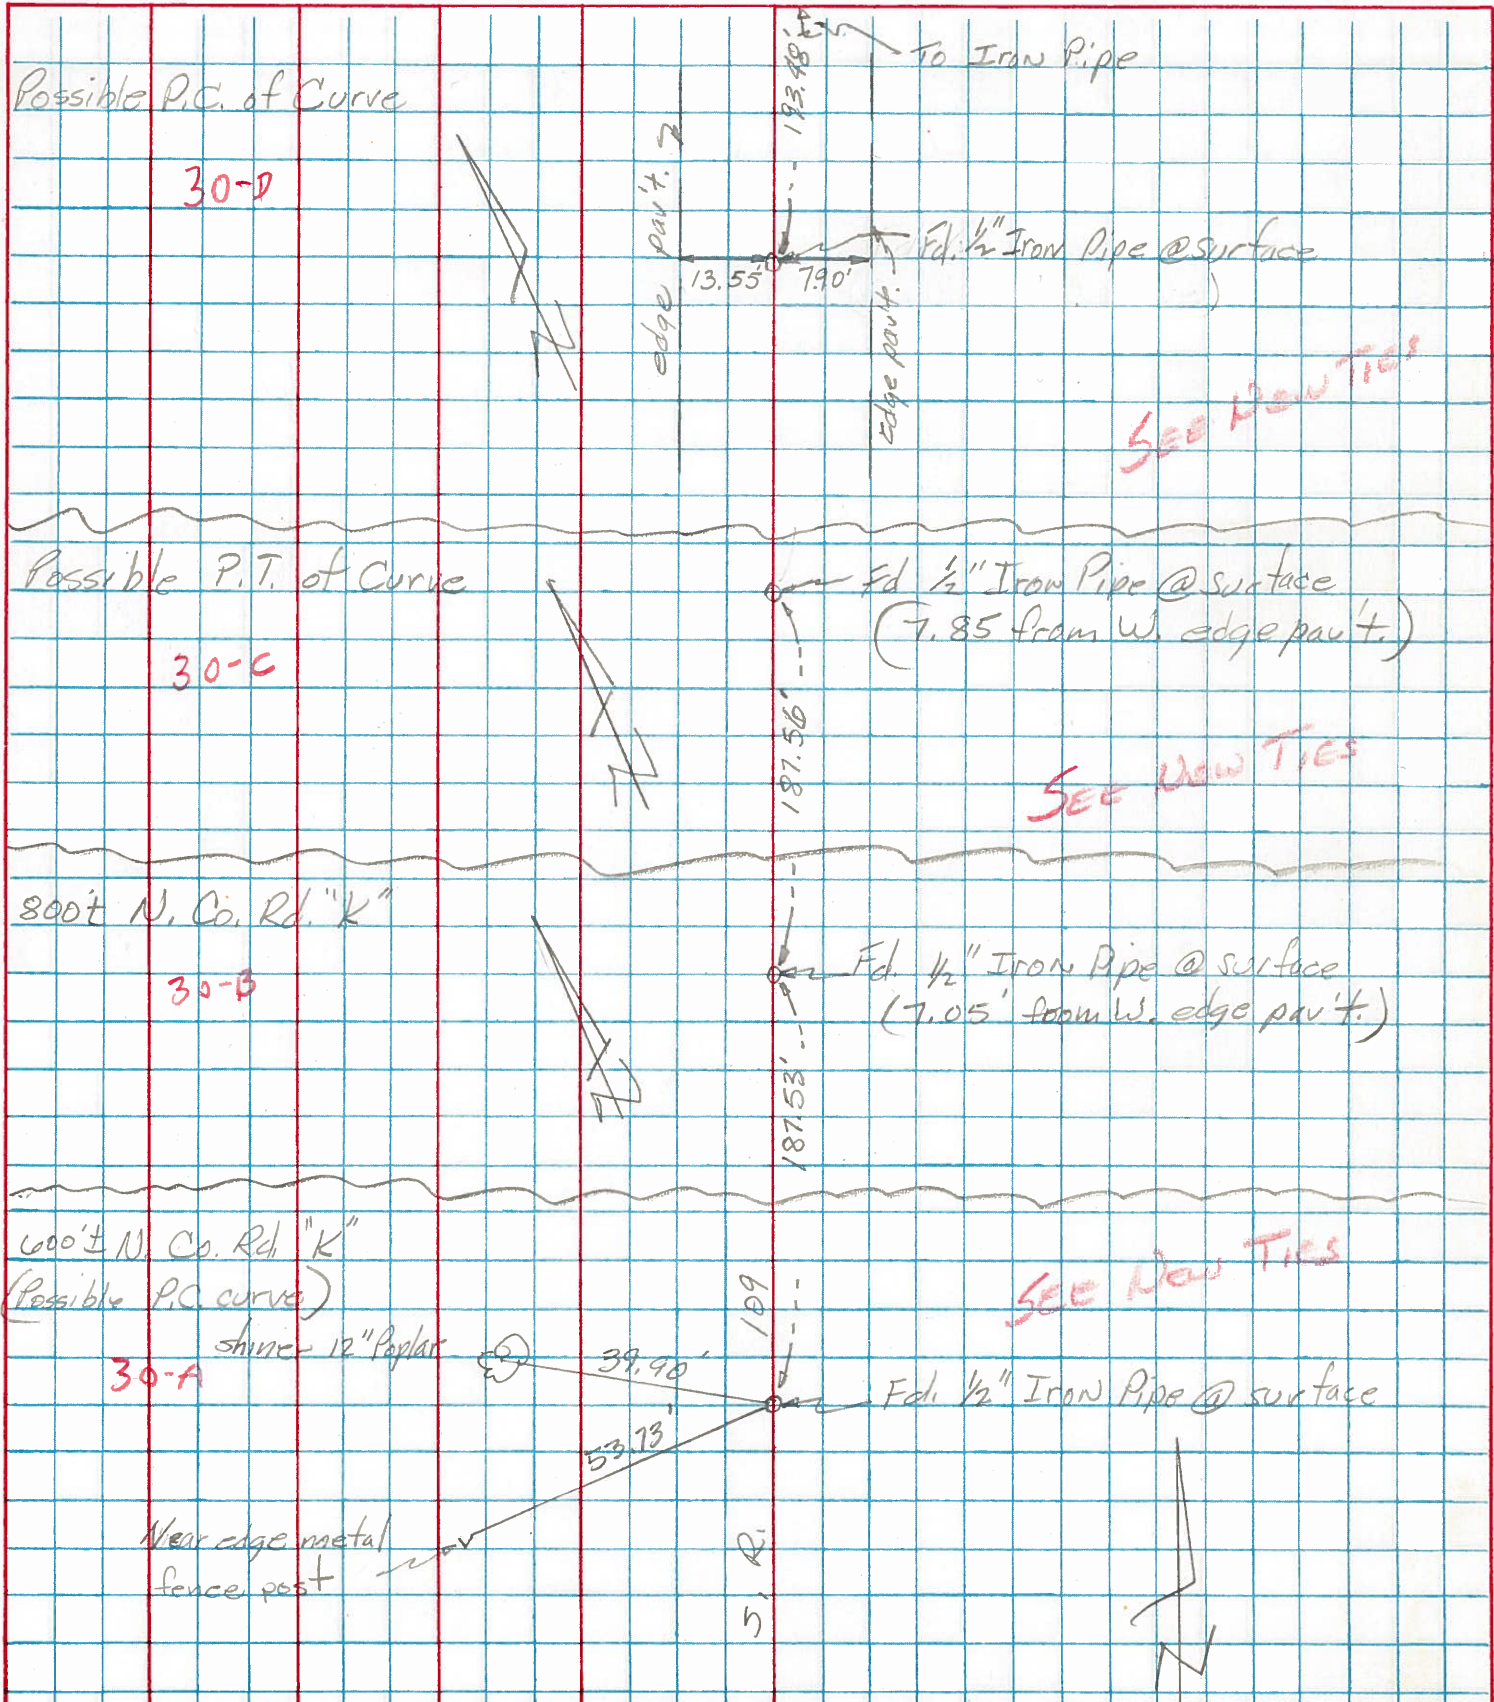

PERSONNEL	TITLE	PERSONNEL	TITLE
Red Beach			
Newcomb			
Knappe			
Wise			

COUNTY FULTON DATE Nov. 1970
S. R. 109 WEATHER _____
SEC. PIKE TWP. TEMP. _____

DESCRIPTION

CONTROL POINTS

JOB NO

