

O.D.O.T. DISTRICT 2 SURVEY OFFICE (USE ONLY)

PERSONNEL

REFERENCE NO. 30 C

SHEET 16 OF 35

NOTES RHOADES

DATE 4/26/21

ROUTE SR 109

H.C. O'DONNELL

WEATHER CLOUDY

COUNTY FULTON

R.C. NIESE

TEMP. 45°

TOWNSHIP PIKE

SECTION 10

DWG BY NIESE PID PAVE TRAIN

T 10 S R 3 E

TYPE MONUMENT MAG SHANK

ON SURFACE - ~~BELOW~~ ON

OFFSET CL PAVEMENT 2.3' LT : ~~RT~~

8.3' TO LT EDGE PAVEMENT


STATION: 601+62.09

HORZ.DATUM: NAD83(2011)


GEOID: 2018

GRID: NORTHING: 715704.571

EASTING: 1548285.984

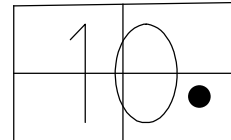

RECORD: P.T.
1/2" IPIPE
±6" DOWN
FD P.K./WASHER
6/15/12, MC
SET MAG/WASHER
3/7/13, MC
FD MAG SHANK
REFC30
4/26/21, JFO
8/26/21, JFO

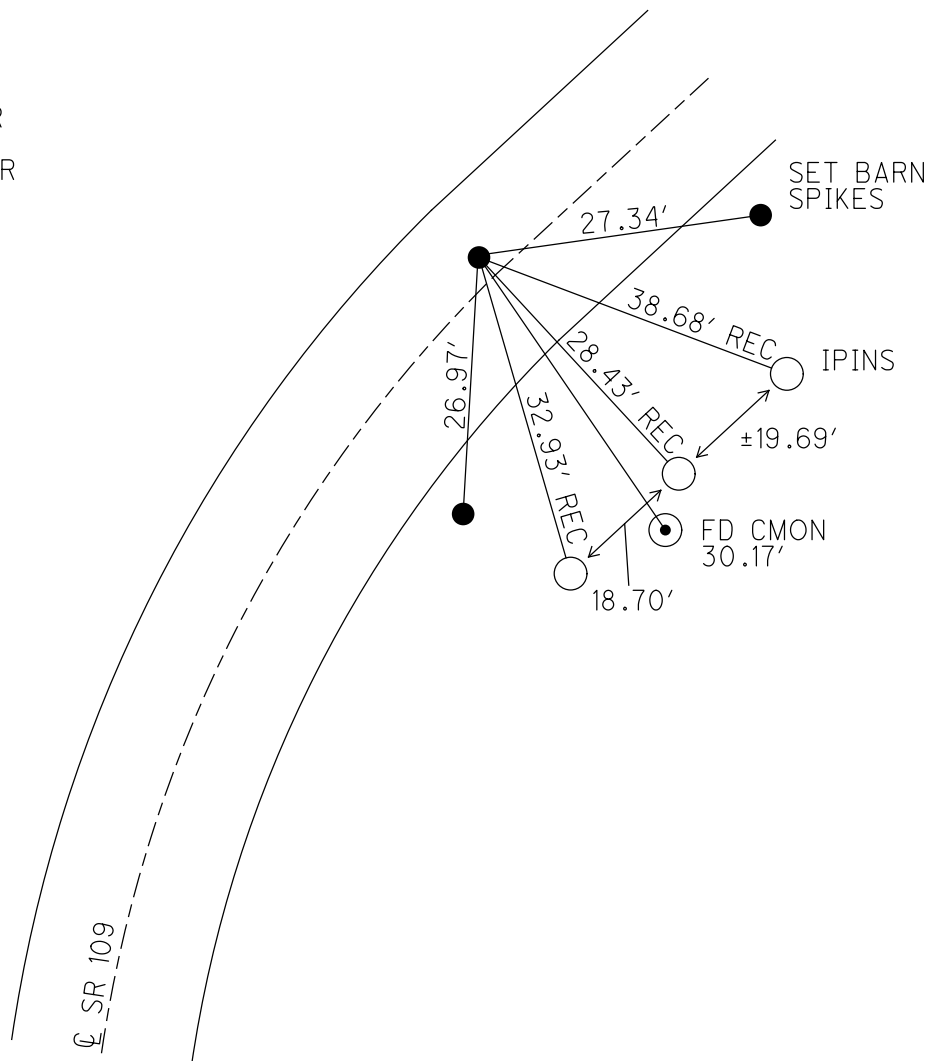

O.D.O.T. DISTRICT 2 SURVEY OFFICE (USE ONLY)

PERSONNEL

REFERENCE NO. 30-C

SHEET 17 OF 35

NOTES CANTERBURY

DATE 06-15-12

ROUTE SR 109

H.C. ROUSOS

WEATHER FAIR

COUNTY FULTON

R.C. LOEHRKE

TEMP. 75°

TOWNSHIP PIKE

HARBAUGH

SECTION 10

COUTCHER

T 10 S R 3 E

TYPE MONUMENT PK/WASHER


ON SURFACE - BELOW ON

LEFT - Q PAV'T - RIGHT 2.3'

8.3' TO LT. EDGE PAVEMENT

S.L.M. 601+64

Grid: Northing: 715704.579 Easting: 1548285.934

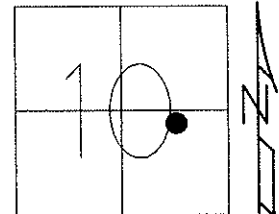

RECORD:


P.T. OF CURVE

0.5" IRON PIPE ±6" DOWN

03-07-13 RESET MAG/WASHER, MC

06-14-12 GPS REF C30

03-07-13 GPS FIN C30

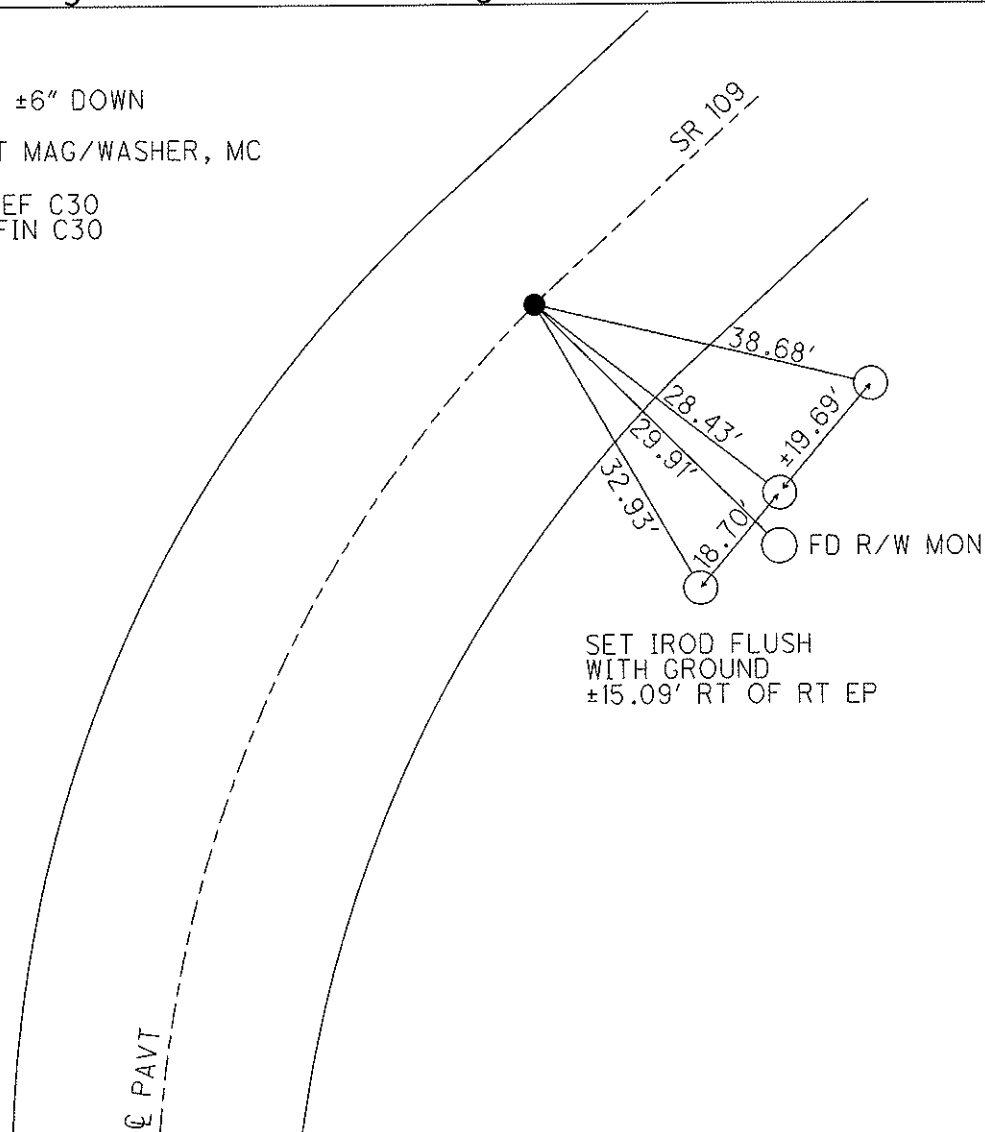

O.D.O.T. DISTRICT 2 SURVEY OFFICE

PERSONNEL

REFERENCE NO. 30-C

SHEET 14 OF 28

NOTES CANTERBURY

H.C. " "

R.C. LOEHRKE

DATE 8-26-96

WEATHER FAIR

TEMP. +80°

ROUTE S.R. 109

COUNTY FULTON

TOWNSHIP Pike

SECTION 10

T 10 S R 3 E

Reset
10-2-97
C.L.


TYPE MONUMENT P.K. WASHER

ON SURFACE - BELOW YES

LEFT-~~C~~ PAV'T. - RIGHT .90 LT 2


2.265 TO LT EDGE PAVEMENT

S.L.M. 18 + 330.75 (601+64)

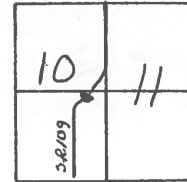

RECORD. P.T. of Curve
1/2" IRON PIPE ± 6" DOWN

SET P.K./WASHER IN LEVELING
COURSE 11/20/96 MRC

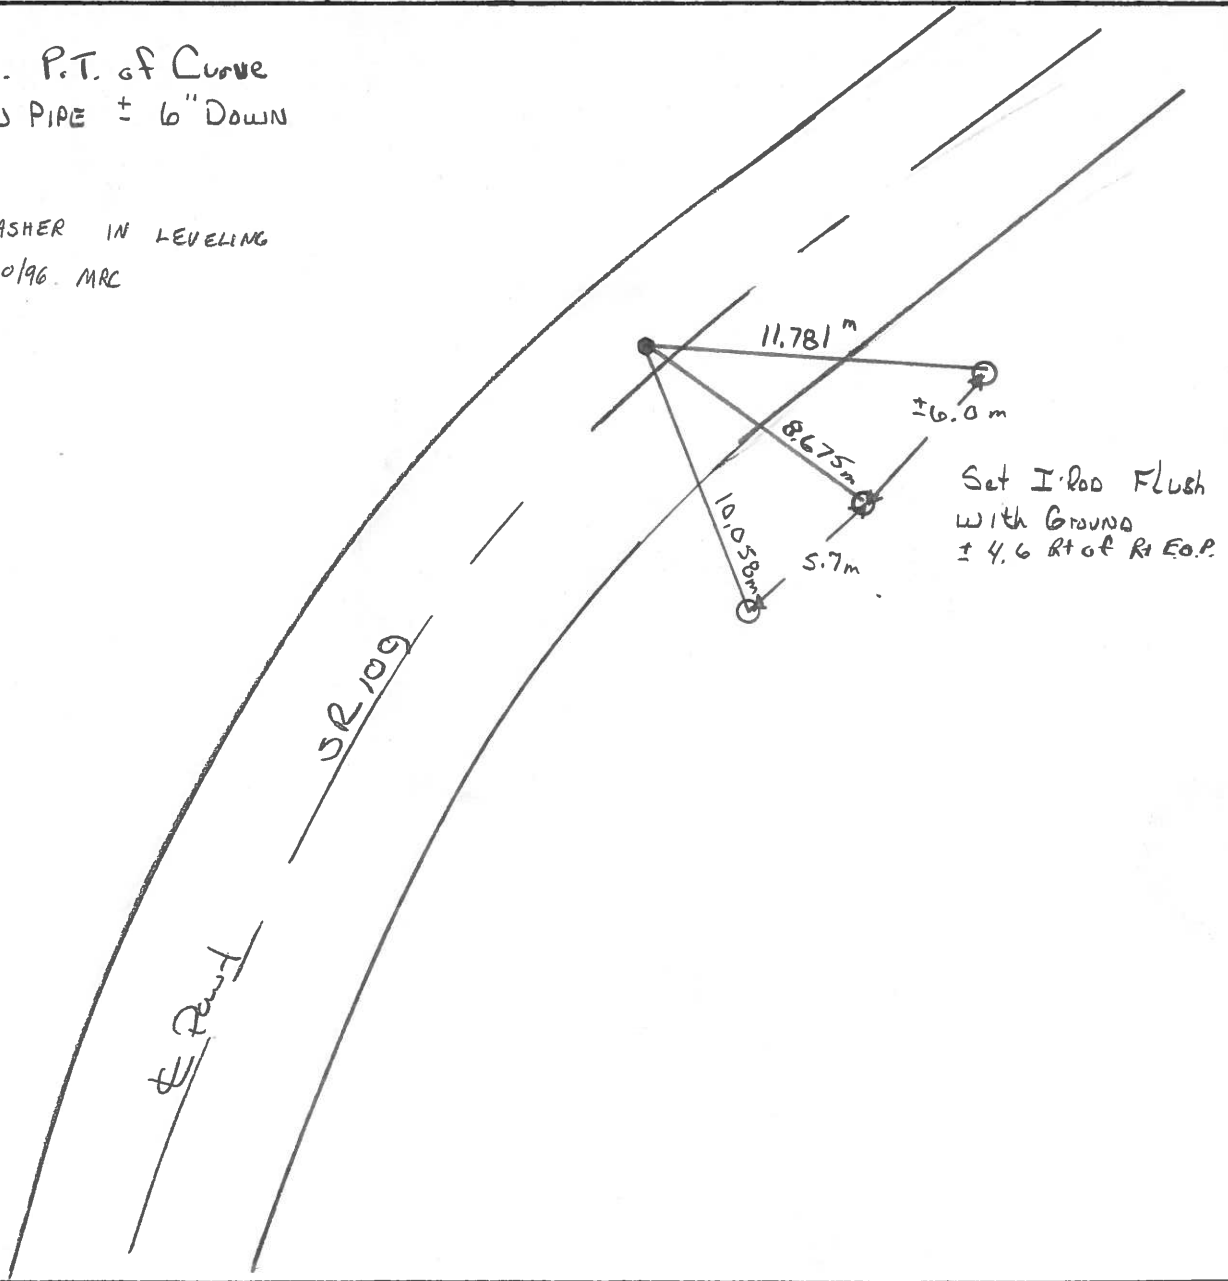

O.D.O.T. DISTRICT 2 SURVEY OFFICE

PERSONNEL

REFERENCE NO. 30-C

SHEET OF

NOTES BARNHISEL

H.C.

R.C. HOFFMAN

DATE 9-5-90

WEATHER clear

TEMP. +80°

ROUTE 109

COUNTY Fulton

TOWNSHIP PIKE

SECTION 10

T 10 S 3 R 3 E


TYPE MONUMENT P.K. NAIL

ON SURFACE - BELOW yes

LEFT - LT PAV'T. - RIGHT 2.5

8.7 TO LT EDGE PAVEMENT


S.L.M. 601 + 64

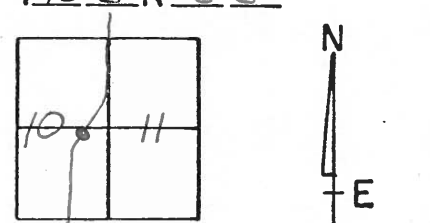

NOTE: Used tacked hubs to reset control, then removed all hubs.

Set P.K. & Washer
10-1-90
MB

Record:
P.T. OF CURVE,
Fd 1/2" I. Pipe 2" down
IN APRIL OF 1984

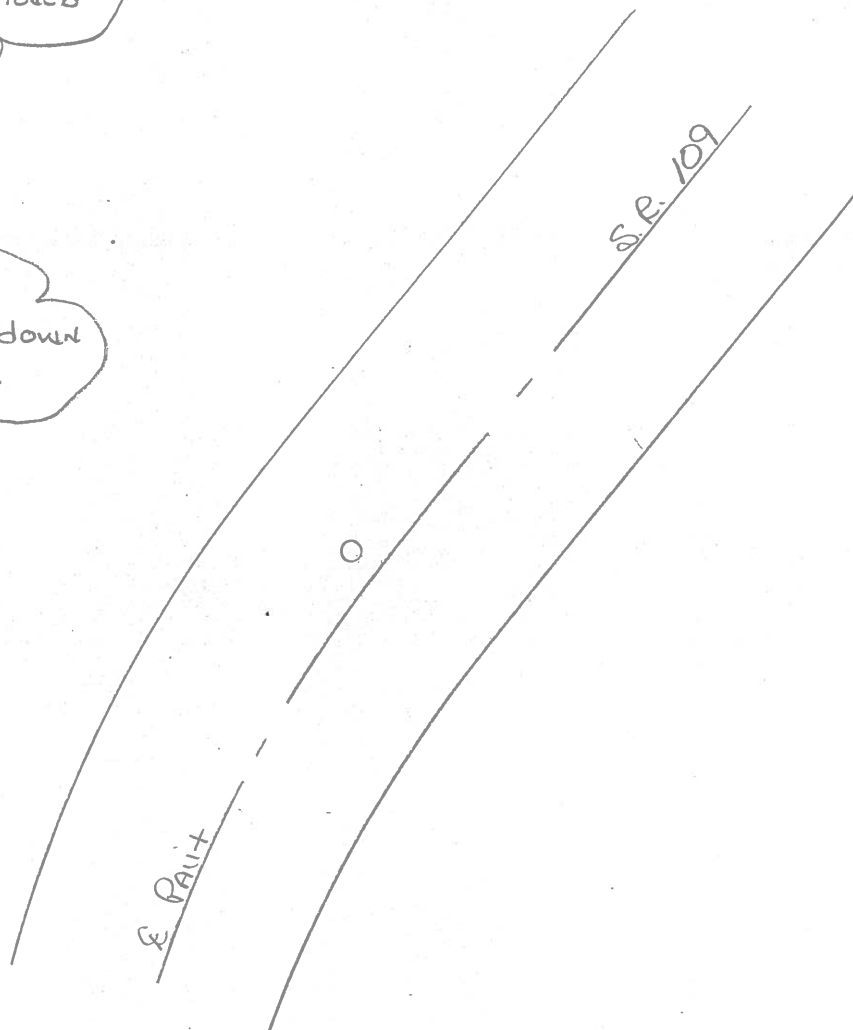

Q.D.O.T. DISTRICT 2 SURVEY OFFICE

SHEET 11 OF

County Fulton S.R. 109

Township PIKE

Section 11

T N, R E

Personnel 1. Stone

P. Neuse


R. Michaelale

D. Curtis

Date 11 April 84


Weather Fair

Temp. 50°

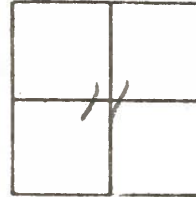

REF. NO. 30-C

601+80

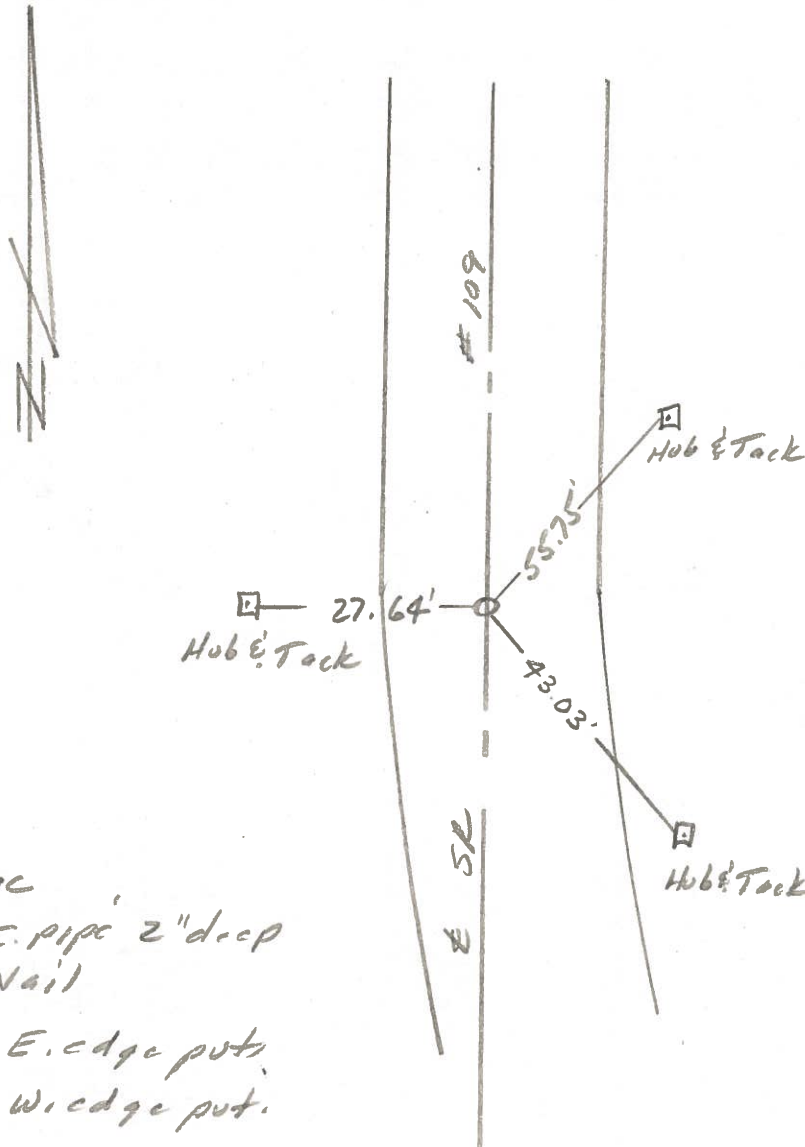

P.T. CURVE
 Fd 1/2" I. pipe 2" deep
 Set PK Nail
 11.9' to E. edge put.
 8.2' to W. edge put.

Q.D.O.T. DISTRICT 2 SURVEY OFFICE

SHEET 11 OF

County Fulton S.R. 109

Township PIKE

Section 11

T N, R E

Personnel I. Stone

P. Neuse


R. Michalake

D. Curtis

Date 11 April 84


Weather Fair

Temp. 50°

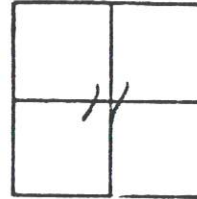

REF. NO. 30-C

601+80

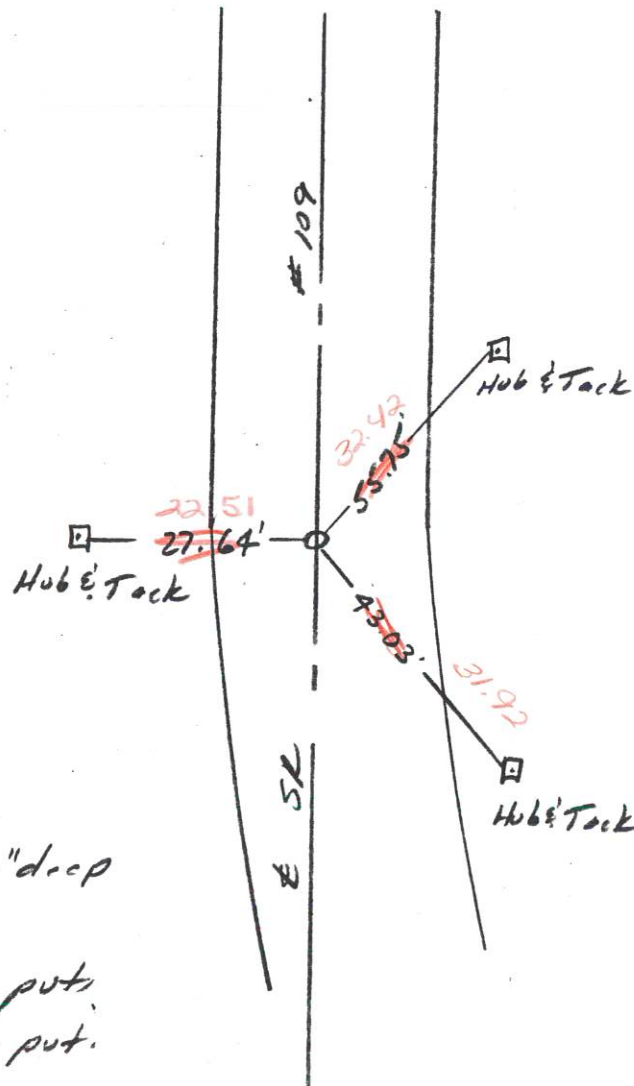


601+64
2.5 LT E
8.7 TO LT ED.
P.K. NAIL

P.T. CURVE
Fd 1/2" I. pipe 2" deep
Set PK Nail
11.9' to E. edge put.
8.2' to W. edge put.

PERSONNEL	TITLE	PERSONNEL	TITLE	COUNTY	DATE
Tomsic					July-19-73
Neuser				S. R. 109	WEATHER clear
Vanyo				SEC.	TEMP. 82°
Granata		Boyle			

DESCRIPTION	MON- LEFT	CENTER LINE	RIGHT	JOB NO.
				024610

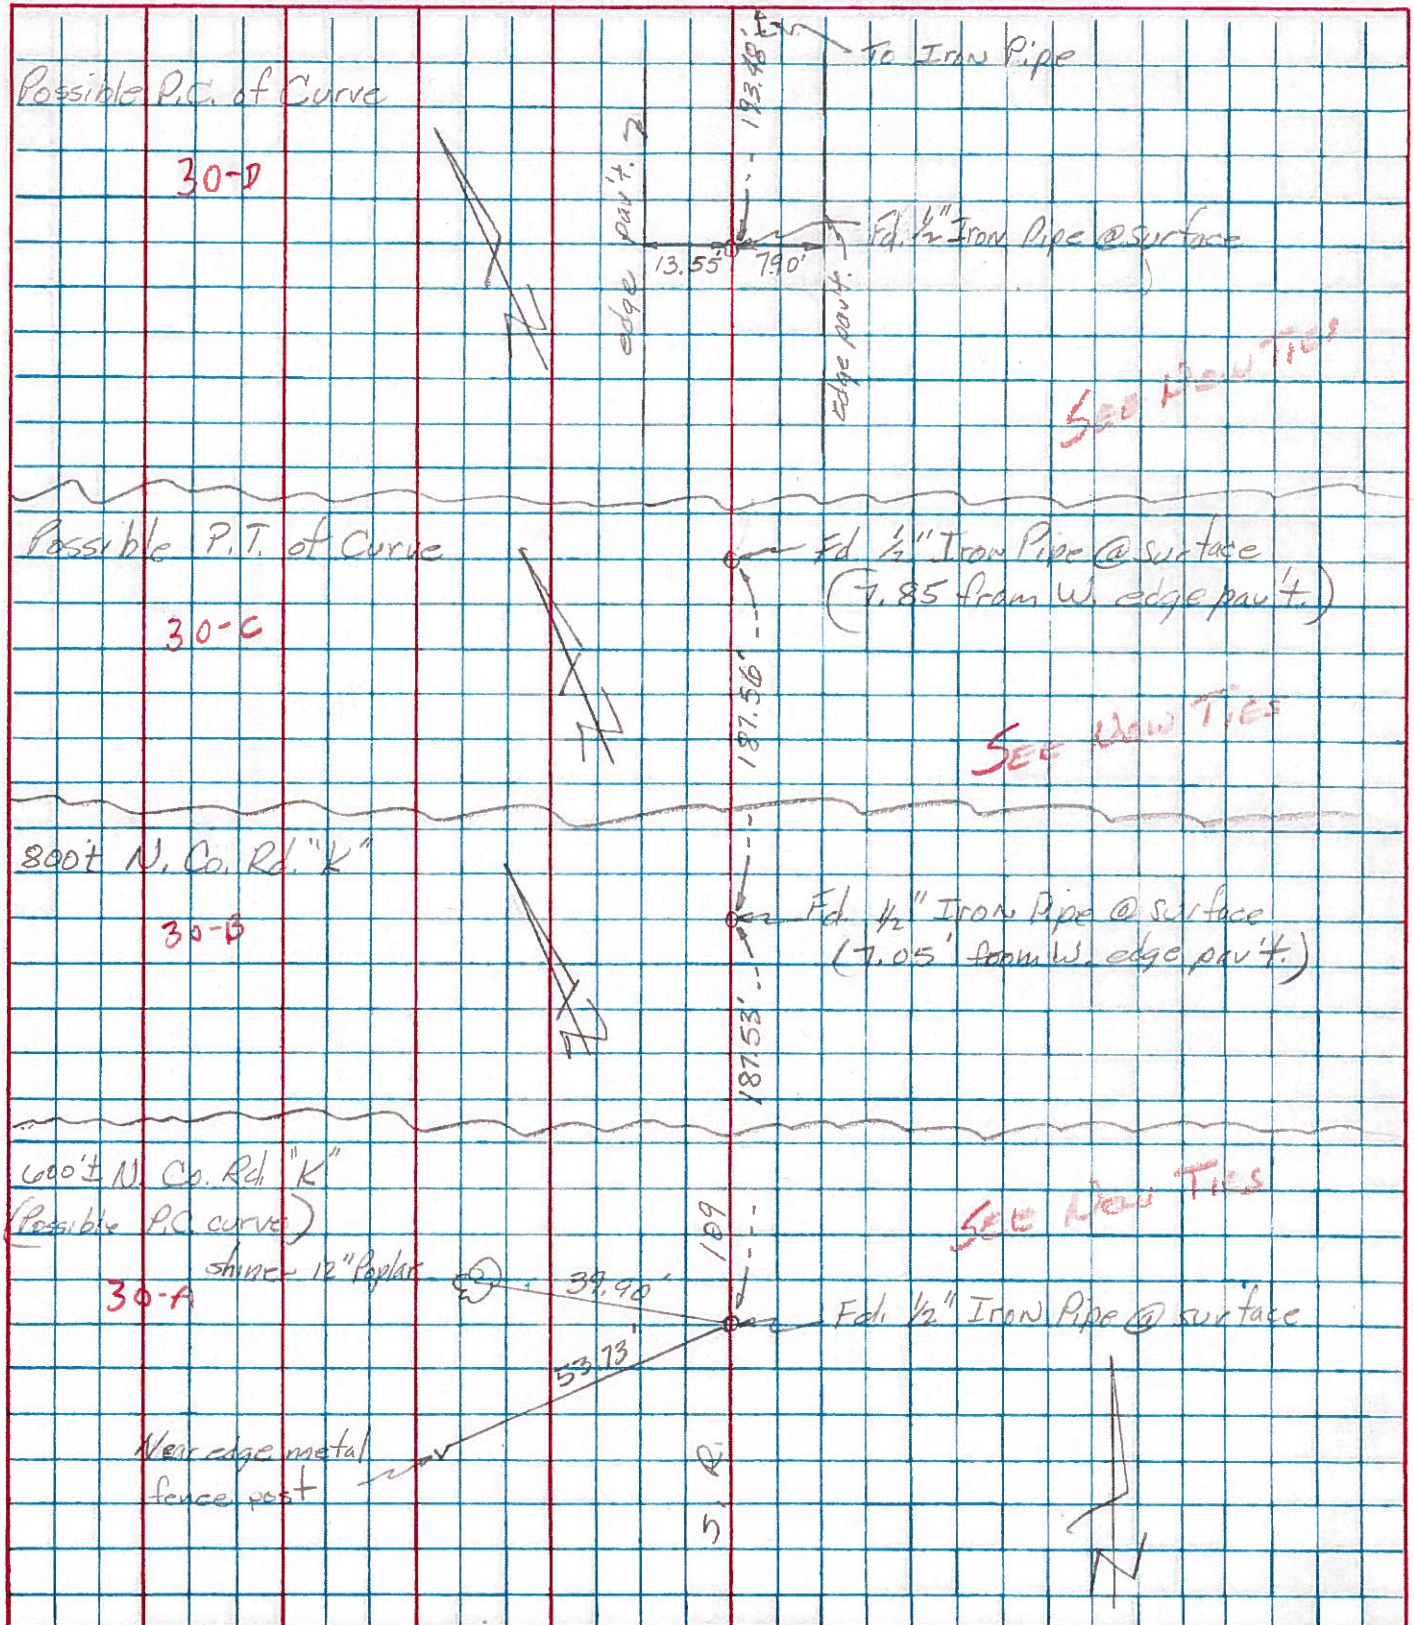

PERSONNEL TITLE PERSONNEL TITLE

Red Beach

Newcomb

Knapa

Wise

COUNTY FULTON

DATE Nov. 1970

S. R. 109

WEATHER


SEC. PIKE TWP.

TEMP.

DESCRIPTION

ALIGNMENT & CONTROLS

JOB NO.

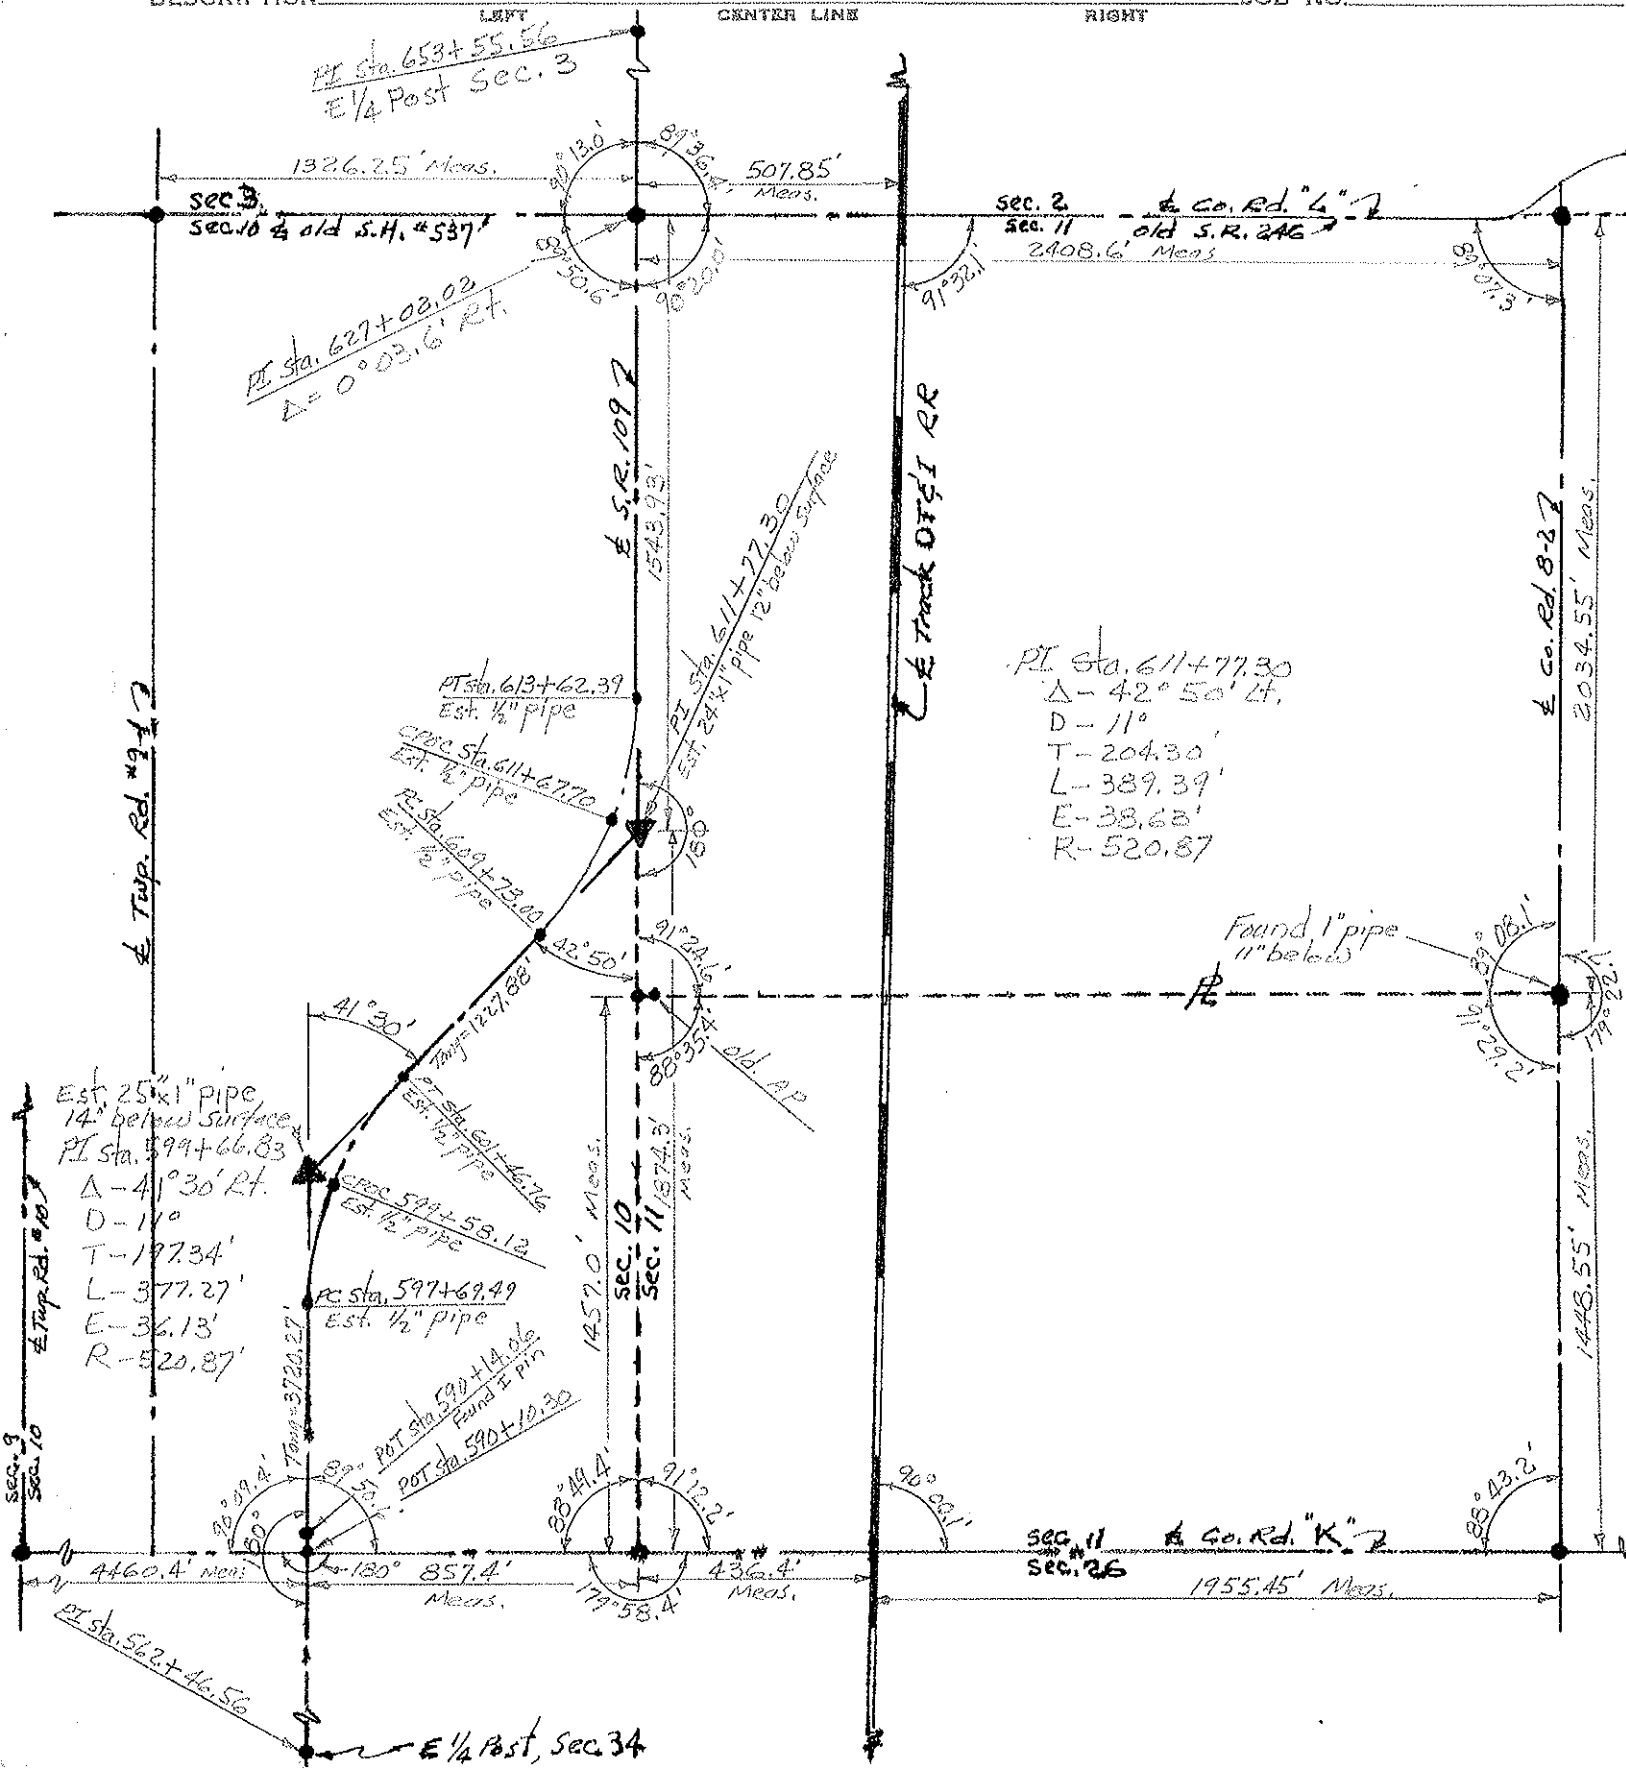

PERSONNEL	TITLE	PERSONNEL	TITLE
Red Beach			
Newcomb			
Knappe			
Wise			

COUNTY FULTON DATE Nov. 1970
S. R. 109 WEATHER _____
SEC. PIKE TWP. TEMP. _____

DESCRIPTION

CONTROL POINTS

JOB NO

