

O.D.O.T. DISTRICT 2 SURVEY OFFICE (USE ONLY)

PERSONNEL

REFERENCE NO. 30 E

SHEET 18 OF 35

NOTES RHOADES

DATE 4/26/21

ROUTE SR 109

H.C. O'DONNELL

WEATHER CLOUDY

COUNTY FULTON

R.C. NIESE

TEMP. 46°

TOWNSHIP PIKE

SECTION 10

DWG BY NIESE PID PAVE TRAIN

T 10 S R 3 E

TYPE MONUMENT MAG/WASHER

ON SURFACE - ~~BELOW~~ ON

OFFSET CL PAVEMENT 4.2' ~~LT~~ : RT

6.5' TO RT EDGE PAVEMENT


STATION: 611+82.25

HORZ.DATUM: NAD83(2011)


GEOID: 2018

GRID: NORTHING: 716475.857

EASTING: 1548949.537

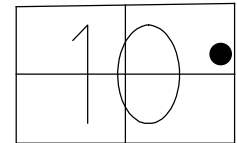

RECORD:
SET P.K./WASHER
11/20/96
FD P.K./WASHER
6/15/12, MC
SET MAG/WASHER
3/7/13
FD MAG/WASHER
REFE30
4/26/21, JFO
8/26/21, JFO

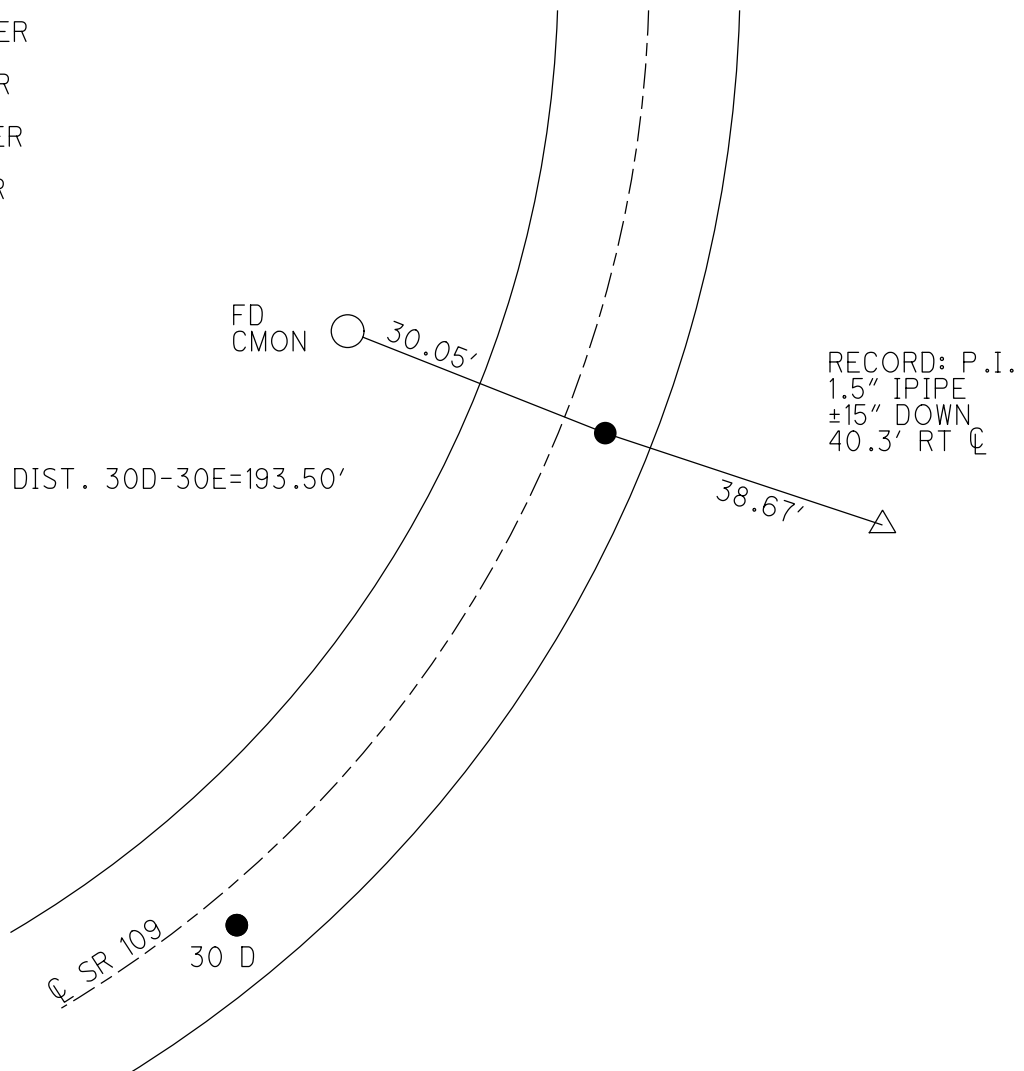

O.D.O.T. DISTRICT 2 SURVEY OFFICE

PERSONNEL

REFERENCE NO. 31

SHEET 16 OF 28

NOTES CANTERBURY

H.C. LOEHRKE

R.C. CANTERBURY

DATE 8-26-96

WEATHER FAIR

TEMP. +80°

ROUTE 109

COUNTY FULTON

TOWNSHIP PIKE

SECTION 10

T10 S R3 E

Set P.K./WASHER

10-2-97

C.L.


TYPE MONUMENT Sm. R.R. SPK.

ON SURFACE - BELOW YES

LEFT - C PAV'T. - RIGHT 1.34" RT &

867" TO RT EDGE PAVEMENT

S.L.M. 18+639.5 +698 (G13+81)

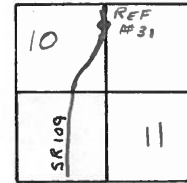


Set P.K.'s & WASHERS
10-1-90
M.B.

SET P.K./WASHER IN LEVELING

COURSE 11/20/96 M.R.C.

BOTH POINTS

Set I-Rods = 1

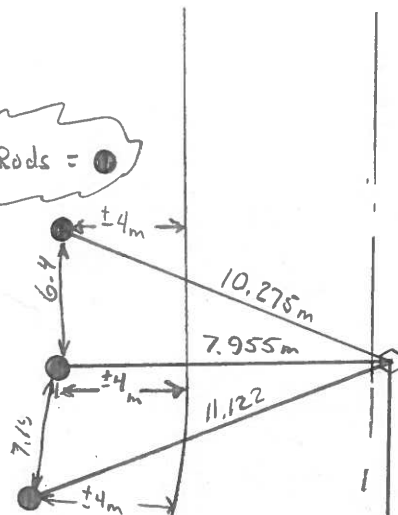

SR109
62.271 (REC)

CONC. R/W MON.
TOP Brake but H612 to use.

9.138"

11.796 (REC)

Record: Fd V2 I-PIPE
38.1cm DEEP
P2. CURVE 1/2.283m. RT. of & Pmnt.
Located "Schonstedt" but didn't dig

30° E

O.D.O.T. DISTRICT 2 SURVEY OFFICE

PERSONNEL

REFERENCE NO. 31

SHEET OF

NOTES BAENHISEL

H.C. " "

R.C. HOFFMAN

DATE 9-4-90

WEATHER clear

TEMP. +80°

ROUTE 109

COUNTY Fulton

TOWNSHIP Pike

SECTION 10

T. 10 S. R. 3 E


TYPE MONUMENT Sm. ee. Spt.

ON SURFACE - BELOW yes

LEFT - & PAV'T. - RIGHT 1.9

8.4 TO RT EDGE PAVEMENT

S.L.M. 613+81

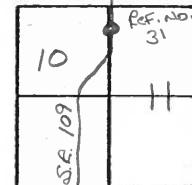

Set P.K.'s & Washers
10-1-90
MB

Note: Ref. No. 31
Tacked
Used Hubs to reset
Control, but has
been removed

30-E Ref. No.
Note: P.K. NAIL & Washer
was reset by using
tacked hubs, that
has been removed

Conc. P.I. Mon.
Top Broke, but ABLE
TO USE



29.97

Fd. P.K. NAIL

(Rec. Dist. 193.5)



BACK TANG.

(Rec. Dist. 204.3)

38.7

Record: Fd 1 1/2" I. Pipe
15" deep
P.I. CURVE

LOCATED WITH Schonstedt, but didn't dig.
40.3 RT OF & PAUT

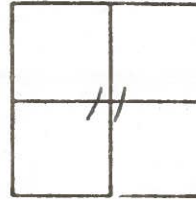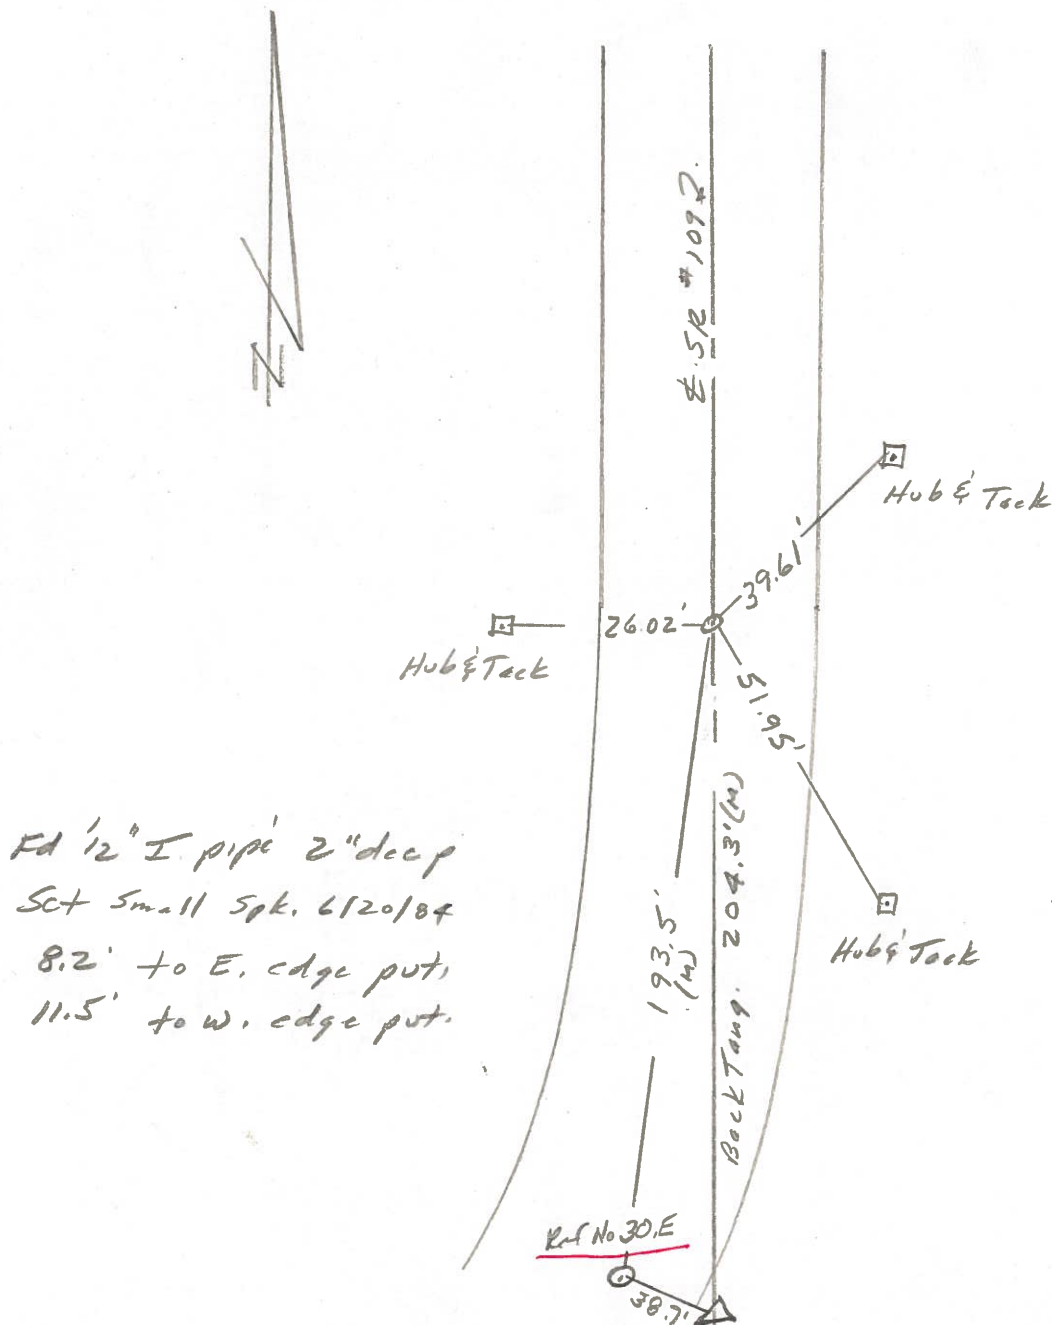County Fulton S.R. 109Township P. KeSection 11T N, R EPersonnel I. StoneP. NeuseR. MichalokD. CurtisDate 12 April 84Weather SunnyTemp. 48°REF. NO. 31

SHEET 13 OF

Date 12 April 84

Weather Sunny

Temp. 48°

A 2x2 grid with a double slash in the center.

N
A

R. Micha


D. Curtis

$$613 + 81$$

S_m RR S_{PK}

1.9 RT $\frac{1}{2}$

8.4 TO RTED

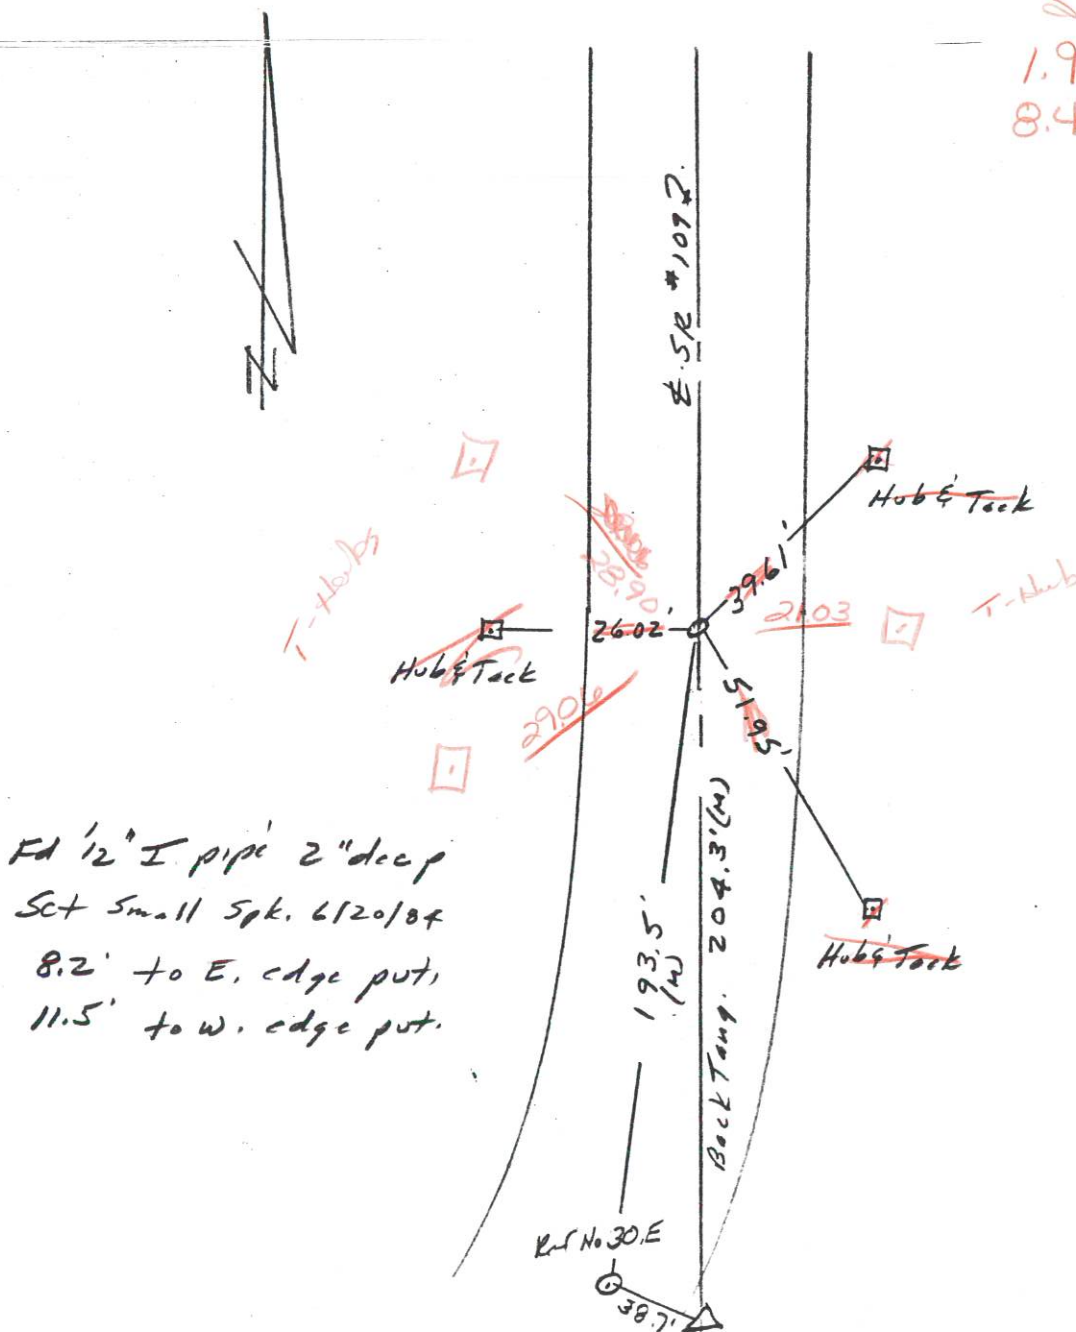

PERSONNEL	TITLE	PERSONNEL	TITLE
Tomsic			
Granata			
Vanpo			
Boyle			

COUNTY FultonDATE July 19, 1973S. R. 109

WEATHER

SEC. PIKE TWP.

TEMP.


DESCRIPTION

LEFT

CENTER LINE

RIGHT

JOB NO.

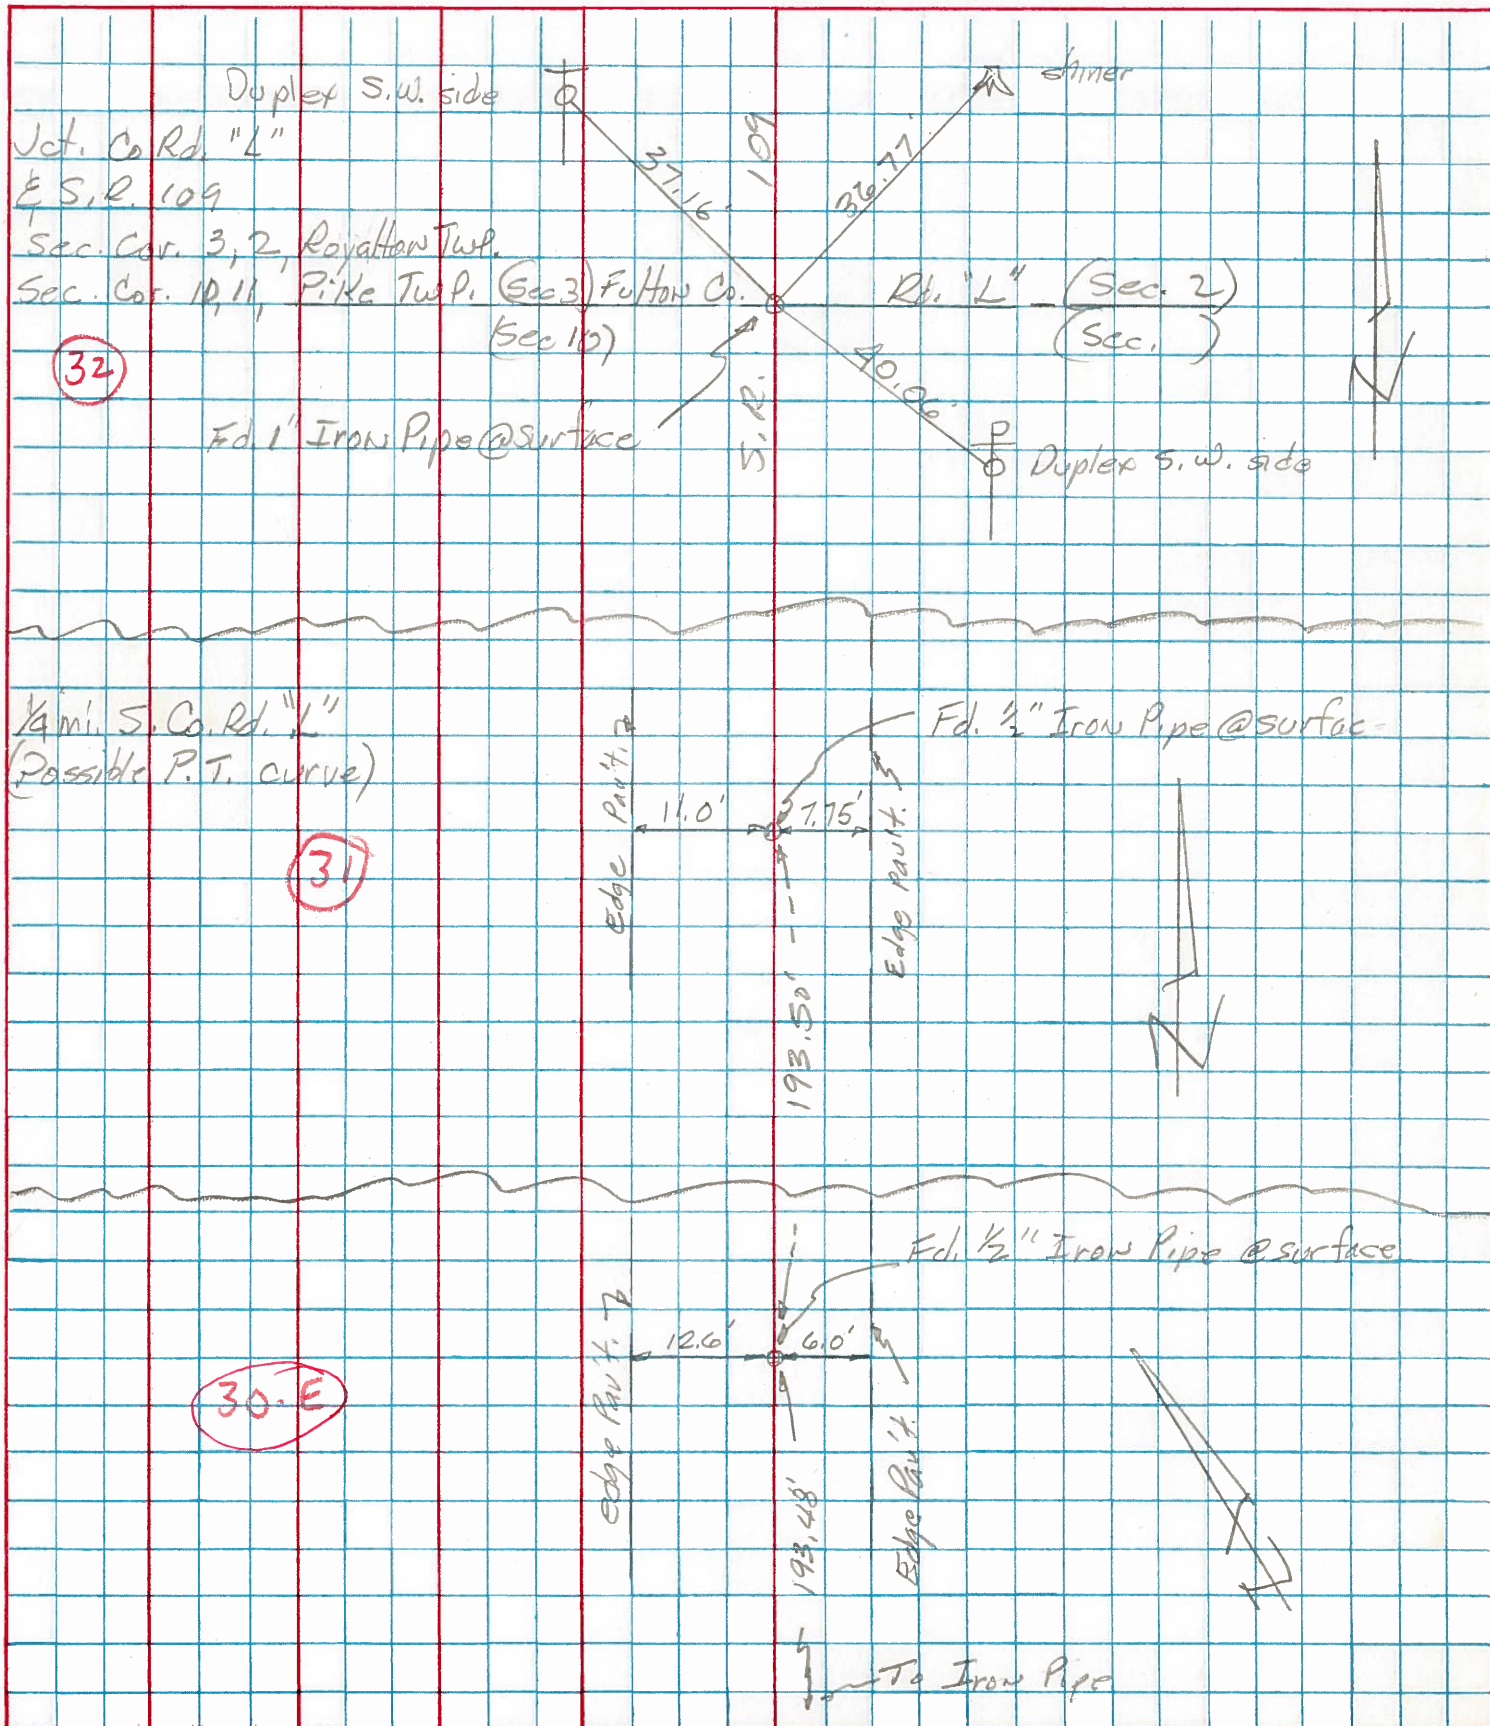

PERSONNEL	TITLE	PERSONNEL	TITLE
Red Beach			
Newcomb			
Knappe			
Wise			

COUNTY FULTON DATE Nov. 1970
S. R. 109 WEATHER _____
SEC. PIKE TWP. TEMP. _____

DESCRIPTION

CONTROL POINTS

JOB NO

