

O.D.O.T. DISTRICT 2 SURVEY OFFICE (USE ONLY)

PERSONNEL

REFERENCE NO. 32

SHEET 20 OF 35

NOTES RHOADES

DATE 4/26/21

ROUTE SR 109

H.C. O'DONNELL

WEATHER CLOUDY

COUNTY FULTON

R.C. NIESE

TEMP. 45°

TOWNSHIP PIKE

DWG BY NIESE

PID PAVE TRAIN

SECTION 10

T 10 S R 3 E

TYPE MONUMENT MAG/WASHER

ON SURFACE - ~~BELOW~~ ON

OFFSET CL PAVEMENT 0.6' ~~LT~~ : RT

- TO - EDGE PAVEMENT


STATION: 627+15.51

HORIZ.DATUM: NAD83(2011)


GEOID: 2018

GRID: NORTHING: 718005.810

EASTING: 1548982.427

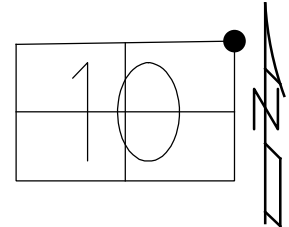

RECORD:
SET P.K./WASHER
11/22/96, MC
FD P.K./WASHER
6/18/12, SH
SET MAG/WASHER
3/7/13, MC
FD MAG/WASHER
REF32
4/26/21, JFO
8/26/21, JFO

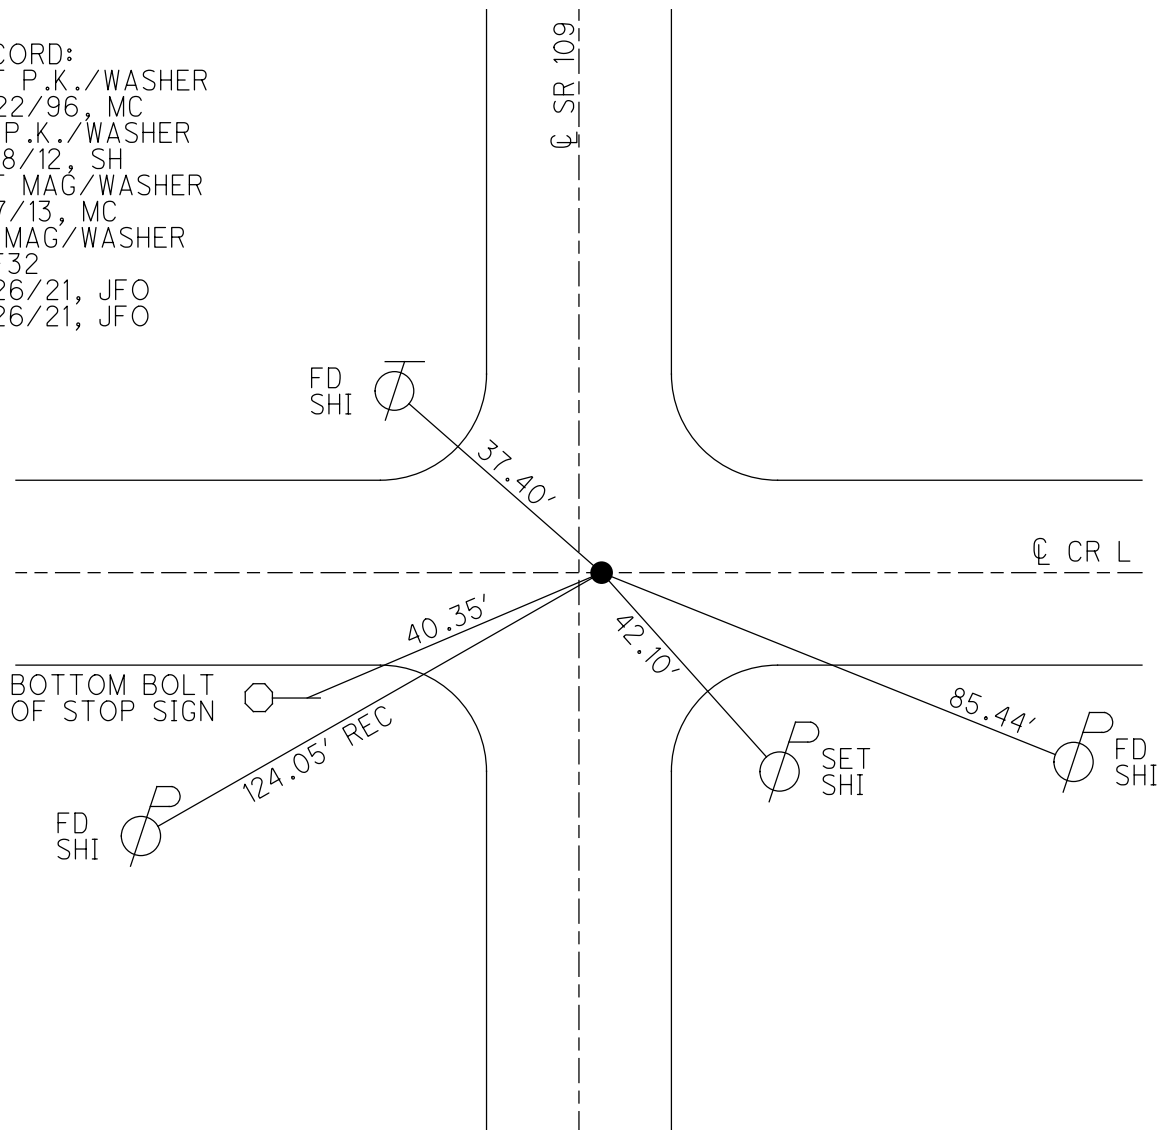

O.D.O.T. DISTRICT 2 SURVEY OFFICE (USE ONLY)

PERSONNEL

REFERENCE NO. 32

SHEET 21 OF 35

NOTES HUSS
H.C. HUSS
R.C. CANTERBURY
HARBAUGH
COUTCHER

DATE 06-18-12
WEATHER FAIR/WARM
TEMP. 82°

ROUTE SR 109
COUNTY FULTON
TOWNSHIP PIKE
SECTION 10
T 10 S R 3 E

TYPE MONUMENT PK/WASHER


ON SURFACE - BELOW ON

LEFT - ℄ PAV'T - RIGHT 0.4'


TO EDGE PAVEMENT

S.L.M. 627+22

Grid: Northing: 718005.797 Easting: 1548982.401

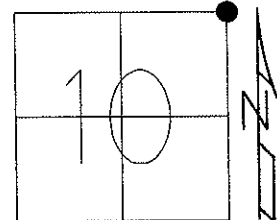

11-22-96 SET PK/WASHER
IN LEVELING COURSE, MRC
03-07-13 RESET MAG/WASHER, MC
06-14-12 GPS REF 32
03-07-13 GPS FIN 32

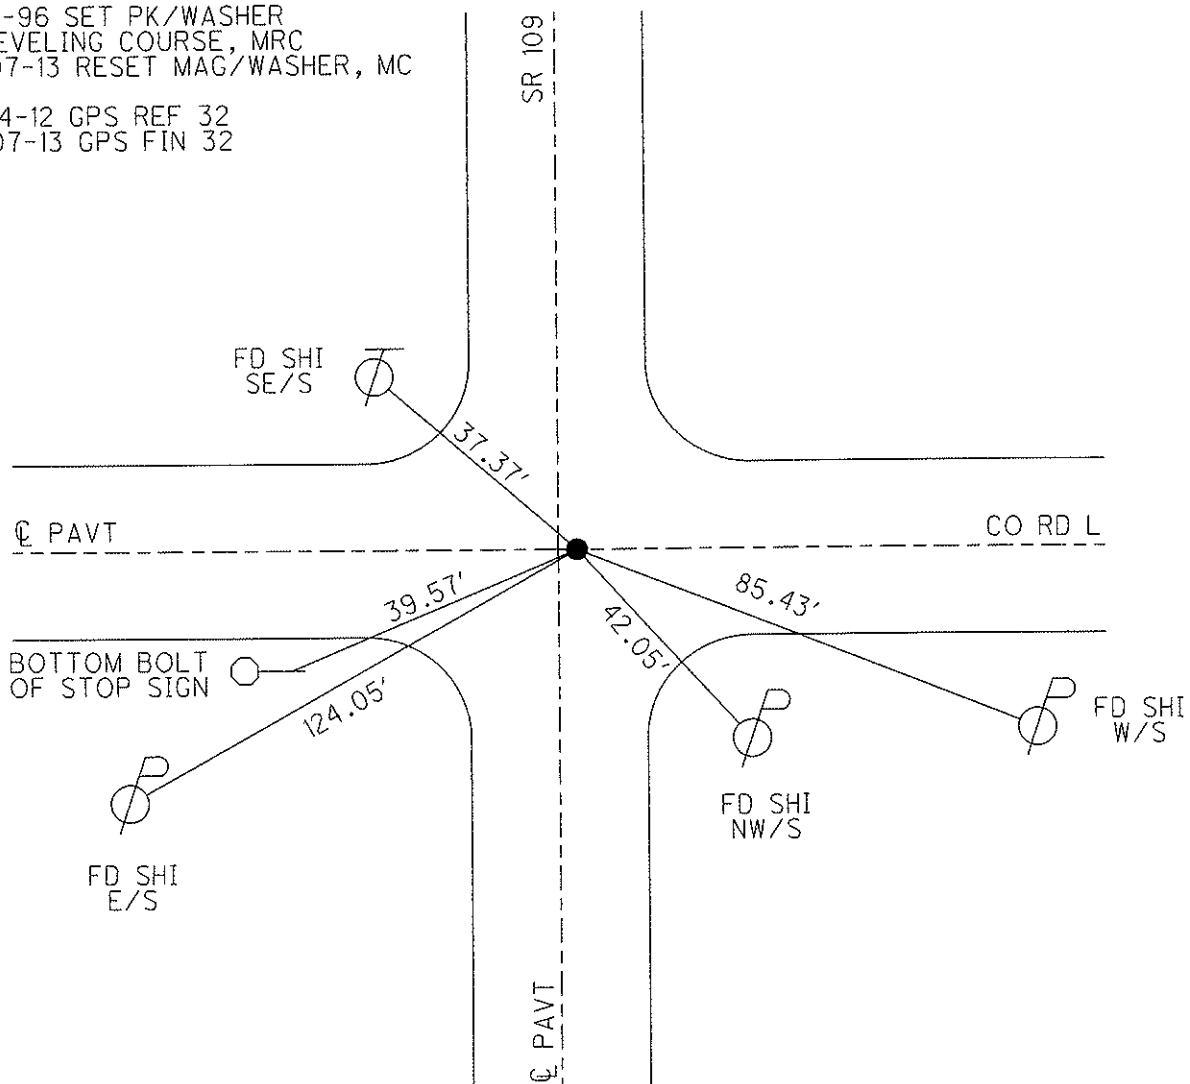

O.D.O.T. DISTRICT 2 SURVEY OFFICE

PERSONNEL

REFERENCE NO. 32

SHEET 17 OF 28

NOTES CANTERBURY

H.C. LOEHRKE

DATE 8-26-96

ROUTE S.R. 109

R.C. CANTERBURY

WEATHER FAIR

COUNTY FULTON

TEMP. +85°

TOWNSHIP PIKE

SECTION NE COR. 10

Reset 9-29-97
C.L.

T 10 S 3 R 3 E

TYPE MONUMENT P.K. & WASHER

ON SURFACE - BELOW YES

~~LEFT~~ - ~~C~~ PAV'T. - ~~RIGHT~~ ON E

— TO — EDGE PAVEMENT


S.L.M. 19+100.8 ON E West (627+22)

3	2
10	11



SET P.K./WASHER IN LEVELING
COURSE 11/22/96. MRC

HUSS - HC
VAN DUSEN - RC
SUNNY +38°F

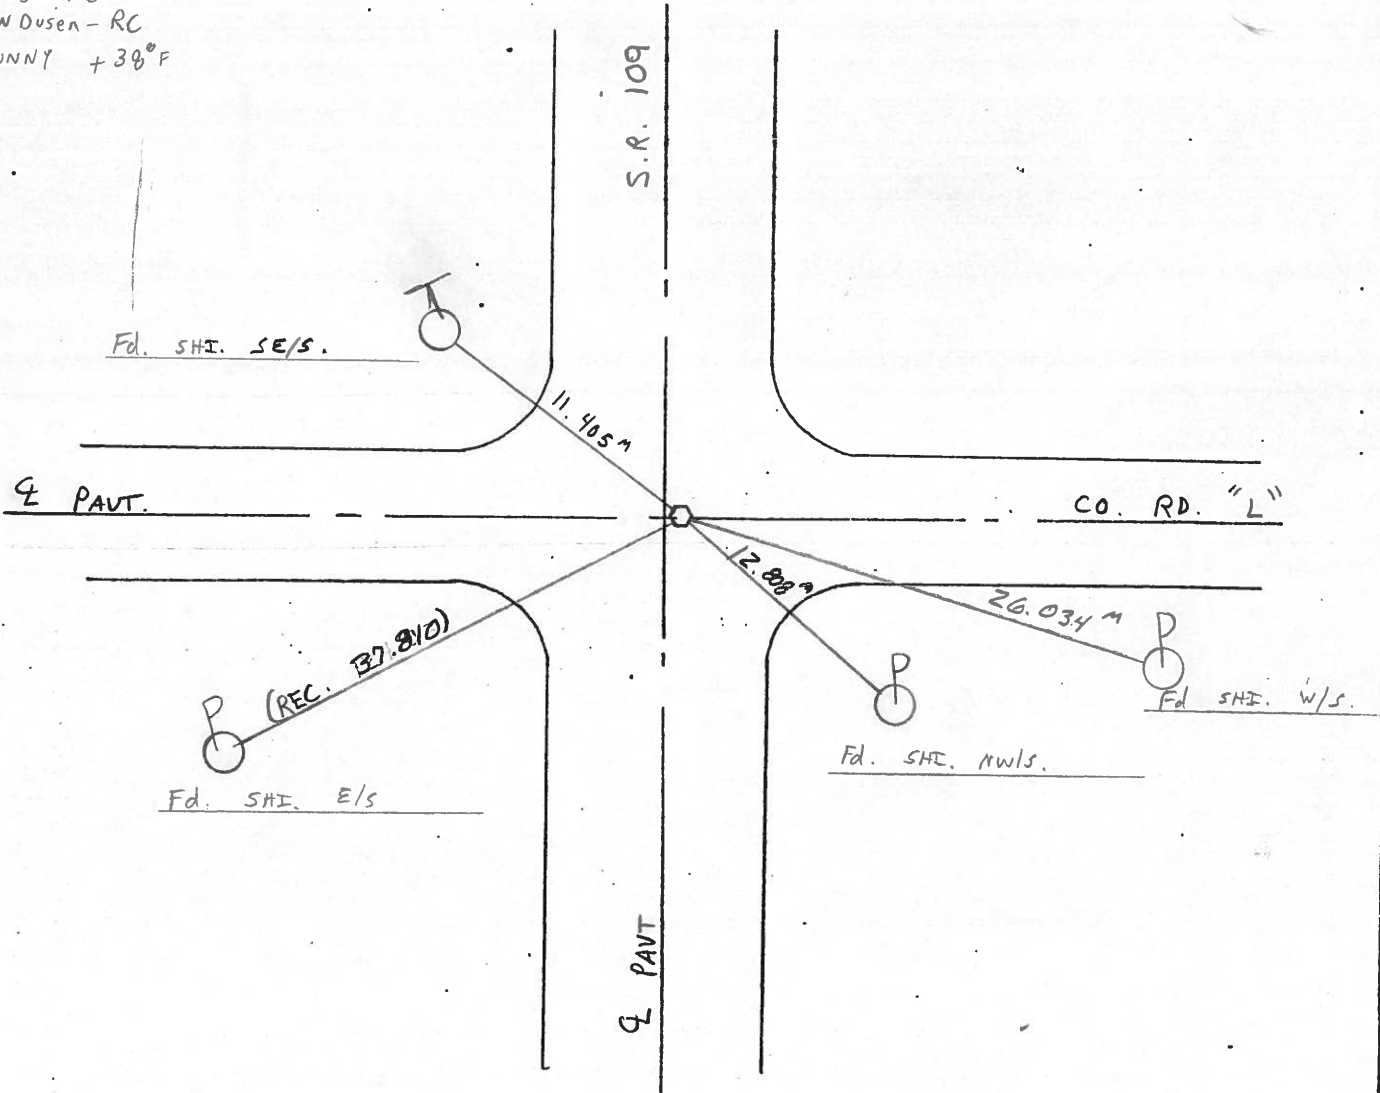

O.D.O.T. DISTRICT 2 SURVEY OFFICE

PERSONNEL

REFERENCE NO. 32

SHEET _____ OF _____

NOTES BARNHISEL

H.C. // // *

R.C. HOFFMAN

DATE 9-4-90

WEATHER Clear

TEMP. +80°

ROUTE 109

COUNTY Fulton

TOWNSHIP PIKE

SECTION NE COE. 10

T 10 S R 3 E

TYPE MONUMENT Sm EE Spk

ON SURFACE - BELOW yes


LEFT - & PAN'T. - RIGHT 0.6

 - TO - EDGE PAVEMENT

S.L.M. 627+22 ON

ON R Paul West

3	2
10	11

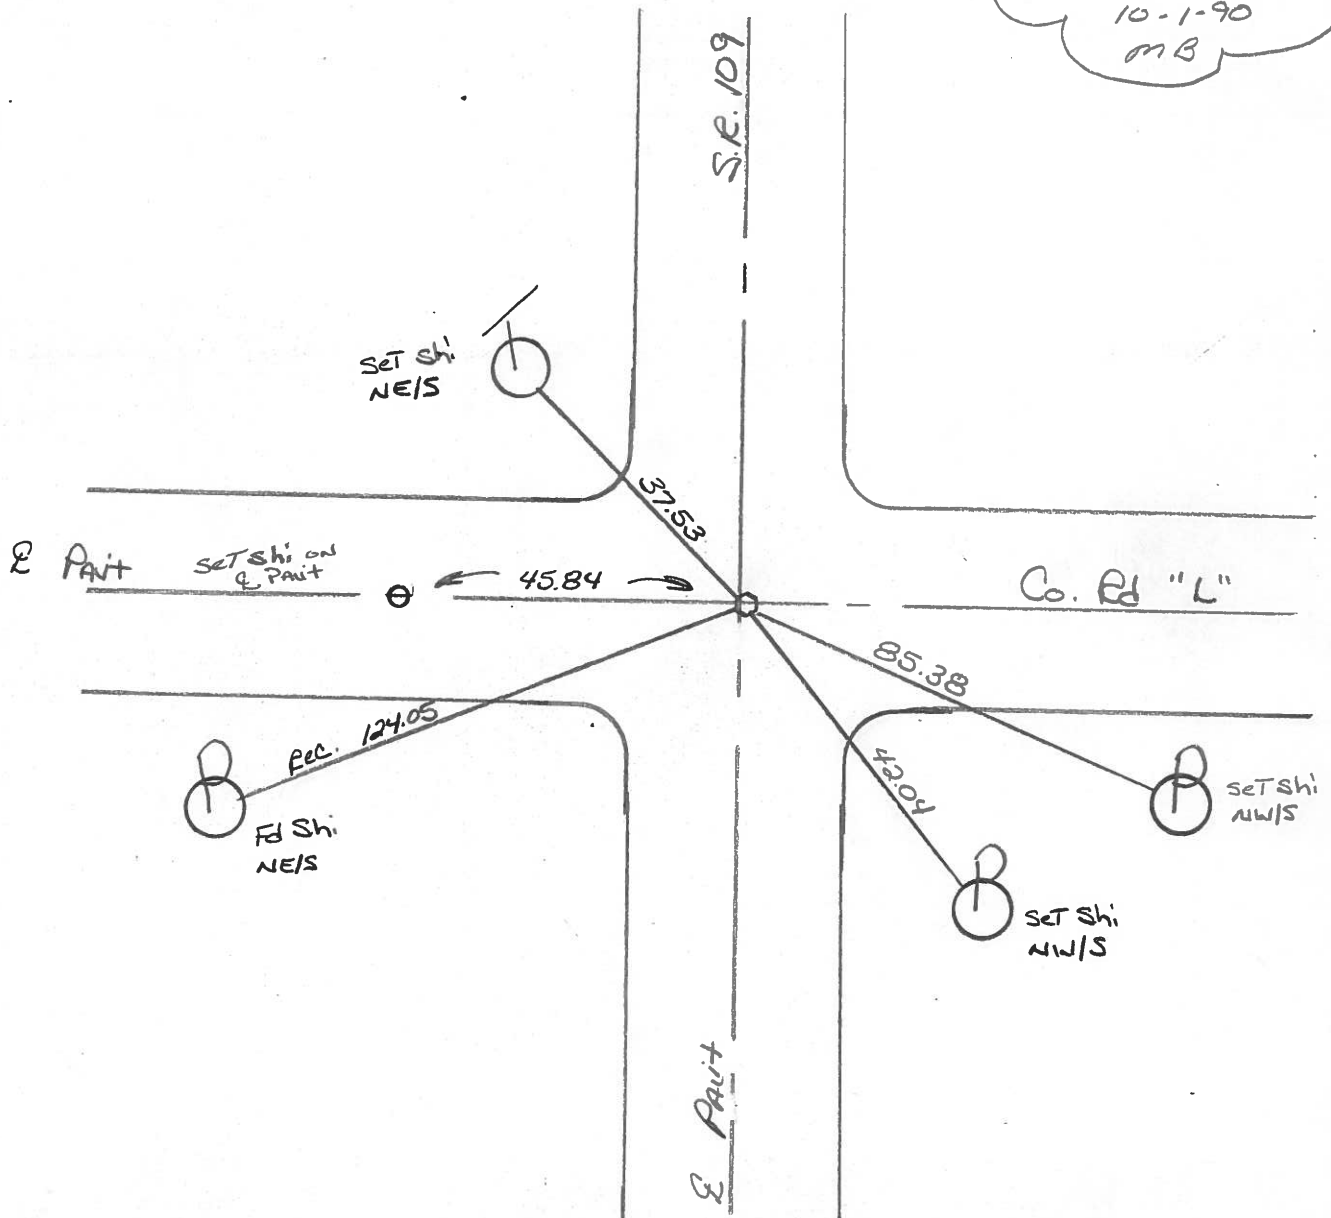


TITLE

DATE 4-23-37 WEATHER Sunny @ 6:00 PM

STONE USED IN Vol. B. P. 207, 1910 by O. GREEN

SET HAROLD THOMPSON AFTER RECONSTRUCTION 8-2-57 (2, 2, 2)

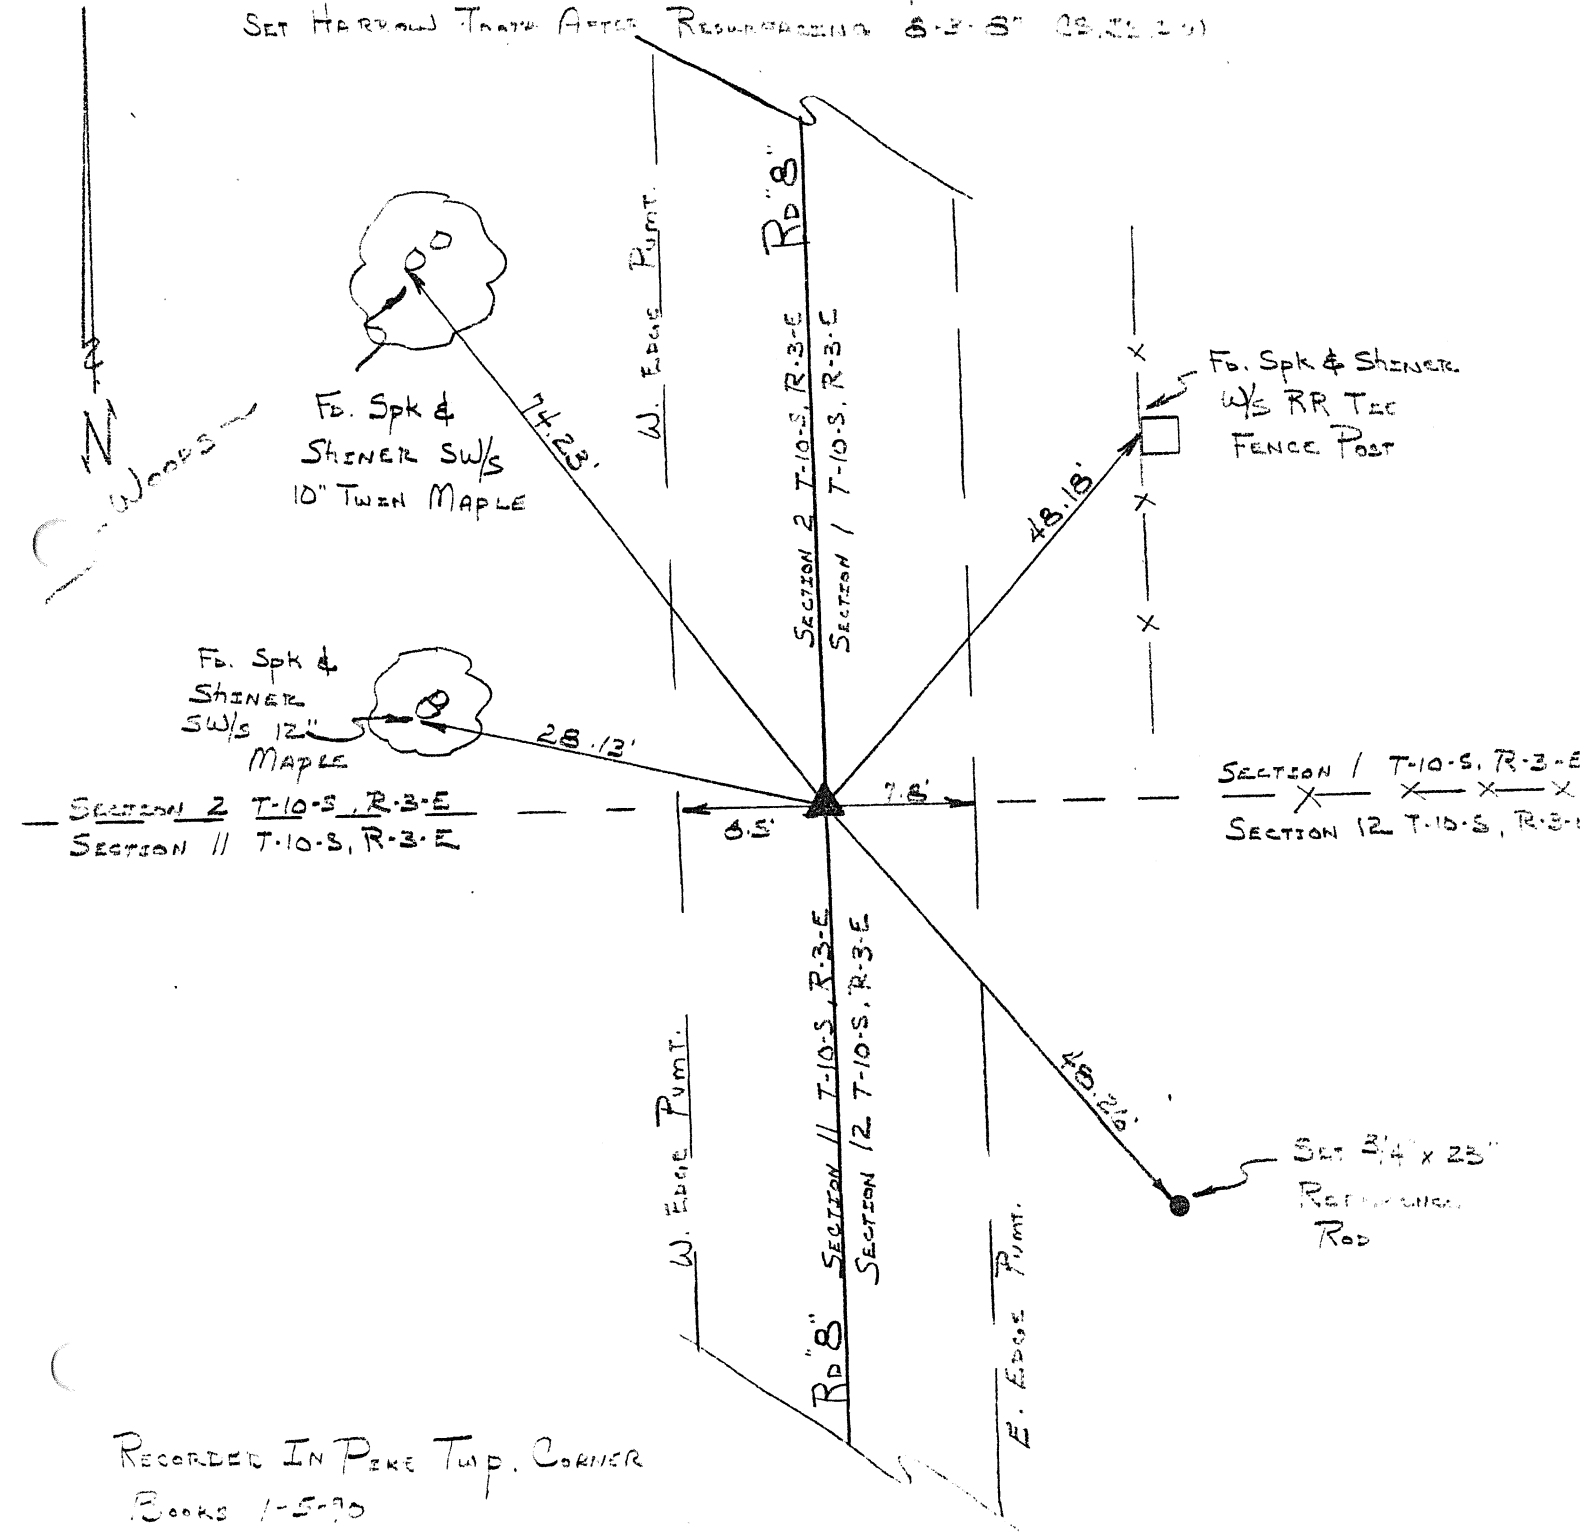

RECORDED IN PIKE TWP. CORNER
BOOKS 1-5-70

ROAD "L" Street to 15th St SP#109

PERSONNEL

TITLE

REFERENCES CHECKED:

STANLEY

4-6-89 STANLEY

SEC. 7.10

T- 10-8

R-3-E

Brooks

Books

CORNER 1/4 CORNER

TWP. PIKE

47

BRINKER

DATE 5-20-86

WEATHER OVERCAST @ 47°

DESCRIPTION: Due To Poor Alignment of Ditch to Main Gate CORNER REPAIR. SET HARDENED TOOTH ON LINE BETWEEN

KNOWN SECTION CORNERS AND $\frac{1}{2}$ the distance between corners.

Set PK Nails 2' S & W

REMOVED HARROW TOOTH TEMPORARILY

SET HARROW TOOTH AFTER RESURFACING

10-2-89 CS. Set SpA & Shiner

NE/S 60" Triple

OAK

SET Spk & SHINER

NW/s

N. Edge Point

SECTION 3 T-10-S, R-3-E

Ro "L"

Section 10, T-10-E, R-3-E

S. Edge Point

SECTION 3 T-10 S, R-3-E

$R_0 = L$

SECTION 10 T-10-S, R-3-E

Set Spik

Sw

Cut "X" Top BRD Bolt

From S. End 14' Multi-Plate

2653.10

2653. 10'


RECORDED IN PIKE TWP.
CORNER BOOKS 2-5-8703.

OK 7-7-

48

PERSONNEL	TITLE	SEC.	T-	R-
<u>STANLEY</u>	REFERENCES CHECKED:	<u>3, 10</u>	<u>10-2</u>	<u>3-E</u>
<u>BROOKS</u>	<u>4-6-89 STANLEY</u>	CORNER	<u>EAST 1/8 CORNER</u>	TWP. <u>PIKE</u>
<u>BRENNER</u>		DATE	<u>5-20-86</u>	WEATHER <u>OVERCAST, Mist @ 52°</u>

DESCRIPTION: SET HARROW TOOTH ON LINE OF SECTION CORNERS AND 1/4 of Total Distance Between CORNERS. Removed 1/2" Rod Set by N. Smith (1930s?) At Station 39+80.5 AND INCORRECT. Alignment 4.03' South of E-W Section Line

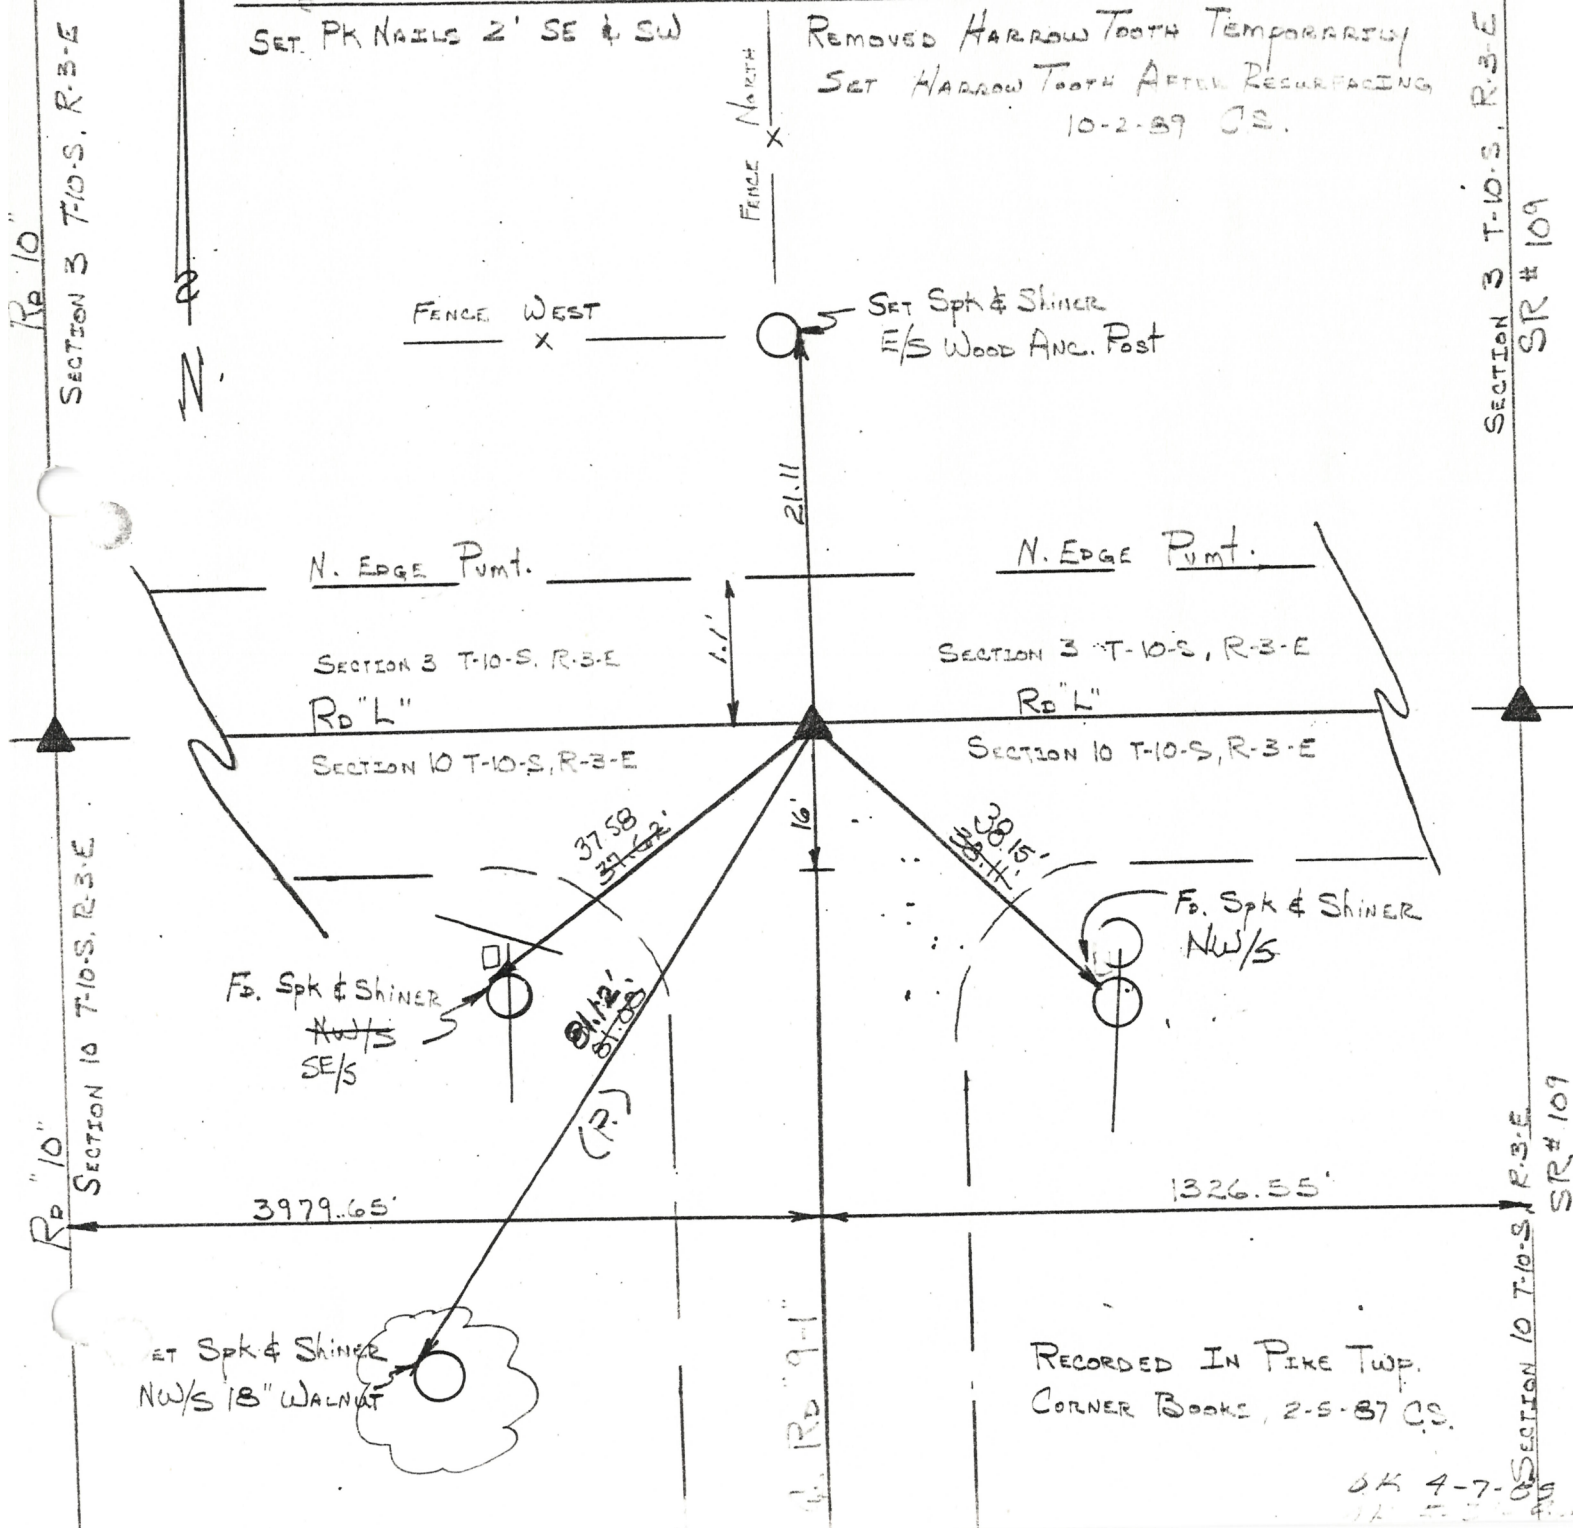

ROAD Intersection Rd "L" & Rd "B-E"

50

PERSONNEL

TITLE

SEC. 2, 11

T-10-S

R-3-E

CORNER


CONTACT
E-111

TWP. PIKE

DATE 5-6-85

WEATHER Pt. Sunny, Very Windy @ 72°

DESCRIPTION: Rewitnessed Existing 3/4" Pipe over "Stone IN Tile" Recovered by N. Smith

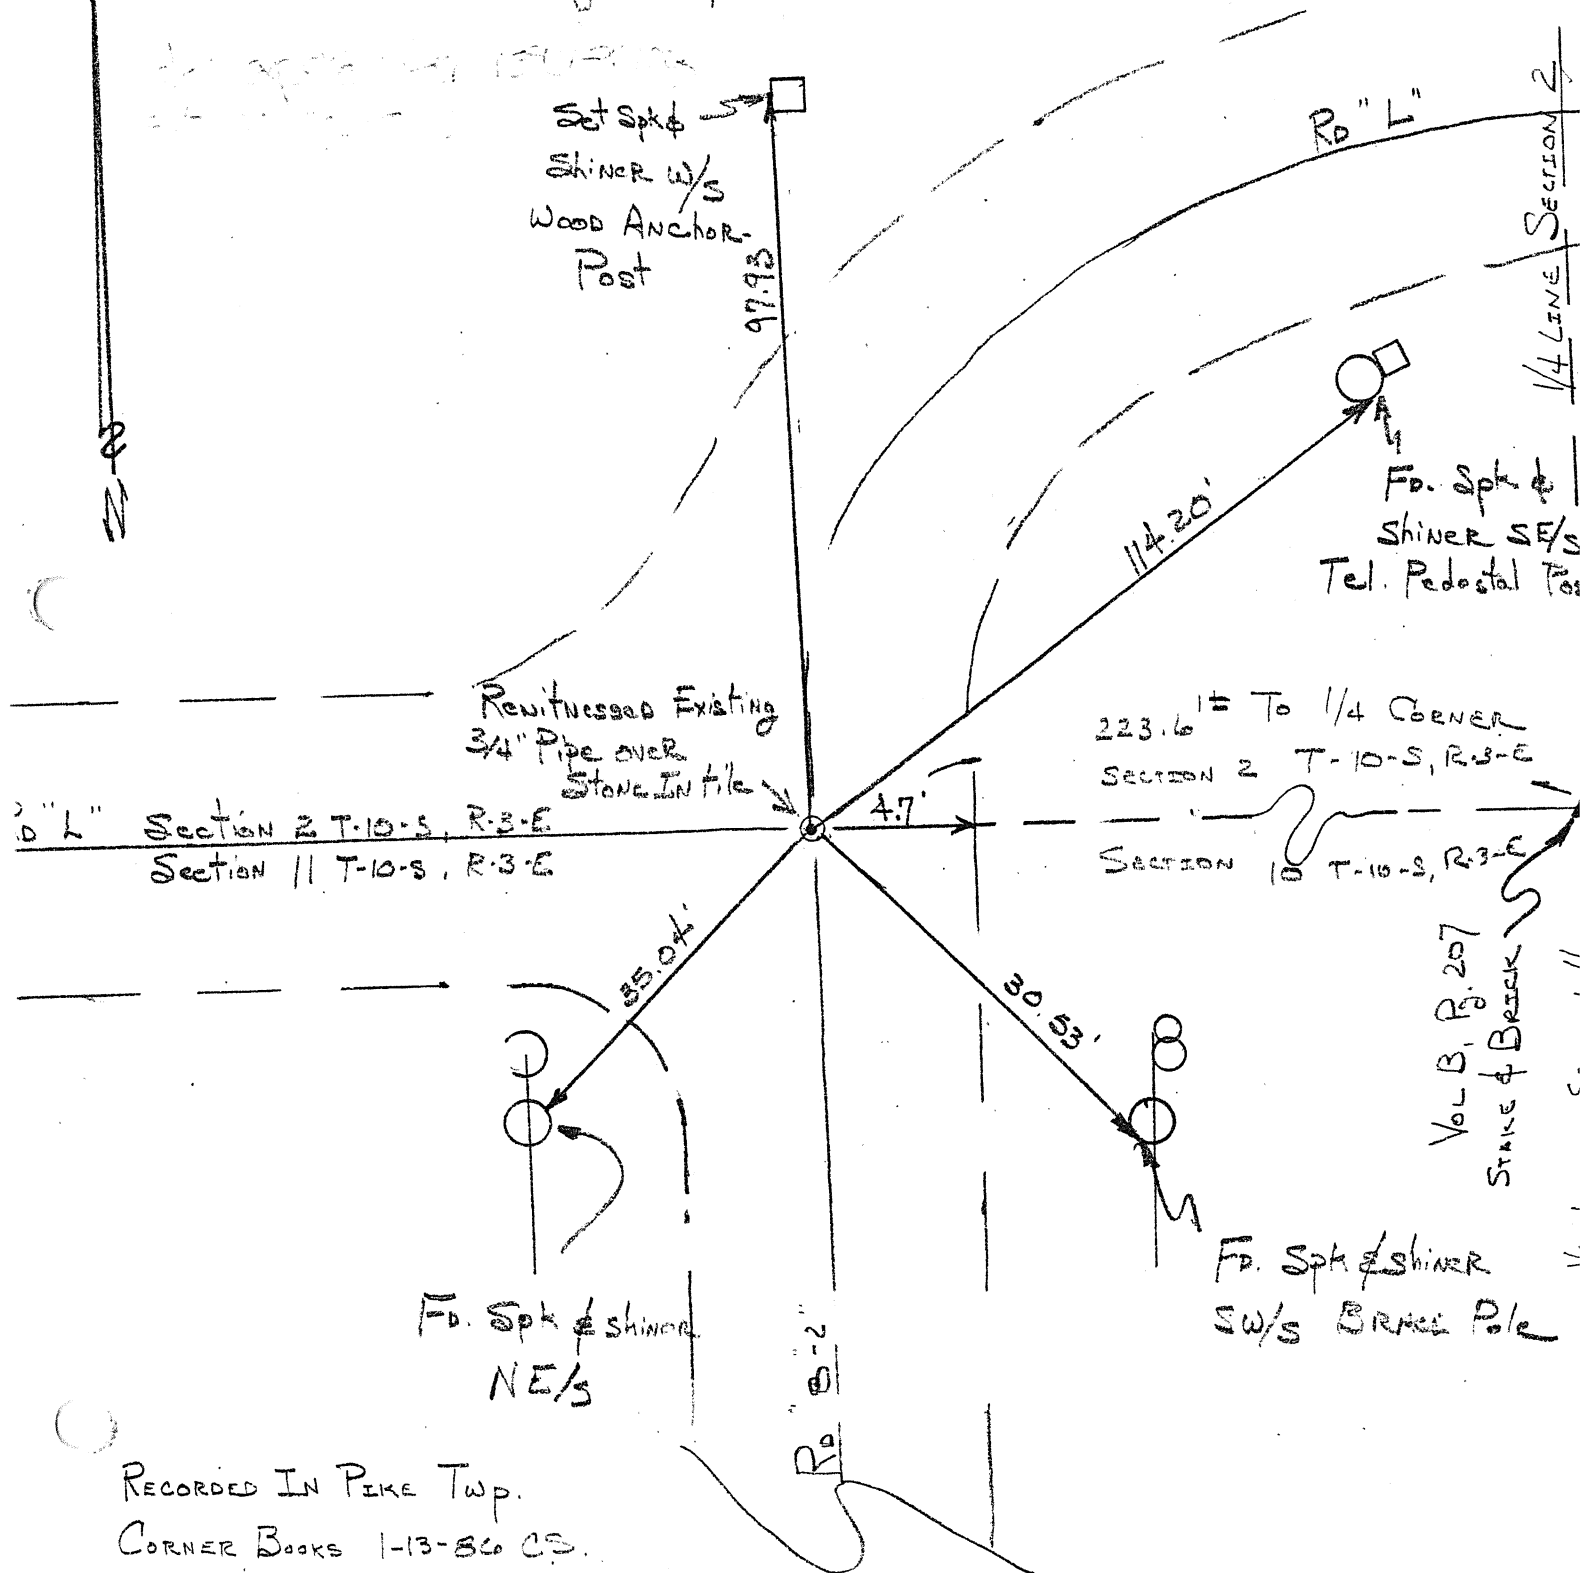


RECORDED IN PIKE TWP.

CORNER BOOKS 1-13-86 CS.

OK 5-7-


County Fulton S.R. 109Township PikeSection 2-3-10-11T N, R EPersonnel L. StoneP. NeuserR. MichalakD. CurtisDate 12 April 84Weather SunnyTemp. 49°

3	2
10	11

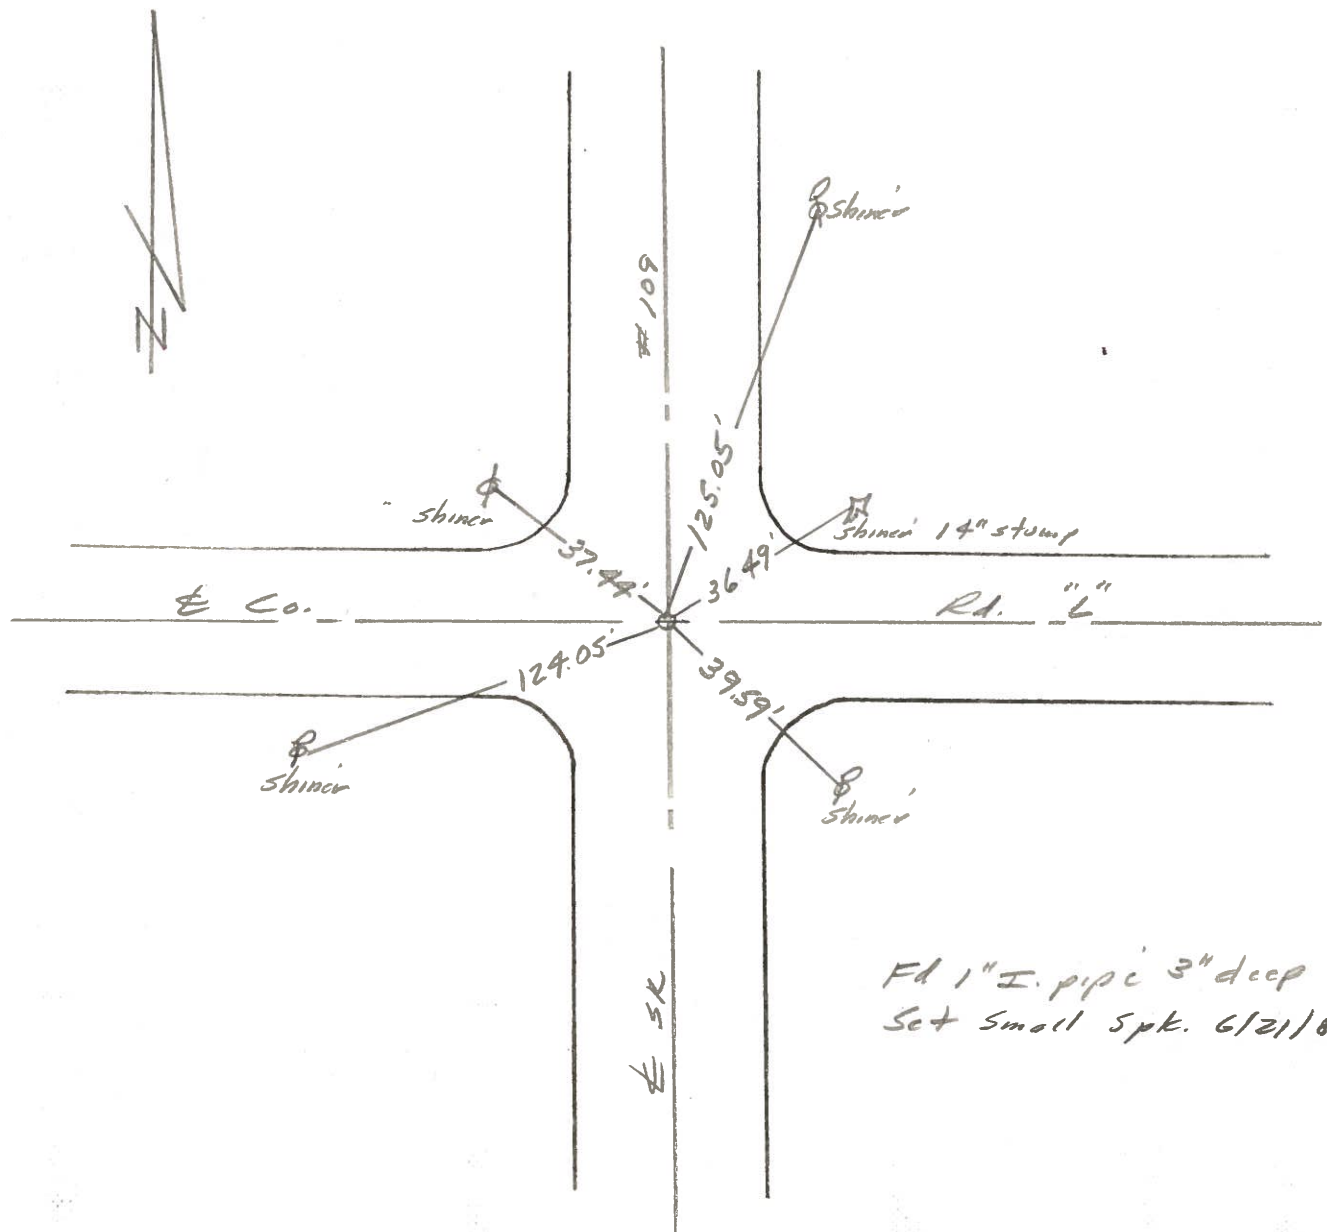REF. NO. 32


County Fulton S.R. 109Township PikeSection 2-3-10-11T N, R EPersonnel I. StoneP. NeusserR. MichalakD. CurtisDate 12 April 84Weather SunnyTemp. 49°

3	2
10	11

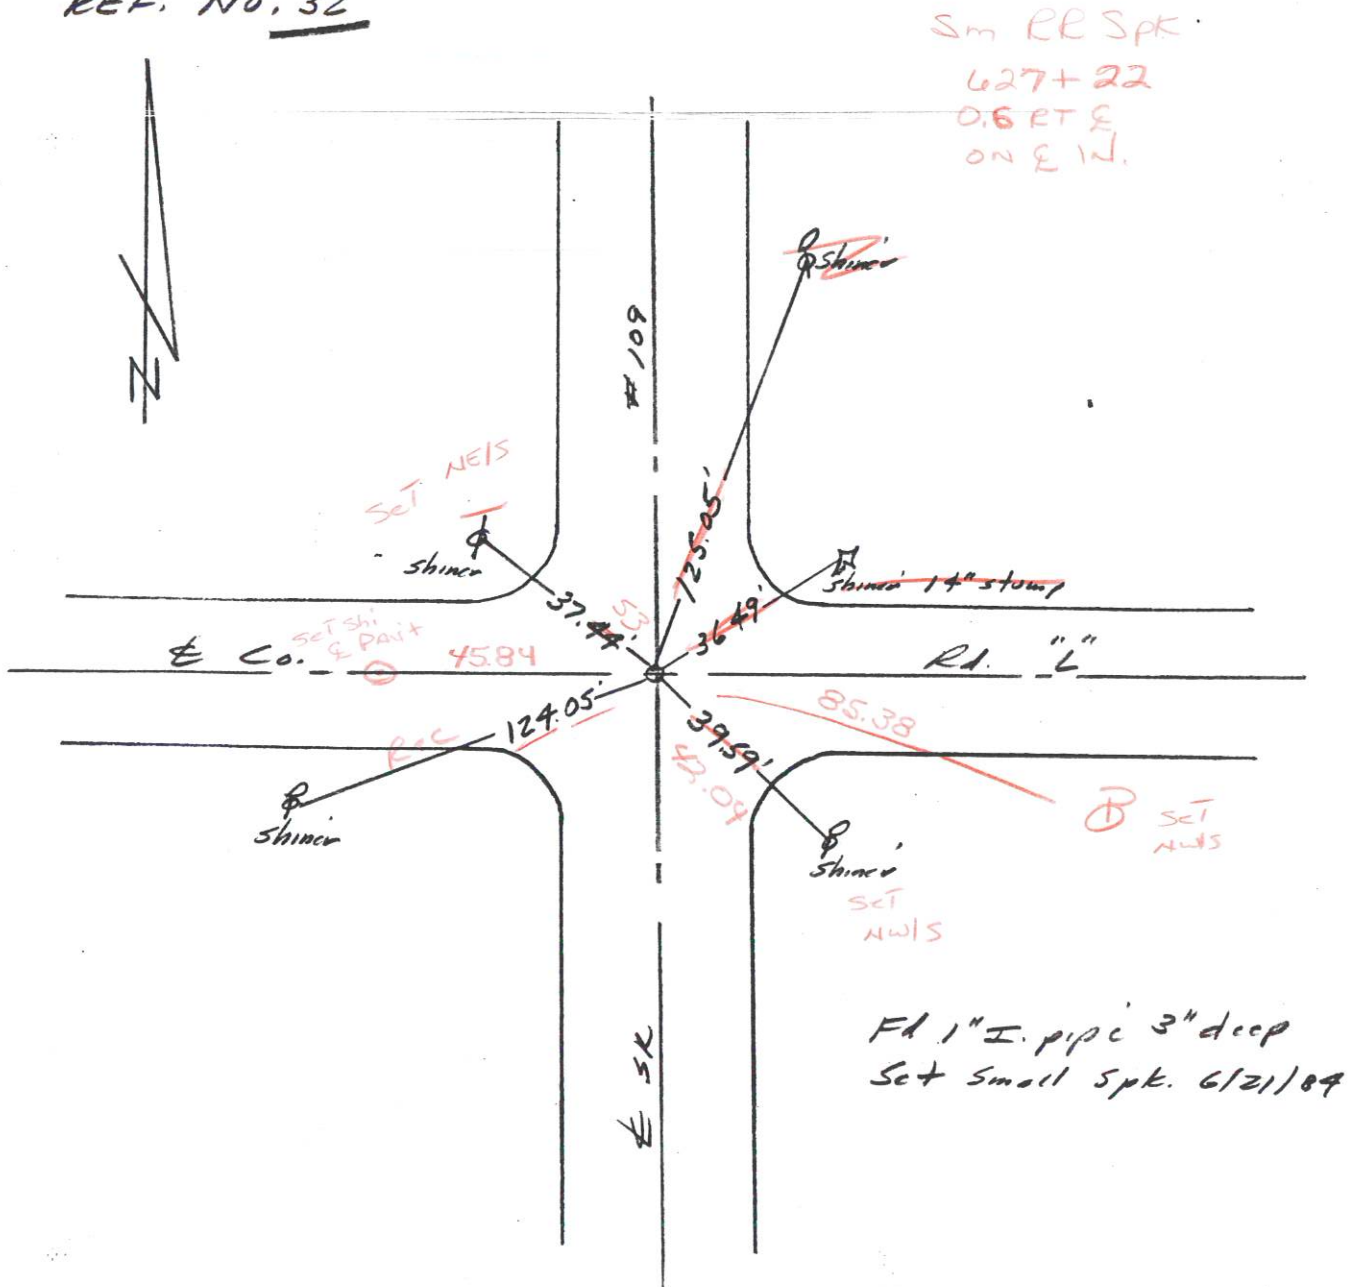
REF. NO. 32

PERSONNEL	TITLE	PERSONNEL	TITLE	COUNTY	DATE	WEATHER	TEMP
Red Beach				Fulton	22-23 Feb. '27		
W. Knappe				S. R. 109			
				SEC. PIKE TWP			
DESCRIPTION <u>CONTROL POINTS</u>				JOB NO.			

(33)

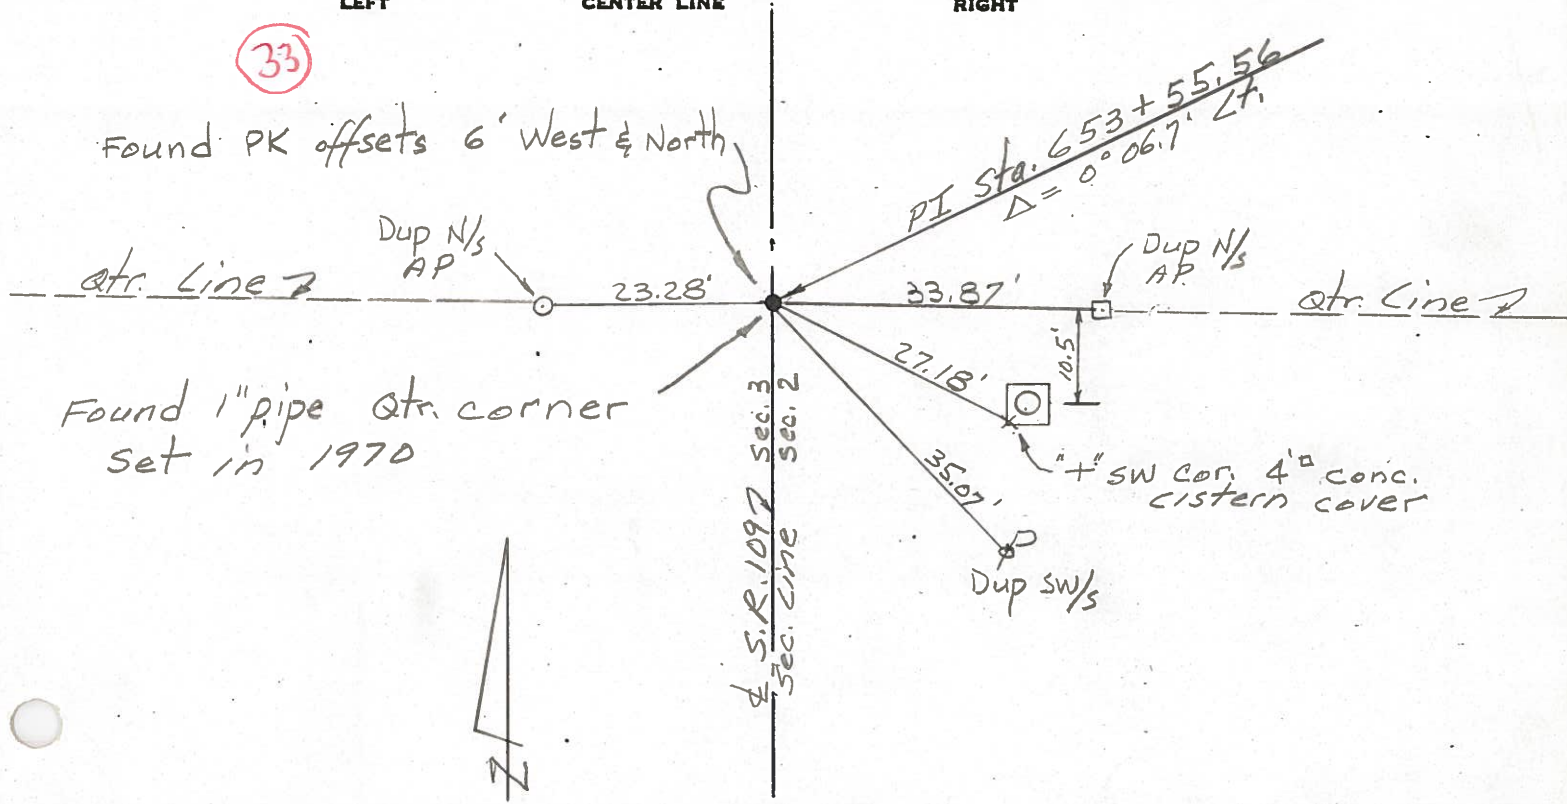

(32)

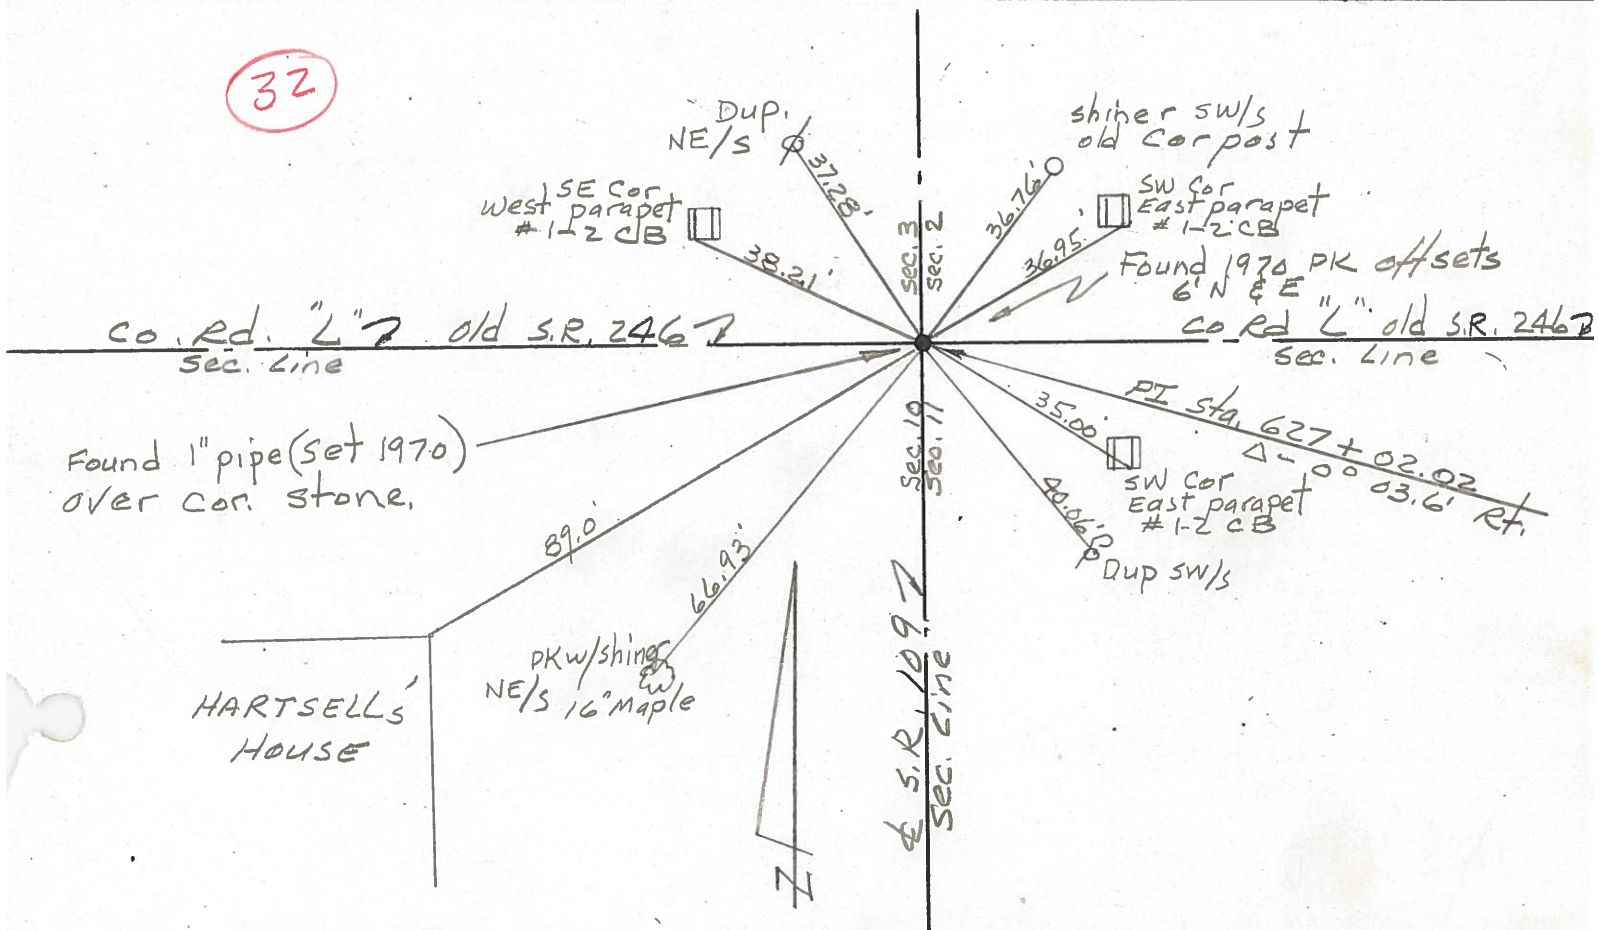


PERSONNEL	TITLE	PERSONNEL	TITLE
Tomsic			
Granata			
Vanzo			
Boyle			

COUNTY Fulton DATE July 19, 1973

S. R. 109 WEATHER _____

SEC. Pike Twp. TEMP. _____

DESCRIPTION _____ LEFT _____ CENTER LINE _____ RIGHT _____ JOB NO. _____

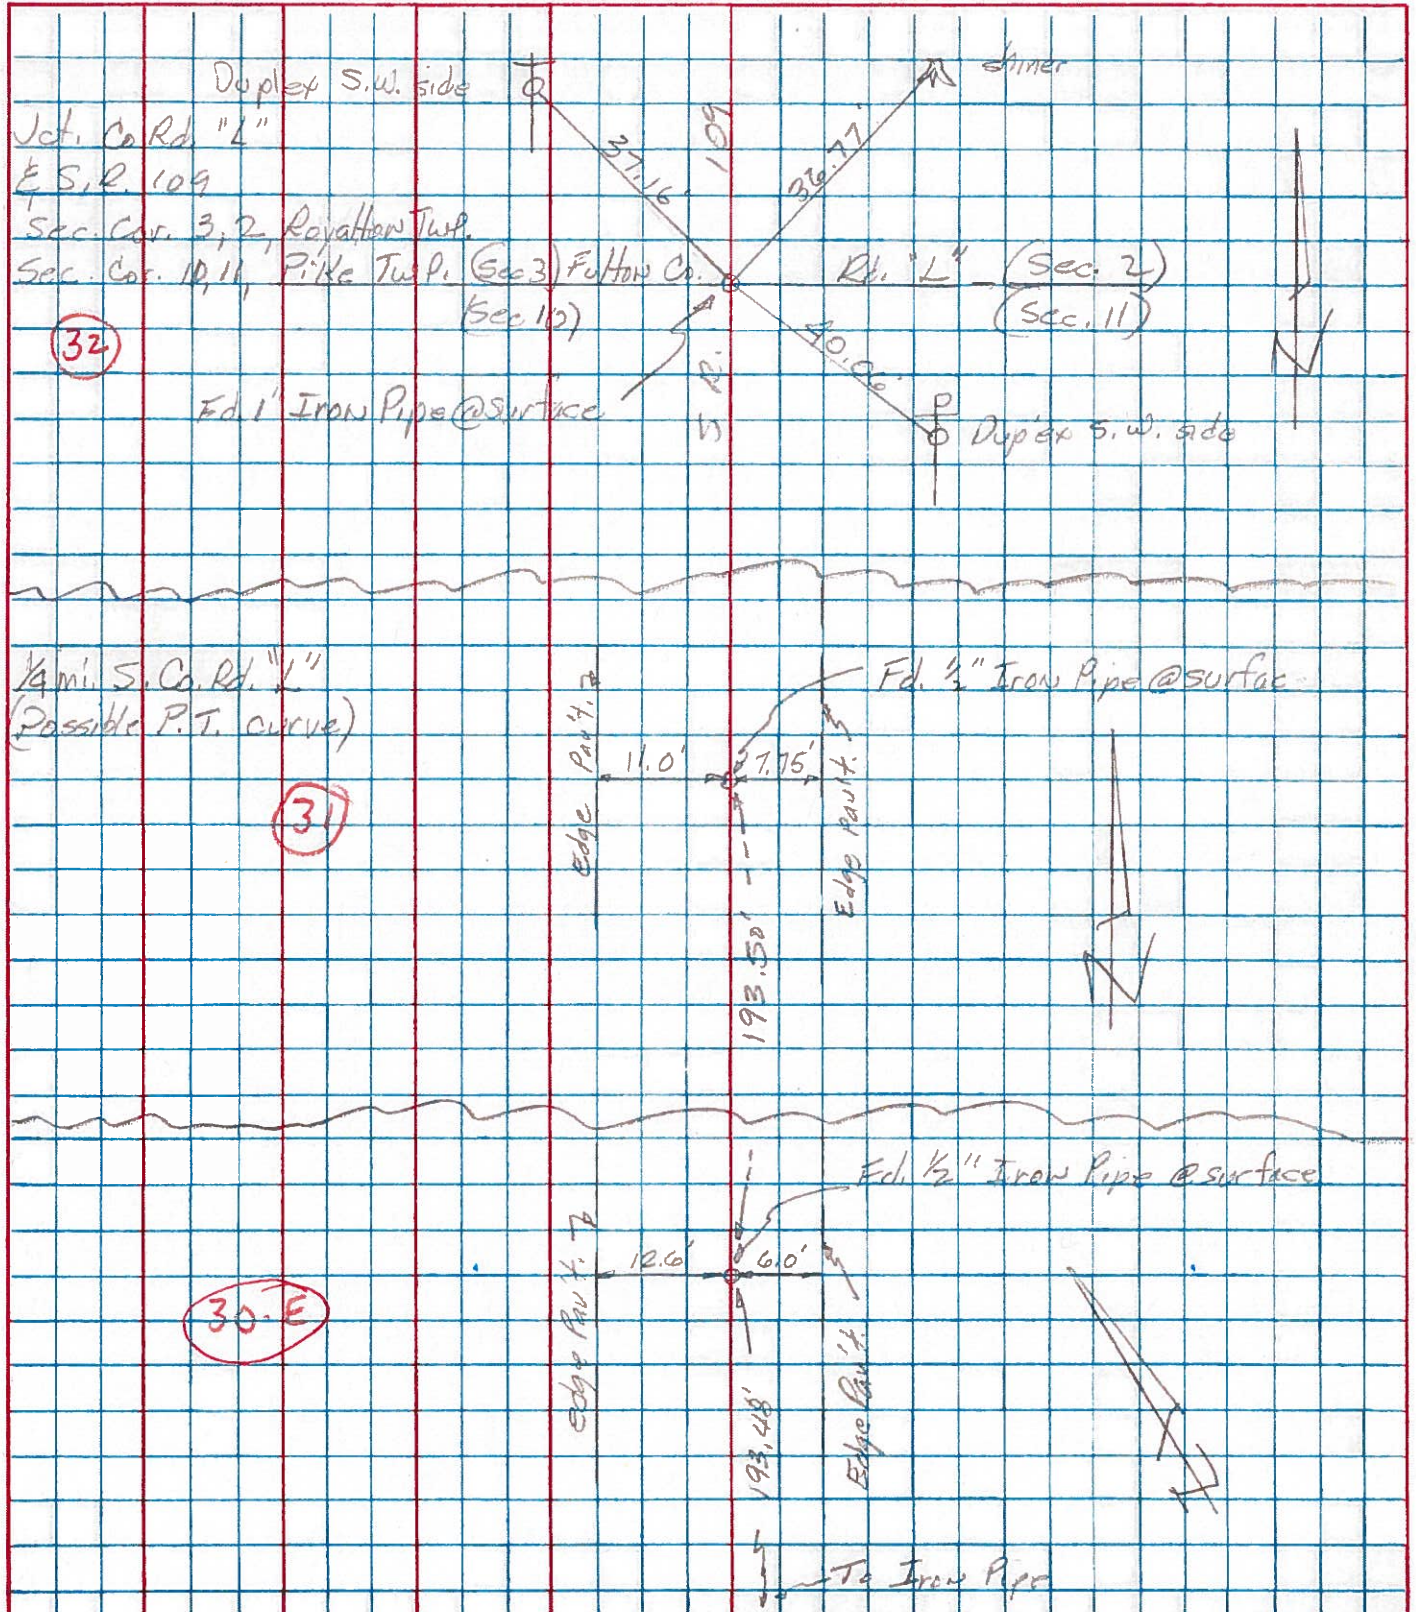

PERSONNEL	TITLE	PERSONNEL	TITLE
Red Beach			
Newcomb			
Knappe			
Wise			

COUNTY FULTON DATE Nov. 1970
S. R. 109 WEATHER _____
SEC. PIKE TWP. TEMP. _____

DESCRIPTION

CONTROL POINTS

JOB NO

