

O.D.O.T. DISTRICT 2 SURVEY OFFICE (USE ONLY)

PERSONNEL

REFERENCE NO. 33

SHEET 21 OF 35

NOTES RHOADES

DATE 4/26/21

ROUTE SR 109

H.C. O'DONNELL

WEATHER CLOUDY

COUNTY FULTON

R.C. NIESE

TEMP. 45°

TOWNSHIP PIKE

DWG BY NIESE

PID PAVE TRAIN

SECTION 2

T 10 S R 3 E

TYPE MONUMENT MAG/WASHER

ON SURFACE - ~~BELOW~~ ON

OFFSET Q PAVEMENT 0.5' LT : ~~RT~~

10.0' TO LT EDGE PAVEMENT


STATION: 653+68.61

HORZ.DATUM: NAD83(2011)

GEOID: 2018

GRID: NORTHING: 720658.909

EASTING: 1548979.941

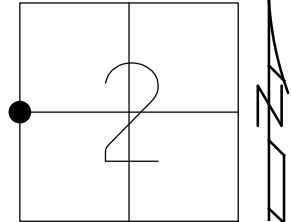

RECORD:
SET P.K./WASHER
11/22/96, MRC
FD P.K./WASHER
6/18/12, SH
SET MAG/WASHER
2/28/13, MC
FD MAG/WASHER
3/7/13, MC
FD MAG/WASHER
REF33
4/26/21, JFO
8/26/21, JFO

FD SHI
4" WOOD
POST

23.03'

Q SR 109

135.57'

SET
SHI

27.80'

SCREW HOLE
FOR WELL CASING

88.25'

FD
SHI

O.D.O.T. DISTRICT 2 SURVEY OFFICE (USE ONLY)

PERSONNEL

REFERENCE NO. 33

SHEET 22 OF 35

NOTES HUSS

DATE 06-18-12

ROUTE SR 109

H.C. HUSS

WEATHER FAIR/WARM

COUNTY FULTON

R.C. CANTERBURY

TEMP. 85°

TOWNSHIP PIKE

HARBAUGH

SECTION 2

DREW

T 10 S R 3 E

TYPE MONUMENT PK/WASHER


ON SURFACE - BELOW ON

LEFT - Q PAV'T - RIGHT 0.5'

10.0' TO LT EDGE PAVEMENT


S.L.M. 655+83

Grid: Northing: 720658.919 Easting: 1548979.891

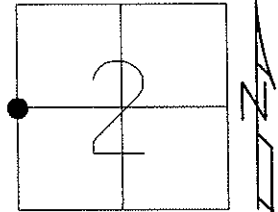

11-22-96 SET PK/WASHER
IN LEVELING COURSE, MRC
02-28-13 SET MAG/WASHER, MC

06-14-12 GPS REF33
03-07-13 GPS FIN 33, MC

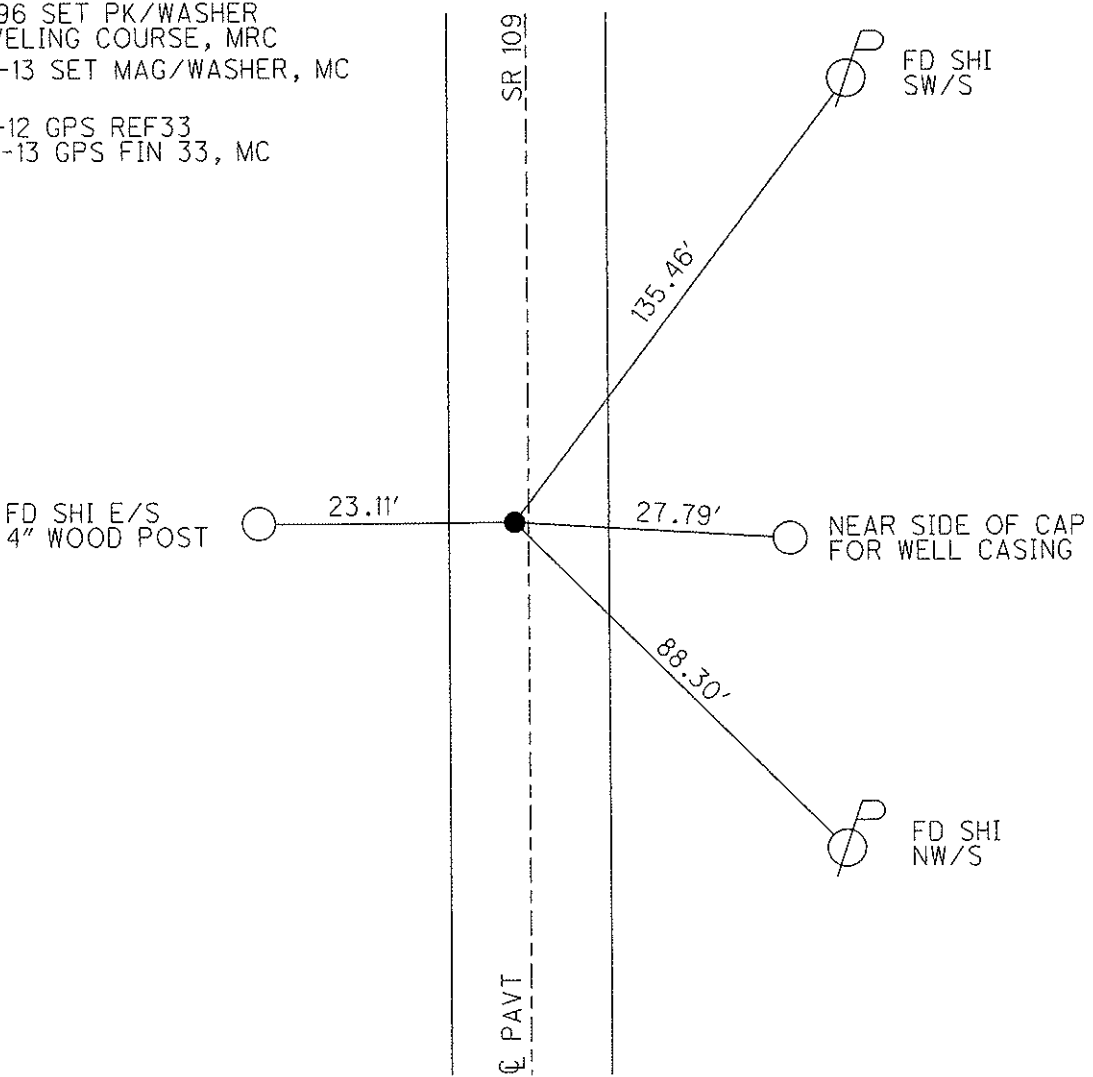

O.D.O.T. DISTRICT 2 SURVEY OFFICE

PERSONNEL

REFERENCE NO. 33

SHEET 18 OF 28

NOTES CANTERBURY

H.C. LOEHRKE

R.C. CANTERBURY

DATE 8-26-96

WEATHER FAIR

TEMP. +85°

ROUTE S.R. 109

COUNTY FULTON

TOWNSHIP PIKE

SECTION 2

T10 S R 3 E

Reset 9-29-97

TYPE MONUMENT PK/WASHER


C.L.

ON SURFACE - BELOW YES

LEFT- & PAV'T. - RIGHT 0.10 LT &


2.84 TO LT EDGE PAVEMENT

S.L.M. 19+919.20 (655+83)

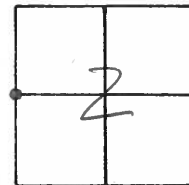

SET P.K./WASHER IN LEVELING COURSE

11/22/96. MRC.

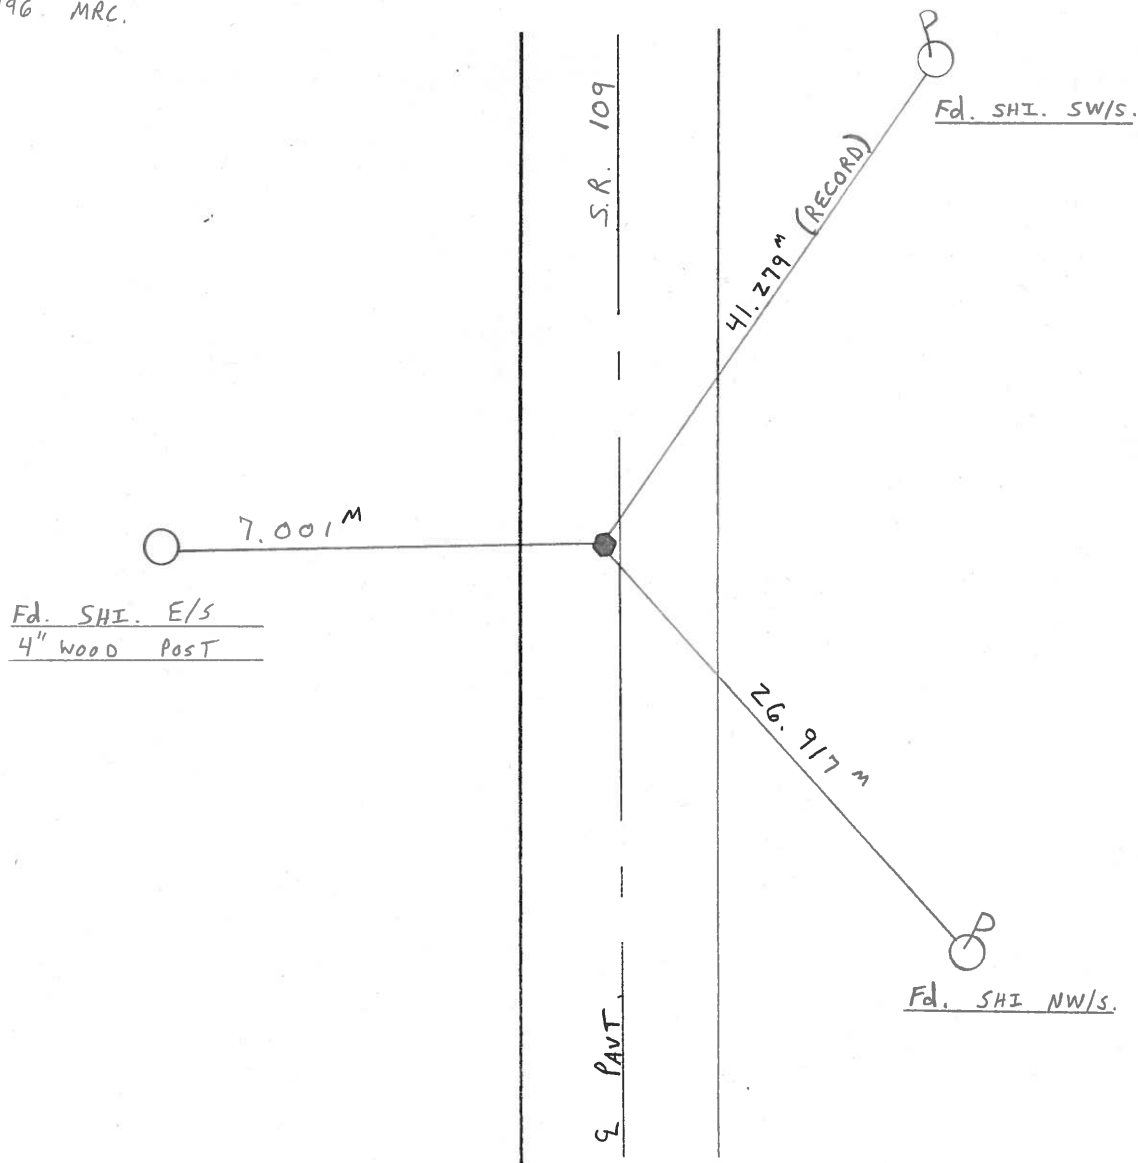

ROAD 10" BETWEEN FORE & HILL TOWNSHIP

53

PERSONNEL

TITLE

SEC. 3, 4

T-10-S

R-3-E

STANLEY

CORNER 1/4 CORNER TWP. PIKE


EAST WIND 8-10

DATE 4-21-94

WEATHER SUNNY @ 55° AM

DESCRIPTION: REFERENCED EXISTING 1/2" I. PIPE AT PAVEMENT SURFACE. PIPE WAS ESTABLISHED BY D. SCHROEDER 1-24-75 ON LINE & MEDWAY BETWEEN SECTION CORNERS. CORNER WAS SEARCHED FOR WITH ROAD GRADER AND NOT RECOVERED. SET RR SPOT WITH "X" OUT AFTER RESURFACING 11-4-94 CS.

NOTE: ALL CONCRETE
REFERENCE MONUMENTS
SET IN 1983 ARE NOW
GONE OR DESTROYED

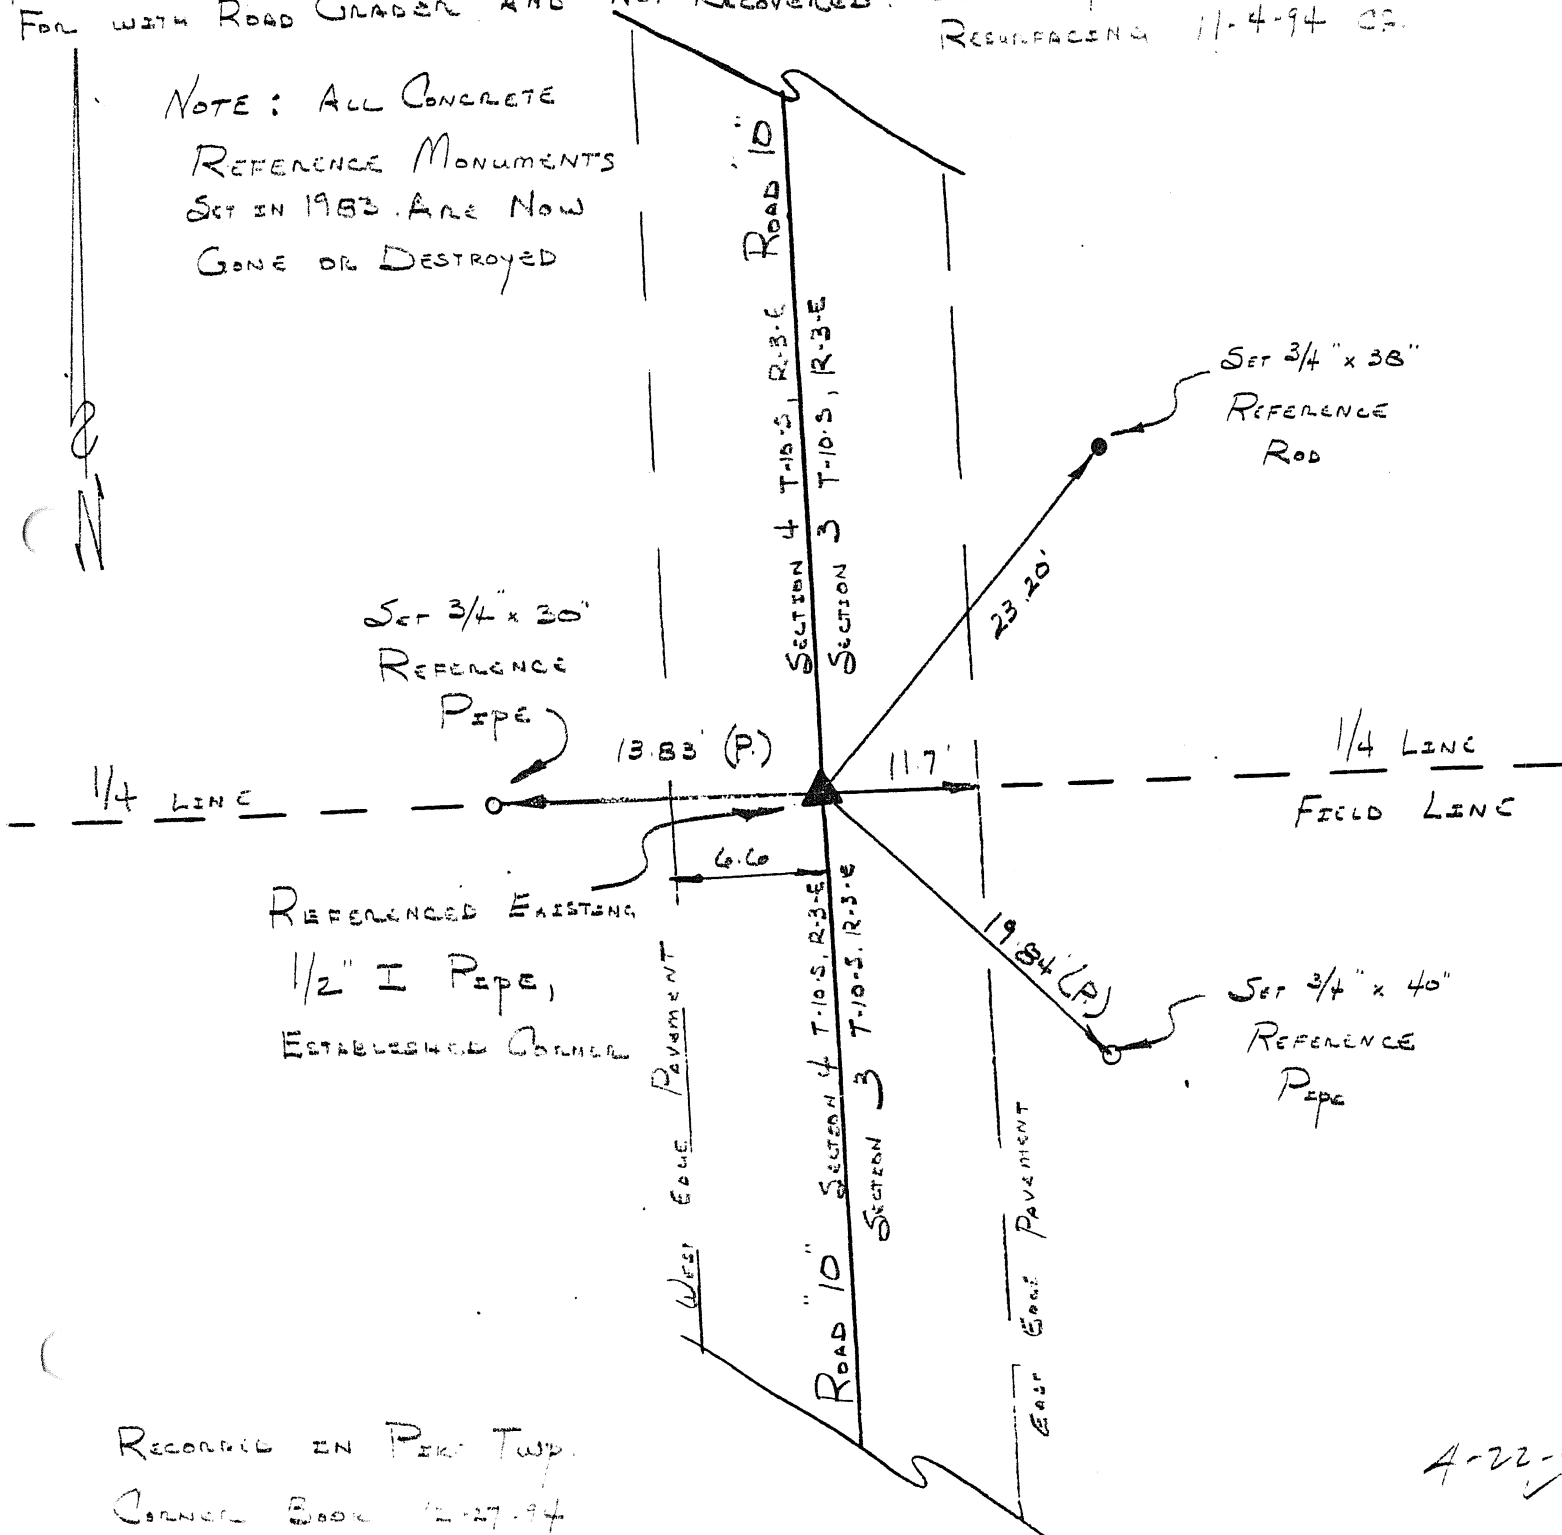

RECORDED IN PIKE TWP.
CORNER BOOK 12-27-94

4-22-94

O.D.O.T. DISTRICT 2 SURVEY OFFICE

PERSONNEL

REFERENCE NO. 33

SHEET OF

NOTES BAENHISEL

H.C. " "

R.C. HOFFMAN

DATE 9-4-90

WEATHER Clear

TEMP. +80°

ROUTE 109

COUNTY Fulton

TOWNSHIP Pike

SECTION 2

T10 S R 3 E



TYPE MONUMENT Sm RE Spk

ON SURFACE - BELOW yes

LEFT- E PAV'T. - RIGHT 0.8

9.4 TO LT EDGE PAVEMENT

S.L.M. 655+83

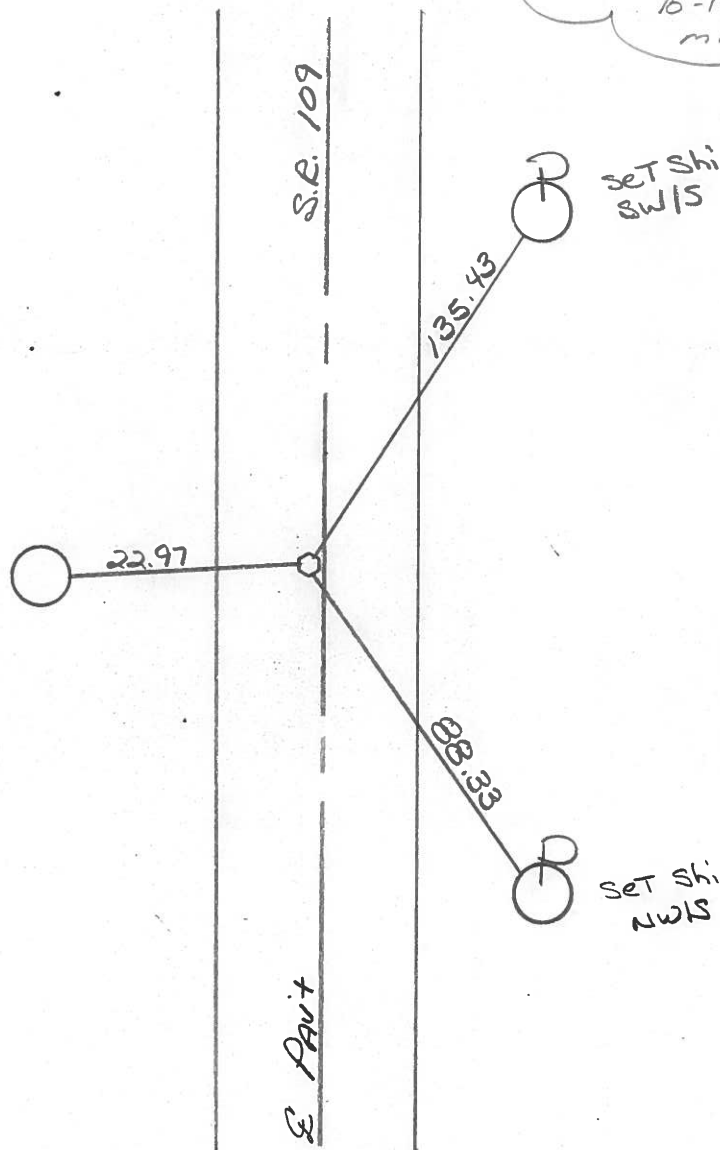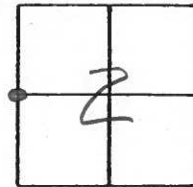


ROAD "8" BETWEEN RD "L" AND RD "M"

57

PERSONNEL	TITLE	SEC.	T-	R-
STANLEY		1, 2	10-S	3-E
BROOKS		CORNER 1/4 CORNER	TWP. PIKE	
BRINKER		DATE 6-8-89	WEATHER SUNNY @ 85° PM HUMID	

DESCRIPTION: REFERENCED EXISTING HARROW TOOTH OVER PAINTED STONE. EXISTING STONE 22" BELOW P.V.M.T. STONE RECOVERED 11-5-82 BY C. STANLEY. FR. PK NAILS 3' N. & E.

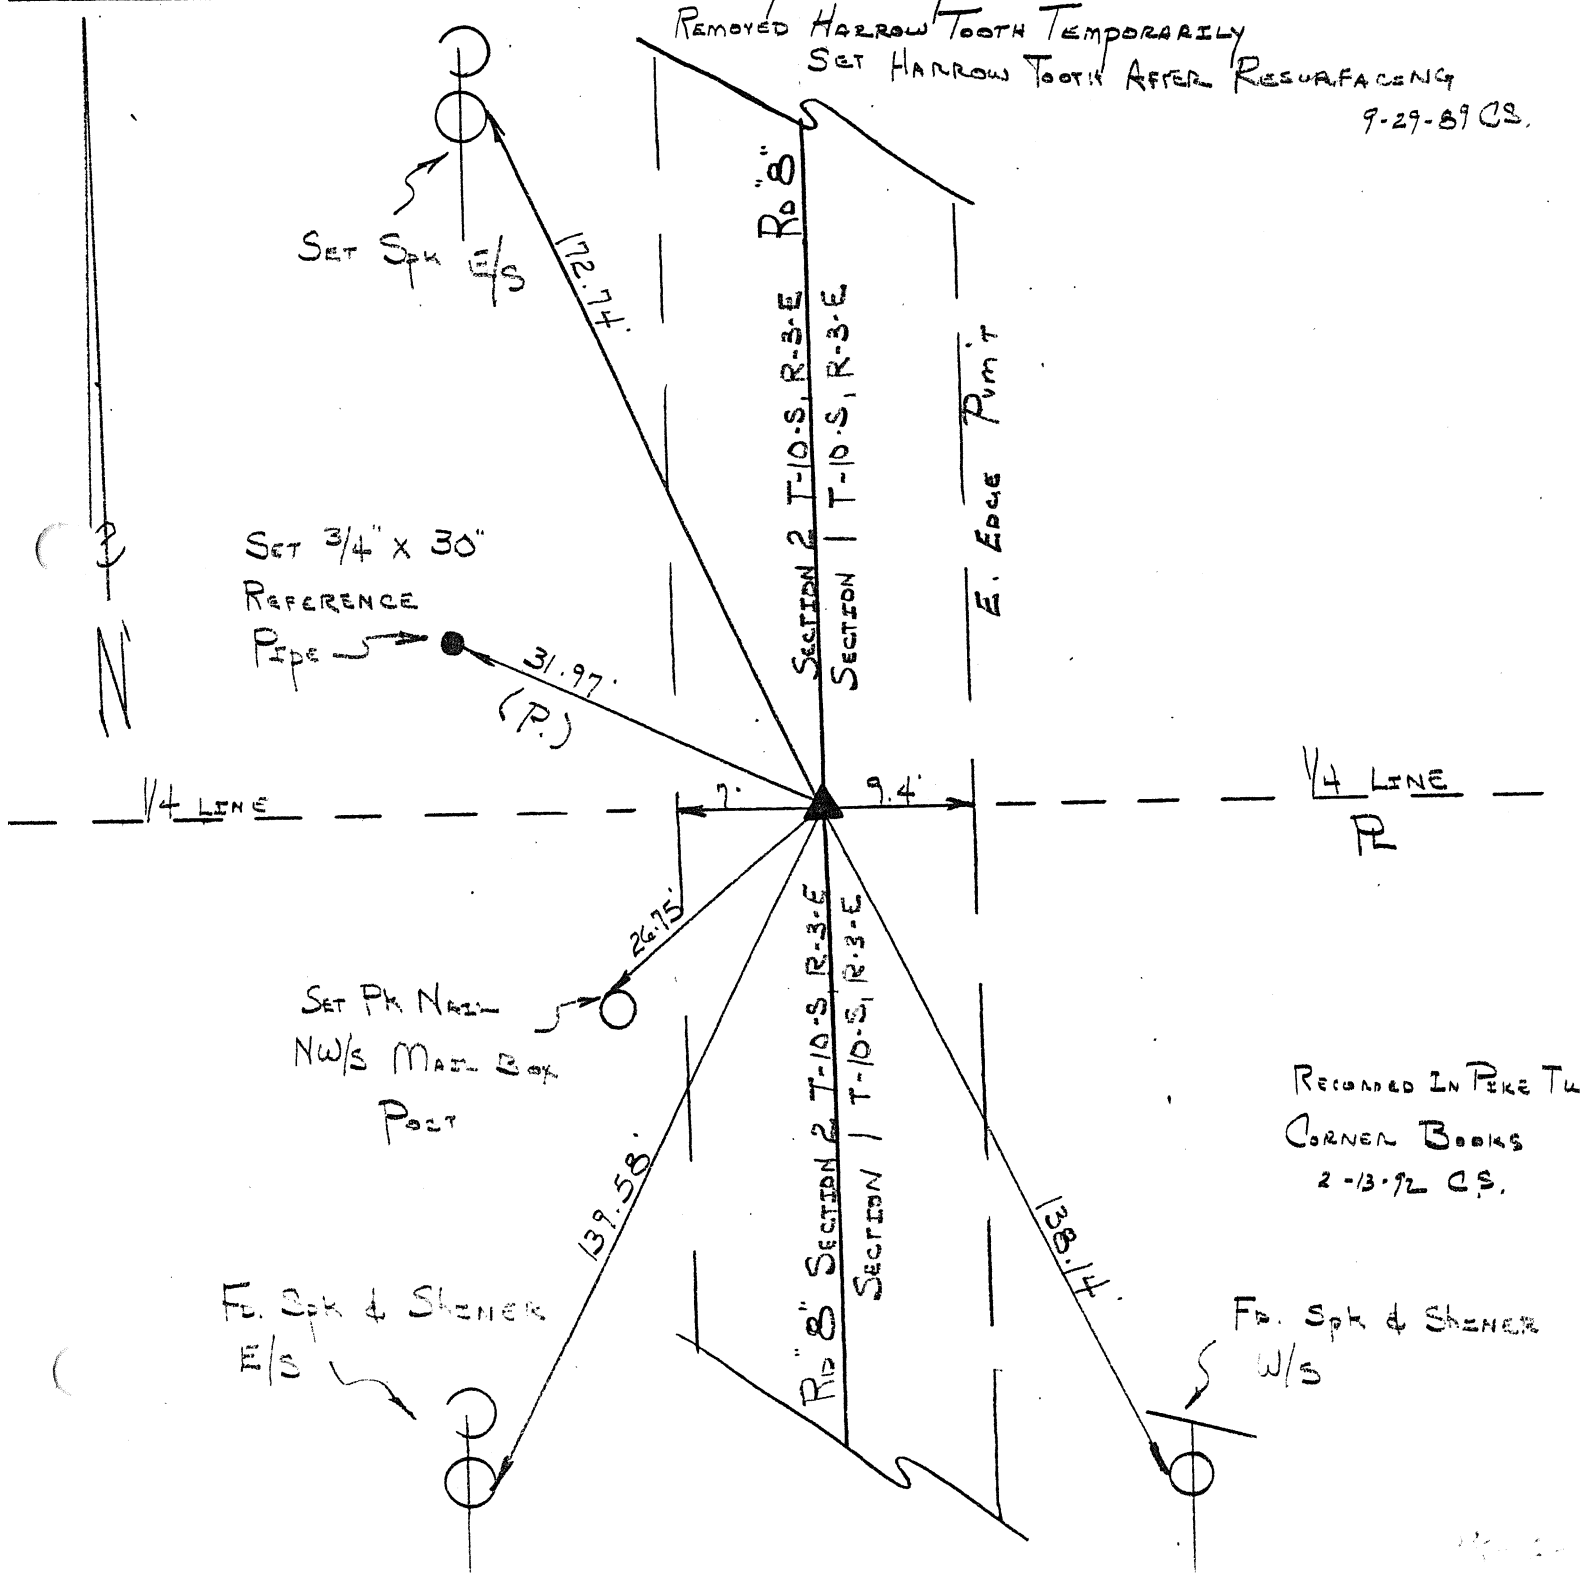

Q.D.O.T. DISTRICT 2 SURVEY OFFICE

SHEET 15 OF

County Fulton S.R. 109

Township Pike

Section 2-3

T N, R E

Personnel I. Stone

P. Neusser


R. Michalski

D. Curtis

Date 12 April 84

Weather Sunny

Temp. 49°

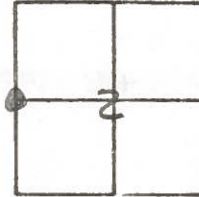

REF. NO. 33



duplex N/S
A.P.

23.25'

#109

35.94'

35.08'

Hub & Tack

duplex
S/S

Fd. 1" I. pipe 2" deep
Set Small Spt. 6/21/84
9.7' to E. edge put
8.5' to W. edge put

E SR

Q.D.O.T. DISTRICT 2 SURVEY OFFICE

SHEET 15 OF

County Fulton S.R. 109

Date 12 April 84

Township Pike

Weather Sunny

Section 2-3

Temp. 49°


T N, R E

Personnel 1. Stone

P. Neuser

R. Michalske

D. Curtis

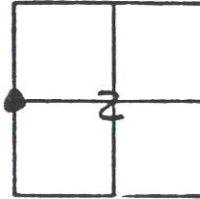

REF. NO. 33



duplex N/S
A.P.

23.25'
22.97'

#109

E 5K

30.26'

35.94'

35.08'

135.43'

88.33'

Hub & Tack

duplex
S/S

4/15

Sm RR Spr
655+83.
0.8 LT &
9.4 TO LT Edge

Set

Fd. 1" I. pipe 2" deep
Set Small Spr. 6/21/84
9.7' to E. edge put
8.5' to W. edge put

PERSONNEL TITLE PERSONNEL TITLE

Red Beach

COUNTY FultonDATE 22-23 Feb. '77

W. Knappe

S. R. 109

WEATHER

SEC. PIKE TWP

TEMP

DESCRIPTION

CONTROL POINTS

JOB NO.

LEFT

CENTER LINE

RIGHT

(33)

Found PK offsets 6' West & North

qtr. Line 2

Dup N/S
AP

23.28'

PI Sta. 653+55.56
 $\Delta = 0^\circ 06.7' \text{ Lt.}$

33.87'

Dup N/S
AP

qtr. Line 2

Found 1" pipe qtr. corner
set in 1970

27.18'

35.07'

" + " SW cor. 4" conc.
cistern cover

Dup SW/S

S.R. 109
Sec. 3
Sec. 2

(32)

Dup.
NE/SSE Cor
West parapet
#1-2 CB

37.28'

38.21'

Co. Rd. "L" old S.R. 2467
Sec. LineFound 1" pipe (set 1970)
over cor. stone.

89.0'

66.93'

HARTSELL'S
HOUSEPK w/shing
NE/S 16" mapleS.R. 109
Sec. 3
Sec. 2shiner SW/S
old cor postSW Cor
East parapet
#1-2 CBFound 1970 PK offsets
6' N & ECo. Rd. "L" old S.R. 2467
Sec. LinePI Sta. 627+02.02
 $\Delta = 0^\circ 03.6' \text{ Rt.}$

Dup SW/S

PERSONNEL	TITLE	PERSONNEL	TITLE	COUNTY	DATE	WEATHER	TEMP.
Tomasic				Fulton	July 19, 1973		
Granata				S. R. 109			
Vandy				SEC. Royalton TWP.			
Boyle							


DESCRIPTION

LEFT

CENTER LINE

RIGHT


JOB NO.

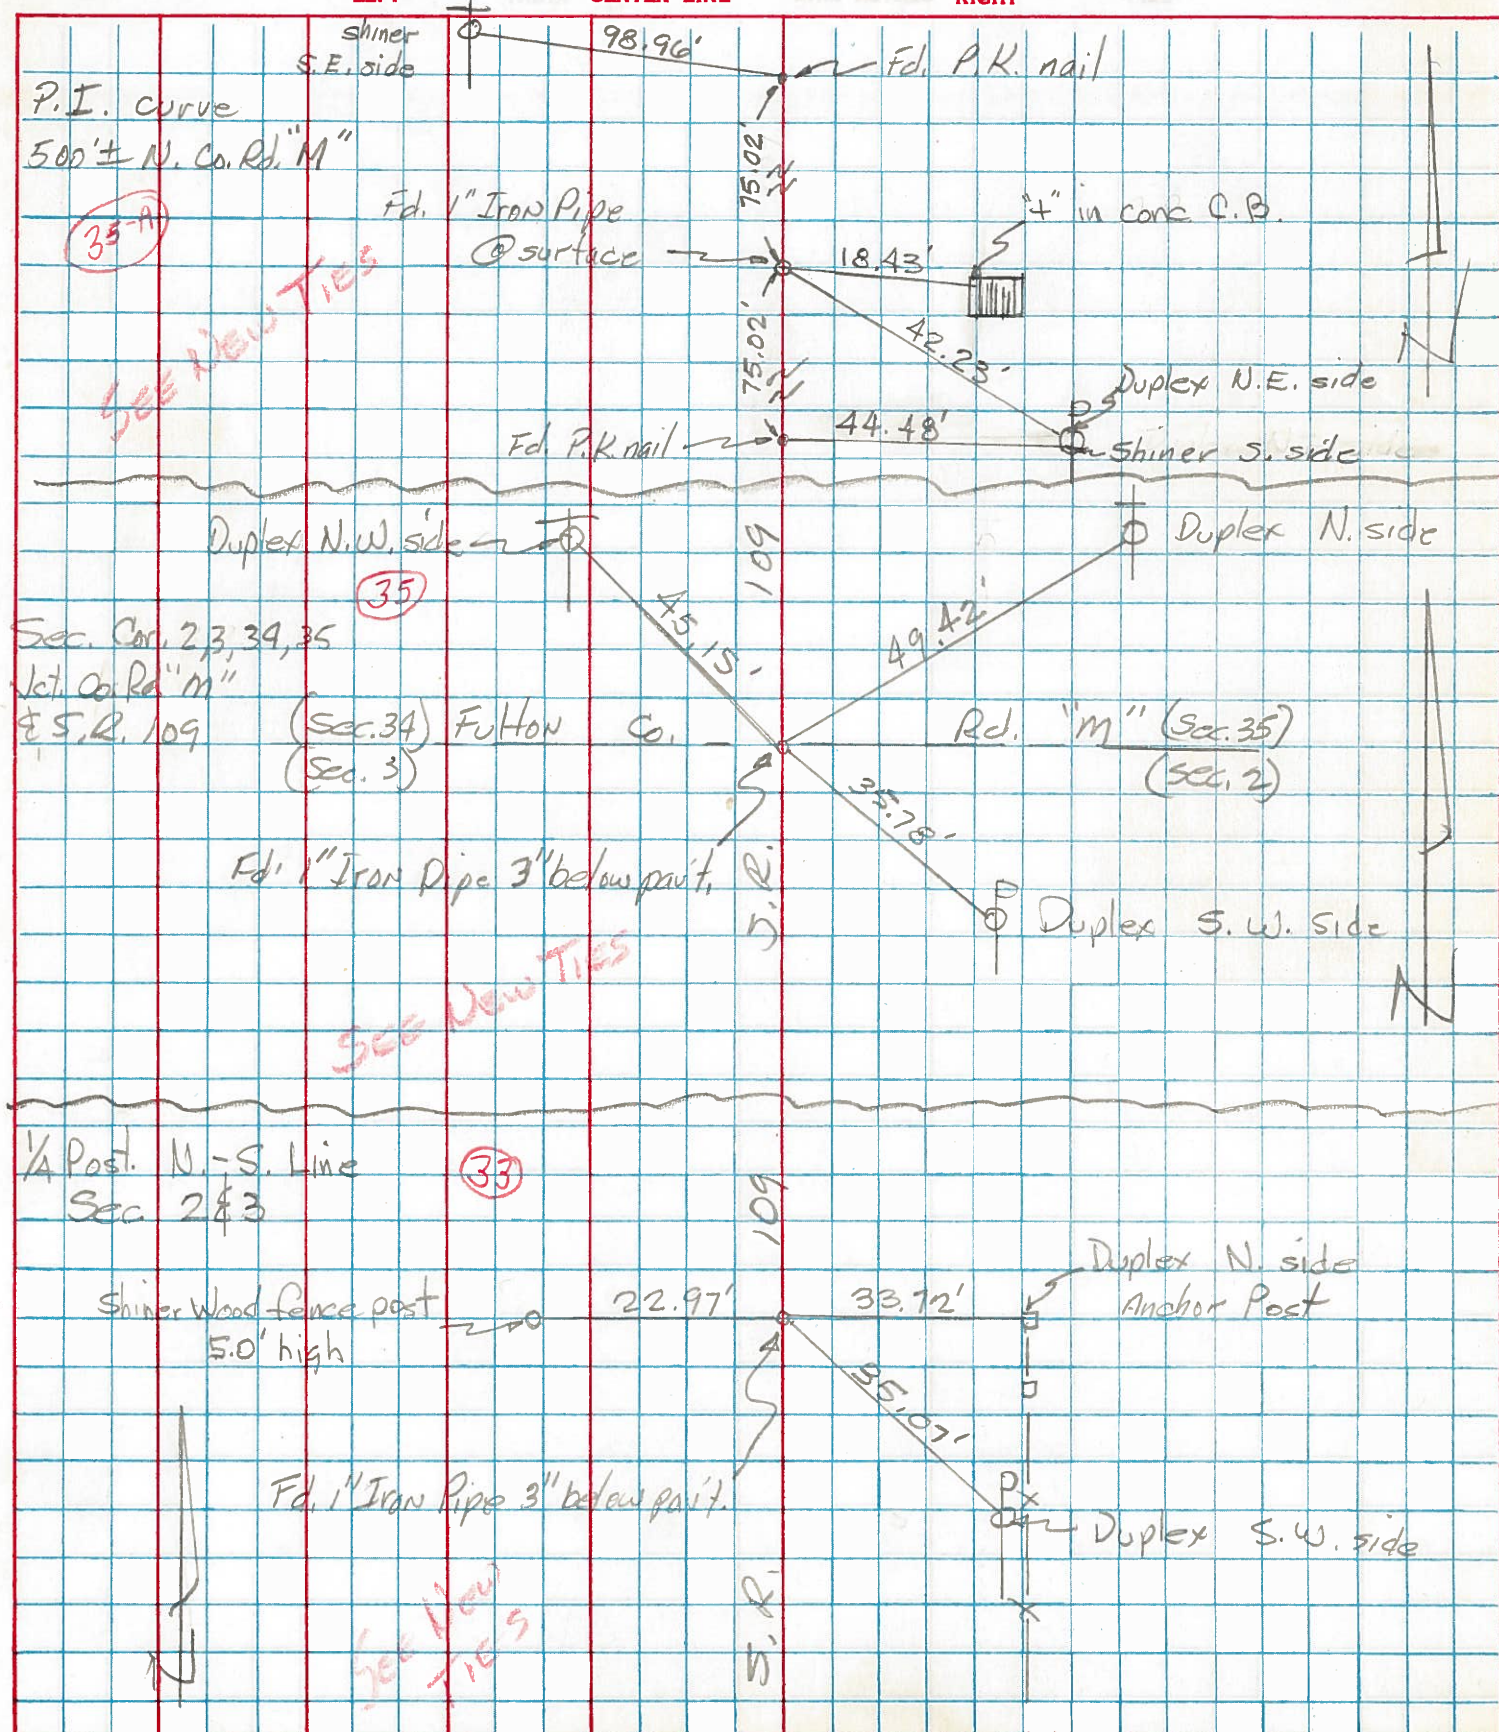

PERSONNEL	TITLE	PERSONNEL	TITLE
Red Beach			
Newcomb			
Knappe			
Wise			

COUNTY FULTON DATE Nov 1970
S. R. 109 WEATHER _____
SEC. PIKE TWP. TEMP. _____


DESCRIPTION	CONTROL POINTS	JOB NO
-------------	----------------	--------

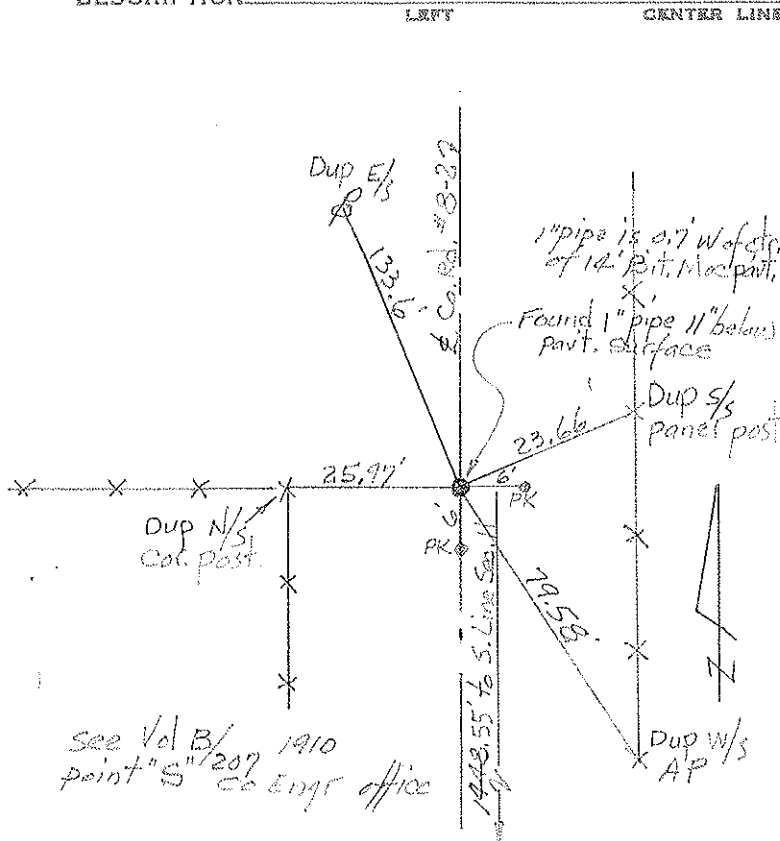

W 1/4 Post, Sec. 2, Pike Twp. T-10-S
E 1/4 Post, Sec. 3, Pike Twp. T-10-S



Made diligent & extensive search for this recorded 1/4 post stone. Both old witness trees gone.

Found very old
wood stake (12" ±)
approx 12" below
 Pavt. Surface.
Stake was in
a vertical position
and surrounded with
brick — accepted same. V.
could not find stone. $\frac{1}{4}$ past 15 is 0.3' West
of ctr. of 18' Bit. Mac. Pavt.

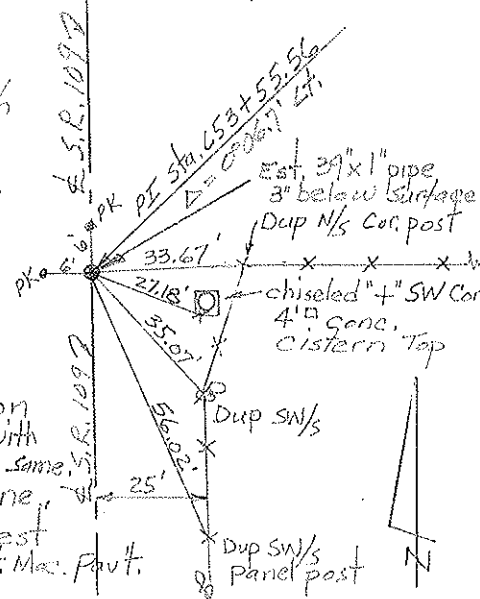

5 1/4 post, Sec. 34 T-9-5
N 1/4 post, Sec. 3 T-10-5

Cor. Sec. 2 & 3 T-10-S Pike Twp.
Cor. Sec. 34 & 35 T-9-S Pike Twp.

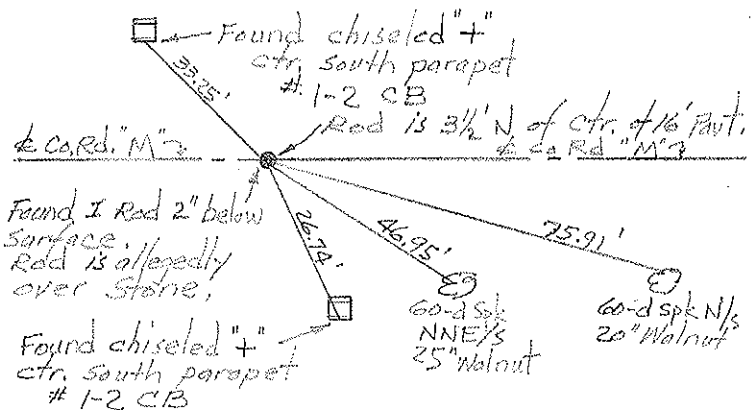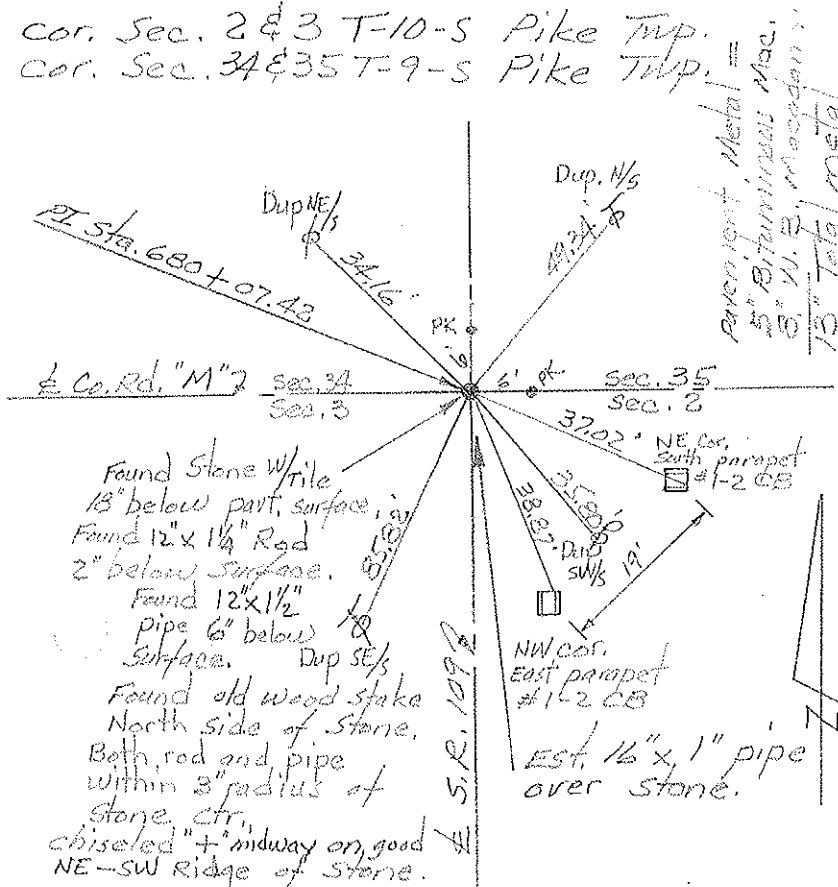

S $\frac{1}{4}$ Post Sec. 35 T-9-S
N $\frac{1}{4}$ Post Sec. 2 T-10-S

