

O.D.O.T. DISTRICT 2 SURVEY OFFICE (USE ONLY)

PERSONNEL

REFERENCE NO. 35

SHEET 23 OF 35

NOTES HUSS

DATE 06-18-12

ROUTE SR 109

H.C. HUSS

WEATHER FAIR/WARM

COUNTY FULTON

R.C. CANTERBURY

TEMP. 82°

TOWNSHIP PIKE

HARBAUGH

SECTION 2

COUTCHER

T 10 S R 3 E

TYPE MONUMENT SHANK


ON SURFACE - BELOW ON

LEFT - Q PAV'T - RIGHT BOTH


- TO - EDGE PAVEMENT

S.L.M. 680+33

Grid: Northing: 723310.663 Easting: 1548972.086

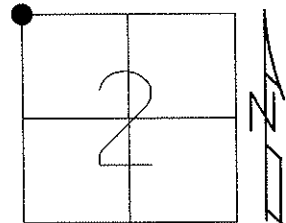

11-22-96 SET PK/WASHER
IN LEVELING COURSE, MRC
06-14-12 FD SHANK
02-28-13 SET MAG/WASHER, MC

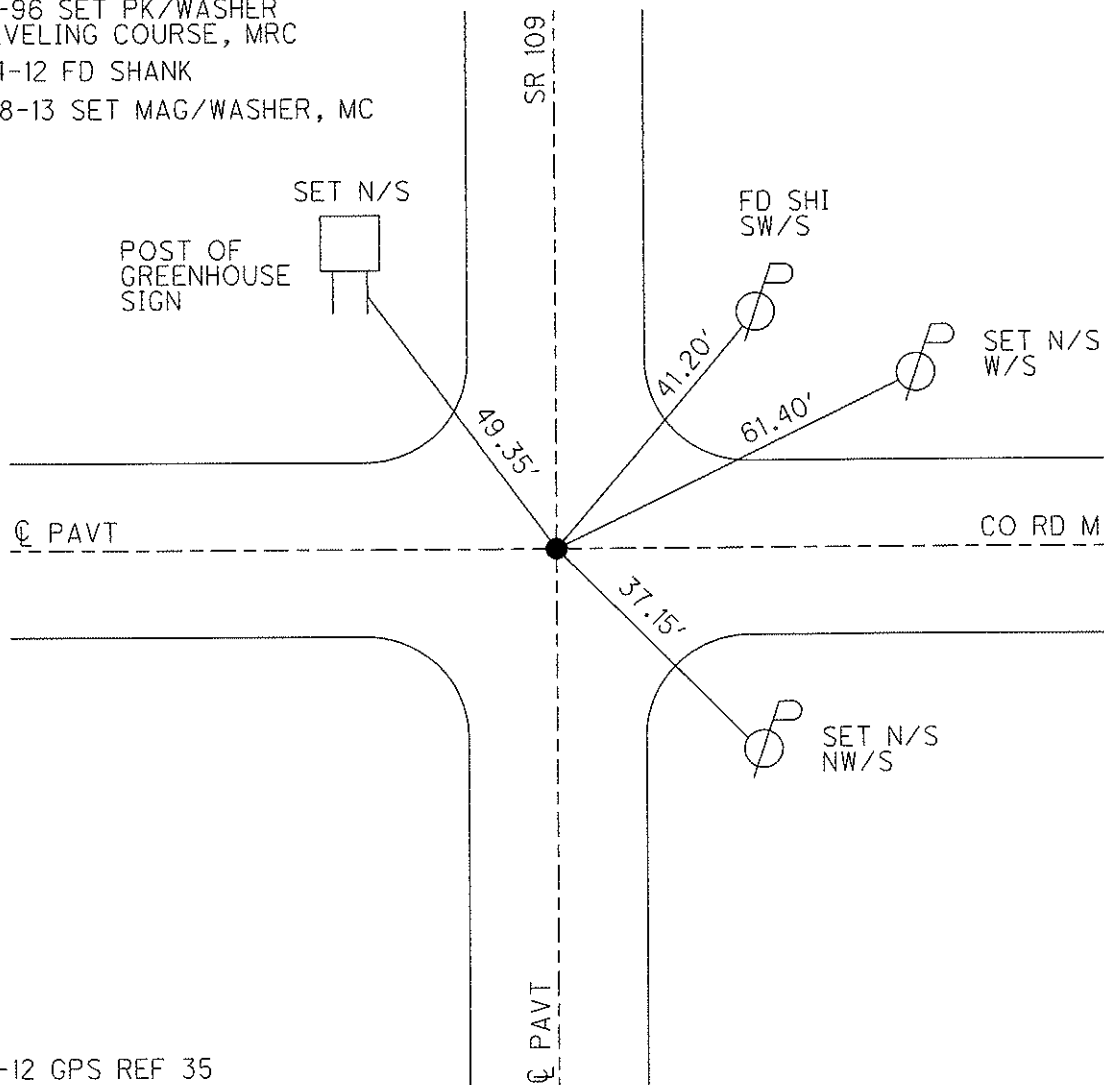

06-14-12 GPS REF 35
03-07-13 GPS FIN 35

O.D.O.T. DISTRICT 2 SURVEY OFFICE

PERSONNEL

REFERENCE NO. 35 SHEET 19 OF 28

NOTES CANTERBURY

H.C. LOEHKE

R.C. CANTERBURY

DATE 8-26-96

WEATHER FAIR

TEMP. +85°

ROUTE S.R. 109

COUNTY FULTON

TOWNSHIP Pike

SECTION 2

T10 S R 3 E

TYPE MONUMENT P.K. WASHER

ON SURFACE - ~~BELOW~~ Yes

LEFT- & PAUT. - RIGHT ON & BOTH

TO EDGE PAVEMENT

S.L.M. 20+718 on & Point east (G80+33)

Reset
9-29-97
C.L.

34	35
3	2




SET P.K./WASHER IN LEVELING
COURSE. 11/22/96. MRL.

Fd. SHI. IN E.
POST OF GREENHOUSE SIGN



Fd. SHI. SW/S.

Fd. SHI. W/S.

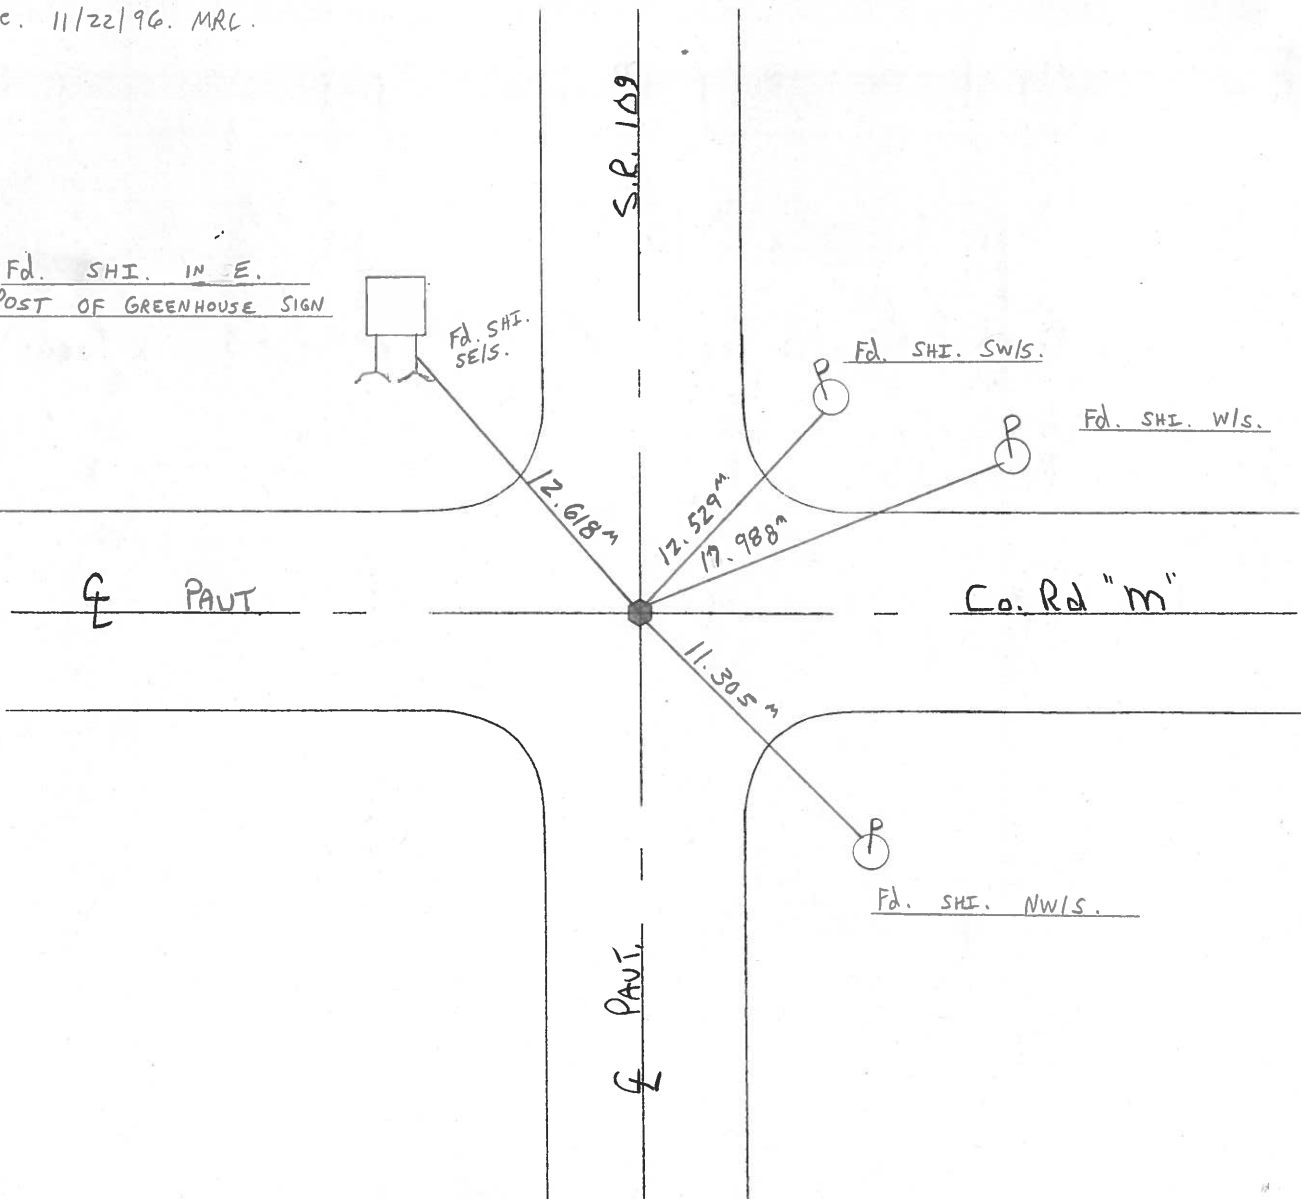

Fd. SHI. NW/S.

O.D.O.T. DISTRICT 2 SURVEY OFFICE

PERSONNEL

REFERENCE NO. 35

SHEET OF

NOTES BAENHISEL

H.C. " "

R.C. HOFFMAN

DATE 9-4-90

WEATHER CLEAR

TEMP. +85°

ROUTE 109

COUNTY Fulton

TOWNSHIP PIKE

SECTION NW Cor. 2

T 10 S R 3 E

TYPE MONUMENT Sm RR Spk


ON SURFACE - BELOW yes

LEFT - & PAV'T. - RIGHT yes

- TO - EDGE PAVEMENT

S.L.M. 680 + 33 ON & Pav't EAST

34	35	T 10 S R 3 E
3	2	

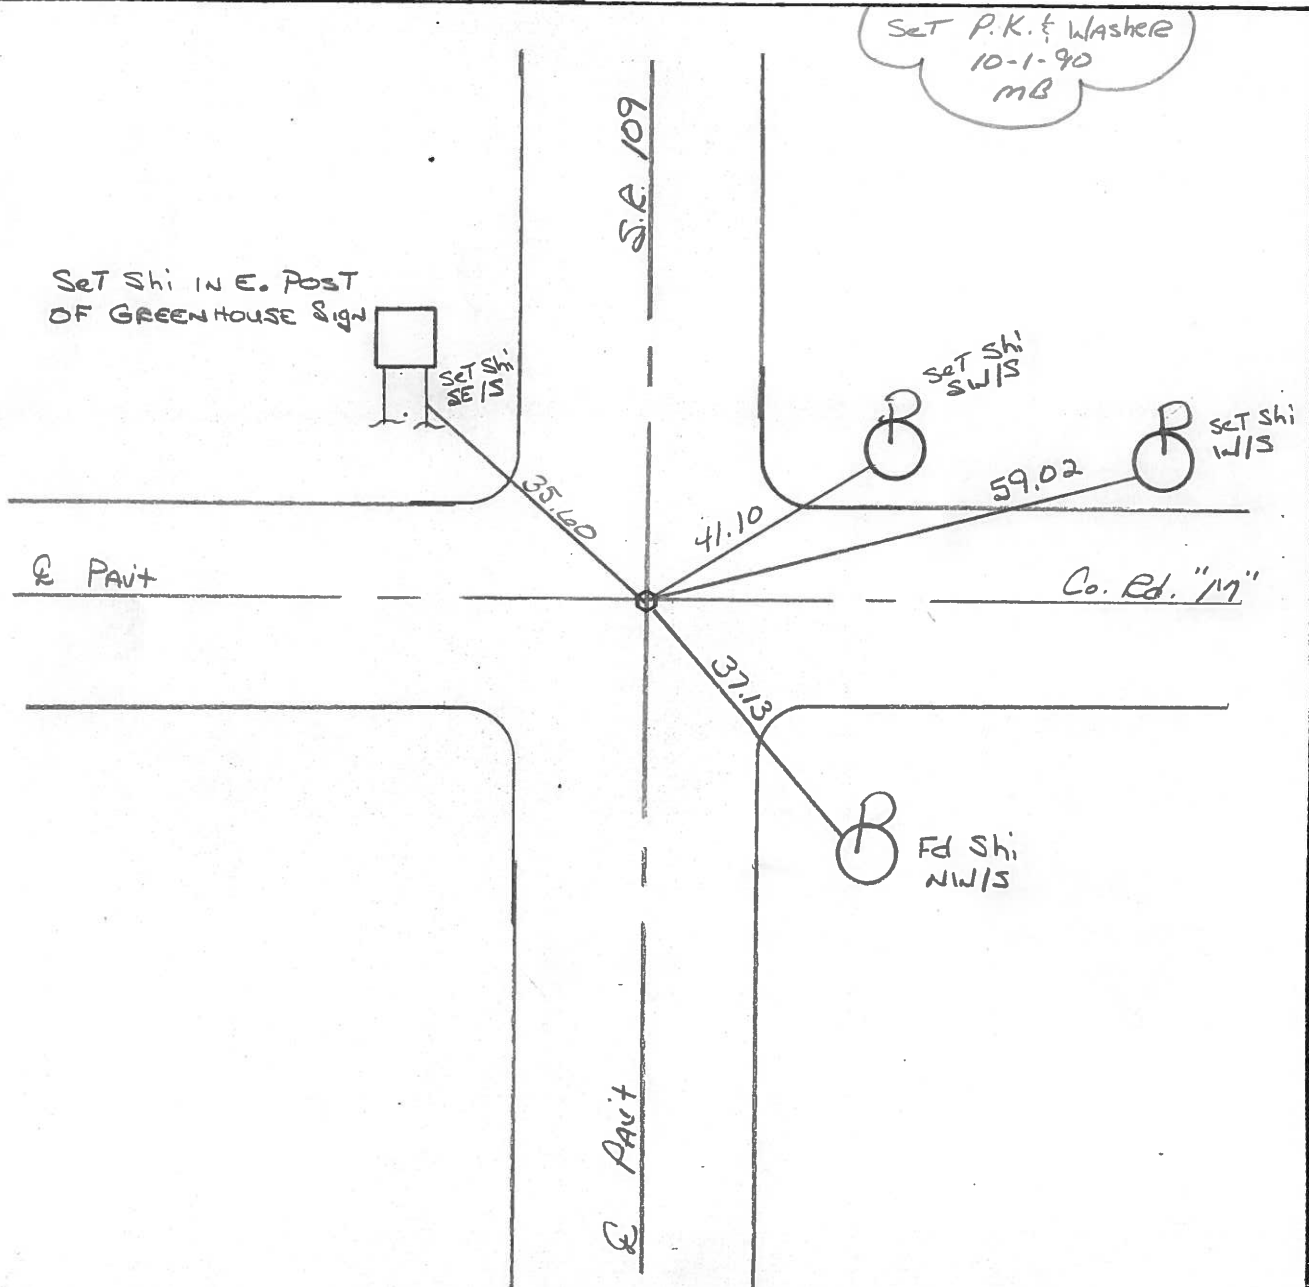


County Eulton S.R. 109Township PikeSection 2-3-34-35T N, R EPersonnel J. StoneP. NeuserR. MichalskeD. CurtisDate 12 April 84Weather SunnyTemp. 49°

34	35
3	2



REF. NO. 35

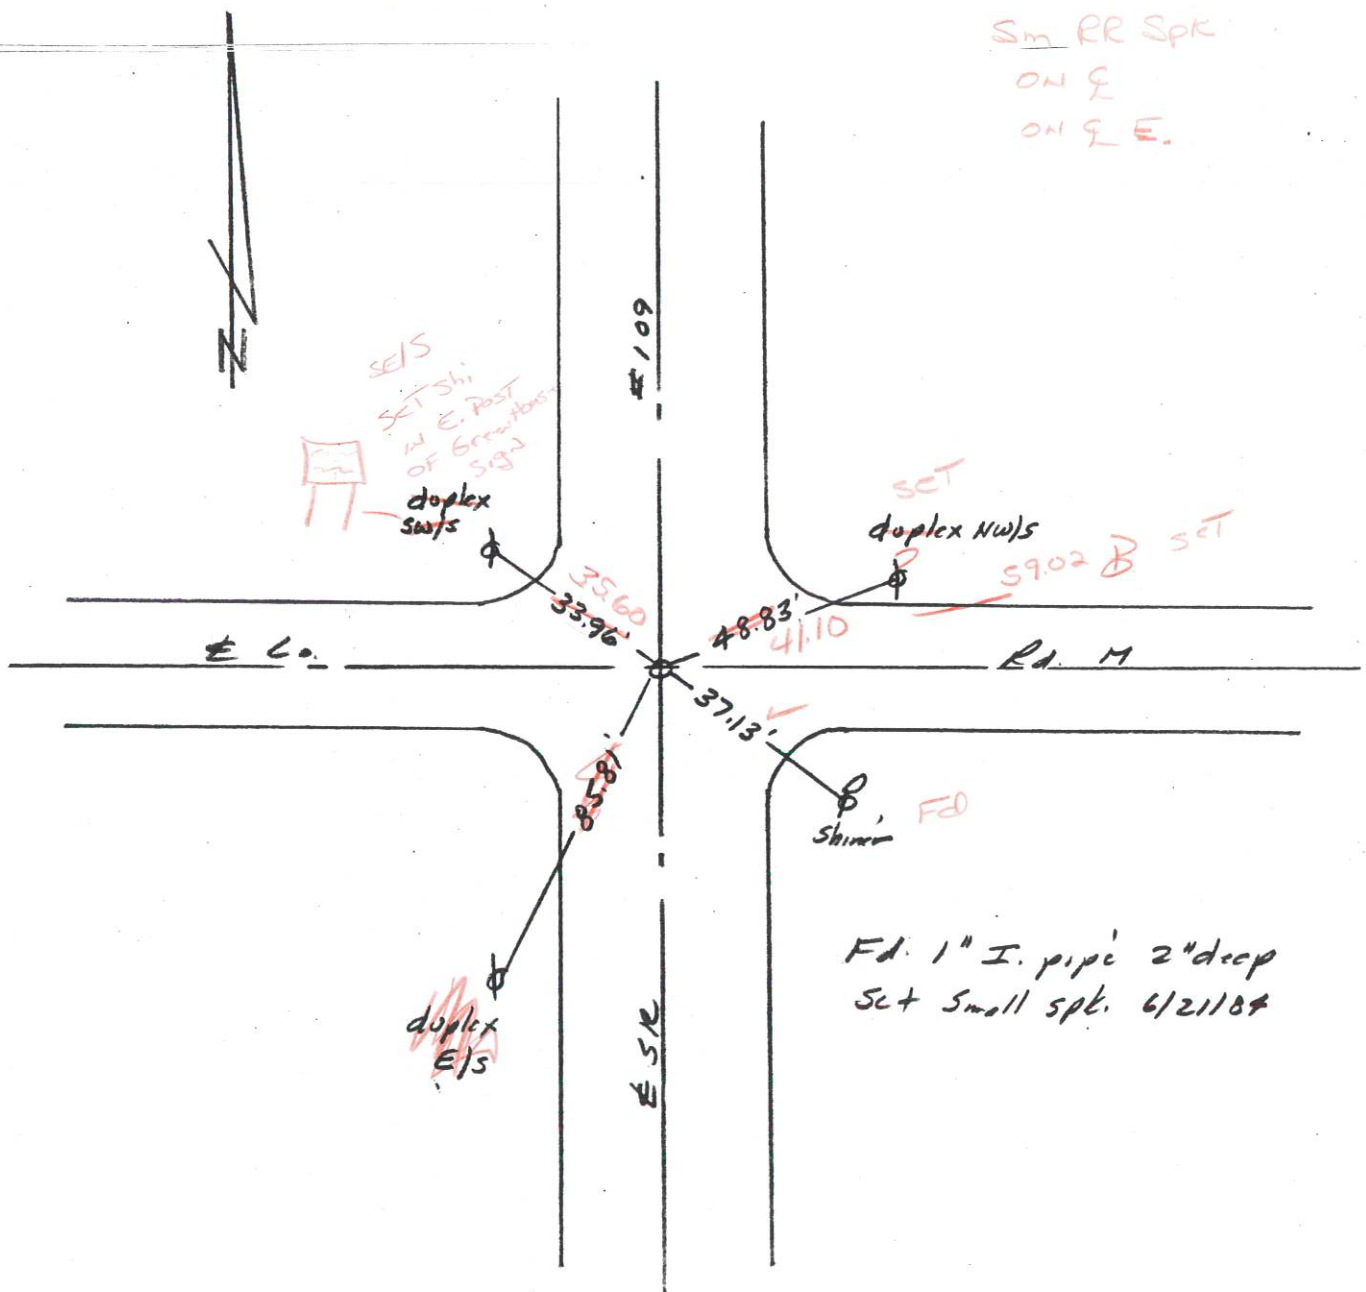

Q.D.O.T. DISTRICT 2 SURVEY OFFICE

SHEET 16 OF

County Fulton S.R. 109

Township Pike

Section 2-3-34-35

T N, R E

Personnel J. Stone

P. Heuser

R. Michalke

D. Curtis

Date 12 April 84


Weather Sunny

Temp. 49°

34	35
3	2




REF. NO. 35

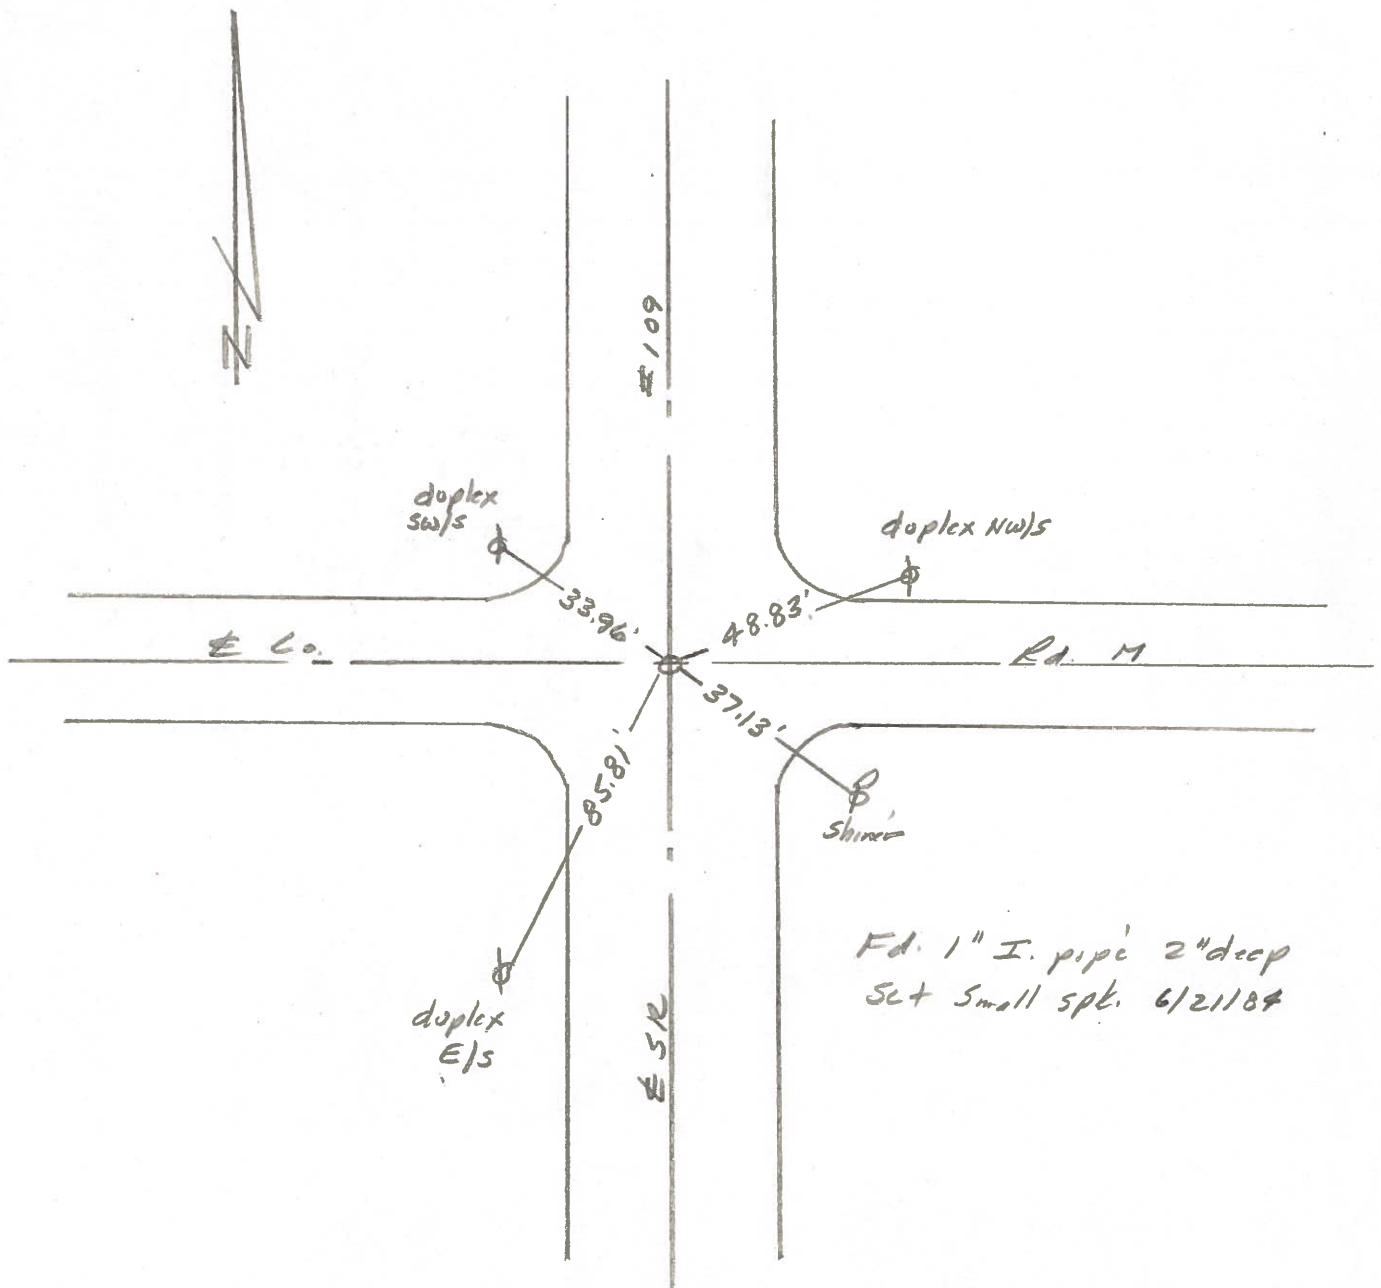


PERSONNEL	TITLE	PERSONNEL	TITLE	COUNTY	DATE	WEATHER
Red Beach				Fulton	23 Feb '77	
W. Knappe				S. R. 109		
				SEC. Pike Twp		
DESCRIPTION				JOB NO.		

(35-A)

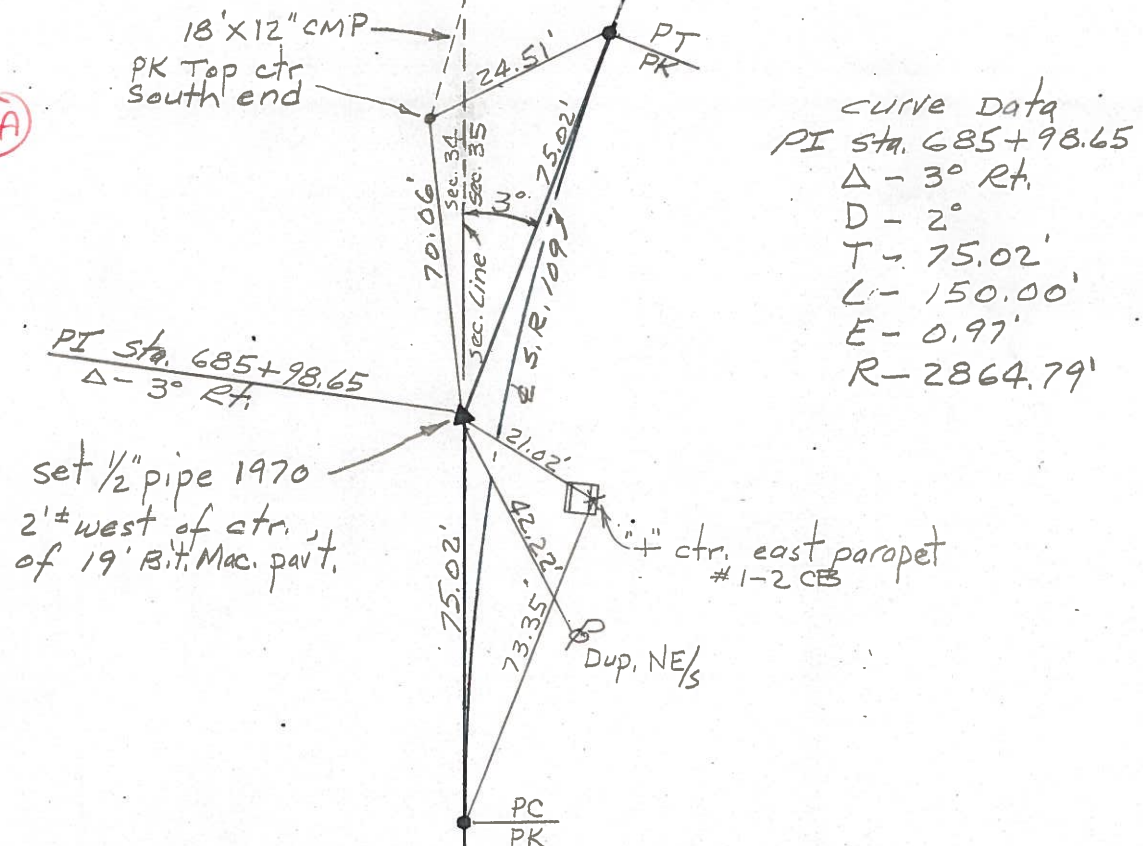

(35)

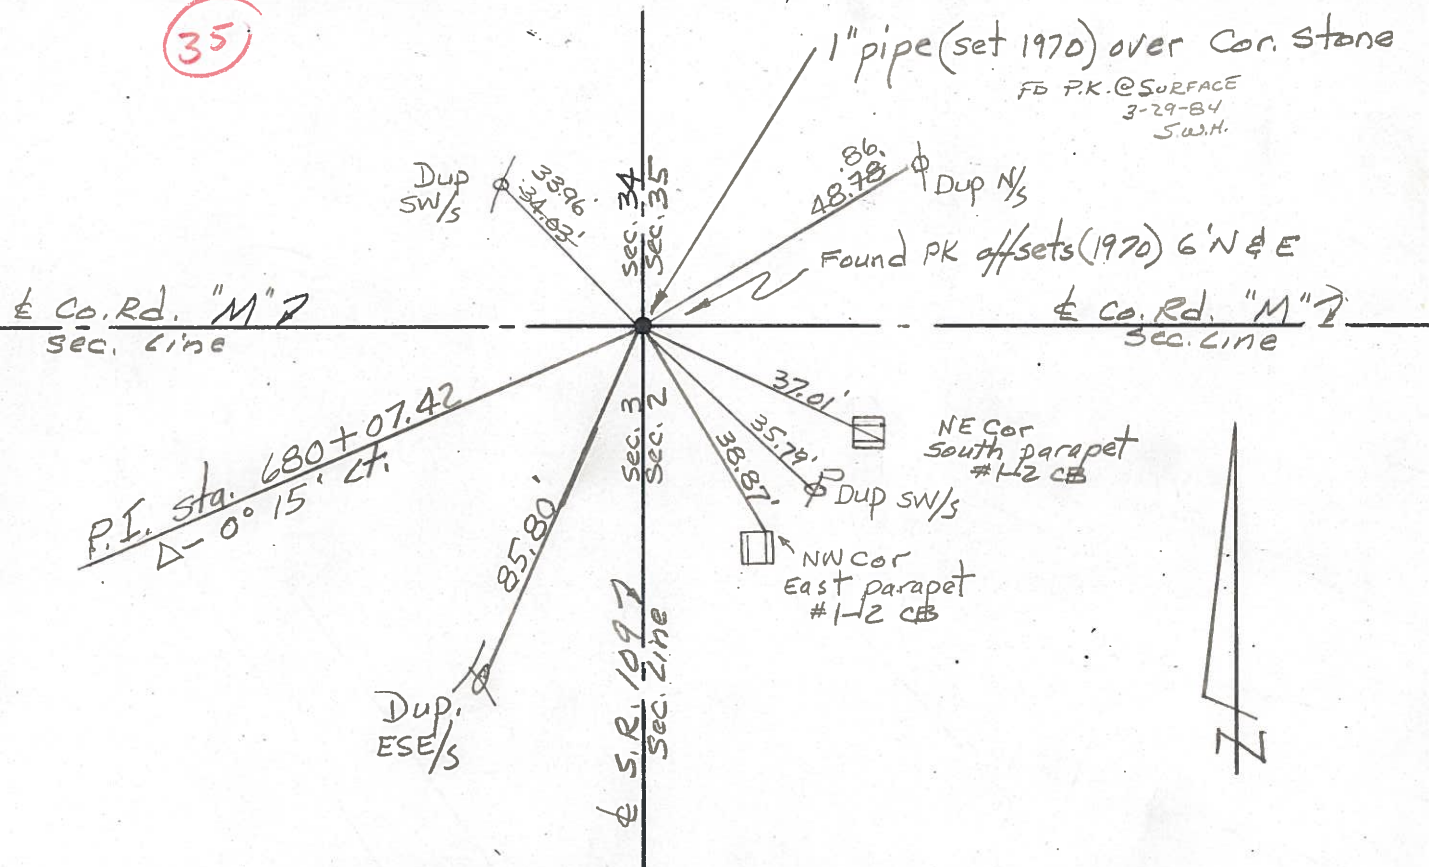

PERSONNEL TITLE PERSONNEL TITLE

COUNTY FultonDATE July 19, 1973TomsicGranataVandyBoyleS. R. 109

WEATHER

SEC. Royalton TWP.

TEMP.


DESCRIPTION

LEFT

CENTER LINE

RIGHT

JOB NO.

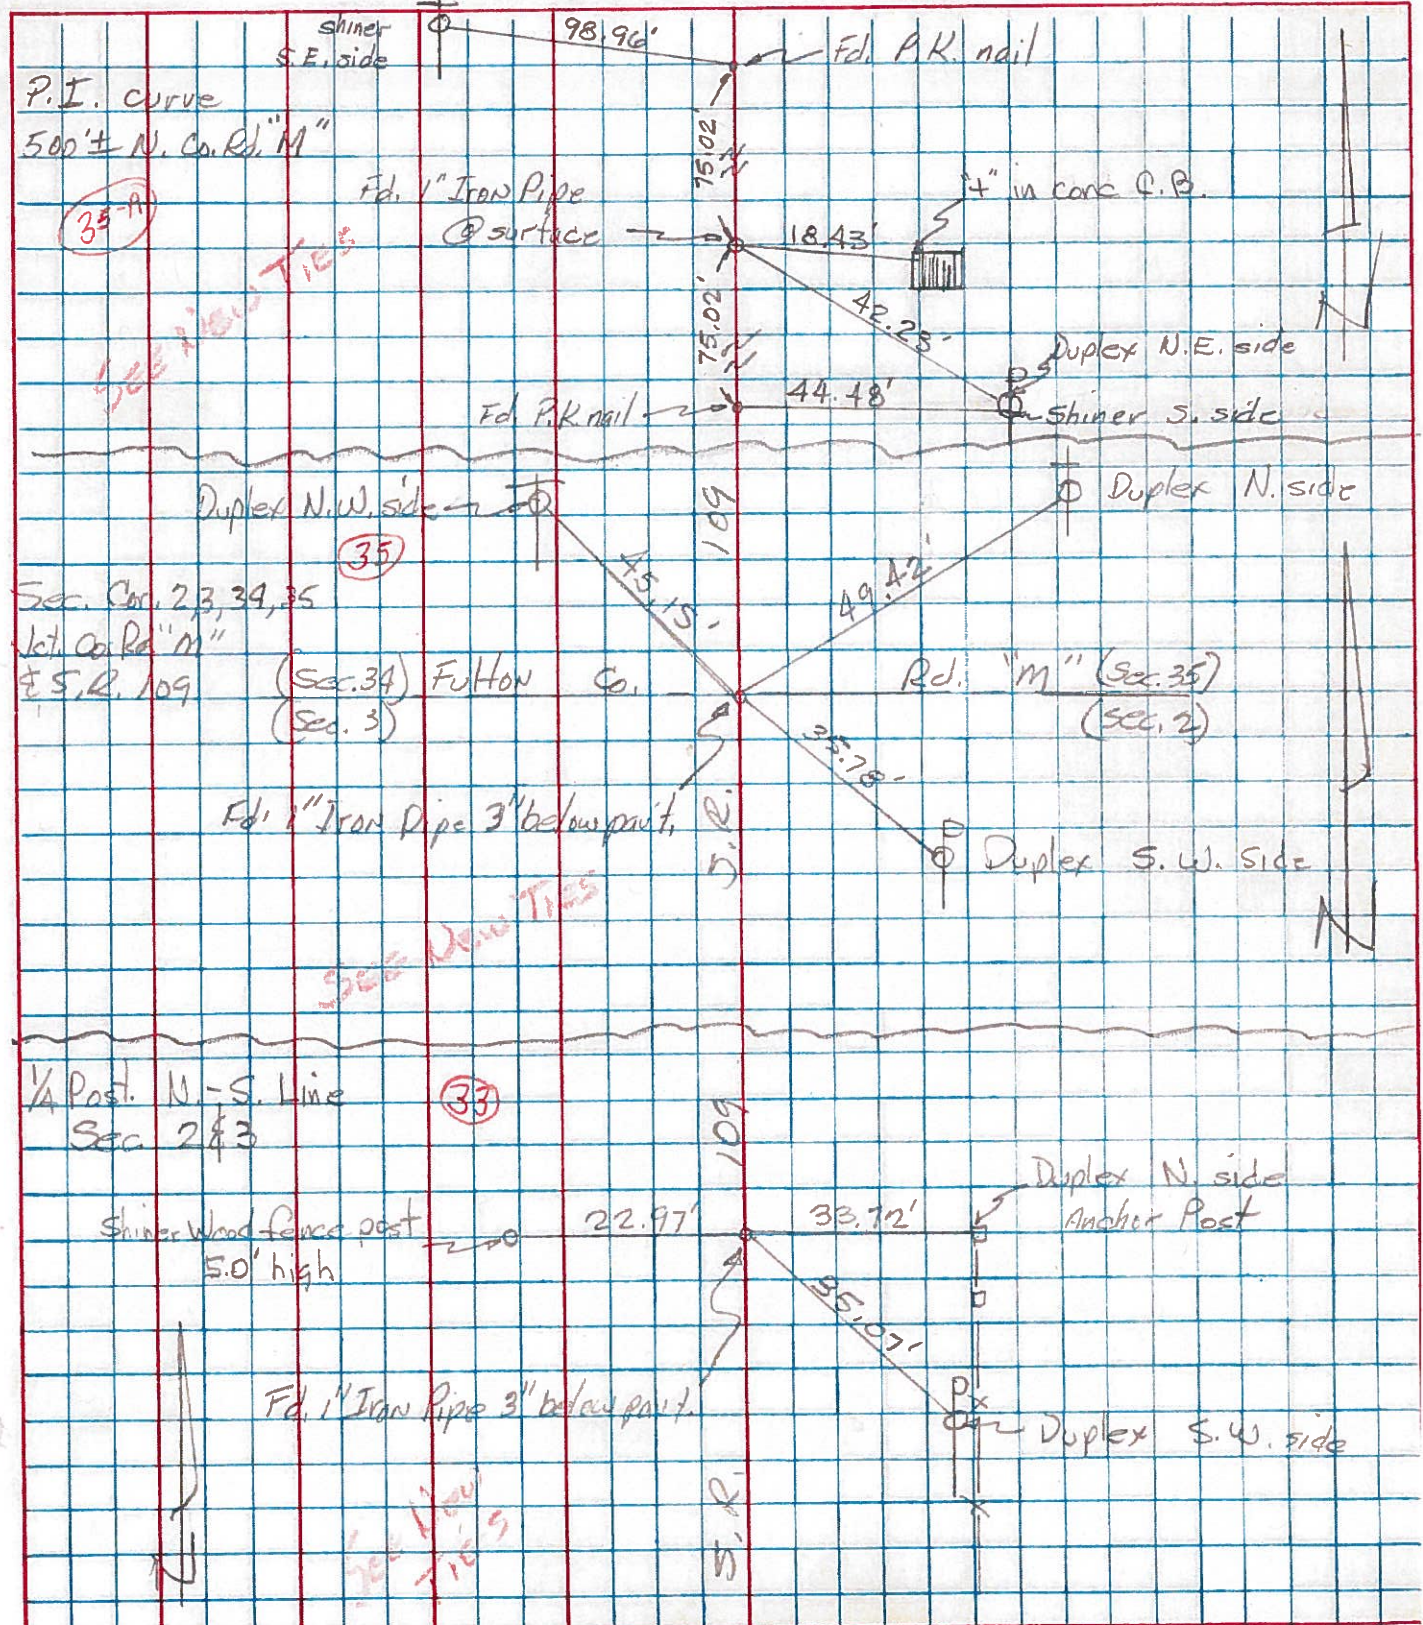

PERSONNEL TITLE PERSONNEL TITLE

Red Beach

COUNTY FULTON

DATE Dec. 1970

Newcomb

S. R. 109

WEATHER.

Knappe

Wise

SEC. PIKE TWP T-9-S TEMP.

DESCRIPTION

ALIGNMENT & CONTROLS

JOB NO.

LEFT

CENTER LINE

RIGHT

Ful Co. acquired 0.15 Ac. Apr. 1910
 40 rod x 10' See Vol. 83 p. 102

H. Schmitz

E-W 1/2 Sec. Line

R. Durham

Abutting owners
 mutually built Catch
 Basin and 30" outlet
 pipe on E-W Line 1962
 see witnesses

Pinus Gillen

C. Havers

ctr. post, Sec. 34
 Found old cor. post

PI sta. 689+80.76--est. 4"x 1/2" pipe
 $\Delta = 3^{\circ}00' \text{ Lt.}$

D - 2°

T - 75.02'

L - 150.00'

E - 0.97'

R - 2864.79'

P.C. sta. 689+05.74--est. PK

P.T. sta. 690+55.74--est. PK

Branch #2 of the
 North Branch of
 BAD CREEK

Ful Co. acquired 0.70 Ac. Apr. 1910
 112 rod x 1 rod See Vol. 93 p. 512

E-W Line passes
 0.18' South of an iron
 A.P. used by abutting
 owners to form p.y.
 Iron A.P. is 21.1' Rt of
 E Survey.

Found and used good cane A.P. and
 good conc. cor. post plus old fence line
 to project line to ctr. post Sec. 34 -
 intersecting E S.R. 109

PI sta. 685+98.65--Est. 4"x 1/2" pipe
 $\Delta = 3^{\circ}00' \text{ Rt.}$

D - 2°

T - 75.02'

L - 150.00'

E - 0.97'

R - 2864.79'

P.C. sta. 685+23.63--Est. PK

P.T. sta. 686+73.63--Est. PK

S 1/4 post, Sec. 34


S 1/4 post, Sec. 35

PI sta. 680+07.42
 $\Delta = 0^{\circ}15' \text{ Lt.}$

PI sta. 653+55.56

W 1/4 post, Sec. 2 Pike Twp T-10-S


PERSONNEL	TITLE	PERSONNEL	TITLE	COUNTY	DATE	WEATHER	TEMP.
Red Beach				FULTON	Nov 1970		
Newcomb				S. R. 109			
Knape				SEC. PIKE TWP.			
Wise				CONTROL POINTS			

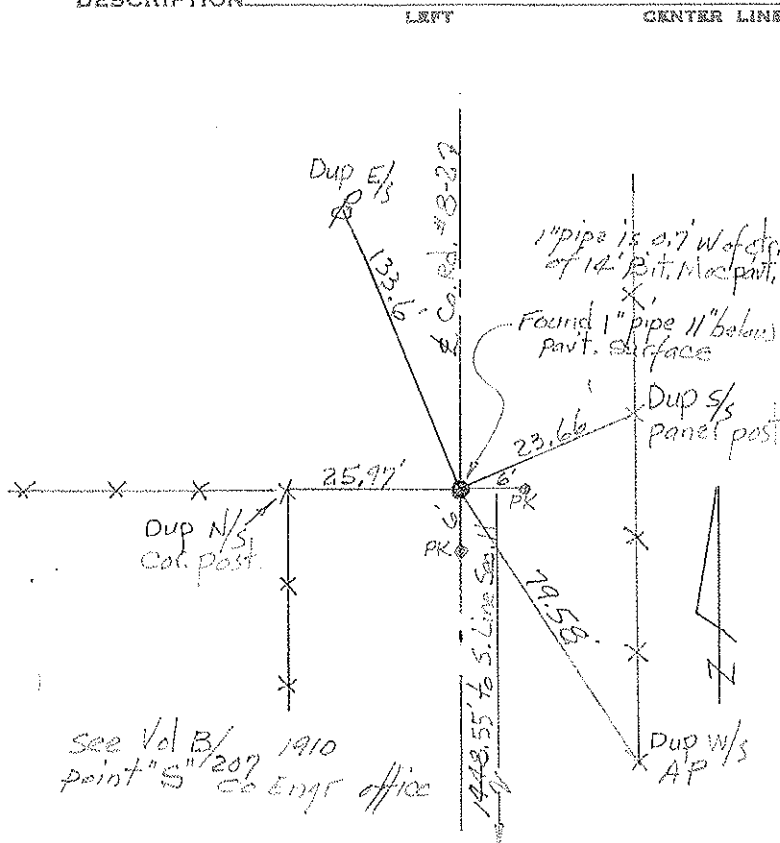


W 1/4 Post, Sec. 2, PIKE TWP. T-10-S
E 1/4 Post, Sec. 3, PIKE TWP. T-10-S

Made diligent & extensive search for this recorded 1/4 Post Stone. Both old witness trees gone.


Found very old wood stake (12"±) approx 12" below part. surface. Stake was in a vertical position and surrounded with brick — accepted same. Could not find stone. 1/4 Post is 0.3' West of ctr. of 18' Bit. Mac. Pavt.

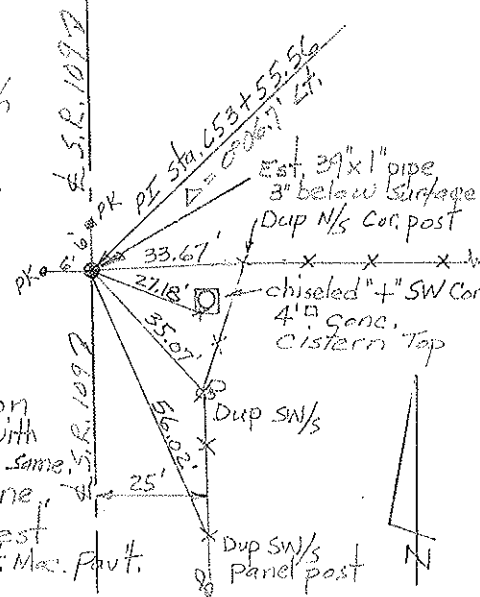

S 1/4 post, Sec. 34 T-9-S
N 1/4 post, Sec. 3 T-10-S

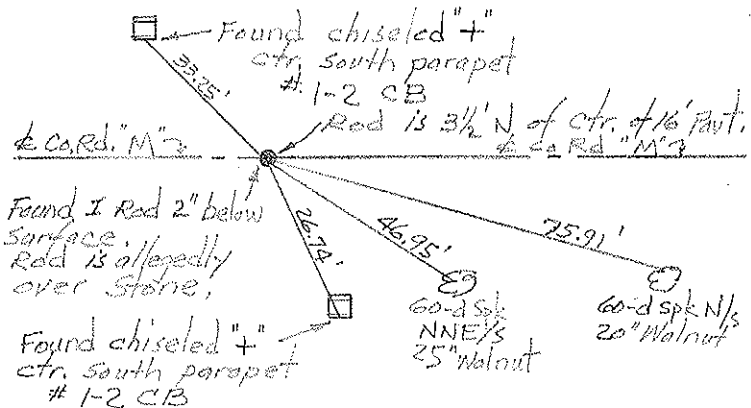

S 1/4 Post Sec. 35 T-9-S
N 1/4 Post Sec. 2 T-10-S

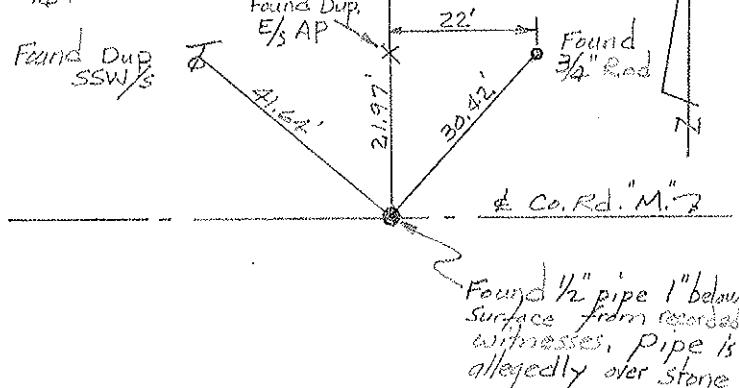

Cor. Sec. 2 & 3 T-10-S PIKE TWP.
Cor. Sec. 34 & 35 T-9-S PIKE TWP.

