

O.D.O.T. DISTRICT 2 SURVEY OFFICE (USE ONLY)

PERSONNEL

REFERENCE NO. 35-A

SHEET 24 OF 35

NOTES HUSS

DATE 06-18-12

ROUTE SR 109

H.C. HUSS

WEATHER FAIR/WARM

COUNTY FULTON

R.C. CANTERBURY

TEMP. 85°

TOWNSHIP PIKE

HARBAUGH

SECTION 35

COUTCHER

T 9 S R 3 E

TYPE MONUMENT PK/WASHER


ON SURFACE - BELOW ON

LEFT - Q PAV'T - RIGHT 2.3'

8.2' TO LT. EDGE PAVEMENT

S.L.M. 686+25

Grid: Northing: 723901.810 Easting: 1548967.671

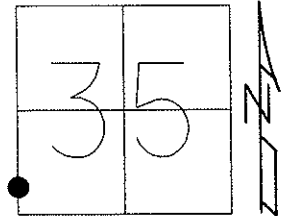


RECORD: APRIL 1984
FD 0.5" PIPE
1.5" DEEP

CURVE DATA
P.I. STA 685+98.65
 $\Delta=03^\circ$
 $D=02^\circ$
 $T=75.02'$
 $R=2864.79'$
 $L=150.00'$

03-07-13 RESET MAG/WASHER

06-11-12 GPS REF A35, SAH
03-07-13 GPS FIN A35, MC

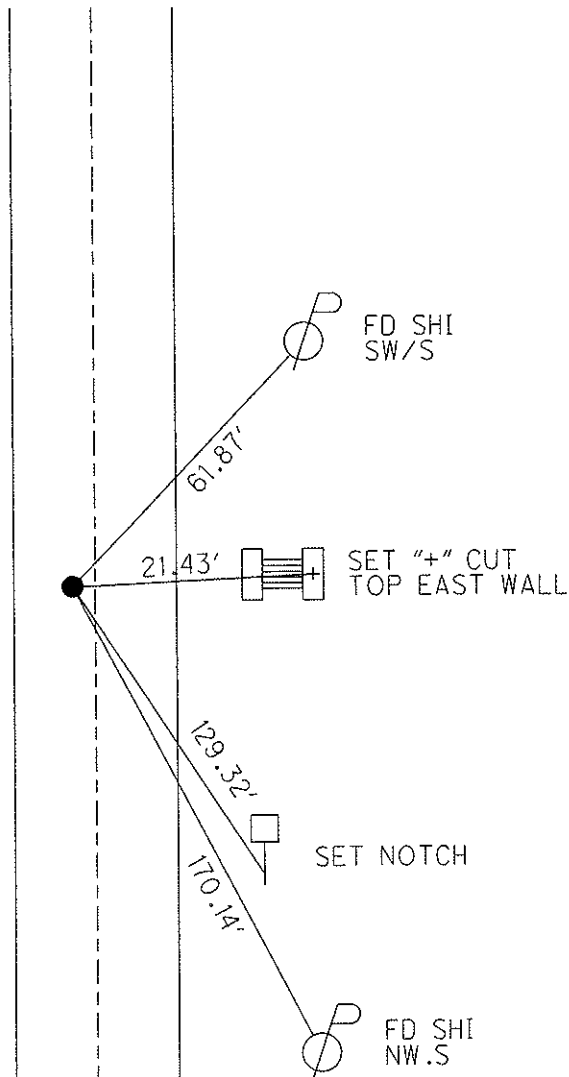

O.D.O.T. DISTRICT 2 SURVEY OFFICE

PERSONNEL

REFERENCE NO. 35-A

SHEET 20 OF 28

NOTES CANTERBURY

H.C. LOEHRKE

R.C. CANTERBURY

DATE 8-26-96

WEATHER FAIR

TEMP. +85°

Reset P.K. WASHER
9-29-97

ROUTE S.R. 109

COUNTY FULTON

TOWNSHIP Pike

SECTION 35

T. 9 R. 3 E


TYPE MONUMENT P.K. / WASHER

ON SURFACE - ~~BELOW~~ Yes

LEFT-~~C~~ PAV'T. - ~~RIGHT~~ .7 LT &

2.5 TO LT EDGE PAVEMENT

S.L.M. 20 + 905 (686+25)

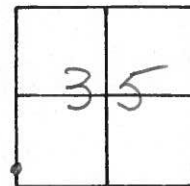

RECORD:

Fd. 1/2" I PIPE
1 1/2" Deep / APRIL-1984


CURVE DATA

P.I. Sta 685+98.65
 $\Delta = 3^\circ$ Rt
 $D^\circ = 2^\circ$
 $T = 75.02$ ft.
 $R = 2864.79$ ft.
 $L = 150.00$ ft.

SET P.K./WASHER IN LEVELING

COURSE 11/22/96, MRC

BASIN ON E+W SIDE OF SR109 NEW

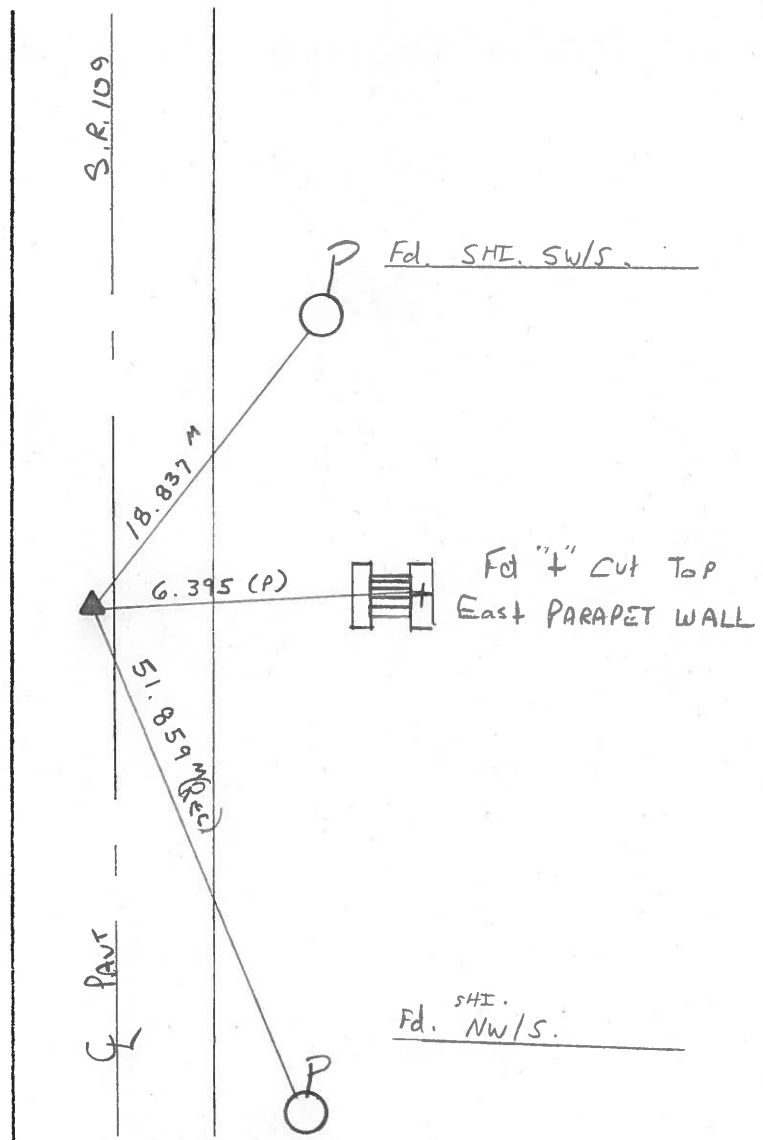

O.D.O.T. DISTRICT 2 SURVEY OFFICE

PERSONNEL

REFERENCE NO. 35-A

SHEET OF

NOTES BARNHISEL

H.C. " "

R.C. HOFFMAN

DATE 9-4-90

WEATHER clear

TEMP. +85°

ROUTE 109

COUNTY Fulton

TOWNSHIP PIKE

SECTION 35

T9 SR 3 E


TYPE MONUMENT Sm RR Spk

ON SURFACE - ~~BELOW~~ yes

LEFT- & PAV'T. - ~~RIGHT~~ 2.3

8.2 TO LT EDGE PAVEMENT

S.L.M. 686 + 25

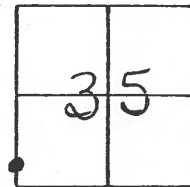

Record: Fd 1/2" I. Pipe

1 1/2" down / April 1984

CURVE DATA:

P.I. STA: 685+98.65

$\Delta = 30^\circ$ RT

$D = 2^\circ$


$T = 75.02'$

$L = 150.00'$

$E = 0.97'$

$R = 2864.79'$

Set P.K. 1/2" Washer
10-1-90
MB

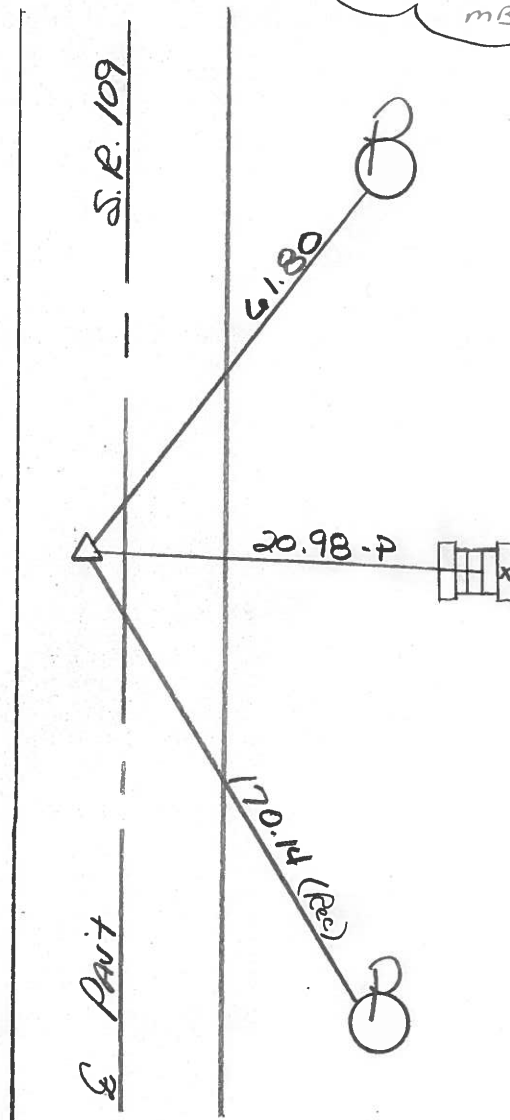

Q.D.O.T. DISTRICT 2 SURVEY OFFICE

SHEET 17 OF

County Fulton S.R. 109

Township Pike

Section 35

T N, R E

Personnel I. Stone

P. Neuse


R. Michalak

D. Curtis


Date 12 April 84

Weather Sunny

Temp. 50°

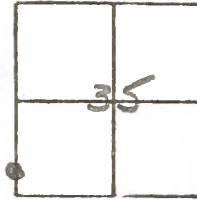

REF. NO. 35-A

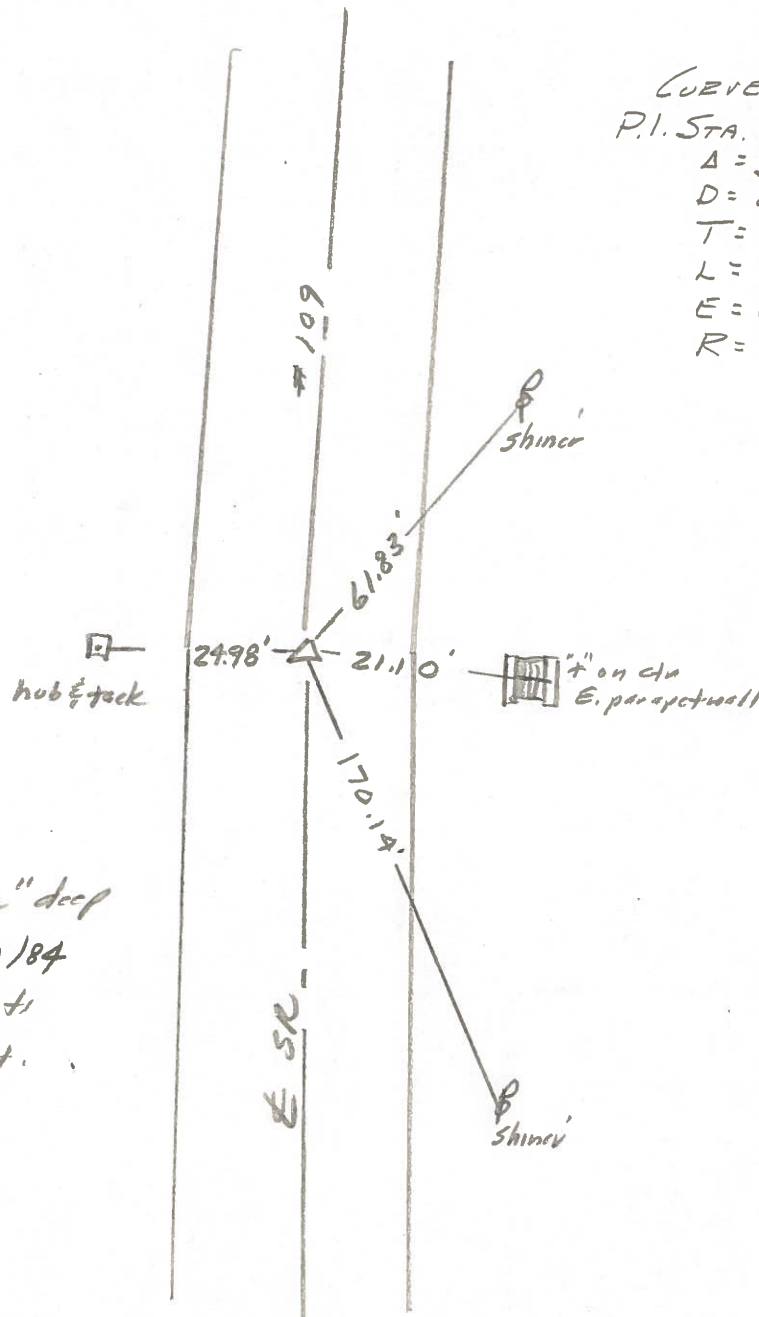

CURVE DATA:
 P.I. STA. 685+98.65
 $\Delta = 3^\circ$ Rt.
 $D = 2^\circ$
 $T = 75.02'$
 $L = 150.00'$
 $E = 0.97'$
 $R = 2864.79'$

P.I. $\Delta = 3^\circ$ Rt.
 Fd. $\frac{1}{2}$ " I. Pipe $1\frac{1}{2}$ " deep
 Set Small Spt. 6/21/84
 11.2' to E. edge put.
 7.2' to W. edge put.

Date 12 April 84

Weather Sunny

Temp. 50°

A 2x2 grid with a dot in the bottom-left cell and the number 35 in the center.

N

R. Michalski

D. Curtis

CURVE DATA:

P.I. STA. 685+98.65

$\Delta = 3^\circ - 27'$


$D = 2''$

$T = 75.02'$

$L = 150.00'$

$E = 0.97'$

$R = 2864.79'$

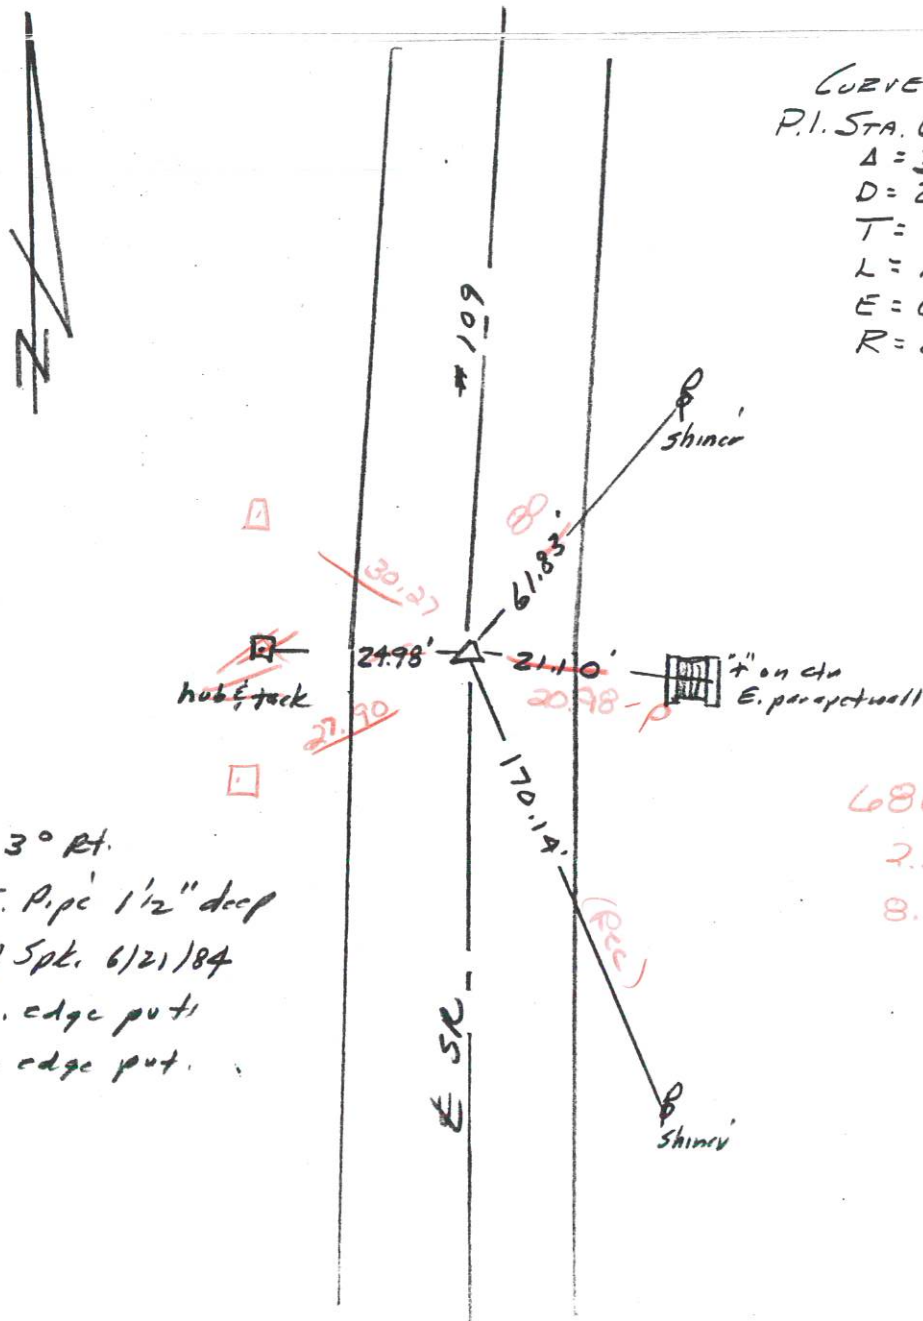

Fd. $\frac{1}{2}$ " I. Pipe $1\frac{1}{2}$ " deep

Set 5moll Spt. 6/21/84

11.2' to E. edge put,

7.2' to W. edge put.

$686 + 25$
 2.3 kT E
 8.2 To kT Ed

PERSONNEL	TITLE	PERSONNEL	TITLE	COUNTY	DATE	WEATHER
<u>Red Beach</u>				<u>Fulton</u>	<u>23 Feb '77</u>	
<u>W. Knappe</u>				<u>109</u>		
				<u>Pike Twp</u>		
DESCRIPTION <u>CONTROL POINTS</u>				JOB NO.		


(35-A)

18'x12" CMP
PK Top ctr
South end


PI Sta. 685+98.65
 $\Delta - 3^\circ \text{ R.H.}$

set 1/2" pipe 1970
2'± west of ctr.
of 19' R.H. Mac. pav't.


Curve Data
PI Sta. 685+98.65
 $\Delta - 3^\circ \text{ R.H.}$
 $D - 2^\circ$
 $T - 75.02'$
 $L - 150.00'$
 $E - 0.97'$
 $R - 2864.79'$

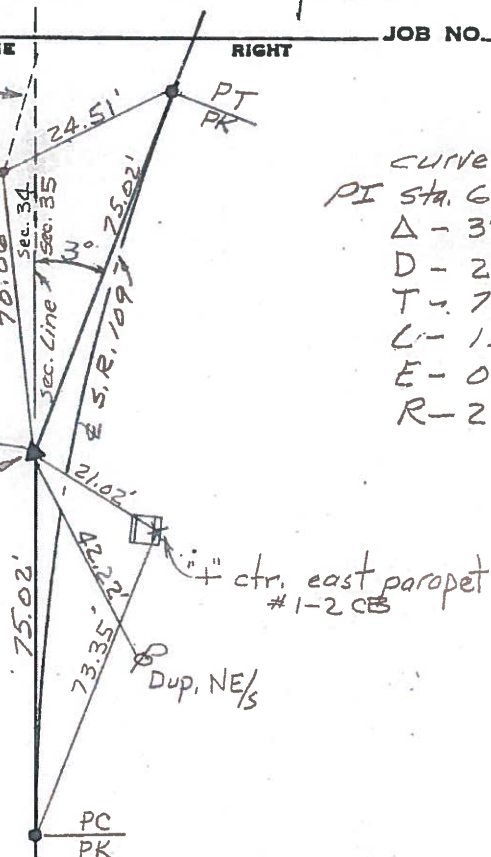

(35)

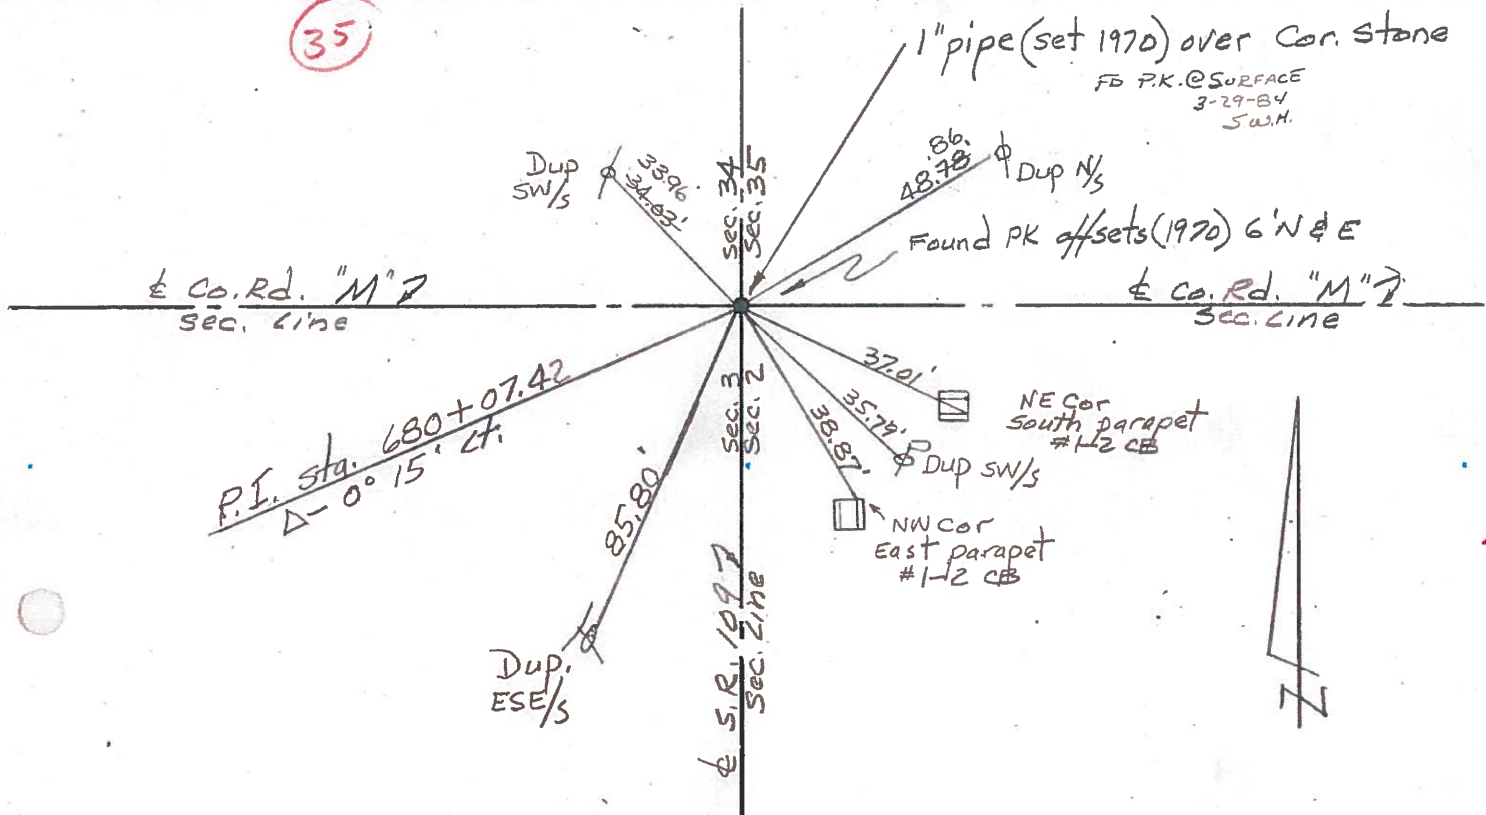

PERSONNEL	TITLE	PERSONNEL	TITLE	COUNTY	DATE	WEATHER	TEMP.
Tomsic				Fulton	July 19, 1973		
Granata				S. R. 109			
Vandy				SEC. Royalton TWP.			
Boyle							

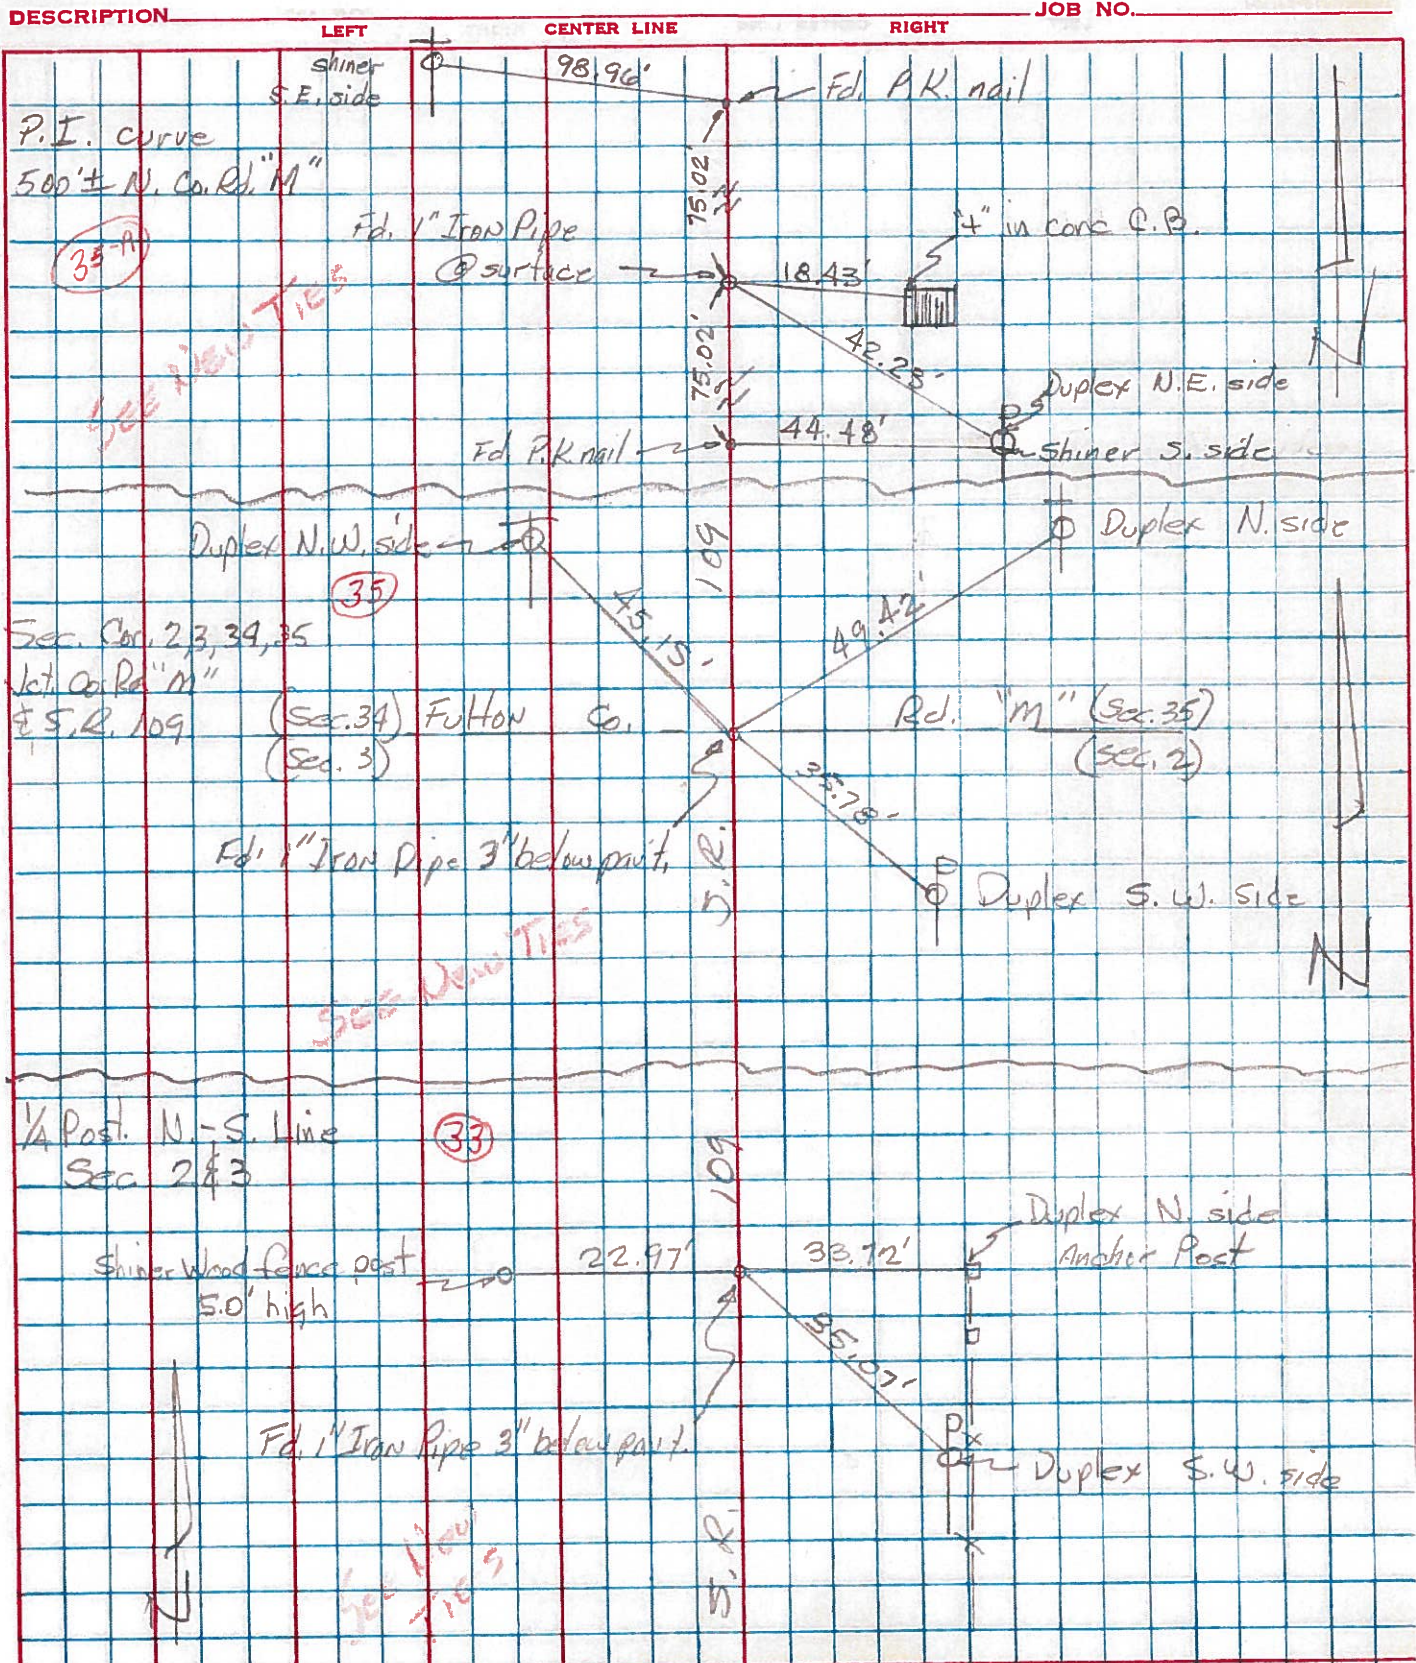

PERSONNEL TITLE PERSONNEL TITLE

Red Beach

COUNTY FULTON

DATE Dec. 1970

Newcomb

S. R. 109

WEATHER.

Knappe

Wise

SEC. PIKE TWP T-9-S TEMP.

DESCRIPTION

ALIGNMENT & CONTROLS

JOB NO.

LEFT

CENTER LINE

RIGHT

Ful Co. acquired 0.15 Ac. Apr. 1910
 40 rod x 10" See Vol. 83 p. 102

H. Schmitz

E-W 1/2 Sec. Line

R. Durham

Abutting owners
 mutually built Catch
 Basin and 30" outlet
 pipe on E-W Line 1962
 see witnesses

Pinus Gillen

C. Havers

ctr. post, Sec. 34
 Found old cor. post

PI sta. 689+80.76--est. 4"x 1/2" pipe
 $\Delta = 3^{\circ}00' \text{ Lt.}$

D - 2°

T - 75.02'

L - 150.00'

E - 0.97'

R - 2864.79'

P.C. sta. 689+05.74--est. PK

P.T. sta. 690+55.74--est. PK

Branch #2 of the
 North Branch of
 BAD CREEK

Ful Co. acquired 0.70 Ac. Apr. 1910
 112 rod x 4 rod See Vol. 93 p. 512

± S.R. 109 7
 2120.98' Tang

± S.R. 109 7
 2120.98' Tang

E-W Line passes
 0.18' South of an iron
 A.P. used by abutting
 owners to form p.y.
 Iron A.P. is 21.1' Rt of
 E Survey.

Found and used good cane A.P. and
 good conc. cor. post plus old fence line
 to project line to ctr. post Sec. 34 -
 intersecting E S.R. 109

PI sta. 685+98.65--Est. 4"x 1/2" pipe
 $\Delta = 3^{\circ}00' \text{ Rt.}$

D - 2°

T - 75.02'

L - 150.00'

E - 0.97'

R - 2864.79'

P.C. sta. 685+23.63--Est. PK

P.T. sta. 686+73.63--Est. PK

S 1/4 post, Sec. 34

S 1/4 post, Sec. 35

PI sta. 680+07.42
 $\Delta = 0^{\circ}15' \text{ Lt.}$

PI sta. 653+55.56

W 1/4 post, Sec. 2 Pike Twp T-10-S

PERSONNEL	TITLE	PERSONNEL	TITLE
Red Beach			
Newcomb			
Knappe			
Wise			

COUNTY FULTON DATE Dec 1970

S. R. 109 WEATHER _____

SEC. PIKE TWP T-9-S TEMP. _____

DESCRIPTION CONTROL POINTS JOB NO. _____


LEFT

CENTER LINE

RIGHT

PI sta. 685+98.65

PI sta 711+01.70

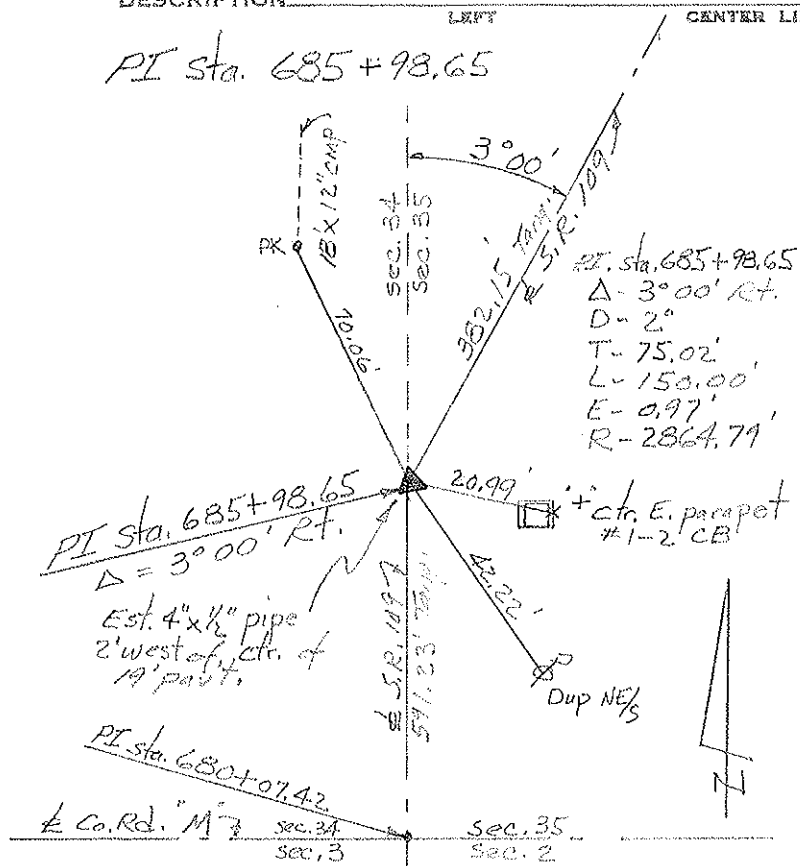

PI sta. 711+01.70

 $\Delta = 2^\circ 32'$ Lt.


D- 2°

T- 63.34'

L- 126.67'

E- 0.69'

R- 2864.79'

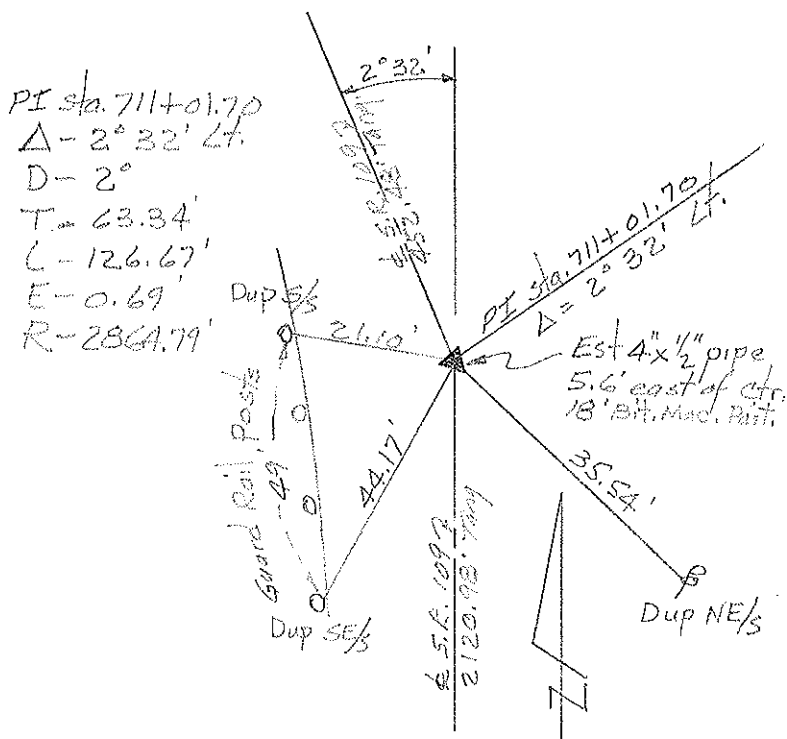

PI sta. 689+80.76

PI sta. 715+54.17

PI sta. 689+80.76

 $\Delta = 3^\circ 00'$ Lt.


D- 2°

T- 75.02'

L- 150.00'

E- 0.97'

R- 2864.79'

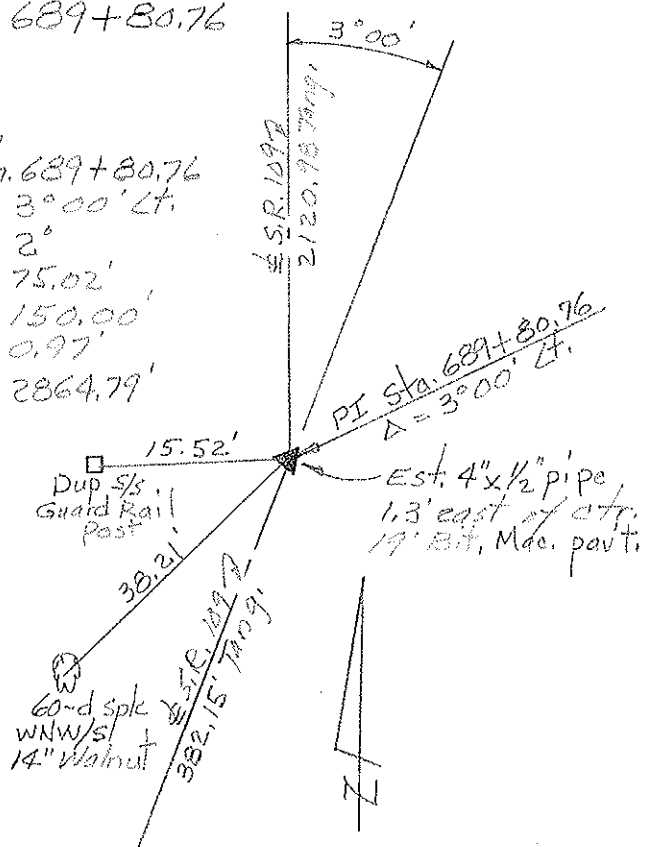

end post a

 $\Delta = 2^\circ 32'$ Rt.

D- 2°

T- 63.34'

L- 126.67'

E- 0.69'

R- 2864.79'

