

O.D.O.T. DISTRICT 2 SURVEY OFFICE (USE ONLY)

PERSONNEL

REFERENCE NO. 36

SHEET 26 OF 35

NOTES HUSS

DATE 06-18-12

ROUTE SR 109

H.C. HUSS

WEATHER FAIR/BREEZY

COUNTY FULTON

R.C. CANTERBURY

TEMP. 86°

TOWNSHIP PIKE

HARBAUGH

SECTION 35

COUTCHER

T 9 S R 3 E

TYPE MONUMENT MAG/WASHER


ON SURFACE - BELOW ON

LEFT - Q PAV'T - RIGHT ON

9.5' TO RT EDGE PAVEMENT


S.L.M. 706+78

Grid: Northing: 725955.545 Easting: 1548972.712

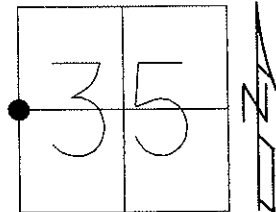

11-22-96 SET PK WASHER
IN LEVELING COURSE, MRC
03-08-13 RESET MAG/WASHER

06-08-12 GPS REF 36, SAH
03-08-13 GPS FIN 36

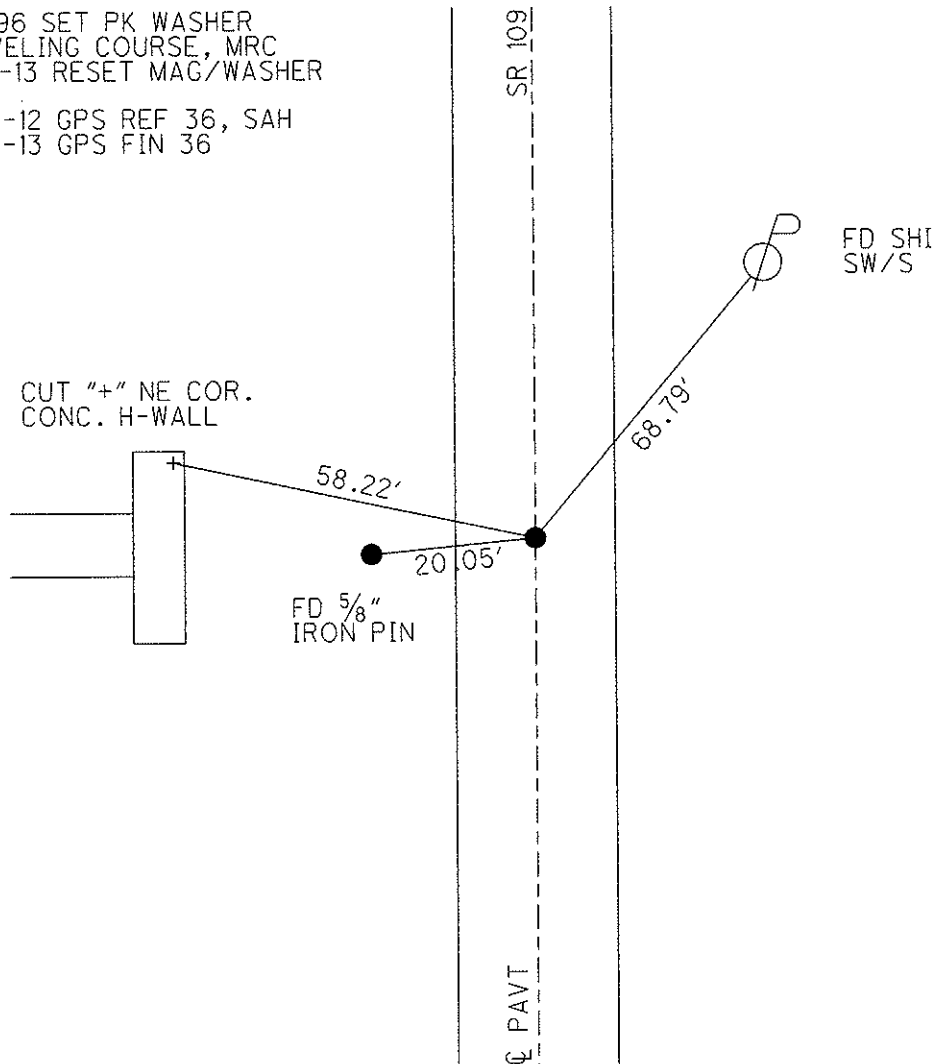

O.D.O.T. DISTRICT 2 SURVEY OFFICE

PERSONNEL

REFERENCE NO. 36

SHEET 22 OF 28

NOTES CANTERBURY

H.C. ROUSOS

R.C. CANTERBURY

DATE 9-3-96

WEATHER FAIR

TEMP. +80°

Reset P.K./WASHER

9-29-97

C.L.

ROUTE S.R. 109

COUNTY FULTON

TOWNSHIP PIKE

SECTION 35

T 9 S R 3 E


TYPE MONUMENT PK / WASHER

ON SURFACE - BELOW YES

~~LEFT~~ - ~~C~~ PAW'T. - RIGHT ON E


2.75 TO RT EDGE PAVEMENT

S.L.M. 21 + 532.85 (706 + 78)

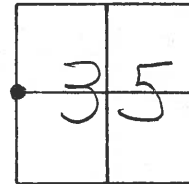

SET P.K./WASHER IN LEVELING
COURSE. 11/22/96. MRC.

CUT 4" NE COR. CONC.
HWALL

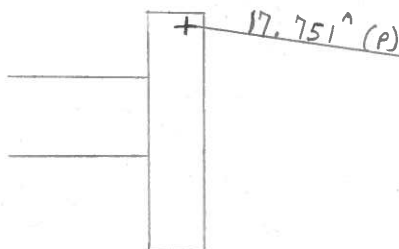

S.R. 109

E PAWT.

Fd. SHI. SW/S.

O.D.O.T. DISTRICT 2 SURVEY OFFICE

PERSONNEL

REFERENCE NO. 36

SHEET OF

NOTES BARNHISEL

H.C. " "

R.C. HOFFMAN

DATE 9-4-90

WEATHER Clear

TEMP. +85°

ROUTE 109

COUNTY Fulton

TOWNSHIP PIKE

SECTION 35

T 9 S R 3 E


TYPE MONUMENT Sm RR Spk

ON SURFACE - BELOW yes


LEFT - CL PAV'T. - RIGHT yes


10.0 TO RT EDGE PAVEMENT

S.L.M. 706+78

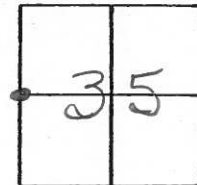


Set P.K. & Washer
10-1-90
MB

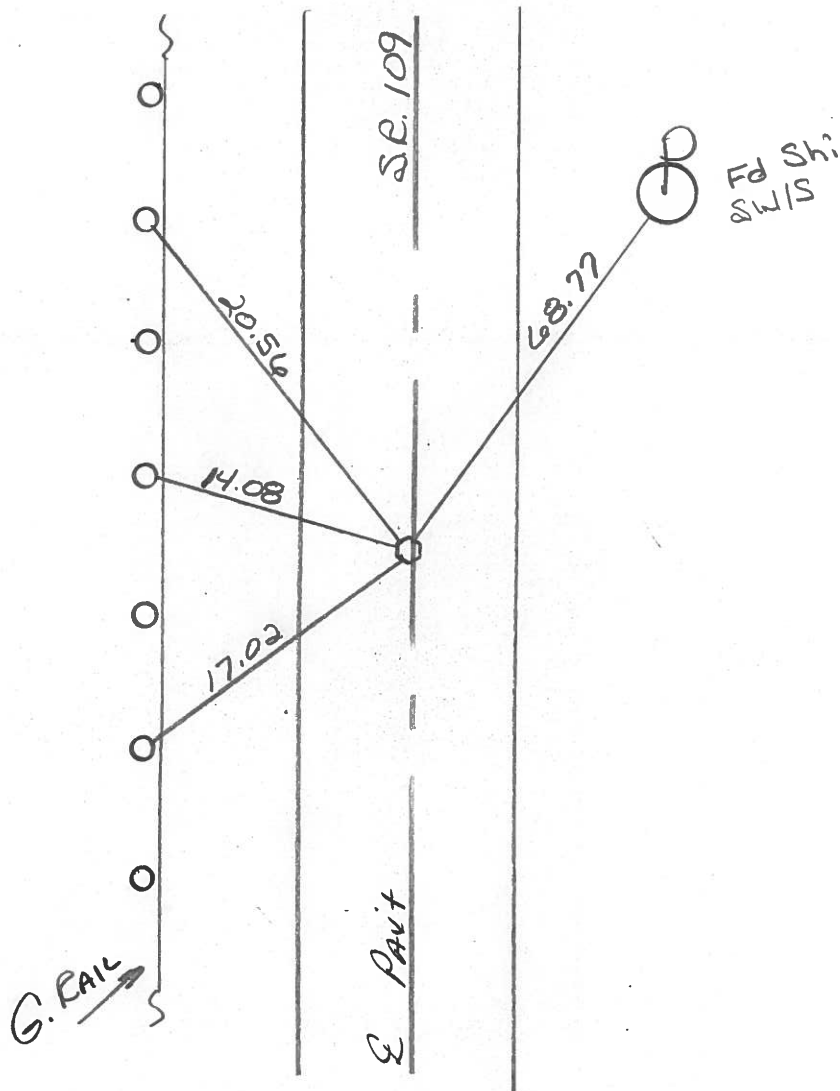

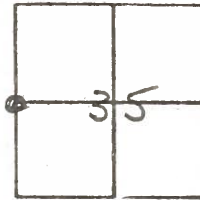County Fulton S.R. 109Township PikeSection 35T N, R EPersonnel J. StoneP. NeuserR. MichalakD. CurtisDate 12 April 84Weather SunnyTemp. 52°

REF. NO. 36

706-70

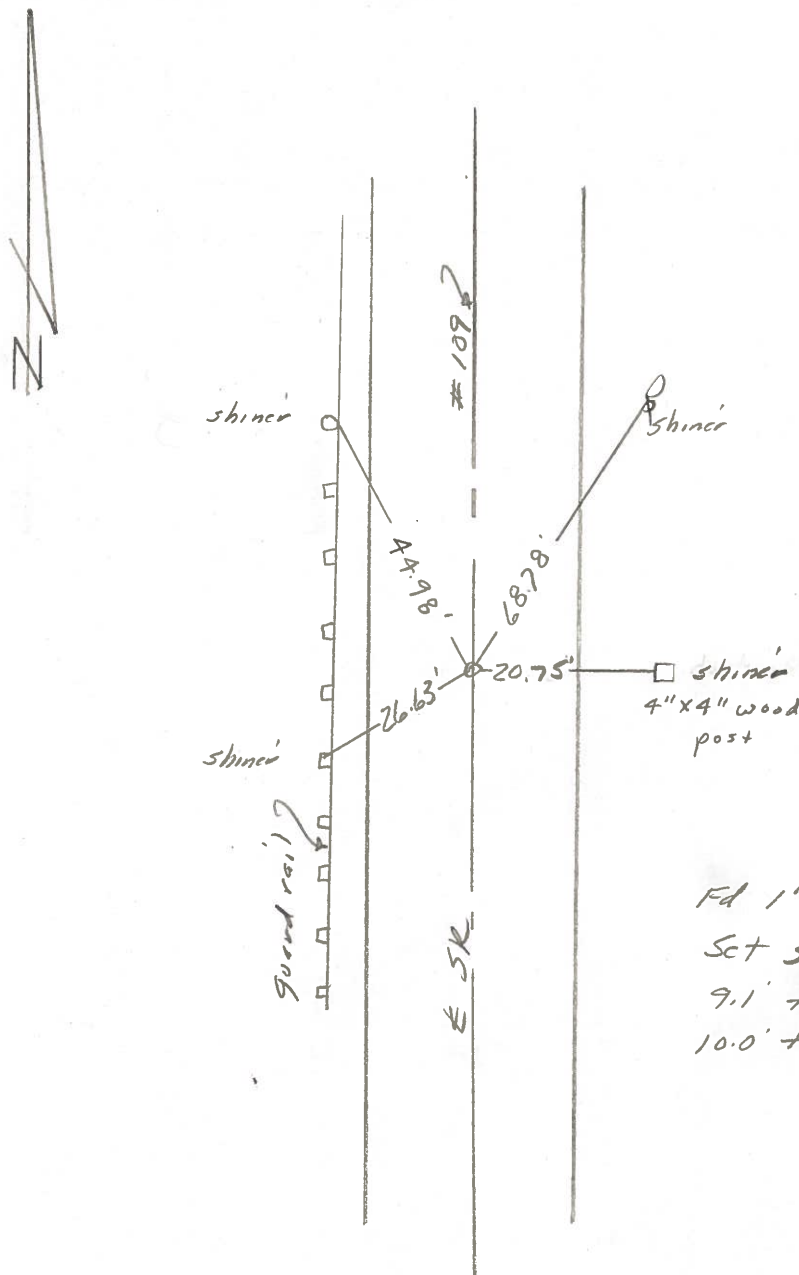

Ed 1" I. P. pc 2" deep
Set Small Spk. 6/21/84
9.1' to E. edge put,
10.0' to W. edge put.

SHEET 19 OF

Date 12 April 84

Weather Sunny

Temp. 52°


A horizontal number line is shown with a vertical tick mark at the center labeled '3'. To the right of '3', there is another tick mark labeled '5'. A point is marked with a dot on the line between '3' and '5', and it is labeled '3.5'.

N

R. Michalek

D. Curtis

Sm FR Spk
706 + 78
ON 8
10.0 TORT Edge

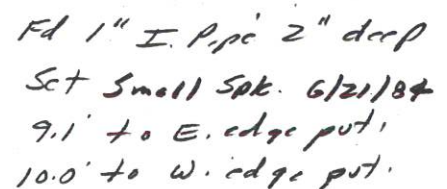

PERSONNEL	TITLE	PERSONNEL	TITLE
1	2	3	4
5	6	7	8
9	10	11	12
13	14	15	16
17	18	19	20
21	22	23	24
25	26	27	28
29	30	31	32
33	34	35	36
37	38	39	40
41	42	43	44
45	46	47	48
49	50	51	52
53	54	55	56
57	58	59	60
61	62	63	64
65	66	67	68
69	70	71	72
73	74	75	76
77	78	79	80
81	82	83	84
85	86	87	88
89	90	91	92
93	94	95	96
97	98	99	100

COUNTY Fulton

DATE 23-24 Feb '77

S. R. 109

WEATHER

SEC. PIKE TWP

TEMP

DESCRIPTION


CONTROL POINTS

LEFT

CENTER LINE

JOB NO

RIGHT

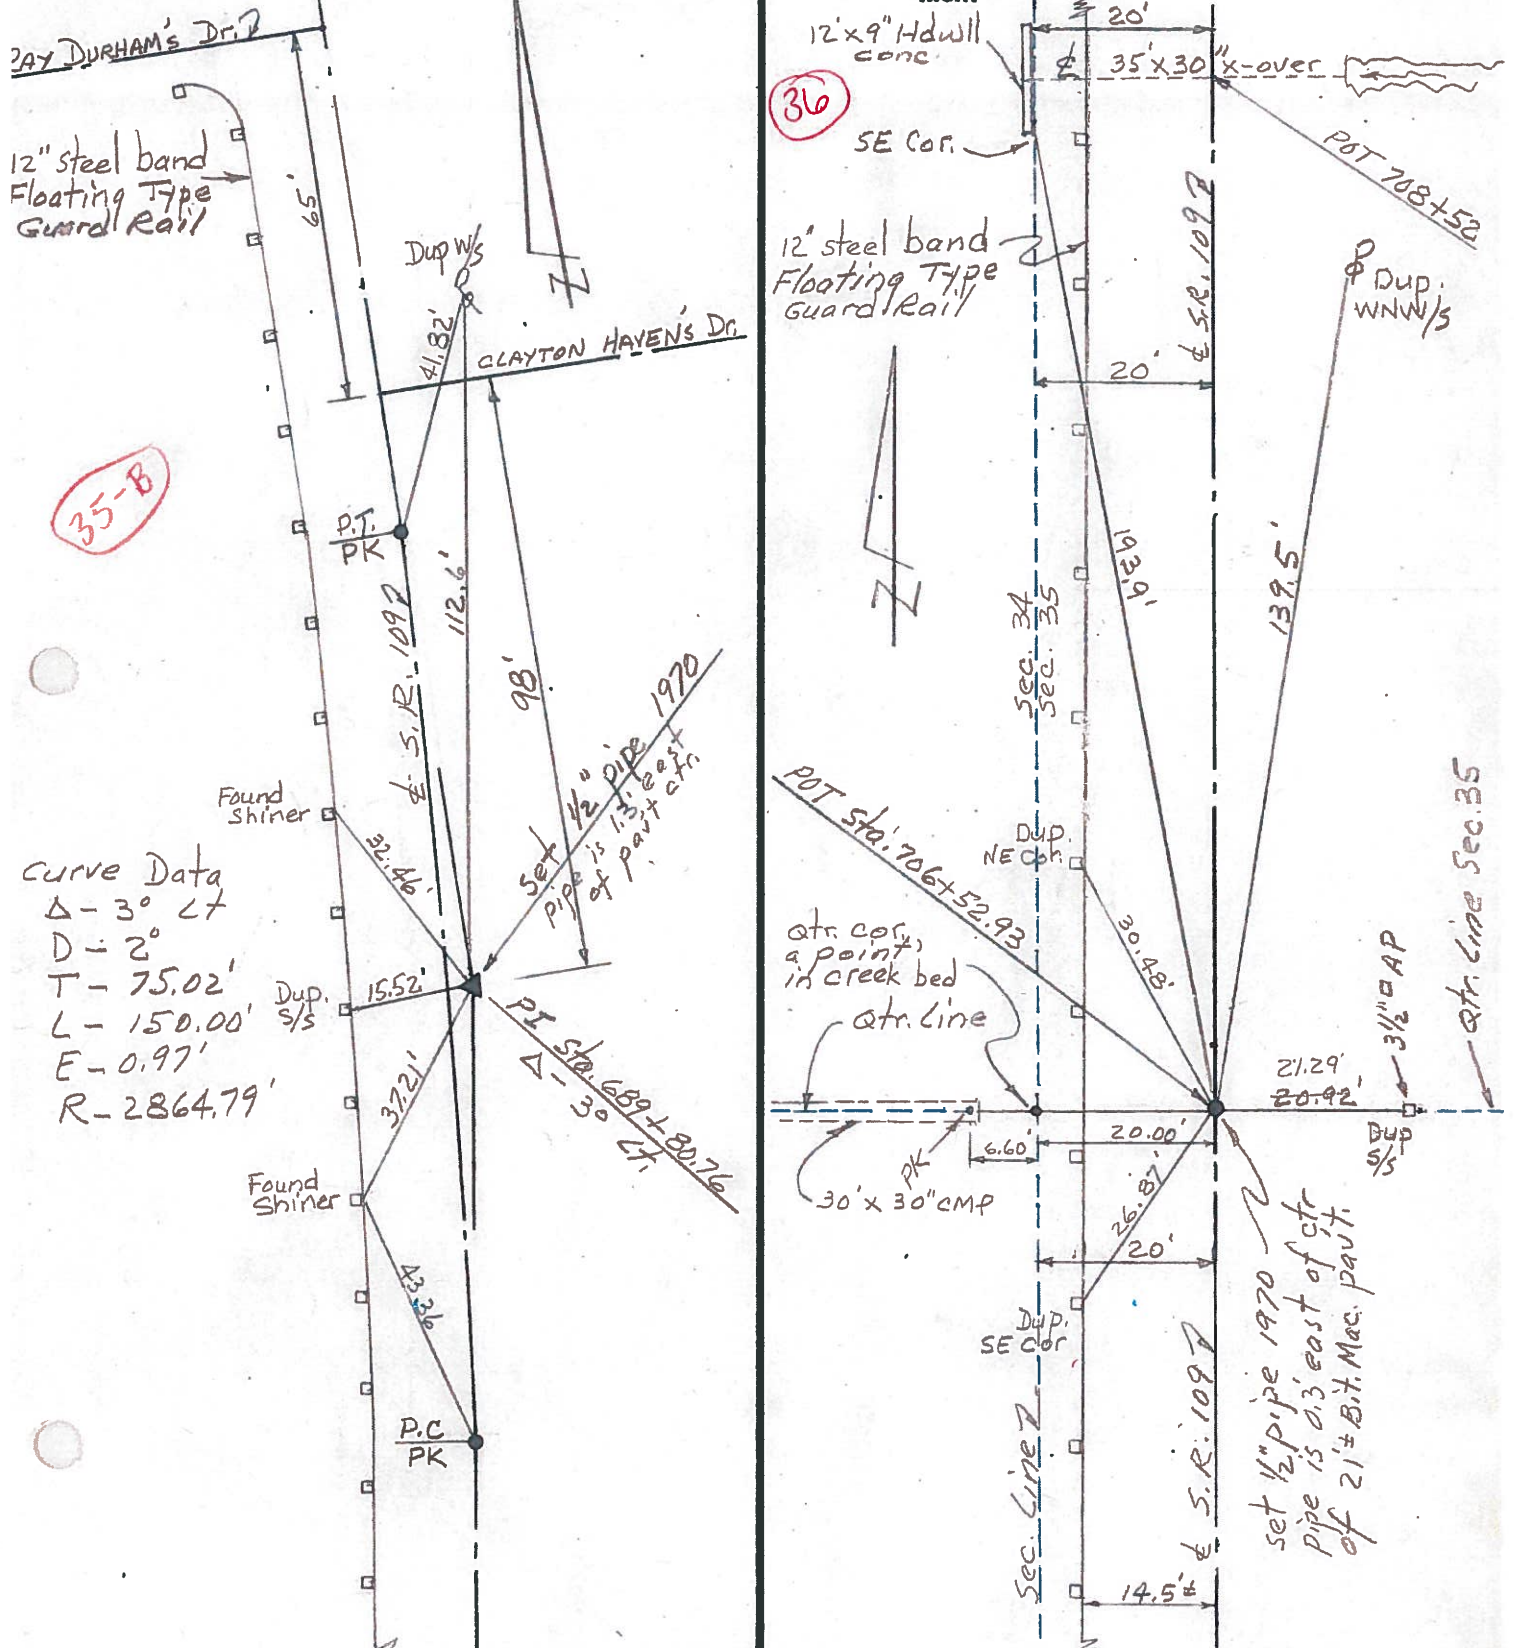


PERSONNEL	TITLE	PERSONNEL	TITLE
TAMMIE		Boyle	
Nasser			
Granata			
Van Yo			

COUNTY Fulton DATE July 23, 1973

S. R. 109 WEATHER _____

SEC. Royalton TWP. TEMP. _____

DESCRIPTION _____ LEFT _____ CENTER LINE _____ RIGHT _____ JOB NO. _____

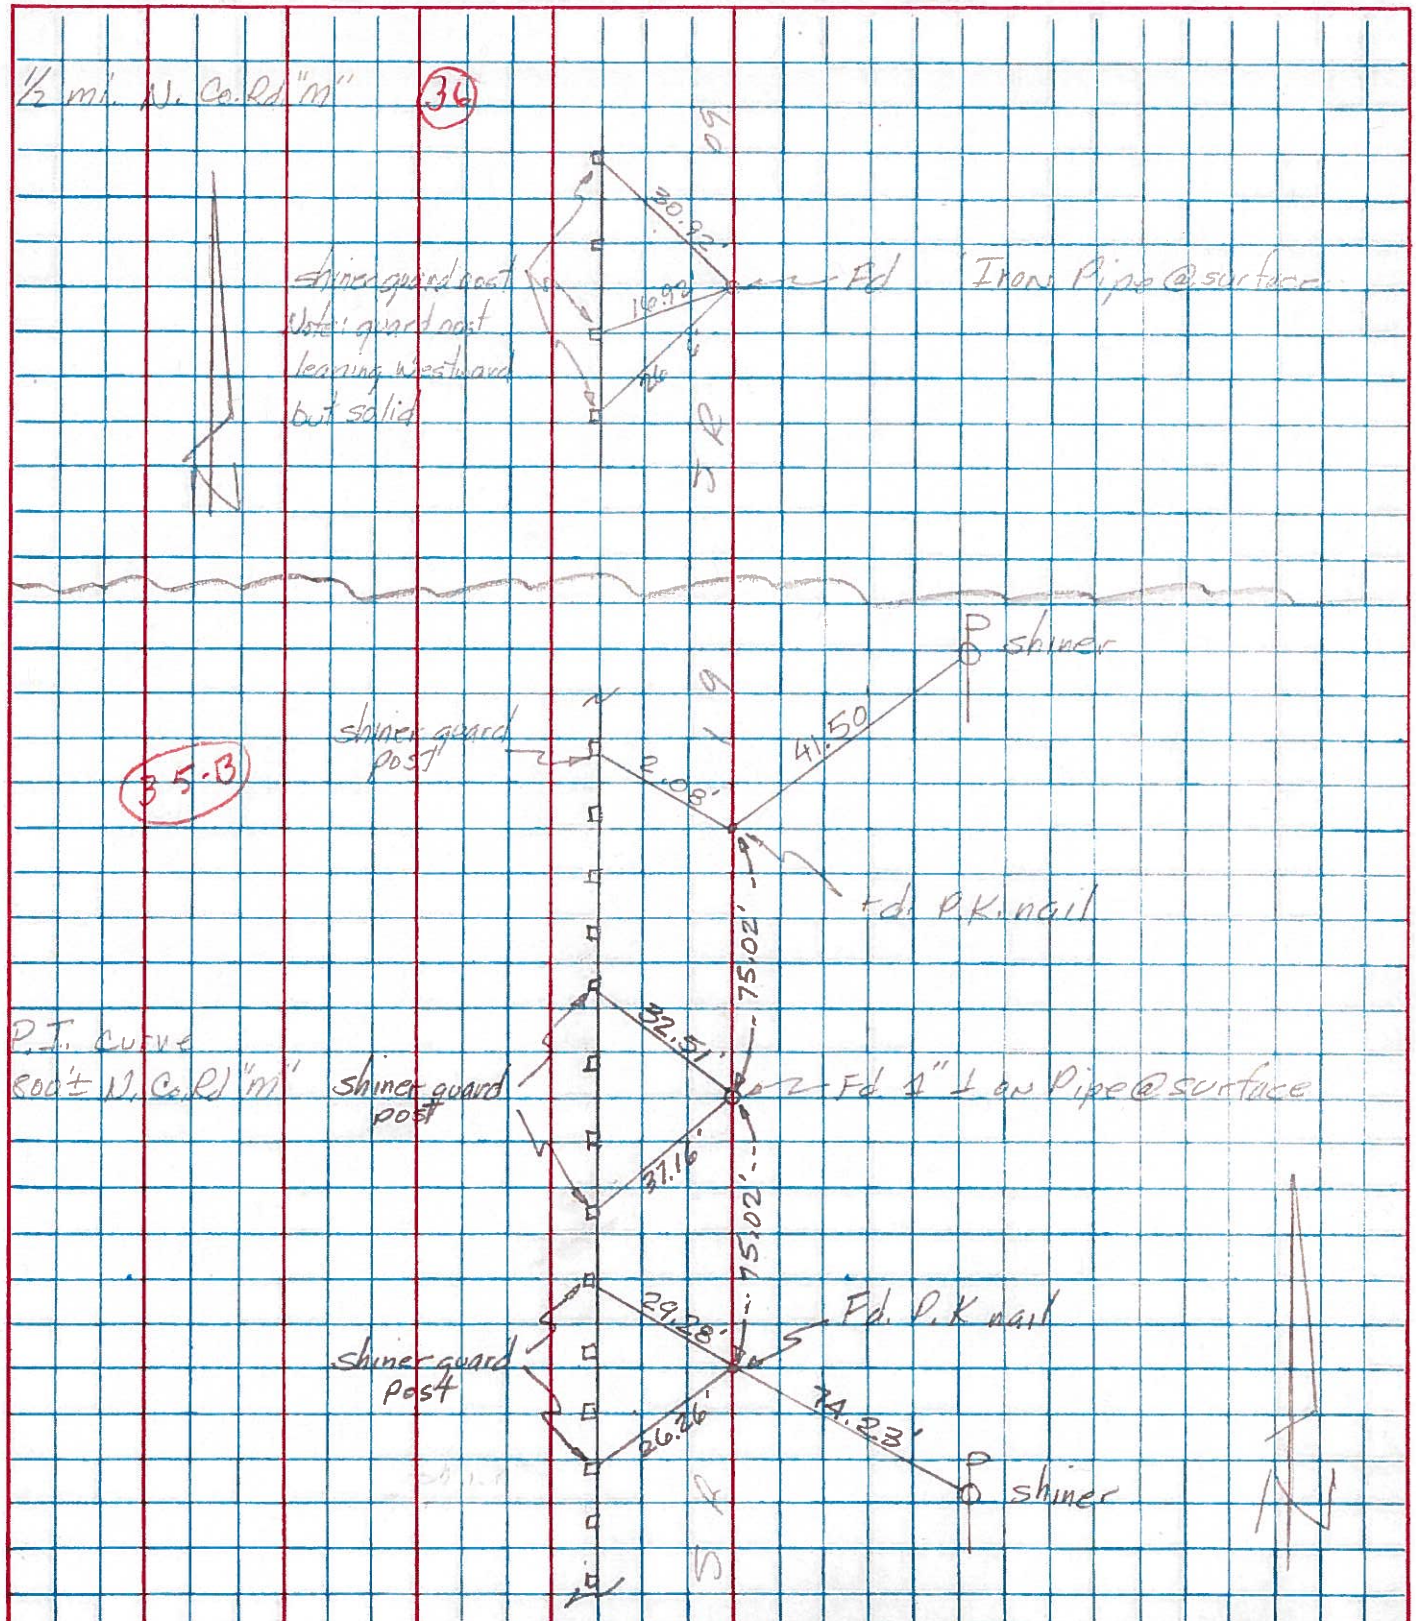

PERSONNEL TITLE PERSONNEL TITLE

Red Beach

COUNTY FULTON

DATE Dec. 1970

Newcomb

S. R. 109

WEATHER.

Knappe

Wise

SEC. PIKE TWP T-9-S TEMP.

DESCRIPTION

ALIGNMENT & CONTROLS

JOB NO.

LEFT

CENTER LINE

RIGHT

Ful Co. acquired 0.15 Ac. Apr. 1910
 40 rod x 10' See Vol. 83 p. 102

H. Schmitz

E-W 1/2 Sec. Line
 R. Durham

Abutting owners
 mutually built Catch
 Basin and 30" outlet
 pipe on E-W Line 1962
 see witnesses

Pinus Gillen

C. Havers

ctr. post, Sec. 34

Found old cor. post

West R/W Line A

Sec. Line 2

E.S.R. 109 7

2120.98' Tang

Ful Co. acquired 0.70 Ac. Apr. 1910
 112 rod x 4 rod See Vol. 93 p. 512

1848' Recorded.

POT Sta. 706+52.93

Est. 4" x 1/2" pipe

E Survey

E-W Line passes
 0.18' South of an iron
 A.P. used by abutting
 owners to form p.y.
 Iron A.P. is 21.1' Rt of
 E Survey.

Found and used good cane A.P. and
 good conc. cor. post plus old fence line
 to project line to ctr. post Sec. 34 -
 intersecting E.S.R. 109

Record

ctr. post, Sec. 35

PI Sta. 689+80.76 - est. 4" x 1/2" pipe

 $\Delta = 3^{\circ}00' \text{ Lt.}$

D - 2'

T - 75.02'

L - 150.00'

E - 0.97'

R - 2864.79'

P.C. Sta. 689+05.74 - est. PK

P.T. Sta. 690+55.74 - est. PK

Branch #2 of the
 North Branch of
 BAD CREEK

2645.17' Meas.

Sec. 34

Sec. 35

E.S.R. 109 7

571.23' Tang

25' R/W

25' R/W

180°

382.15' Tang

East R/W Line A

16.5' Sta. 688+06.21 - 30.68' Rt.

Sta. 688+05.44 - 14.19' Rt.

PI Sta. 685+98.65 - Est. 4" x 1/2" pipe

 $\Delta = 3^{\circ}00' \text{ Rt.}$

D - 2'

T - 75.02'

L - 150.00'

E - 0.97'

R - 2864.79'

P.C. Sta. 685+23.63 - Est. PK

P.T. Sta. 686+73.63 - Est. PK

5/4 post, Sec. 34

5/4 post, Sec. 35

Sec. 34

Sec. 3

Sec. 35

Sec. 2

Co. Rd. M 2

2646.27' Meas.

PI Sta. 680+07.42

 $\Delta = 0^{\circ}15' \text{ Lt.}$

PI Sta. 653+55.56

W 1/4 post, Sec. 2 Pike Twp T-10-S

PERSONNEL TITLE PERSONNEL TITLE
 Red Beach
 Newcomb
 Knappe
 Wise

COUNTY FULTON DATE Dec 1970
 S. R. 109 WEATHER
 SEC. PIKE - ROYALTON TEMP.



DESCRIPTION

CONTROL POINTS

JOB NO.

Cor. Sec. 34, 35 PIKE Twp T-9-S
 Cor. Sec. 26, 27 ROYALTON Twp



W 1/4 post Stone, Sec. 26 Royalton Twp.
 E 1/4 post Stone, Sec. 27 Royalton Twp

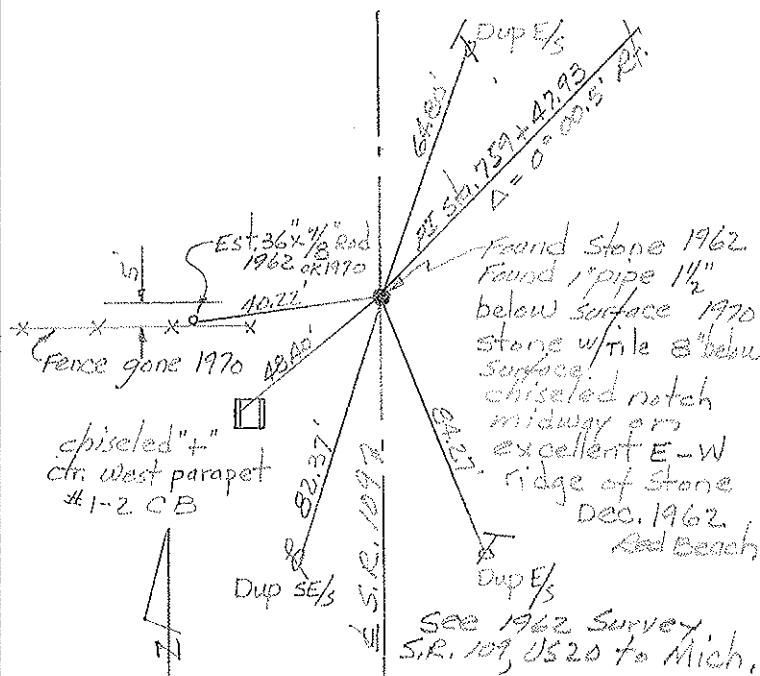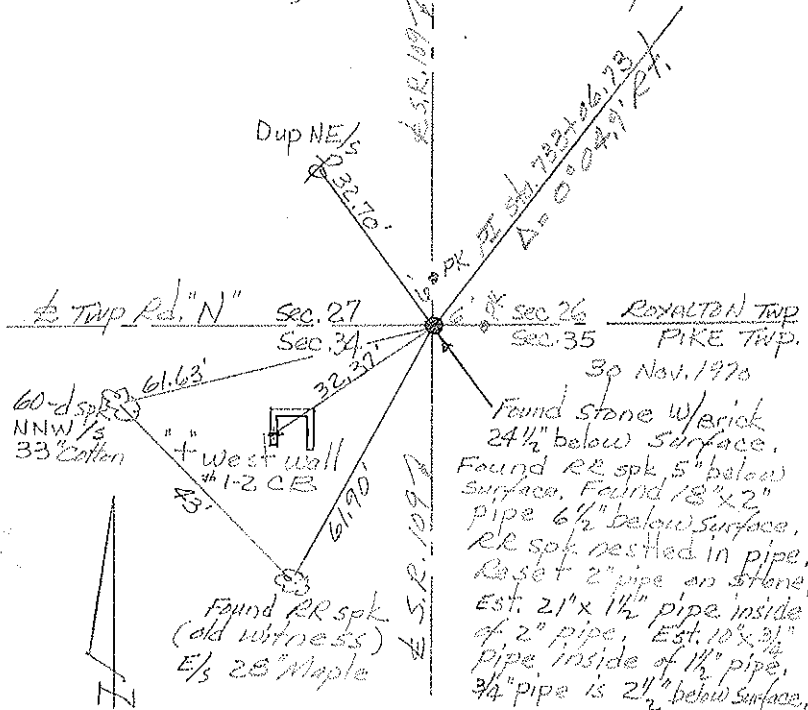

S 1/4 Post Stone, Sec. 26 ROYALTON TWP.
 N 1/4 Post Stone, Sec. 35 PIKE TWP. T-9-S

E 1/4 post, Sec. 34 PIKE TWP. T-9-S
 W 1/4 post, Sec. 35 PIKE TWP. T-9-S

stone measured precisely
 midway between sec. Cors.
 east & west, i.e.; 2652.8'
 each way, 1 Dec. 1970
 as recorded Vol. B/218
 1911

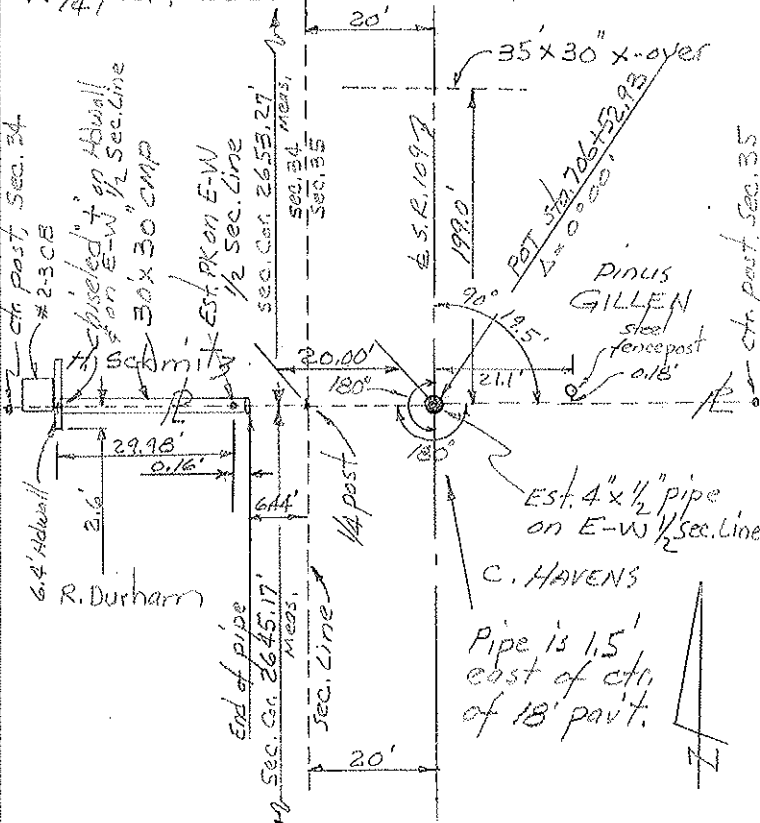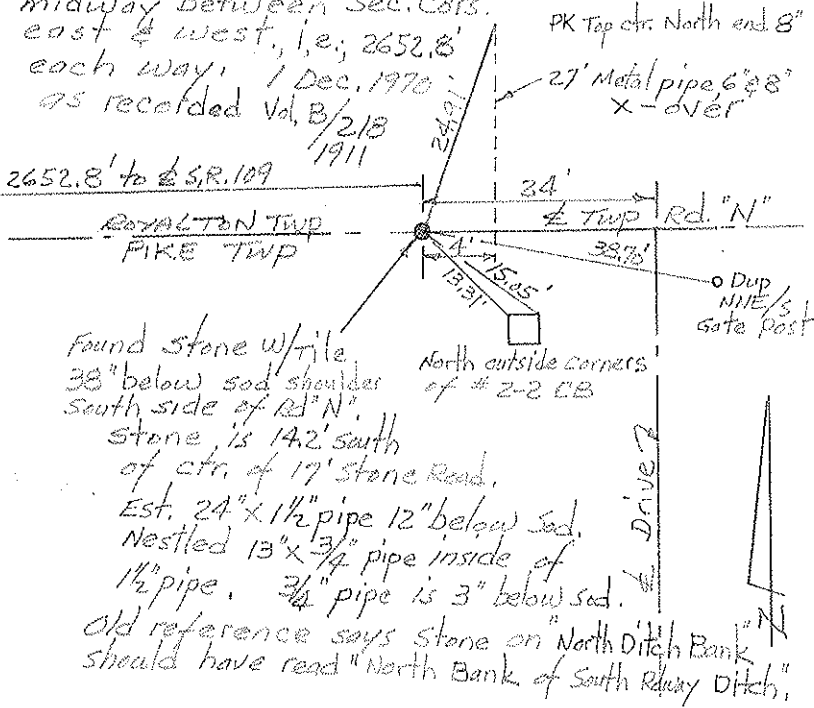


PERSONNEL	TITLE	PERSONNEL	TITLE
Rod Beach			
Newcomb			
Knappe			
Wise			


COUNTY	FULTON	DATE	Nov 1970
S. R.	109	WEATHER	
SEC.	PIKE - ROYALTON	TEMP.	

DESCRIPTION	CONTROL POINTS	JOB NO.
-------------	----------------	---------


S 1/4 Post, Sec. 27, ROYALTON TWP.
N 1/4 Post, Sec. 34, PIKE TWP.

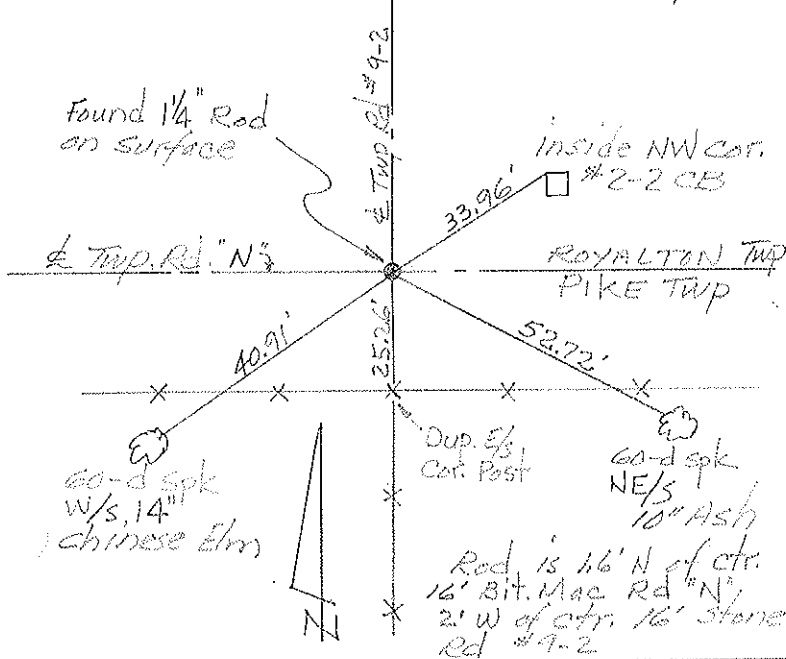

COR. Sec. 25, 26 ROYALTON TWP.
COR. Sec. 35, 36 PIKE TWP.

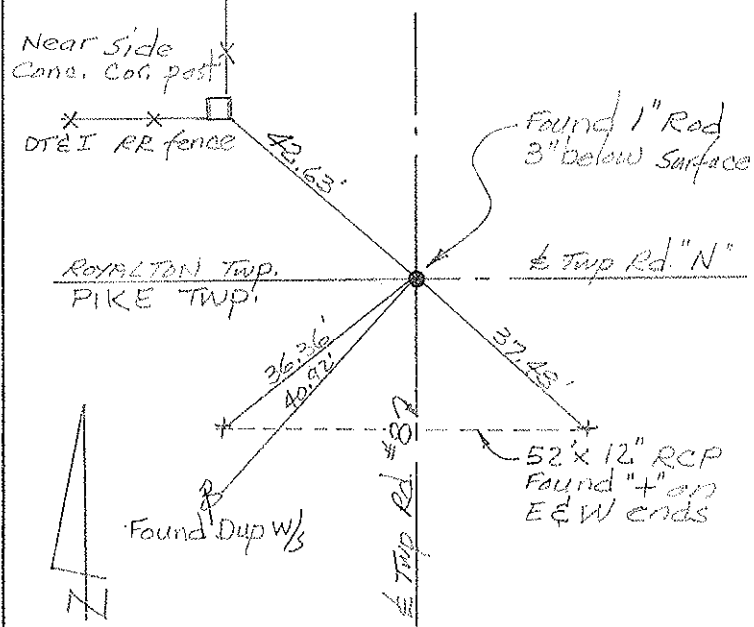

ctr. Post, Sec 27, ROYALTON TWP.

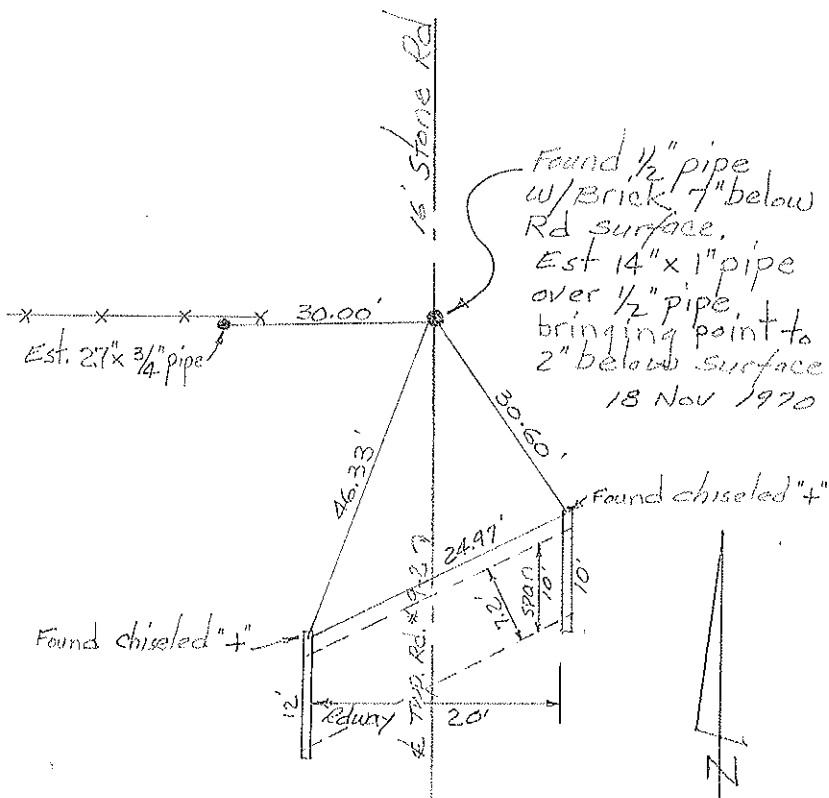

ctr. post, Sec. 26, ROYALTON TWP.

