

O.D.O.T. DISTRICT 2 SURVEY OFFICE (USE ONLY)

PERSONNEL

REFERENCE NO. 36-A

SHEET 27 OF 35

NOTES HUSS

DATE 06-18-12

ROUTE SR 109

H.C. HUSS

WEATHER FAIR/BREEZY

COUNTY FULTON

R.C. CANTERBURY

TEMP. 68°

TOWNSHIP PIKE

HARBAUGH

SECTION 35

COUTCHER

T 9 S R 3 E

TYPE MONUMENT SHANK


ON SURFACE - BELOW 0.1'

LEFT - Q PAV'T - RIGHT 4.6'

6.1' TO RT EDGE PAVEMENT

S.L.M. 710+25


Grid: Northing: 726404.450 Easting: 1548969.353

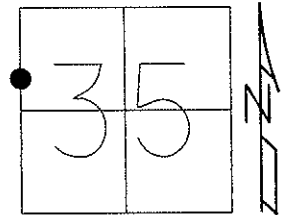

03-08-13 RESET MAG/WASHER, MC

06-18-12 GPS REF A36, SAH

03-08-13 GPS FIN A36, MC

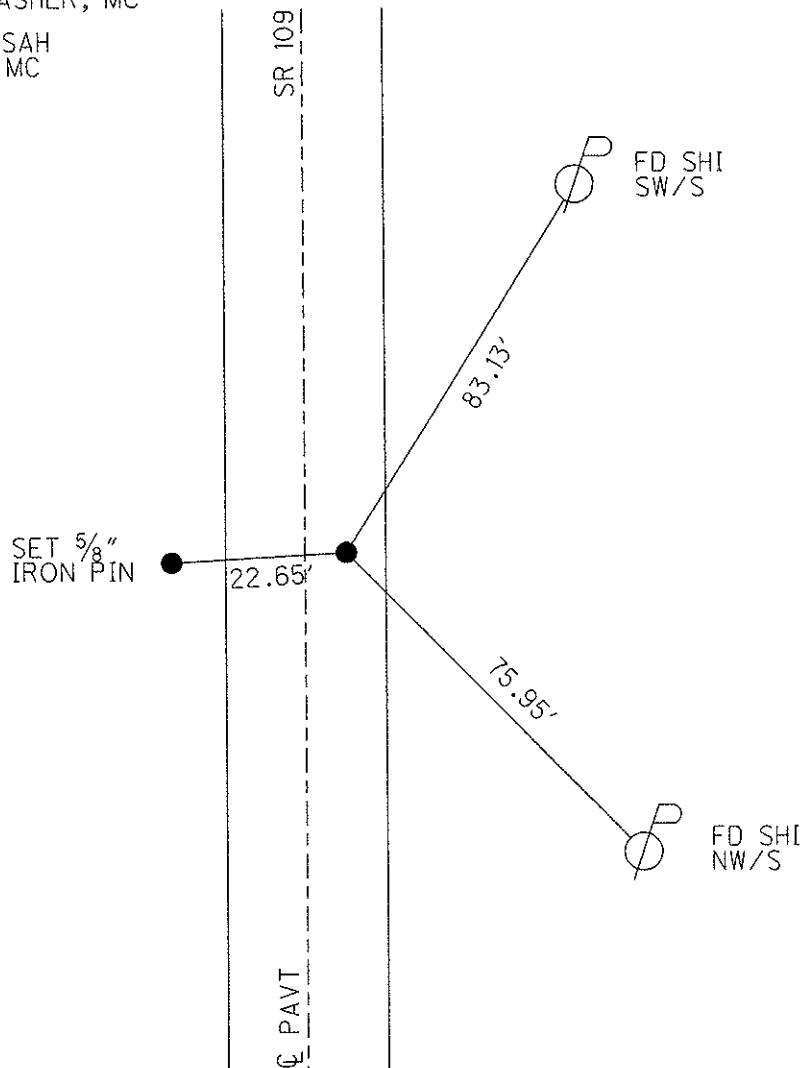

O.D.O.T. DISTRICT 2 SURVEY OFFICE

PERSONNEL

REFERENCE NO. 36-A

SHEET 23 OF 28

NOTES CANTERBURY

H.C. Rousos

R.C. CANTERBURY

DATE 9-3-96

WEATHER FAIR

TEMP. +80°

Reset P.K. / WASHER
9-29-97
C.L.

ROUTE S.R. 109

COUNTY FULTON

TOWNSHIP PIKE

SECTION 35

T 9 S R 3 E


TYPE MONUMENT PK / WASHER

ON SURFACE - ~~BELOW~~ YES

LEFT - ~~C~~ PAV'T. - RIGHT 1.44" RT 4

1.448 TO RT EDGE PAVEMENT

S.L.M. 21 + 669.3 (710 + 25)

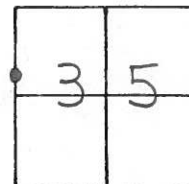

SET P.K. / WASHER IN FINAL COURSE

11/23/96. MRC. CLOUDY


☐ - CANTERBURY +32°F

H.C. - MOSER

R.C. - VAN DUSEN

SR 109

Q. PAV'T

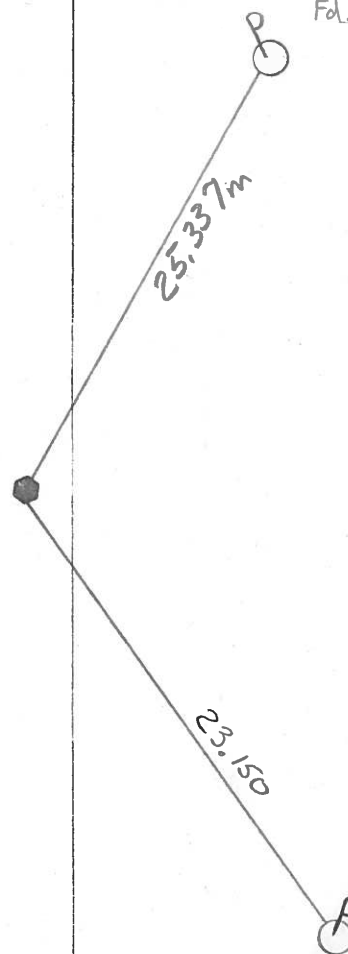

Fd. SHI. SW/S.

SET SHI. NW/S.

O.D.O.T. DISTRICT 2 SURVEY OFFICE

PERSONNEL

REFERENCE NO. 36-A

SHEET OF

NOTES BARNHISEL

H.C. " "

R.C. HOFFMAN

DATE 9-4-90

WEATHER CLEAR

TEMP. +85°

ROUTE 109

COUNTY Fulton

TOWNSHIP PIKE

SECTION 35

T 9 S R 3 E


TYPE MONUMENT Sm RR Spk

ON SURFACE - ~~BELOW~~ YES


~~LEFT - & PAV'T.~~ - RIGHT 4.6

5.5 TO RT EDGE PAVEMENT

S.L.M. 710+25

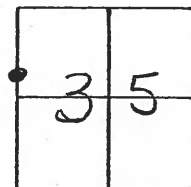

Set P.K. & In Asher
10-1-90
mB

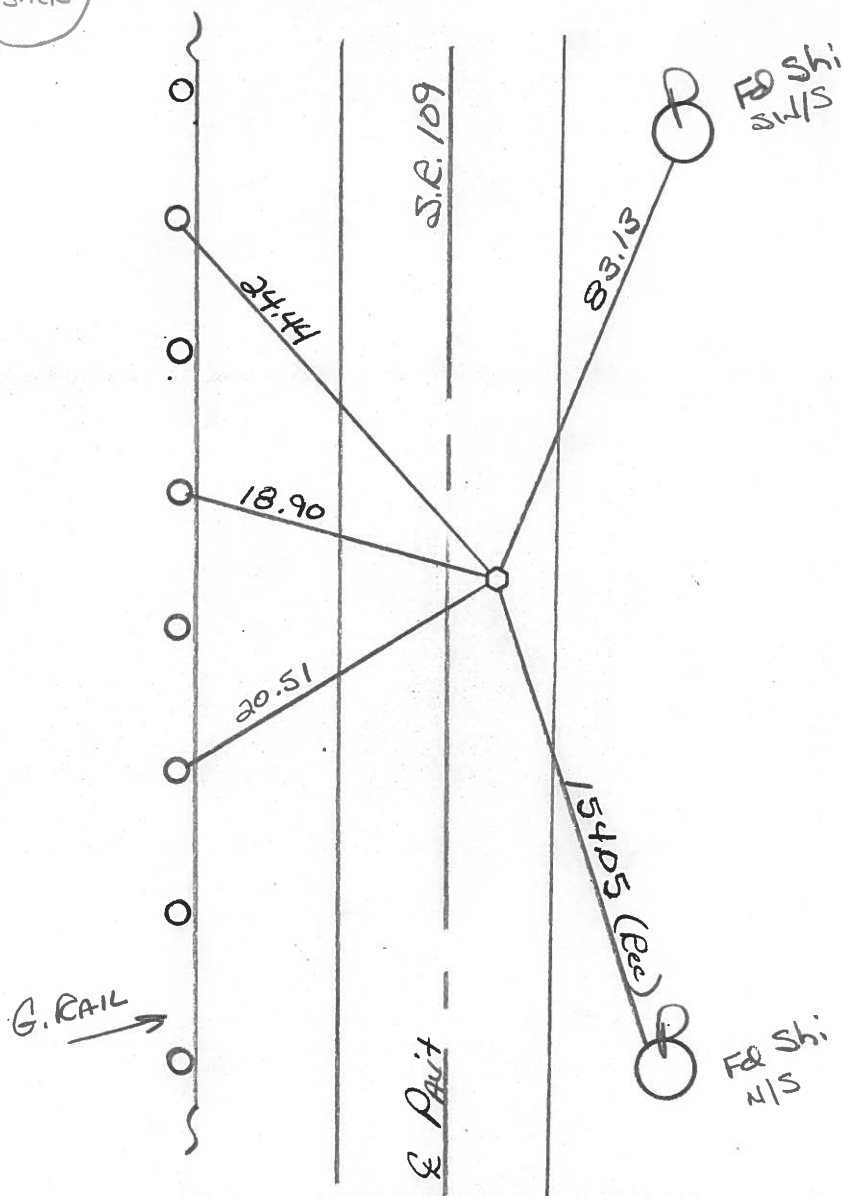

Q.D.O.T. DISTRICT 2 SURVEY OFFICE

SHEET 20 OF

County Fulton S.R. 109

Township Pike

Section 35

T N, R E

Personnel I. Stone

P. Nusser


R. Michalak

D. Curtis


Date 12 April 84

Weather Sunny

Temp. 52°

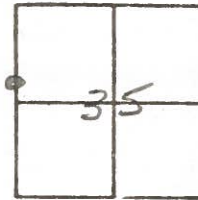

REF. NO. 36-A

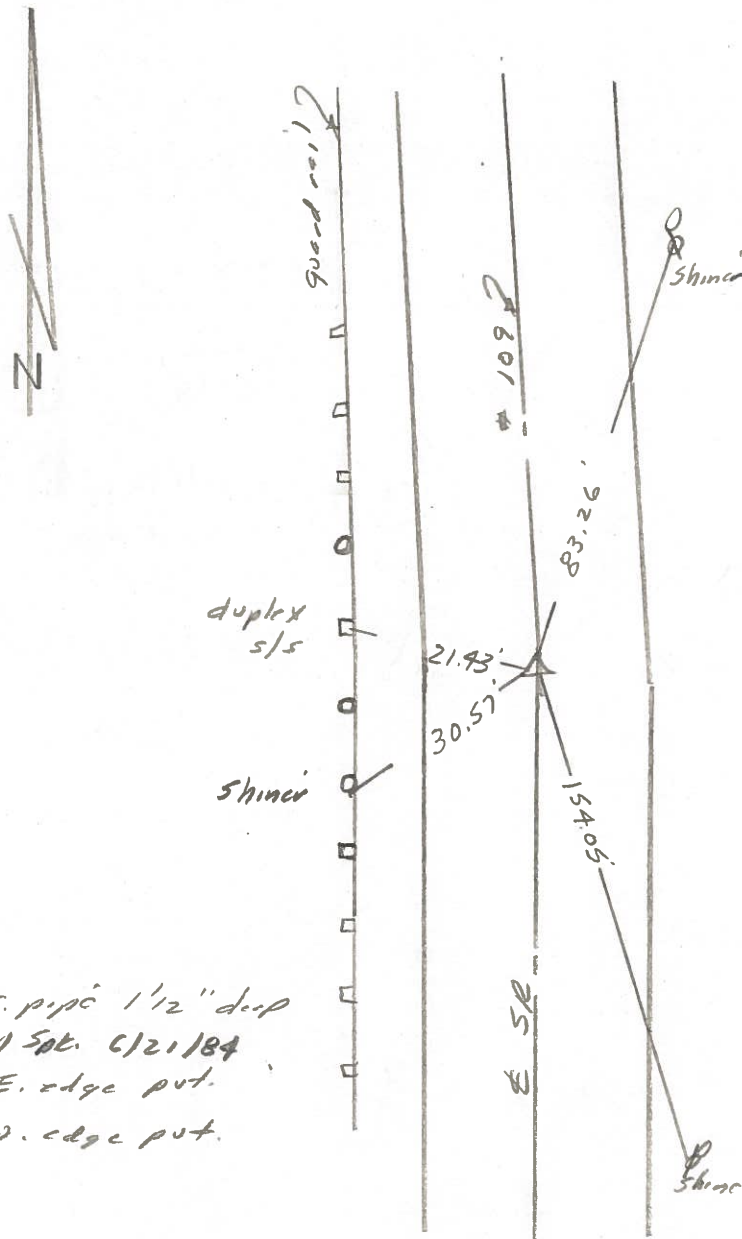

Fd 1/2" I. pipe 1 1/2" deep
Set Small Sp. 6/21/84
5.0' to E. edge put.
13.0' to W. edge put.

SHEET 20 OF

Date 12 April 84

Weather Sunny


Temp. 52°

N
A

R. Michalak

D. Curtis

REF. NO. 36-A

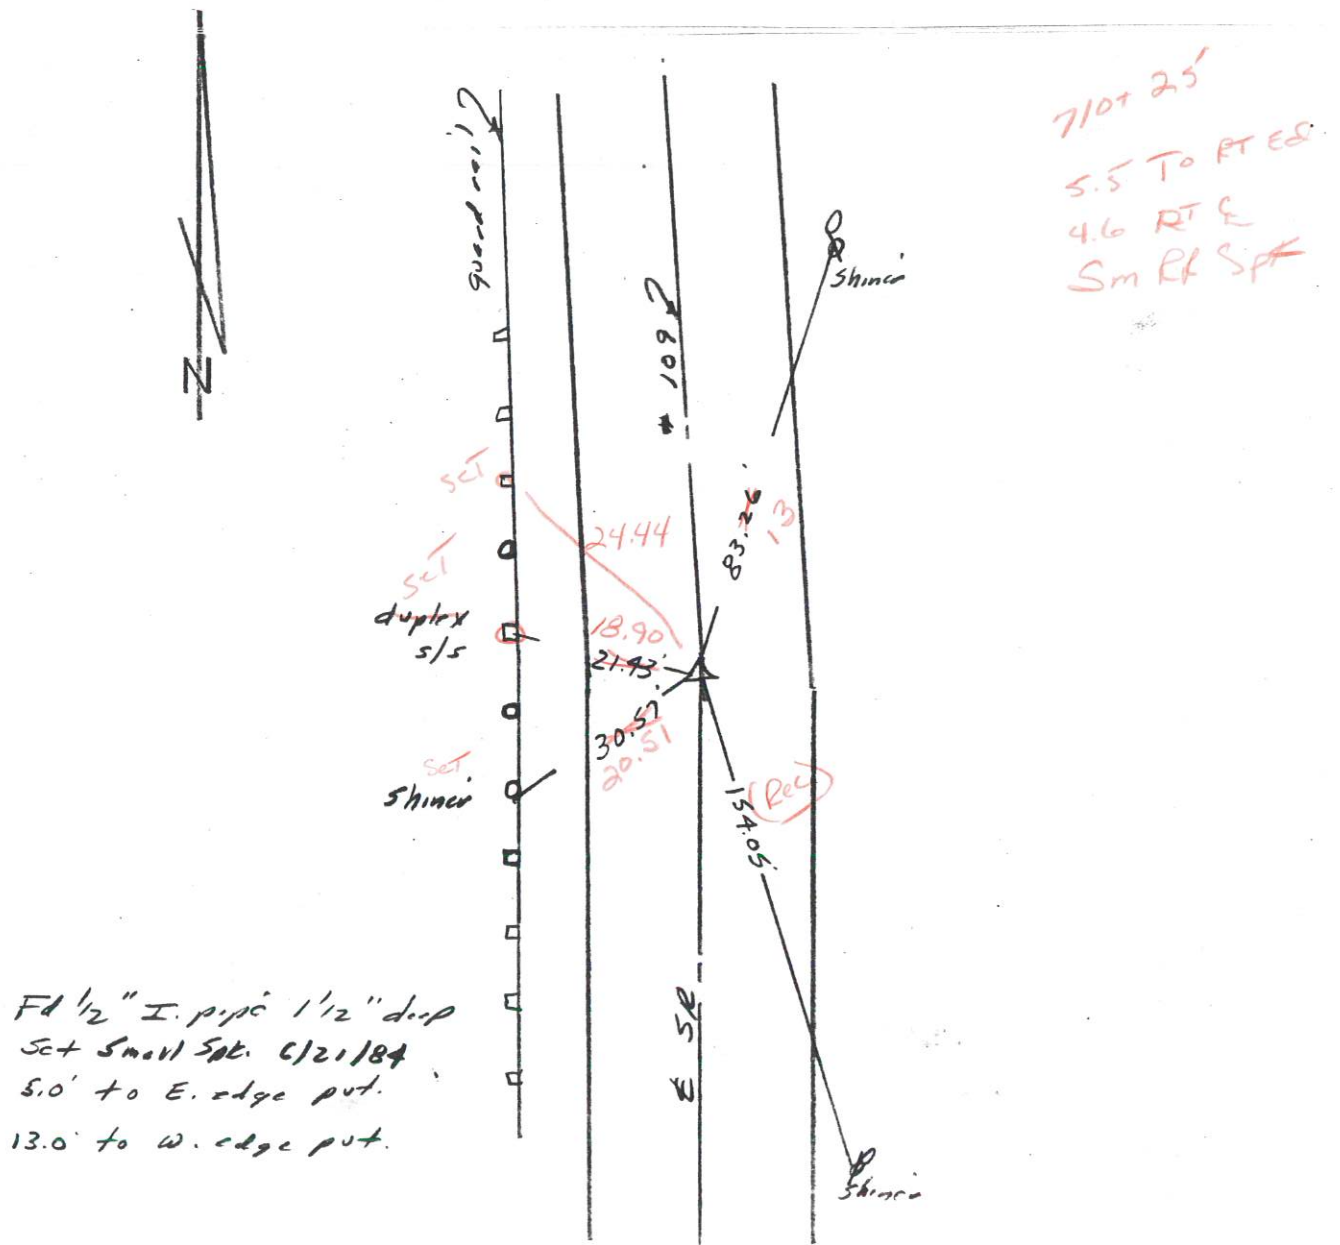


PERSONNEL	TITLE	PERSONNEL	TITLE
<u>Red Beach</u>			
<u>W. Knape</u>			

COUNTY Fulton DATE 24-25 Feb '77

S. R. 109 WEATHER _____


SEC. PIKE TWP TEMP. _____

CONTROL POINTS

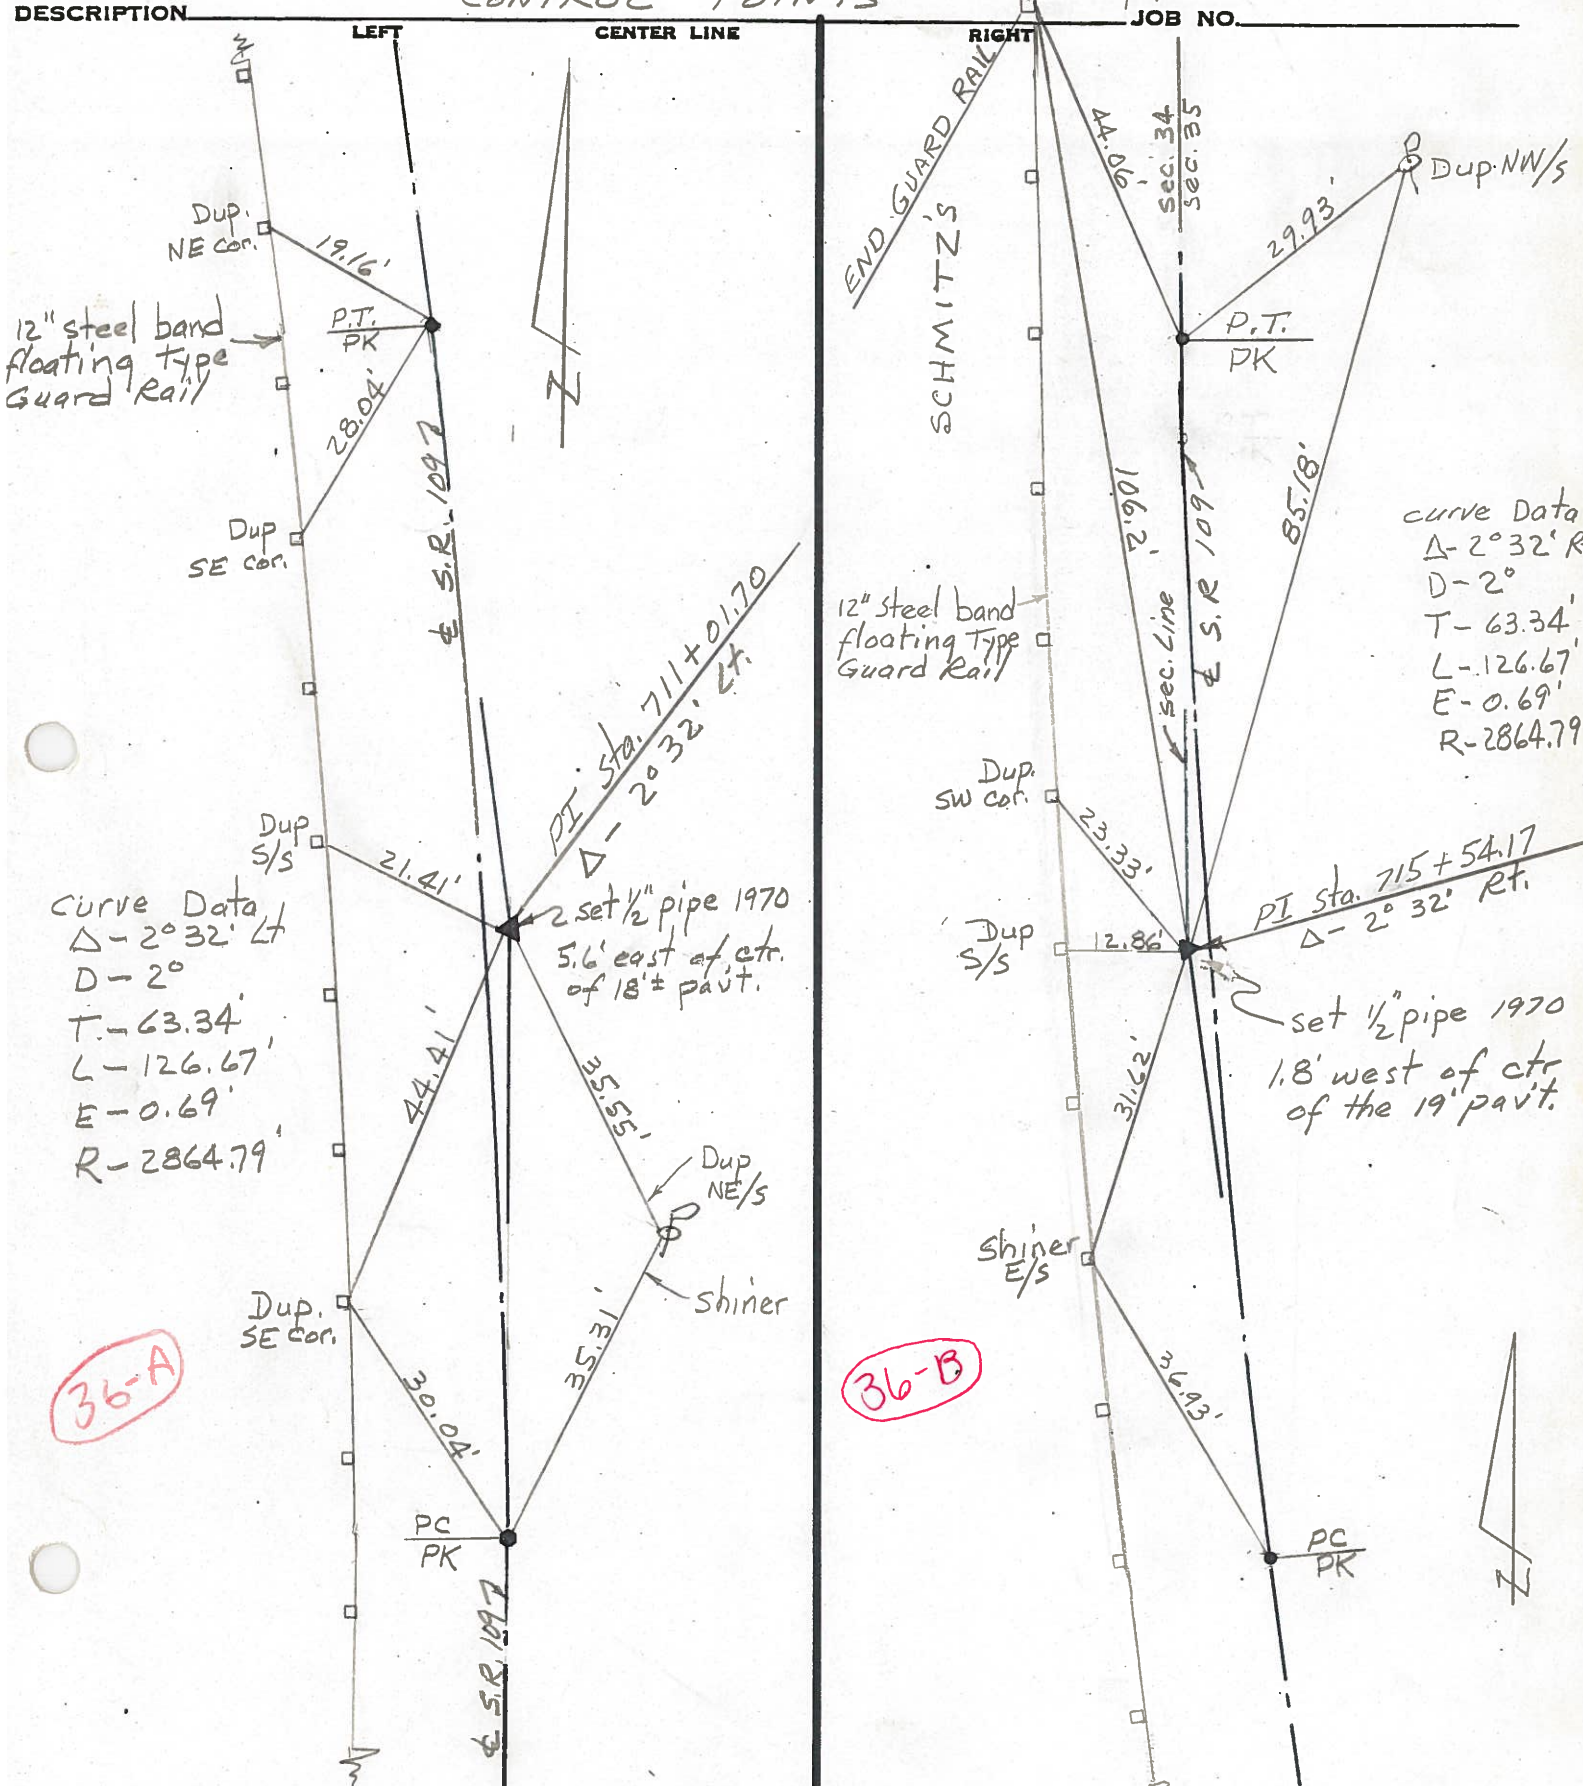

PERSONNEL	TITLE	PERSONNEL	TITLE	COUNTY	DATE	S. R.	WEATHER	SEC.	TEMP.
Tamsic		Boyle		Fulton	July 23, 1973	109		Royalton Twp.	
Newser									
Granata									
Wanyo									

DESCRIPTION	LEFT	CENTER LINE	RIGHT	JOB NO.
-------------	------	-------------	-------	---------

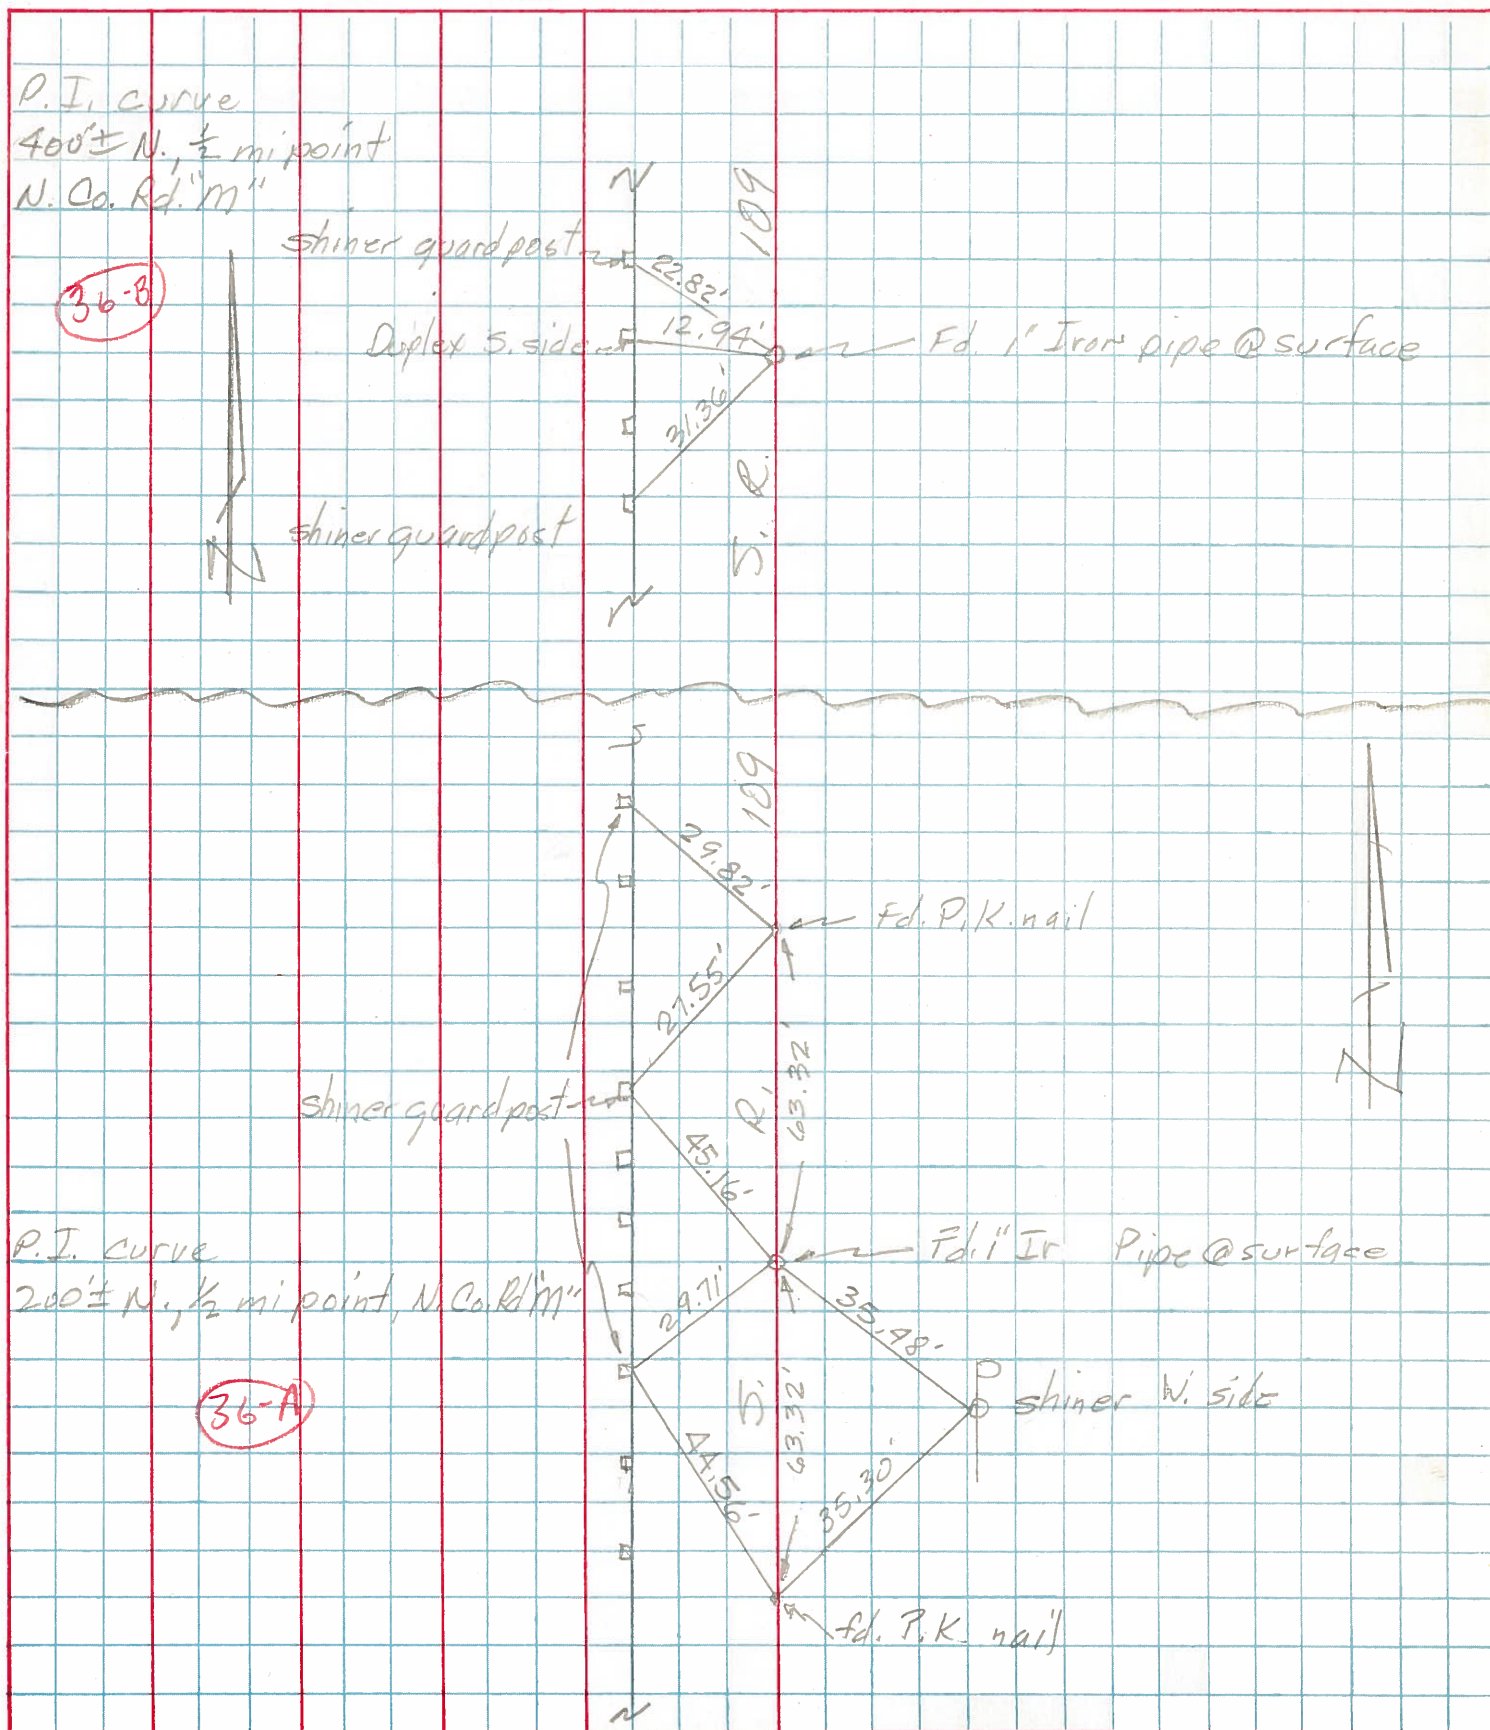

PERSONNEL TITLE PERSONNEL TITLE
 Red Beach
 Newcomb
 Knope
 Wise

COUNTY FULTON DATE Dec, 1970
 S. R. 109 WEATHER
 SEC PIKE TWP. 7-9-5 TEMP.

DESCRIPTION


ALIGNMENT & CONTROLS

JOB NO.

LEFT

CENTER LINE

RIGHT

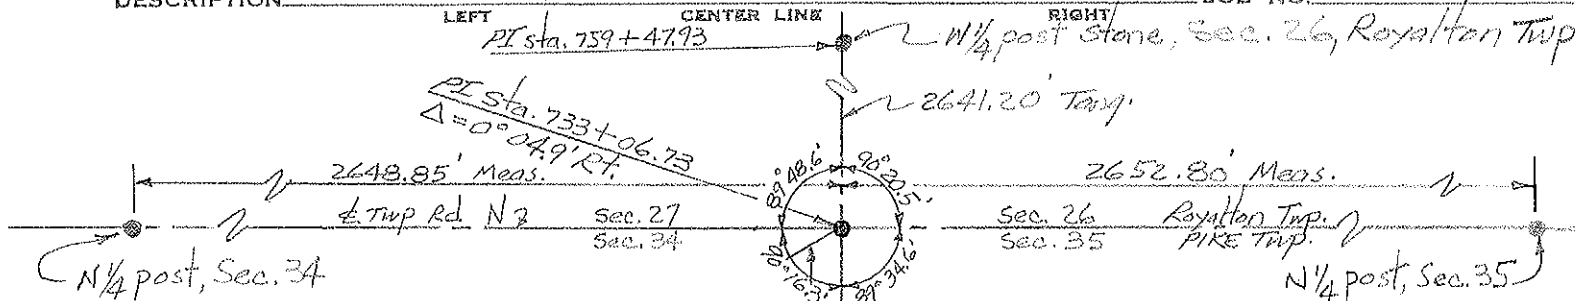

BRANCH #2 of the
 NORTH BRANCH of
 BAD CREEK

PI sta. 715+54.17-est. 4"x 1/2" pipe
 $\Delta = 2^\circ 32' \text{ Rt.}$
 $D = 2^\circ$
 $T = 63.34'$
 $L = 126.67'$
 $E = 0.69'$
 $R = 2864.79'$
 PC sta. 714+90.83-est. PK
 PT sta. 716+17.50-est. PK

PI sta. 711+01.70 est. 4"x 1/2" pipe
 $\Delta = 2^\circ 32' \text{ Lt.}$
 $D = 2^\circ$
 $T = 63.34'$
 $L = 126.67'$
 $E = 0.69'$
 $R = 2864.79'$
 PC sta. 710+38.36-est. PK
 PT sta. 711+65.03-est. PK

E-W 1/2 Sec. Line
 See sheet #6

POT sta. 706+52.93
 Est. 4"x 1/2" pipe & Sur.

PI sta. 689+80.76
 $\Delta = 3^\circ 00' \text{ Lt.}$

Pinus Gillen
 Clayton Havenis