

O.D.O.T. DISTRICT 2 SURVEY OFFICE (USE ONLY)

PERSONNEL

REFERENCE NO. 36-B

SHEET 28 OF 35

NOTES HARBAUGH

DATE 06-25-12

ROUTE SR 109

H.C. HUSS

WEATHER FAIR

COUNTY FULTON

R.C. COUTCHER

TEMP. 68°

TOWNSHIP PIKE

SECTION 35

T 9 S R 3 E

TYPE MONUMENT PK/WASHER


ON SURFACE - BELOW 0.1'

LEFT - Q PAV'T - RIGHT 3.8'

6.0' TO LT EDGE PAVEMENT


S.L.M. 716+78

Grid: Northing: 726856.335 Easting: 1548945.965

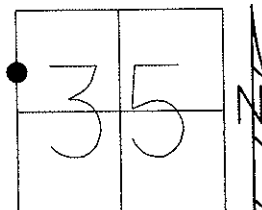

11-23-96 SET PK/WASHER
IN LEVELING COURSE, MRC
03-08-13 RESET MAG/WASHER, MC

06-25-12 GPS REF B36, SAH
03-08-13 GPS FIN B36, MC

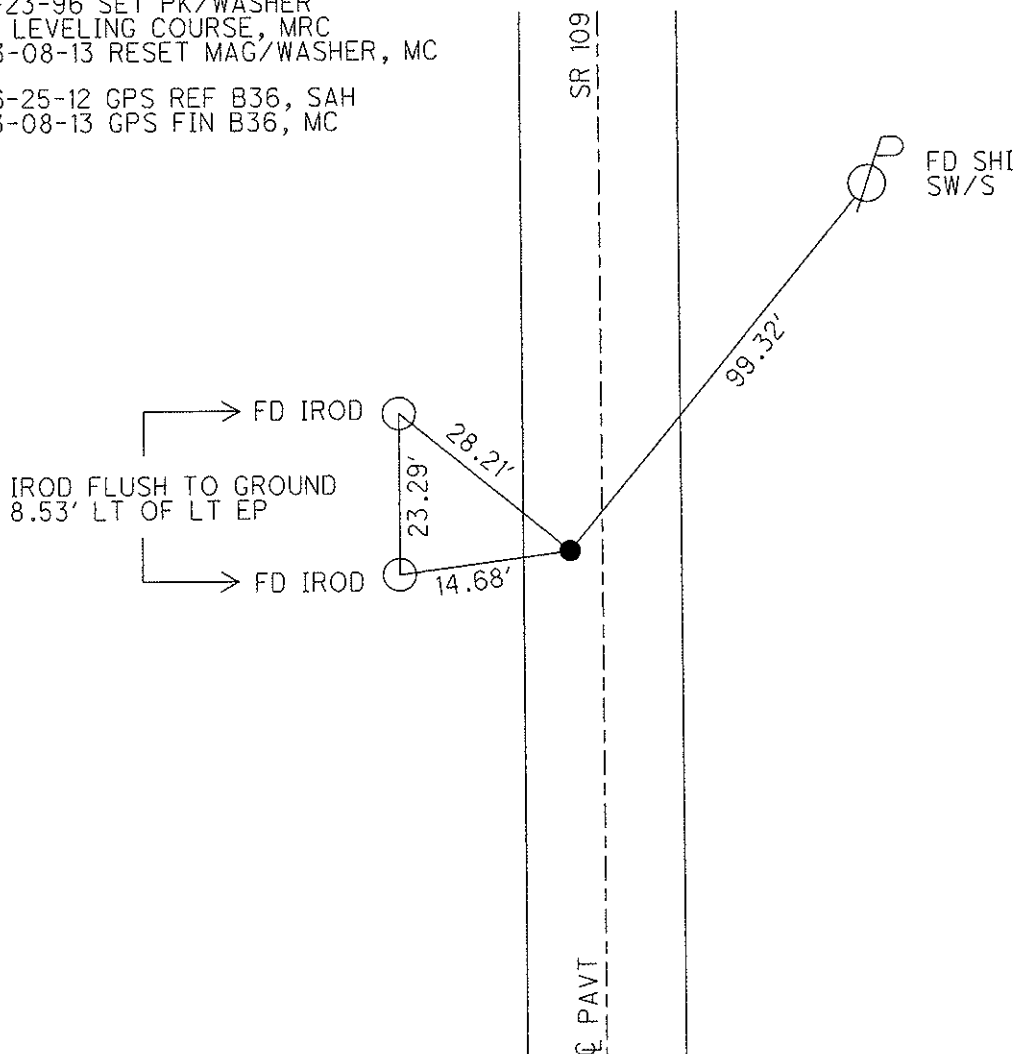

O.D.O.T. DISTRICT 2 SURVEY OFFICE

PERSONNEL _____

REFERENCE NO. 36-B

SHEET 24 OF 28

NOTES CANTERBURY

H.C. Rouses

R.C. CANTERBURY

DATE 9-3-96

WEATHER FAIR

TEMP. +80°

ROUTE S.R. 109

COUNTY FULTON

TOWNSHIP PIKE

SECTION 35

T 9 S R 3 E

Reset
10-6-97
C.L.


TYPE MONUMENT P.K. / WASHER

ON SURFACE - BELOW Yes


LEFT - LT PAV'T. - RIGHT 1.04 LT 2

1.705 TO LT EDGE PAVEMENT

S.L.M. 21 + 807 (716 + 78)

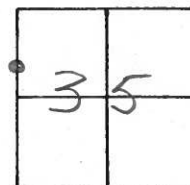

SET P.K. / WASHER IN LEVELING
Course 11/23/96. MRC.

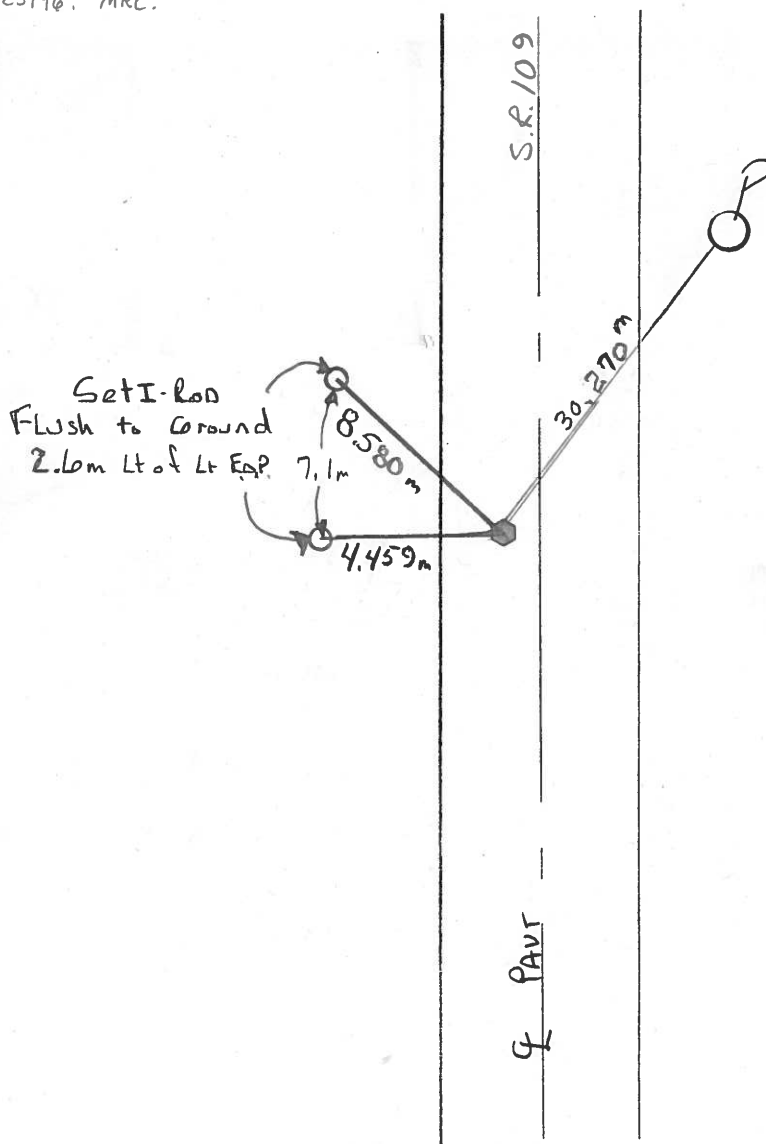

O.D.O.T. DISTRICT 2 SURVEY OFFICE

PERSONNEL

REFERENCE NO. 36-B

SHEET OF

NOTES BARNHISEL

H.C. " "

R.C. HOFFMAN

DATE 9-4-90

WEATHER CLEAR

TEMP. +85°

ROUTE 109

COUNTY Fulton

TOWNSHIP PIKE

SECTION 35

T 9 S R 3 E


TYPE MONUMENT Sm RR Spk

ON SURFACE - BELOW YES


LEFT - C PAV'T. - RIGHT 3.7

6.0 TO LT EDGE PAVEMENT

S.L.M. 716 + 78

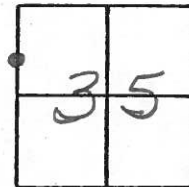

Set P.K. & Washers
10-1-90
MB

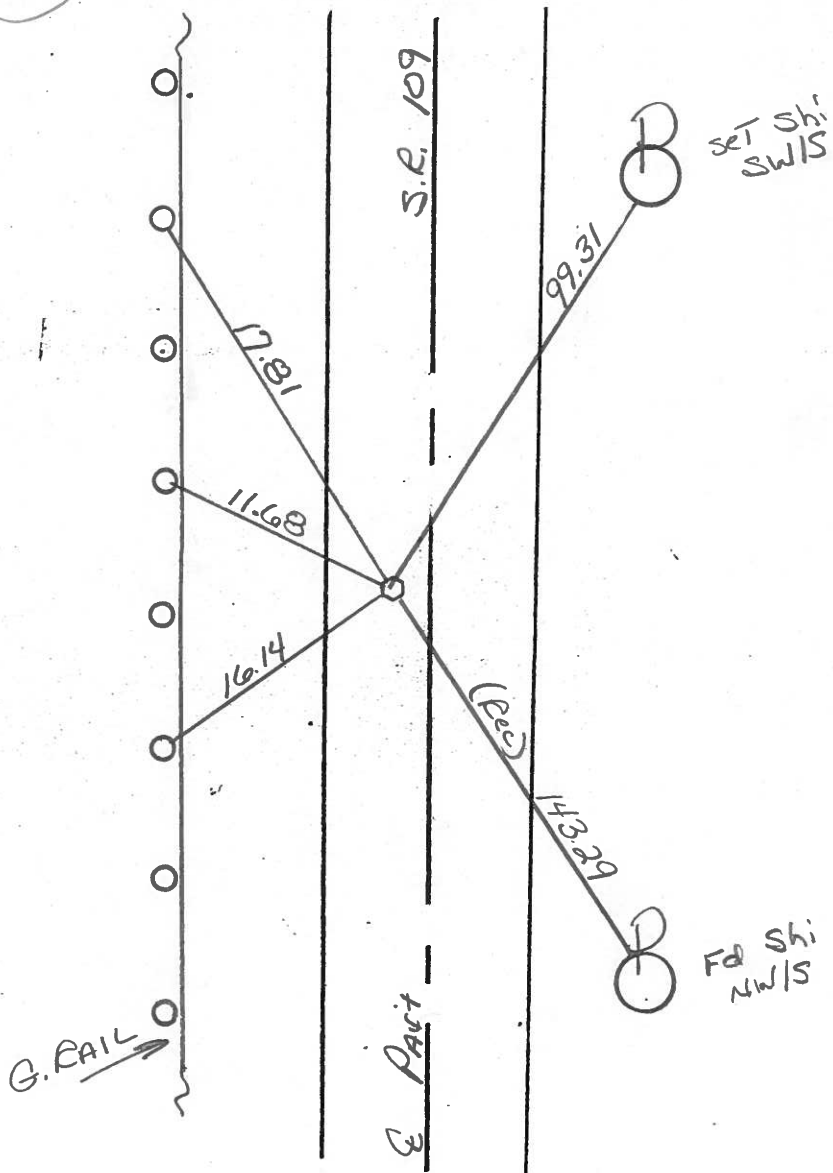

Q.D.O.T. DISTRICT 2 SURVEY OFFICE

SHEET 21 OF

County Fulton S.R. 109

Township Pike

Section 35

T N, R E

Personnel L. Stone

P. Neuse


R. Michalak

D. Curtis

Date 12 April 84


Weather Sunny

Temp. 52°

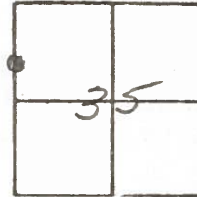

REF. NO. 36-18

715493

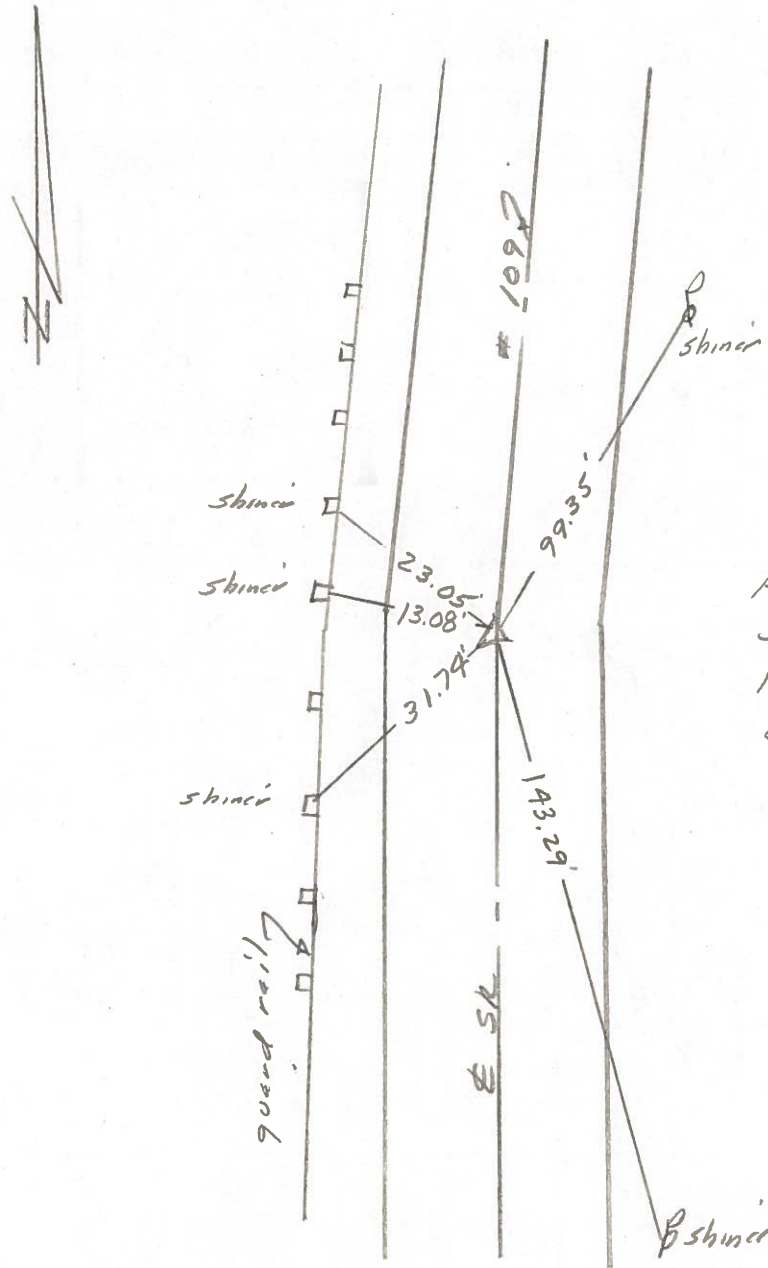

Fd 1/2" I.P. pipe 1 1/2" deep
Set Small spike 6/21/83
12.9' to E. edge put
6.0' to W. edge put.

Q.D.O.T. DISTRICT 2 SURVEY OFFICE

SHEET 21 OF

County Fulton S.R. 109

Township Pike

Section 35

T_N, R_E

Personnel L. Stone

P. Neuse


R. Michalak

D. Curtis

Date 12 April 84

Weather Sunny

Temp. 52°

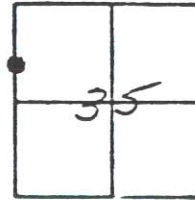


REF. NO. 36-KB

716+78

Sm RE Spk

3.7 LT E

6.0 TO LTED

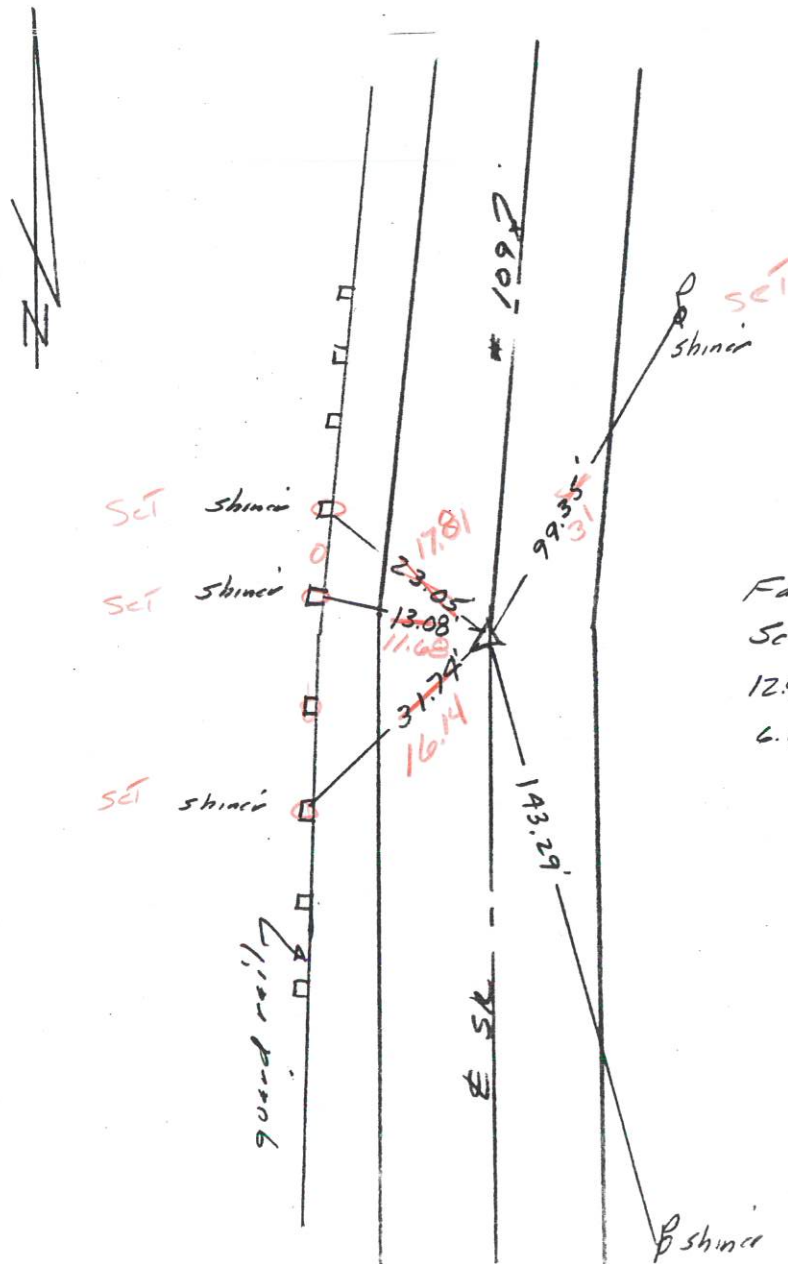

Fd 1/2" I. Pipe 1 1/2" deep
Set Small Spk. 6/21/83
12.9' to E. edge put
6.0' to W. edge put.

PERSONNEL TITLE PERSONNEL TITLE

Red BeachCOUNTY FultonDATE 24-25 Feb '77W. KnappeS. R. 109

WEATHER


SEC. PIKE TWP

TEMP.

DESCRIPTION

CONTROL POINTS

JOB NO.

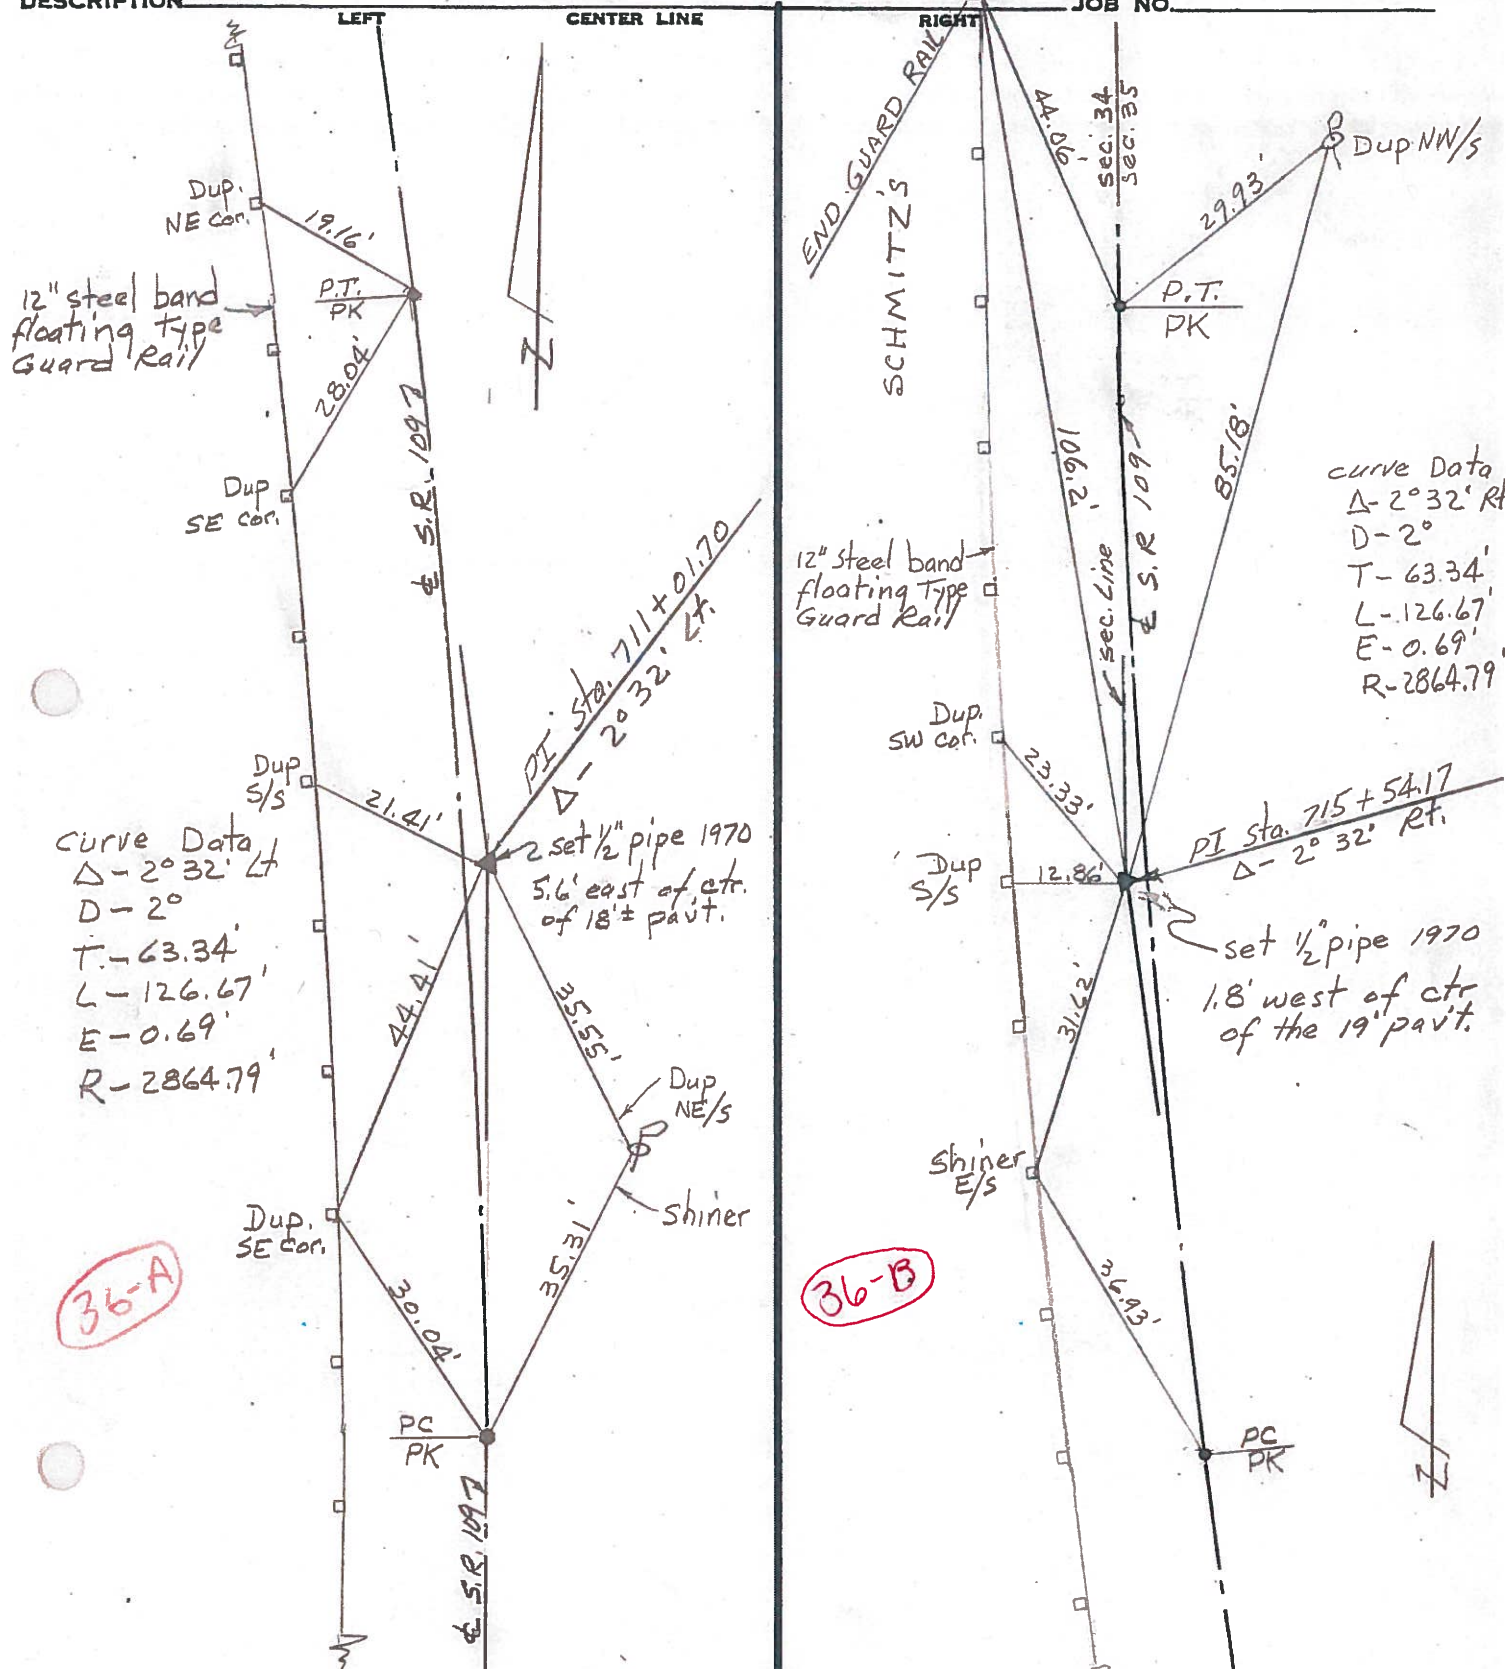

PERSONNEL	TITLE	PERSONNEL	TITLE	COUNTY	DATE
Tamsir		Boyle		Fulton	JULY, 23, 1973
Neuser				S. R. <u>109</u>	WEATHER
Granata				SEC. <u>Royalton Twp</u>	TEMP.
Vanya					

DESCRIPTION	LEFT	CENTER LINE	RIGHT	JOB NO.
-------------	------	-------------	-------	---------

