

O.D.O.T. DISTRICT 2 SURVEY OFFICE (USE ONLY)

PERSONNEL

REFERENCE NO. 37

SHEET 29 OF 35

NOTES HUSS, HARBAUGH

DATE 06-25-12

ROUTE SR 109

H.C. HUSS

WEATHER FAIR

COUNTY FULTON

R.C. COUTCHER

TEMP. 68°

TOWNSHIP PIKE

SECTION 35

T 9 S R 3 E

TYPE MONUMENT PK/WASHER


ON SURFACE - BELOW ON

LEFT - Q PAV'T - RIGHT 1.0'

- TO - EDGE PAVEMENT


S.L.M. 733+30

Grid: Northing: 728608.730 Easting: 1548932.951

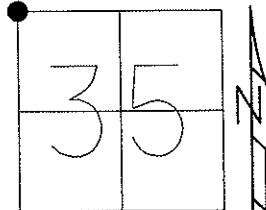

11-23-96 SET PK/WASHER
IN LEVELING COURSE, MRC
02-28-13 SET MAG/WASHER, MC

06-25-12 GPS REF 37, SAH
03-08-13 GPS FIN 37, MC

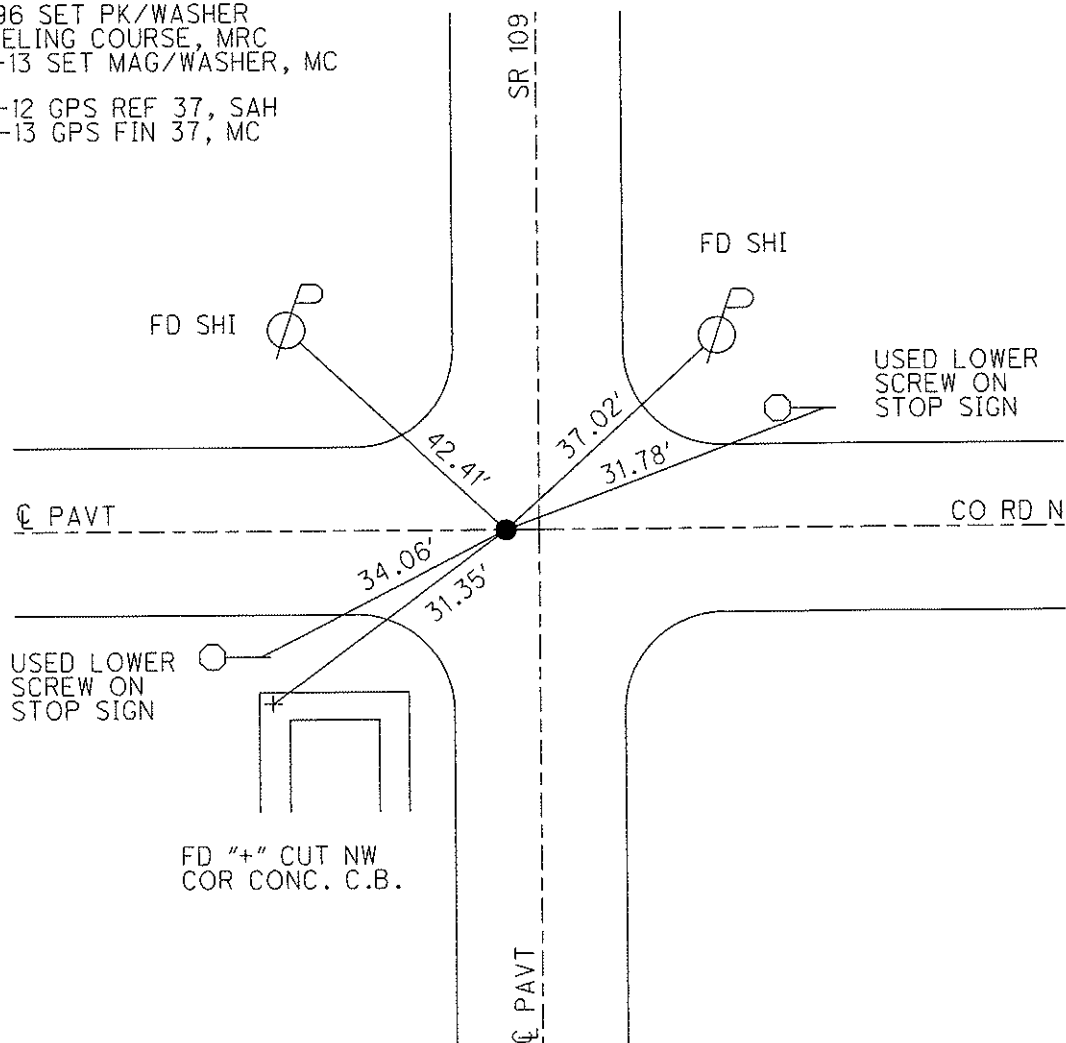

O.D.O.T. DISTRICT 2 SURVEY OFFICE

PERSONNEL

REFERENCE NO. 37

SHEET 25 OF 28

NOTES CANTERBURY

H.C. Rousos

R.C. CANTERBURY

DATE 9-3-96

WEATHER FAIR

TEMP. +80°

Reset P.K. / WASHER

9-29-97

C.L.

ROUTE S.R. 109

COUNTY FULTON

TOWNSHIP Pike

SECTION 35

T 9 S R 3 E


TYPE MONUMENT P.K. / WASHER

ON SURFACE - BELOW Yes

LEFT- & PAV'T. - RIGHT 0.33 LT &

— TO — EDGE PAVEMENT


S.L.M. 22+340.40 (733+30)

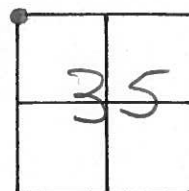

SET P.K. / WASHER IN LEVELING
COURSE. 11/23/96. MRC.

NOTE: PK HEAD BROKE - SHANK STILL IN PAVT

1.0' N. of & Pavt West

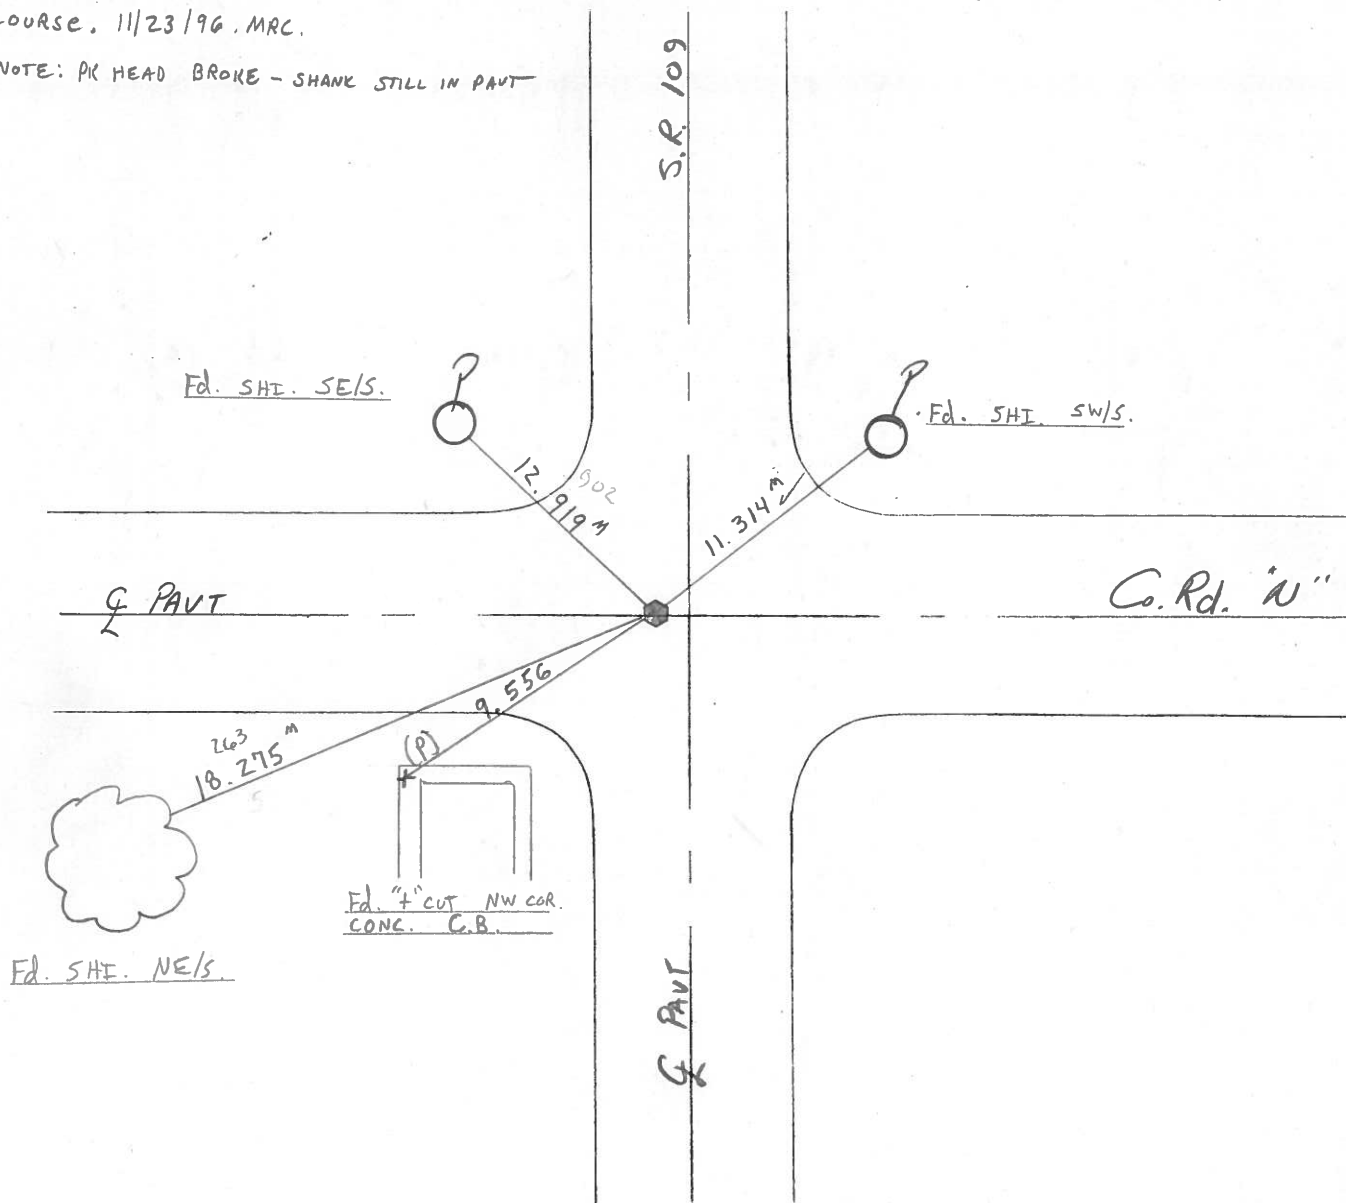

O.D.O.T. DISTRICT 2 SURVEY OFFICE

PERSONNEL

REFERENCE NO. 37

SHEET OF

NOTES BARNHISEL

H.C.

R.C. HOFFMAN

DATE 9-4-90

WEATHER CLEAR

TEMP. +85°

ROUTE 109

COUNTY FULTON

TOWNSHIP Royalton & Pike

SECTION N.W. Cor. 35

T 9 S R 3 E

TYPE MONUMENT Sm RR Spk

ON SURFACE - BELOW yes

LEFT- & PAV'T. - RIGHT 0.8

- TO - EDGE PAVEMENT

S.L.M. 733+30


1.0 N. OF & Pav't West

ROYALTON
PIKE

27	26
34	35



Set P.K. & Washer
10-1-90
mB

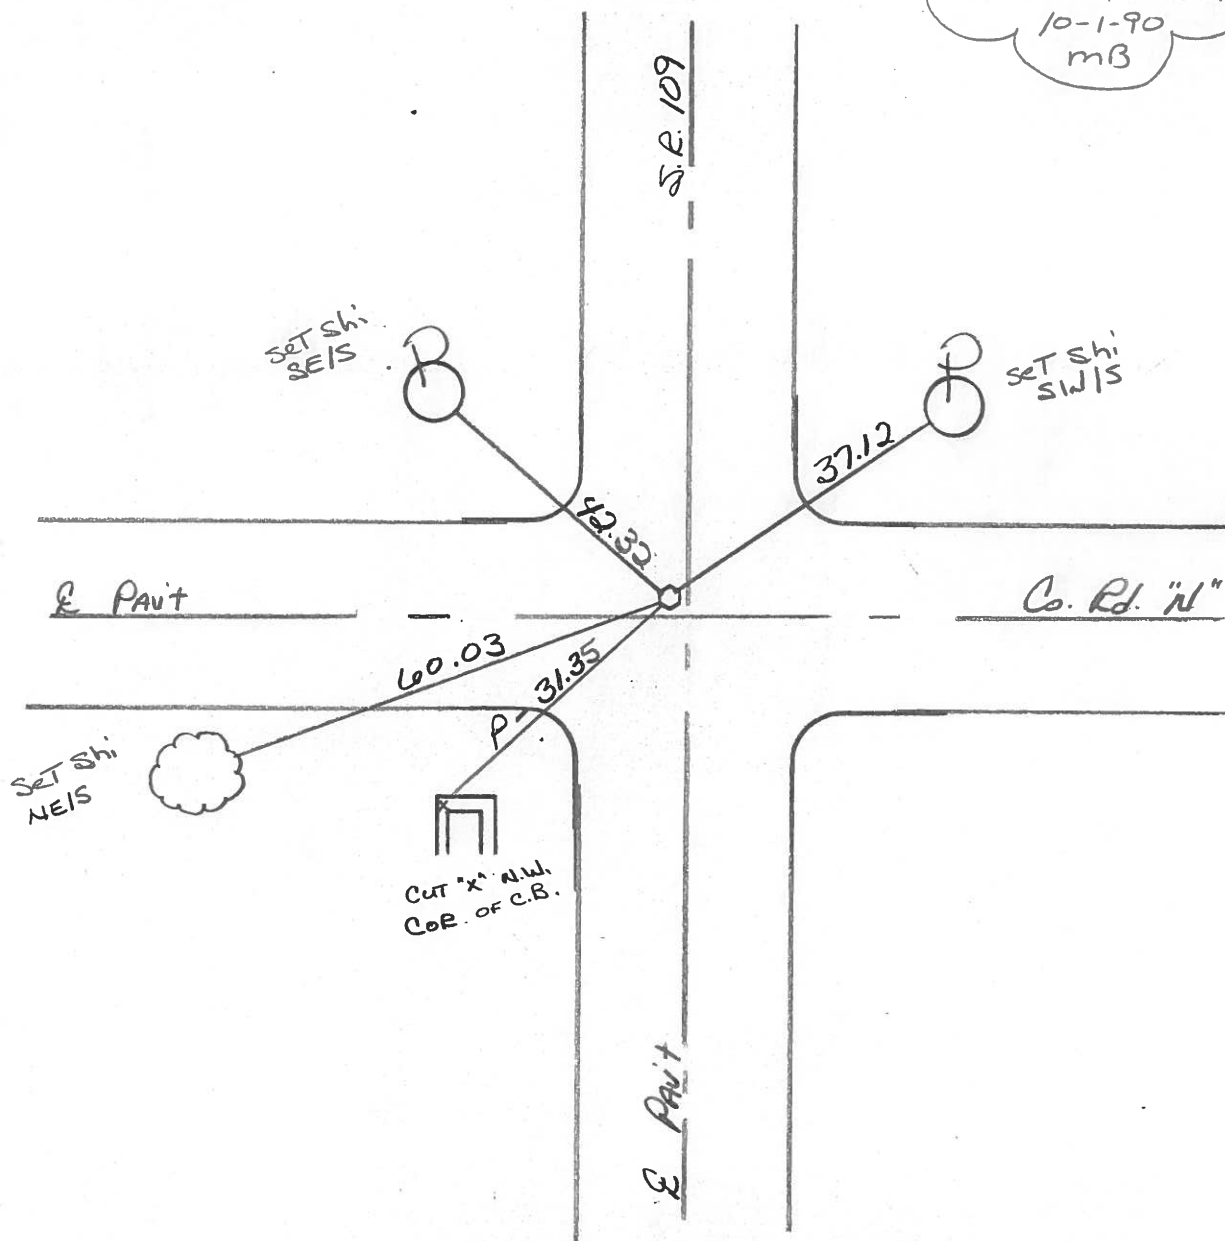

ROAD "10" BETWEEN R^oM" & R^oN"

63

PERSONNEL


TITLE

SEC. 33, 34 T-9-S R-3-E

CORNER 1/4 CORNER TWP. PIKE

DATE 10-21-88 WEATHER OVERCAST, Lt. RAIN @

DESCRIPTION: REFERENCED EXISTING 1/2" x 30" I. ROD SET FOR 1/4 CORNER. I. ROD ESTABLISHED E
J. METZGER & D. MAXSON ON LINE AND MEDWAY BETWEEN SECTION CORNERS.
SET PK NAILS 4' NE & SE

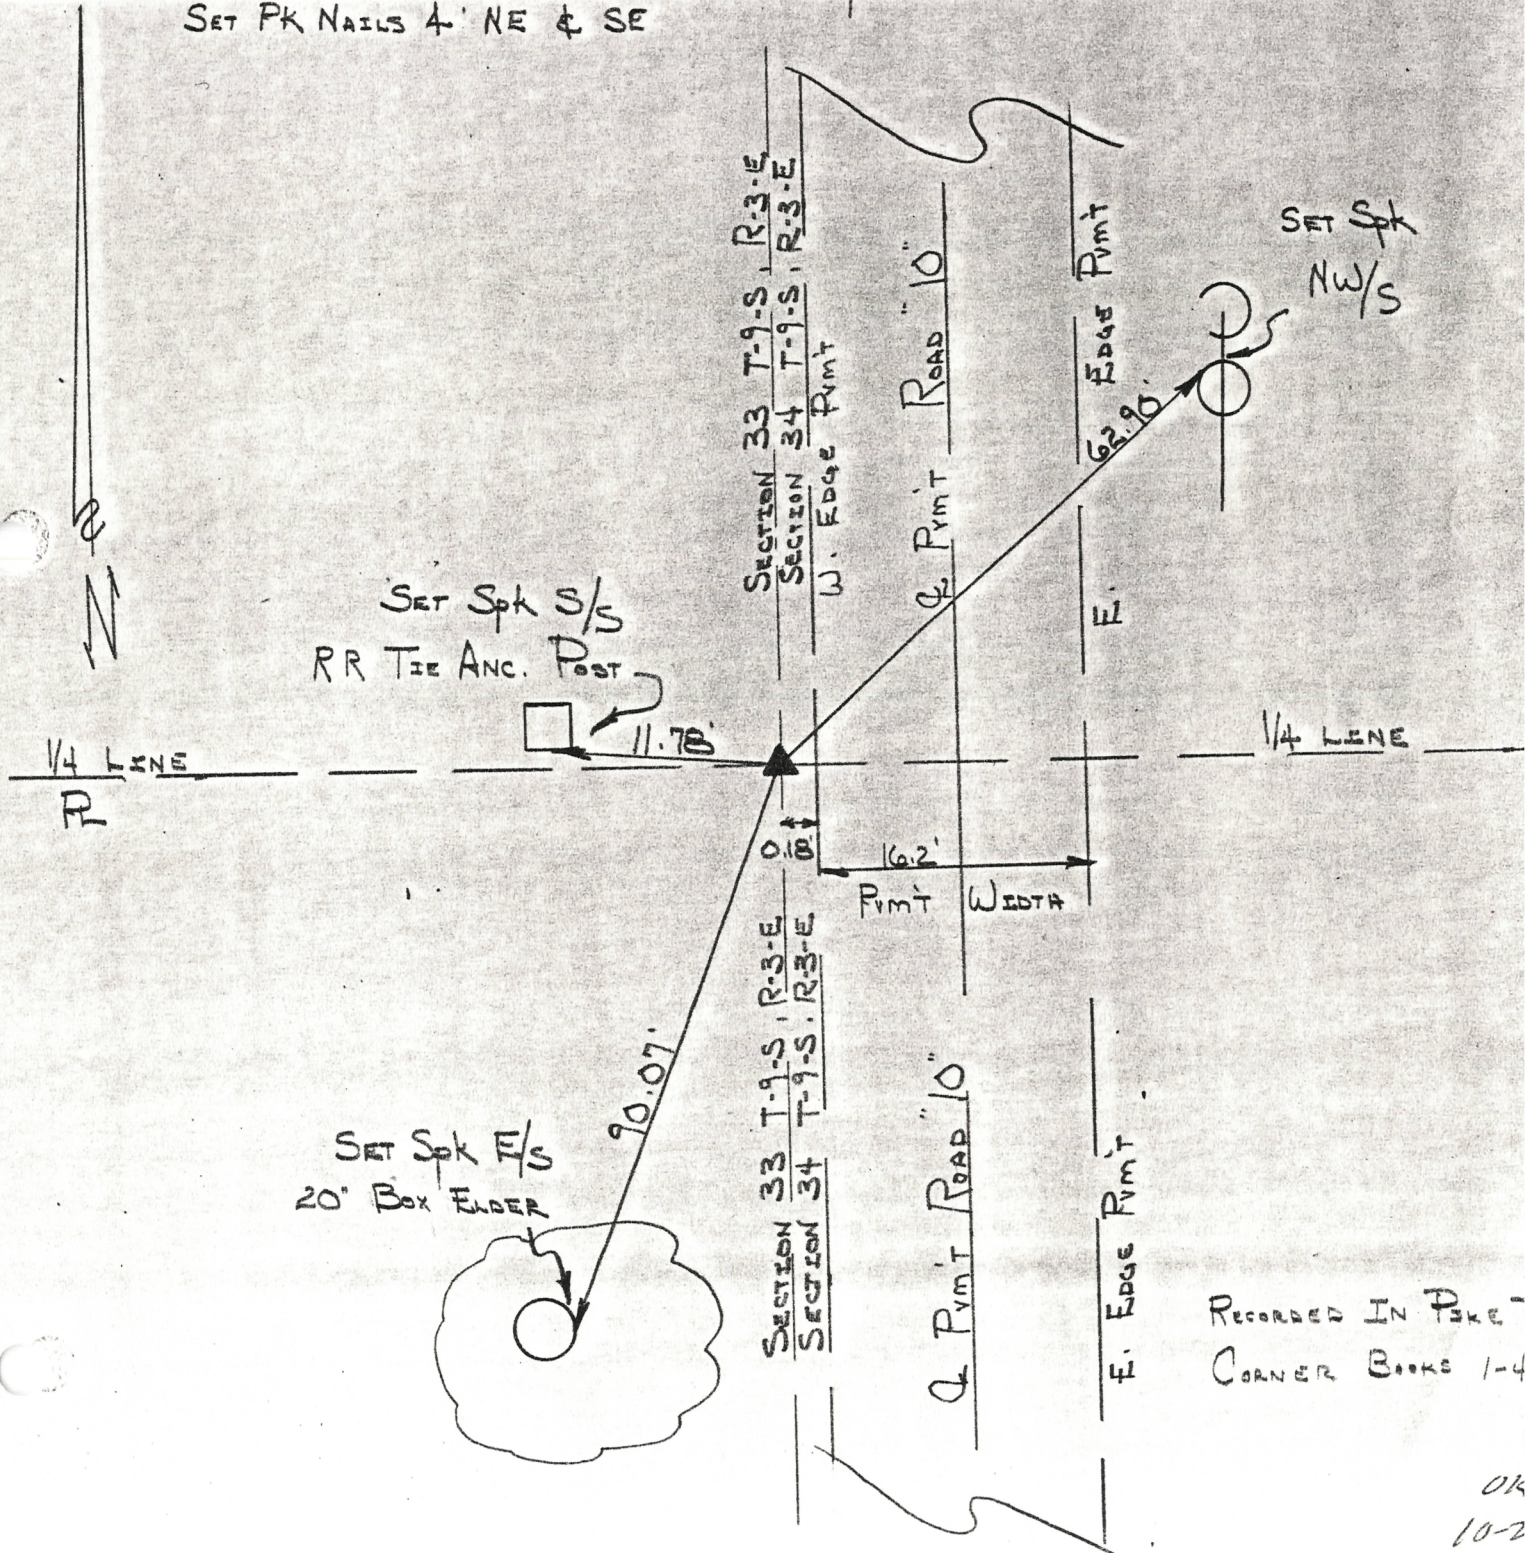

RECORDED IN PIKE -
CORNER BOOKS 1-4

OK
10-2

SHEET 22 OF

Date 12 April 84

Weather Sunny

Temp. 53°

27	26
34	35


N
A

P. Nurse


R. Michalek

D. Curtis

REF. NO. 37

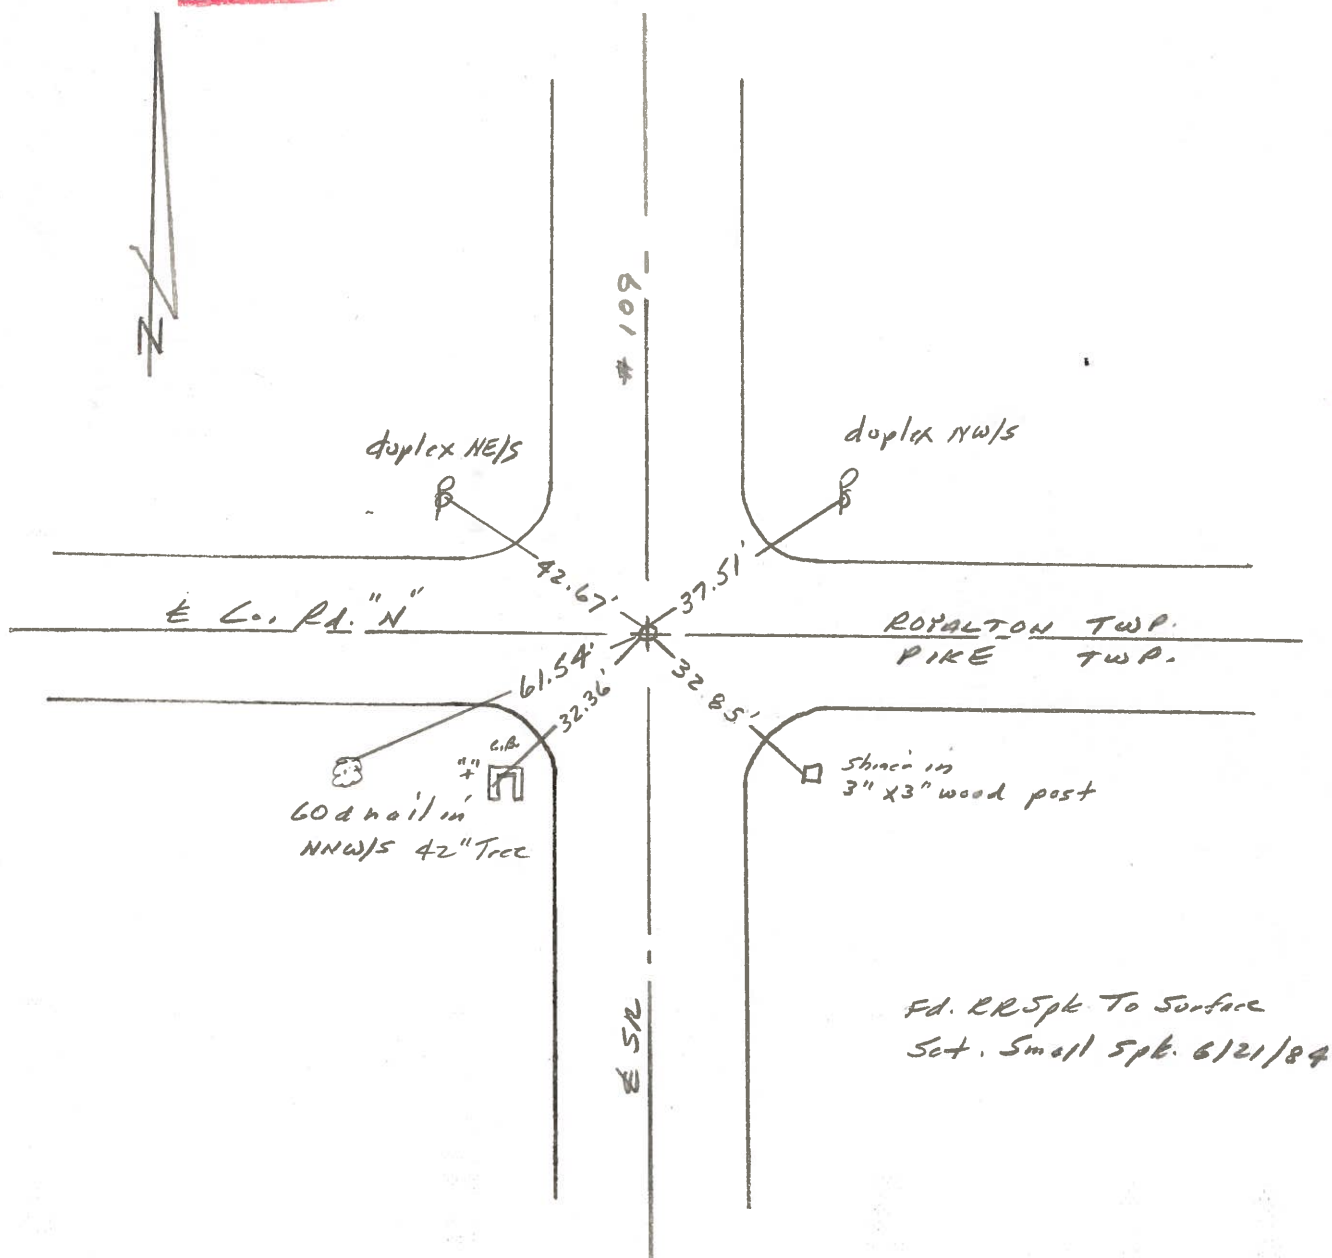


PERSONNEL		TITLE		ROAD	Intersection RD "N" + T- 9-S R- 3-E	
J. Stanley			Crew Chief	SEC.	27	T- 9-S R- 3-E Royalton
L. ARNOLD			Chain Man	SEC.	34	T- 9-S R- 3-E PIKE
J. GRIFFIN			Chain Man	CORNER	1/4 CORNER	TWP. PIKE, Royalton
				DATE	12-1-81	WEATHER Pt Sunny 35°

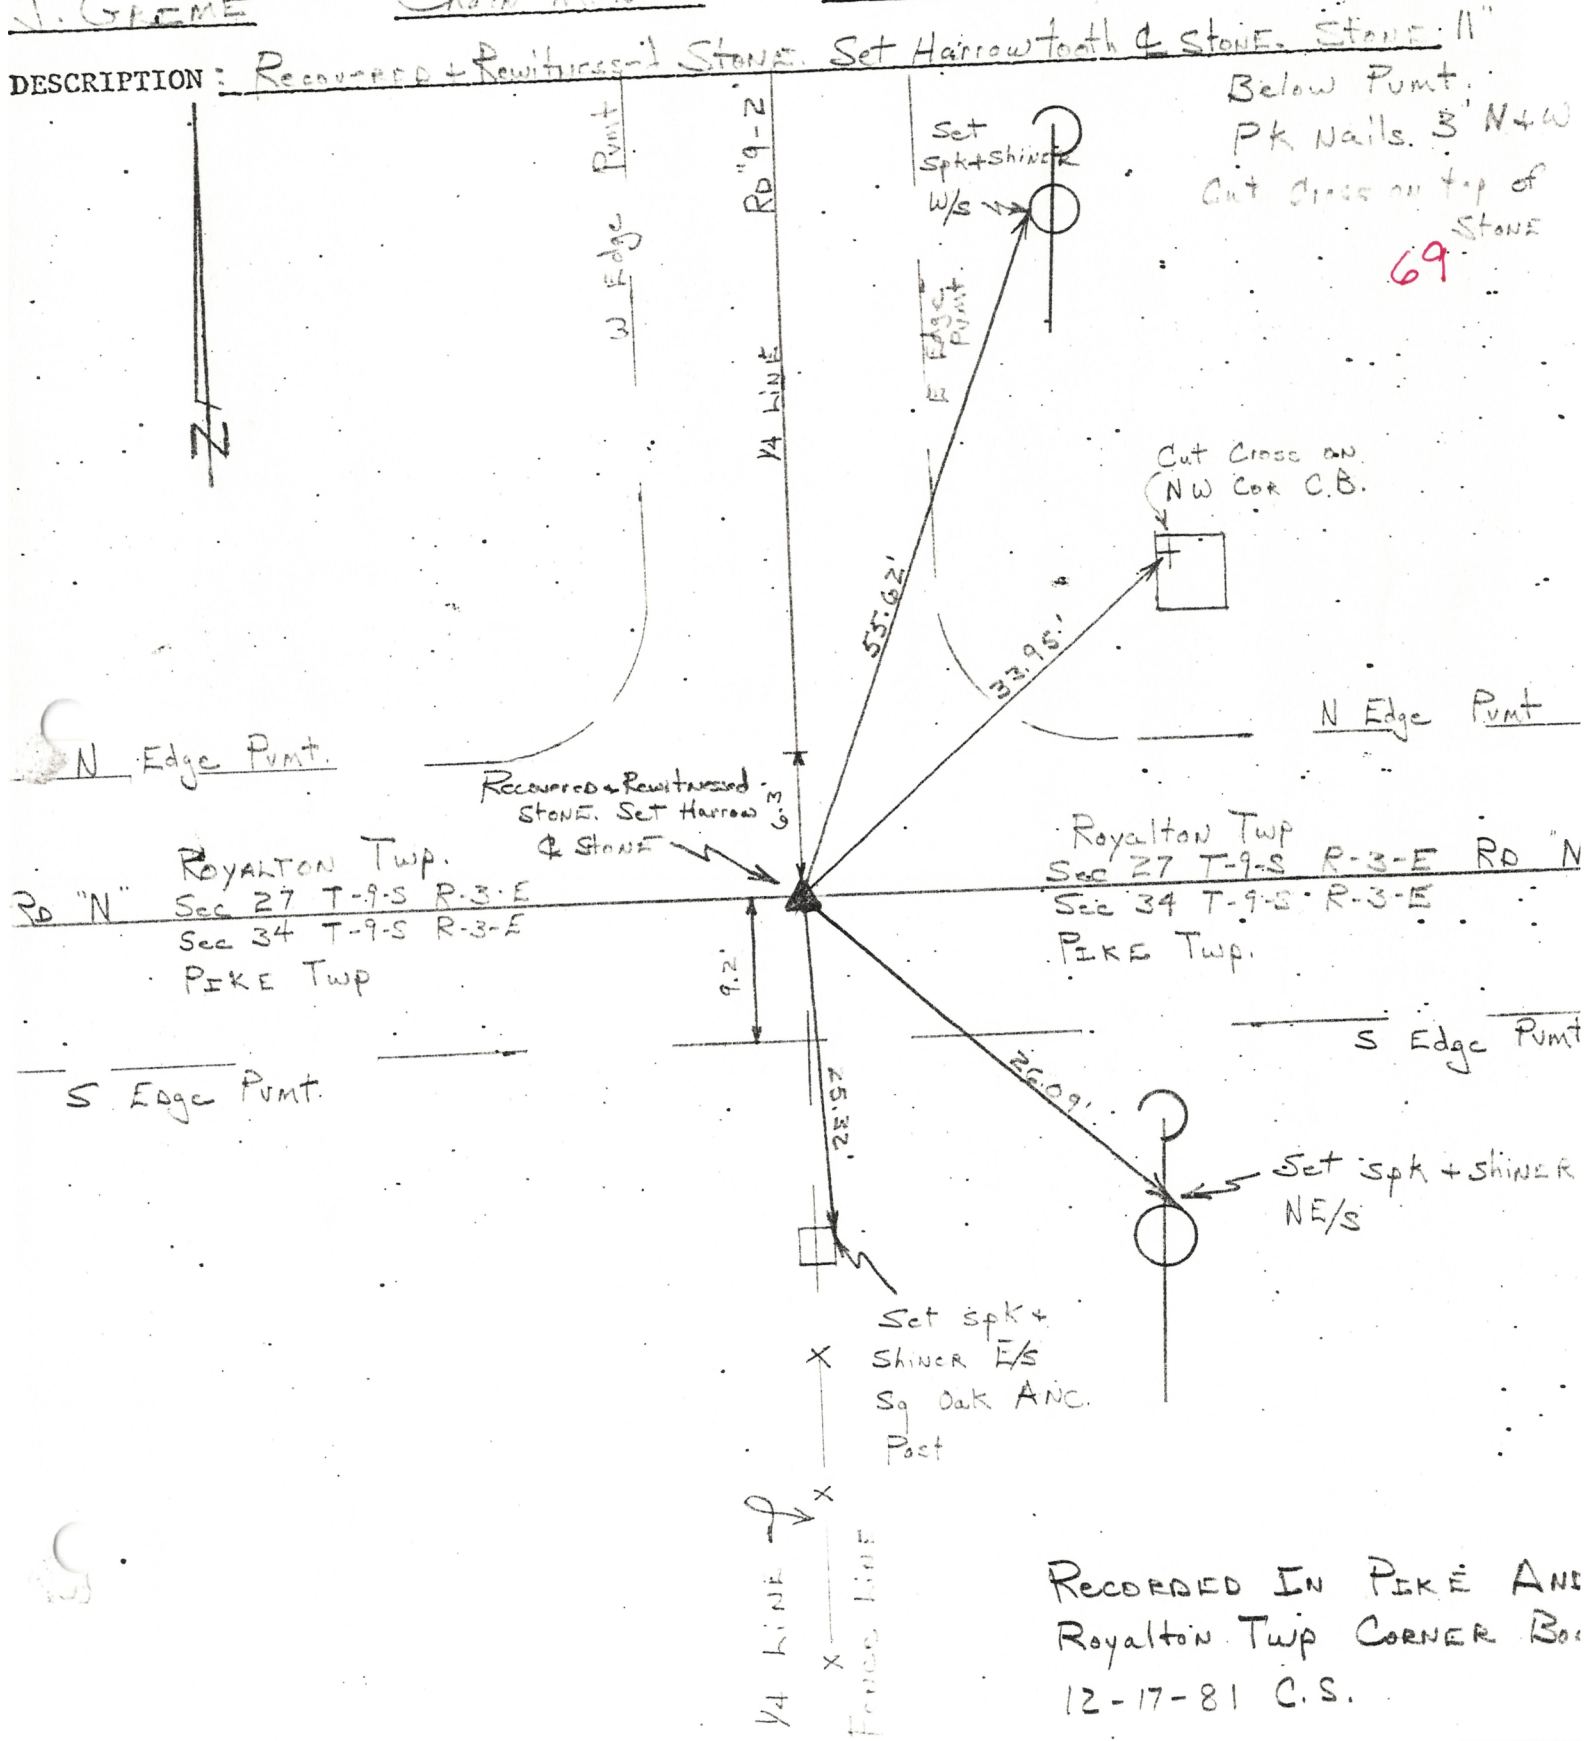

PERSONNEL	TITLE
C. Stanley	Crew Chief
A. ARNOLD	Chain Man
J. GRIME	Chain Man

ROAD Intersection Rd N + SR#109
 SEC 26, 27 T-9-S R-3-E Royal
 SEC. 34, 35 T-9-S R-3-E PIKE
 CORNER Section Corner TWP. PIKE, Royalton
 DATE 12-1-81 WEATHER Pt sunny 50° windy

DESCRIPTION: Rewitnessed Existing Nail over Stone + 2" pipe

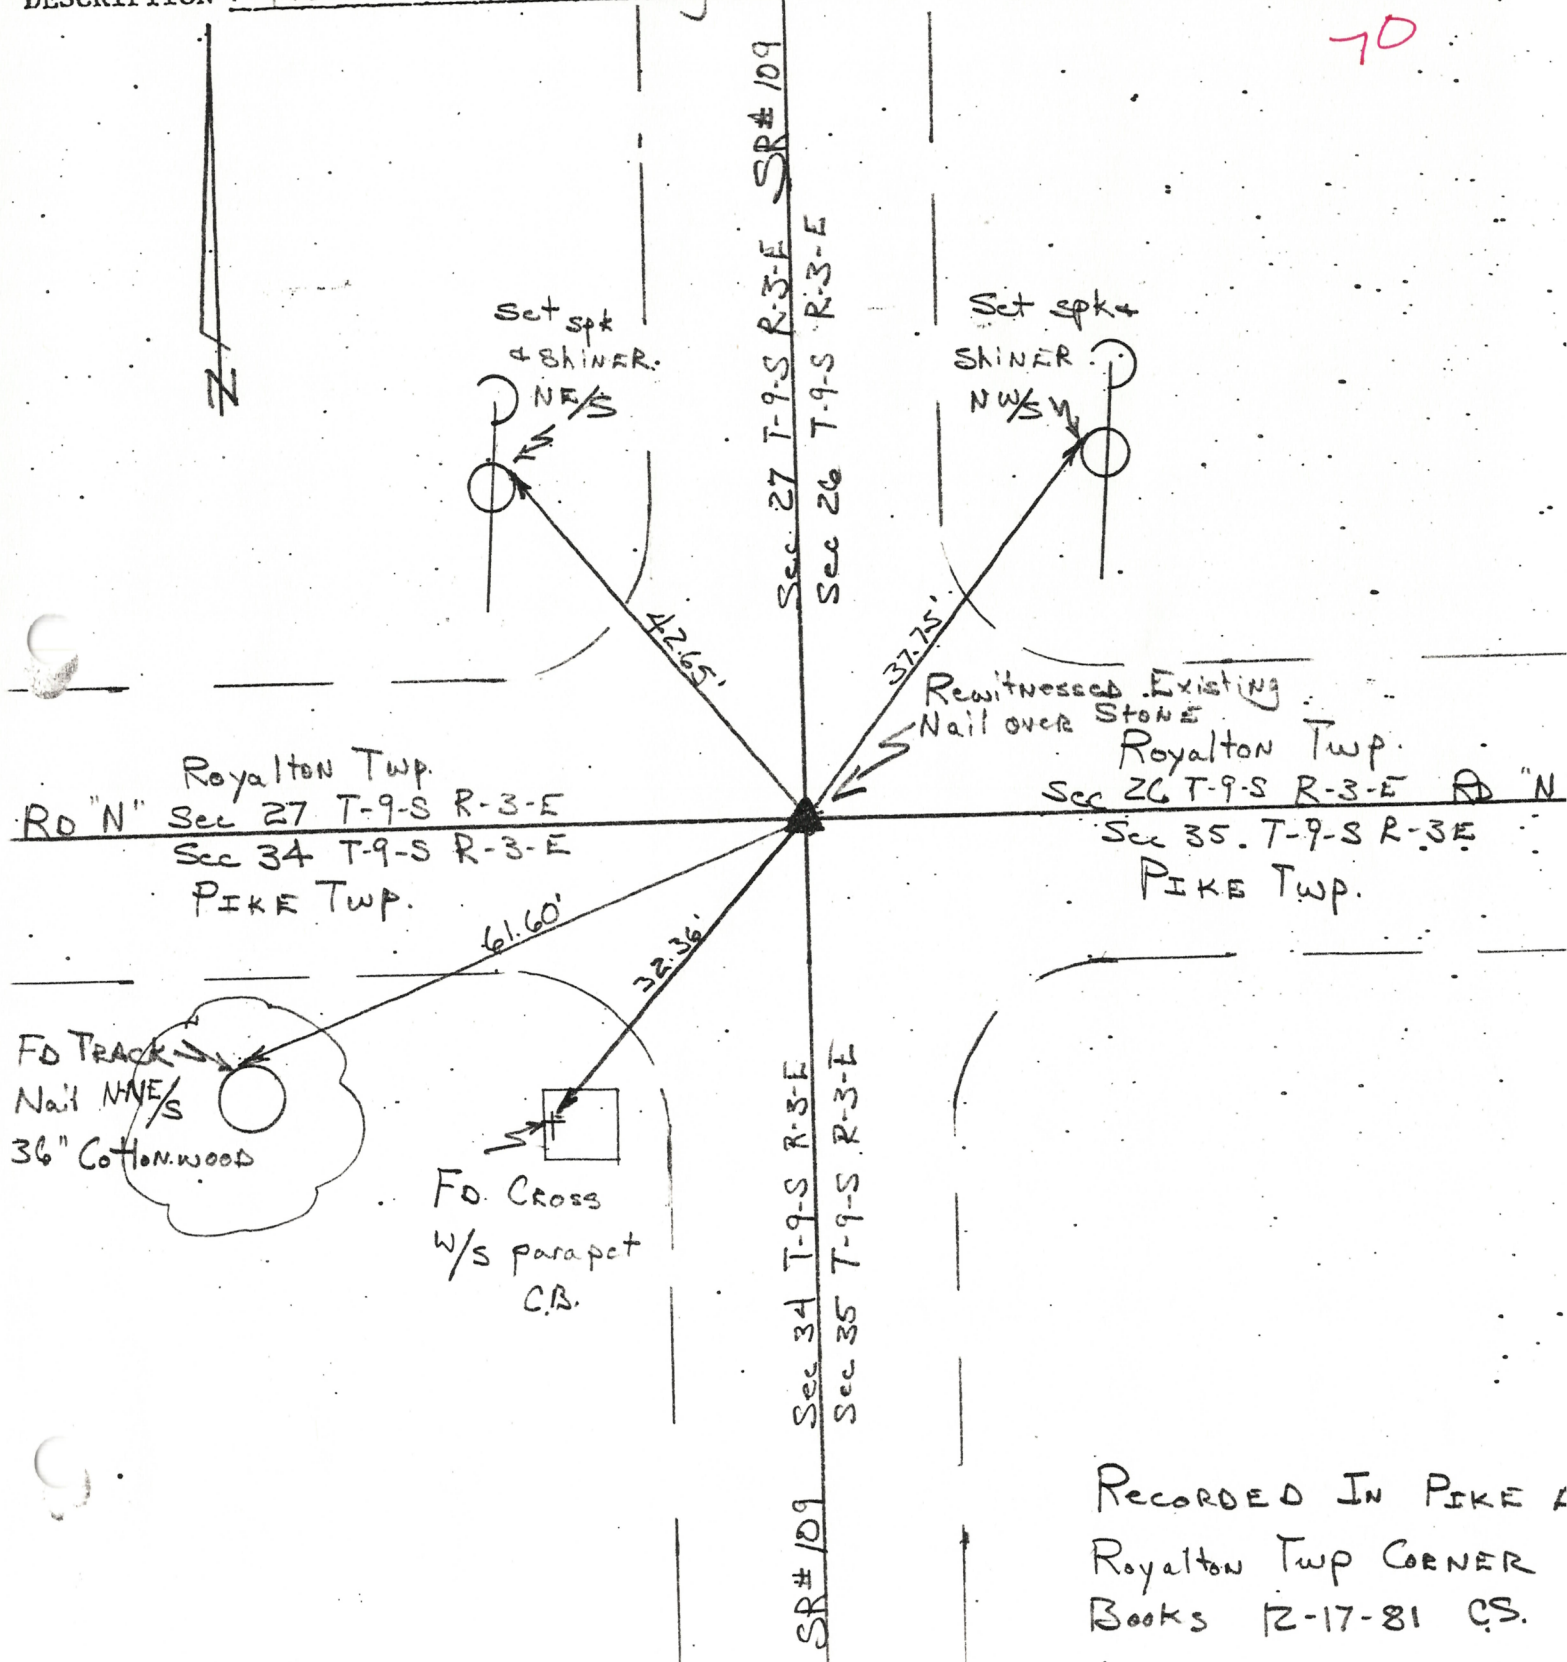


RECORDED IN PIKE &
 Royalton Twp CORNER
 Books 12-17-81 CS.

PERSONNEL	TITLE
C. Stanley	CREW Chief
M. ARNOLD	Chain Man
J. GRIME	Chain Man

ROAD "N" between RD 8 & SR 109
 SEC. 26 T. 9-S R. 3-E Royalton
 SEC. 35 T. 9-S R. 3-E PIKE
 CORNER 1/4 CORNER TWP. PIKE, Royalton
 DATE 12-1-81 WEATHER Pt cloudy 44°

DESCRIPTION: Recovered & Rewitnessed 1 1/4" pipe. This pipe 18" below ground level with tile around it. Set 1/2" x 20" pipe to surface. Red Bea Recovered Stone 38' below ground. Beach Set 1 1/4" pipe & stone. 1970. See State Highway Notes

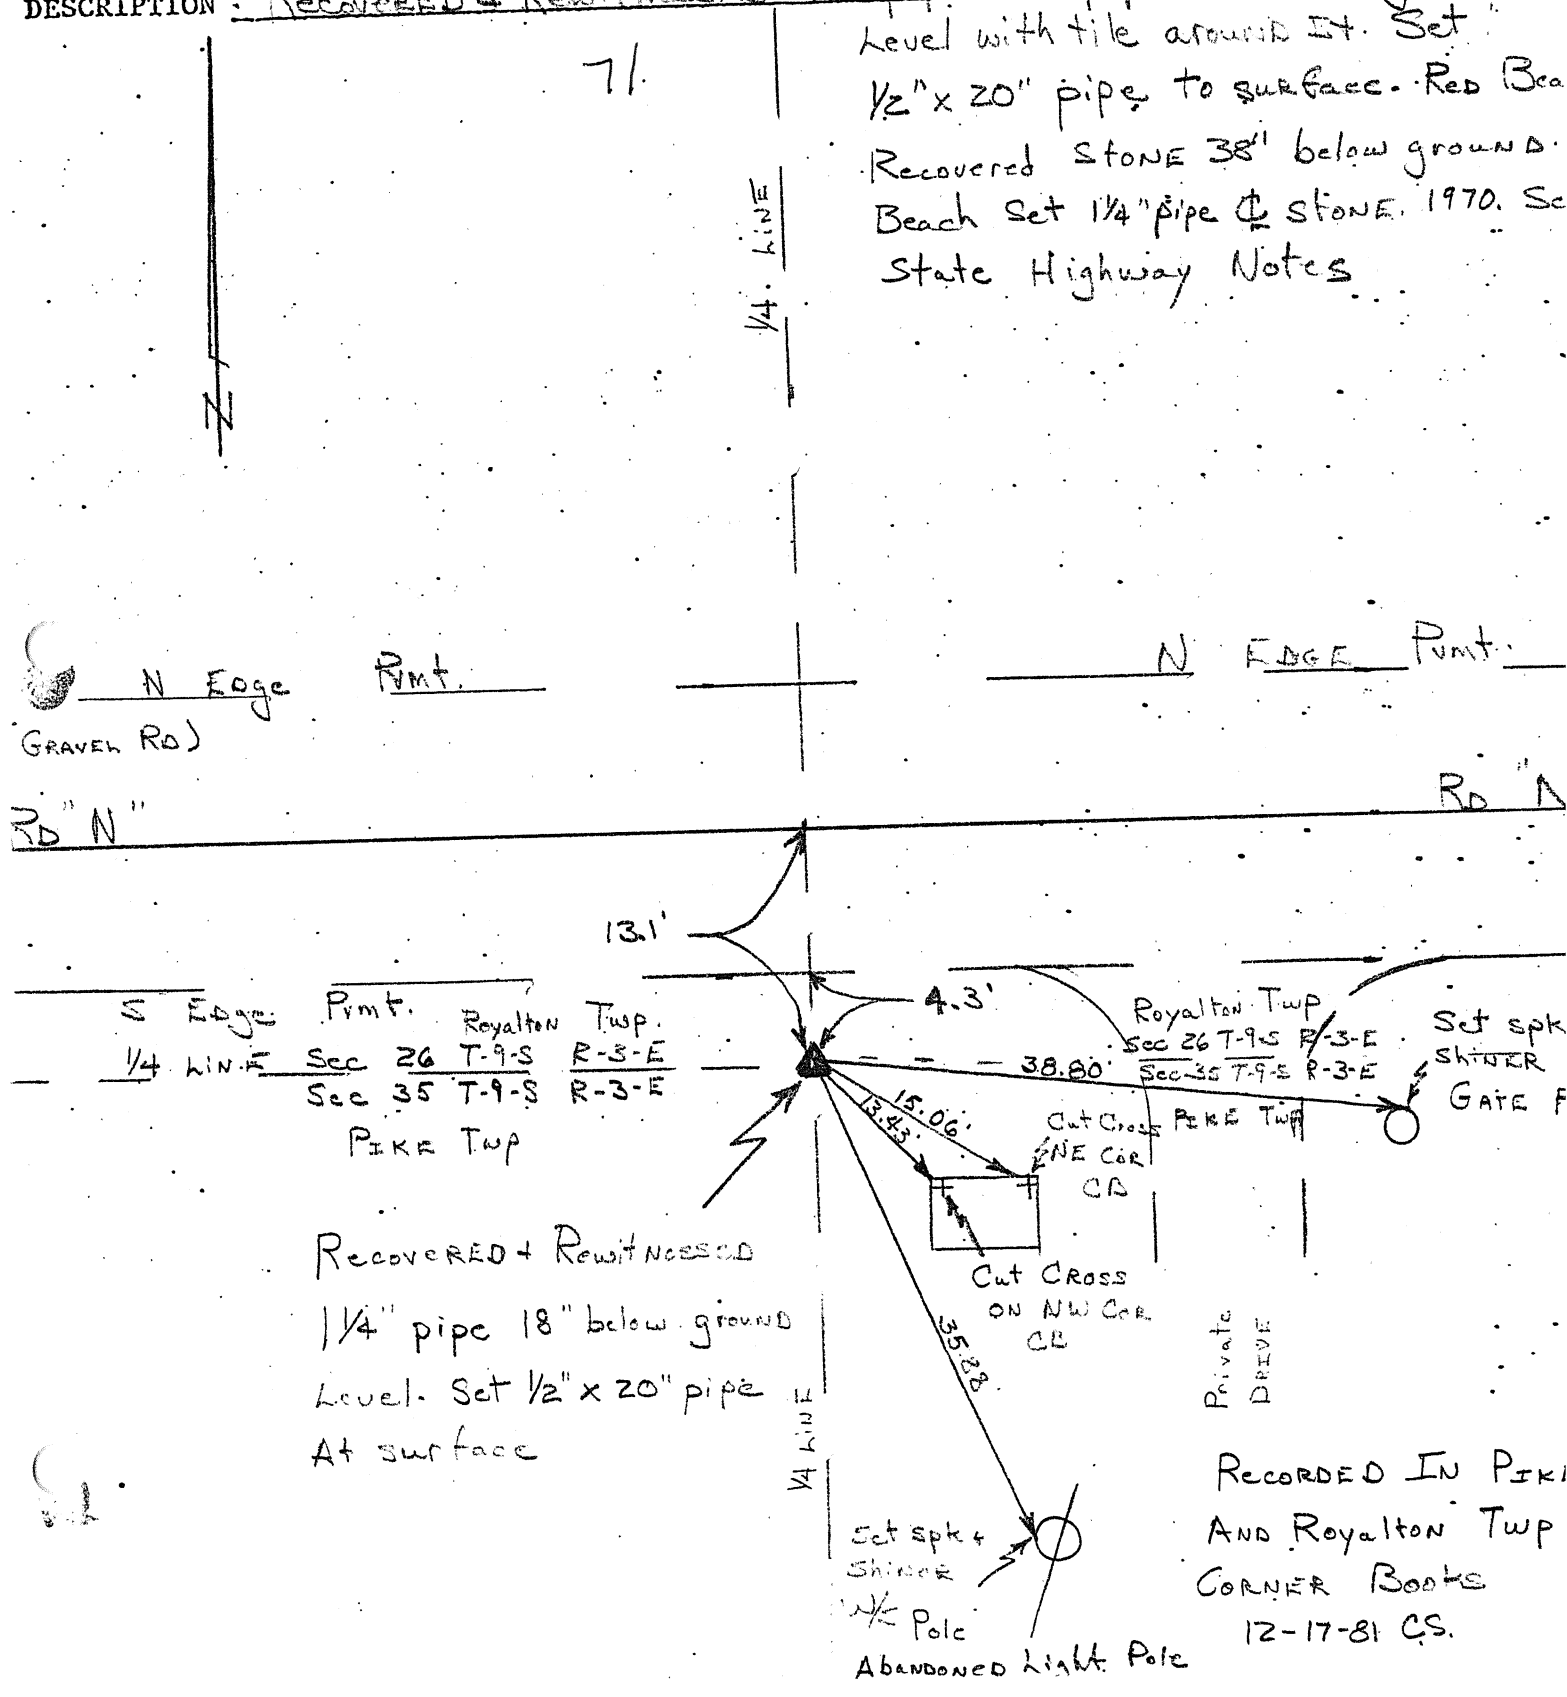

PERSONNEL TITLE PERSONNEL TITLE

Red Beach

COUNTY Fulton

DATE 28 Feb '77

W. Knappe

S. R. 109

WEATHER

SEC. ROYALTON TWP

TEMP.

DESCRIPTION

CONTROL POINTS

LEFT

CENTER LINE



RIGHT

JOB NO.


E US 20

(38)


(36-A)

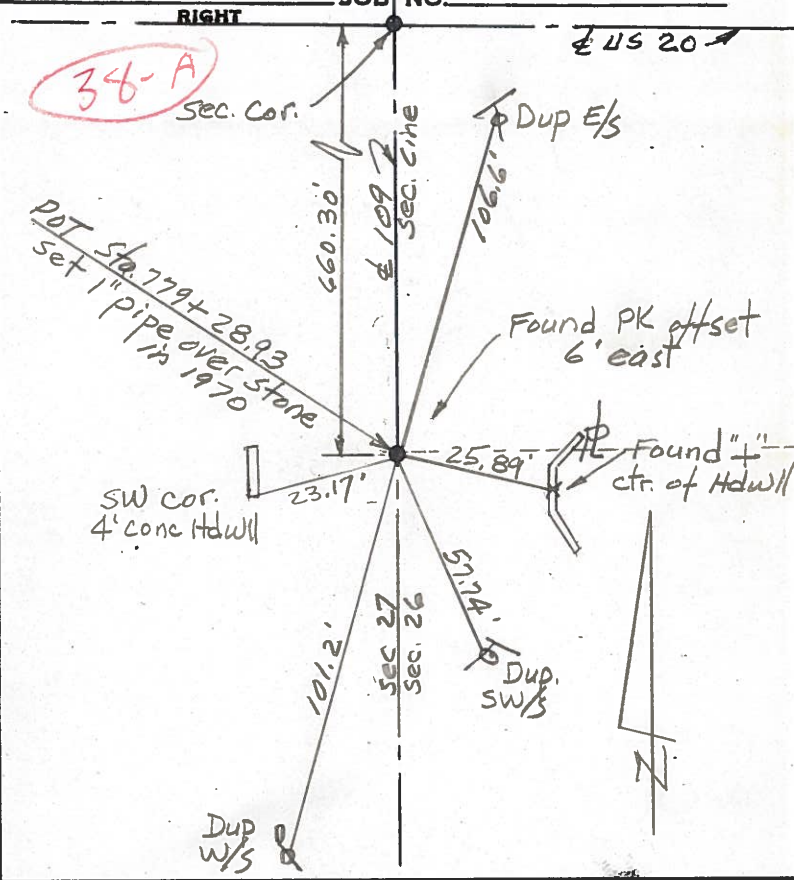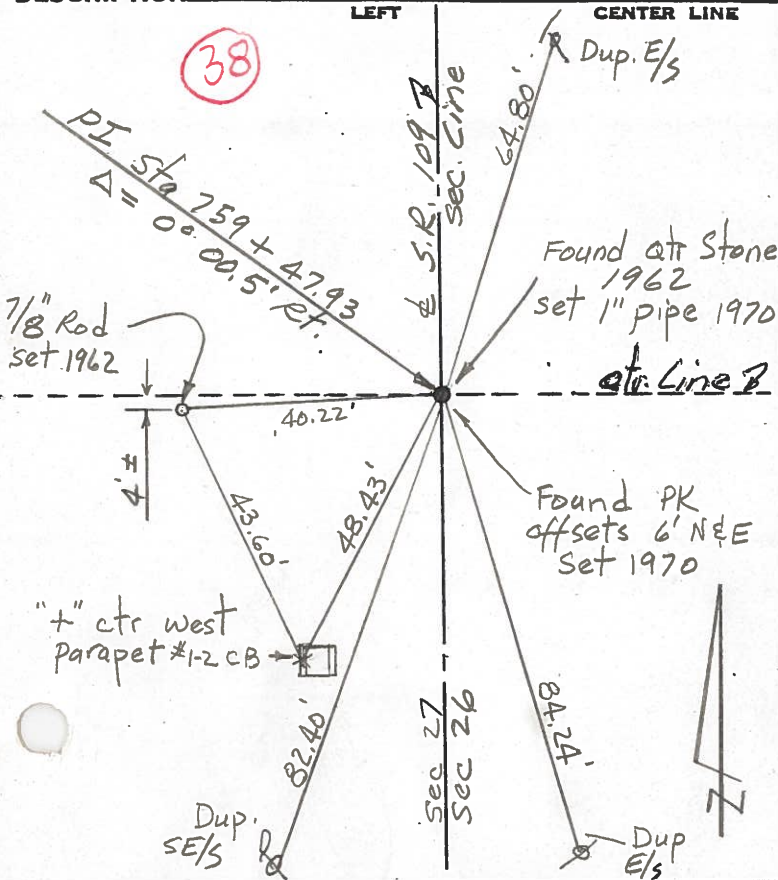

(37)

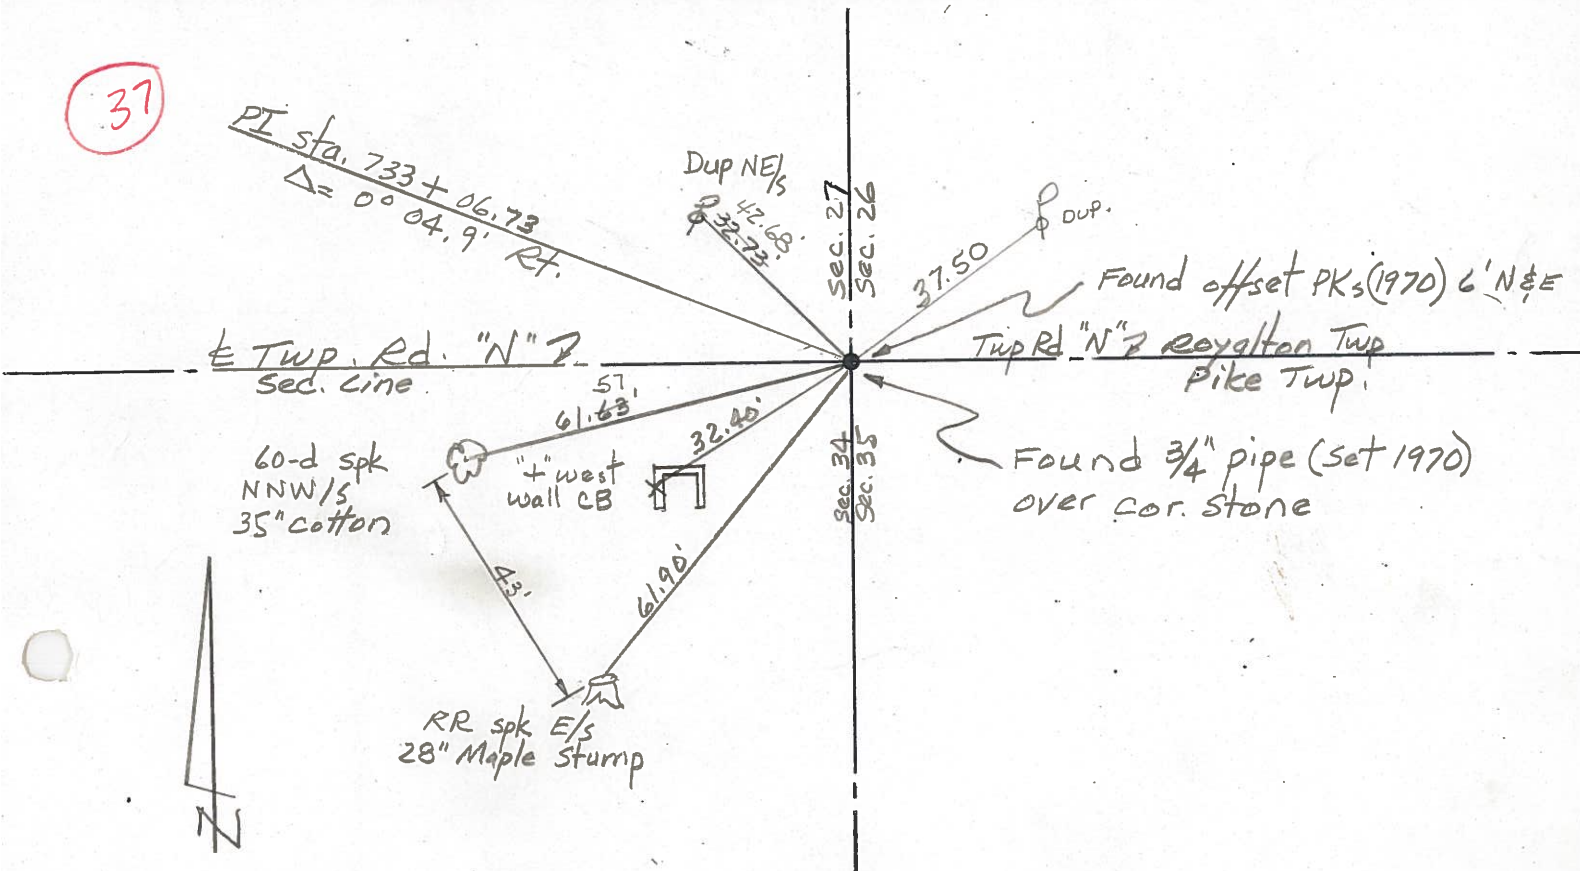

PERSONNEL	TITLE	PERSONNEL	TITLE	COUNTY	DATE	WEATHER	TEMP.
Tomsic					July 23, 1973		
Neuser							
na							


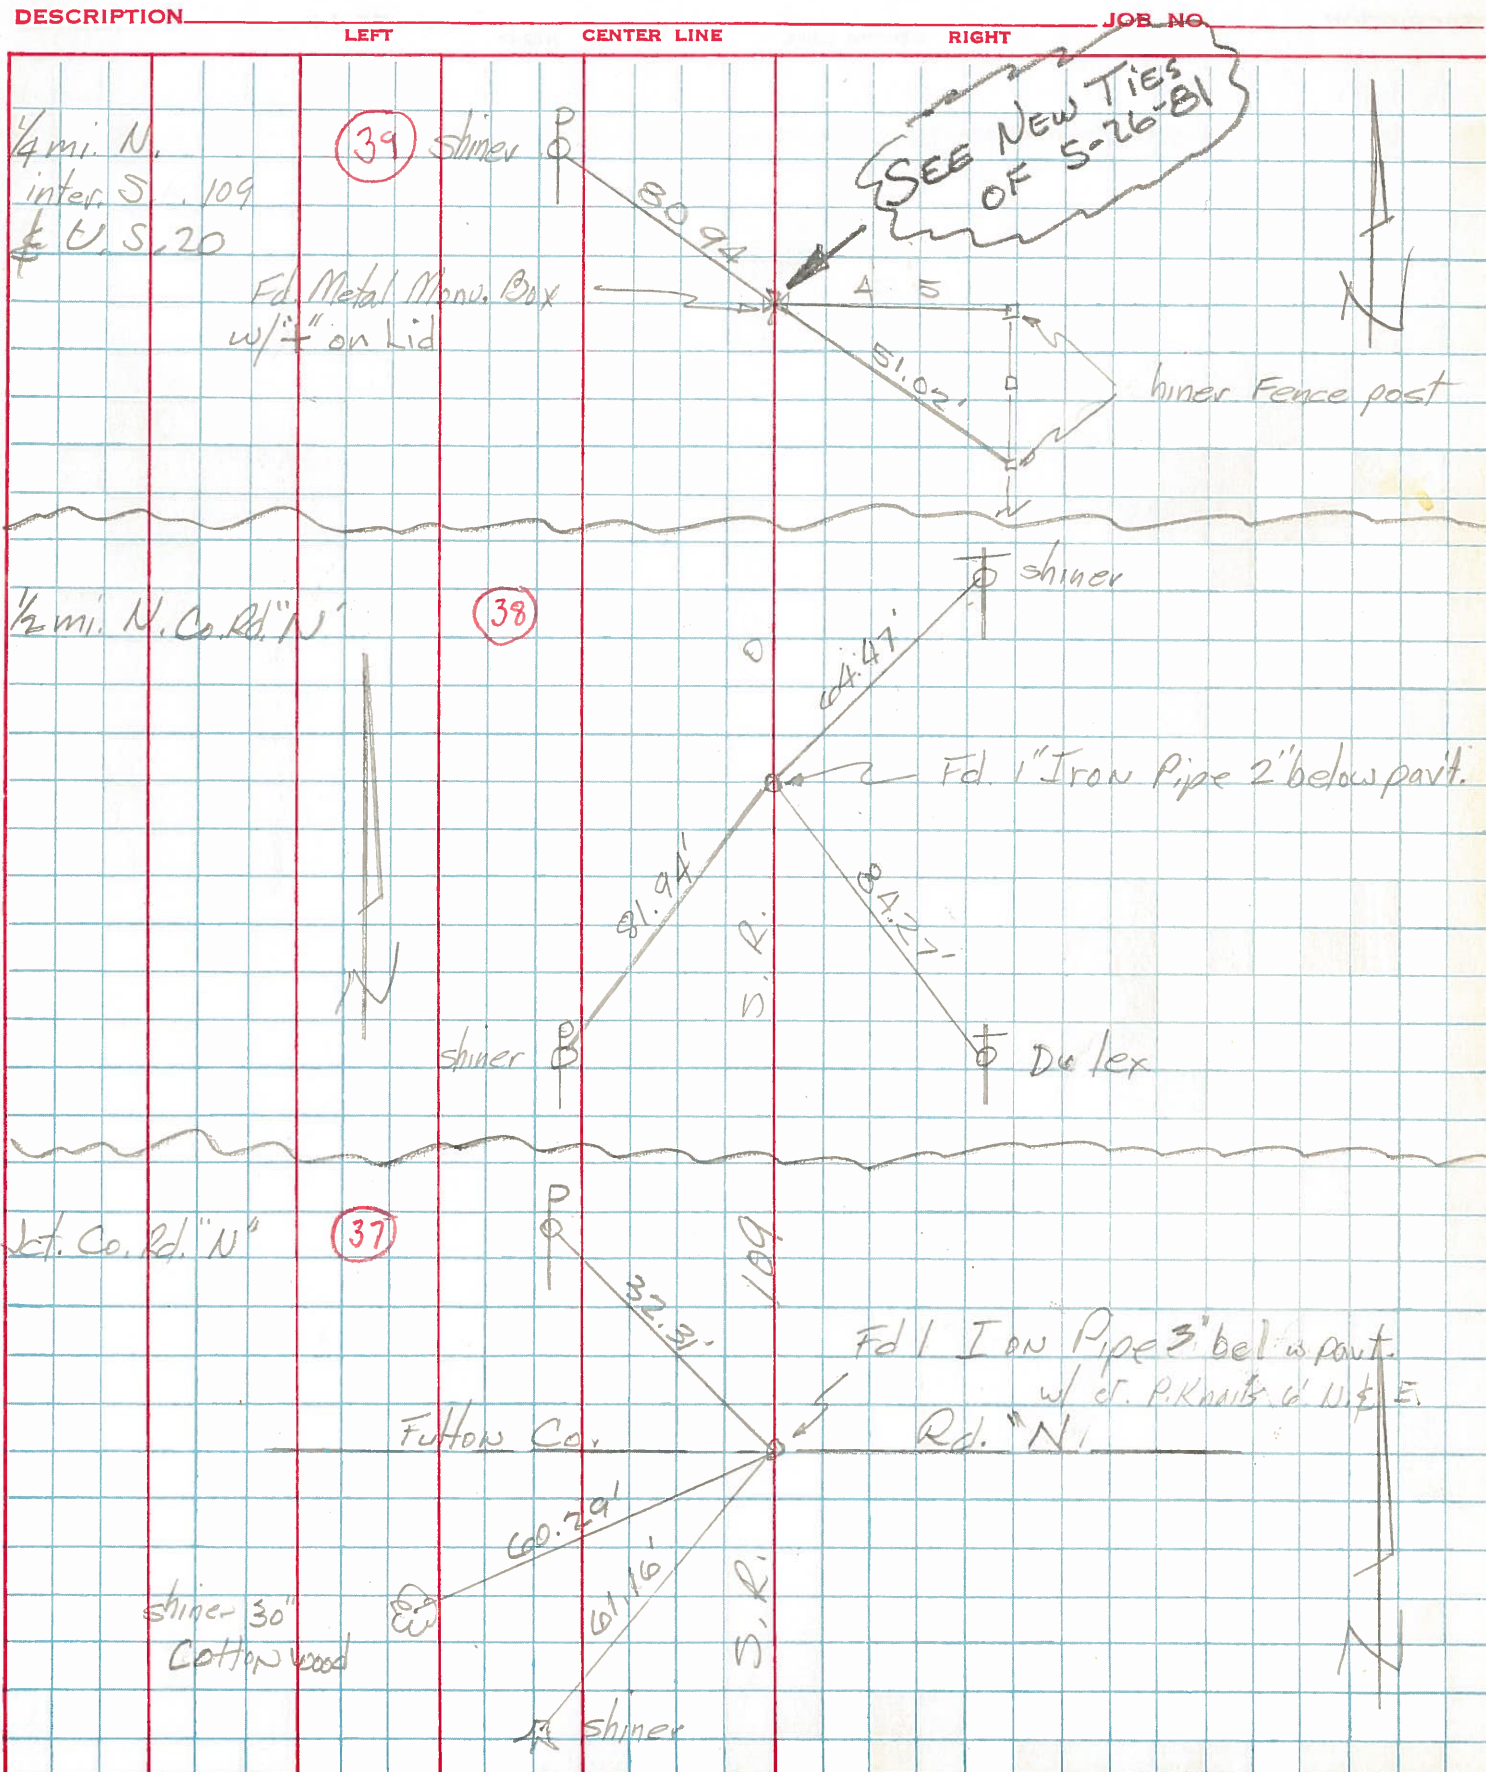


COUNTY FULTON DATE Dec 1970
S. R. 109 WEATHER _____
SEC. PIKE - ROYALTON TEMP. _____

CONTROL POINTS


JOE NO.

W 1/4 past Stone, Sec. 26 Royalton Twp.
E 1/4 past Stone, Sec. 27 Royalton Twp

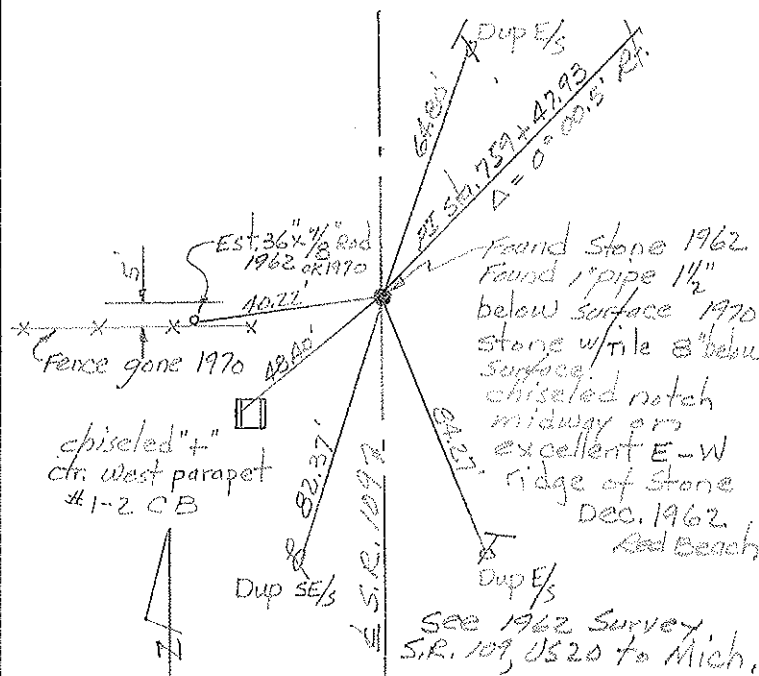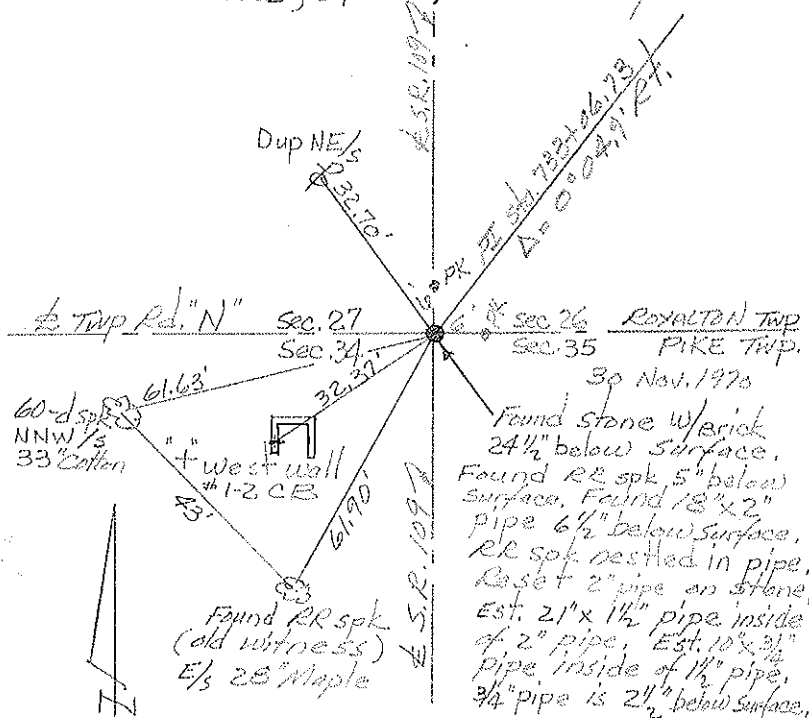


S $\frac{1}{4}$ Post Stone, Sec. 26 ROYALTON TWP.
N $\frac{1}{4}$ Post Stone, Sec. 35 PIKE TWP. 7-9-5

stone measured precisely
midway between sec. Cors.
east & west, i.e.; 2652.8'
each way. 1 Dec. 1970
95 recorded Vol. 2 / 16

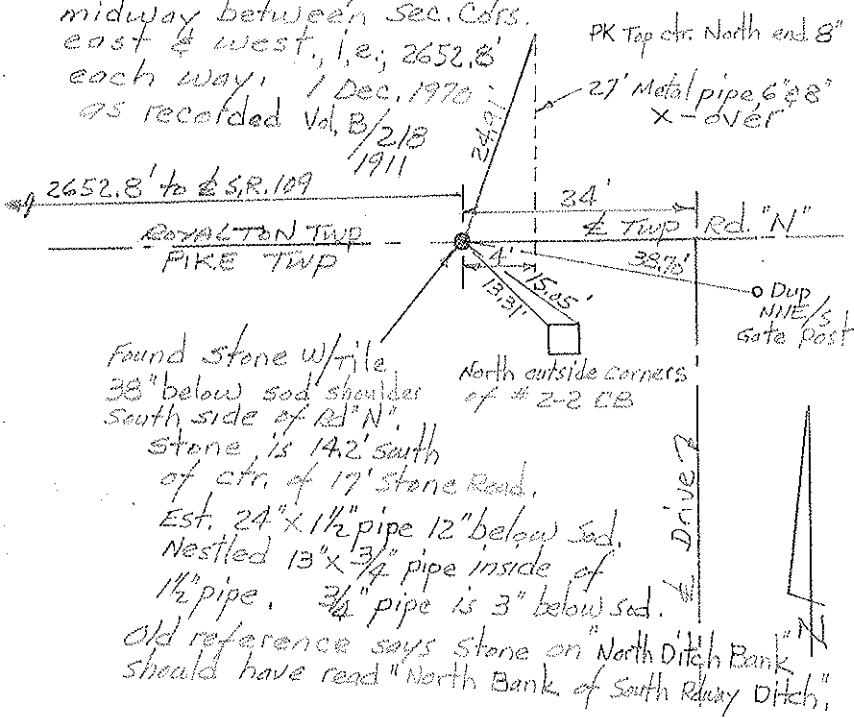

E $\frac{1}{4}$ post, Sec. 34 PIKE Twp. T-9-S
W $\frac{1}{4}$ post, Sec. 35 PIKE Twp. T-9-S

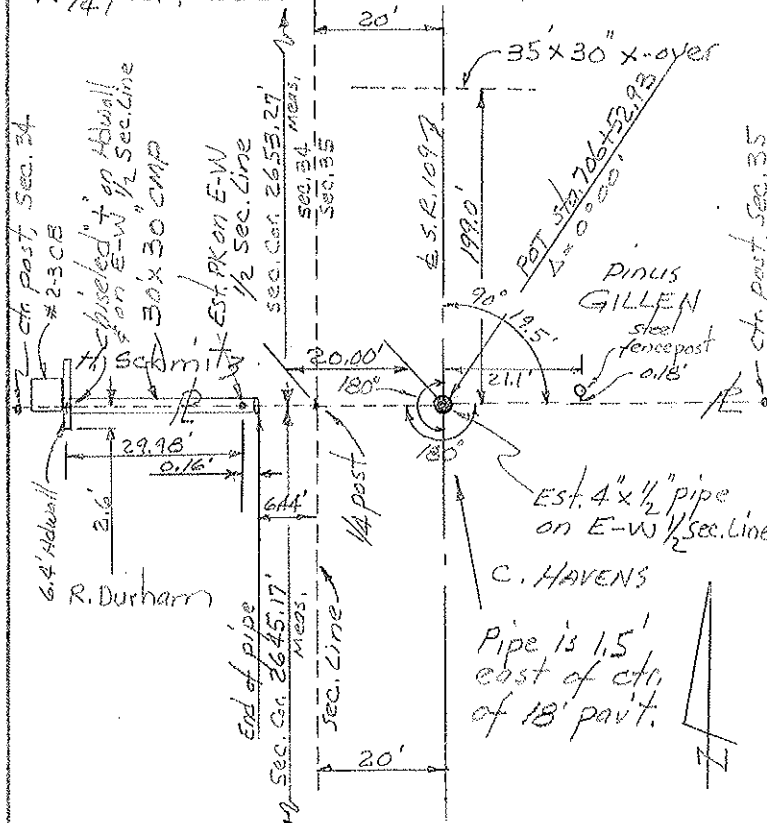

County Fulton S.R. 109Township PikeSection 26-27-34-35T N, R EPersonnel I. StoneP. NussR. MichalekD. CurtisDate 12 April 84Weather SunnyTemp. 53°

27	26
34	35



REF. NO. 37

