


O.D.O.T. DISTRICT 2 SURVEY OFFICE (USE ONLY)


PERSONNEL _____ REFERENCE NO. 12 SHEET 30 OF 50
NOTES HOMAN DATE 5/11/12 ROUTE SR 120
H.C. ROUSOS WEATHER SUNNY COUNTY FULTON
R.C. HOMAN TEMP. 60° TOWNSHIP ROYALTON
DWG BY RHOADES PID PAVETRAIN SECTION 10
T 9 N R 3 E

TYPE MONUMENT MONBOX W/1" IPIN
ON SURFACE - ~~BELOW~~ ON
OFFSET Q PAVEMENT ON LT : RT
- TO - EDGE PAVEMENT
STATION: 386+92.17

HORZ. DATUM: NAD83 2011 GEOID: NAVD88 2018
GRID: NORTHING: 744462.159 EASTING: 1548833.793

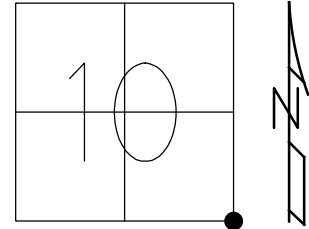

RECORD:
FD MONBOX
9/19/84, DC
FD MONBOX
REF26
6/8/10, DCH
FD MONBOX
W/1" IPIN
REF12
7/1/22, DSA
4/12/23, JMR

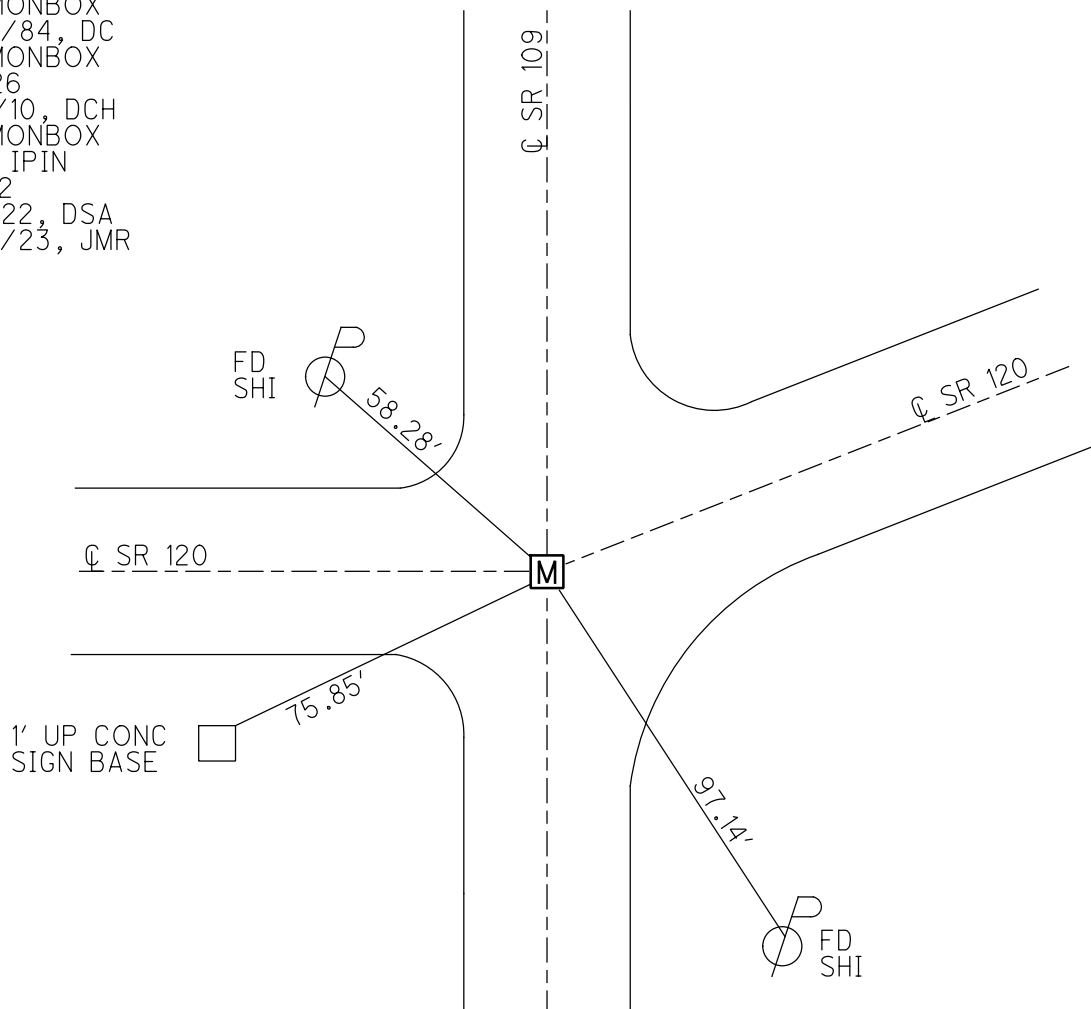

O.D.O.T. DISTRICT 2 SURVEY OFFICE (USE ONLY)

PERSONNEL

REFERENCE NO. 12

SHEET 27 OF 45

NOTES

HOMAN

DATE 5/11/12

ROUTE SR 120

H.C.

ROUSOS

WEATHER SUNNY

COUNTY FULTON

R.C.

HOMAN

TEMP. 60°

TOWNSHIP ROYALTON

SECTION 10

T 9 N R 3 E

TYPE MONUMENT MONBOX


ON SURFACE - ~~BELOW~~ ON

LEFT - Q PAV'T - RIGHT ON

TO Q EDGE PAVEMENT

S.L.M. 386+92.17

GRID: NORTHING: 744462.161 EASTING: 1548833.780

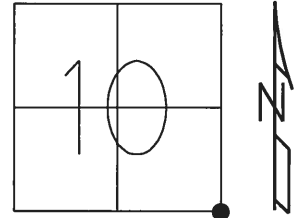

RECORD:


FD MONBOX

9/19/84, DC

FD MONBOX

REF26

6/8/10, DCH

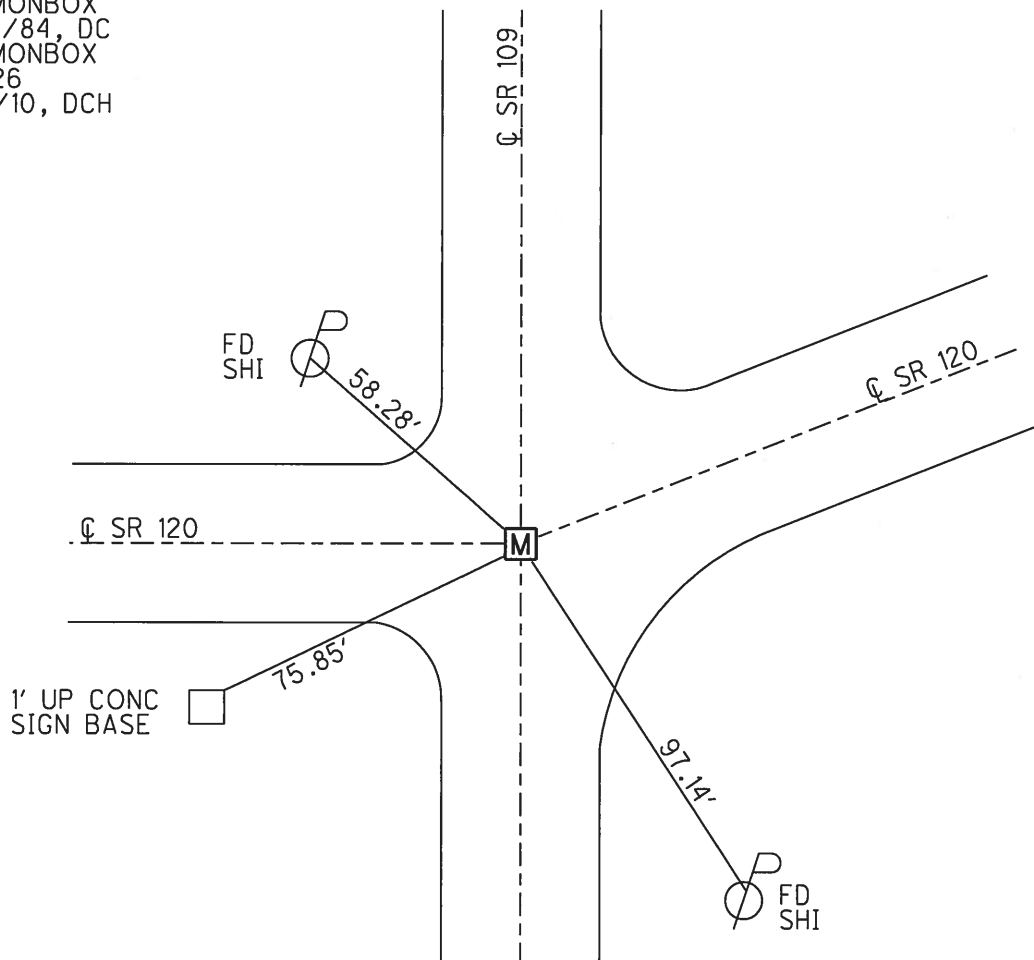

O.D.O.T. DISTRICT 2 SURVEY OFFICE

PERSONNEL

REFERENCE NO. 12

SHEET 27 OF 45

NOTES CURTIS

DATE 9/19/84

ROUTE SR 120

H.C. NEUSER

WEATHER MILD

COUNTY FULTON

R.C. MICHALAK

TEMP. 75°

TOWNSHIP ROYALTON

SECTION 10

T 9 N R 3 E

TYPE MONUMENT MON.BOX


ON SURFACE - ~~BELOW~~ ON

LEFT - Q PAV'T - RIGHT ON


TO EDGE PAVEMENT

S.L.M. 387+02.4, 891+79.2 = SR 109

Grid: Northing: Easting:

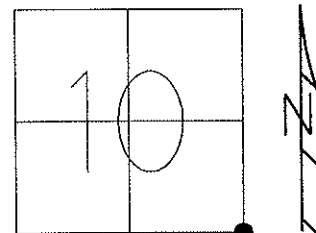

FD MON.BOX TO
SURFACE, 9/19/84

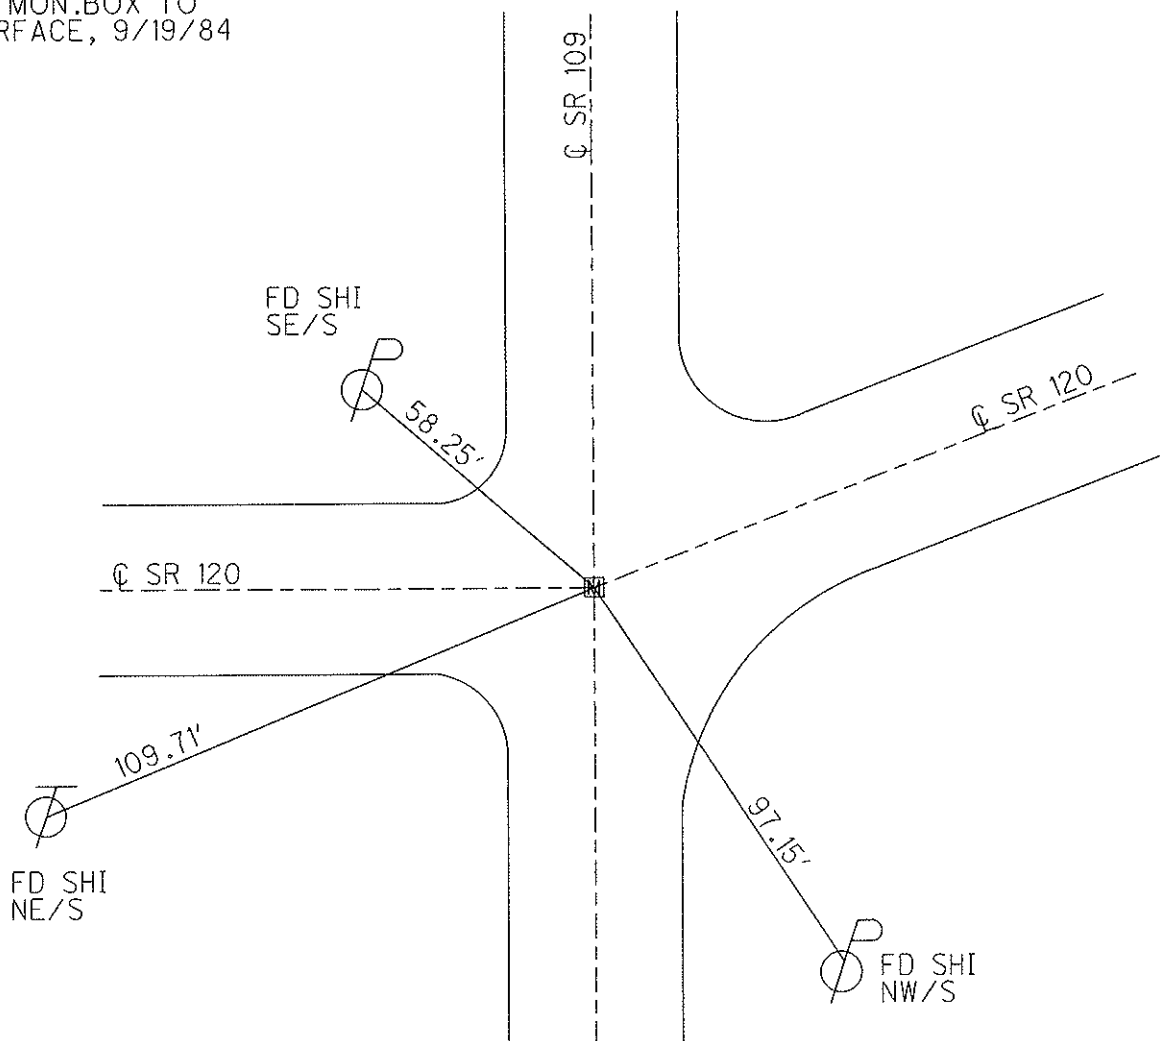

O.D.O.T. DISTRICT 2 SURVEY OFFICE

PERSONNEL

NOTES D. CURTIS

H.C. P. NEUSER

R.C. R. MICHALAK

REFERENCE NO. 12
#44-SR109

DATE 9-19-84

WEATHER MILD

TEMP. 75°

SHEET 3 OF 18

ROUTE S.R. 120

COUNTY FULTON

TOWNSHIP ROYALTON

SECTION 10, 11, 14, 15

T N R E

TYPE MONUMENT MON. BOX

ON SURFACE ~~BELOW~~ ON

~~LEFT - C~~ PAV'T - RIGHT ON


TO EDGE PAVEMENT

S.L.M. 7.33 ON SR 120 = 387+02.4

16.89 ON SR 109 = 891+79.2

10	11
15	14

FD. MON. BOX TO SURFACE
9-19-84

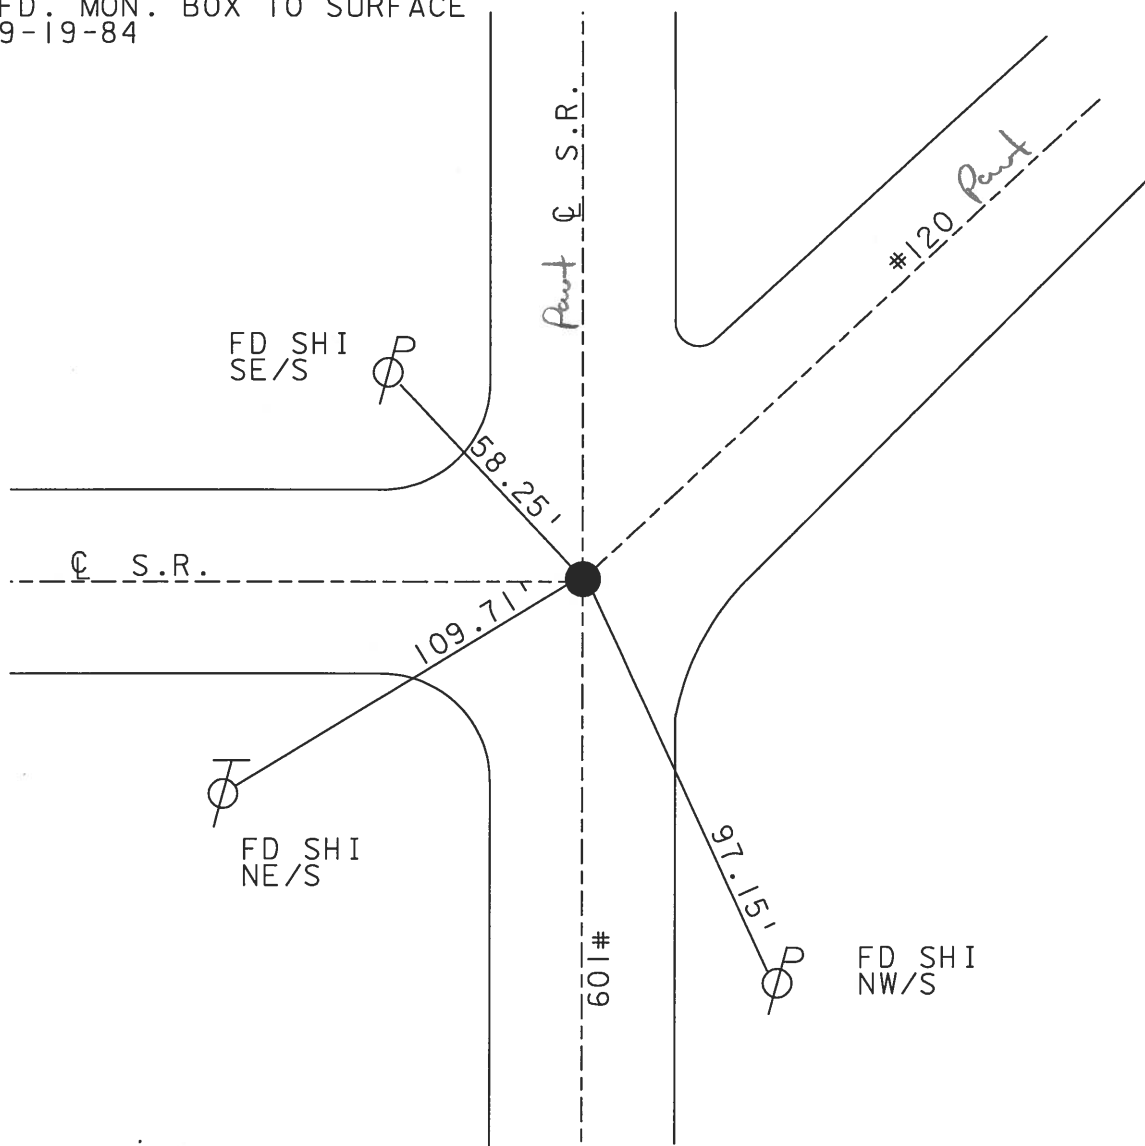

O.D.O.T. DISTRICT 2 SURVEY OFFICE

SHEET 20 OF 20

County Fulton S.R. 120

Township Royalton

Section 10-11-14-15

T N, R E

Personnel D. Curtis

P. Neuser

R. Michalak

Date 19 Sept. 84

Weather Mild


Temp. 75°

10	11
15	14



Z —————

#12

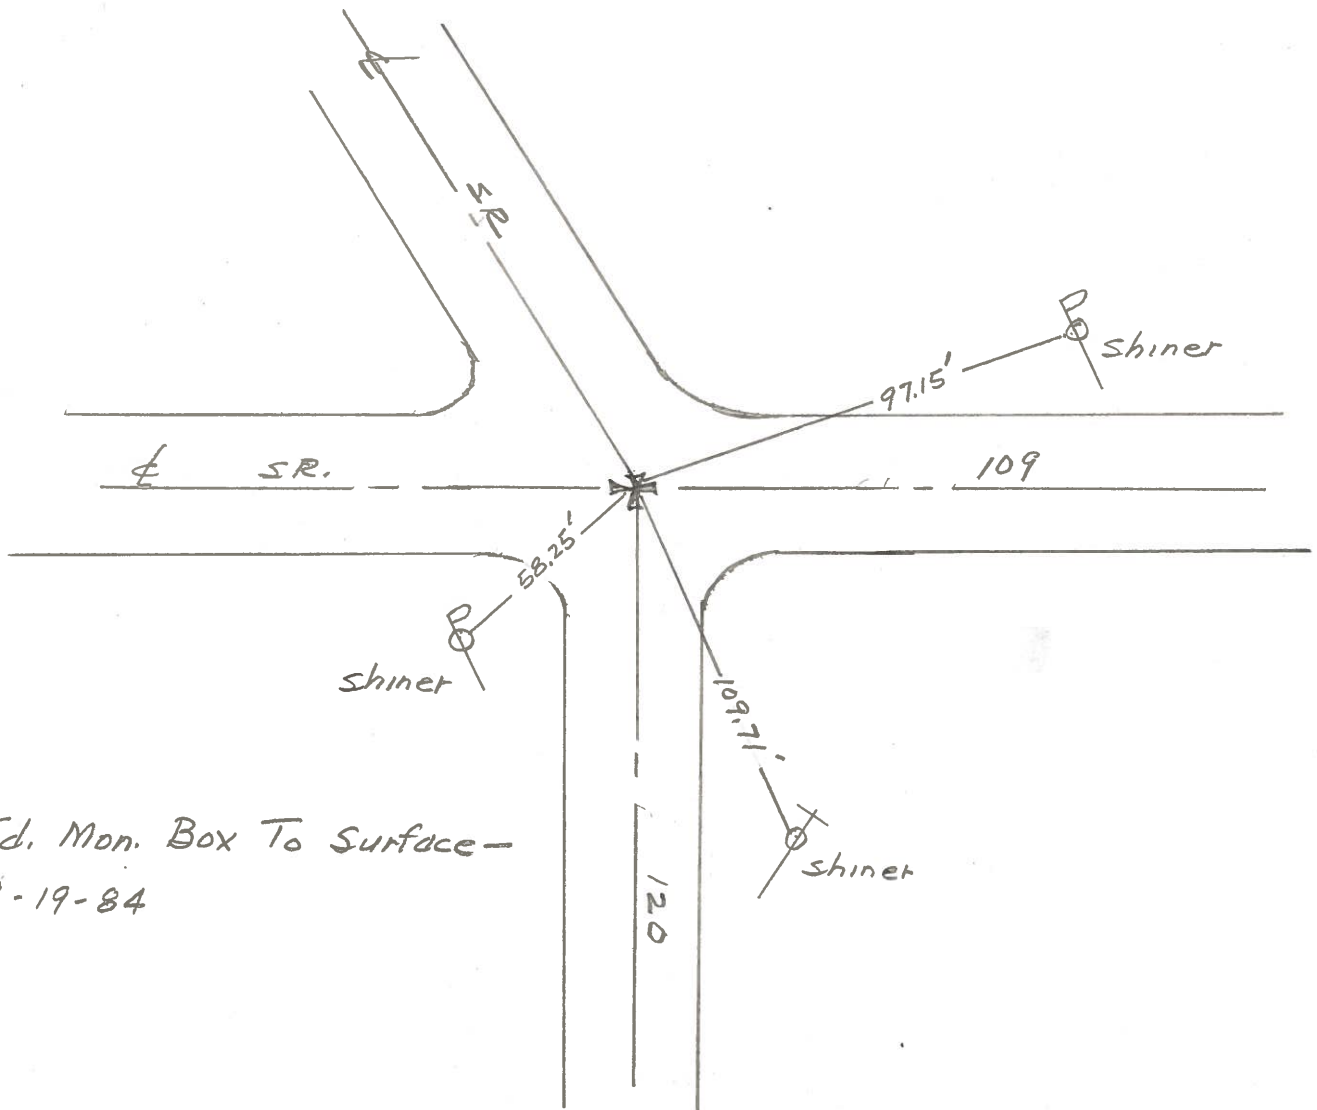

Fd. Mon. Box To Surface—
9-19-84

PERSONNEL TITLE PERSONNEL TITLE

Tomsir _____ Boyle _____ COUNTY Fulton DATE July 10, 1973Nouser _____ S. R. 120 WEATHER _____Granata _____ SEC. Royalton Twp. TEMP. _____

Vanx _____


DESCRIPTION

LEFT

CENTER LINE

RIGHT

JOB NO. _____

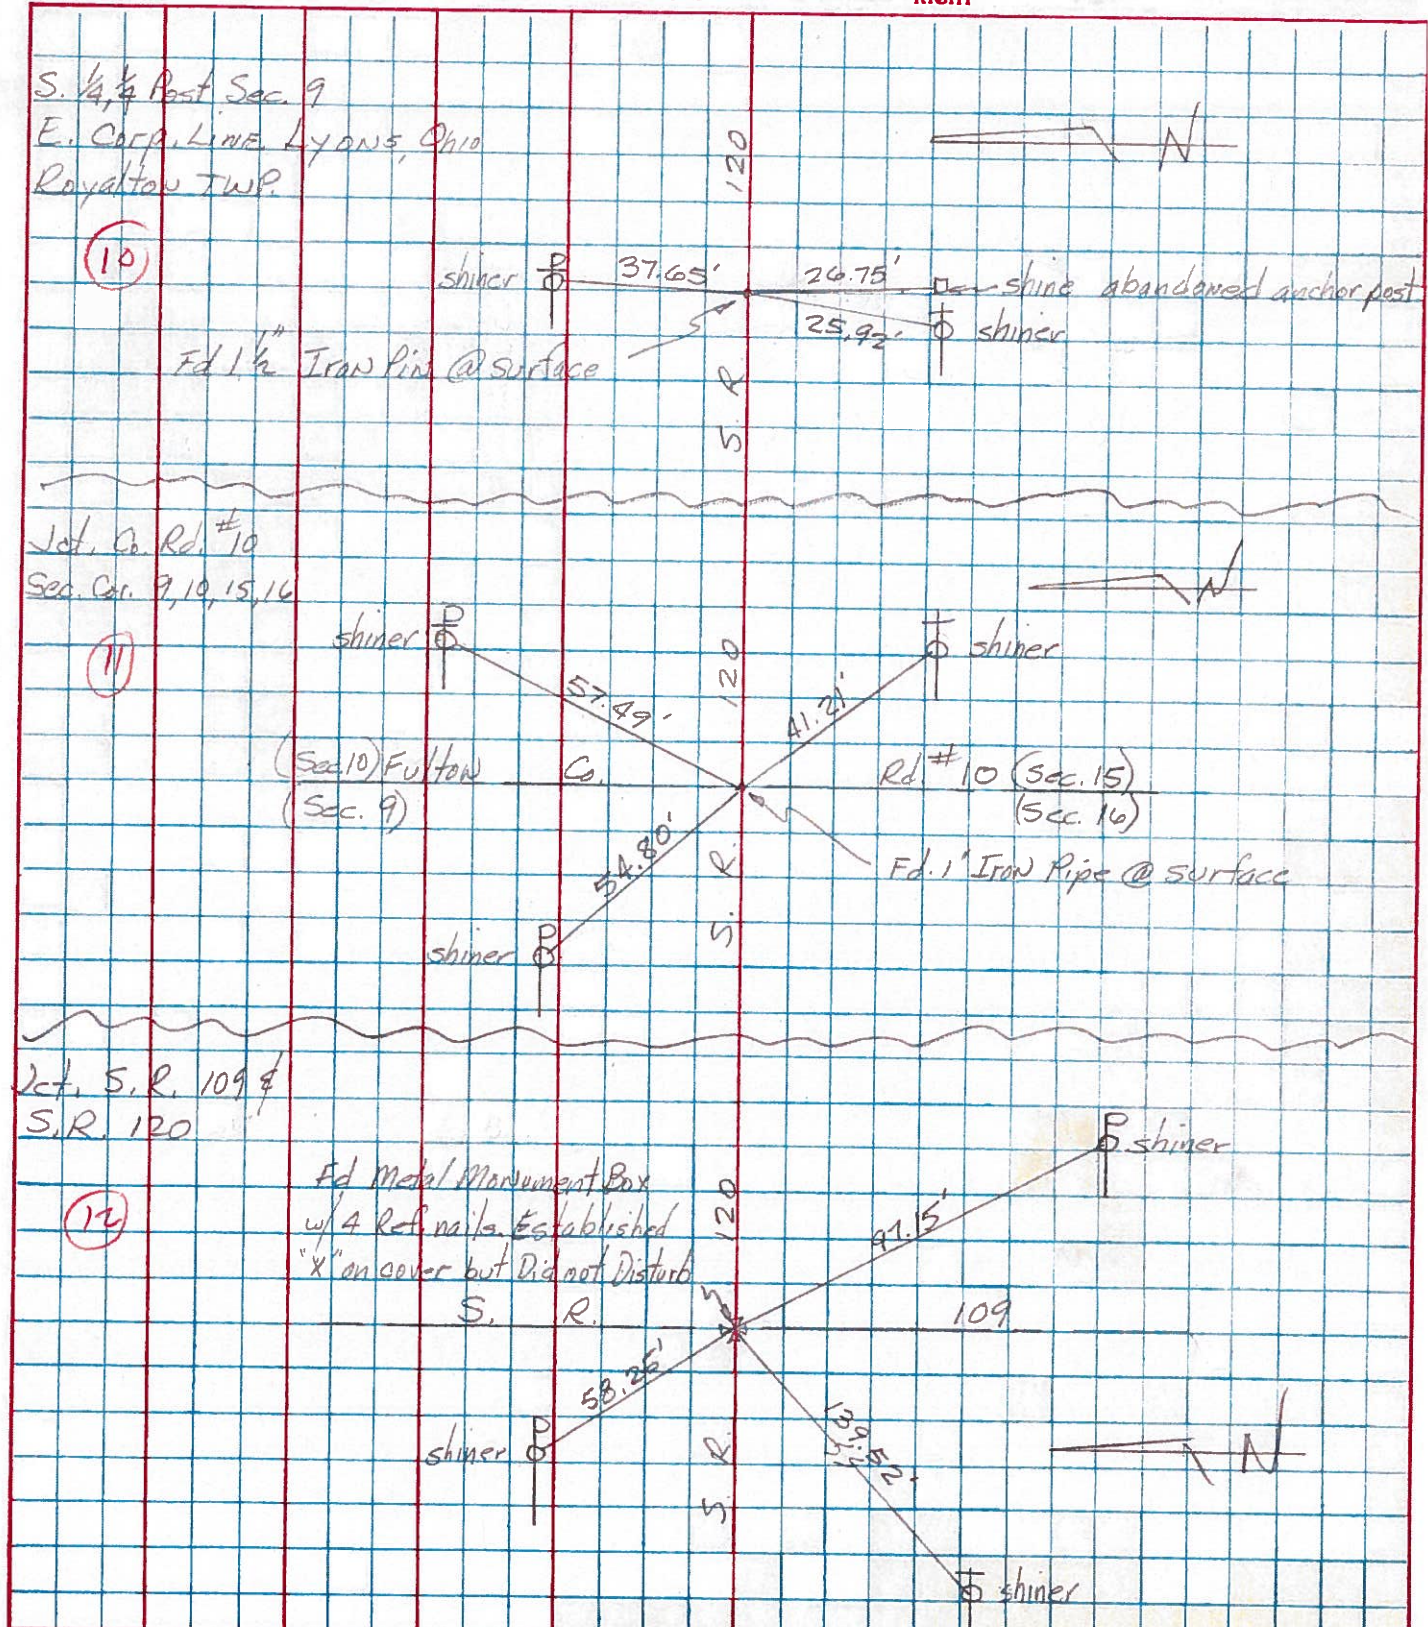

COMPUTATION SHEET

STATE OF OHIO — DEPARTMENT OF HIGHWAYS — BUREAU OF LOCATION AND DESIGN _____ COLUMBUS, OHIO
BY Denna - Curtis - Granata - Orney DATE June 7, 1966 NO. _____ OF _____ SHEETS
COUNTY Fulton SECTION _____
DIV. NO. 2 S.R. 120 U.S.R. _____ I. R. _____
SUBJECT OF THIS SHEET Ref. Monuments SR 120

