

O.D.O.T. DISTRICT 2 SURVEY OFFICE (USE ONLY)

PERSONNEL

REFERENCE NO. 15 C

SHEET 38 OF 47

NOTES RHOADES

DATE 5/2/19

ROUTE SR 120

H.C. O'DONNELL

WEATHER CLOUDY

COUNTY FULTON

R.C. RHOADES

TEMP. 53°

TOWNSHIP AMBOY

DWG BY NASON

PID 101243

SECTION 8

T 9 N R 4 E

TYPE MONUMENT MAG/WASHER

ON SURFACE - ~~BELOW~~ ON

OFFSET CL PAVEMENT 3.4' LT : ~~RT~~

6.8' TO LT EDGE PAVEMENT


STATION: 604+17.08

HORZ.DATUM: NAD83 (2011)


GEOID: 2012A

GRID: NORTHING: 748854.745

EASTING: 1569566.852

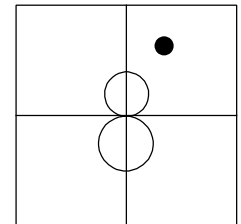

SET MAG/WASHER
8/18/03, DCH
FD MAG/WASHER
5/20/11, RJL
REFC15
5/23/11, RJL
FD MAG/WASHER
REFC15
3/5/18, JFO

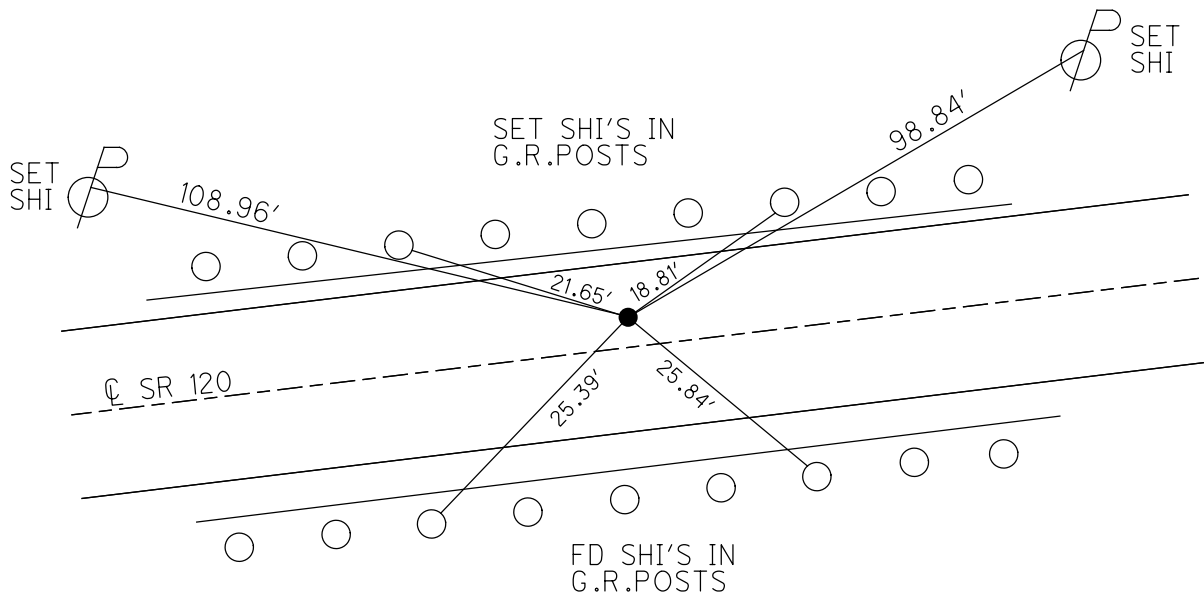

O.D.O.T. DISTRICT 2 SURVEY OFFICE

PERSONNEL

REFERENCE NO. 15 C

SHEET 38 OF 45

NOTES FINGER

DATE 5/20/11

ROUTE SR 120

H.C. LUMBREZER

WEATHER CLOUDY

COUNTY FULTON

R.C. MOSE

TEMP. 65°

TOWNSHIP AMBOY

SECTION 8

T 9 N R 4 E

TYPE MONUMENT MON.BOX



ON SURFACE - ~~BELOW~~ ON

LEFT - Q PAV'T - ~~RIGHT~~ 3.4'

6.8' TO LT EDGE PAVEMENT

S.L.M. 603+84

Grid: Northing: 748854.689 Easting: 1569566.752

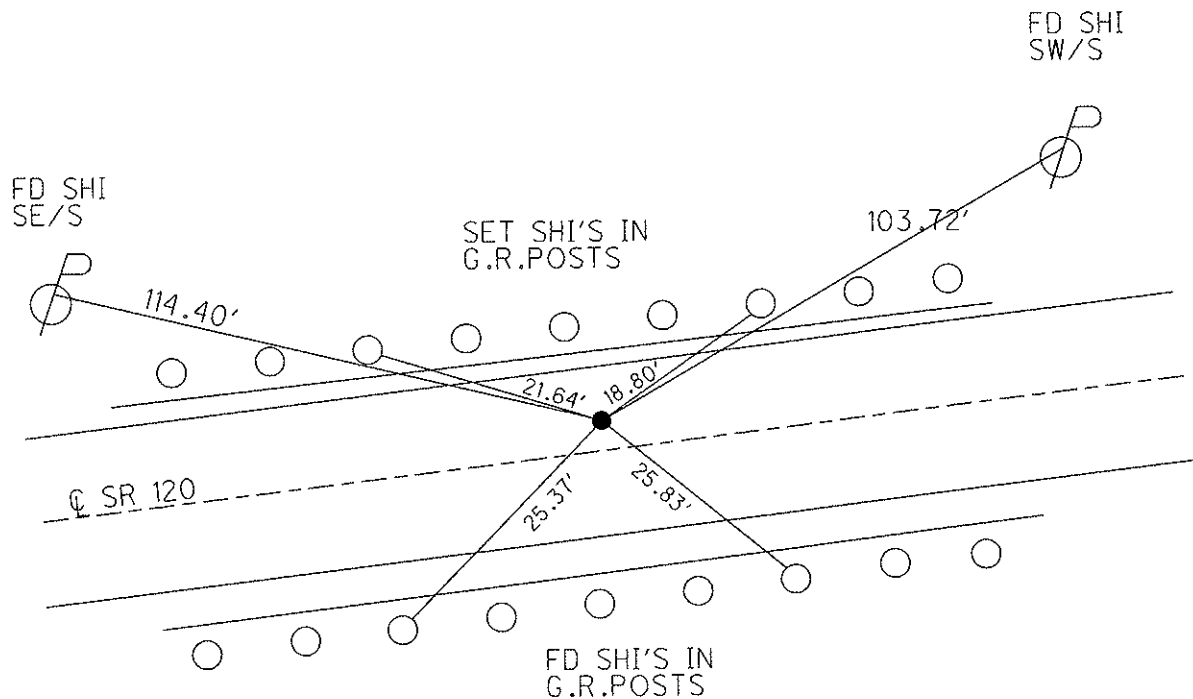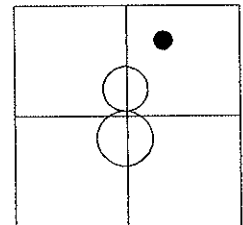

SET MAG/WASHER
8/18/03, DCH

FD MAG/WASHER
5/20/11, RJL

GPS, REFC15
5/23/11, RJL

O.D.O.T. DISTRICT 2 SURVEY OFFICE

PERSONNEL

REFERENCE NO. 15-B

SHEET 9 OF

NOTES 1. Stone

H.C. D. Curtis

R.C. J. Householder

DATE 18 April 91

WEATHER Coal

TEMP. 52°

ROUTE SR#120

COUNTY Fulton

TOWNSHIP Ambey

SECTION 8

T R

TYPE MONUMENT R. R. Spk.



ON SURFACE - BELOW Surface

LEFT- PAV'T. - RIGHT 3.5

4.5 TO Lt EDGE PAVEMENT


S.L.M. 603+84

EXPOSED
3-18-92

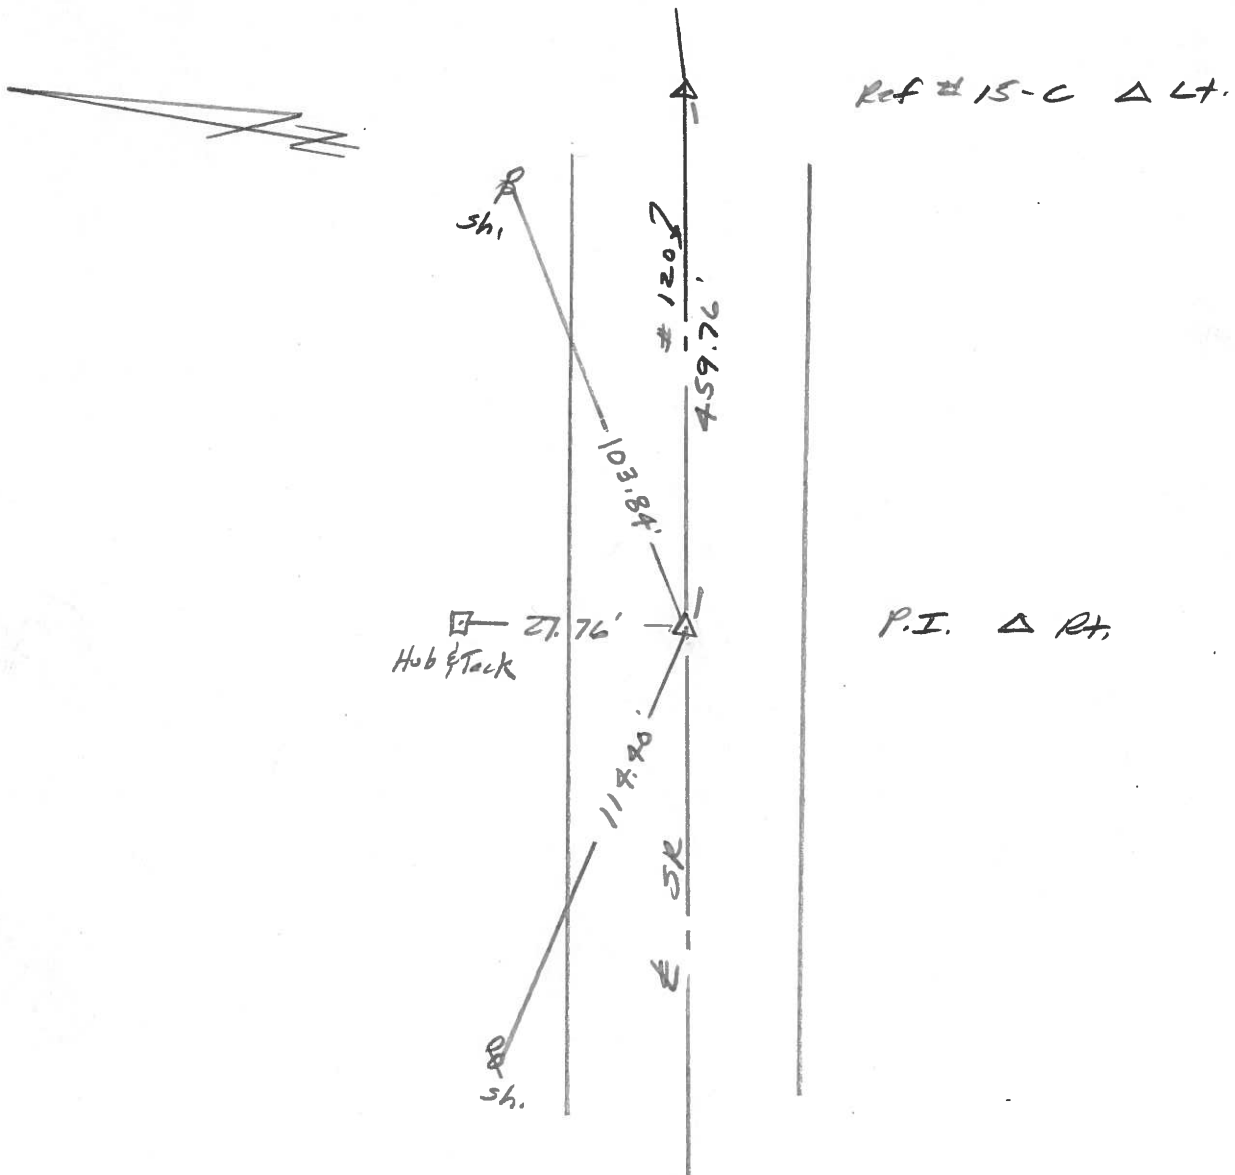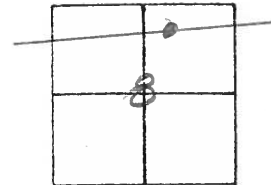

O.D.O.T. DISTRICT 2 SURVEY OFFICE

SHEET 7 OF

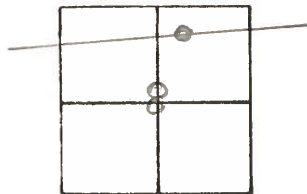County Fulton S.R. 120Township AmboySection 8T N, R EPersonnel 1. StoneP. NeuserR. MichalakD. CurtisDate 12 May 81Weather ClearTemp. 58°

REF. NO. 15B

Shiner

103.90'

114.50'

5R

E

84.05'

Shiner 4' high
Cut off T. Blc

Shiner

Fd. 1. Rod 3" deep

PI Δ Rt,

4.4' to N. edge put,

11.6' + S. edge put,

Set Small Spk 7/28/81

O.D.O.T. DISTRICT 2 SURVEY OFFICE

PERSONNEL

NOTES _____
H.C. _____
R.C. _____


REFERENCE NO. 15C

DATE 8-15-03
WEATHER SUNNY
TEMP. 75°

SHEET 14 OF 18

ROUTE SR 120
COUNTY FULTON
TOWNSHIP AMBOY
SECTION 8
T 9 S R 4 E

TYPE MONUMENT PK NAIL & WASHER
ON SURFACE - ~~BELOW~~ ON
LEFT - ~~Q~~ PAV'T - ~~RIGHT~~ 3.5'
6.5 TO LT EDGE PAVEMENT
S.L.M. 603+84

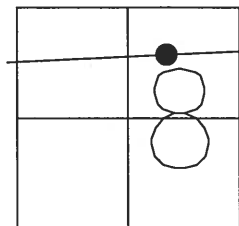

SET MAG NAIL
& WASHER
8-18-03
DCH

