

O.D.O.T. DISTRICT 2 SURVEY OFFICE (USE ONLY)

PERSONNEL

REFERENCE NO. 15 D

SHEET 39 OF 47

NOTES FINGER

DATE 5/20/11

ROUTE SR 120

H.C. LUMBREZER

WEATHER CLOUDY

COUNTY FULTON

R.C. MOSER

TEMP. 65°

TOWNSHIP AMBOY

DWG BY NASON PID 101243

SECTION 8

T 9 N R 4 E

TYPE MONUMENT D.N.F. R.R.SPIKE

~~ON SURFACE~~ - BELOW 6"

OFFSET $\varnothing$ PAVEMENT _____ LT : RT

_____ TO _____ EDGE PAVEMENT


STATION: 608+76.84

HORZ.DATUM: NAD83 (2011)


GEOID: 2012A

GRID: NORTHING: 748907.472

EASTING: 1570026.547

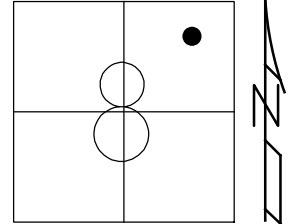

RECORD: 1991
FD R.R.SPIKE
6" DOWN
459.76' TO REF 15B
D.N.F.
CALC.POINT USED
3/5/18, JFO

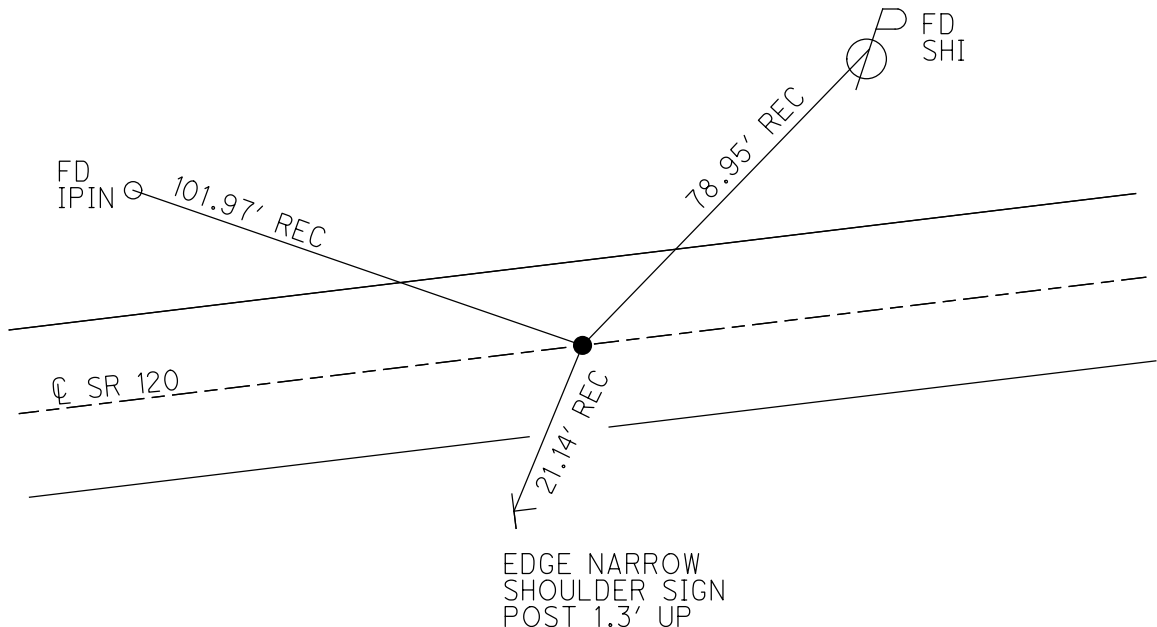

O.D.O.T. DISTRICT 2 SURVEY OFFICE

PERSONNEL

REFERENCE NO. 15 D

SHEET 39 OF 45

NOTES FINGER

DATE 5/20/11

ROUTE SR 120

H.C. LUMBREZER

WEATHER CLOUDY

COUNTY FULTON

R.C. MOSER

TEMP. 65°

TOWNSHIP AMBOY

SECTION 8

T 9 N R 4 E

TYPE MONUMENT R.R.SPIKE D.N.F.


~~ON SURFACE~~ - BELOW 6"

LEFT - Q PAV'T - ~~RIGHT~~ ?


TO EDGE PAVEMENT

S.L.M. 608+44

Grid: Northing: _____ Easting: _____

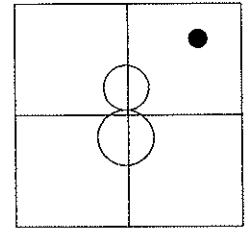

RECORD: 1991
FD R.R.SPIKE, 6" DOWN.
459.76' TO REF 15B.

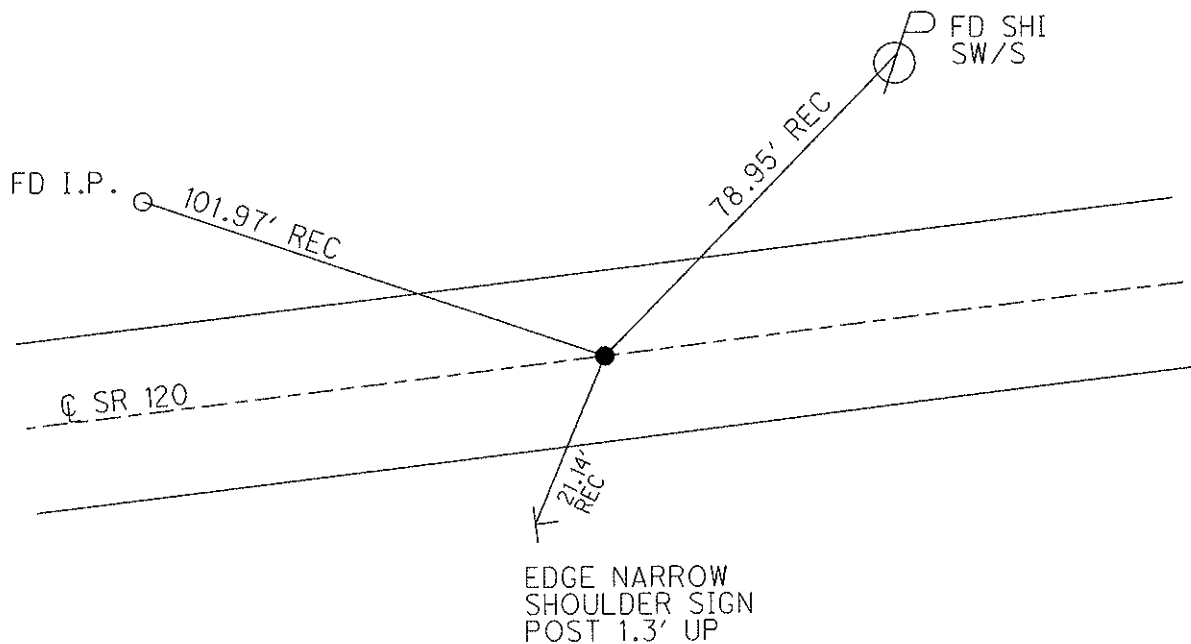

O.D.O.T. DISTRICT 2 SURVEY OFFICE

PERSONNEL

REFERENCE NO. 15-C

SHEET 10 OF

NOTES L. Stone

H.C. D. Curtis

R.C. J. Hauscholder

DATE 18 April 91

WEATHER Cloud

TEMP. 51°

ROUTE SR#120

COUNTY Fulton

TOWNSHIP Amboy

SECTION 8

T R



TYPE MONUMENT RR Spt. D.O Not Reset

ON SURFACE - BELOW 6" deep

LEFT - & PAW'T. - RIGHT

TO EDGE PAVEMENT

S.L.M. 608+44

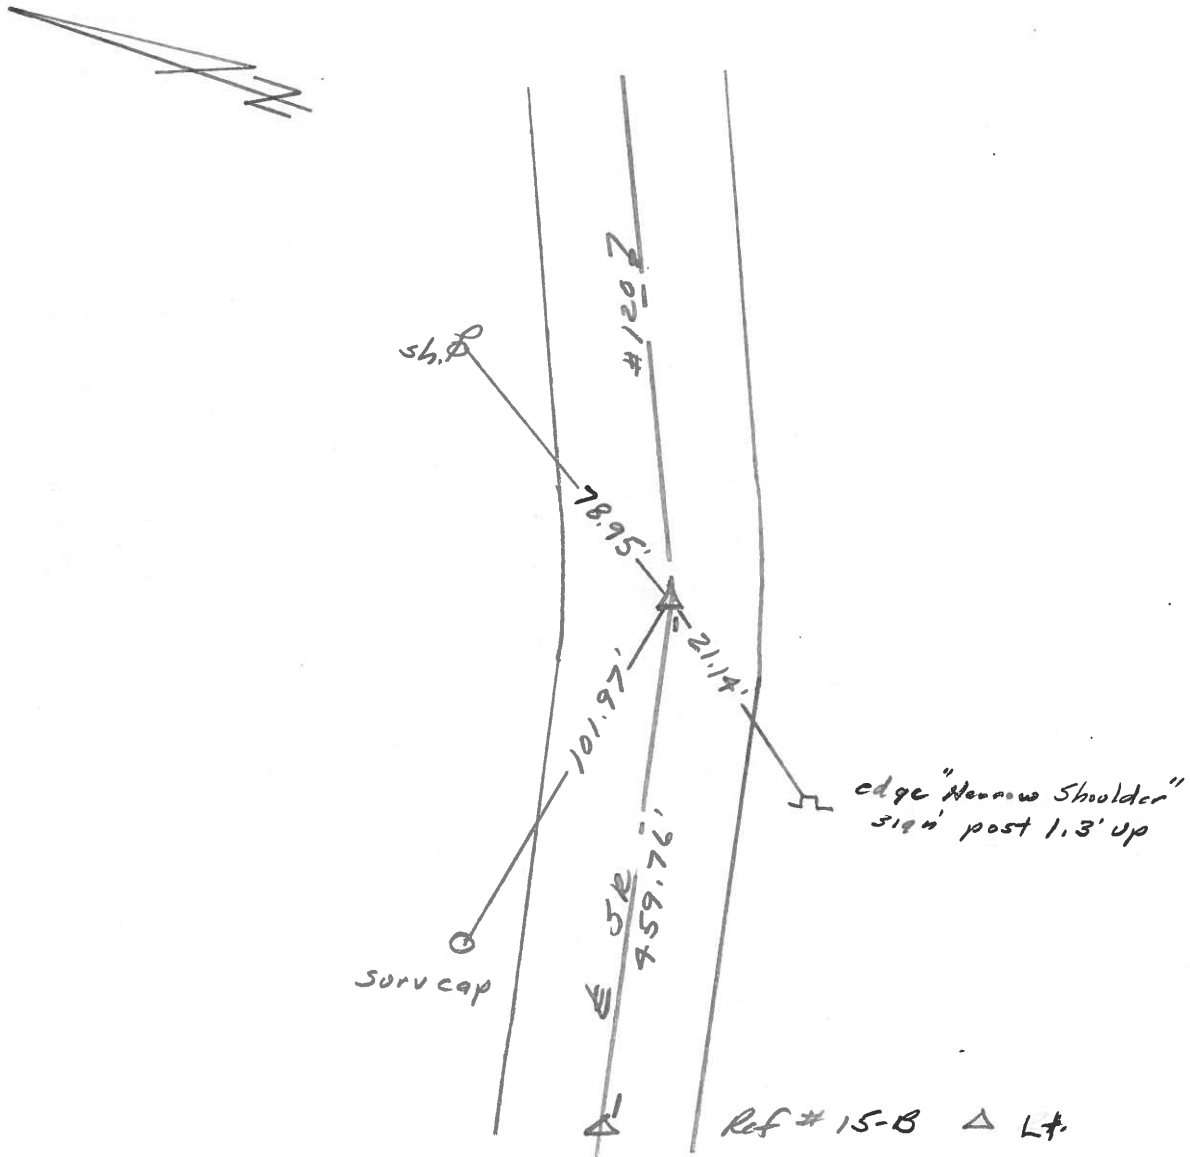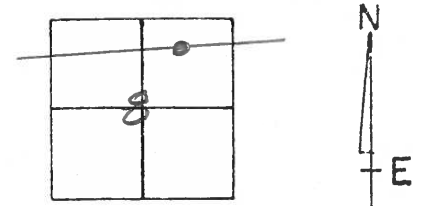

O.D.O.T. DISTRICT 2 SURVEY OFFICE

PERSONNEL

NOTES _____
H.C. _____
R.C. _____


REFERENCE NO. IS-D

DATE 8-15-03
WEATHER SUNNY
TEMP. 75°

SHEET 15 OF 18

ROUTE SR 120
COUNTY FULTON
TOWNSHIP AMBOY
SECTION 8
T 9 S R 4 E

TYPE MONUMENT _____ DID NOT FIND
ON SURFACE - ~~BELOW~~ _____
LEFT - ~~C~~ PAV'T - ~~RIGHT~~ _____
_____ TO _____ EDGE PAVEMENT
S.L.M. _____ 608+44

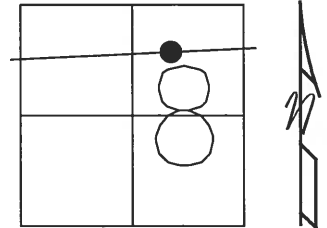

Records: 1991 Fd. R.R. SPK, 6" Down

