

O.D.O.T. DISTRICT 2 SURVEY OFFICE (USE ONLY)

PERSONNEL

REFERENCE NO. 27

SHEET 53 OF 61

NOTES MICHALAK

H.C. HOMAN

R.C. MALINSKY

DATE 6/6/02

WEATHER CLOUDY

TEMP. 56°

ROUTE US 20A

COUNTY FULTON

TOWNSHIP CLINTON

SECTION 11

T 7 N R 6 E

TYPE MONUMENT SM.R.R.SPIKE

ON SURFACE - ~~BELOW~~ ON


LEFT - Q PAV'T - RIGHT ON

- TO - EDGE PAVEMENT


S.L.M. 689+71

GRID: NORTHING: _____

EASTING: _____

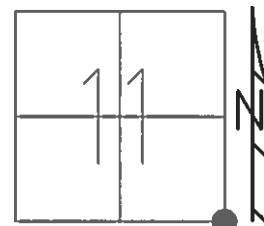

SET MAG/WASHER
7-18-03, DCH

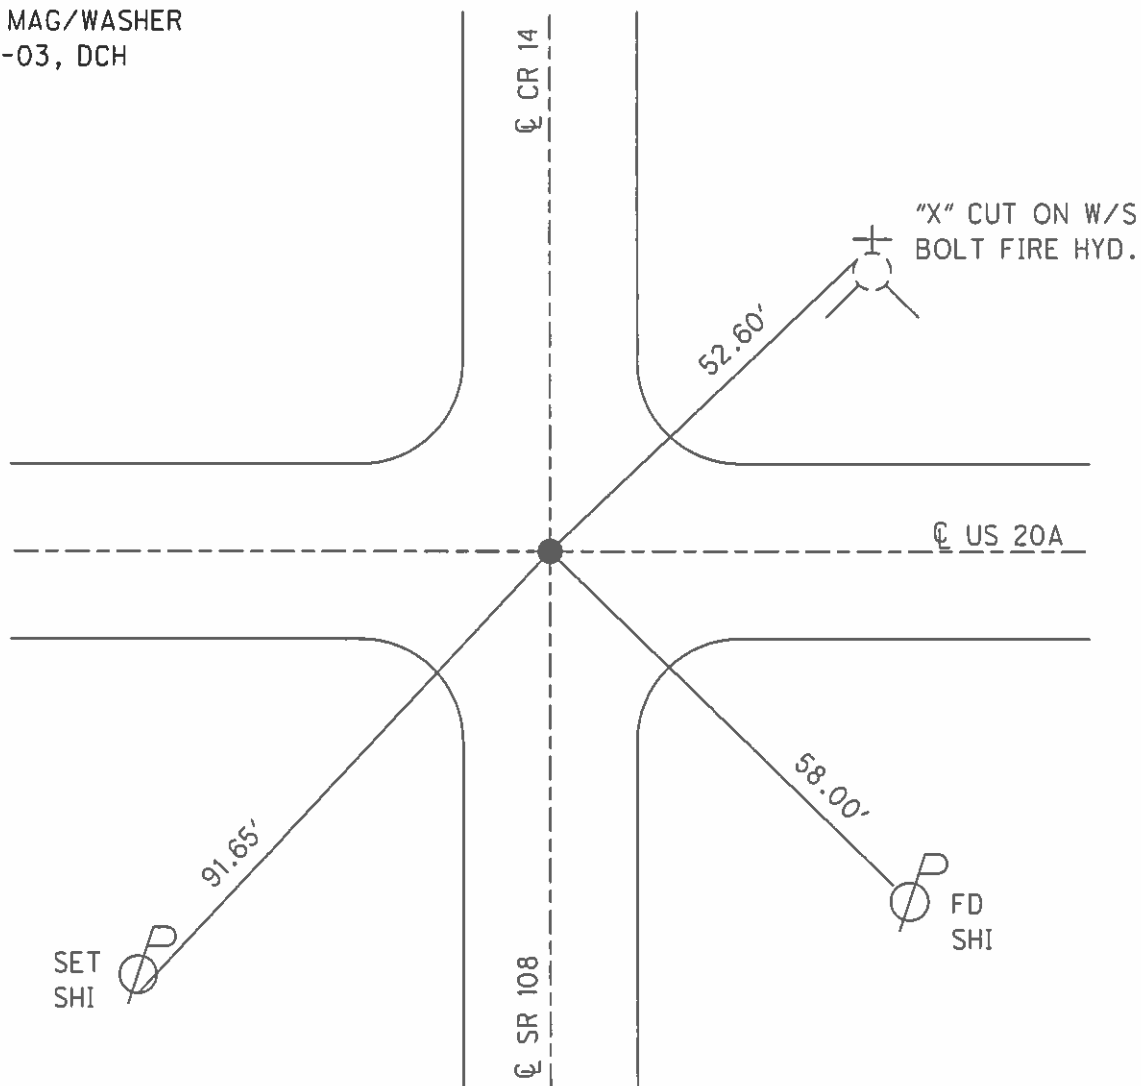

O.D.O.T. DISTRICT 2 SURVEY OFFICE

PERSONNEL

REFERENCE NO. 27

SHEET 30 OF 30

NOTES MICHALAK

DATE 6-6-02

ROUTE U.S. 20-A

H.C. HOMAN

WEATHER RAIN

COUNTY FULTON

R.C. MALINSKY

TEMP. 56°

TOWNSHIP CLINTON

SECTION 11-12-13-14

T 7 N R 6 E


TYPE MONUMENT SMALL RR SPIKE

ON SURFACE - ~~BELOW~~ YES


~~LEFT - C~~ PAVT - ~~RIGHT~~ YES

TO EDGE PAVEMENT

S.L.M. 689+71

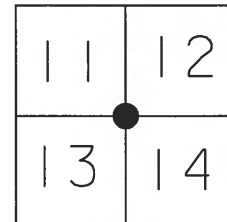

SET MAG NAIL
& WASHER
7-18-03
DCH

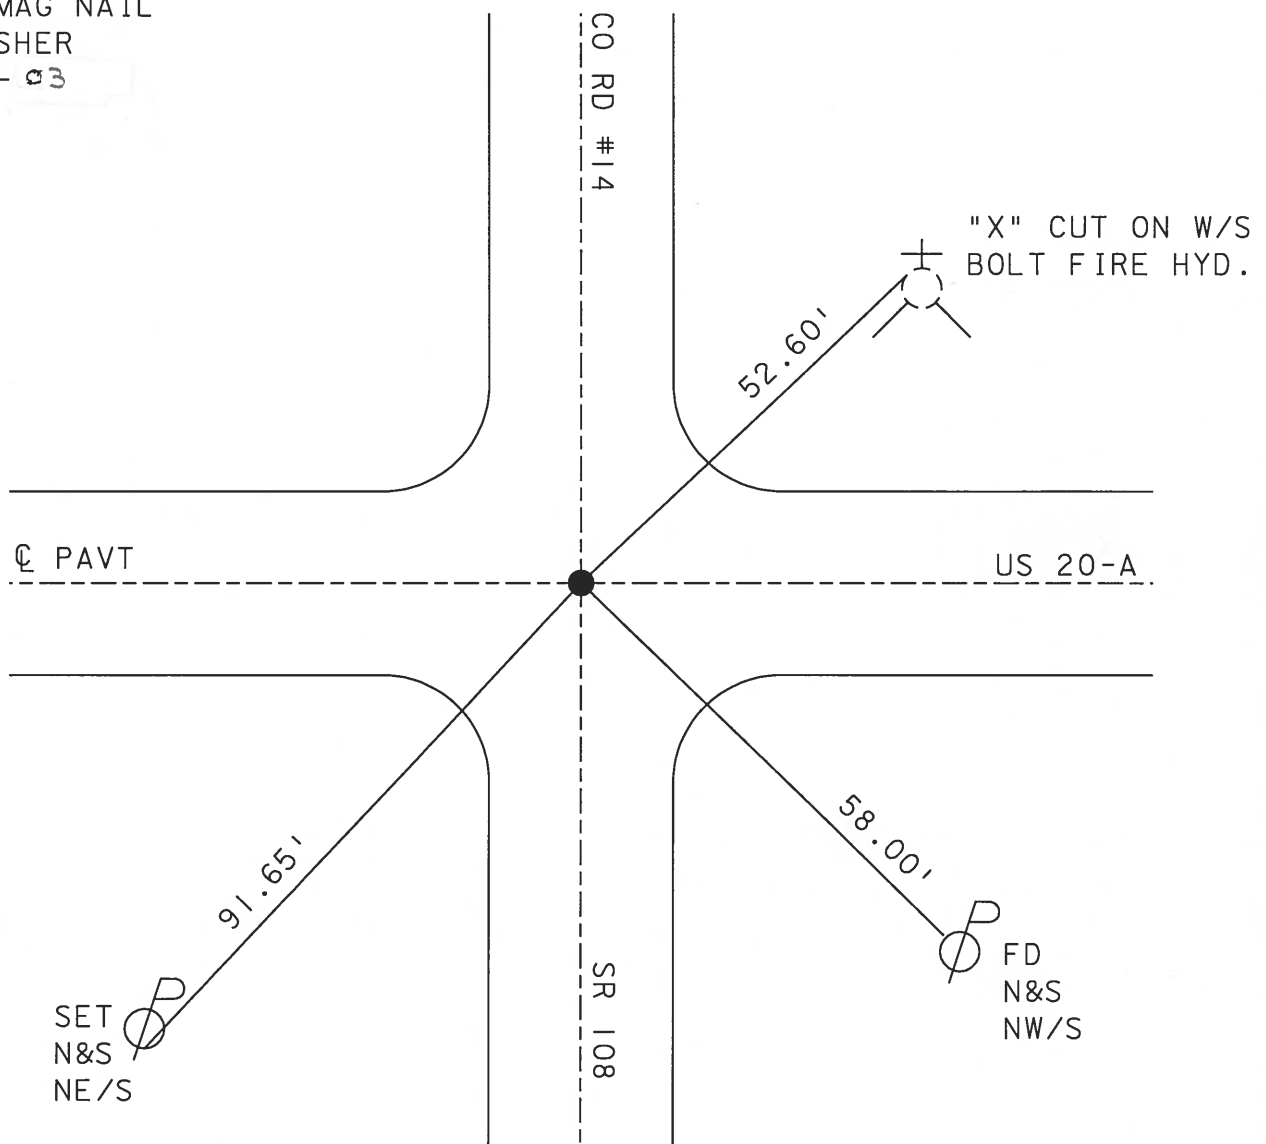

O.D.O.T. DISTRICT 2 SURVEY OFFICE

PERSONNEL

REFERENCE NO. 27

SHEET 4 OF 24

NOTES 1. Stone

H.C. D. Curtis

R.C. J. Housholder

DATE 16 Sept. 86

WEATHER Cool

TEMP. 50°

ROUTE US #20-A

COUNTY Fulton

TOWNSHIP Clinton

SECTION 11-12-13-14

T R


TYPE MONUMENT Small RR Spk

ON SURFACE - BELOW Surface


LEFT- & PAV'T. - RIGHT

 TO EDGE PAVEMENT

S.L.M. 690+18

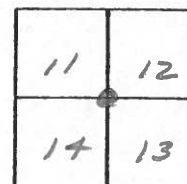

SET SMALL R.R. SPK. TO SURFACE
4-29-88

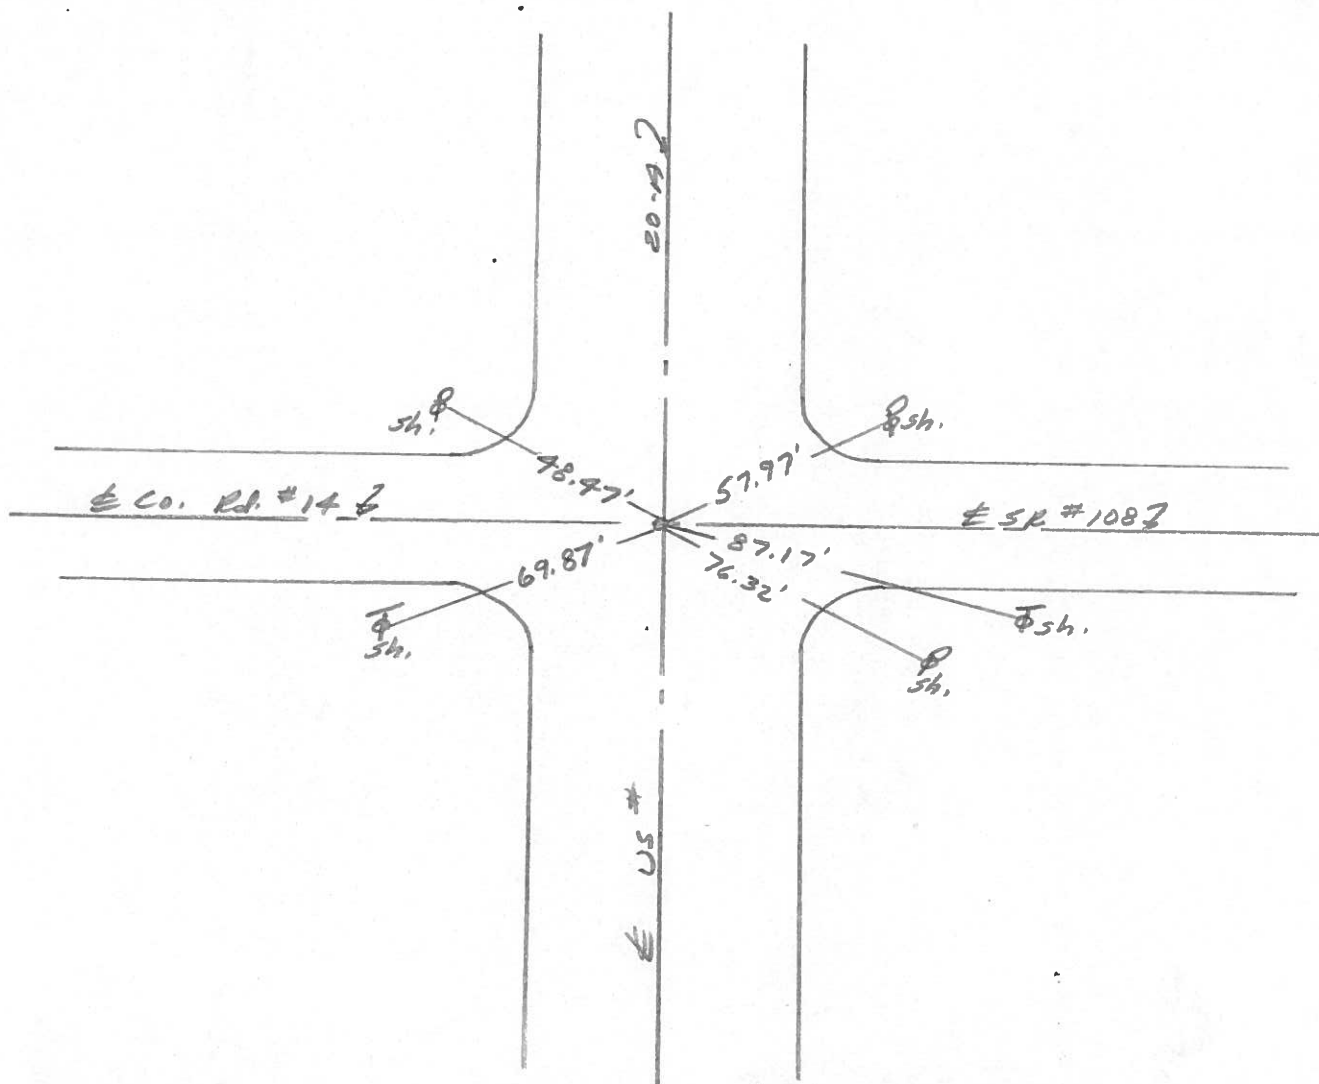

O.D.O.T. DISTRICT 2 SURVEY OFFICE

SHEET 1 OF 1

County Fulton S.R. US20A #SR2

Date 6-5-1980

Township Clinton

Weather Clear

Section NW Cor. Sec. 13


Temp. +80°

T1N, R1E

Personnel Smith


Bowers

Mead

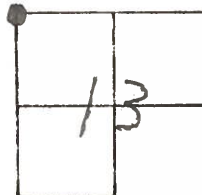

(27)

Fd 1" Iron Pipe
@ Surface

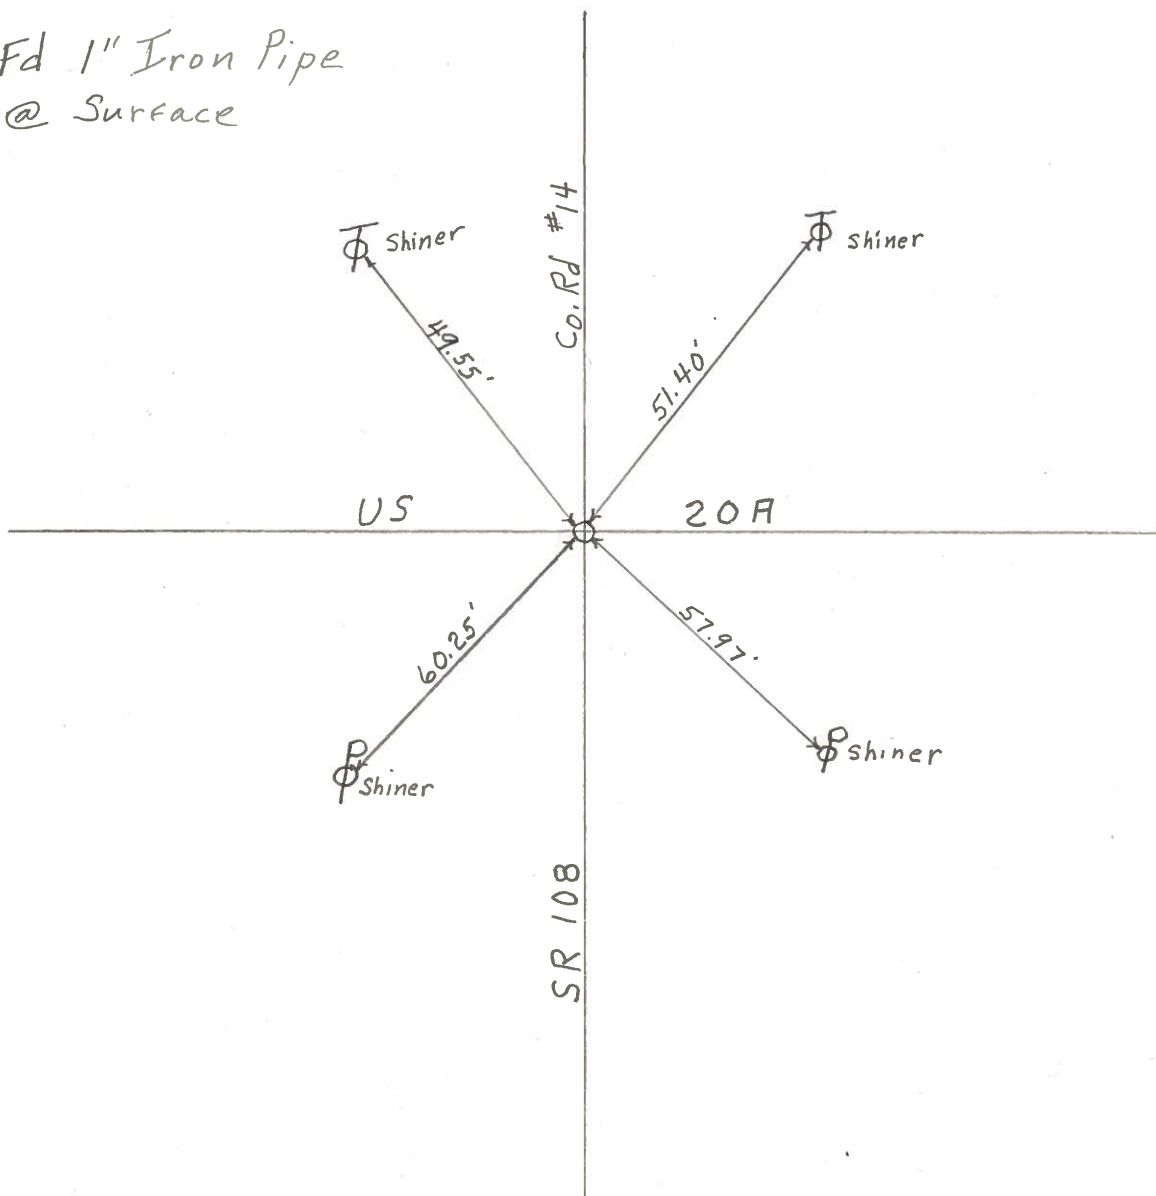

Q.D.O.T. DISTRICT 2 SURVEY OFFICE

Sht. 30 of

County Fulton S.R. 05 20 A

Township Clinton

Section 11


T N, R E

Personnel L. Stone
R. Michalak
P. Neuser
D. Curtis
D. Granata

Date 29 June 79


Weather cloudy

Temp. 74°

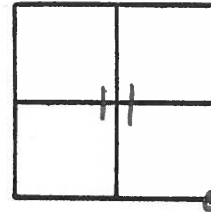

REF. NO. 27

SLM BLKTOP STA. 689+69

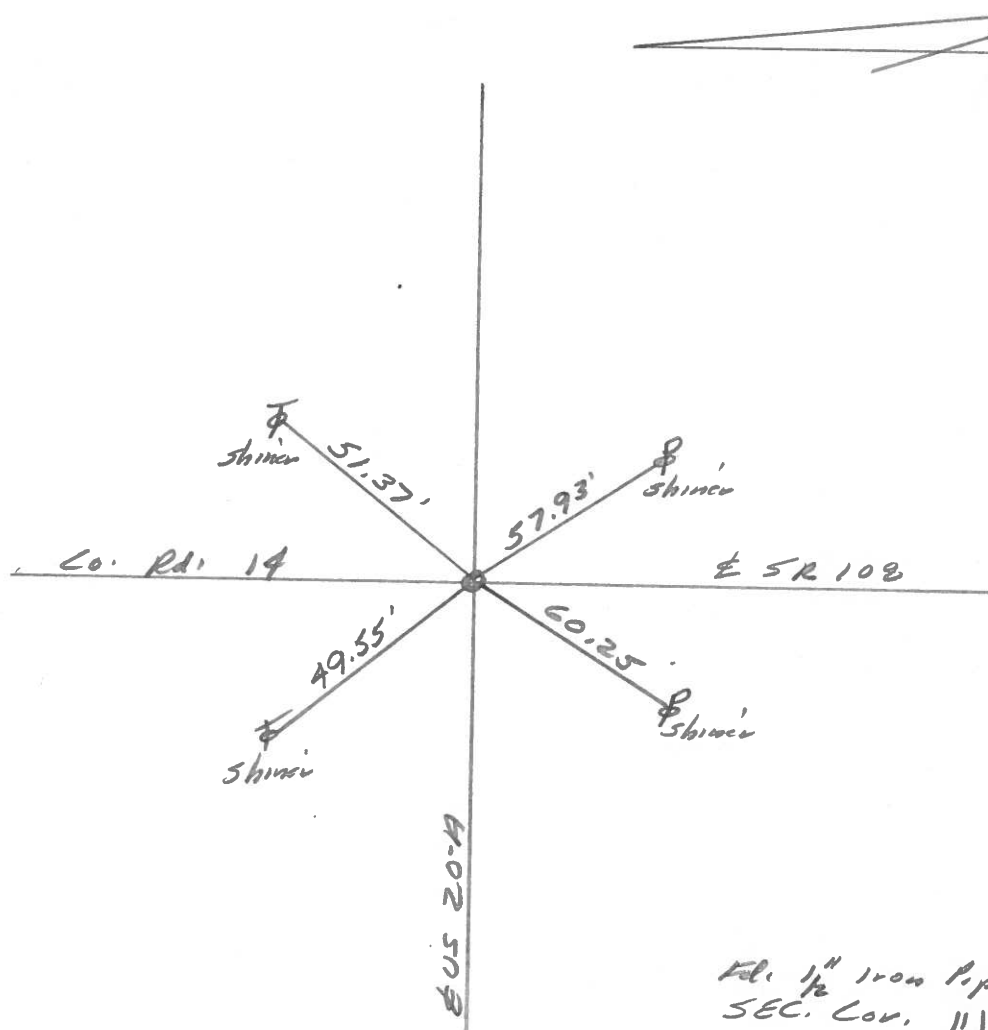

Rel. $\frac{1}{2}$ " Iron P. p. To Surface
 SEC. Cor. $\frac{11}{14} \frac{12}{13}$
 Old Sta. 689+78.36


PERSONNEL	TITLE	PERSONNEL	TITLE	COUNTY	Fulton	DATE	Jan 1972
Red Beach				S. R.	US 20-A	WEATHER	
Newcomb				SEC.	12, Clinton Twp. T-7-N	TEMP.	
Knap							
Eriksen							

DESCRIPTION ALIGNMENT & CONTROLS JOB NO. _____


LEFT

CENTER LINE

RIGHT

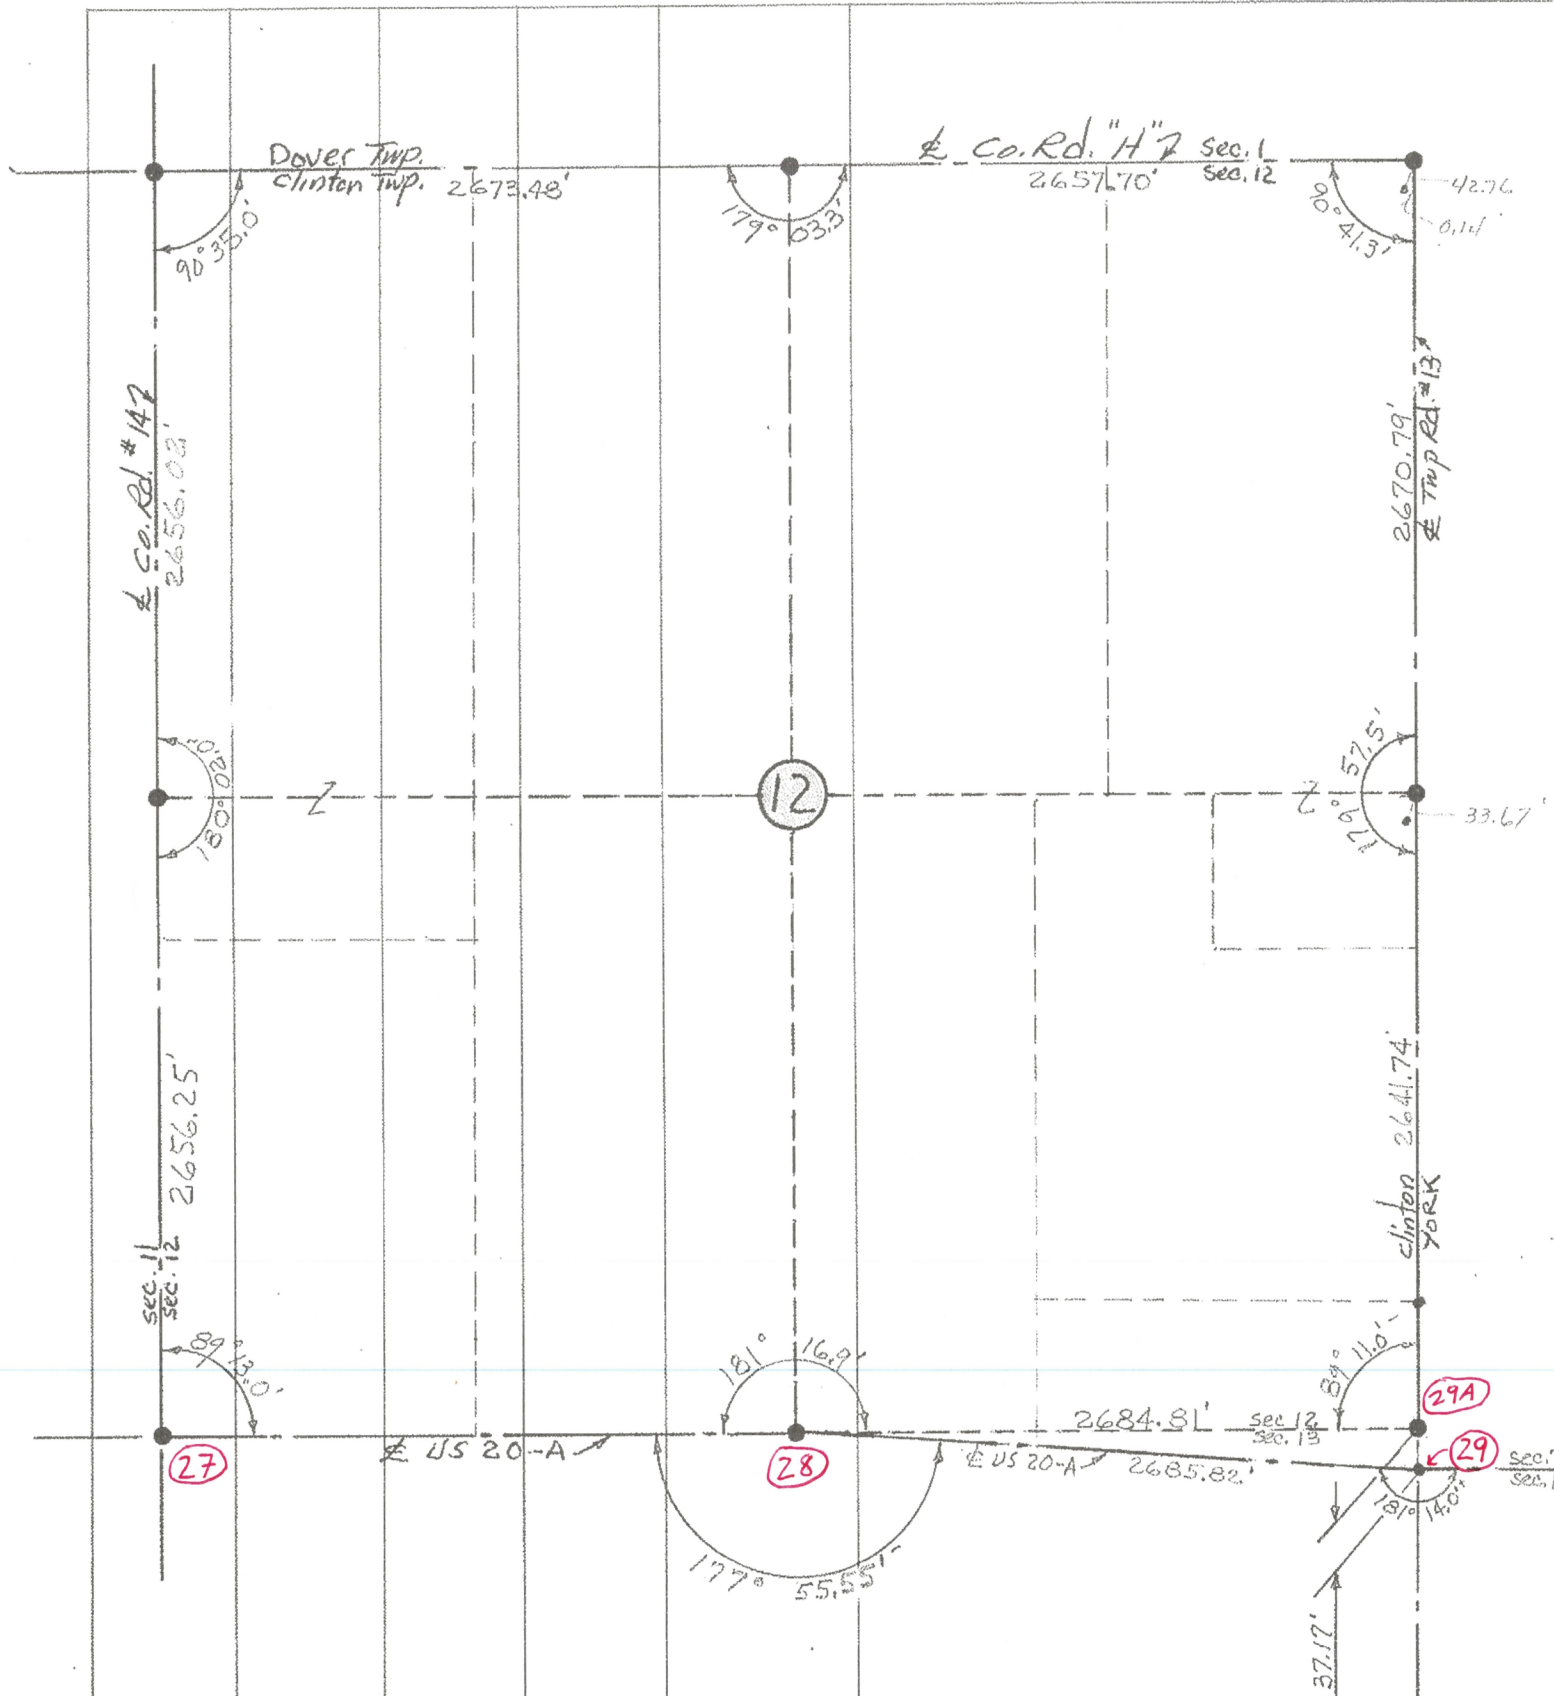


PERSONNEL	TITLE	PERSONNEL	TITLE	COUNTY	FULTON	DATE	Jan 1972
Red Beach				S. R.	US 20-A	WEATHER	
Newcomb				SEC.	13 Clinton Twp. T-7-N	TEMP.	
Knappe							
Eriksen							
ALIGNMENT & CONTROLS				JOB NO. _____			
LEFT		CENTER LINE		RIGHT			

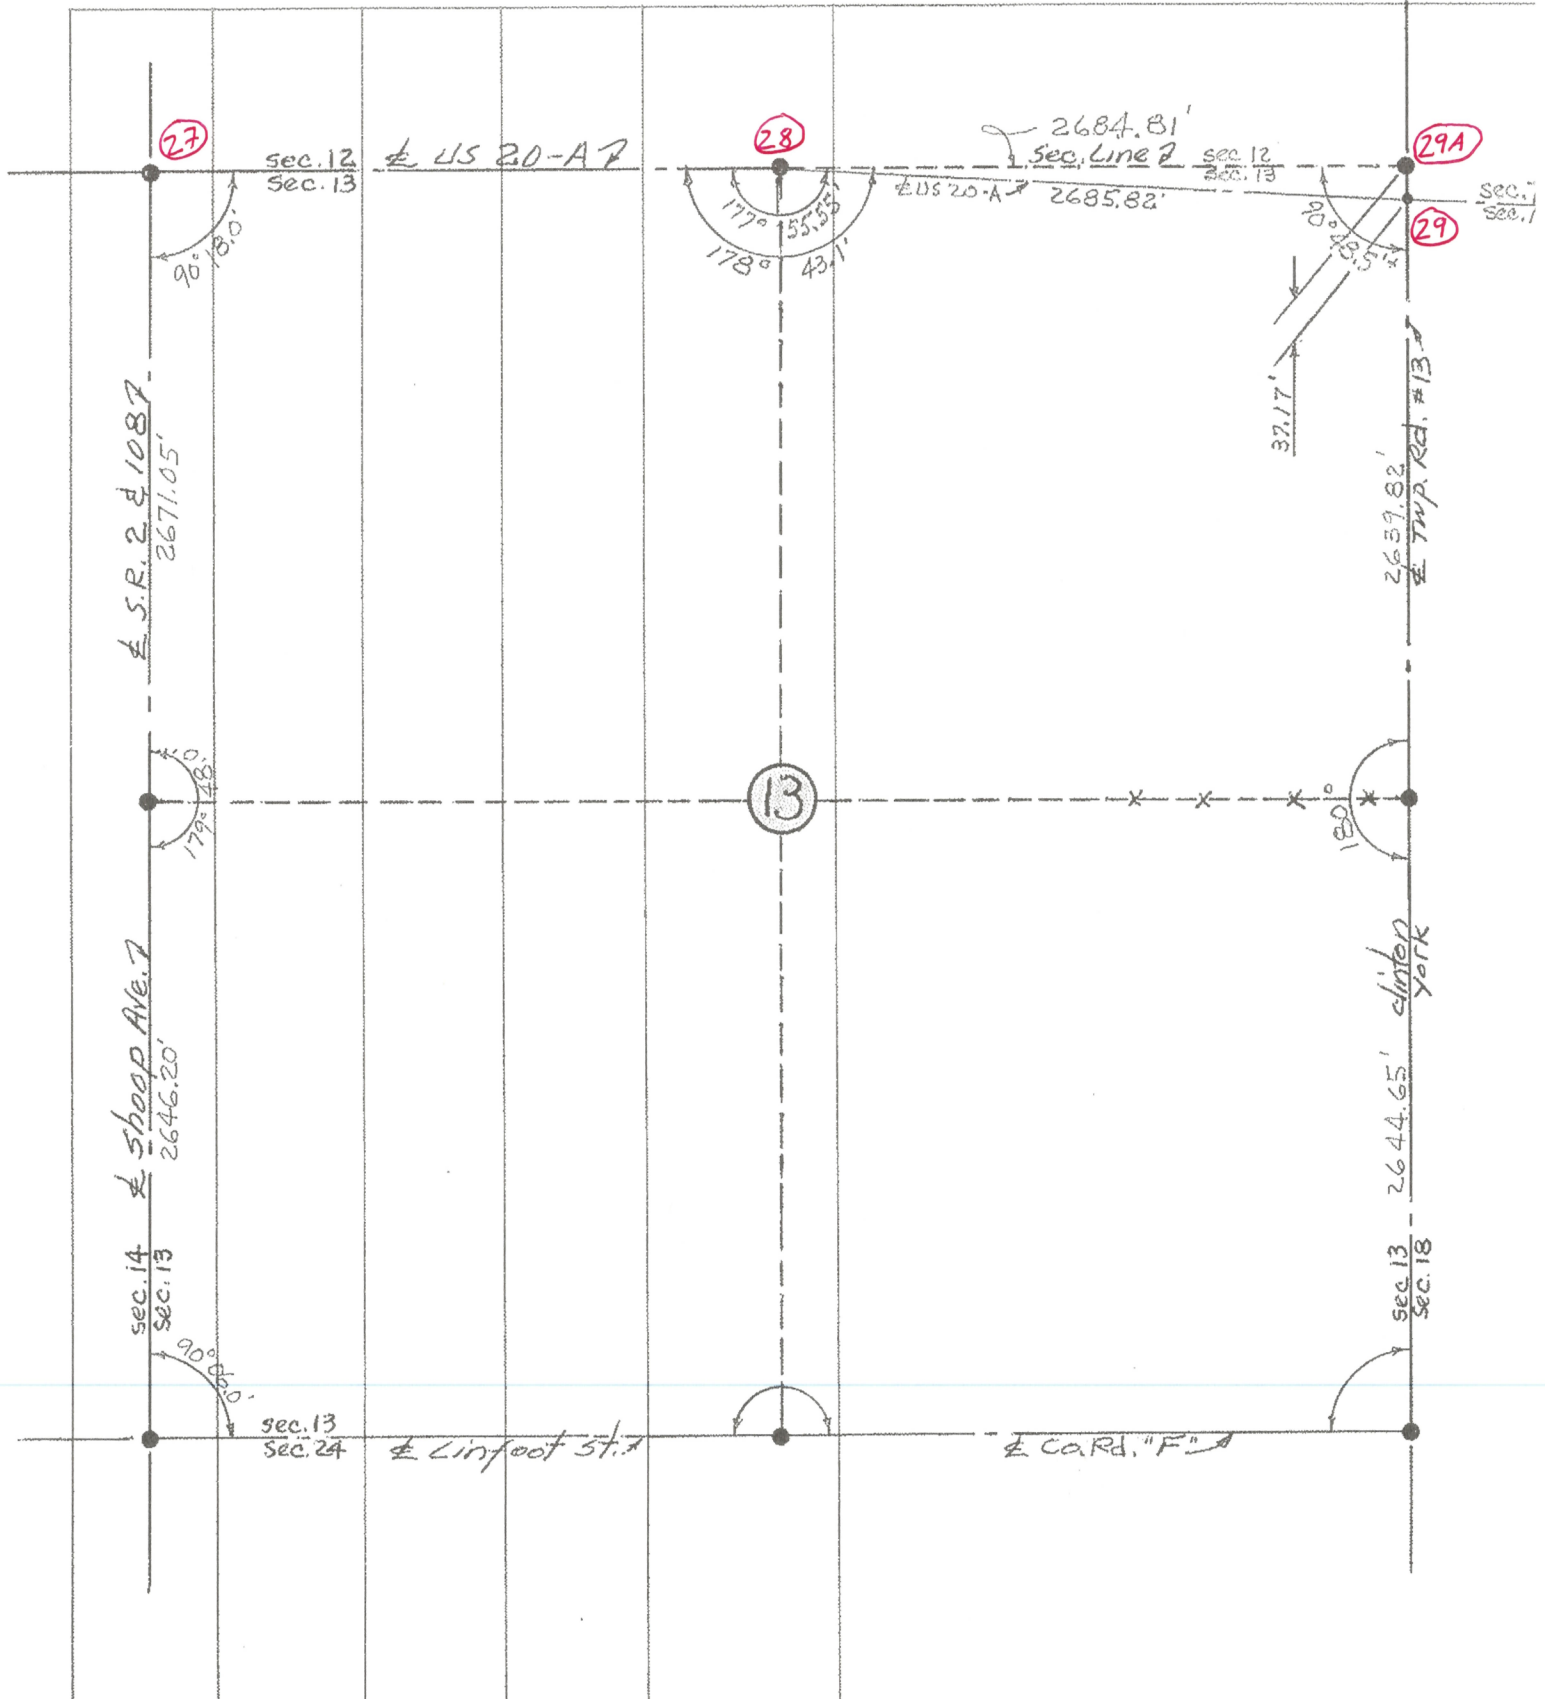

PERSONNEL	TITLE	PERSONNEL	TITLE	COUNTY	DATE	WEATHER	TEMP.
Tamsic				Fulto	April		
Newser				S. R. US			
Vanyo				SEC. CLINTON			
Granata							

DESCRIPTION	LEFT	CENTER LINE	RIGHT	JOB NO.
-------------	------	-------------	-------	---------

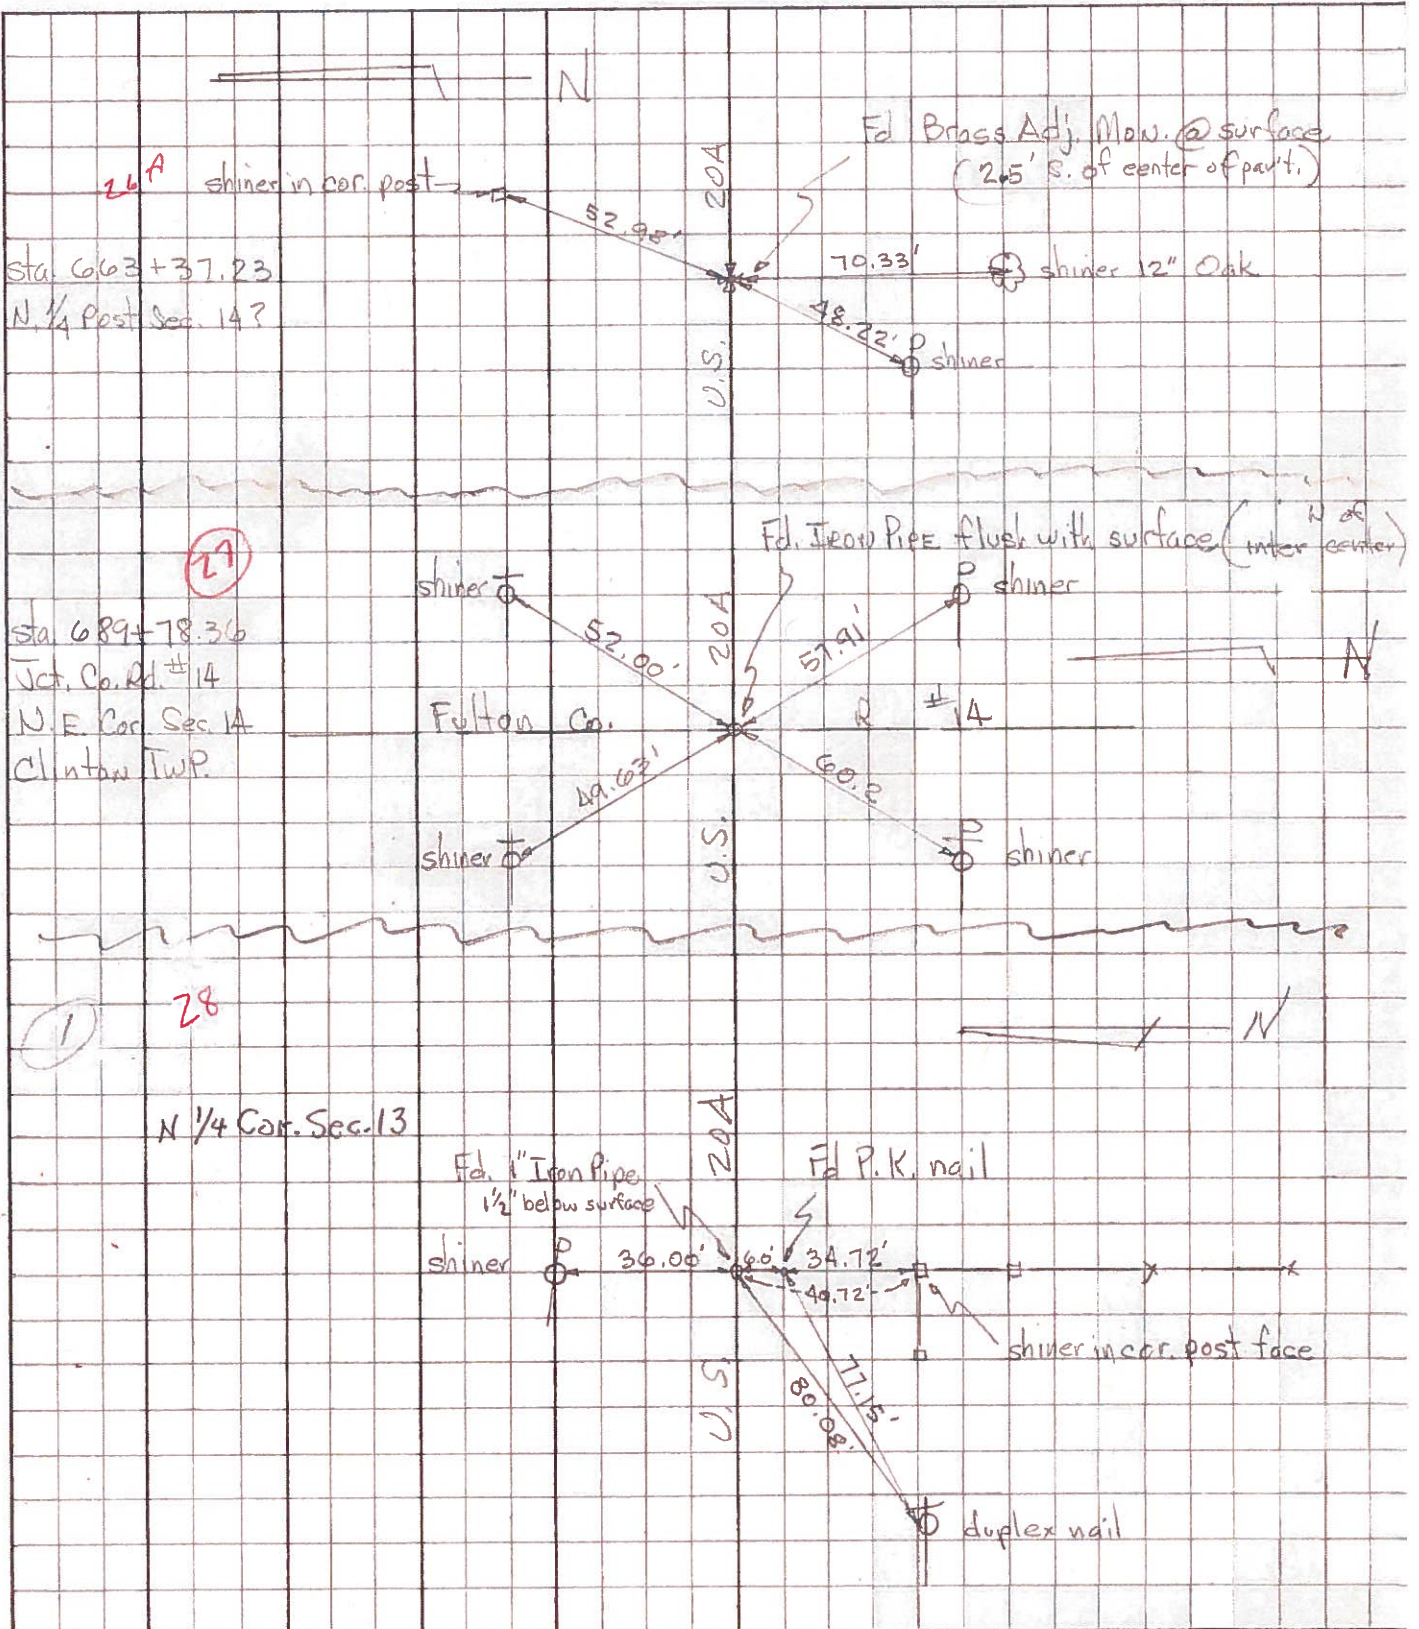

PERSONNEL TITLE PERSONNEL TITLE

Jameson

COUNTY FultonDATE 3-28-55

Passefall-9-12-60

S. R. #2

WEATHER

SEC. M, A. O

TEMP.

DESCRIPTION

LEFT

CENTER LINE

RIGHT

JOB NO.

1/2 mi. S. of Toledo-
Wauseon Rd.
(mon.)

#67

W. to shiner in A.P.
S.W. to shiner in 12' Elm
S.S.W. to shiner in 8' Elm

7.33'
3.5'
65.81'

1 mi. S. of Tol.-Wauseon
Rd.
(mon.)

#68

N.E. to shiner in P.P.
S.E. to shiner in P.P.
N.W. to shiner in Guy pole
W.S.W. to shiner in T.P.

1.3'
43.06'
8.0
92.50'

1 1/2 mi. S. of Tol.-Wauseon
Rd.
(mon.)

#69

S.W. to shiner in 12' maple
N.W. to shiner in 12' maple
S.E. to shiner in 18' Catalpa

43.8
39.7
36.5

Sta. 0+00
S.W. cor Sec. 12
Brass Adjustable.
20A & S.R. 2

#70


S.E. to shiner in P.P.
S.W. to shiner in T.P.
N.W. to Cor. block bldg. 2nd to Guy.
N.E. to shiner in I.P.

46.75
77.2
7.80
50.58' 48.07'

P.L. Sta. 26+76.59
N 1/4 Sec #12 York Twp

#71

Fd. P.K. & Shiner
(Did not find)
35.97'

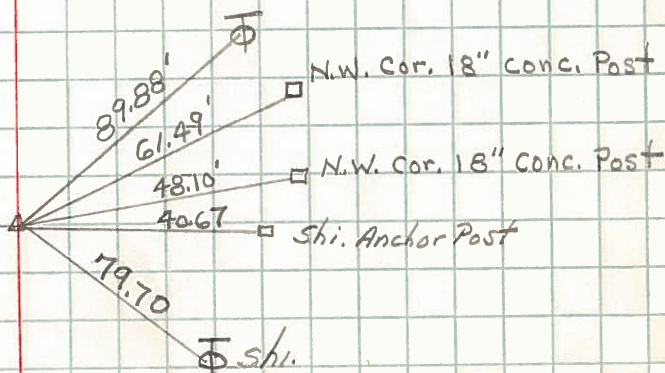

PERSONNEL	TITLE	PERSONNEL	TITLE	COUNTY	DATE	WEATHER	TEMP.
Pessafail				Fulton	9-29-60	Clear	72°
Wisc				S. R. 20-A & 2			
Baird				SEC.			
Newcomb							

DESCRIPTION Wauseon to Delta

JOB NO. _____

LEFT

CENTER LINE

RIGHT

OK. 10-18-61 H. K. Knappe

OK. 10-18-61 H. K. Knappe

70
Sta 0+00
S.W. Cor Sec 12
Mobar

