

O.D.O.T. DISTRICT 2 SURVEY OFFICE (USE ONLY)

PERSONNEL

REFERENCE NO. 28

SHEET 55 OF 62

NOTES MILLER

DATE 7/16/19

ROUTE US 20A

H.C. O'DONNELL

WEATHER CLOUDY

COUNTY FULTON

R.C. AUBLE

TEMP. 78°

TOWNSHIP CLINTON

RHOADES

SECTION 1

DWG BY NASON PID 101232

T 7 N R 6 E

TYPE MONUMENT P.K.SHANK

ON SURFACE - ~~BELOW~~ ON

OFFSET Q PAVEMENT 2.4' LT : ~~RT~~

9.6' TO LT EDGE PAVEMENT


STATION: 716+46.27

HORZ.DATUM: NAD83(2011)


GEOID: 2012A

GRID: NORTHING: 698900.760

EASTING: 1523970.448

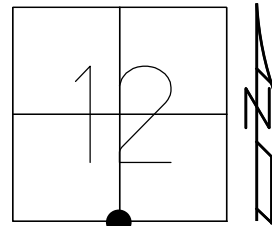

RECORD:
FD P.K.NAIL
9/16/04, MB
SET MAG/WASHER
10-13-04, DCH
FD P.K.SHANK
REF28
9/30/14, EBW
REF28
12/21/17, JFO
SET MAG/WASHER
10/22/19, JFO

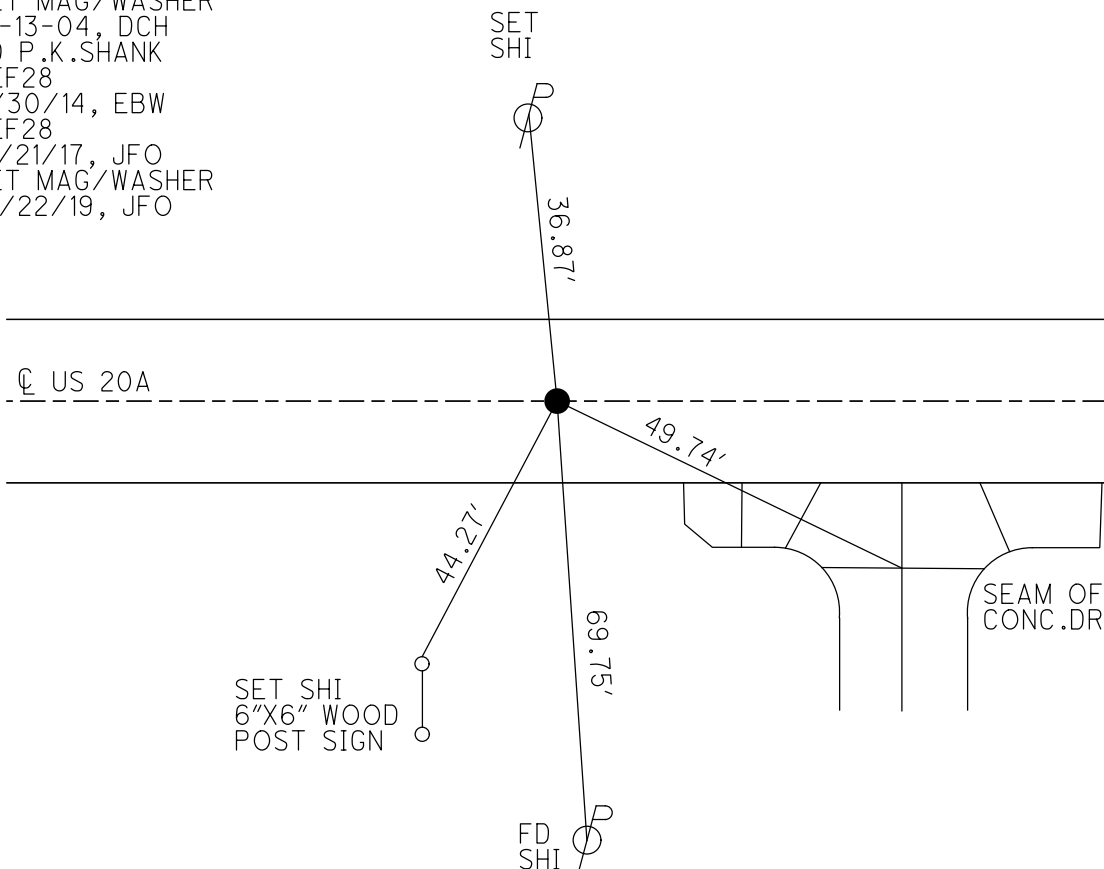

O.D.O.T. DISTRICT 2 SURVEY OFFICE (USE ONLY)

PERSONNEL

REFERENCE NO. 28

SHEET 54 OF 61

NOTES

HOMAN

DATE

9/16/04

ROUTE

US 20A

H.C.

CANTERBURY

WEATHER

CLOUDY

COUNTY

FULTON

R.C.

BARNHISEL

TEMP.

70°

TOWNSHIP

CLINTON

SECTION

13

T 7 N R 6 E

TYPE MONUMENT

P.K.NAIL

ON SURFACE - ~~BELOW~~ ON


LEFT - CL PAV'T - ~~RIGHT~~ 2.4'

9.6' TOLT EDGE PAVEMENT


S.L.M. 716+51

GRID: NORTHING:

EASTING:

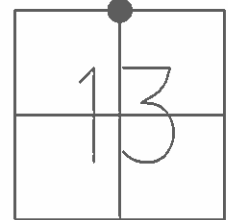

SET MAG/WASHER
10-13-04, DCH

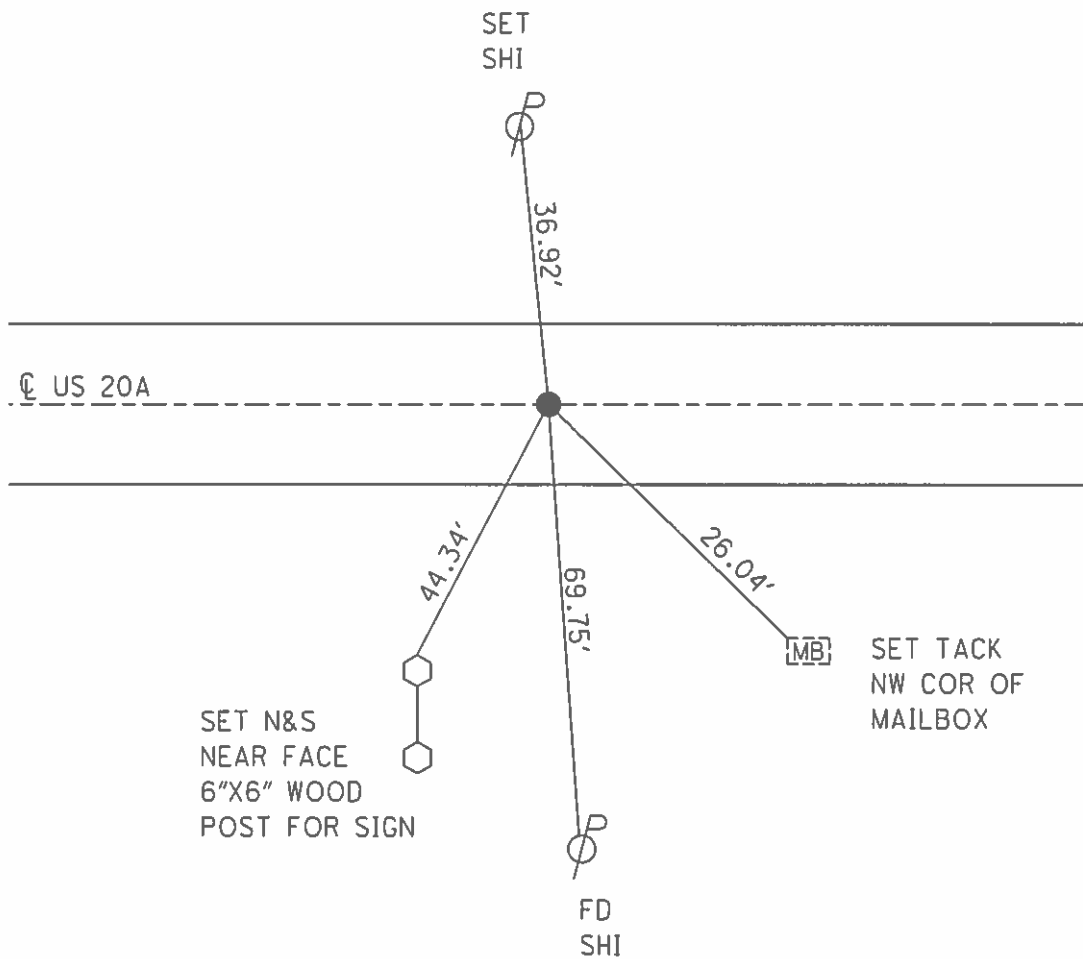

Resurfaced 2004

O.D.O.T. DISTRICT 2 SURVEY OFFICE

PERSONNEL

REFERENCE NO. 28

SHEET 5 OF 24

NOTES 1. Stone

H.C. D. Curtis

R.C. T. Householder

DATE 16 Sept. 86

WEATHER Cool

TEMP. 50°

ROUTE US #20-A

COUNTY Fulton

TOWNSHIP Clinton

SECTION 13

T R


TYPE MONUMENT P.K. Nail

ON SURFACE - BELOW Surface


LEFT - & PAV'T. - RIGHT

 TO EDGE PAVEMENT

S.L.M. 716 + 95

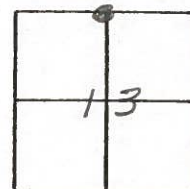


SET P.K. NAIL TO SURFACE
4-29-88

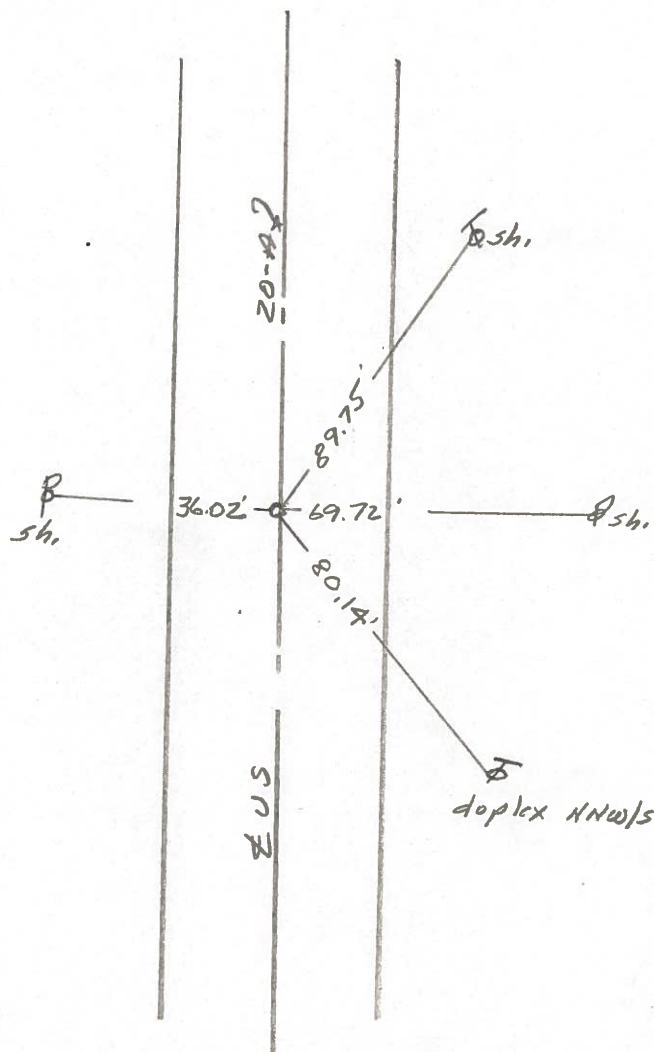


County Fulton S.R. US 20A#SR2Date 6-5-1980Township ClintonWeather ClearSection N $\frac{1}{4}$ Cor. Sec. 13Temp. +80°

T1N, R1E

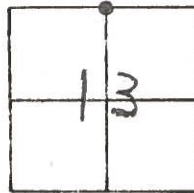Personnel SmithBowersMead

(28)

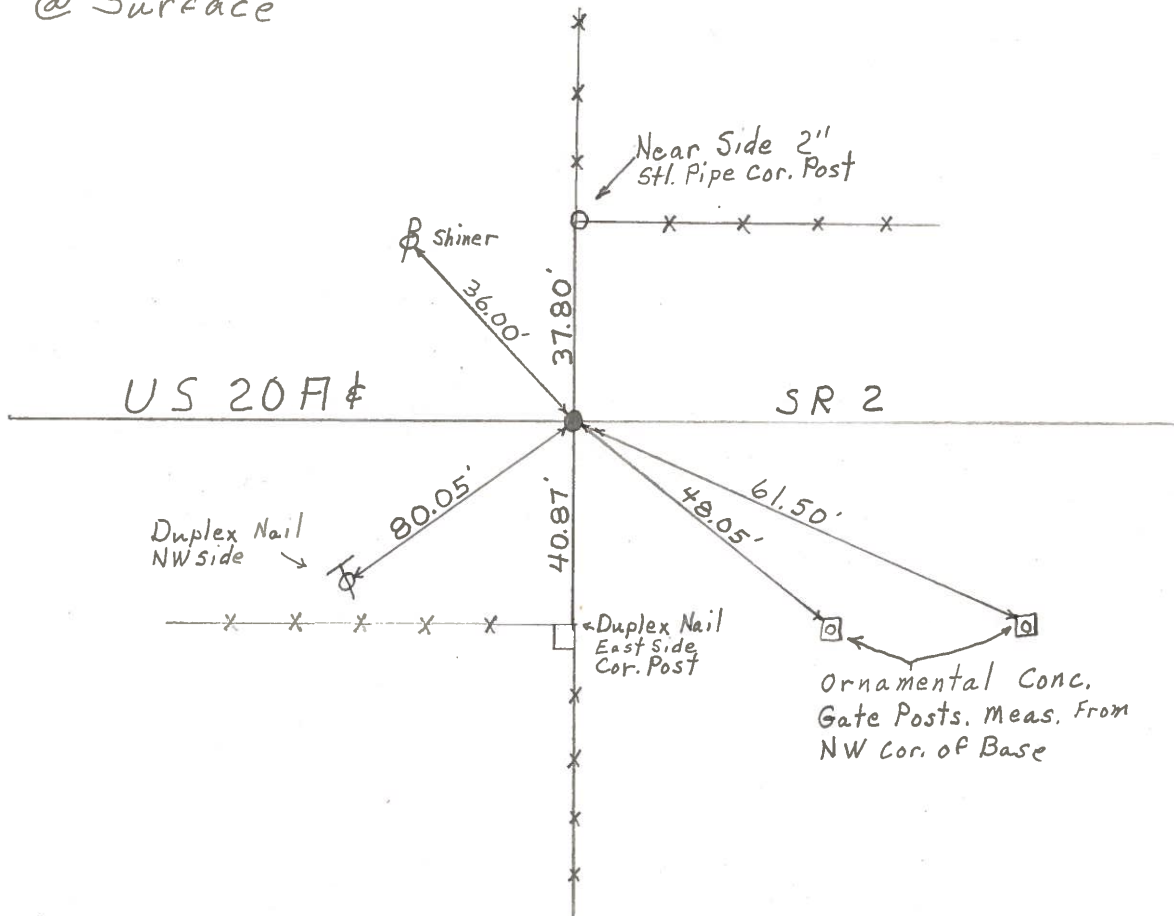Fd 1" Iron Pipe
@ Surface

PERSONNEL	TITLE
-----------	-------

PERSONNEL	TITLE
-----------	-------

COUNTY FULTON DATE Jan 1972

Red Beach
Newcomb

S. R. US 20-A WEATHER.


SEC. 13 Clinton Twp. T-7-N. TEMP.

DESCRIPTION _____ ALIGNMENT C CONTROLS JOB NO.

LEFT

CENTER LINE


RIGHT

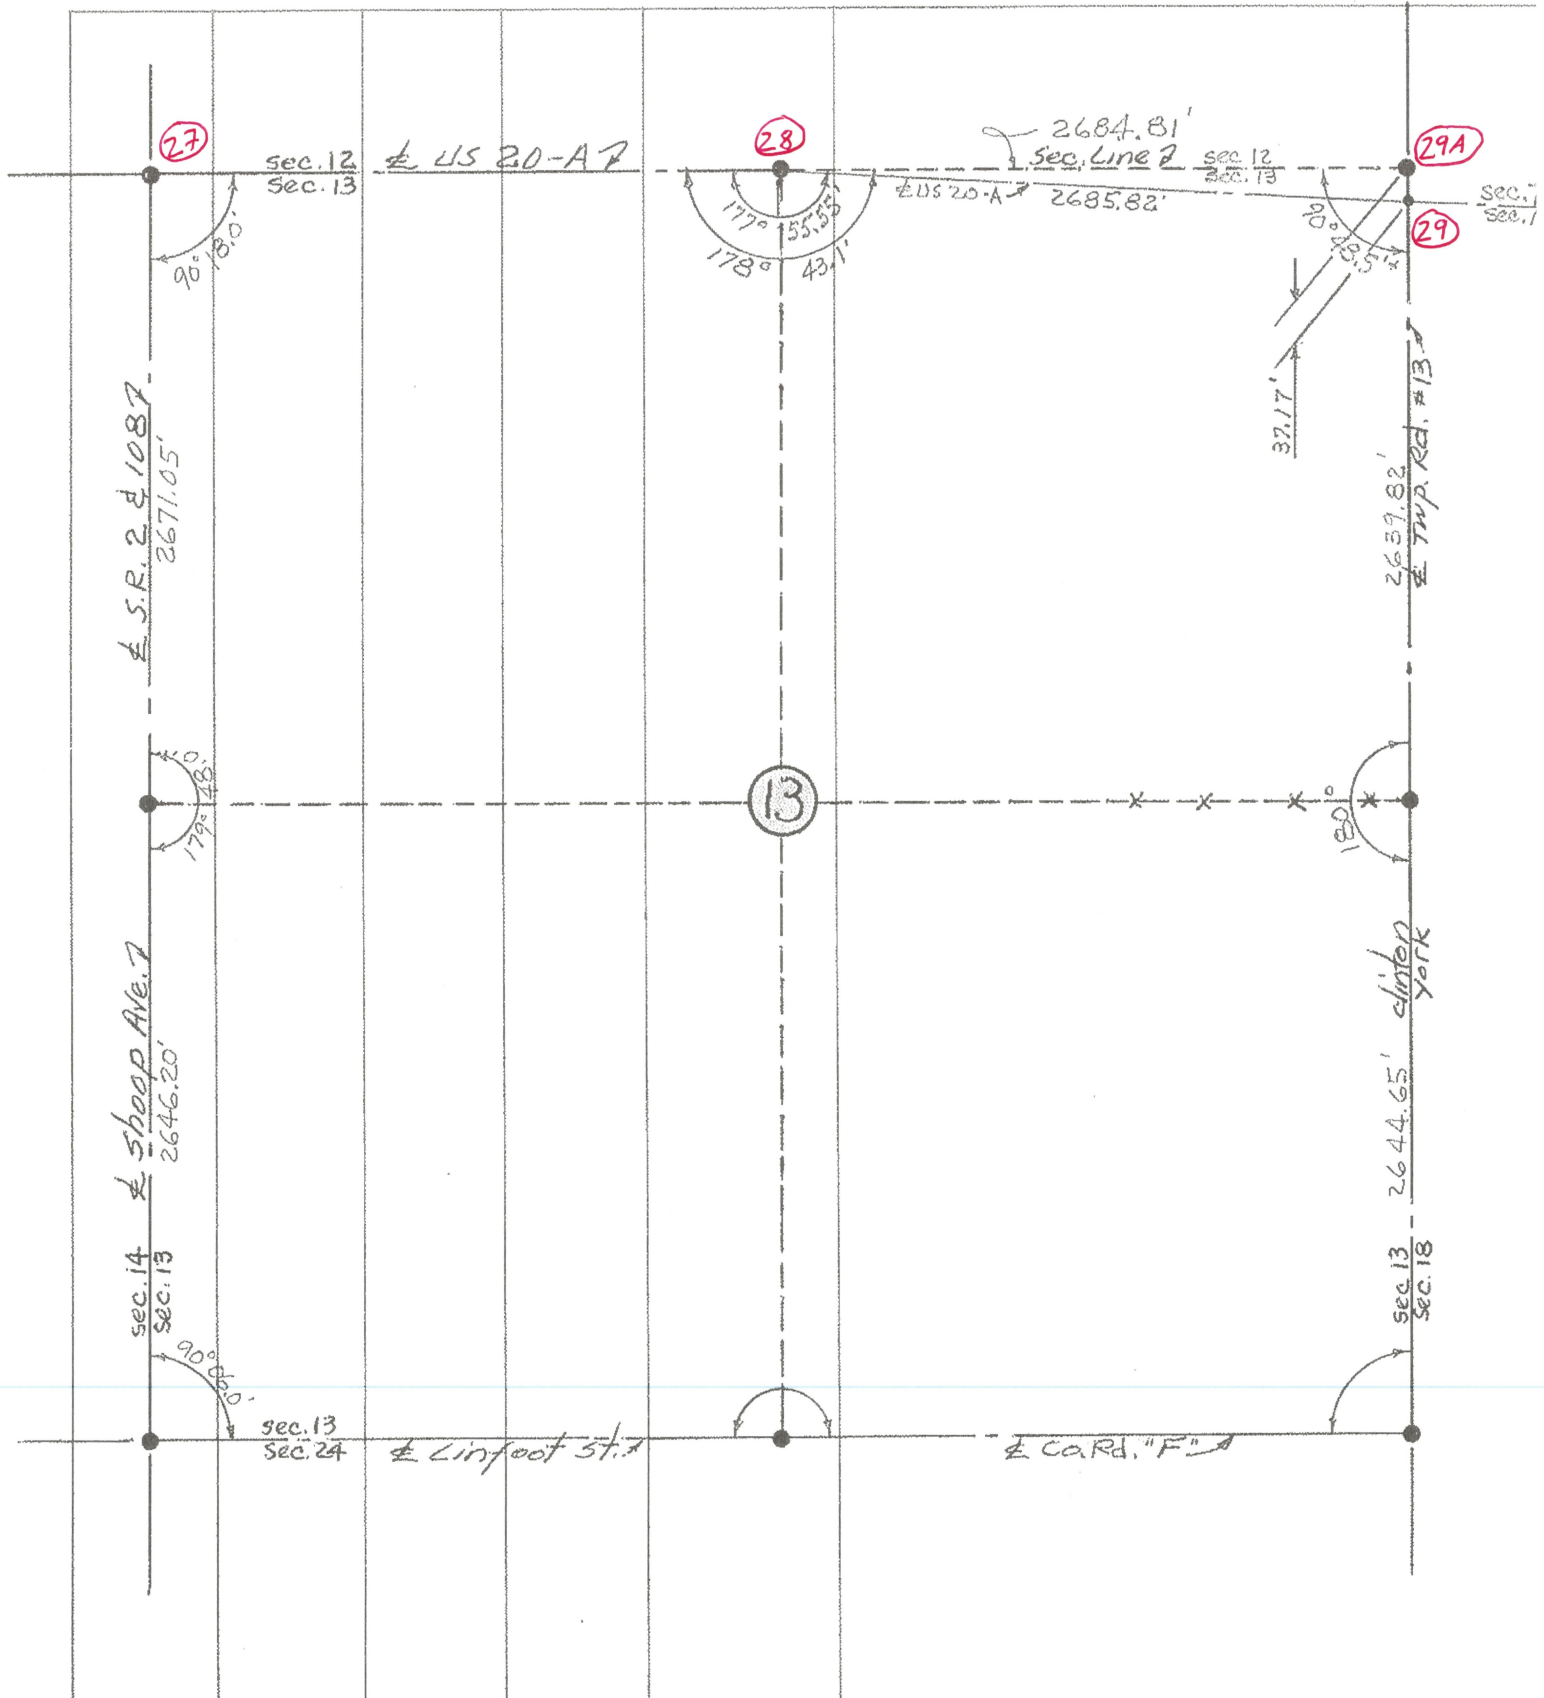

PERSONNEL	TITLE	PERSONNEL	TITLE
Tomsic			
Neuser			
Vanyo			
Granata			

COUNTY Fulton DATE Apr 11S. R. U.S. WEATHER _____SEC. CLINTON TEMP. _____

DESCRIPTION _____ LEFT _____ CENTER LINE _____ RIGHT _____ JOB NO. _____

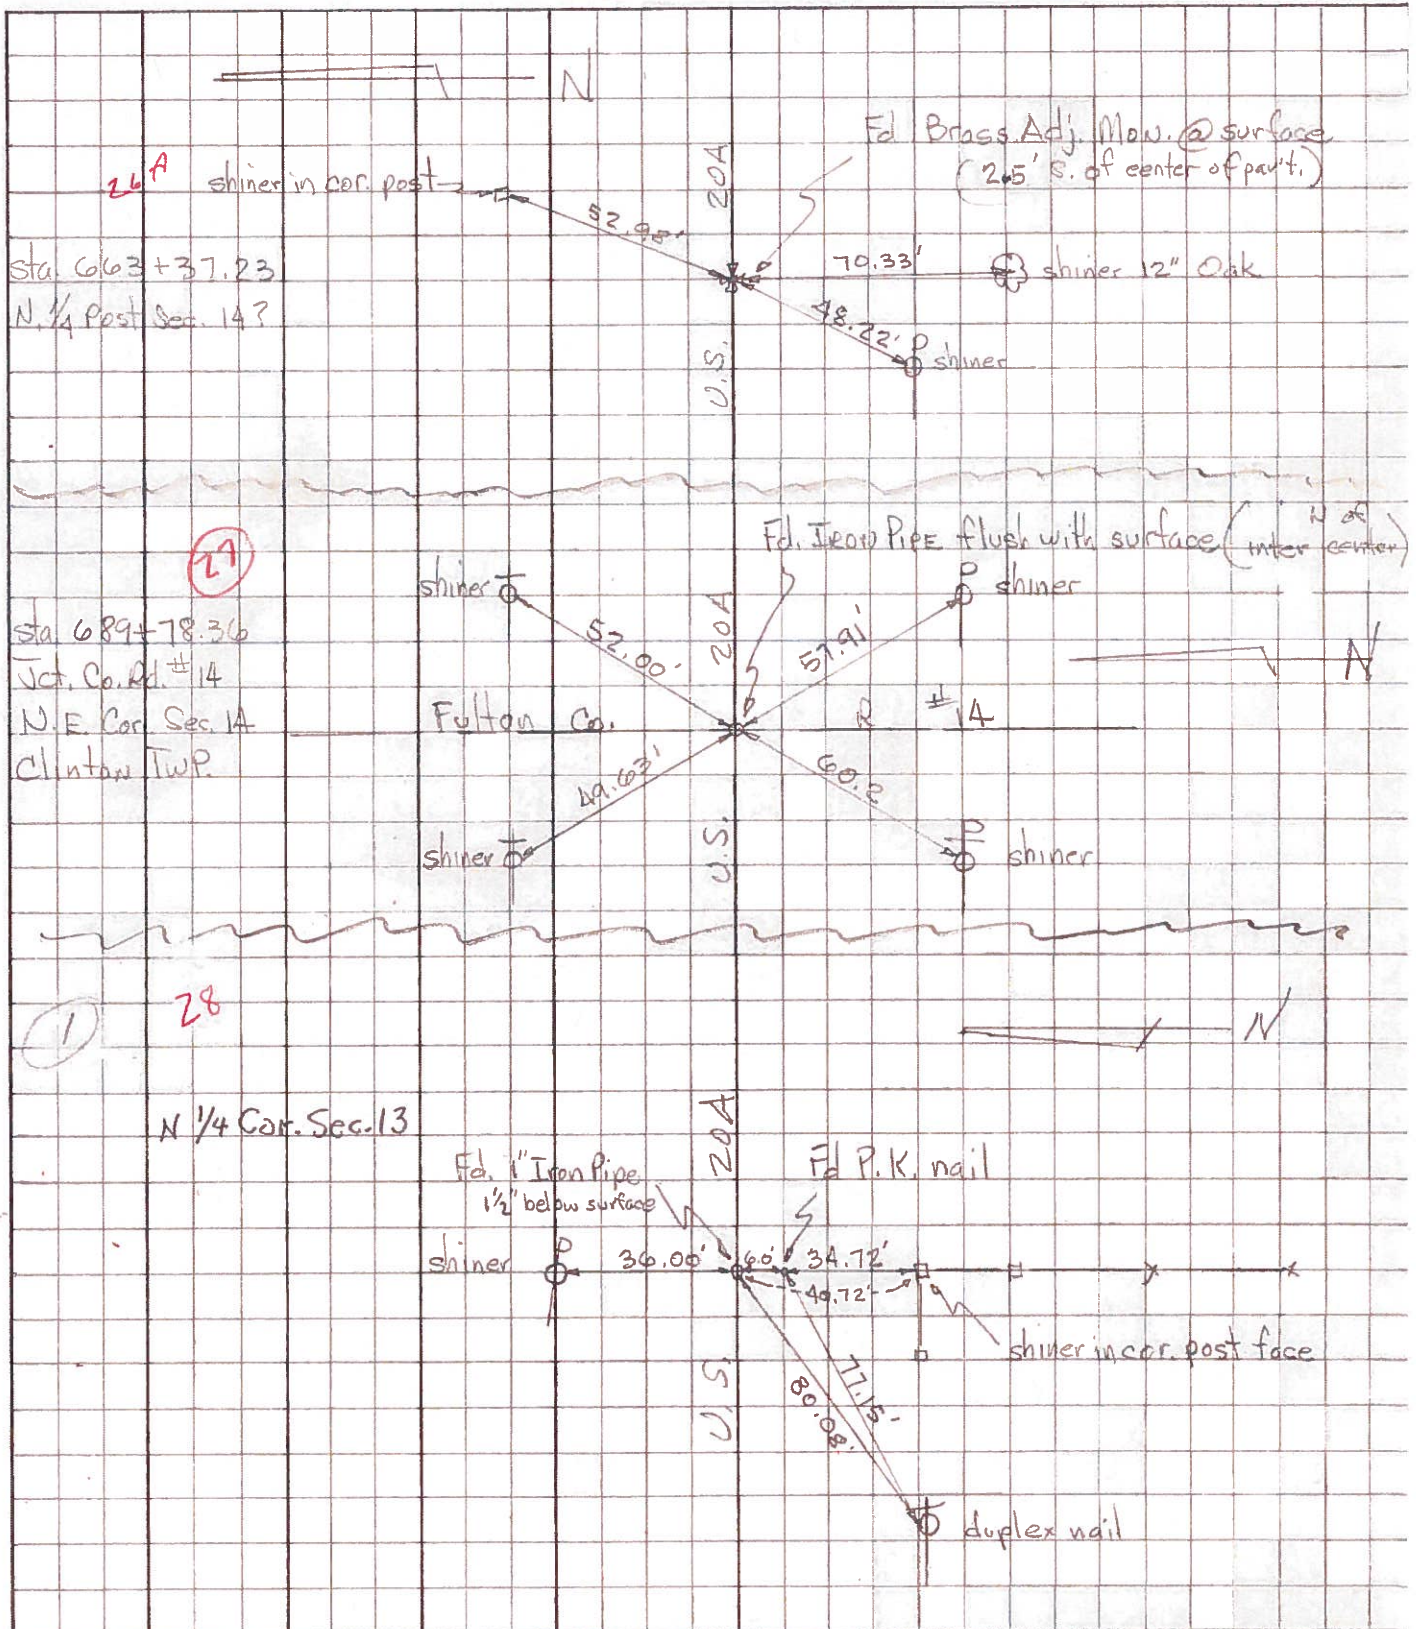

PERSONNEL TITLE PERSONNEL TITLE

Red Beach
Newcomb
Knape
EriksonCOUNTY FultonDATE Jan 1972S. R. US 20-A

WEATHER _____

SEC. CLINTON Twp

TEMP. _____

DESCRIPTION



CONTROL POINTS

JOB NO. _____

LEFT

CENTER LINE

RIGHT

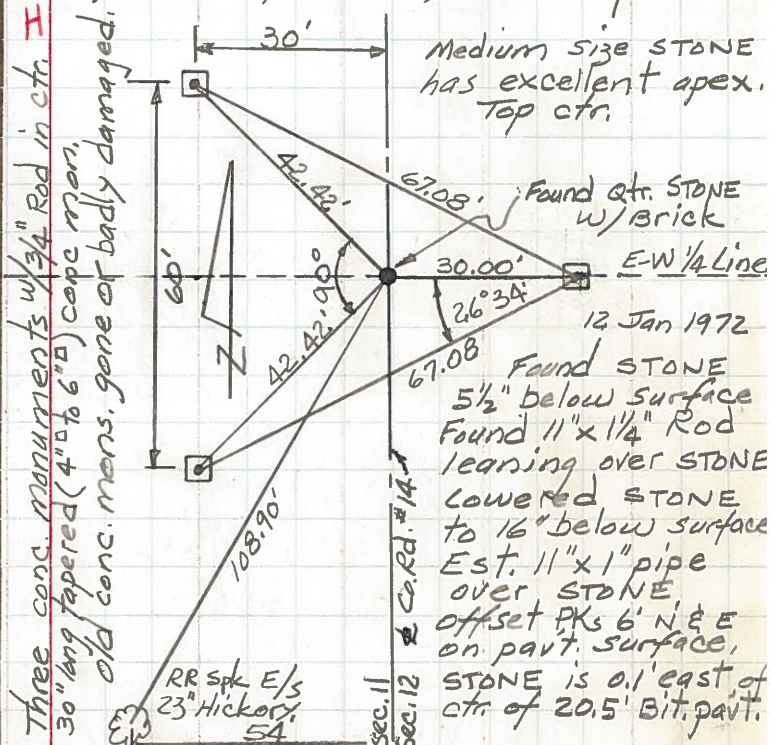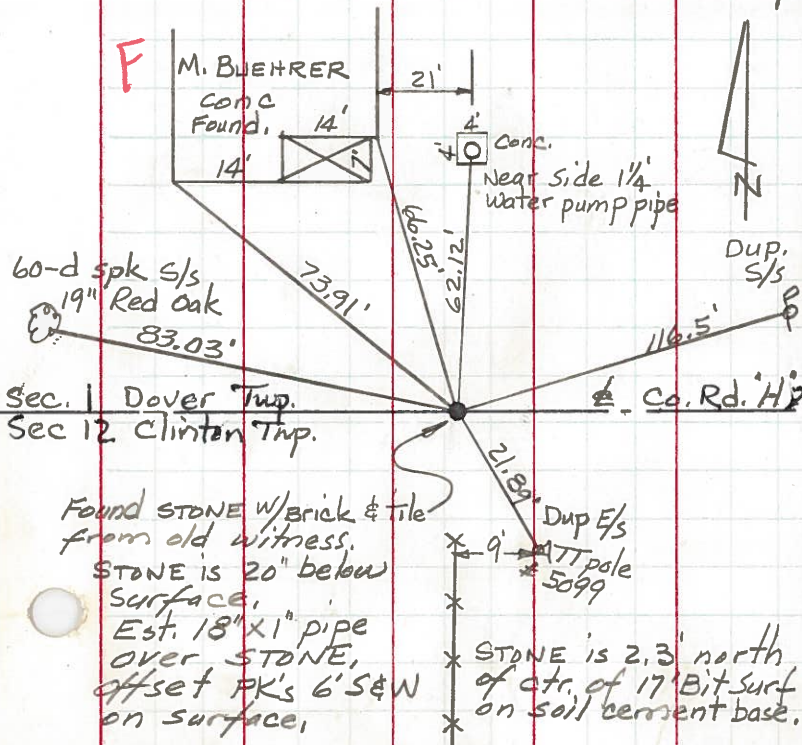N $\frac{1}{4}$ STONE Sec. 12 Clinton Twp.W $\frac{1}{4}$ Stone, Sec. 12, Clinton Twp T-7-N

NW Cor. STONE, Sec. 12, Clinton Twp. T-7-N

S $\frac{1}{4}$ STONE, Sec. 12, Clinton Twp. T-7-N
N $\frac{1}{4}$ STONE, Sec. 13, Clinton Twp. T-7-N
 $\frac{1}{2}$ mile east of Esters