

O.D.O.T. DISTRICT 2 SURVEY OFFICE (USE ONLY)

PERSONNEL

REFERENCE NO. 29

SHEET 55 OF 61

NOTES

HOMAN
H.C. CANTERBURY

DATE

9/16/04

ROUTE

US 20A

R.C. BARNHISEL

WEATHER

CLOUDY

COUNTY

FULTON

TEMP.

70°

TOWNSHIP

CLINTON

SECTION

13

T 7 N R 6 E

TYPE MONUMENT P.K.NAIL

ON SURFACE - ~~BELOW~~ ON


~~LEFT~~ - CL PAV'T - RIGHT 1.5'

- TO - EDGE PAVEMENT

S.L.M. 743+35


GRID: NORTHING:

EASTING:

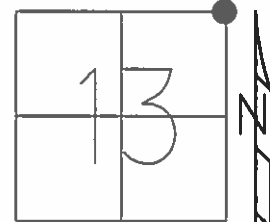

SET MAG/WASHER

10-13-04, DCH

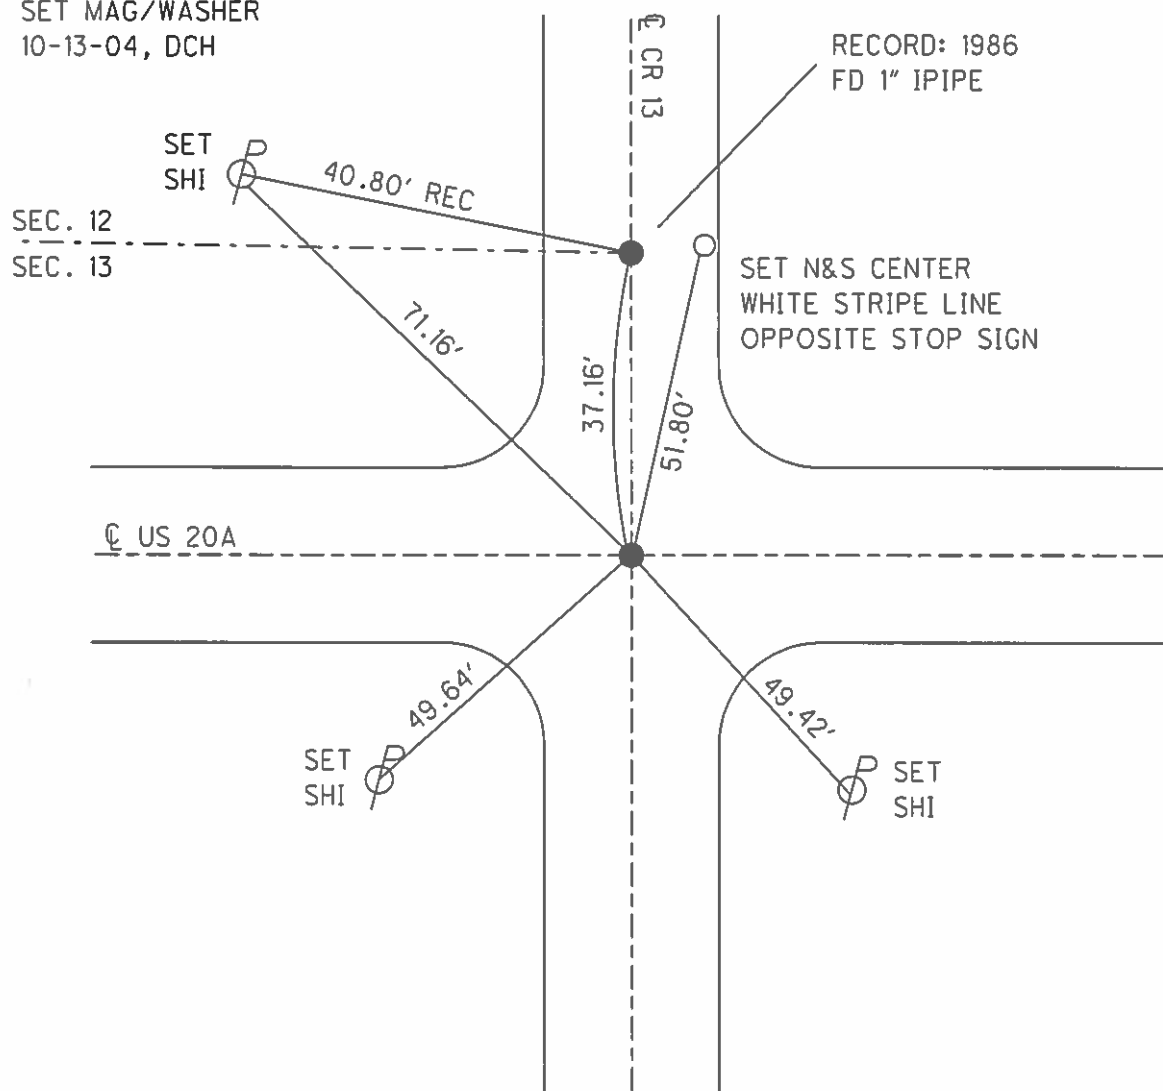

O.D.O.T. DISTRICT 2 SURVEY OFFICE

PERSONNEL

REFERENCE NO. 29

SHEET 2 OF 7

NOTES HOMAN

DATE 9-16-04

ROUTE U.S. 20-A

H.C. CANTERBURY

WEATHER CLOUDY

COUNTY FULTON

R.C. BARNHISEL

TEMP. 70°

TOWNSHIP CLIN/YORK

SECTION 12-7-13-18

T 7 N R 6 E


TYPE MONUMENT PK NAIL POINT "B"

ON SURFACE ~~-BELOW~~ ON


~~LEFT - Q PAVT - RIGHT~~ 1.5' RT

TO EDGE PAVEMENT

S.L.M. 743+35

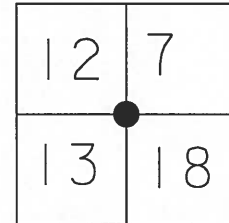

POINT "B" SET MAG NAIL
& WASHER
10-13-04
DCH

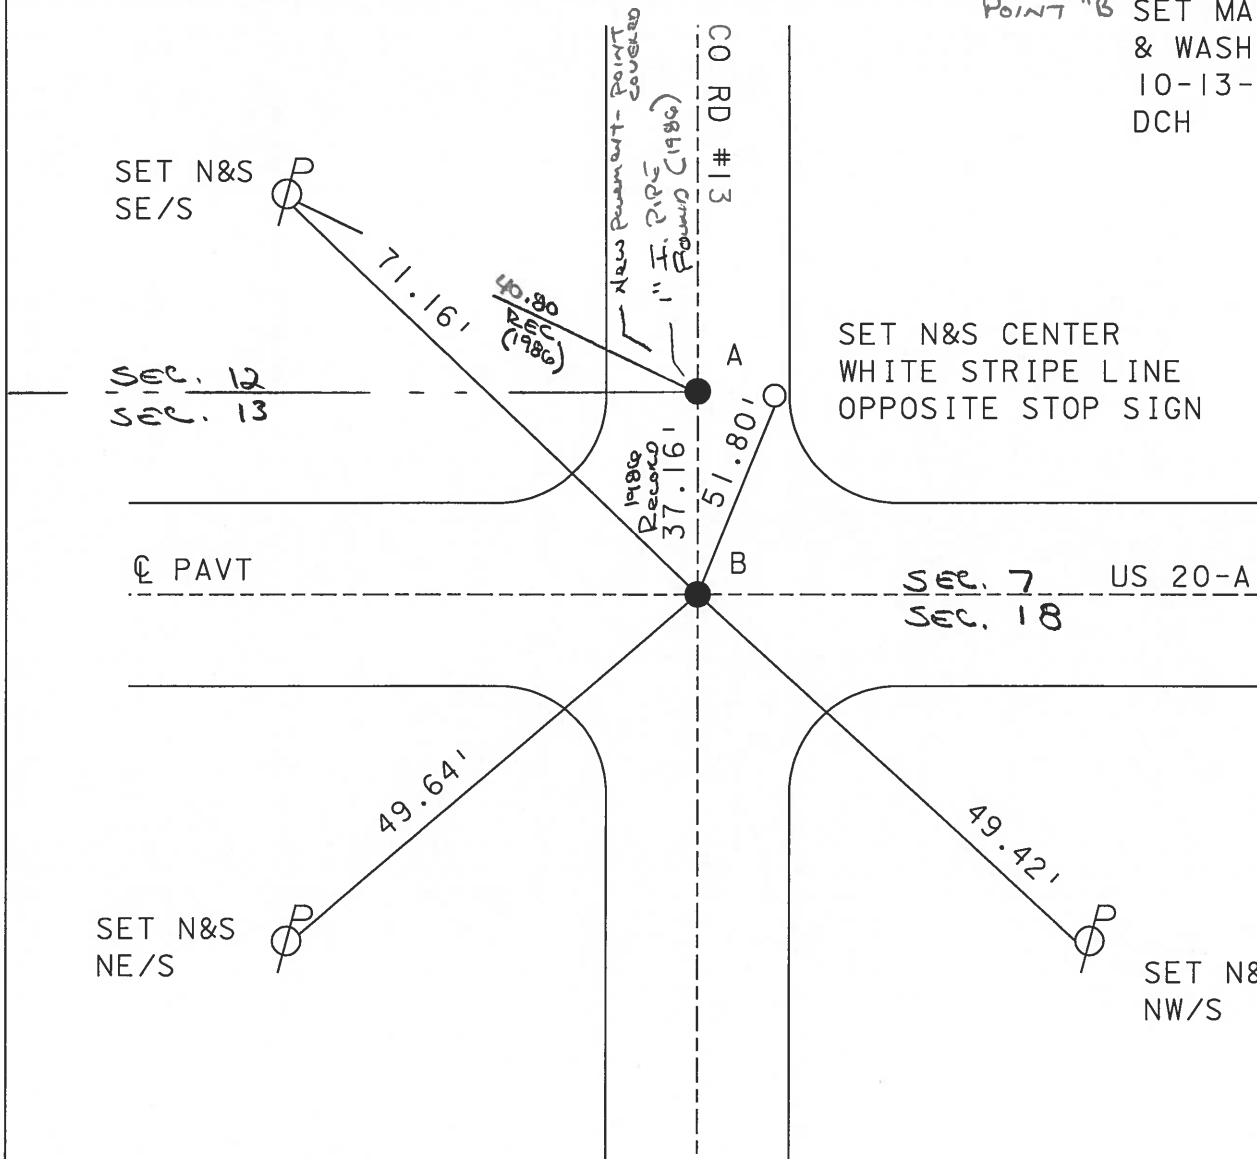

O.D.O.T. DISTRICT 2 SURVEY OFFICE

PERSONNEL

REFERENCE NO. 29

SHEET 6 OF 24

NOTES 1. Stone

H.C. D. Curtis

R.C. J. Householder

DATE 16 Sept. 86

WEATHER Cool

TEMP. 50°

ROUTE US # 20-A

COUNTY Edmon

TOWNSHIP Clinton - York

SECTION 12-7-13-18

T R

TYPE MONUMENT PK Nail

ON SURFACE - BELOW Surface

LEFT- & PAV'T. - RIGHT


TO EDGE PAVEMENT

S.L.M. 743+80

12	7
13	18



- Ⓐ OK & TO SURFACE
 - Ⓑ SET P.K. NAIL TO SURFACE
- 4-29-88

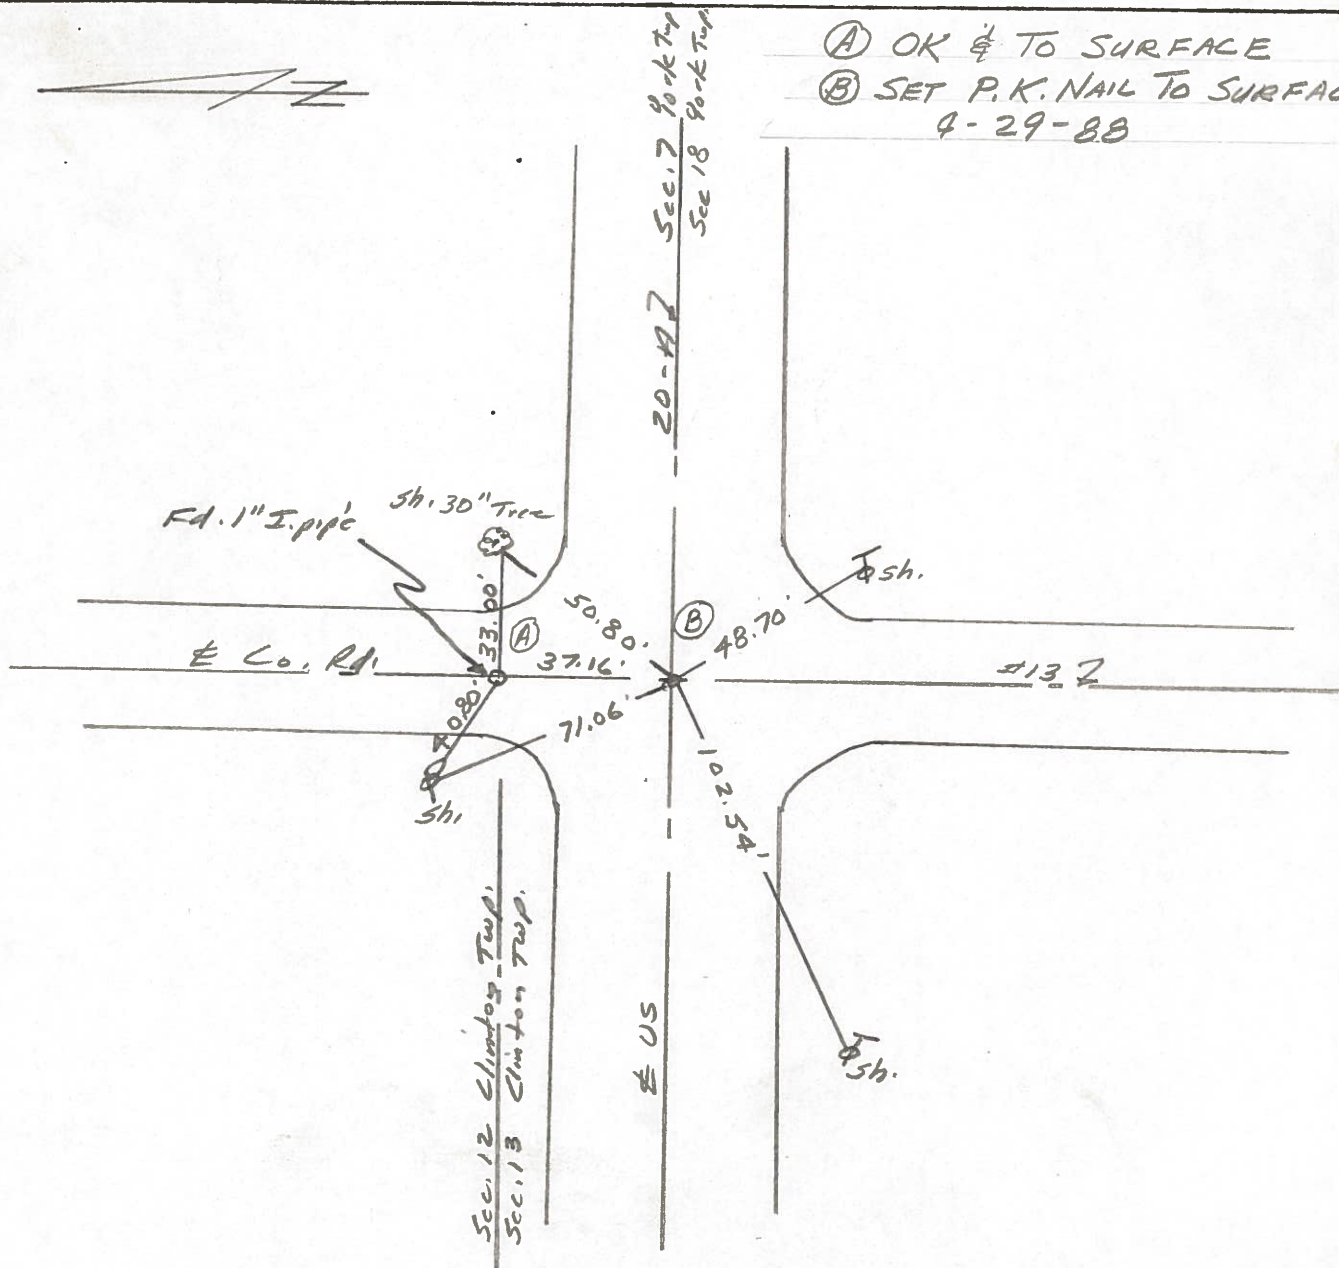

O.D.O.T. DISTRICT 2 SURVEY OFFICE

SHEET 3 OF
SET P.K. & SHI 10-16-80
BOWERS

County Fulton S.R. US 20A & SR 2

Date 6-5-1980

Township Clinton & York


Weather Clear

Section NE Cor. Sec. 13, SE Cor. Sec. 12 Clinton
NW Cor. Sec. 18, SW Cor. Sec. 7 York

Temp. + 80°

TZN, R1E

Personnel Smith
Bowers
Mead

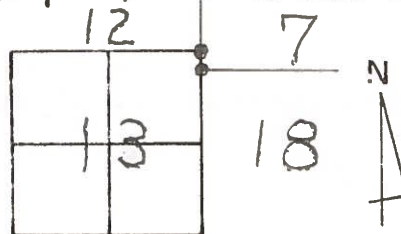

(29)

Fd 2 1" Iron Pipes

@ Surface

SET P.K. & SHI.
10-16-80

Sec. 12 Clinton Twp.
Sec. 13 Clinton Twp.

US 20A & SR 2

Clinton Twp. Sec. 13
York Twp. Sec. 18

Stone Masonry
Foundation

60D Spk. ESE/S
15" Catalpa

SHI.
60D Spk. NNW/S
27" Hickory

Shiner SW/S

Sec. 7 York Twp.
Sec. 18 York Twp.

Shiner

Shiner

40.80'

Twp. Rd. #13 Sec. 12
Sec. 7

41.72' p'

49.21' p'

33.04
33.00

29.15'

45.91'

47.74'

51.95'

50.87'

71.08'

37.17'

81.67'
48.23'
48.73'

PERSONNEL	TITLE	PERSONNEL	TITLE
1	2	3	4
5	6	7	8
9	10	11	12
13	14	15	16
17	18	19	20
21	22	23	24
25	26	27	28
29	30	31	32
33	34	35	36
37	38	39	40
41	42	43	44
45	46	47	48
49	50	51	52
53	54	55	56
57	58	59	60
61	62	63	64
65	66	67	68
69	70	71	72
73	74	75	76
77	78	79	80
81	82	83	84
85	86	87	88
89	90	91	92
93	94	95	96
97	98	99	100

Tomic

Newsor

Van yò

Granata

COUNTY Fulton

DATE April 12, 1973

S. R. U.S. 70A

WEATHER

SEC. YORK

TEMP.


DESCRIPTION.

LEFT


CENTER LINE

RIGHT

JOB NO.

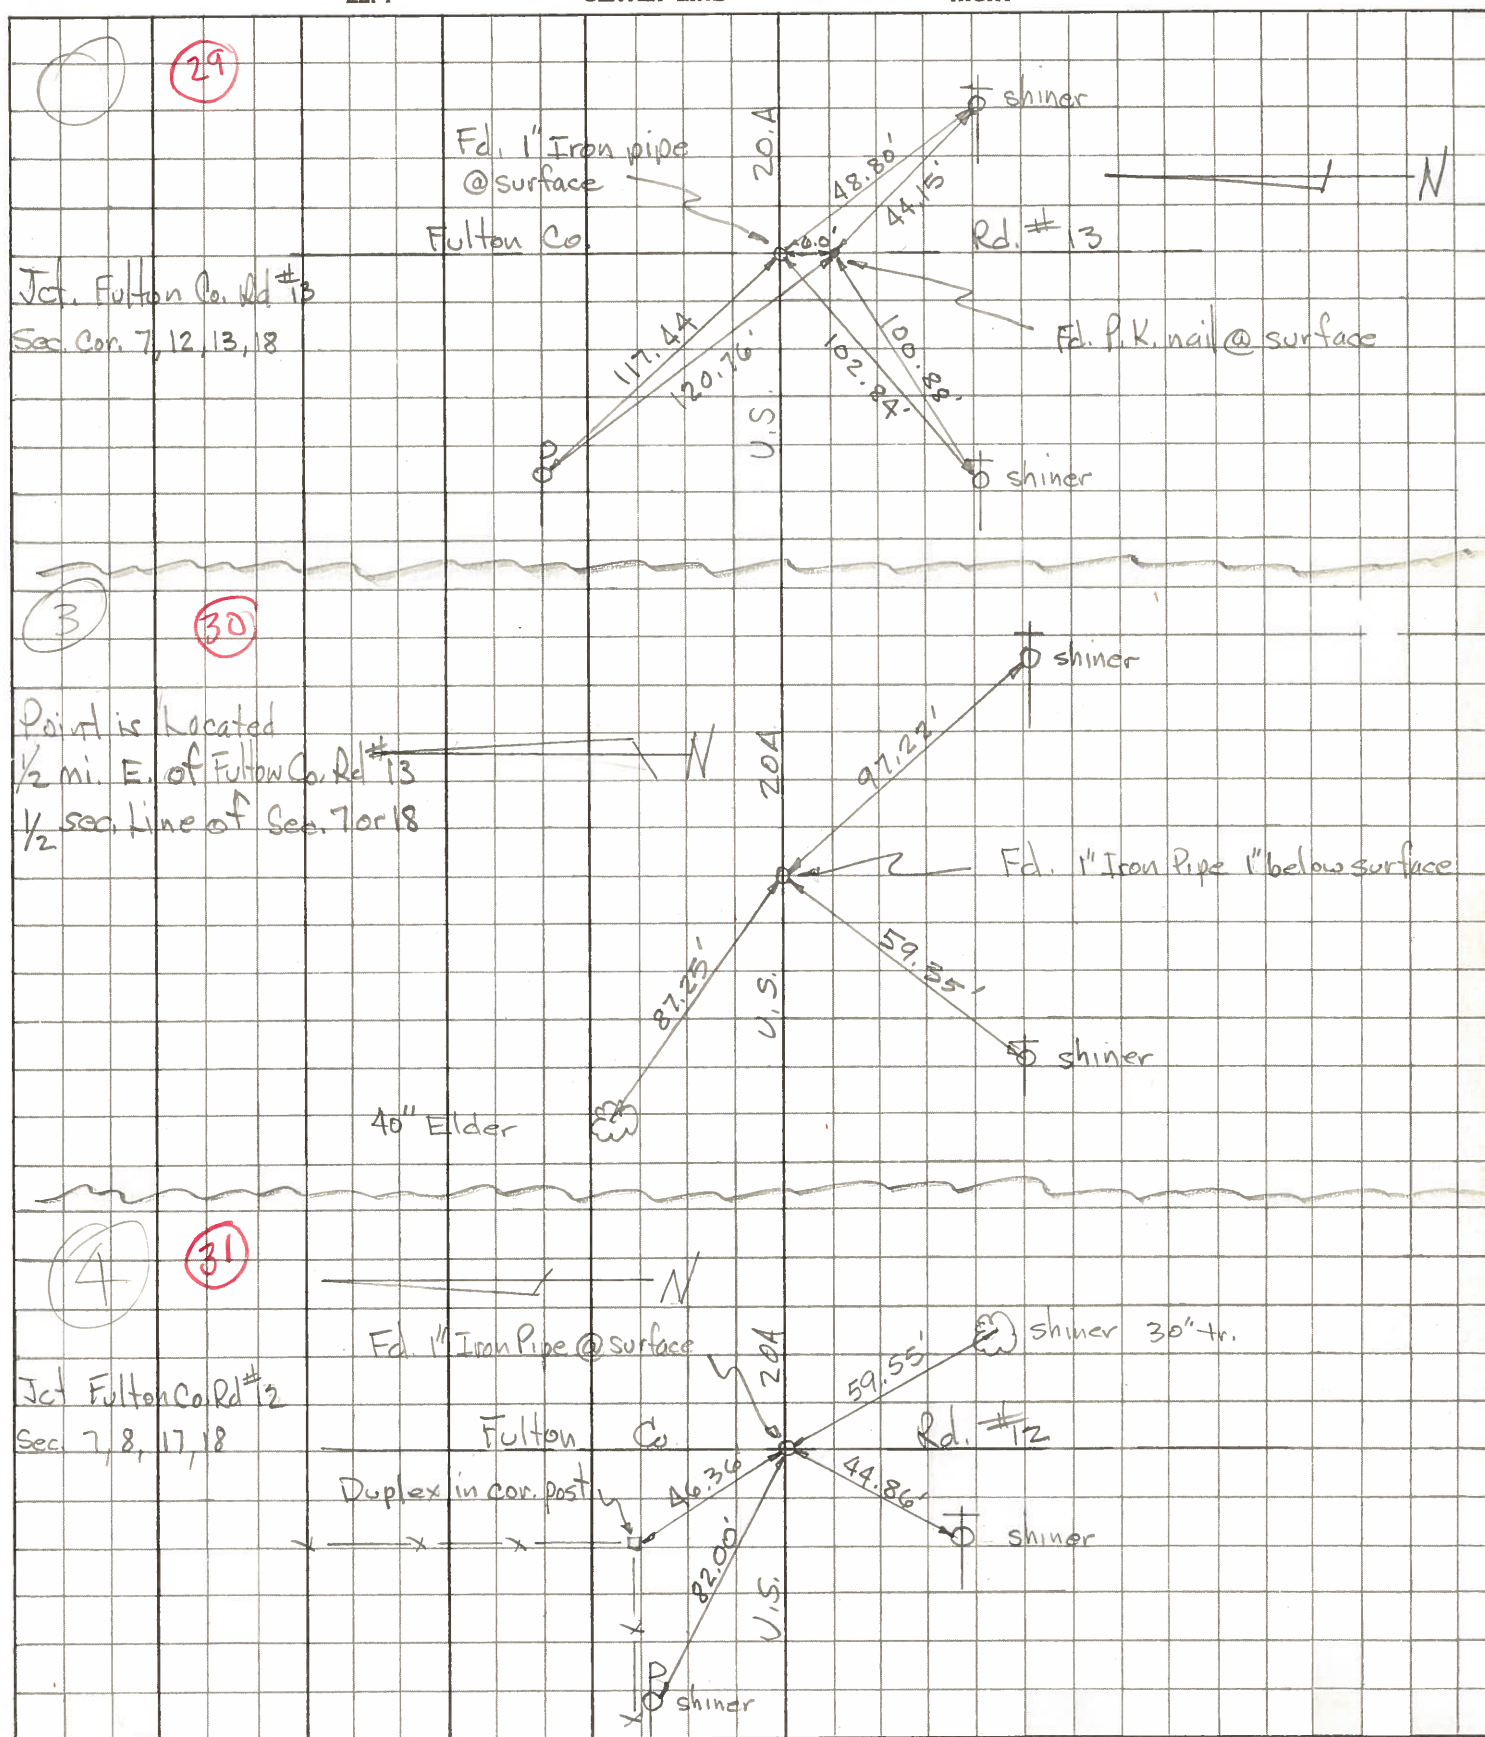

PERSONNEL	TITLE	PERSONNEL	TITLE	COUNTY	FULTON	DATE	Jan 1972
Red Beach				S. R.	US 20-A	WEATHER	
Newcomb				SEC.	13 Clinton Twp. T-7-N	TEMP.	
Knappe							
Eriksen							
ALIGNMENT & CONTROLS				JOB NO. _____			
LEFT		CENTER LINE		RIGHT			

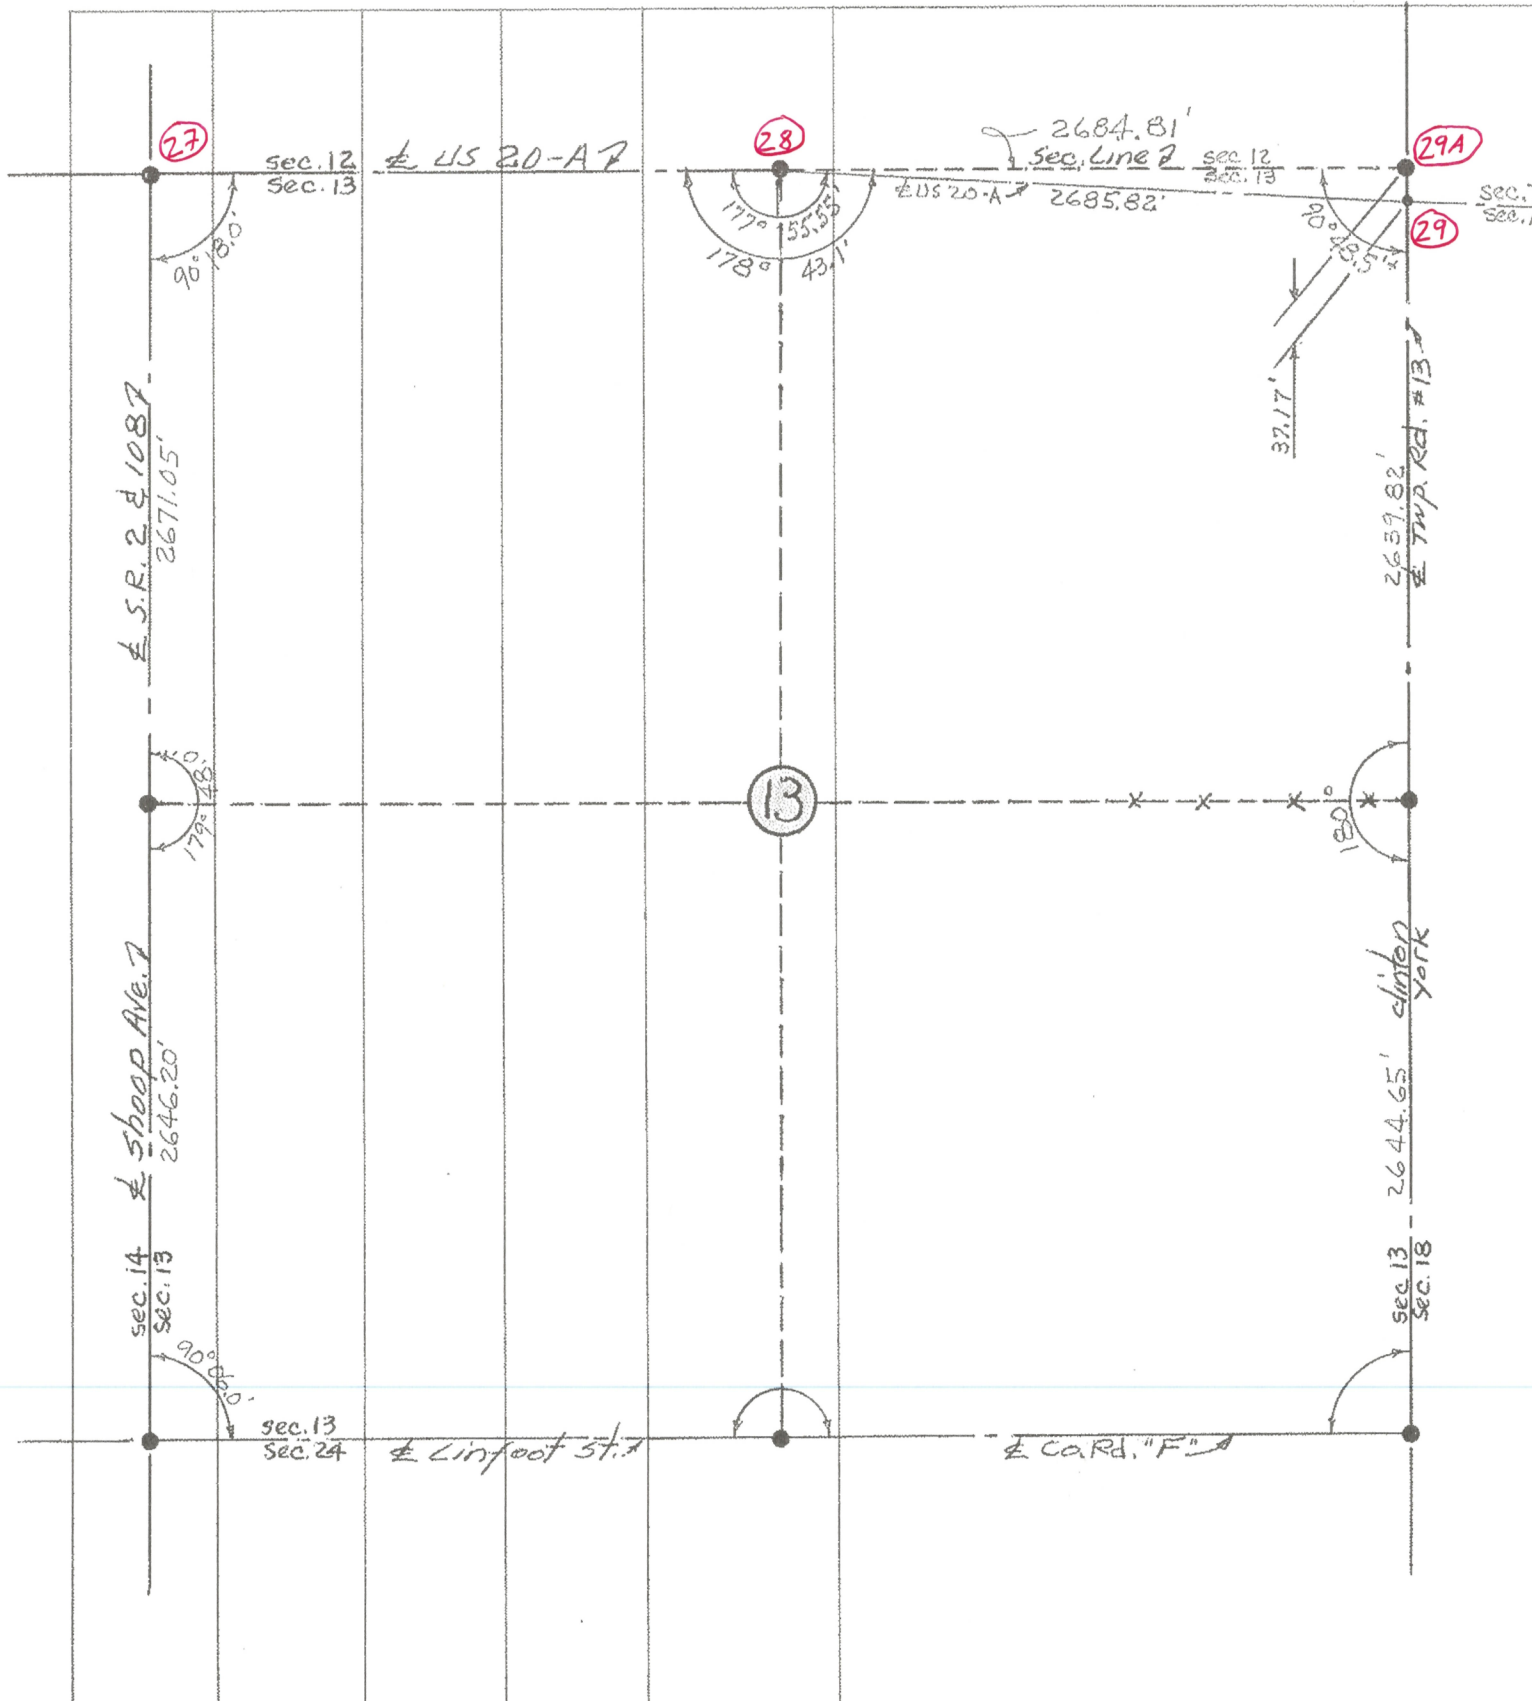

PERSONNEL TITLE

PERSONNEL TITLE

COUNTY FULTONDATE Jan. 1972

Red Beach
Newcomb
Knape
Erikson

S. R. US 20-A

WEATHER _____

SEC. clinton-york T-7-N TEMP. _____

DESCRIPTION

CONTROL POINTS

JOB NO. _____

LEFT

CENTER LINE

RIGHT

CLINTON-YORK TWP. JUNCTION

(29) US 20-A @ Twp. Rd. #13

"Clinton Corner"

Found 11" x 1 1/4" Rod
 from old witnesses
 2" below surface.

Est. 18" x 1" pipe
 21 Jan 1972

offset PK's 6'
 N & W on surf.

Near side 3" pipe
 6' stl. pipe
 Gas Valve
 Cage
 46.41'

Sec. 12
 Sec. 13

Sec. 12
 Sec. 13

60-d spk ESE/s
 13" Catalpa

Stone masonry
 Foundtn.

Robt. Ward Gorsuch Res.

41.65'

49.07'

32.81'

29.15'

47.14'

51.95'

37.17'

51.52'

82.36'

51.52'

82.36'

51.52'

82.36'

51.52'

82.36'

51.52'

60-d spk ESE/s
 13" Catalpa

41.65'

49.07'

32.81'

29.15'

47.14'

51.95'

37.17'

51.52'

82.36'

51.52'

82.36'

51.52'

82.36'

51.52'

82.36'

51.52'

Stone masonry
 Foundtn.

41.65'

49.07'

32.81'

29.15'

47.14'

51.95'

37.17'

51.52'

82.36'

51.52'

82.36'

51.52'

82.36'

51.52'

82.36'

51.52'

Stone masonry
 Foundtn.

41.65'

49.07'

32.81'

29.15'

47.14'

51.95'

37.17'

51.52'

82.36'

51.52'

82.36'

51.52'

82.36'

51.52'

82.36'

51.52'

Stone masonry
 Foundtn.

41.65'

COUNTY FULTON DATE Dec 1971

S. R. US 20-A WEATHER

SEC. CLINTON-YORK TWP. TEMP. _____

DESCRIPTION CONTROL POINTS JOB NO.

NW Cor. Sec. 7 York Twp T-7-N
NE Cor. Sec. 12 Clinton Twp.

CLINTON STONE
Found cor. STONE 6' below surface with
brick. Lowered STONE to 14" below surf.
Found 18"x1" pipe bent over STONE.
Found 10"x1 1/4" Rod north side of STONE,
STONE has small drilled hole top ctr.
Est. 12 1/2" x 1" pipe over STONE 10 Jan. 1972
offset PKs 6' NE W on surface.

Hand-drawn survey map of the Dover Pike area. The map shows a central intersection of Dover Pike and Clinton Street. A red 'A' is in the top left. Various points are marked with circles and labeled: 'Dup N/S' (top left), 'Dup W/S' (middle left), 'Found Track nail N/S' (top right), 'Dup ESE/S' (middle right), and 'Dup S/S AP' (bottom left, marked with a square). Distances are written along the lines: 43.34' (Dup N/S to center), 29.49' (Found Track nail N/S to center), 99.66' (Dup W/S to center), 99.53' (Dup ESE/S to center), 42.76' (center to bottom intersection), 55.85' (Dup N/S to bottom intersection), 71.02' (Dup W/S to bottom intersection), 79.8' (center to bottom intersection), and 99.65' (bottom intersection to right edge). A wavy line labeled 'CLINTON STON' is at the top. A horizontal line is labeled 'Dover & Cord H'. A vertical line is labeled 'Dover Pike'. A horizontal line at the bottom is labeled '& Cord. H' Pike'. A vertical line on the right is labeled 'Dup S/S ATT pole'.

71.02
 26.37'
 Dup NW/5
 clinton
 york
 * 13 A
 E. Co. Rd. "H" & Pike
 York
 "YORK STONE"
 Found 15" x 1" pipe bent over STONE.
 Found STONE w/ brick 18 1/2" below surface.
 Est. 17" x 1" pipe over STONE.
 offset PKs 6' S & E on pavt. surface.

Found 11" x 13" 1 1/2" Rad 1 1/2" below surf.
Found 1 1/4" pipe * 20" below surface.
Est. 18" x 1" pipe over 1 1/4" pipe
offset PKs
6' N.W. on
pav't surface

Co. Rd. # 132

A hand-drawn diagram on grid paper showing a triangle with vertices at approximately (1, 1), (2, 3), and (3, 1). A vertical line is drawn passing through the triangle, intersecting the top vertex at (2, 3) and the base at (2, 0). The line extends from the top of the grid to the bottom.

PERSONNEL TITLE PERSONNEL TITLE

COUNTY FultonDATE 3-28-559-12-60S. R. #2 & 20 Aft.

WEATHER

SEC. M, A, O,

TEMP.

DESCRIPTION

LEFT

CENTER LINE

RIGHT

JOB NO.

P.I. Sta. 53+62.34
S.W. cor. sec. 7
Fd. iron pin 12" below
surface of pav't.
(Not plum bed.)

#72 ✓

S.E. to shiner in T.P. 45.35'
S.W. to shiner in A. Post 46.90'
S.W. to shiner in T.P. 102.25'
N.W. to shiner in 24" Elm 171.45'
N.E. to shiner in 20" Hickory 51.05'

Sta. 79+78.58
S. 1/4 sec. 7
Fd. iron pin

#73 ✓

N.W. to shiner in 30" walnut 87.25'
S.W. to shiner in T.P. 59.60
S.E. to iron A.P. 1' above gnd. 44.30'
N.E. to shi. in 24" Spruce N.E. 97.15'

Sta. 106+08.39
S.W. cor. sec. 8
Iron pin

#74 ✓

N.E. to iron post in pump island 62.09'
N.W. to shiner in P.P. 81.90'
S.W. to shiner in 12" maple 54.83
S.E. to shiner in 30" catalpa 59.70'

Sta. 132+68.17
S. 1/4 sec. 8
Fd. iron pin

#75

N.N.E. to steel sign post stake 40.47
N.N.E. to shiner in P.P. 40.94 40.88
N.W. to shiner in 3rd fence post 54.35
S. to shiner in T.P. 38.25

Sta. 159+27.37
S.W. cor. sec. 9
Fd. iron pin

#76

S.W. to shiner in T.P. 44.10
N.E. to shiner in P.P. 45.67
S.E. to near side of Gov. B.M. 56.97
N.W. to near side of iron A.P. 44.80