

O.D.O.T. DISTRICT 2 SURVEY OFFICE (USE ONLY)

PERSONNEL

REFERENCE NO. 29 A

SHEET 57 OF 63

NOTES RHOADES

DATE 6/11/19

ROUTE US 20A

H.C. O'DONNELL

WEATHER SUNNY

COUNTY FULTON

R.C. MILLER

TEMP. 62°

TOWNSHIP CLINTON

DWG BY BALBAUGH PID 101232

SECTION 13

T 7 N R 6 E

TYPE MONUMENT MAG NAIL

ON SURFACE - ~~BELOW~~ ON

OFFSET CL PAVEMENT ON LT : RT

TO EDGE PAVEMENT


STATION: 743+31.58

HORIZ.DATUM: NAD83 (2011)


GEOID: 2012A

GRID: NORTHING: 698814.540

EASTING: 1526653.552

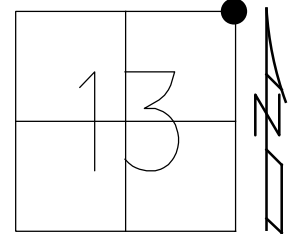

NOTE:
DIST. 29-29A= 37.13'

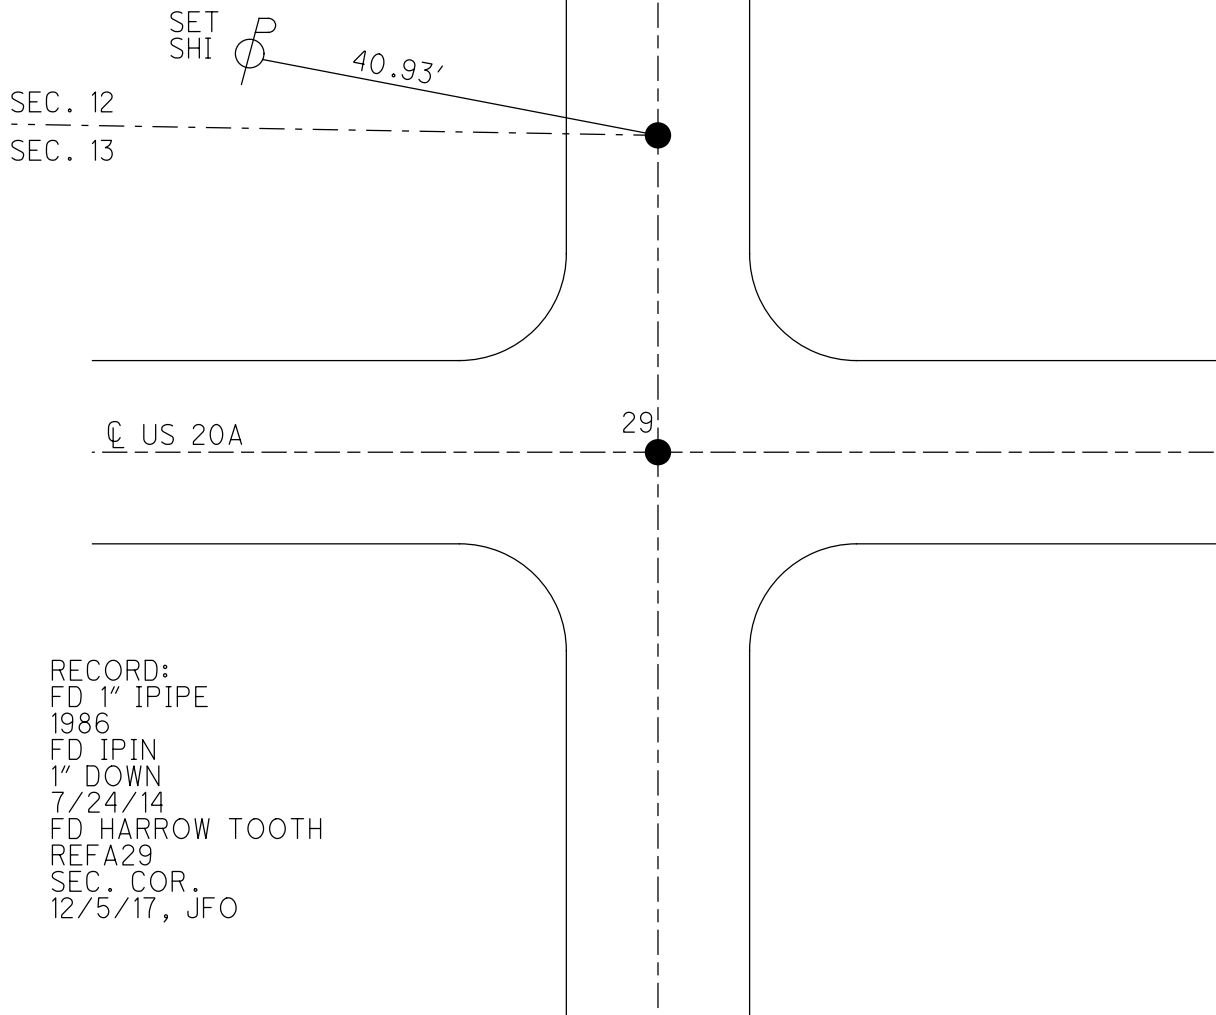

NOTE:
DIST. 29-29A= 37.13'

SEC. 12
SEC. 13

SET SHI

71.13'

29A

51.79'

FD NAIL/SHI CENTER
WHITE STRIPE LINE
OPPOSITE STOP SIGN

US 20A

49.74'

FD SHI

49.44'

FD SHI

RECORD:
FD P.K.NAIL
9/16/04, MC
SET MAG/WASHER
10/13/04, DCH
FD MAG/WASHER
12/5/17, JFO
REF29
12/21/17, JFO
SET MAG/WASHER
REF29
10/25/19, JFO

O.D.O.T. DISTRICT 2 SURVEY OFFICE (USE ONLY)

PERSONNEL

REFERENCE NO. 29

SHEET 55 OF 61

NOTES

HOMAN

DATE

9/16/04

ROUTE US 20A

H.C. CANTERBURY

WEATHER

CLOUDY

COUNTY FULTON

R.C. BARNHISEL

TEMP.

70°

TOWNSHIP CLINTON

SECTION 13

T 7 N R 6 E

TYPE MONUMENT P.K.NAIL

ON SURFACE - ~~BELOW~~ ON


~~LEFT~~ - ℄ PAV'T - RIGHT 1.5'

- TO - EDGE PAVEMENT

S.L.M. 743+35


GRID: NORTHING:

EASTING:

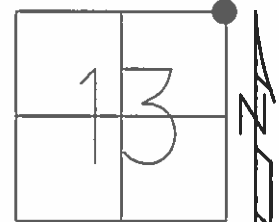

SET MAG/WASHER

10-13-04, DCH

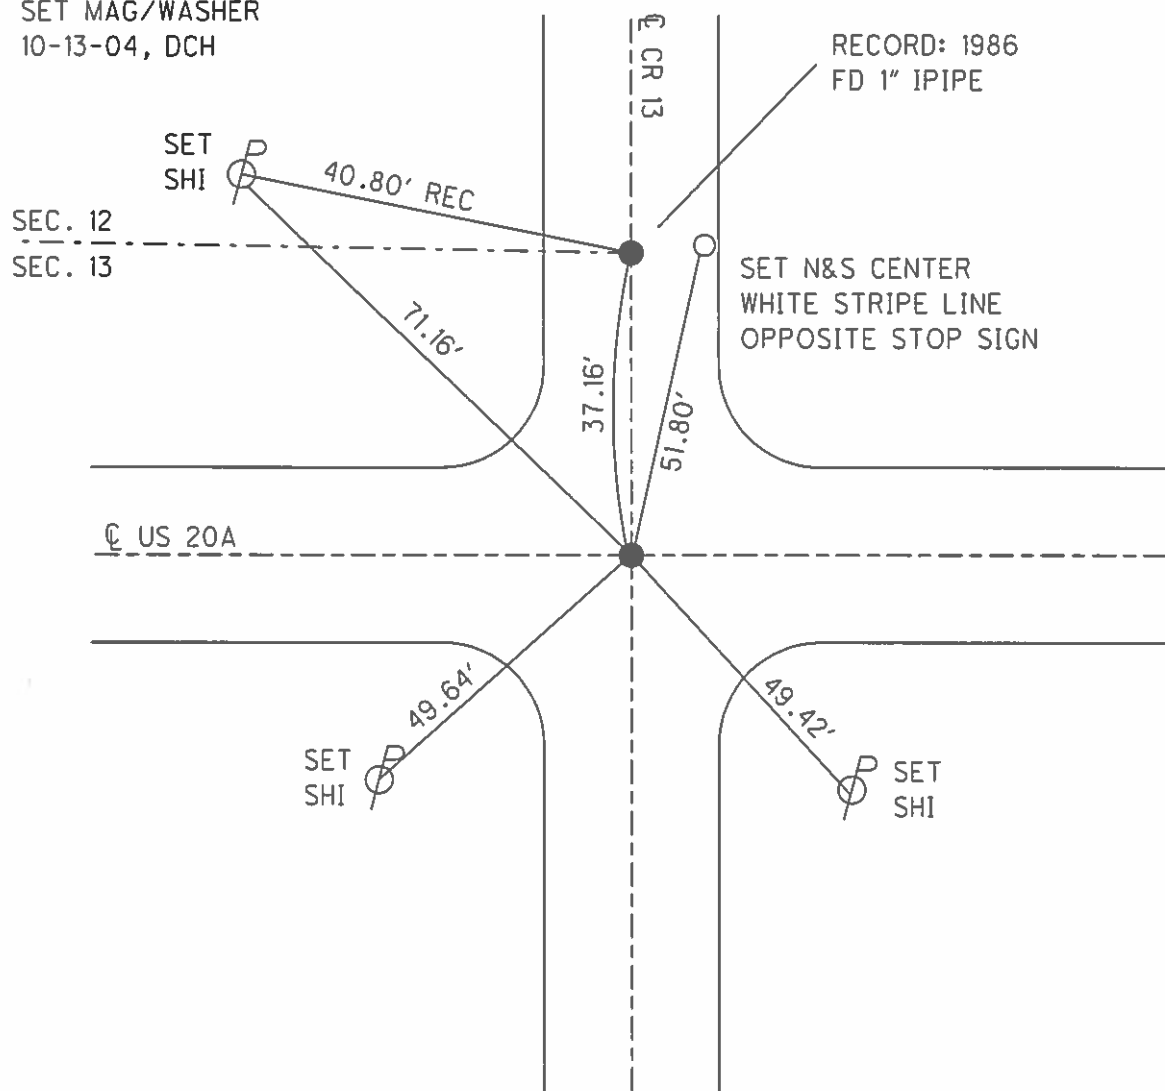

O.D.O.T. DISTRICT 2 SURVEY OFFICE

PERSONNEL

REFERENCE NO. 29

SHEET 2 OF 7

NOTES HOMAN

DATE 9-16-04

ROUTE U.S. 20-A

H.C. CANTERBURY

WEATHER CLOUDY

COUNTY FULTON

R.C. BARNHISEL

TEMP. 70°

TOWNSHIP CLIN/YORK

SECTION 12-7-13-18

T 7 N R 6 E


TYPE MONUMENT PK NAIL POINT "B"

ON SURFACE ~~BELOW~~ ON


~~LEFT - Q PAVT - RIGHT~~ 1.5' RT

TO EDGE PAVEMENT

S.L.M. 743+35

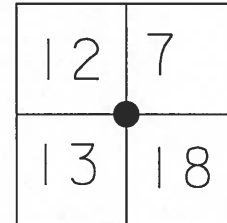

POINT "B" SET MAG NAIL
& WASHER
10-13-04
DCH

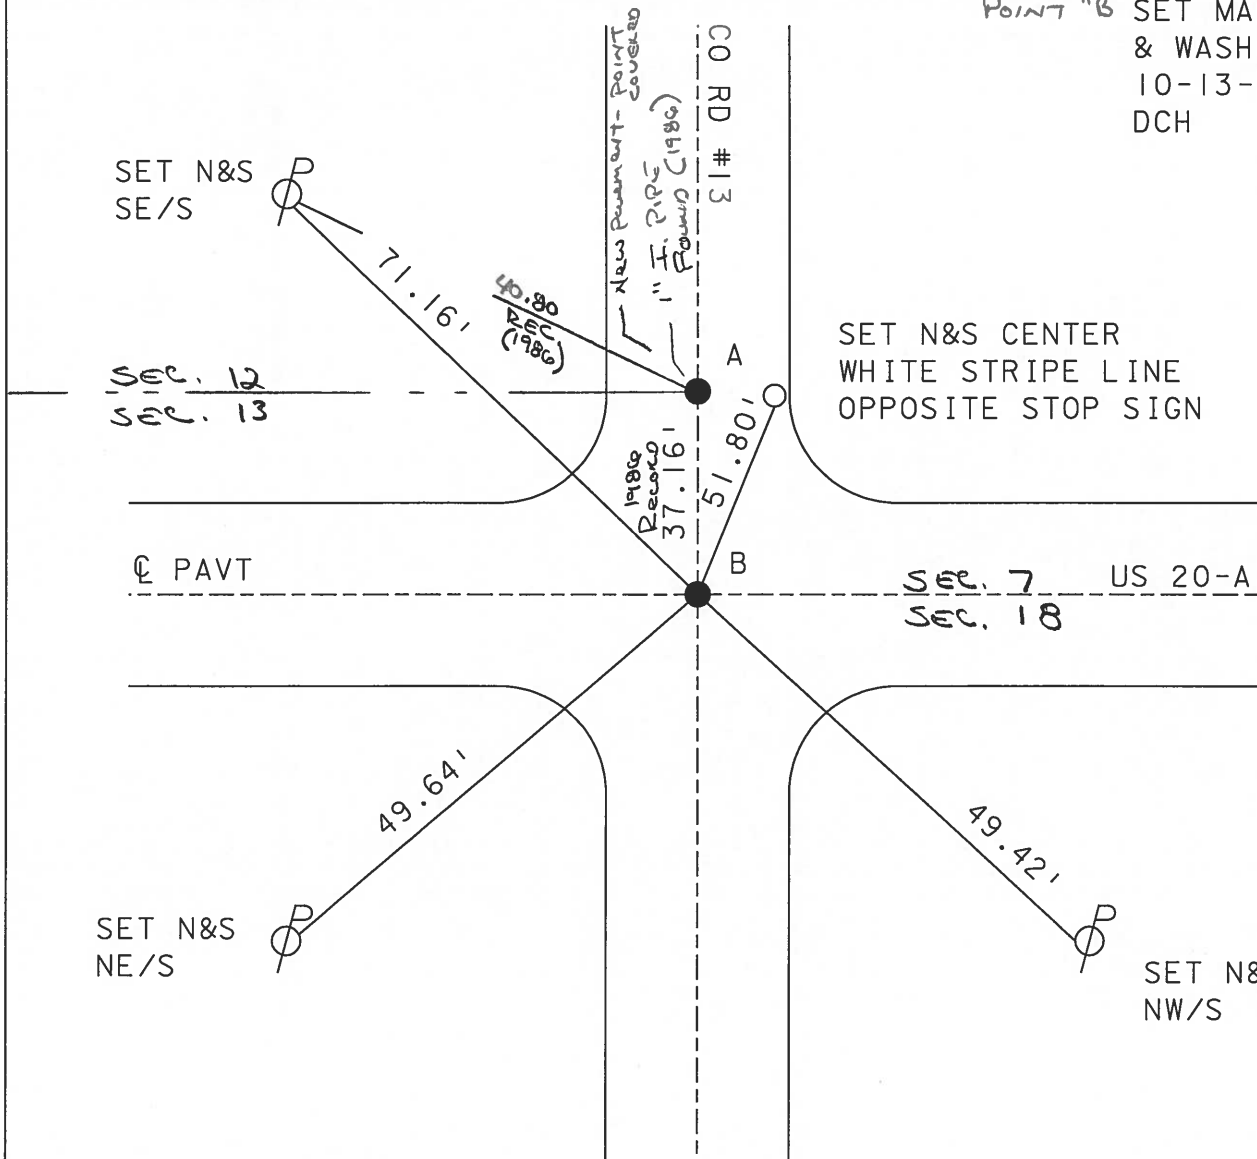

O.D.O.T. DISTRICT 2 SURVEY OFFICE

PERSONNEL

REFERENCE NO. 29

SHEET 6 OF 24

NOTES 1. Stone

H.C. D. Curtis

R.C. J. Householder

DATE 16 Sept. 86

WEATHER Cool

TEMP. 50°

ROUTE US # 20-A

COUNTY Edinboro

TOWNSHIP Clinton - York

SECTION 12-7-13-18

T R

TYPE MONUMENT PK Nail

ON SURFACE - BELOW Surface

LEFT- & PAV'T. - RIGHT


TO EDGE PAVEMENT

S.L.M. 743+80

12	7
13	18



- Ⓐ OK & TO SURFACE
 - Ⓑ SET P.K. NAIL TO SURFACE
- 4-29-88

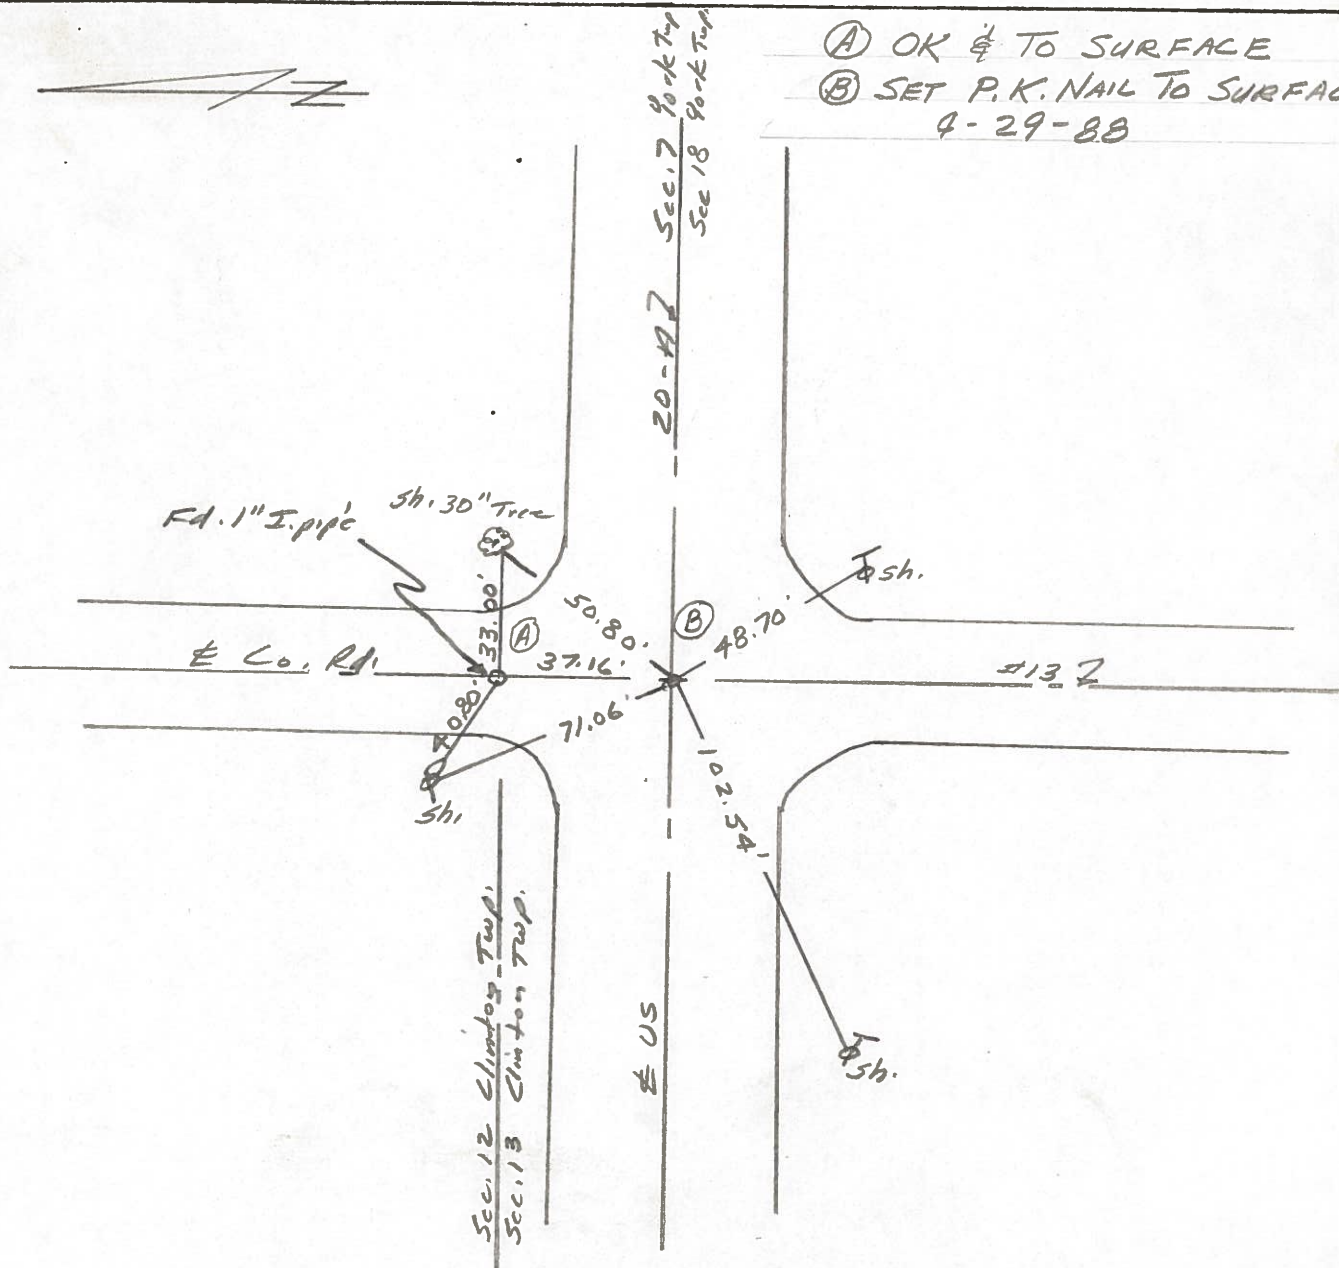

O.D.O.T. DISTRICT 2 SURVEY OFFICE

SHEET 3 OF
SET P.K. & SHI 10-16-80
BOWERS

County Fulton S.R. US 20A & SR 2

Date 6-5-1980

Township Clinton & York


Weather Clear

Section NE Cor. Sec. 13, SE Cor. Sec. 12 Clinton
NW Cor. Sec. 18, SW Cor. Sec. 7 York

Temp. + 80°

TZN, R1E

Personnel Smith
Bowers
Mead

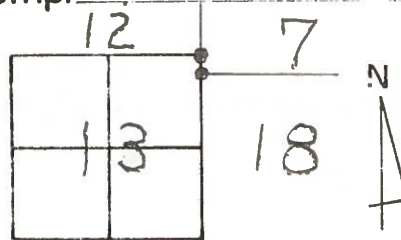

(29)

Fd 2 1" Iron Pipes

@ Surface

SET P.K. & SHI.
10-16-80

Sec. 12 Clinton Twp.
Sec. 13 Clinton Twp.

US 20A & SR 2

Clinton Twp. Sec. 13
York Twp. Sec. 18

Stone Masonry
Foundation

60D Spk. ESE/S
15" Catalpa

SHI.
60D Spk. NNW/S
27" Hickory

Shiner SW/S

Sec. 7 York Twp.
Sec. 18 York Twp.

Shiner

Shiner

40.80'

Twp. Rd. #13 Sec. 12
Sec. 7

41.72' p'

49.21' p'

33.04
33.00

29.15'

45.91'

47.74'

51.95'

50.87'

71.08'

37.17'

81.67'
48.23'
48.73'


PERSONNEL	TITLE	PERSONNEL	TITLE
Tomsic			
Neuser			
Vanyo			
Granata			

COUNTY Fulton DATE April 12, 1973


S. R. U.S. 20A WEATHER _____

SEC. YORK TEMP. _____

DESCRIPTION _____ LEFT _____ CENTER LINE _____ RIGHT _____ JOB NO. _____

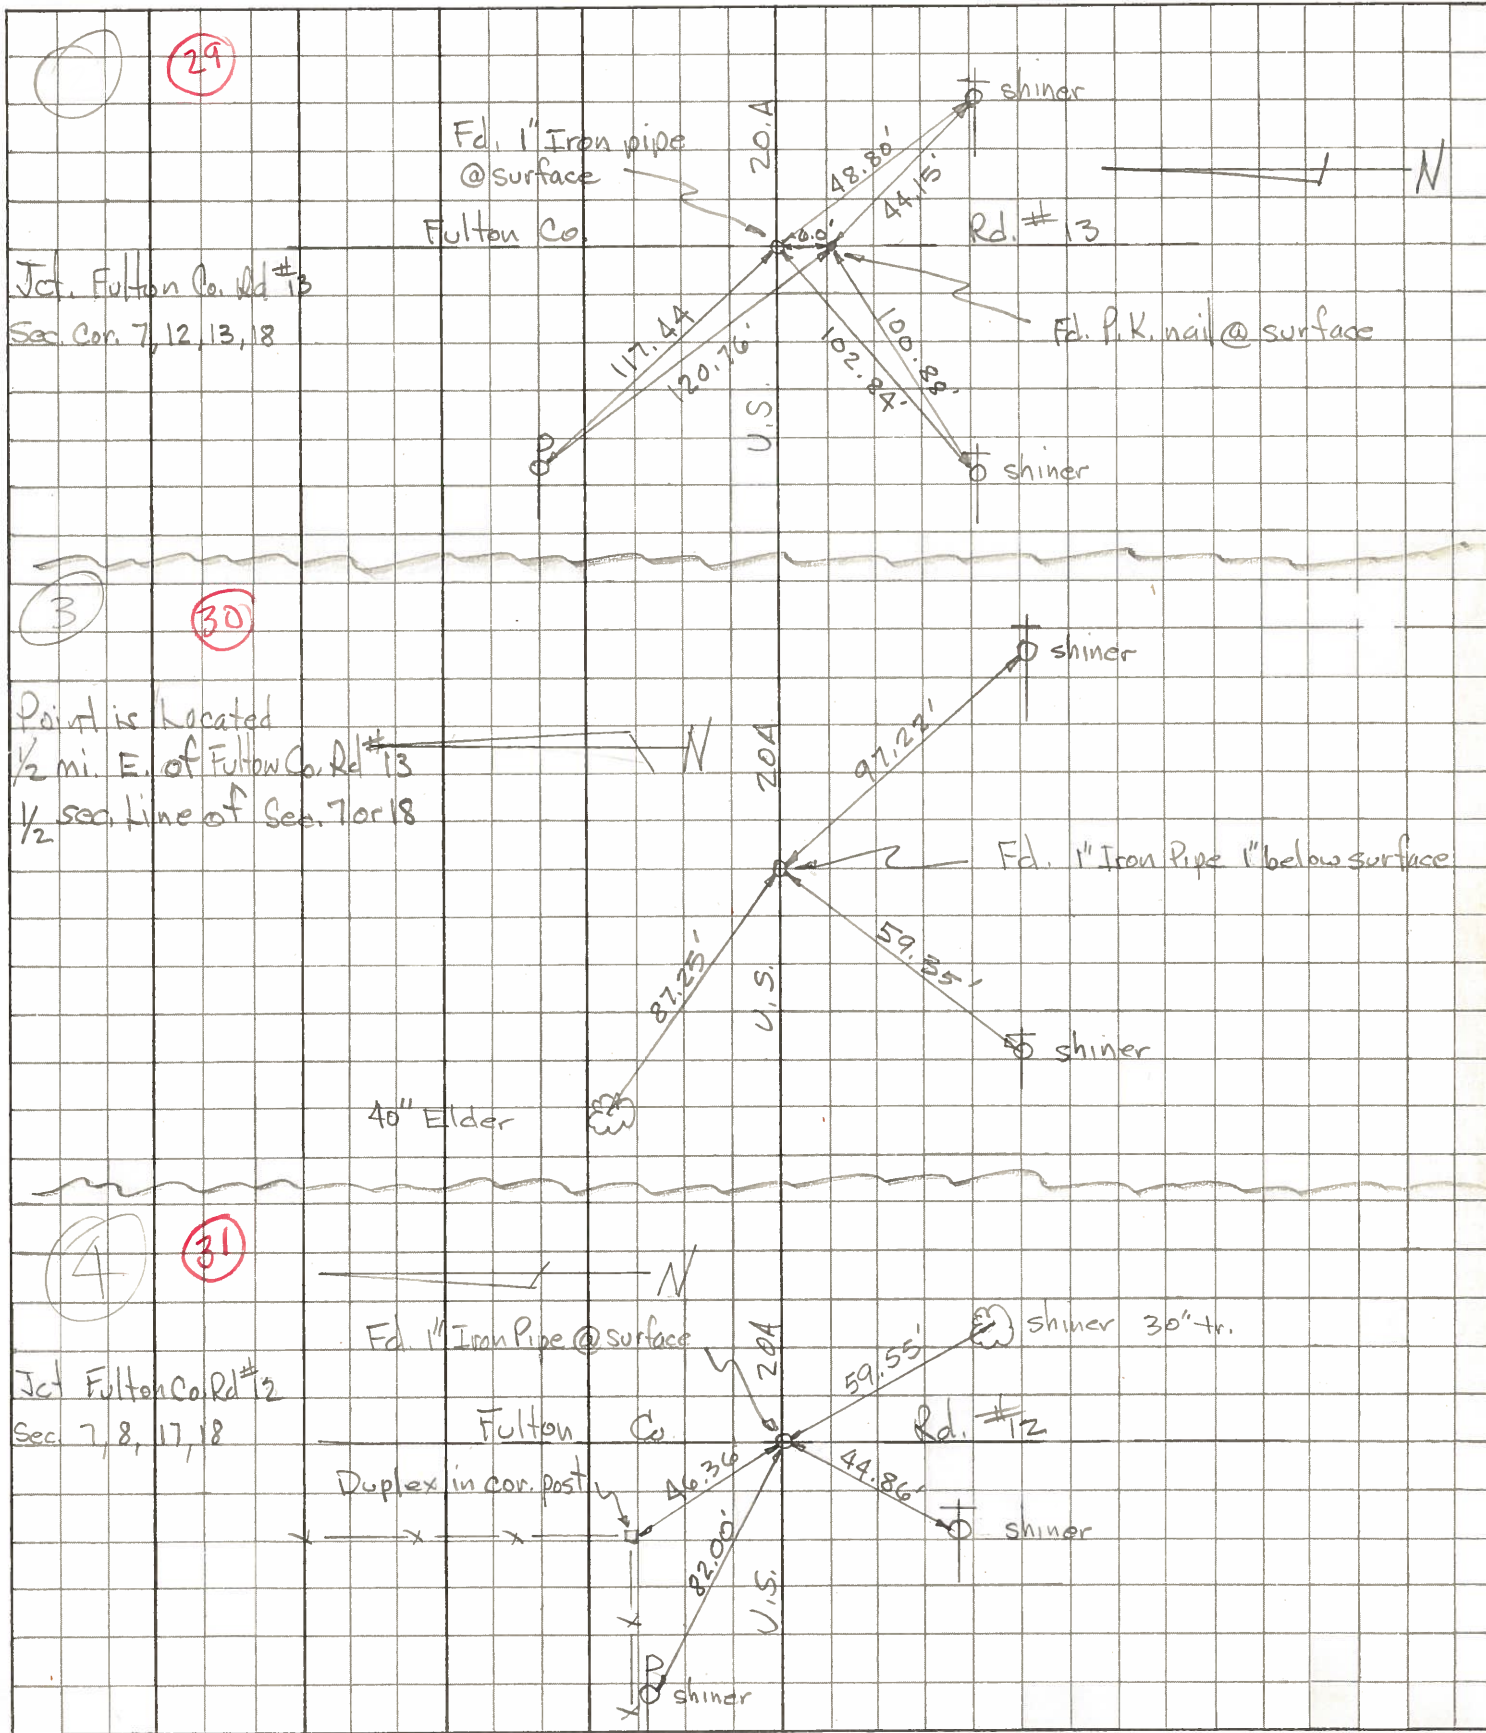

PERSONNEL	TITLE	PERSONNEL	TITLE	COUNTY	FULTON	DATE	Jan 1972
Red Beach				S. R.	US 20-A	WEATHER	
Newcomb				SEC.	13 Clinton Twp. T-7-N	TEMP.	
Knappe							
Eriksen							
ALIGNMENT & CONTROLS				JOB NO. _____			
LEFT		CENTER LINE		RIGHT			

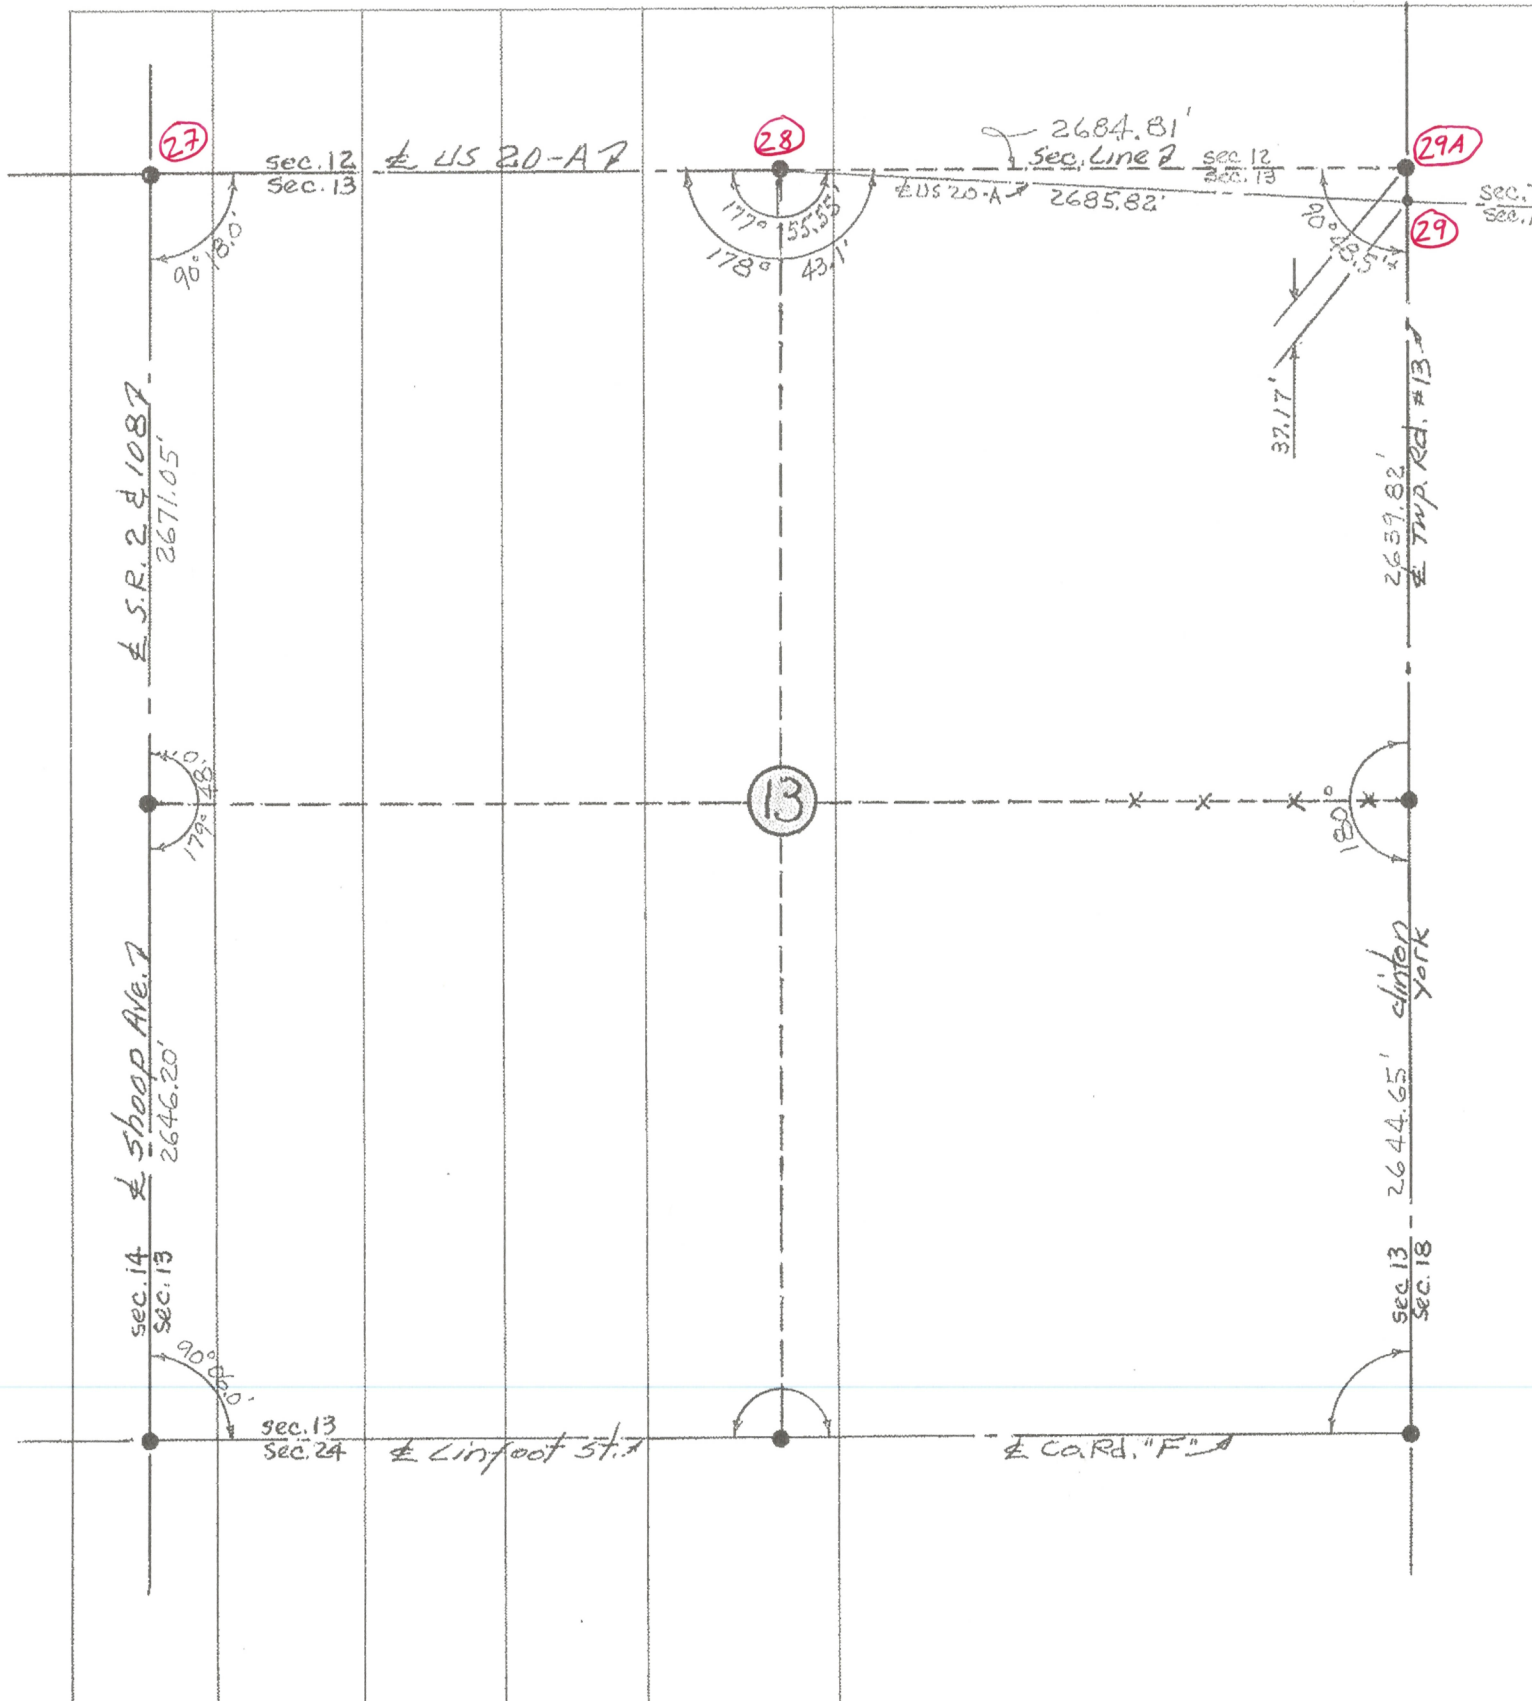

PERSONNEL TITLE

PERSONNEL TITLE

COUNTY FULTONDATE Jan. 1972

Red Beach
Newcomb
Knape
Erikson

S. R. US 20-A

WEATHER _____

SEC. clinton-york T-7-N TEMP. _____

DESCRIPTION

CONTROL

POINTS

JOB NO. _____

LEFT

CENTER LINE

RIGHT

CLINTON-YORK TWP. JUNCTION

(29) US 20-A @ Twp. Rd. #13

"Clinton Corner"

Found 11" x 1 1/4" Rod
 from old witnesses
 2" below surface.

Est. 18" x 1" pipe
 21 Jan 1972

offset PK's 6'
 N & W on surf.

Near side 3" pipe

stl. pipe
 Gas Valve
 Cage

46.41'

Sec. 12
 Sec. 13

US 20-A

US 20-A
 Sec. 7
 Sec. 13

No record of STONES at these
 corners in recent years. Made
 cursory search. Extensive
 cuts in the 1930's at this
 junction have erased the
 original corners.

Sec. 12

Sec. 13

Sec. 12

Sec. 13

Sec. 12

60-d spk ESE/s
 13" Catalpa

41.65'

49.07'

60-d spk NNW/s

27" Hickory

32.81'

29.15'

Dup. N/s

47.14'

51.95'

shiner SW/s

37.17'

7.27'

Near side 8" Gas Valve Box

51.52'

82.36'

Near side 8" Gas Valve Box

Stone masonry Foundtn.

Robt. Ward Gorsuch Res.

Clinton York

Clinton York

"YORK CORNER"

Found lg. sq. head
 pin from old
 witnesses 16"

below pavt. surface

Est. 14" x 1" pipe

over existing pin.

21 Jan 1972

set offset PK's 6'

S. & E. of Cor. on

pavt surface.