

O.D.O.T. DISTRICT 2 SURVEY OFFICE (USE ONLY)

PERSONNEL

REFERENCE NO. 30

SHEET 58 OF 63

NOTES RHOADES

DATE 6/11/19

ROUTE US 20A

H.C. O'DONNELL

WEATHER SUNNY

COUNTY FULTON

R.C. MILLER

TEMP. 62°

TOWNSHIP YORK

SECTION 18

DWG BY BALBAUGH

PID 101232

T 7 N R 7 E

TYPE MONUMENT MAG/WASHER

ON SURFACE - ~~BELOW~~ ON

OFFSET CL PAVEMENT ON ~~LT~~ : ~~RT~~

13.1' TO RT EDGE PAVEMENT


STATION: 769+47.43

HORIZ.DATUM: NAD83 (2011)

GEOID: 2012A


GRID: NORTHING: 698713.590

EASTING: 1529267.935

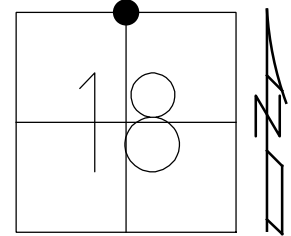

RECORD:

FD P.K.NAIL
9/16/04, MC
SET MAG/WASHER
10/13/04, DH
FD MAG/WASHER
12/5/17, JFO
REF30
12/21/17, JFO
REF30
6/13/19, JFO
FD MONBOX
W/ 1/2" IPIPE
NEWREF30
10/25/19, JFO

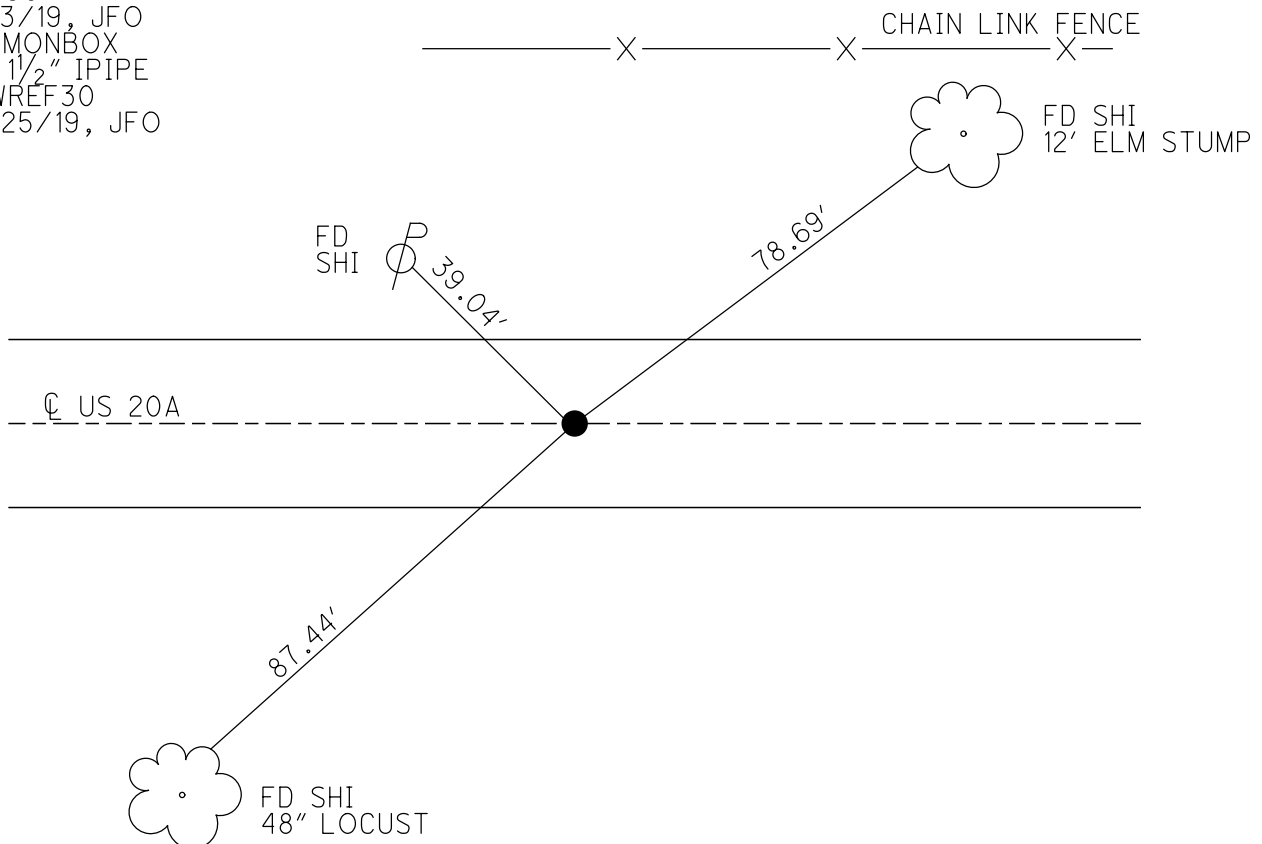

O.D.O.T. DISTRICT 2 SURVEY OFFICE (USE ONLY)

PERSONNEL

REFERENCE NO. 30

SHEET 56 OF 61

NOTES

HOMAN

DATE

9/16/04

ROUTE

US 20A

H.C.

CANTERBURY

WEATHER

CLOUDY

COUNTY

FULTON

R.C.

BARNHISEL

TEMP.

70°

TOWNSHIP

YORK

SECTION

18

T 7 N R 7 E

TYPE MONUMENT

P.K.NAIL

ON SURFACE - ~~BELOW~~

ON

LEFT - ℄ PAV'T - RIGHT

ON


13.1' TO RT EDGE PAVEMENT

S.L.M.

769+50


GRID: NORTHING:

EASTING:

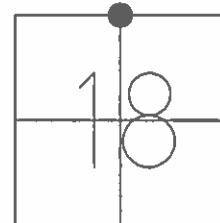

SET MAG/WASHER

10-13-04, DCH

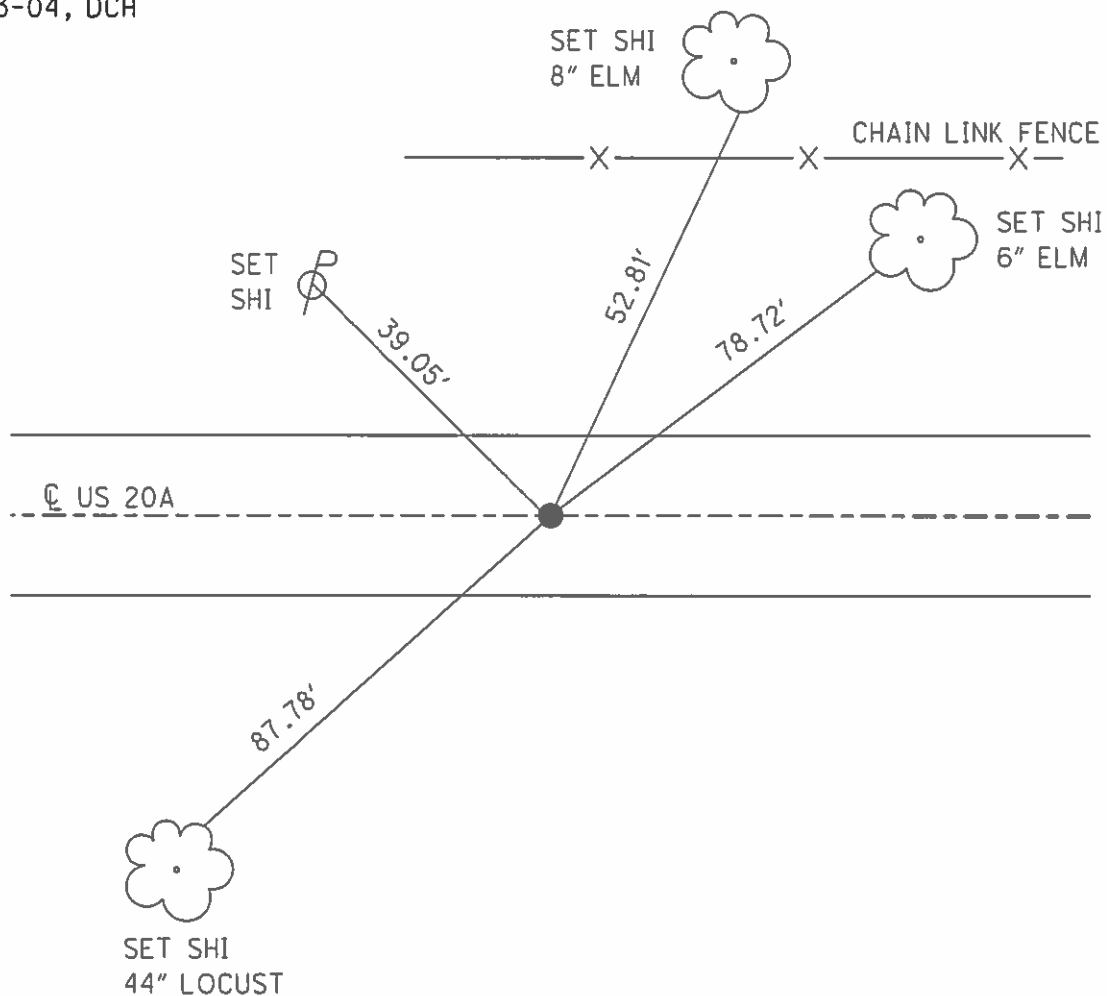

O.D.O.T. DISTRICT 2 SURVEY OFFICE

PERSONNEL

REFERENCE NO. 30

SHEET 3 OF 7

NOTES HOMAN

DATE 9-16-04

ROUTE U.S. 20-A

H.C. CANTERBURY

WEATHER CLOUDY

COUNTY FULTON

R.C. BARNHISEL

TEMP. 70°

TOWNSHIP YORK

SECTION 18

T 7 N R 7 E


TYPE MONUMENT PK NAIL

ON SURFACE - ~~BELOW~~ YES

~~LEFT~~ - Q PAV'T - ~~RIGHT~~ YES

13.1 TO RT EDGE PAVEMENT

S.L.M. 769+50

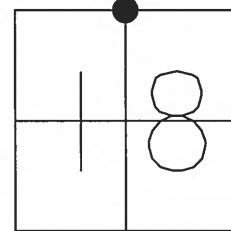

SET MAG NAIL
& WASHER
10-13-04
DCH

SET N&S
SW/S
8" ELM

SET N&S
SE/S

CHAIN LINK FENCE

SET N&S
SW/S
6" ELM

Q PAVT

U.S. 20-A

87.78'

SET N&S
NE/S
44" LOCUST

39.05'

52.81'

78.72'

O.D.O.T. DISTRICT 2 SURVEY OFFICE

PERSONNEL

REFERENCE NO. 30

SHEET 7 OF 24

NOTES 1. Stone

H.C. D. Curtis

DATE 16 Sept. 86

ROUTE US #20-A

R.C. J. Hausholder

WEATHER Cool

COUNTY Fulton

TEMP. 55°

TOWNSHIP Pock

SECTION 18

T R


TYPE MONUMENT PK Nail

ON SURFACE - BELOW Surface


LEFT- & PAV'T. - RIGHT

TO EDGE PAVEMENT

S.L.M. 769+97

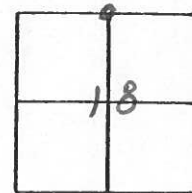

SET P.K. NAIL TO SURFACE
4-29-88

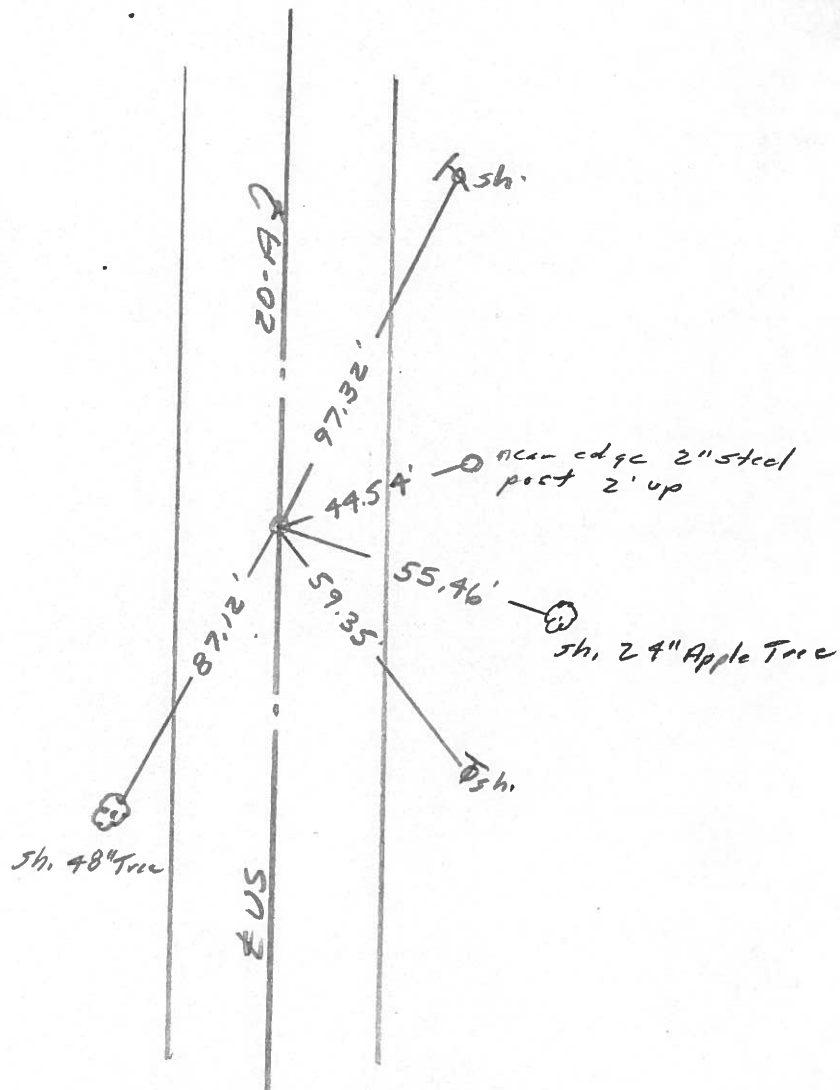

Q.D.O.T. DISTRICT 2 SURVEY OFFICE

SHEET

OF

County Fulton S.R. 2 & US 20A

Date 6-5-1980

Township York

Weather Clear

Section 18 N $\frac{1}{4}$ Cor


Temp. + 80°

TIN, RIE

Personnel Smith


Bowers

Mead

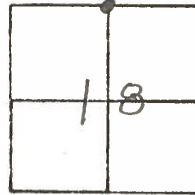


(30)

Fd 1" Iron Pipe @ Surface

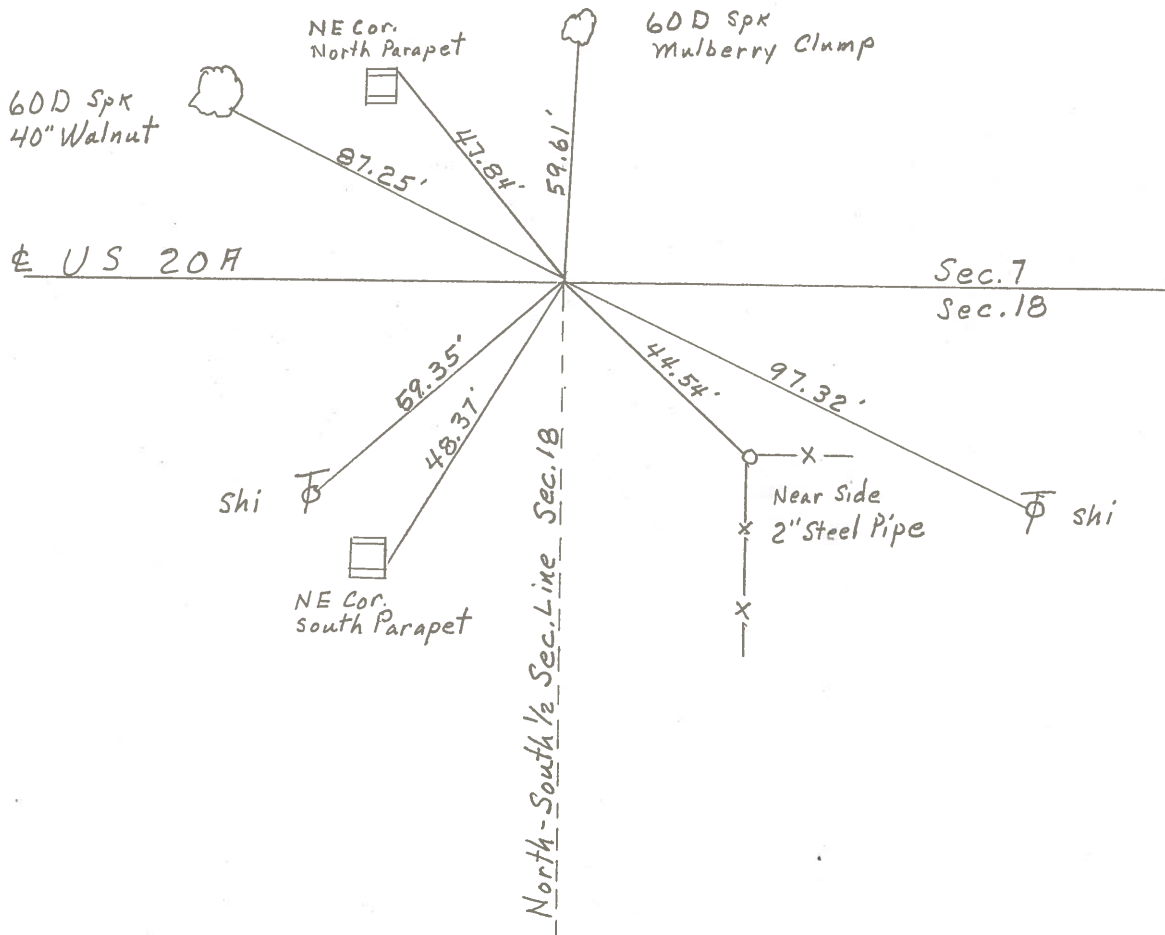


PERSONNEL	TITLE	PERSONNEL	TITLE	COUNTY	DATE	WEATHER	TEMP.
Tomsic				Fulton	April 12, 1973		
Neuser				S. R. U.S. 20A			
Vanyo				SEC. YORK			
Granata							

DESCRIPTION	LEFT	CENTER LINE	RIGHT	JOB NO.
-------------	------	-------------	-------	---------

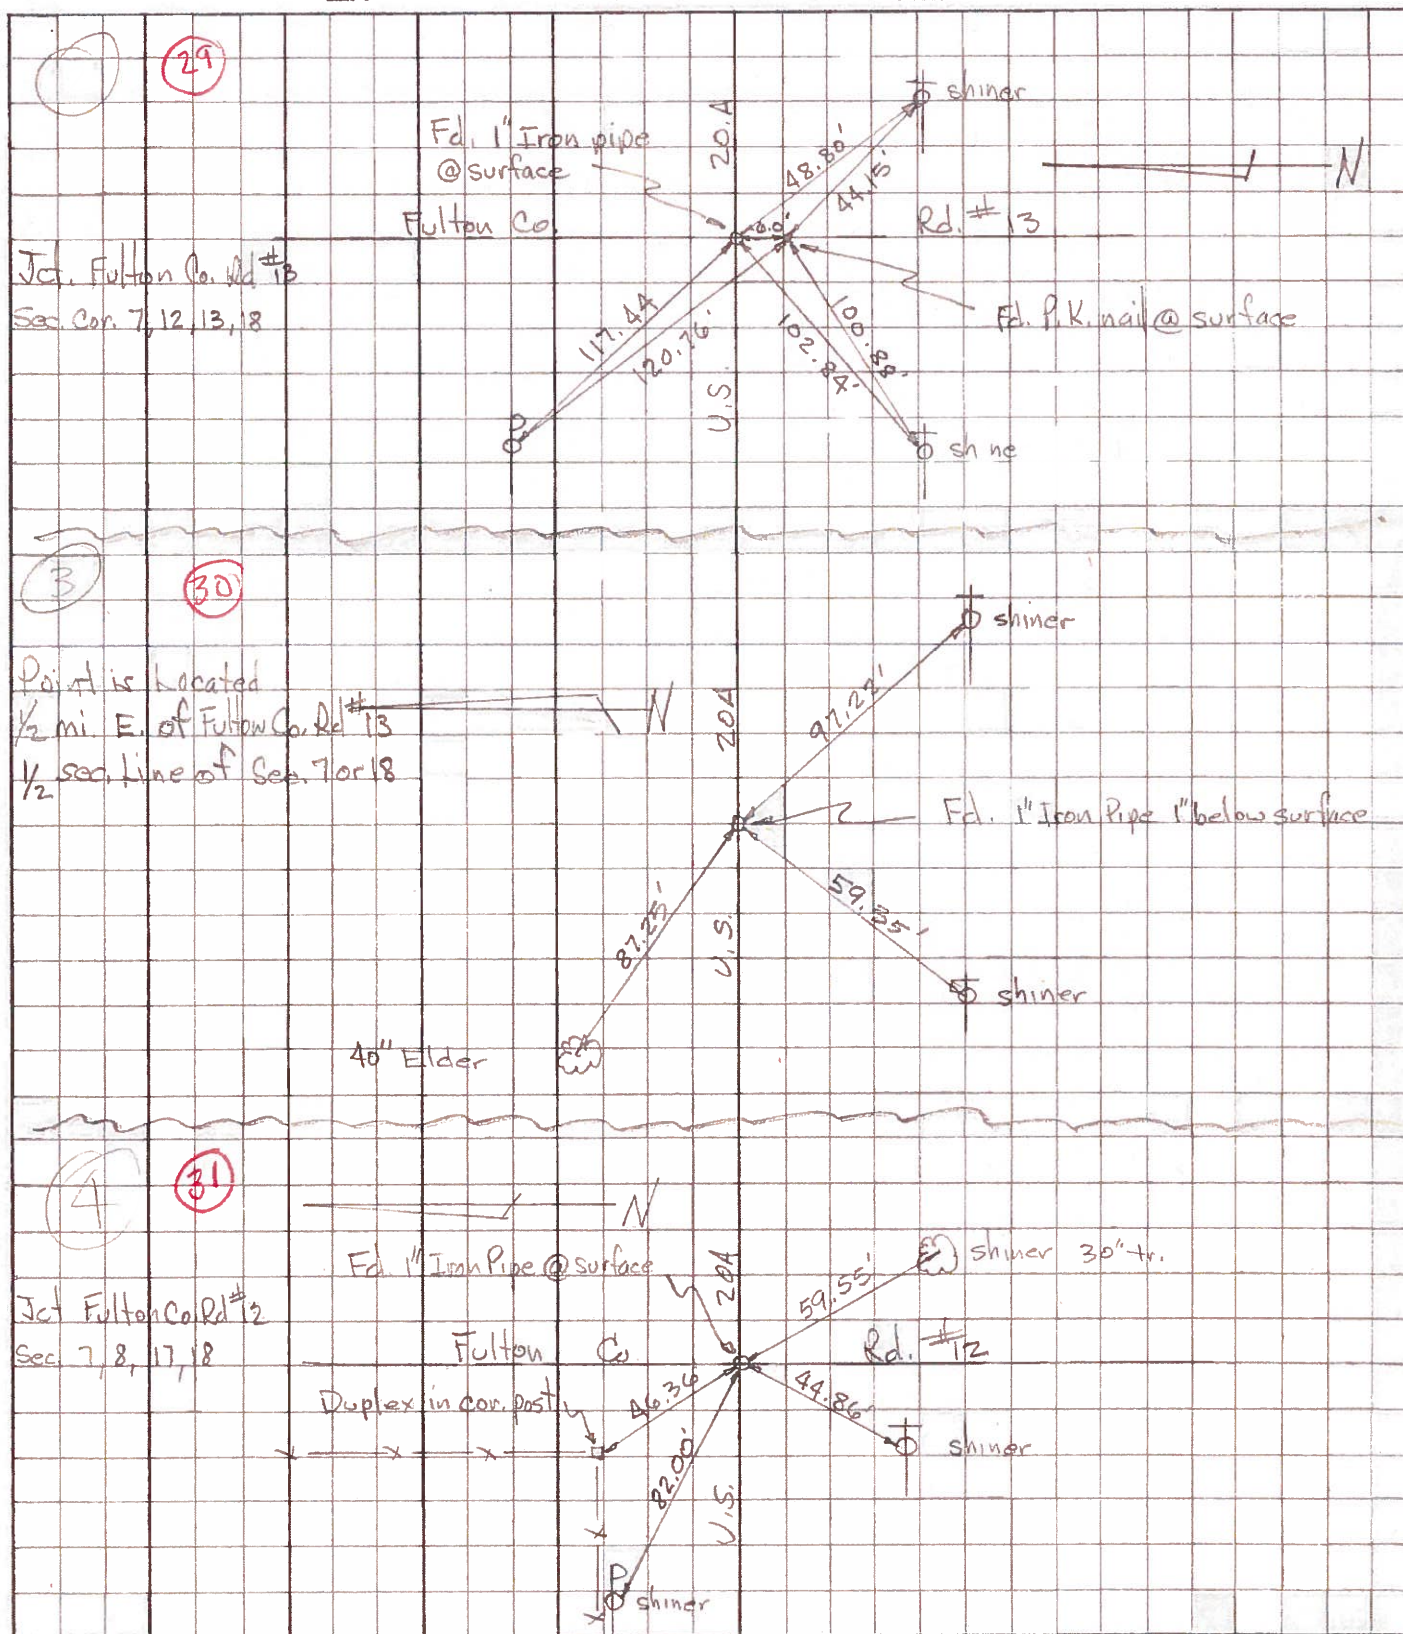

PERSONNEL	TITLE	PERSONNEL	TITLE	COUNTY	DATE
Red Beach,				Fulton	Jan 1972
Newcomb				S. R.	US 20-A
Knappe				SEC.	7 YORK TWP. T-7-N
Eriksen				TEMP.	
DESCRIPTION				ALIGNMENT & CONTROLS	
LEFT		CENTER LINE		RIGHT	
				JOB NO.	

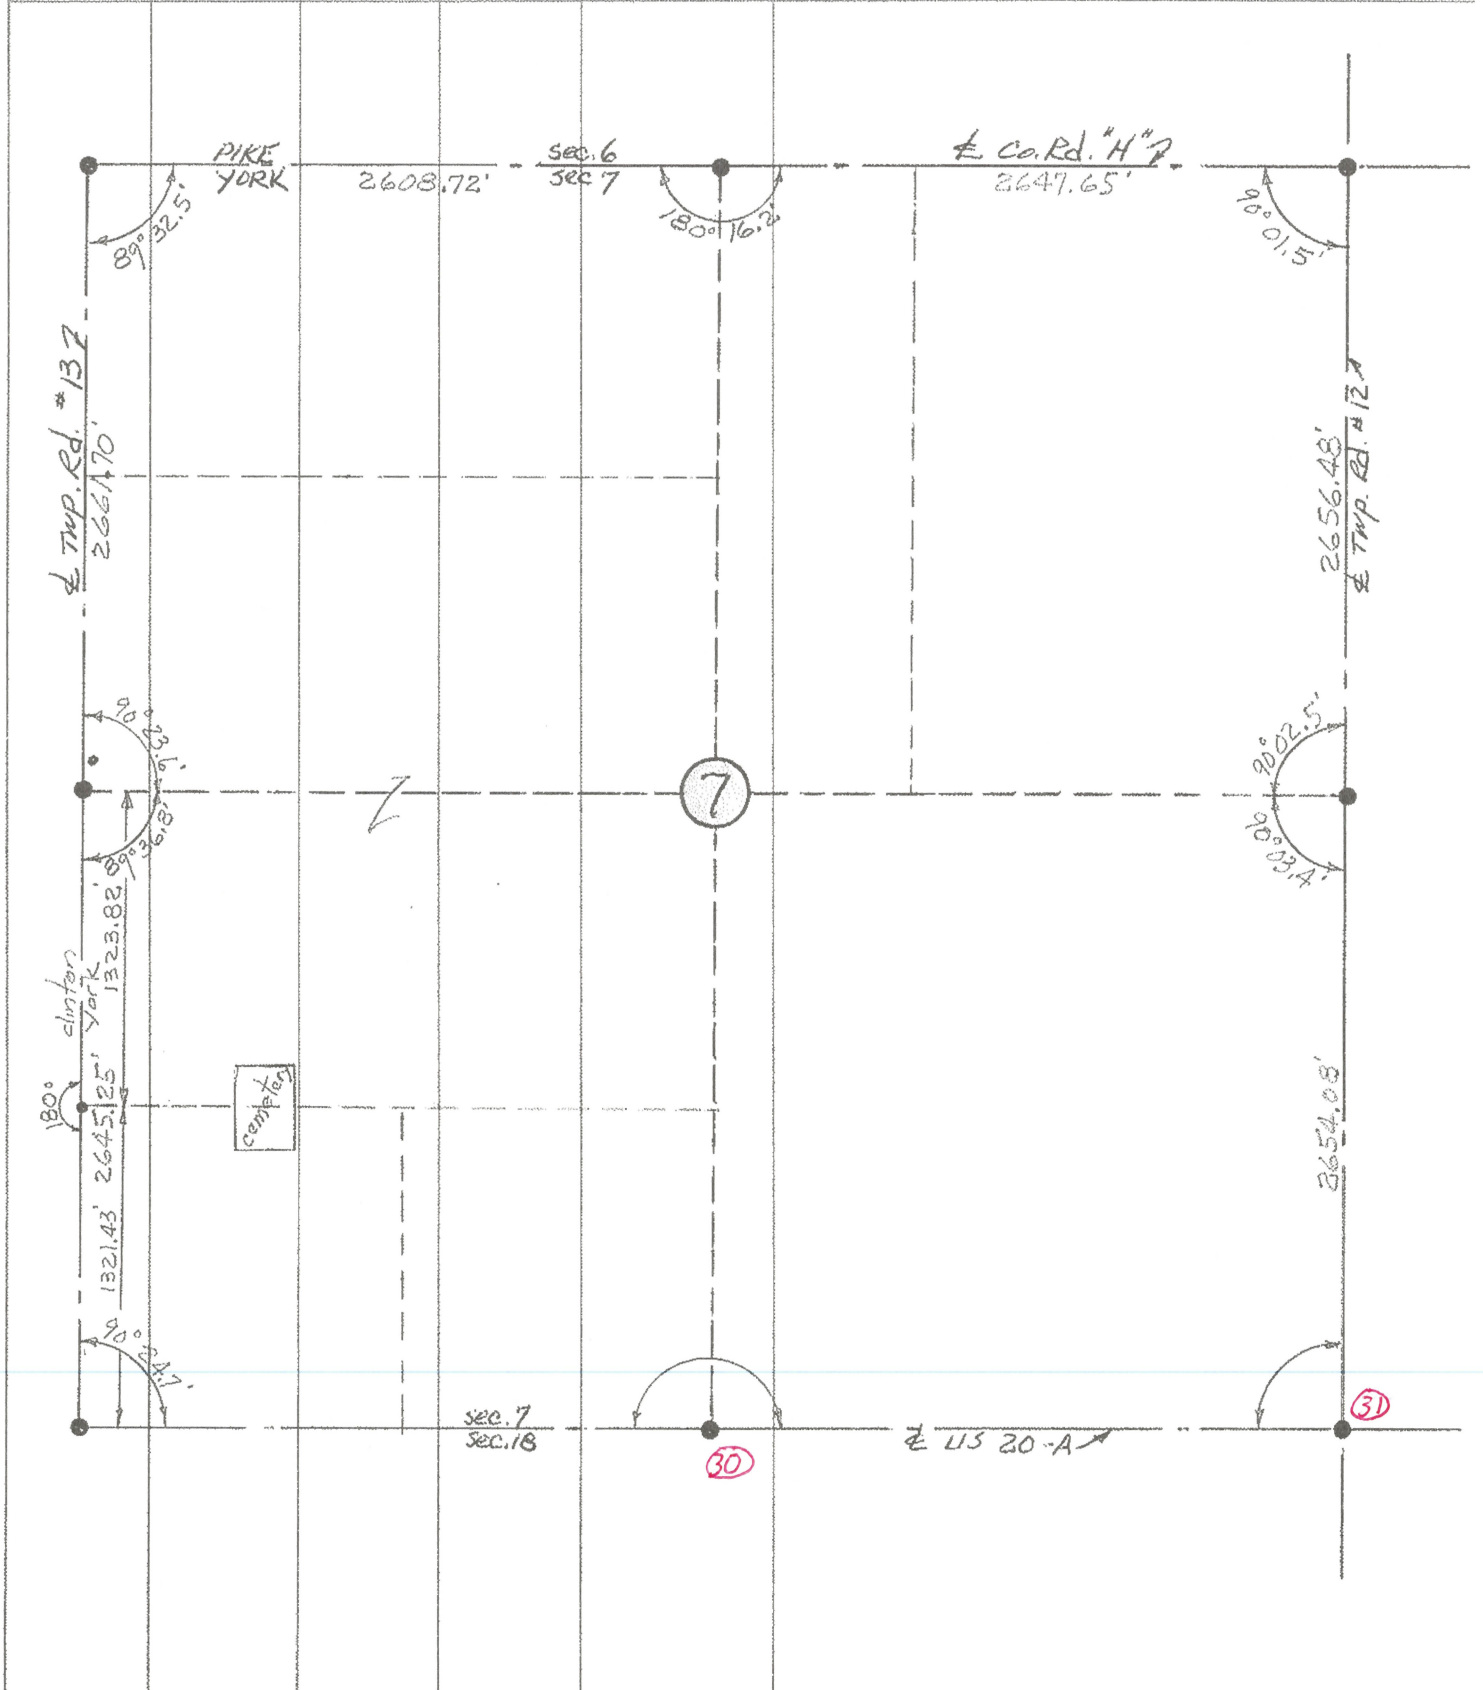

COUNTY Fulton DATE Jan 1972

S. R. US 20-A WEATHER

SEC. YORK TWP TEMP. _____

DESCRIPTION CONTROL POINTS JOB NO.

LEFT

CENTER LINE

RIGHT

- JOB NO.

S¹/₄ STONE, sec. 8 YORK TWP. T-7-N
N¹/₄ STONE, sec. 17 YORK TWP T-7-N

S $\frac{1}{4}$ STONE, Sec. 7 YORK TWP. T-7-N
N $\frac{1}{4}$ STONE, Sec 18 YORK TWP. T-7-N

Hand-drawn sketch of a survey area. The sketch includes several points marked with 'x' and lines connecting them. Key labels and measurements include:

- Top Left:** "Dup w/s Wagner Mtn. Sales Sign" with an arrow pointing to a point.
- Top Right:** "Dup E/s Cor. post" with an arrow pointing to a point.
- Left Side:** "Dup SW/s 3rd panel post western" with an arrow pointing to a point.
- Center:** A point labeled "NW Cor. #2-2 CB" with a small square symbol next to it.
- Angles and Distances:**
 - Angle of 81.82° at the bottom left point.
 - Angle of 28.57° at the bottom center point.
 - Angle of 51.22° at the top right point.
 - Angle of 41.26° at the bottom right point.
 - Distance of $7' \pm$ between two points at the top.
 - Distance of $10' \pm$ between two points at the top right.
- Bottom Right:** A note "Found 10' pin 3' below surface" with an arrow pointing to a point.
- Far Right:** A vertical line labeled "Z".

60-d spk w/s Mulberry
7"-8"-9"-10"-11"-12" clump
NE Cor. North parapet
1-2 CB

60-d spk NNE/s
(37" walnut)

89.30'

47.84'

59.69'

19 Jan. 1972
Found qtr. STONE
w/ tile 25" below
pavt. surface,
chsld "t" top ctr.
£ US 20-A

sec. 7 sec. line 2
sec. 18

US 20-A & Sec. Line 2 sec. 8

sec. 8
Sec. 17

offset PK's 6' N & E on part. surface. Found qtn STONE w/ tile 15" below surface. 18 Jan. 72

Est. 19" x 1" pipe
on surface
over stone

NE Cor. South parapet-
1-2 CB

offset PKs 6' N & E
on part. surface.
STONE is 0.1' south of
ctr. of 24.0' part.

Found 15" pin 10" below part surface over STAIR
Found small RR spk on surface

COR. STONE Sec. 7, 8, 17 & 18 YORK Twp T-7-N

NW Cor., S $\frac{1}{2}$, SW $\frac{1}{4}$, Sec. 7, YORK Twp T-7-N

31

A hand-drawn survey map on grid paper. A vertical line is labeled "Sec. 7" on the left and "Sec. 8" on the right, with a north arrow pointing upwards. A horizontal line is labeled "Twp. Rd. 12 E". A line segment from the intersection of the section line and township road is labeled "82.46'" and "Dup SW 1/4". Another line segment is labeled "46.34'" and "Dup E 1/4". A third line segment is labeled "62.03'" and "Near side 3" pipe ctr. 15.5' x 2.5' abandoned pump island". A fourth line segment is labeled "21 1/2" below surface." and "Found con. STONE w/ brick". The date "18 Jan 1972" is written near the bottom right. The text "US 20-A2" is written at the bottom right.

Sec. 7

Sec. 8

Twp. Rd. 12 E

82.46'

46.34'

62.03'

Near side 3" pipe
ctr. 15.5' x 2.5'
abandoned pump
island

Found con. STONE w/ brick
21 1/2" below surface.

18 Jan 1972

US 20-A2

offset PK's 6' N & E
on pavt surf.

42' 18' 17' 6'

Near side 2" filler pipe

3'

60-d sk w/s
20" Maple
26'
24'
60-d sk E/S
33" T.O.H.
18.95'
STONE
FOUND.

EST. 18" x 1 pipe
on surface over
the COR-STONE,
chiseled "+" top ctr
of STONE
STONE is 0.4' south
of 1.0' - 1.2' - 1.4' - 1.6' - 115.4' - 1

[illegible]

PERSONNEL TITLE PERSONNEL TITLE

COUNTY Fulton DATE 3-28-55S. R. #2 & 20 Aft. WEATHER 9-12-60SEC. M, A, O, TEMP.

DESCRIPTION LEFT CENTER LINE RIGHT JOB NO.

P.I. Sta. 53+62.34
S.W. cor. sec. 7
Fd. iron pin 12" below
surface of pav't.
(Not plum bed.)

#72 ✓

S.E. to shiner in T.P. 45.35'
S.W. to shiner in A. Post 46.90'
S.W. to shiner in T.P. 102.25'
N.W. to shiner in 24" Elm 171.45'
N.E. to shiner in 20" Hickory 51.05'

Sta. 79+78.58
S. 1/4 sec. 7
Fd. iron pin

#73 ✓

N.W. to shiner in 30" walnut 87.25'
S.W. to shiner in T.P. 59.60
S.E. to iron A.P. 1' above gnd. 44.30'
N.E. to shi. in 24" Spruce N.E. 97.15'

Sta. 106+08.39
S.W. cor. sec. 8
Iron pin

#74 ✓

N.E. to iron post in pump island 62.09'
N.W. to shiner in P.P. 81.90'
S.W. to shiner in 12" maple 54.83'
S.E. to shiner in 30" catalpa 59.70'

Sta. 132+68.17
S. 1/4 sec. 8
Fd. iron pin

#75

N.N.E. to steel sign post stake 40.47'
N.N.E. to shiner in P.P. 40.94 40.88'
N.W. to shiner in 3rd fence post 54.35'
S. to shiner in T.P. 38.25'

Sta. 159+27.37
S.W. cor. sec. 9
Fd. iron pin

#76

S.W. to shiner in T.P. 44.10'
N.E. to shiner in P.P. 45.67'
S.E. to near side of Gov. B.M. 56.97'
N.W. to near side of iron A.P. 44.80'