

O.D.O.T. DISTRICT 2 SURVEY OFFICE (USE ONLY)

PERSONNEL

REFERENCE NO. 31

SHEET 59 OF 63

NOTES RHOADES

DATE 6/11/19

ROUTE US 20A

H.C. O'DONNELL

WEATHER SUNNY

COUNTY FULTON

R.C. MILLER

TEMP. 62°

TOWNSHIP YORK

SECTION 18

DWG BY BALBAUGH PID 101232

T 7 N R 7 E

TYPE MONUMENT MAG/WASHER

ON SURFACE - ~~BELOW~~ ON

OFFSET Q PAVEMENT ON LT : RT

TO EDGE PAVEMENT


STATION: 795+77.04

HORZ.DATUM: NAD83 (2011)


GEOID: 2012A

GRID: NORTHING: 698652.834

EASTING: 1531896.829

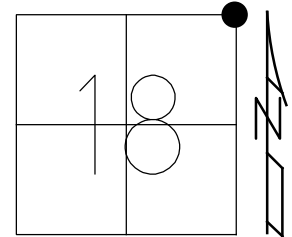

RECORD:  
FD P.K.NAIL  
9/16/04, MC  
SET MAG/WASHER  
10/13/04, DCH  
FD MAG/WASHER  
12/5/17, JFO  
REF31  
12/21/17, JFO  
REF31  
6/13/19, JFO  
FD MONBOX  
W/ 1 1/2" IPIPE  
NEWREF31  
10/25/19, JFO

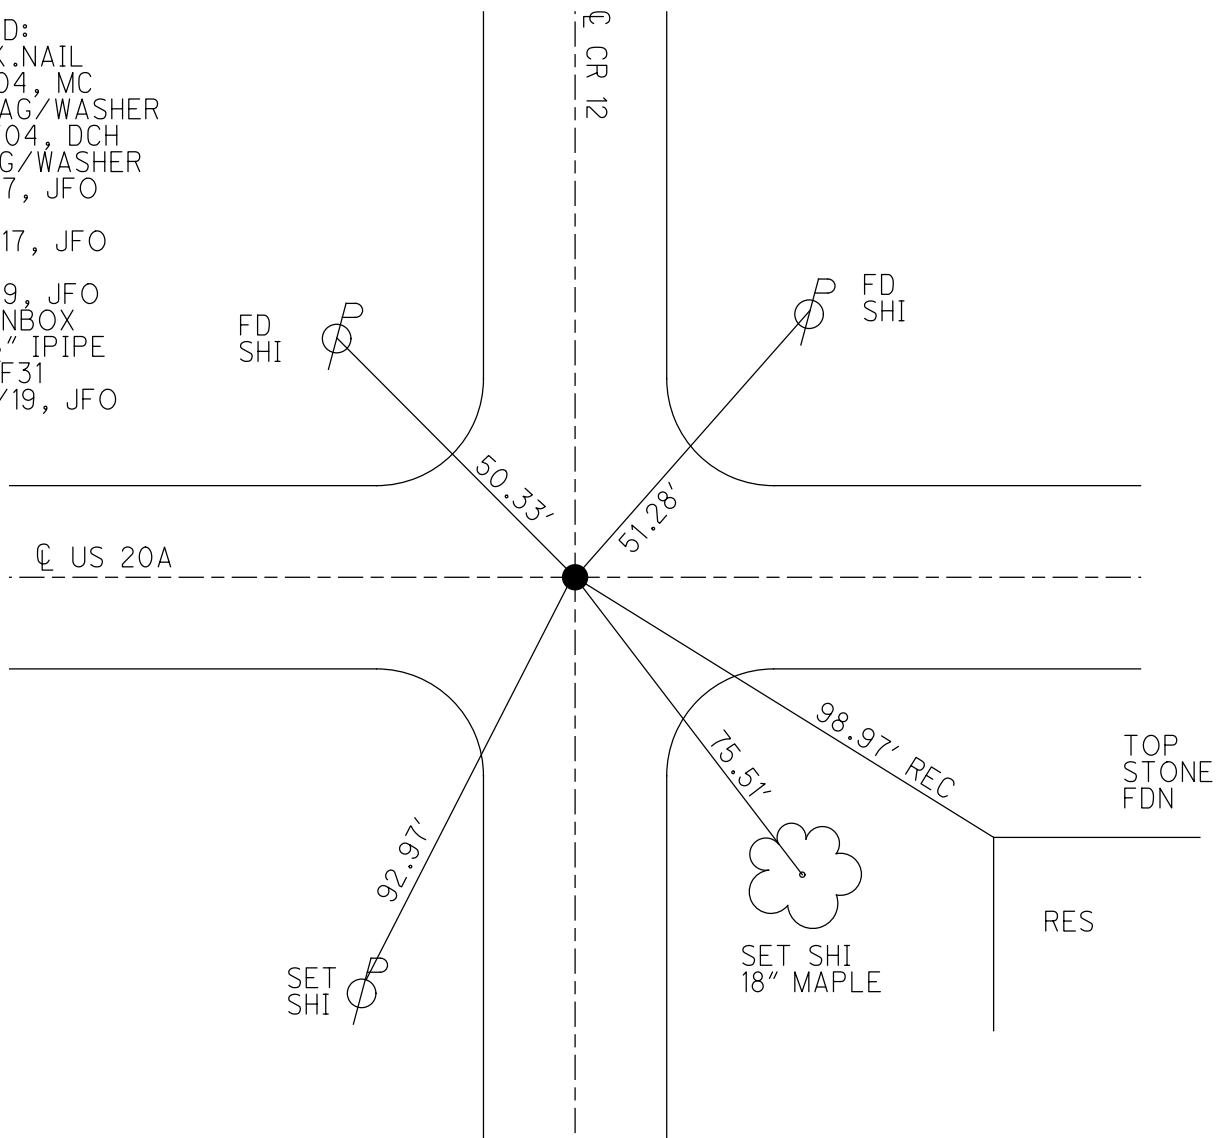

# O.D.O.T. DISTRICT 2 SURVEY OFFICE (USE ONLY)

PERSONNEL

REFERENCE NO.

31

SHEET

57

OF 61

NOTES

HOMAN

DATE

9/16/04

ROUTE

US 20A

H.C.

CANTERBURY

WEATHER

CLOUDY

COUNTY

FULTON

R.C.

BARNHISEL

TEMP.

70°

TOWNSHIP

YORK

SECTION

18

T 7 N

R 7 E

TYPE MONUMENT

P.K. NAIL

ON SURFACE - ~~BELOW~~

ON

LEFT - C PAV'T - RIGHT

ON


- TO - EDGE PAVEMENT

S.L.M.

795+79


GRID: NORTHING:

EASTING:

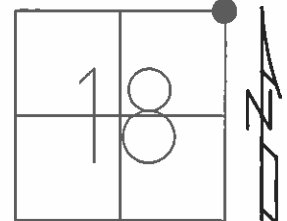

SET MAG/WASHER

10-13-04, DCH

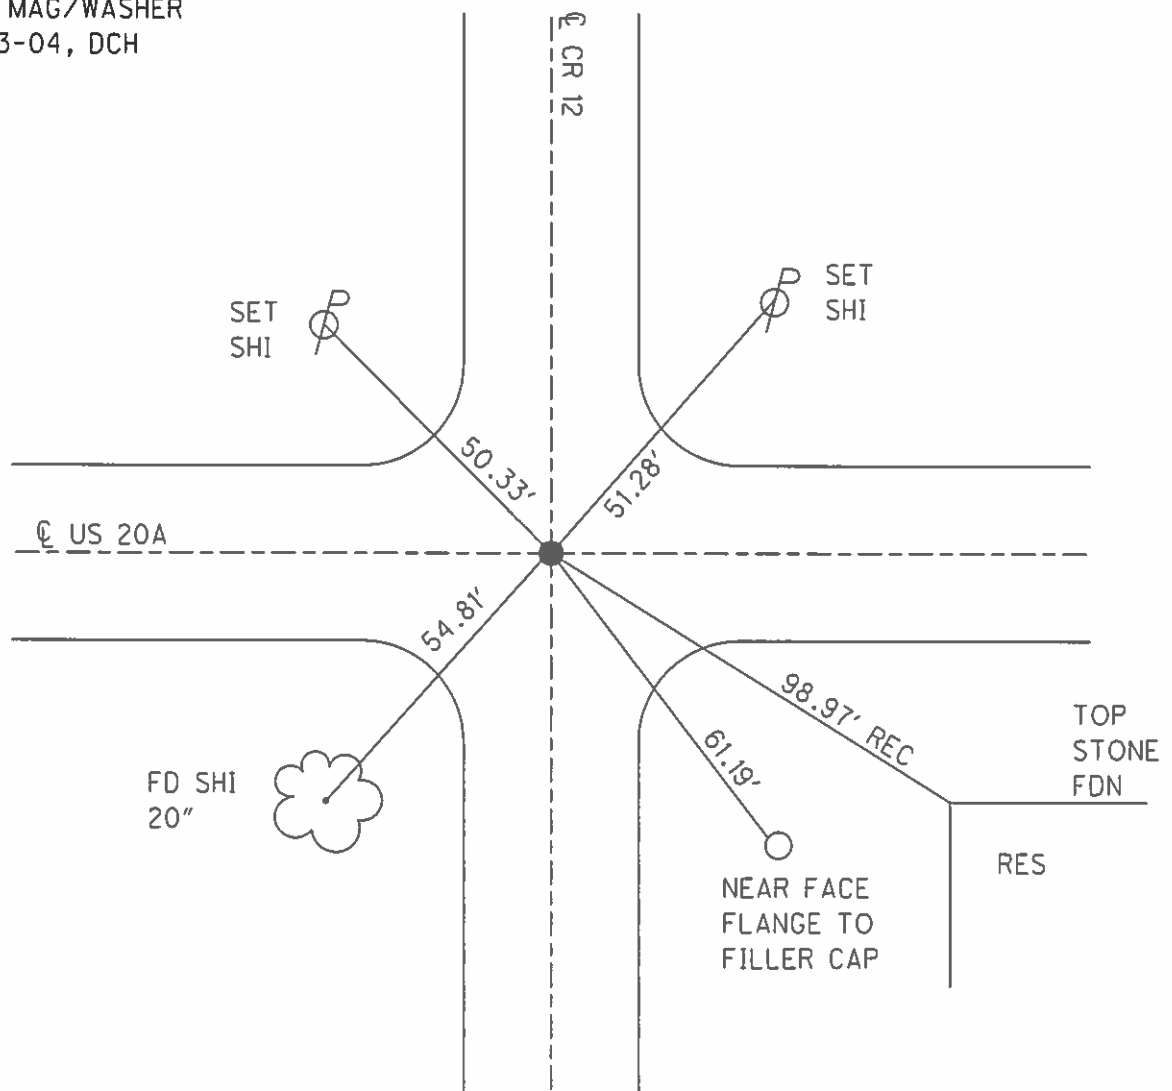

O.D.O.T. DISTRICT 2 SURVEY OFFICE

PERSONNEL

REFERENCE NO. 31

SHEET 4 OF 7

NOTES HOMAN

DATE 9-16-04

ROUTE U.S. 20-A

H.C. CANTERBURY

WEATHER CLOUDY

COUNTY FULTON

R.C. BARNHISEL

TEMP. 70°

TOWNSHIP YORK

SECTION 7-8-17-18

T 7 N R 7 E


TYPE MONUMENT PK NAIL

ON SURFACE ~~- BELOW~~ YES


~~LEFT~~ - Q PAVT ~~- RIGHT~~ YES

TO EDGE PAVEMENT

S.L.M. 795+79

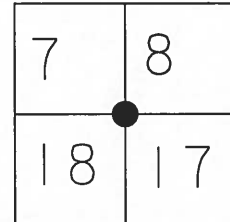

SET MAG NAIL  
& WASHER  
10-13-04  
DCH

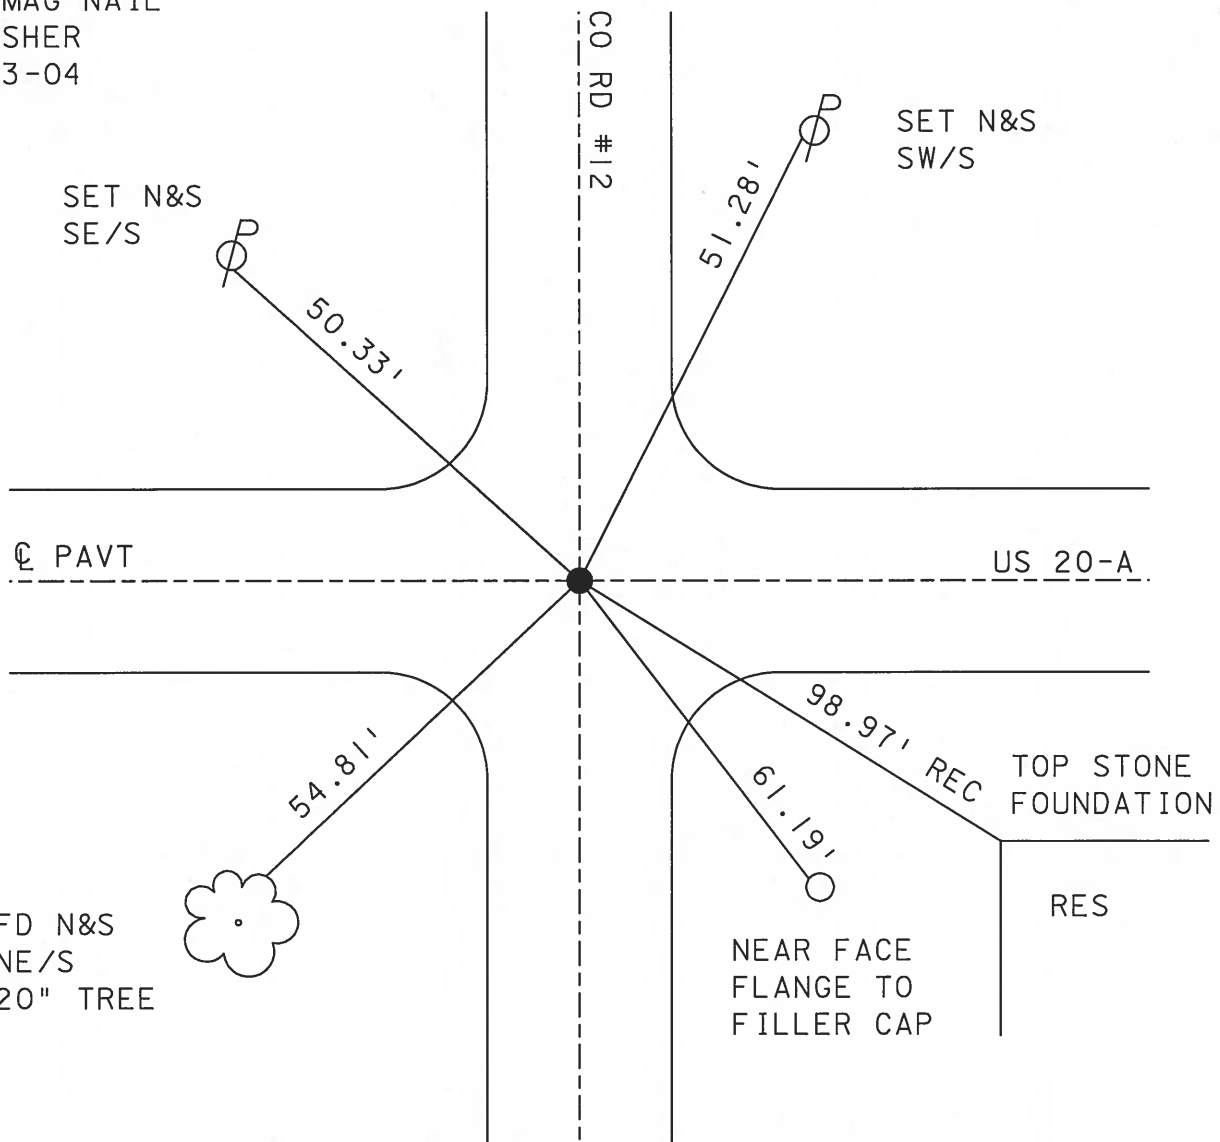

# O.D.O.T. DISTRICT 2 SURVEY OFFICE

PERSONNEL

REFERENCE NO. 31

SHEET 8 OF 24

NOTES 1. Stone

H.C. D. Curtis

R.G. J. Hauscholder

DATE 16 Sept. 86

WEATHER Eool

TEMP. 57°

ROUTE US #20-A

COUNTY Fulton

TOWNSHIP York

SECTION 7-8-17-18

T    R   

TYPE MONUMENT PK Nail

ON SURFACE - BELOW Surface

LEFT- & PAW'T. - RIGHT   


   TO    EDGE PAVEMENT

S.L.M. 796+25

|    |    |
|----|----|
| 7  | 8  |
| 18 | 17 |



SET P.K. NAIL TO SURFACE  
4-29-88

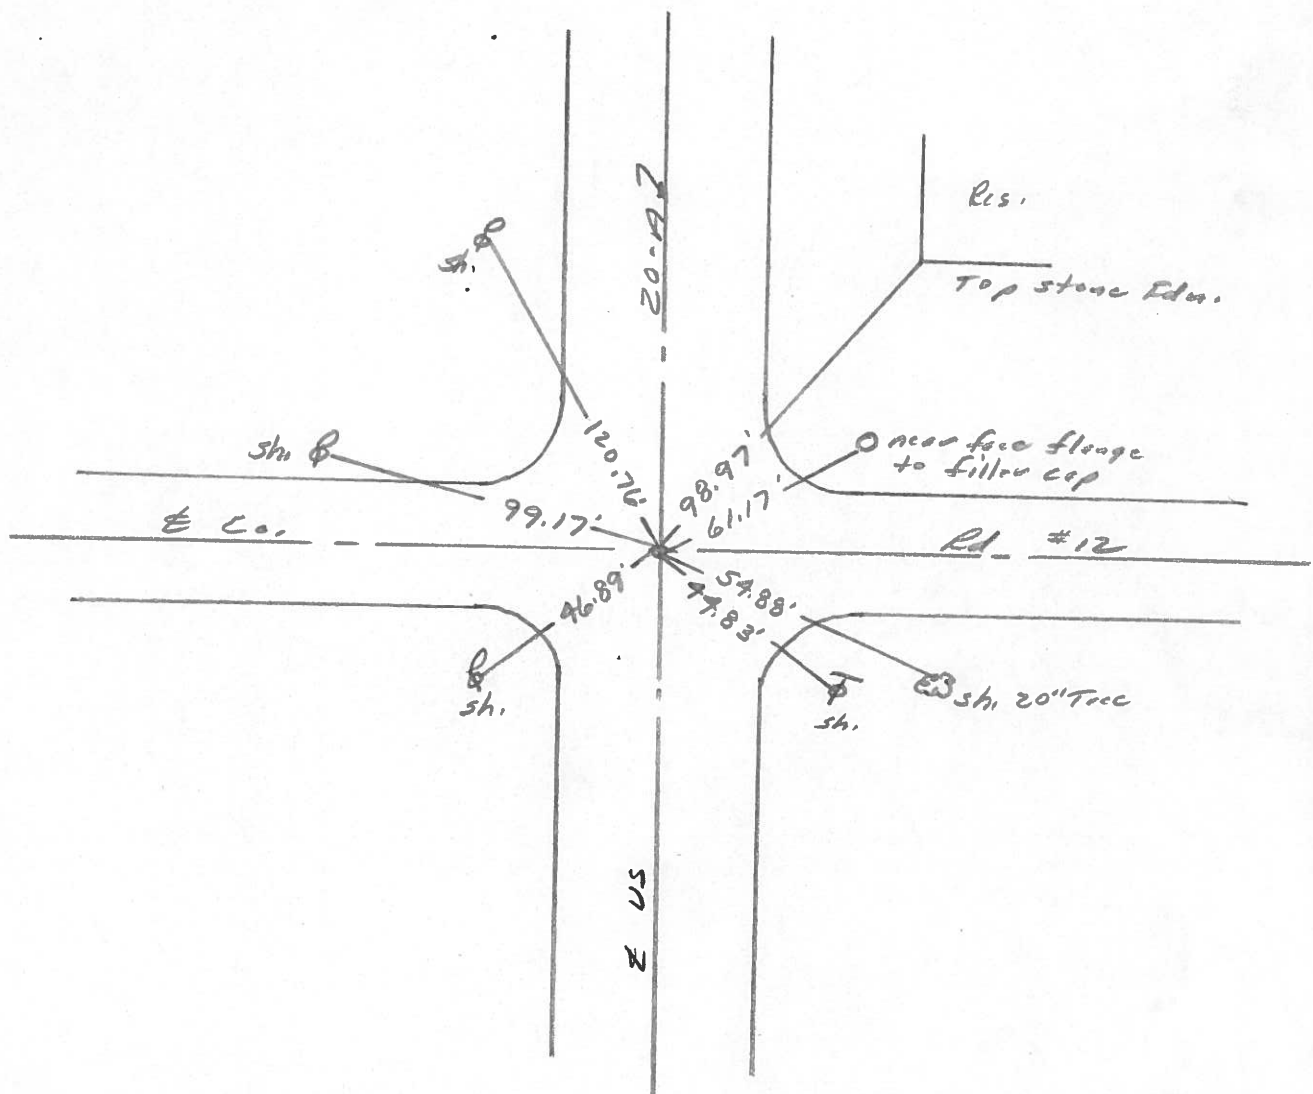

# O.D.O.T. DISTRICT 2 SURVEY OFFICE

SHEET

OF

County Fulton S.R. 2 & US 20A

Date 6-5-1980 <sup>OK-10-15-80</sup>

Township York

Weather Clear

Section NW Cor. Sec. 17 NE Cor. Sec. 18


Temp. +80°

TZN, RZE <sup>SW Cor. Sec. 8 SE Cor. Sec. 7</sup>

Personnel Smith

Bowers


Mead

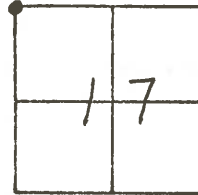

(31)


Fd 1" Iron Pipe  
@ Surface

SET P.K. & Shi.  
BOWERS

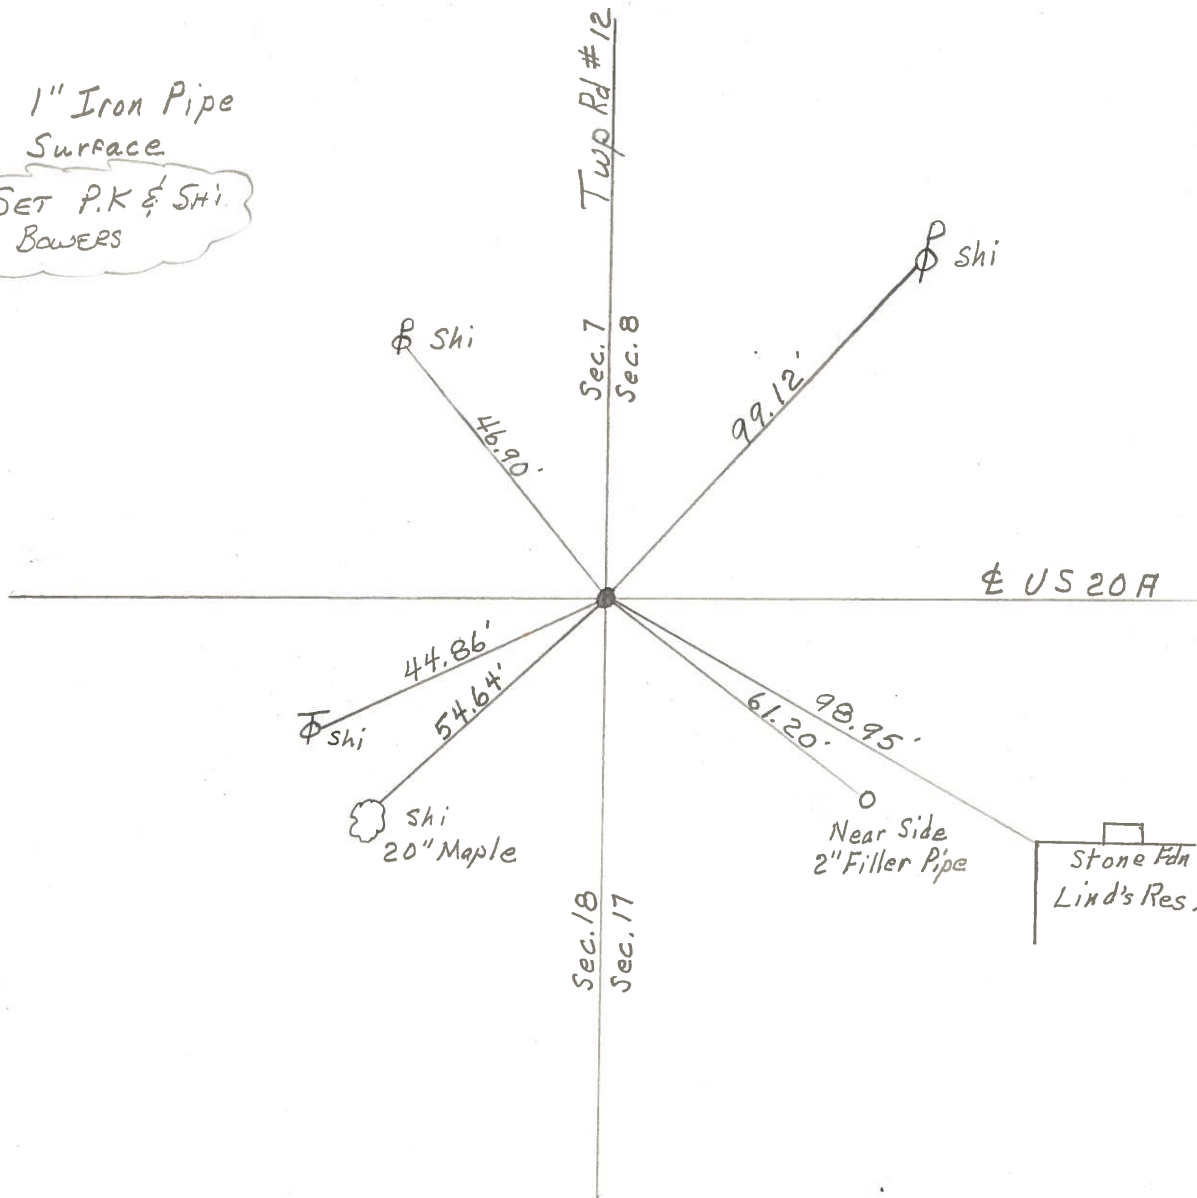

| PERSONNEL | TITLE | PERSONNEL | TITLE | COUNTY         | DATE           | WEATHER | TEMP. |
|-----------|-------|-----------|-------|----------------|----------------|---------|-------|
| Tomsic    |       |           |       | Fulton         | April 12, 1973 |         |       |
| Neuser    |       |           |       | S. R. U.S. 70A |                |         |       |
| Vanyo     |       |           |       | SEC. YORK      |                |         |       |
| Granata   |       |           |       |                |                |         |       |

DESCRIPTION LEFT CENTER LINE RIGHT JOB NO.

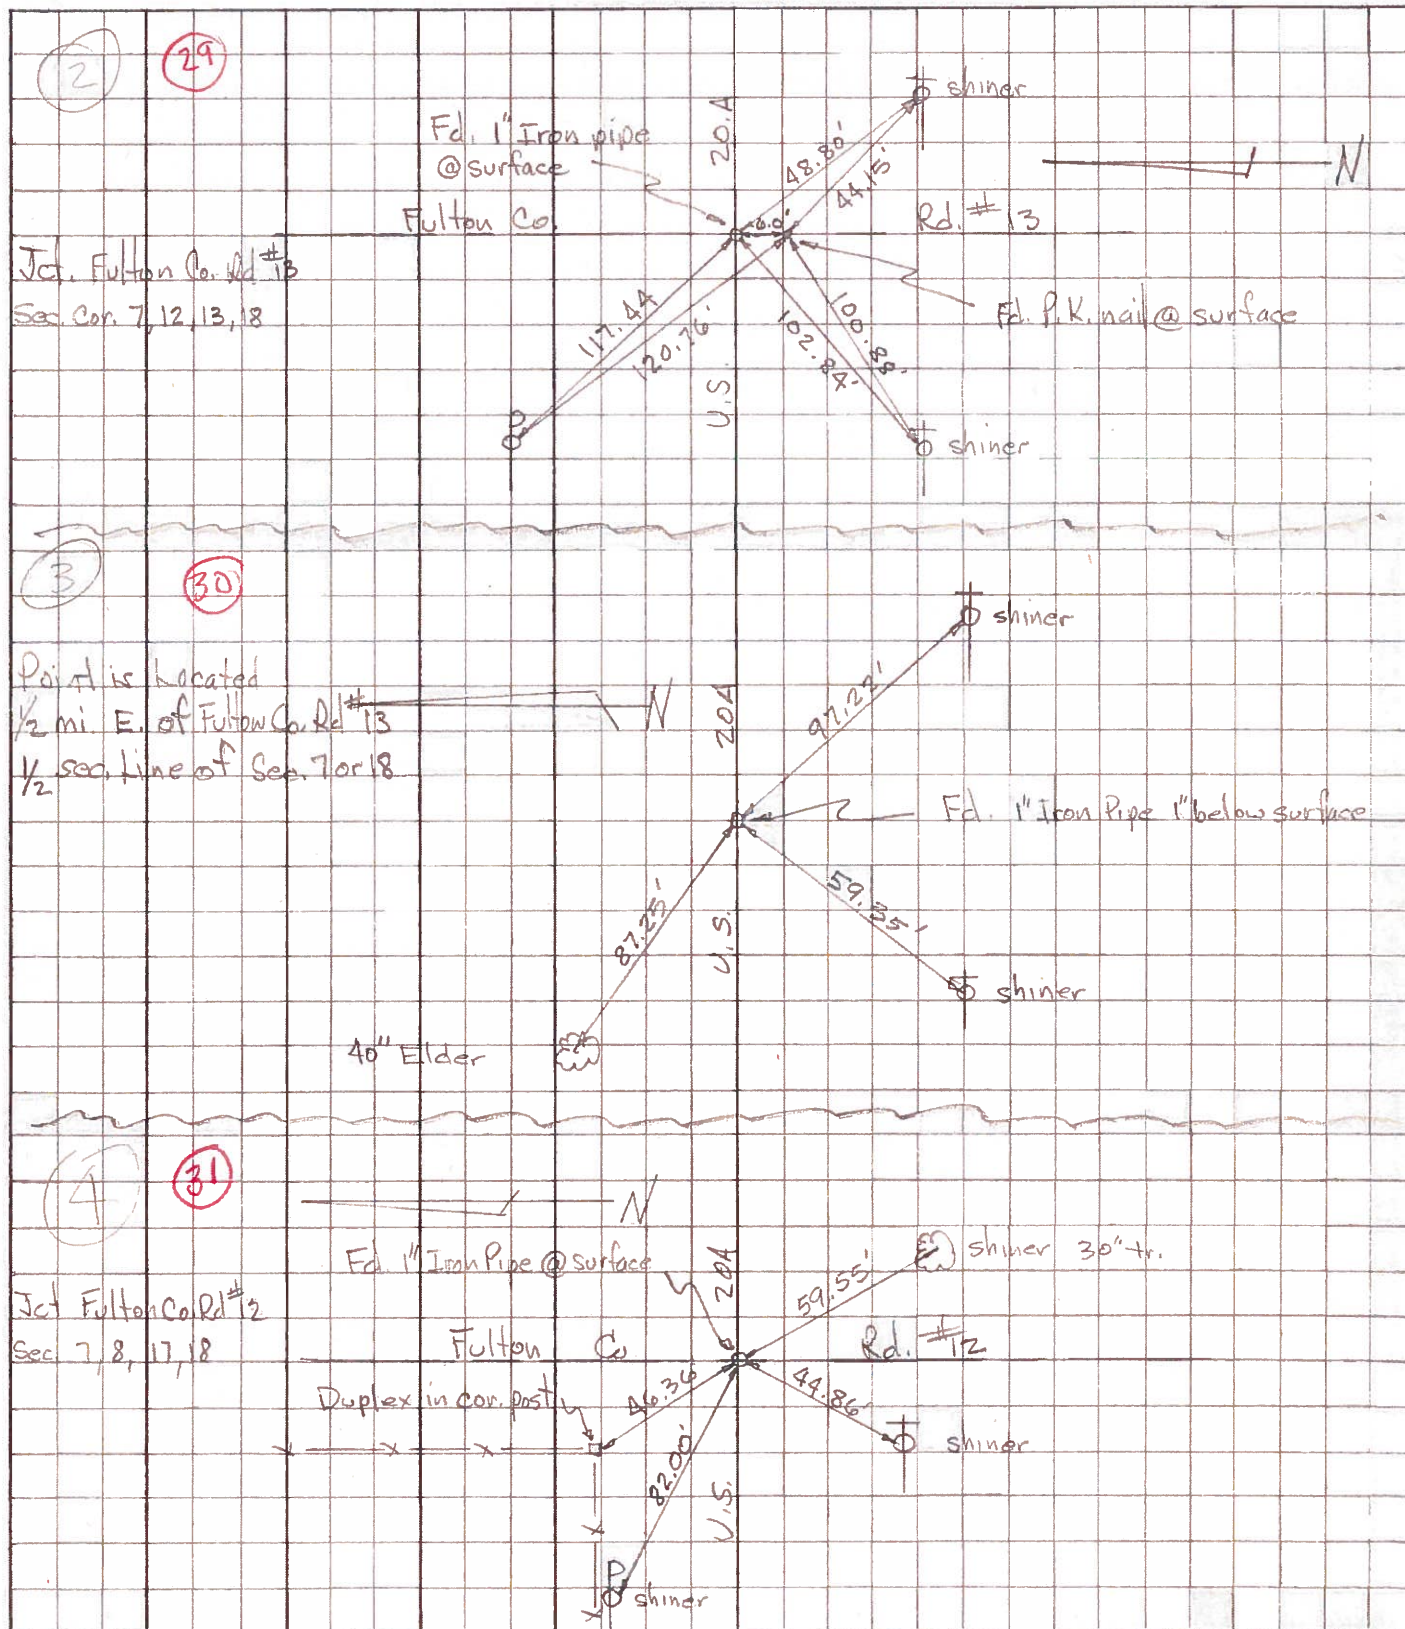

SHEET NO. \_\_\_\_\_

| PERSONNEL | TITLE | PERSONNEL | TITLE |
|-----------|-------|-----------|-------|
| 1         | 2     | 3         | 4     |
| 5         | 6     | 7         | 8     |
| 9         | 10    | 11        | 12    |
| 13        | 14    | 15        | 16    |
| 17        | 18    | 19        | 20    |
| 21        | 22    | 23        | 24    |
| 25        | 26    | 27        | 28    |
| 29        | 30    | 31        | 32    |
| 33        | 34    | 35        | 36    |
| 37        | 38    | 39        | 40    |
| 41        | 42    | 43        | 44    |
| 45        | 46    | 47        | 48    |
| 49        | 50    | 51        | 52    |
| 53        | 54    | 55        | 56    |
| 57        | 58    | 59        | 60    |
| 61        | 62    | 63        | 64    |
| 65        | 66    | 67        | 68    |
| 69        | 70    | 71        | 72    |
| 73        | 74    | 75        | 76    |
| 77        | 78    | 79        | 80    |
| 81        | 82    | 83        | 84    |
| 85        | 86    | 87        | 88    |
| 89        | 90    | 91        | 92    |
| 93        | 94    | 95        | 96    |
| 97        | 98    | 99        | 100   |

Red Beach,  
Newcomb  
Knappe  
Eriksen

COUNTY Fulton DATE Jan 1972

S. R. US 20-A WEATHER


SEC. 7 YORK TWP. T-7-N TEMP.

DESCRIPTION ALIGNMENT & CONTROLS JOB NO.                     

LEFT

## CENTER LINE

RIGHT

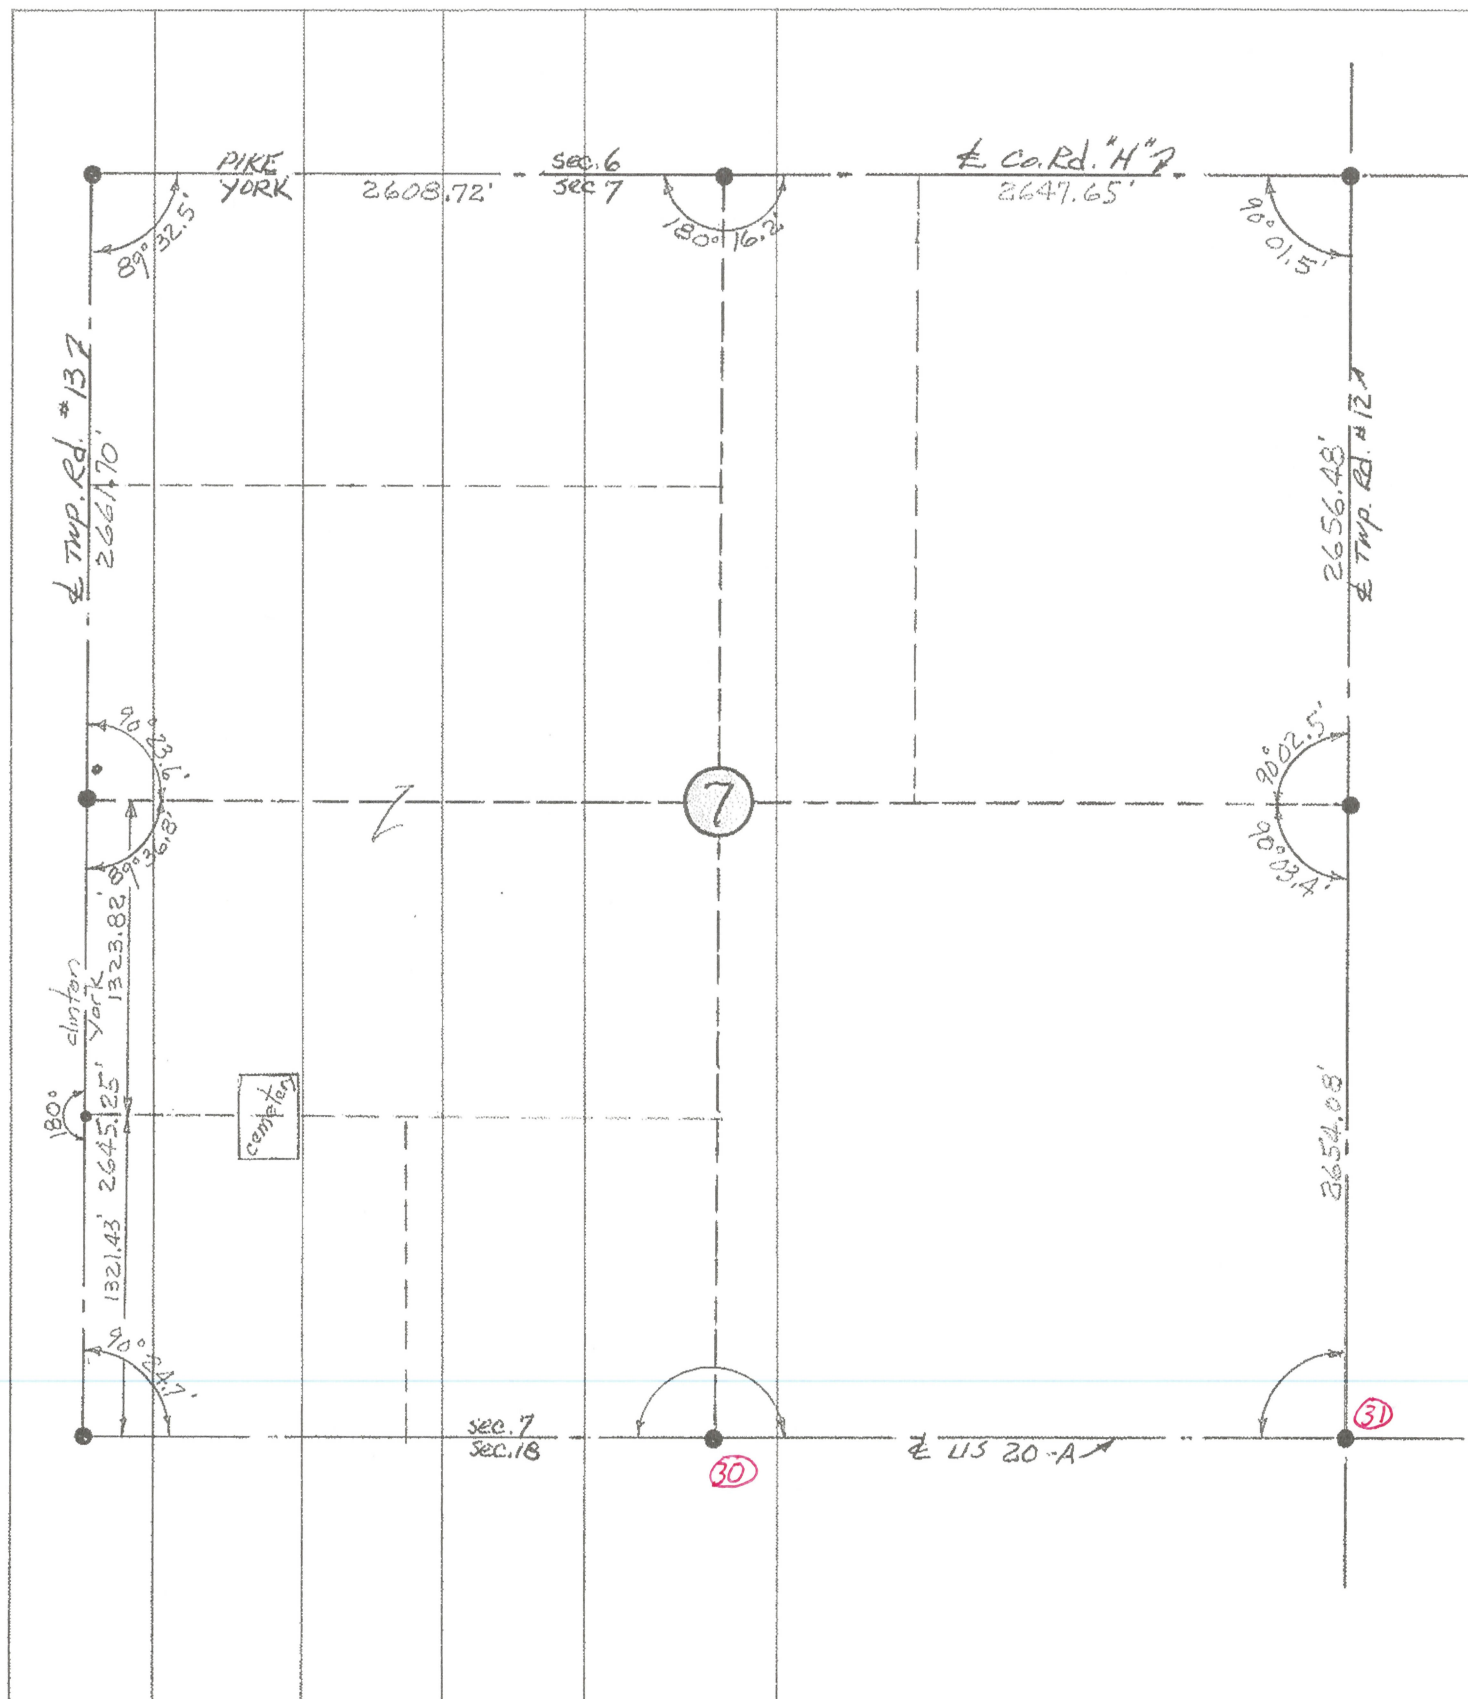



PERSONNEL TITLE PERSONNEL TITLE

Red Beach  
Newcomb  
KnappeCOUNTY FULTONDATE Dec. 1971S. R. US 20-A


WEATHER \_\_\_\_\_

SEC. 8 YORK TWP T-7-N TEMP. \_\_\_\_\_

DESCRIPTION

ALIGNMENT & CONTROLS

JOB NO. \_\_\_\_\_

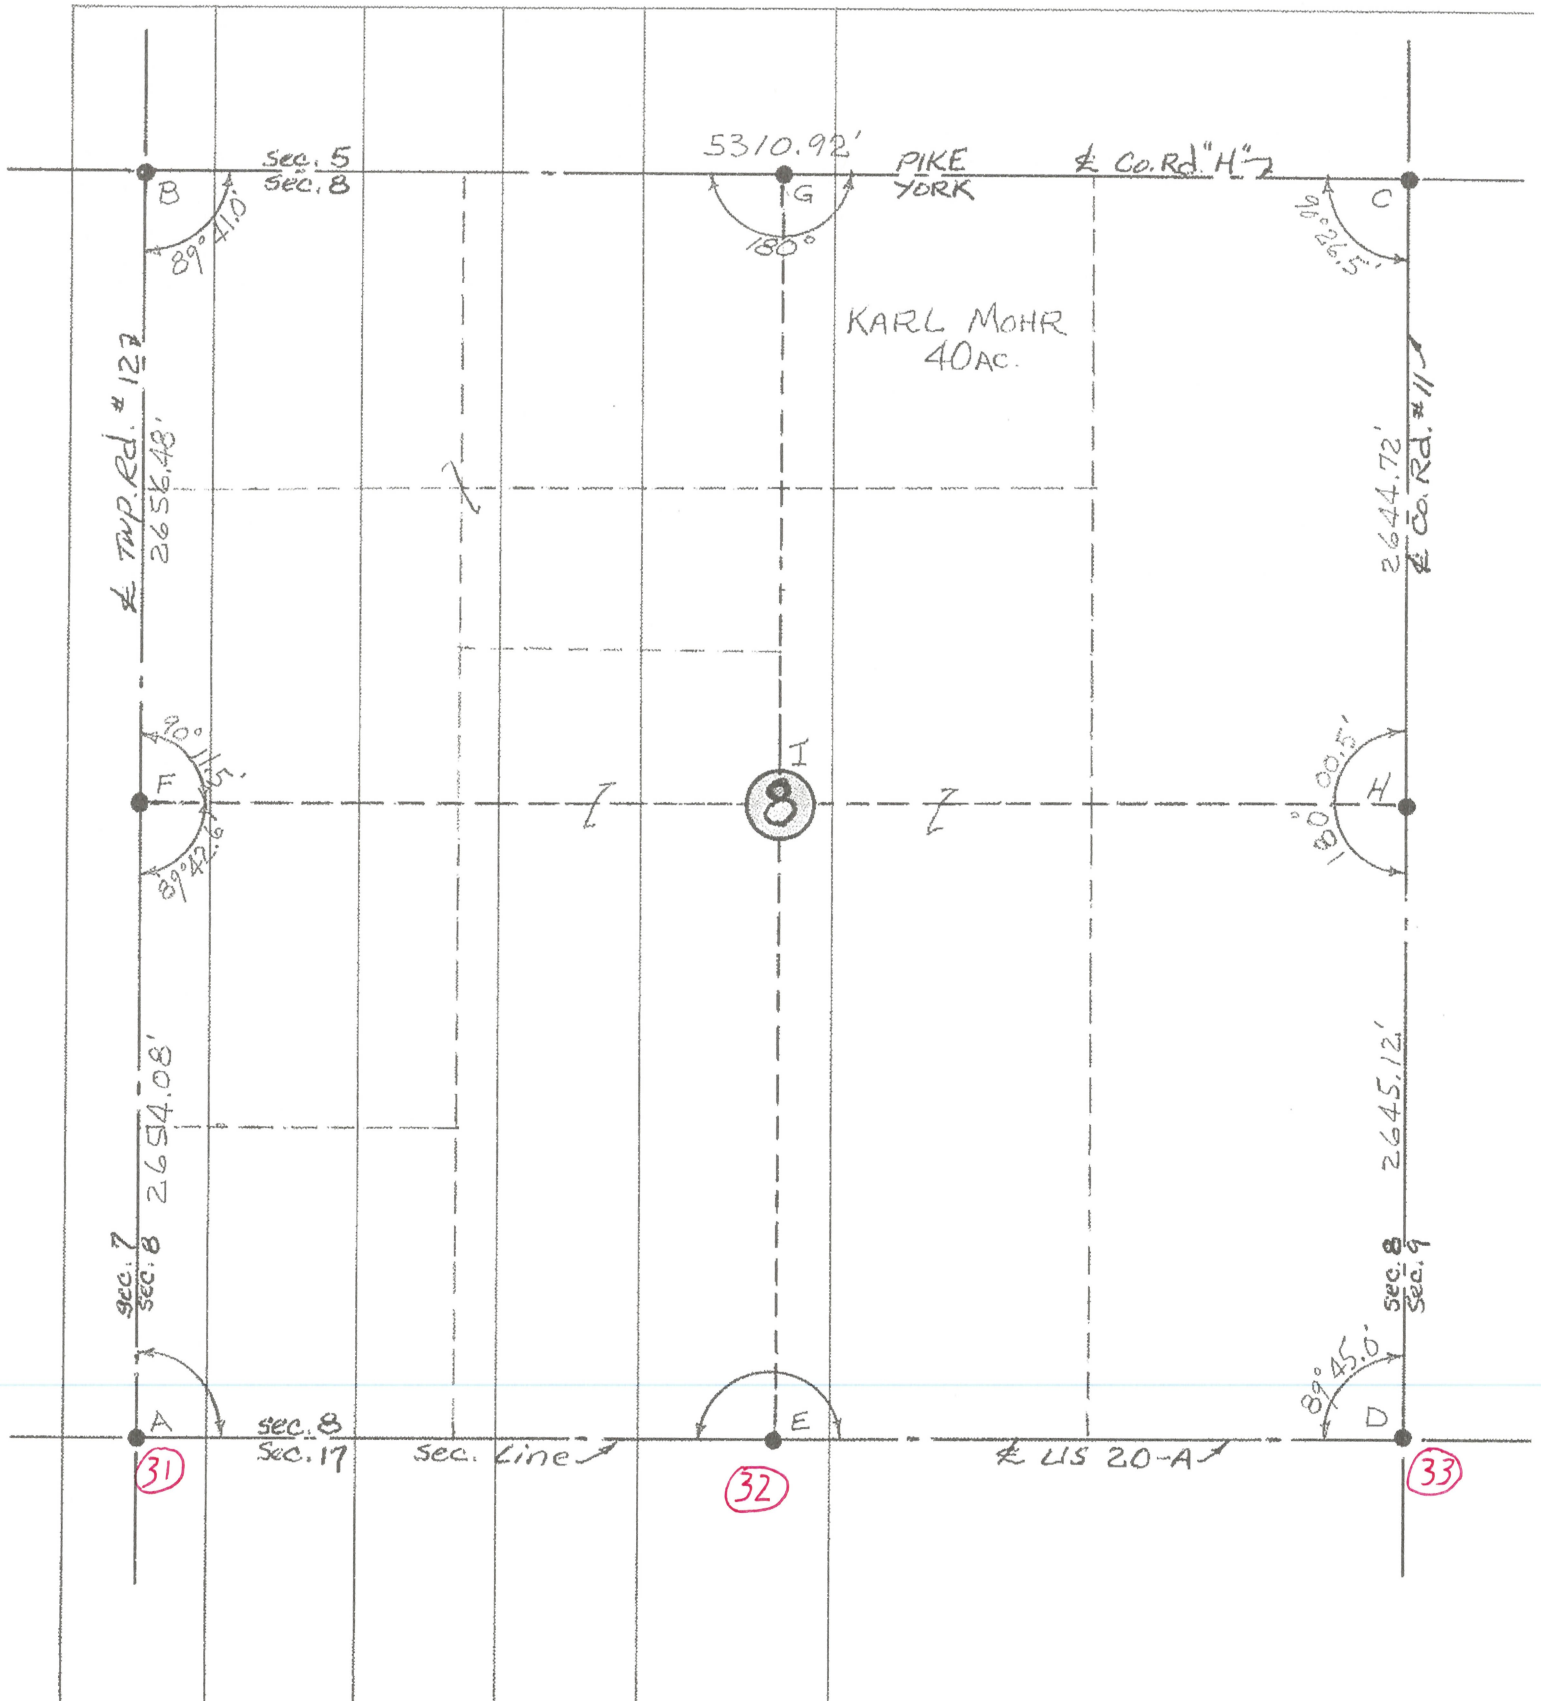



PERSONNEL TITLE PERSONNEL TITLE

Red Beach  
Newcomb  
Knappe  
EriksenCOUNTY FultonDATE Jan 1972S. R. US 20-A

WEATHER


SEC. YORK TWP

TEMP.

DESCRIPTION

## CONTROL POINTS


JOB NO.

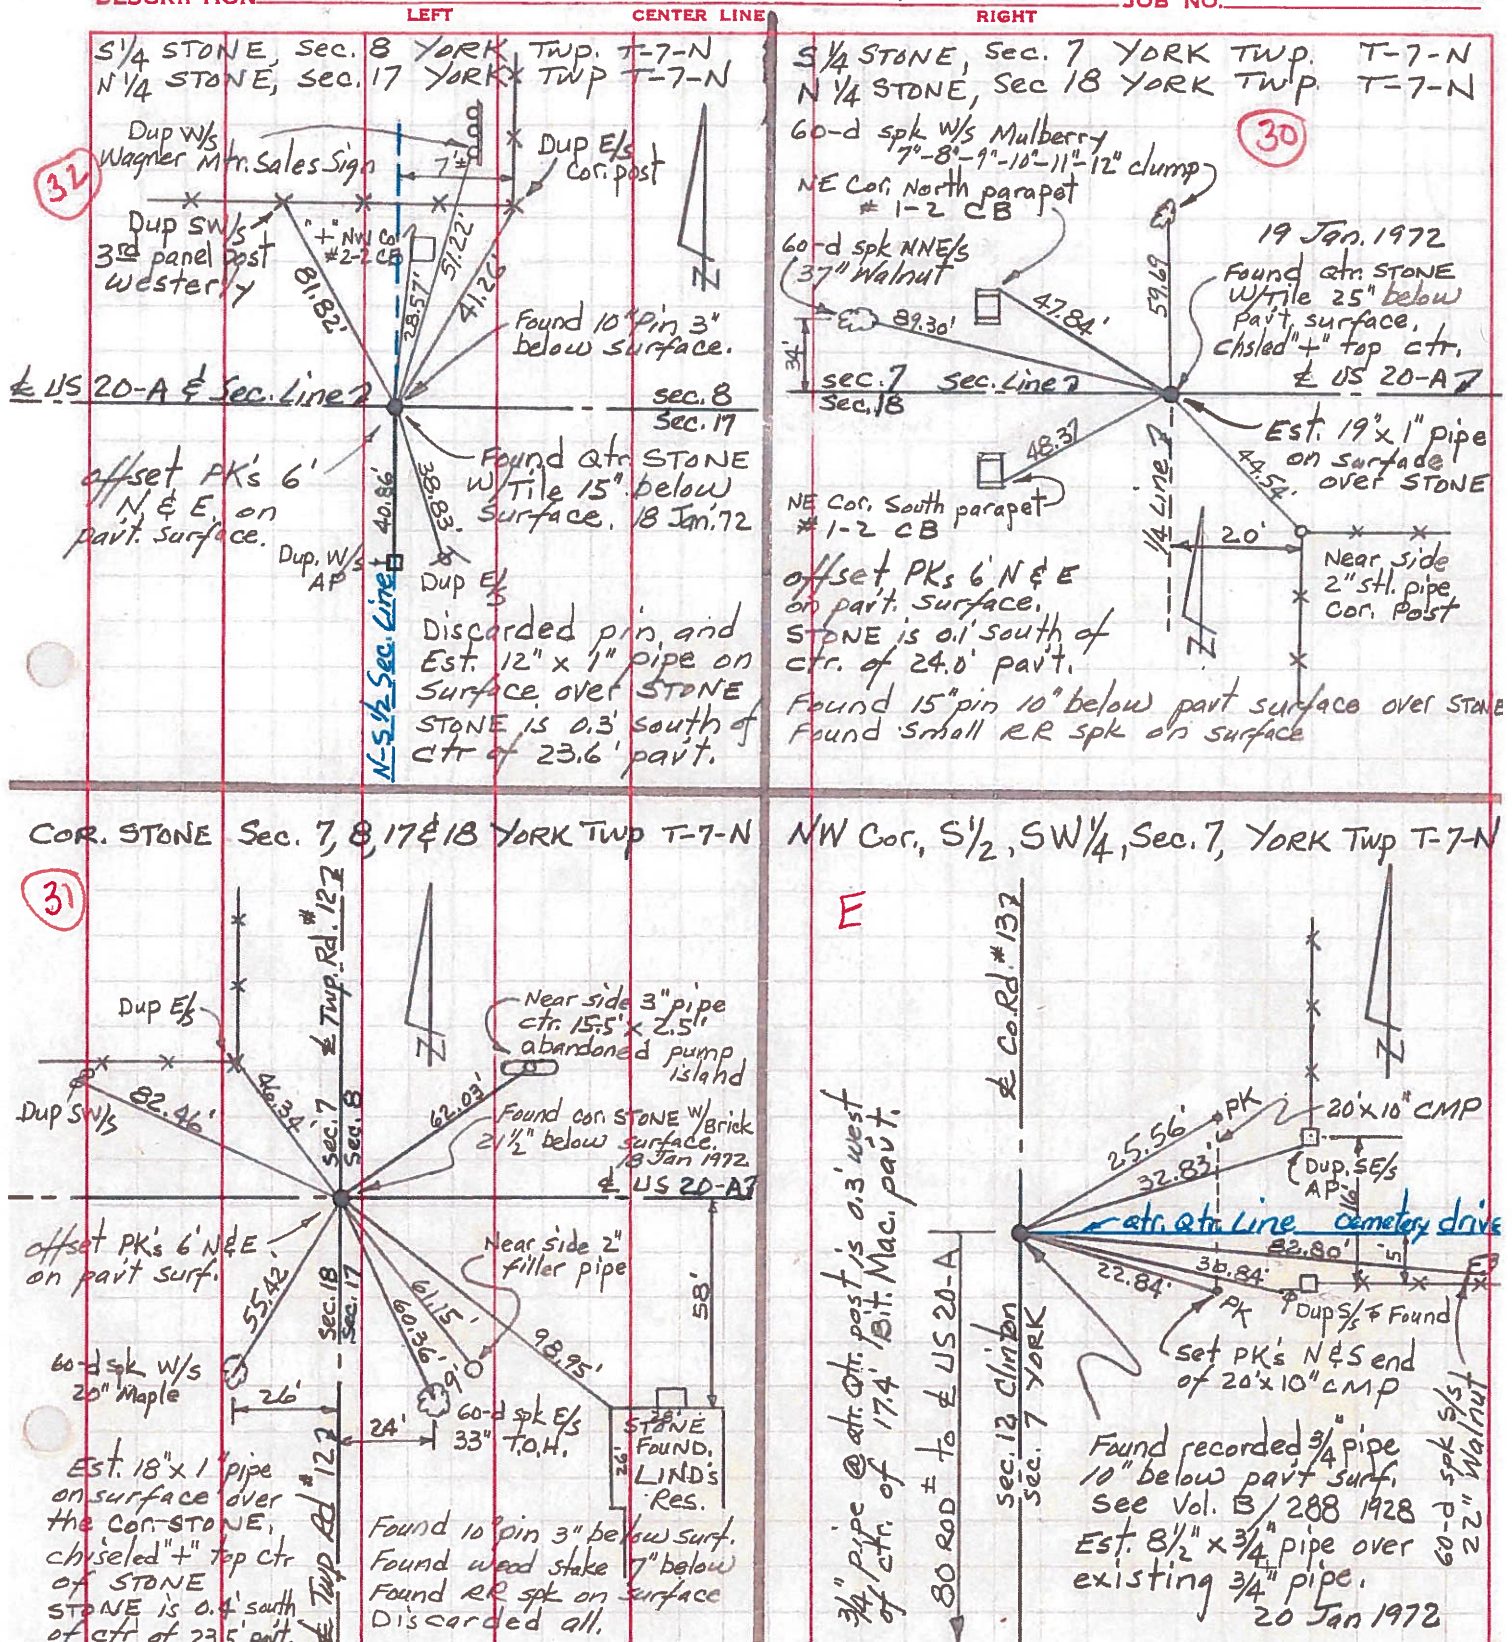



PERSONNEL TITLE PERSONNEL TITLE COUNTY FULTON DATE Jan 1972  
Red Beach \_\_\_\_\_  
Newcomb \_\_\_\_\_  
Knape \_\_\_\_\_  
Eriksen \_\_\_\_\_  
 S. R. US 20-A WEATHER \_\_\_\_\_  
 SEC. YORK TWP. T-7-N TEMP. \_\_\_\_\_

DESCRIPTION CONTROL POINTS JOB NO. \_\_\_\_\_

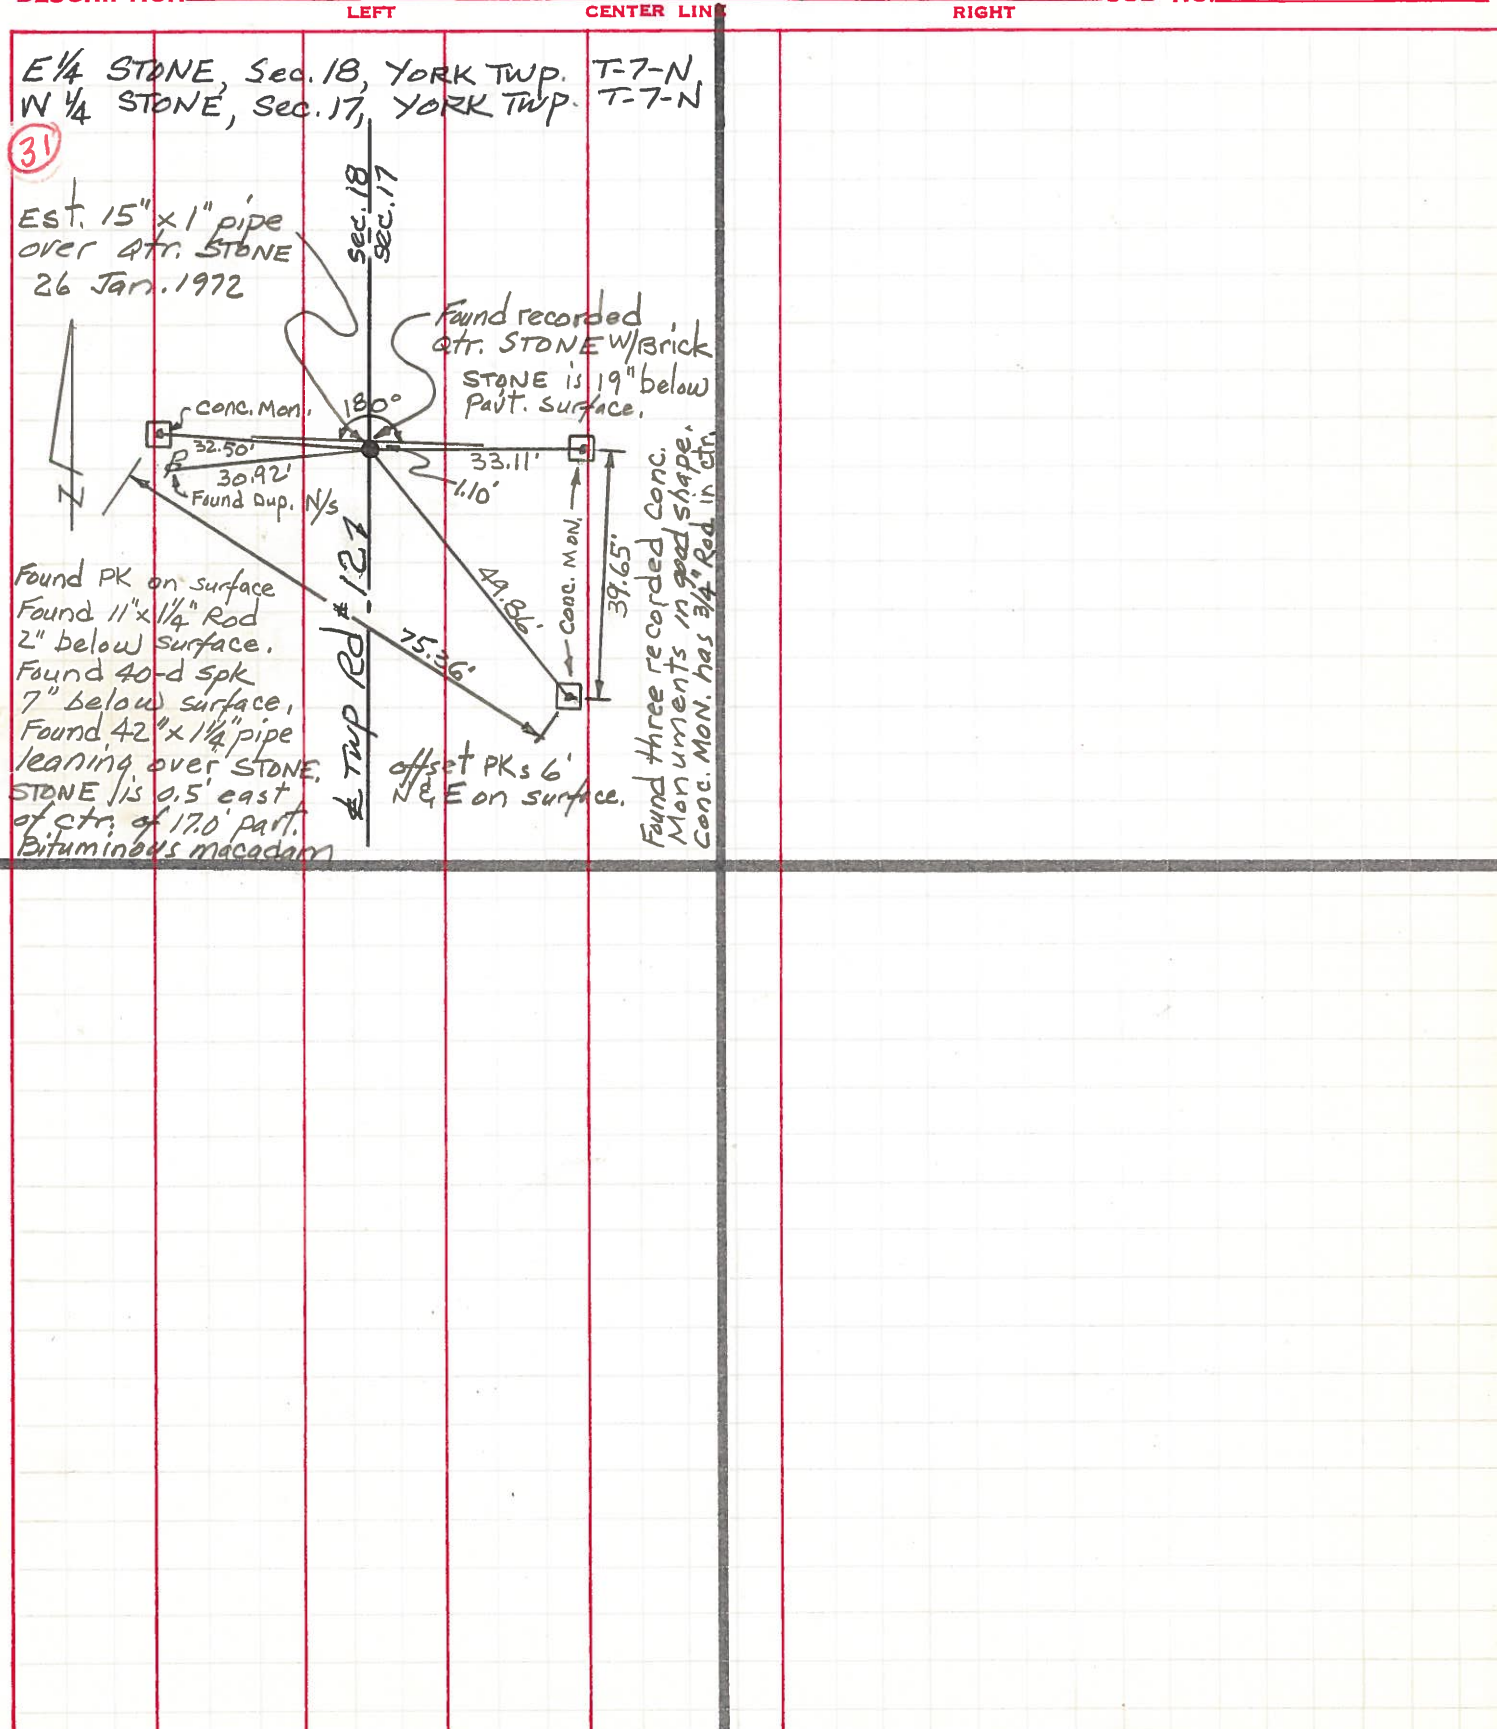

PERSONNEL TITLE PERSONNEL TITLE

COUNTY FultonDATE 3-28-559-12-60S. R. #2 & 20 Aft.

WEATHER

SEC. M, A, O,

TEMP.

DESCRIPTION

LEFT

CENTER LINE

RIGHT

JOB NO.

P.I. Sta. 53+62.34  
S.W. cor. sec. 7  
Fd. iron pin 12" below  
surface of pav't.  
(Not plum bed.)

#72 ✓

S.E. to shiner in T.P. 45.35'  
S.W. to shiner in A. Post 46.90'  
S.W. to shiner in T.P. 102.25'  
N.W. to shiner in 24" Elm 171.45'  
N.E. to shiner in 20" Hickory 51.05'

Sta. 79+78.58  
S. 1/4 sec. 7  
Fd. iron pin

#73 ✓

N.W. to shiner in 30" walnut 87.25'  
S.W. to shiner in T.P. 59.60  
S.E. to iron A.P. 1' above gnd. 44.30'  
N.E. to shi. in 24" Spruce N.E. 97.15'

Sta. 106+08.39  
S.W. cor. sec. 8  
Iron pin

#74 ✓

N.E. to iron post in pump island 62.09'  
N.W. to shiner in P.P. 81.90'  
S.W. to shiner in 12" maple 54.83  
S.E. to shiner in 30" catalpa 59.70'

Sta. 132+68.17  
S. 1/4 sec. 8  
Fd. iron pin

#75

N.N.E. to steel sign post stake 40.47  
N.N.E. to shiner in P.P. 40.94 40.88  
N.W. to shiner in 3rd fence post 54.35  
S. to shiner in T.P. 38.25

Sta. 159+27.37  
S.W. cor. sec. 9  
Fd. iron pin

#76

S.W. to shiner in T.P. 44.10  
N.E. to shiner in P.P. 45.67  
S.E. to near side of Gov. B.M. 56.97  
N.W. to near side of iron A.P. 44.80'