

O.D.O.T. DISTRICT 2 SURVEY OFFICE (USE ONLY)

PERSONNEL

REFERENCE NO. 32

SHEET 60 OF 63

NOTES RHOADES

DATE 6/11/19

ROUTE US 20A

H.C. O'DONNELL

WEATHER SUNNY

COUNTY FULTON

R.C. MILLER

TEMP. 62°

TOWNSHIP YORK

DWG BY BALBAUGH

PID 101232

SECTION 17

T 7 N R 7 E

TYPE MONUMENT MAG/WASHER

ON SURFACE - ~~BELOW~~ ON

OFFSET CL PAVEMENT ON ~~LT~~ : ~~RT~~

13.1' TO RT EDGE PAVEMENT


STATION: 822+36.27

HORZ.DATUM: NAD83 (2011)


GEOID: 2012A

GRID: NORTHING: 698594.692

EASTING: 1534555.360

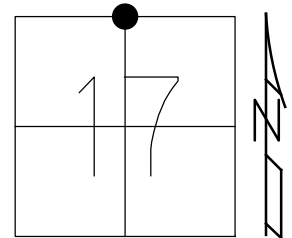

RECORD:
FD R.R.SPIKE
9/16/04, MC
SET MAG/WASHER
10/13/04, DCH
FD MAG/WASHER
12/5/17, JFO
REF32
12/21/17, JFO
SET MAG/WASHER
10/25/19, JFO

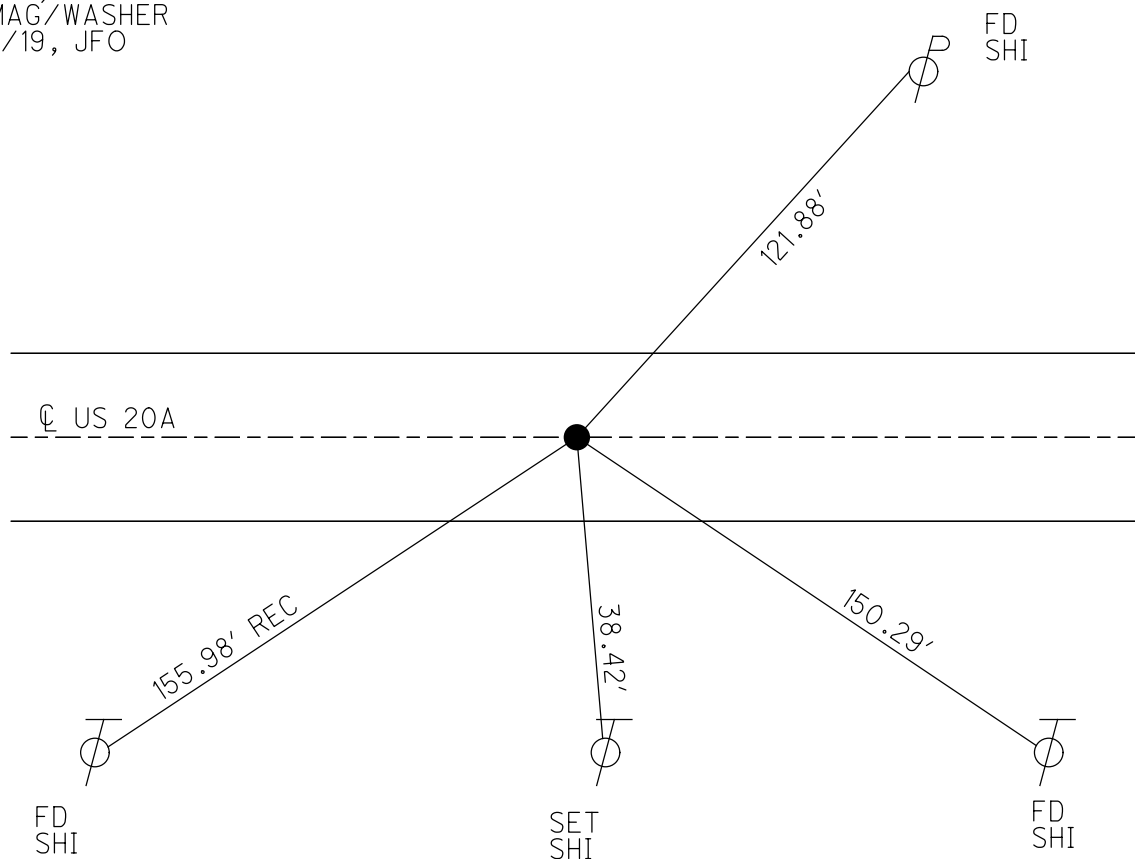

O.D.O.T. DISTRICT 2 SURVEY OFFICE (USE ONLY)

PERSONNEL

REFERENCE NO. 32

SHEET 58 OF 61

NOTES

HOMAN

DATE

9/16/04

ROUTE

US 20A

H.C.

CANTERBURY

WEATHER

CLOUDY

COUNTY

FULTON

R.C.

BARNHISEL

TEMP.

70°

TOWNSHIP

YORK

SECTION

17

T 7 N R 7 E

TYPE MONUMENT R.R.SPIKE

ON SURFACE - ~~BELOW~~ ON


LEFT - ℄ PAV'T - RIGHT ON

13.1' TO RT EDGE PAVEMENT

S.L.M. 822+42


GRID: NORTHING:

EASTING:

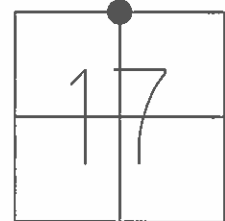

SET MAG/WASHER
10-13-04, DCH

SET N&S
NEAR FACE
4"X6"
WOOD POST FOR
PRIVATE SIGN

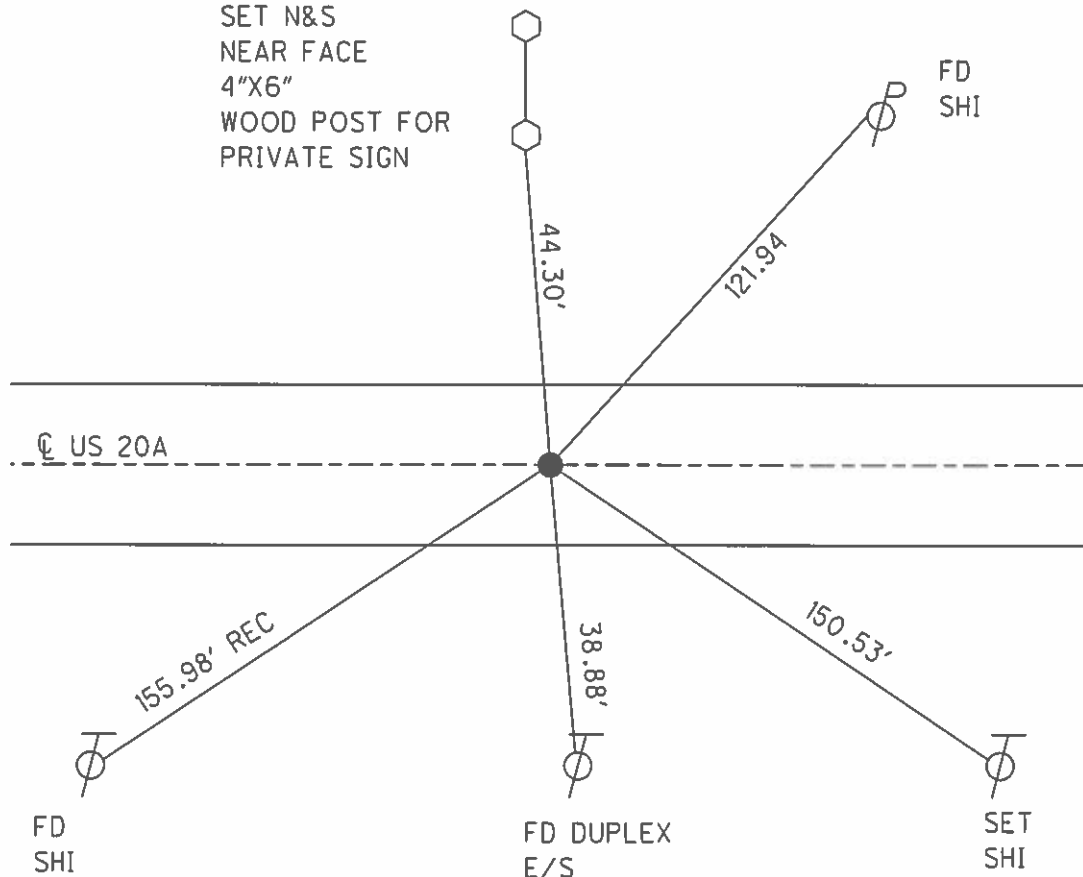

O.D.O.T. DISTRICT 2 SURVEY OFFICE

PERSONNEL

REFERENCE NO. 32

SHEET 9 OF 24

NOTES 1. Stone

H.C. D. Curtis

R.C. J. Householder

DATE 16 Sept. 86

WEATHER Cool

TEMP. 58°

ROUTE US #20-A

COUNTY Fulton

TOWNSHIP York

SECTION 17

T R


TYPE MONUMENT 1" I. pipe

ON SURFACE - BELOW 2" deep


LEFT- & PAV'T. - RIGHT

TO EDGE PAVEMENT

S.L.M. 822 + 84

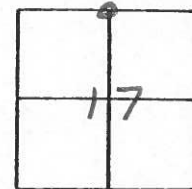

SET SMALL R.R. SPK. TO SURFACE
4-29-88

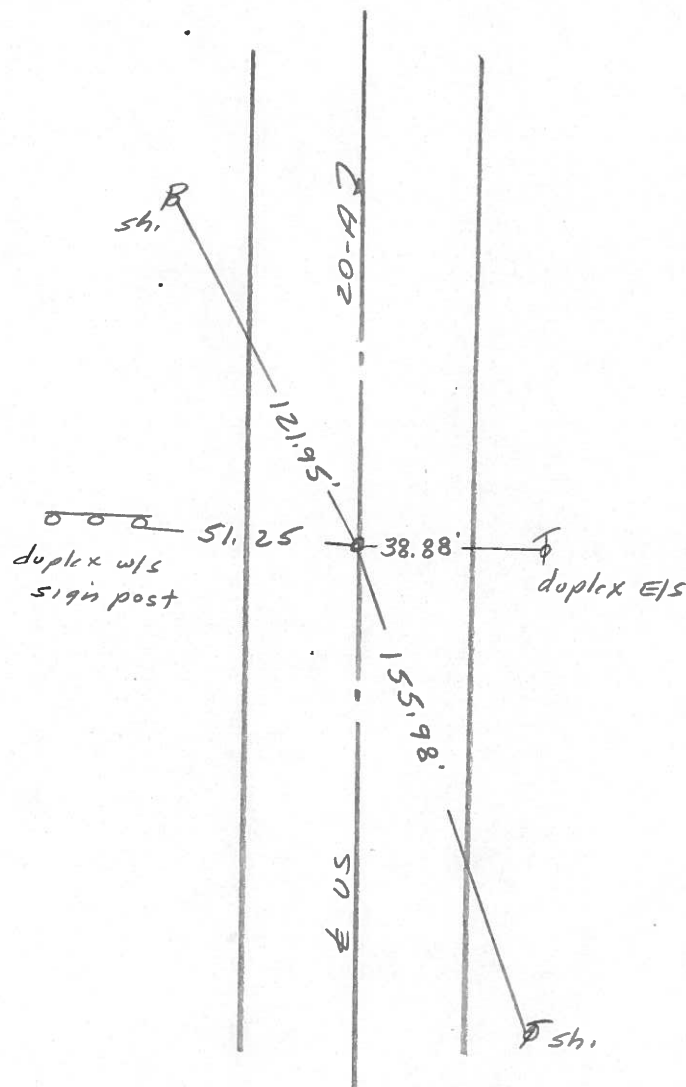

O.D.O.T. DISTRICT 2 SURVEY OFFICE

SHEET _____ OF _____

County Fulton S.R. 2 US 20A

Date 6-5-1980

Township York

Weather Clear

Section N $\frac{1}{4}$ Sec. 17


Temp. +80°

T7N, R7E

Personnel Smith

Bowers


Mead

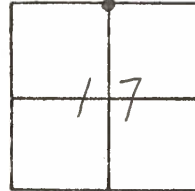

(32)


Fd 1" Iron Pipe
@ Surface

SET P.K. & SH.
BOWERS

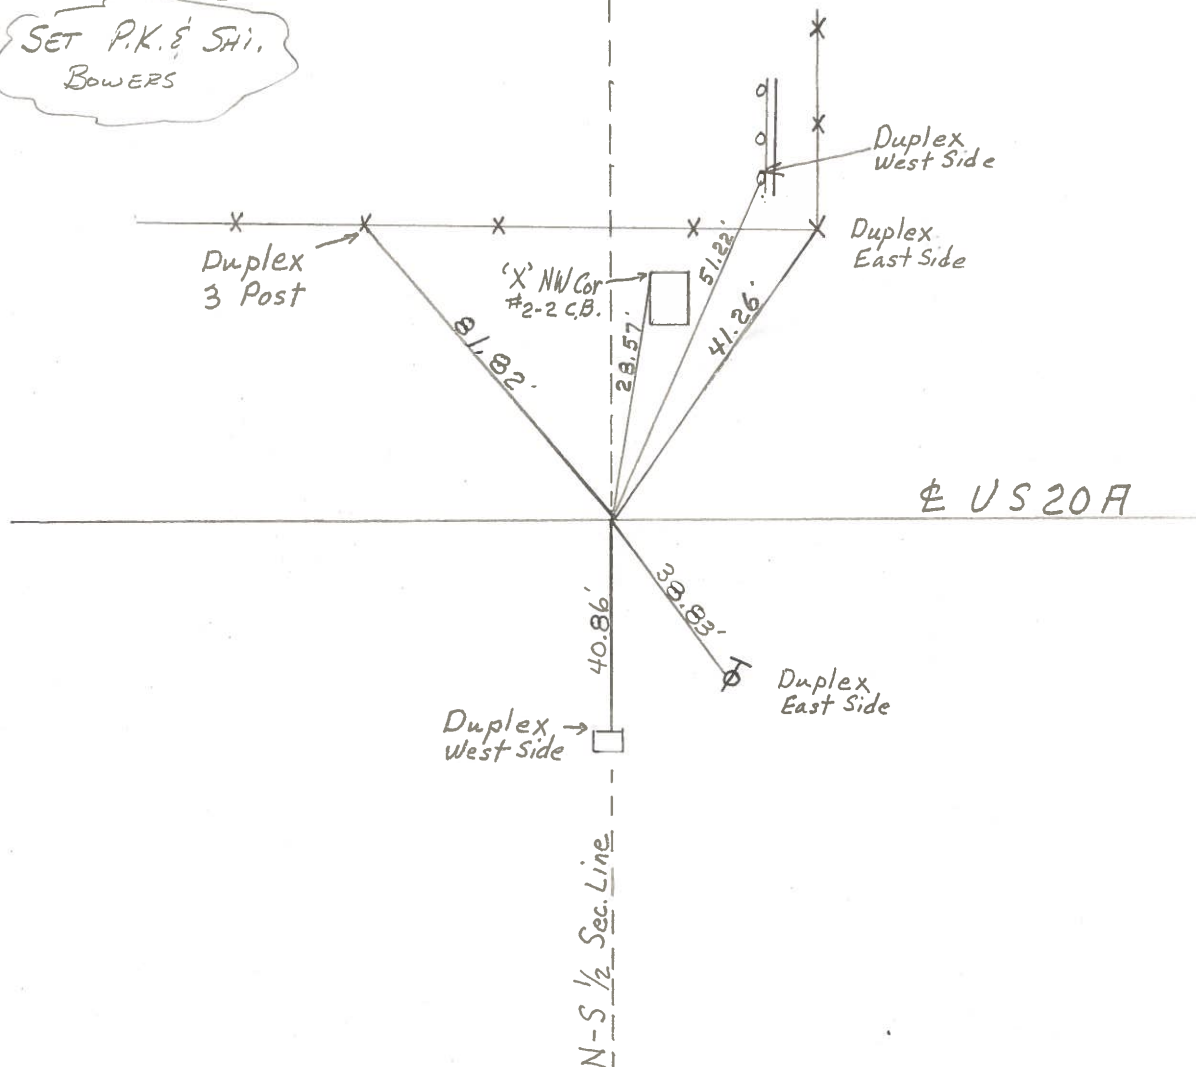

PERSONNEL	TITLE	PERSONNEL	TITLE	COUNTY	DATE	WEATHER	TEMP.
Tomsic				Fulton	April 18, 1973		
Neuser				U.S. 20A			
Granata							
Vanyo							

DESCRIPTION	LEFT	CENTER LINE	RIGHT	JOB NO.
-------------	------	-------------	-------	---------

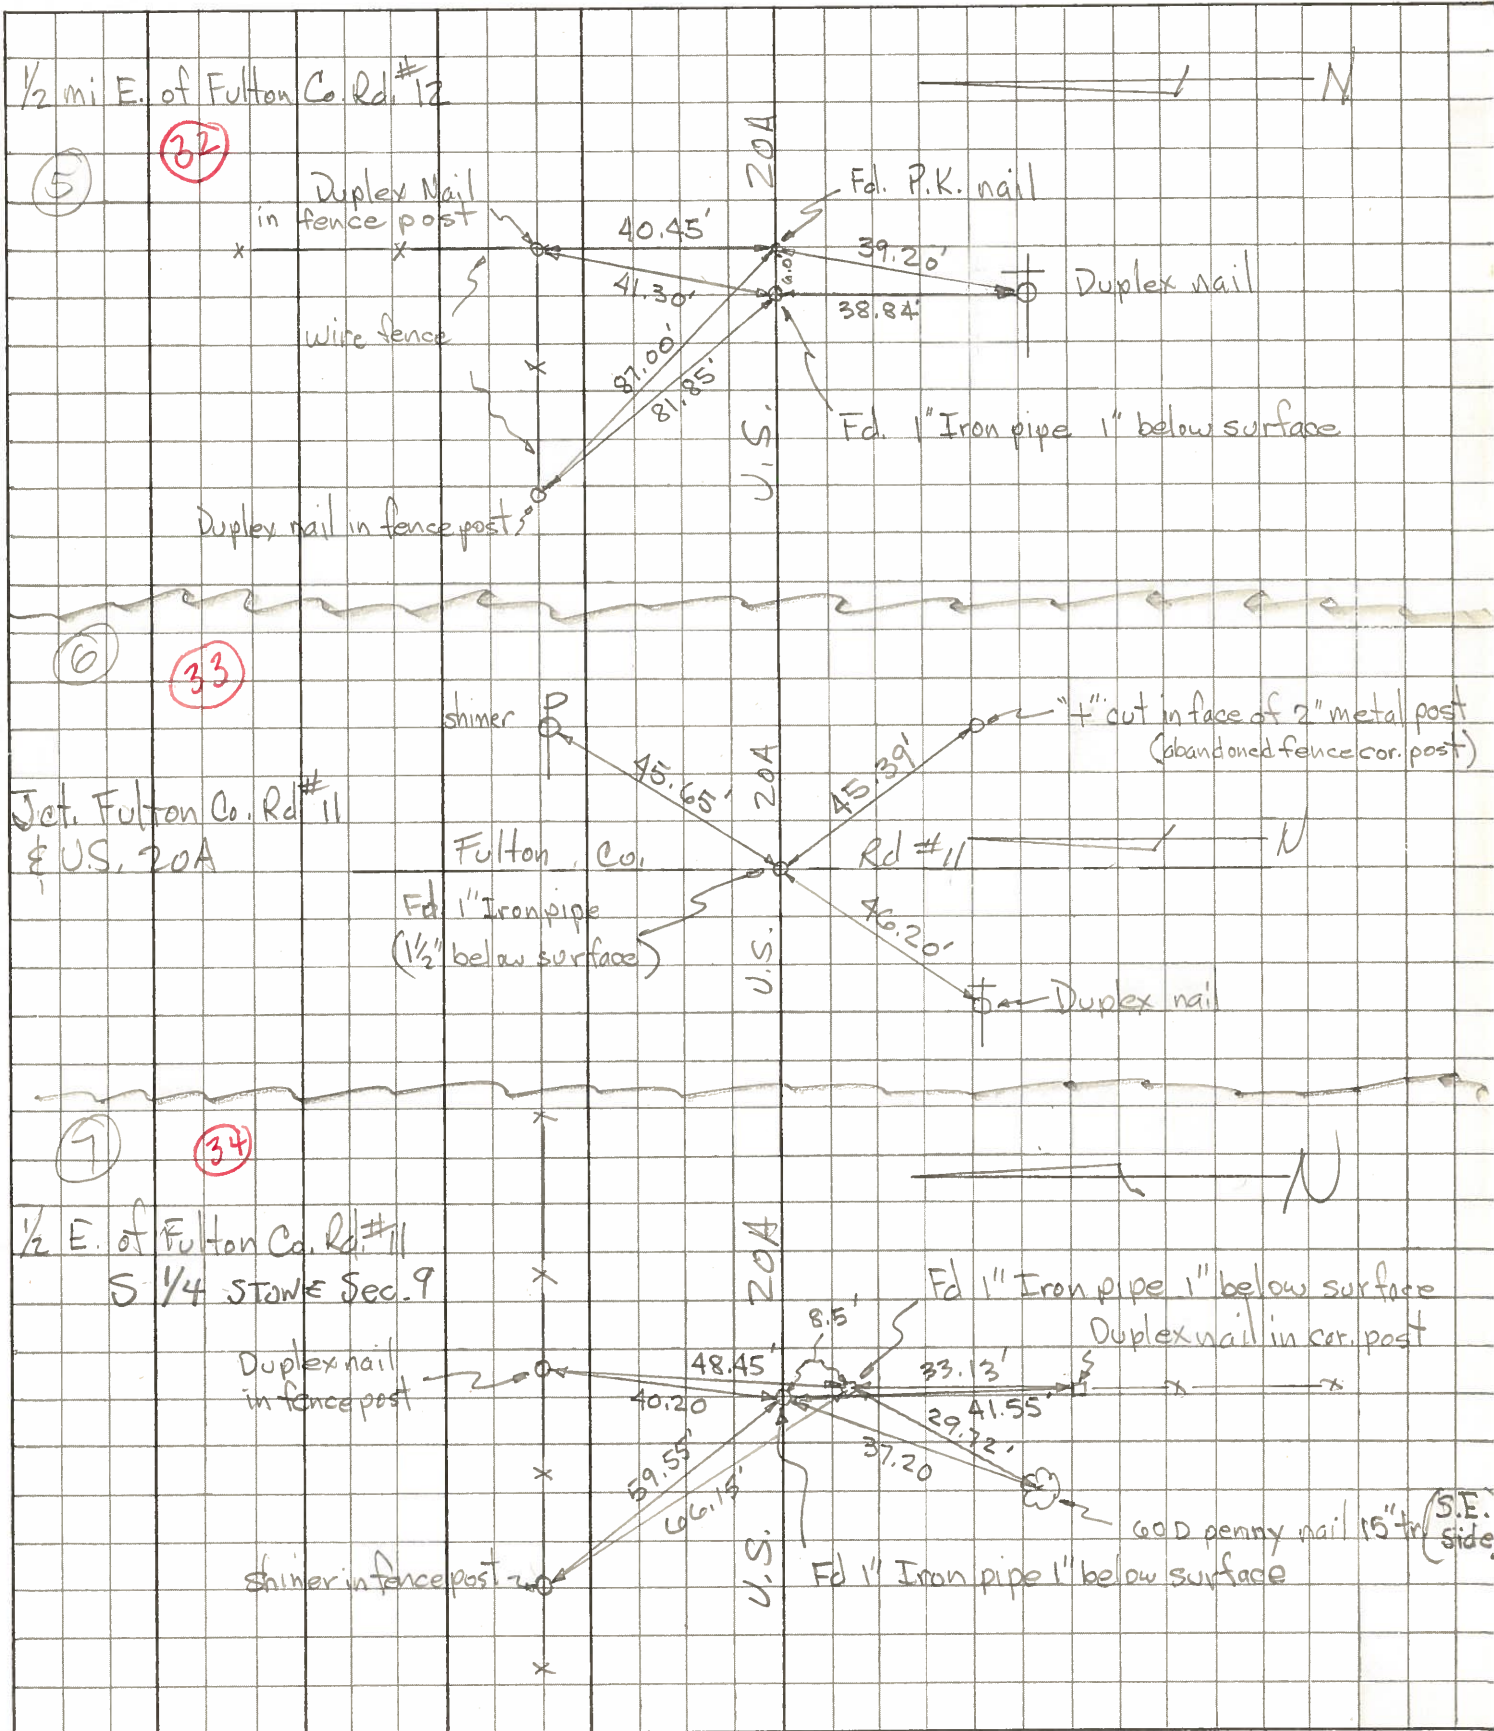

PERSONNEL TITLE PERSONNEL TITLE

Red Beach
Newcomb
KnappeCOUNTY FULTONDATE Dec. 1971S. R. US 20-A


WEATHER _____

SEC. 8 YORK TWP T-7-N TEMP. _____

DESCRIPTION

ALIGNMENT & CONTROLS

JOB NO. _____

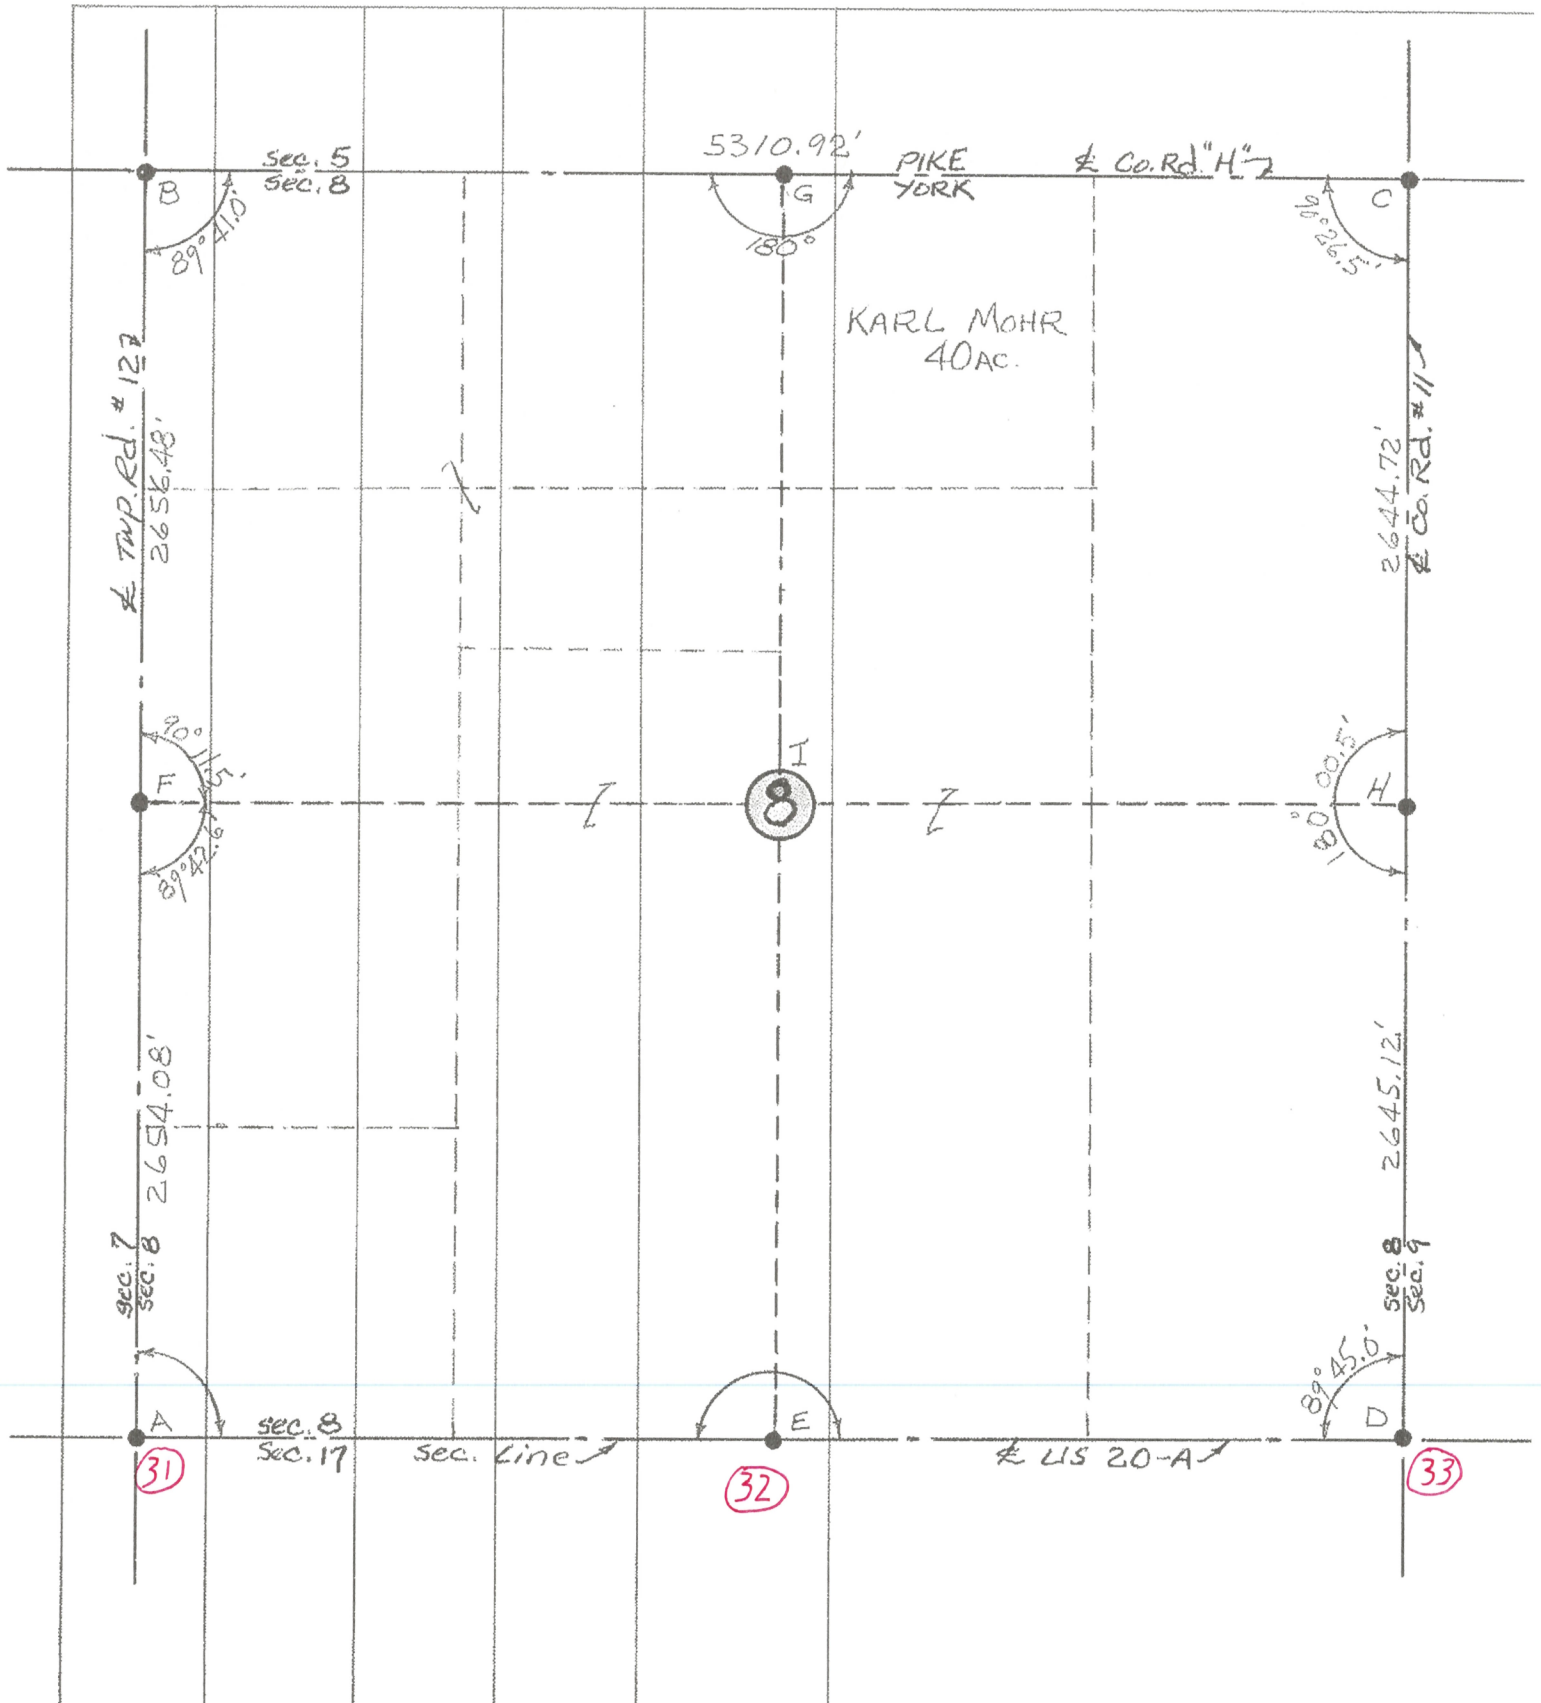


PERSONNEL TITLE PERSONNEL TITLE
 Red Beach
 Newcomb
 Knappe
 Eriksen

COUNTY Fulton DATE Jan 1972
 S. R. US 20-A WEATHER
 SEC. YORK TWP TEMP.

DESCRIPTION

CONTROL POINTS

JOB NO.

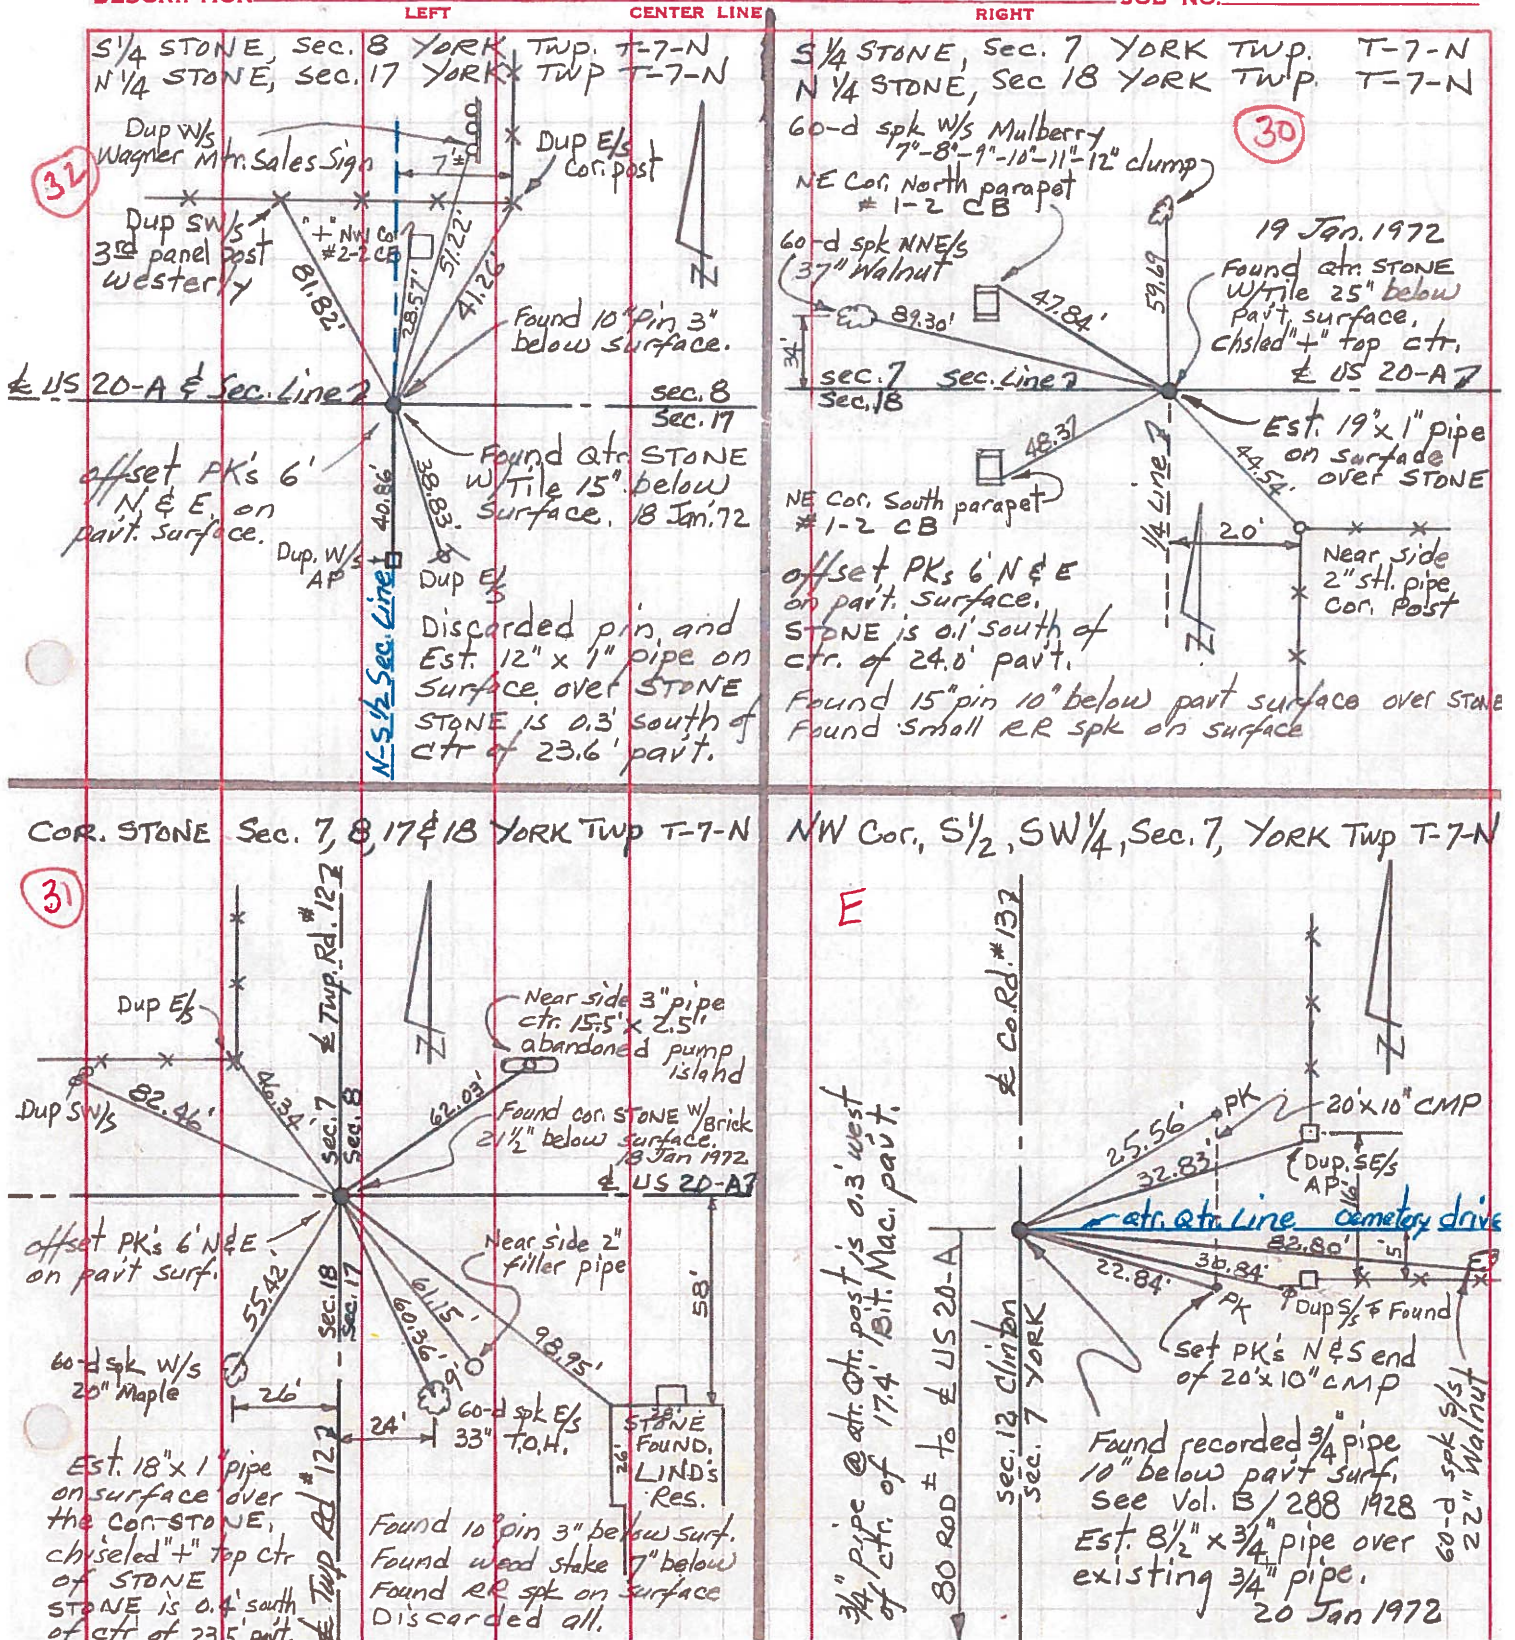

PERSONNEL TITLE PERSONNEL TITLE

COUNTY Fulton DATE 3-28-55S. R. #2 & 20 Aft. WEATHER 9-12-60SEC. M, A, O, TEMP.

DESCRIPTION LEFT CENTER LINE RIGHT JOB NO.

P.I. Sta. 53+62.34			S.E. to shiner in T.P.	45.35'
S.W. cor. sec. 7			S.W. to shiner in A. Post	46.90'
Fd. iron pin 12" below surface of pav't. (Not plum bed.)	✓		S.W. to shiner in T.P.	102.25'
#72 ✓			N.W. to shiner in 24" Elm	171.45'
			N.E. to shiner in 20" Hickory	51.05'
Sta. 79+78.58			N.W. to shiner in 30" Walnut	87.25'
S. 1/4 sec. 7	✓		S.W. to shiner in T.P.	59.60'
Fd. iron pin			S.E. to iron A.P. 1' above gnd.	44.30'
#73 ✓			N.E. to shi. in 24" Spruce N.E.	97.15'
Sta. 106+08.39			N.E. to iron post in pump island	62.09'
S.W. cor. sec. 8	✓		N.W. to shiner in P.P.	81.90'
Iron pin			S.W. to shiner in 12" maple	54.83'
#74 ✓			S.E. to shiner in 30" Catalpa	59.70'
Sta. 132+68.17			N.N.E. to steel sign post stake	40.47'
S. 1/4 sec. 8	✓		N.N.E. to shiner in P.P.	40.94 40.88'
Fd. iron pin			N.W. to shiner in 3rd fence post	54.35' 54.24'
#75			S. to shiner in T.P.	38.25'
Sta. 159+27.37			S.W. to shiner in T.P.	44.10' 44.20'
S.W. cor. sec. 9	✓		N.E. to shiner in P.P.	45.67'
Fd. iron pin			S.E. to near side of Gov. B.M.	57.13' 56.97'
#76			N.W. to near side of iron A.P.	44.80'