

O.D.O.T. DISTRICT 2 SURVEY OFFICE (USE ONLY)

PERSONNEL

REFERENCE NO. 33

SHEET 61 OF 63

NOTES RHOADES

DATE 6/11/19

ROUTE US 20A

H.C. O'DONNELL

WEATHER SUNNY

COUNTY FULTON

R.C. MILLER

TEMP. 62°

TOWNSHIP YORK

DWG BY BALBAUGH

PID 101232

SECTION 17

T 7 N R 7 E

TYPE MONUMENT MAG/WASHER

ON SURFACE - ~~BELOW~~ ON

OFFSET CL PAVEMENT 0.7' ~~LT~~ : RT

TO EDGE PAVEMENT


STATION: 848+95.23

HORZ.DATUM: NAD83 (2011)


GEOID: 2012A

GRID: NORTHING: 698536.250

EASTING: 1537213.675

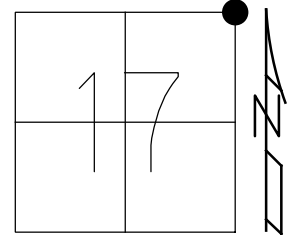

RECORD:
FD P.K.NAIL
9/16/04, MC
SET MAG/WASHER
10/13/04, DCH
FD MAG/WASHER
12/5/17, JFO
REF33
12/21/17, JFO
SET MAG/WASHER
10/25/19, JFO

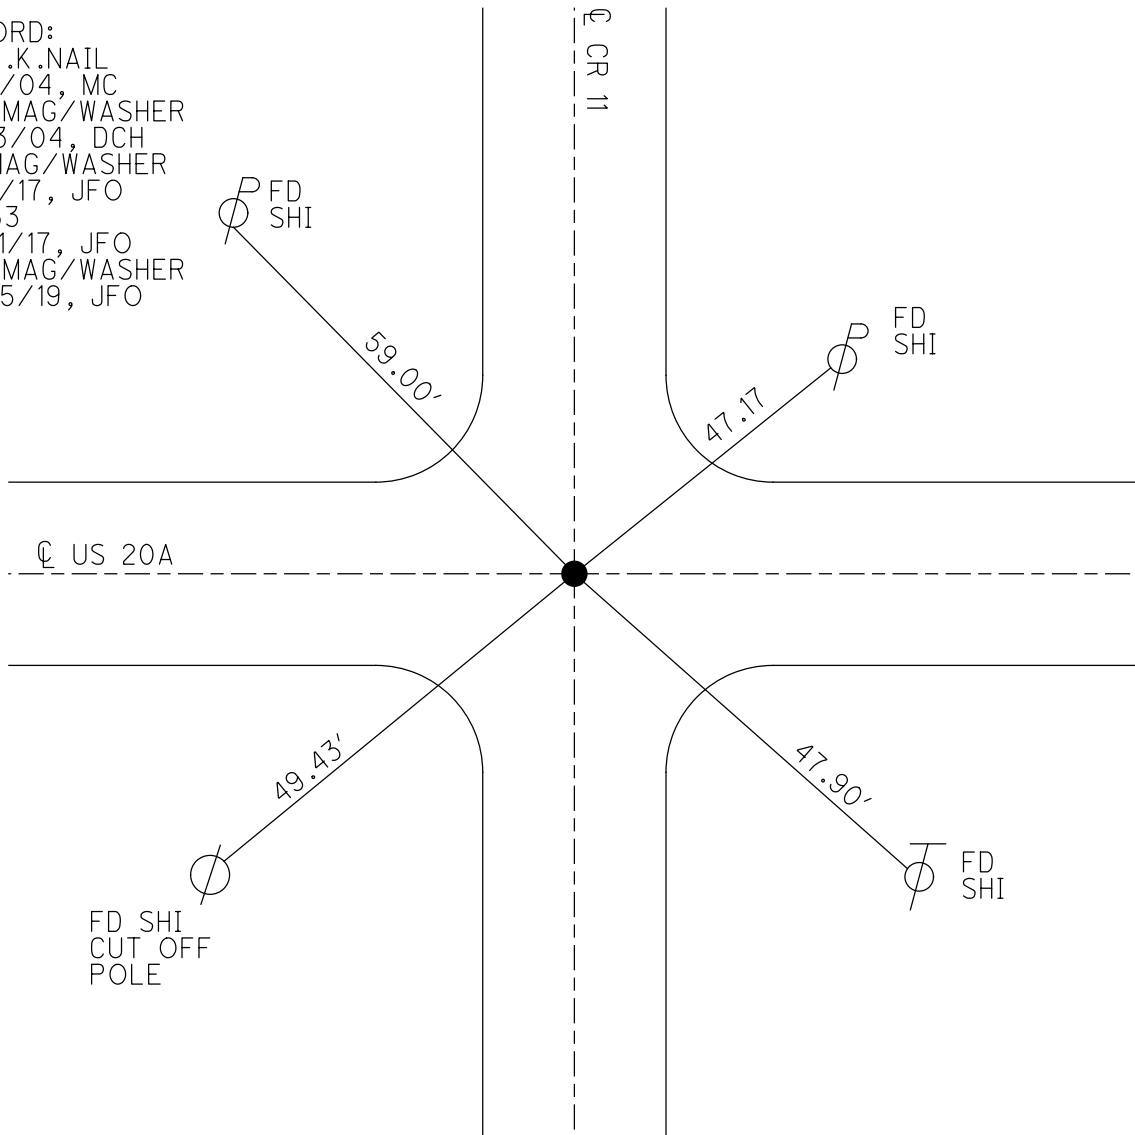

O.D.O.T. DISTRICT 2 SURVEY OFFICE (USE ONLY)

PERSONNEL

REFERENCE NO. 33

SHEET 59 OF 61

NOTES

HOMAN

DATE

9/16/04

ROUTE

US 20A

H.C.

CANTERBURY

WEATHER

CLOUDY

COUNTY

FULTON

R.C.

BARNHISEL

TEMP.

70°

TOWNSHIP

YORK

SECTION

17

T 7 N R 7 E

TYPE MONUMENT P.K.NAIL


ON SURFACE - ~~BELOW~~ ON

~~LEFT~~ - CL PAV'T - RIGHT 0.7'

- TO - EDGE PAVEMENT


S.L.M. 849+04

GRID: NORTHING: _____ EASTING: _____

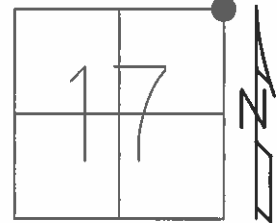

SET MAG/WASHER

10-13-04, DCH

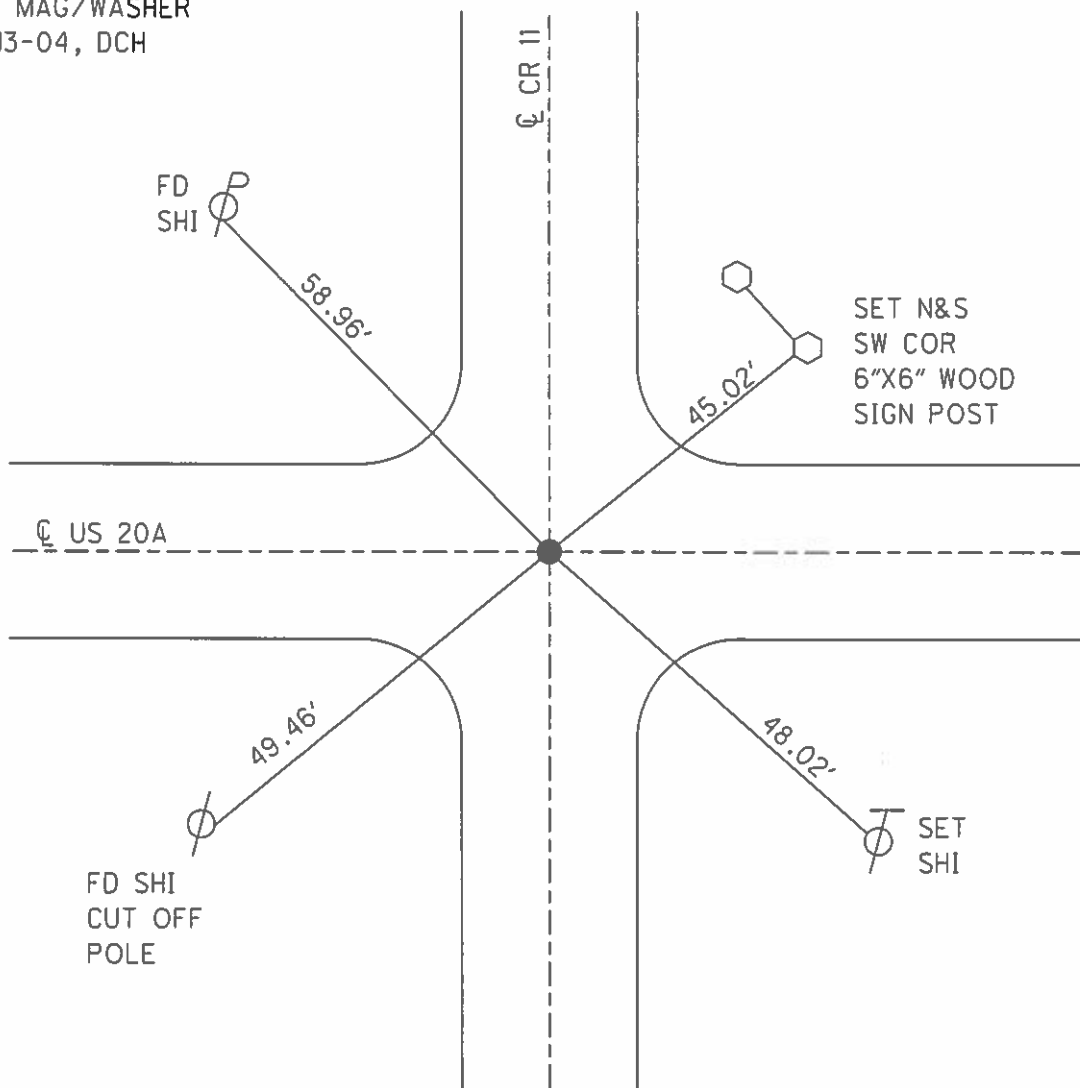

O.D.O.T. DISTRICT 2 SURVEY OFFICE

PERSONNEL

REFERENCE NO. 33

SHEET 6 OF 7

NOTES HOMAN

DATE 9-16-04

ROUTE U.S. 20-A

H.C. CANTERBURY

WEATHER CLOUDY

COUNTY FULTON

R.C. BARNHISEL

TEMP. 70°

TOWNSHIP YORK

SECTION 8-9-16-17

T 7 N R 7 E


TYPE MONUMENT PK NAIL

ON SURFACE ~~- BELOW~~ YES


~~LEFT - C PAVT~~ - RIGHT 0.7' RT

TO EDGE PAVEMENT

S.L.M. 849+04

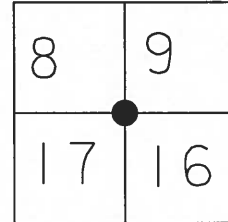

SET MAG NAIL
& WASHER
10-13-04
DCH

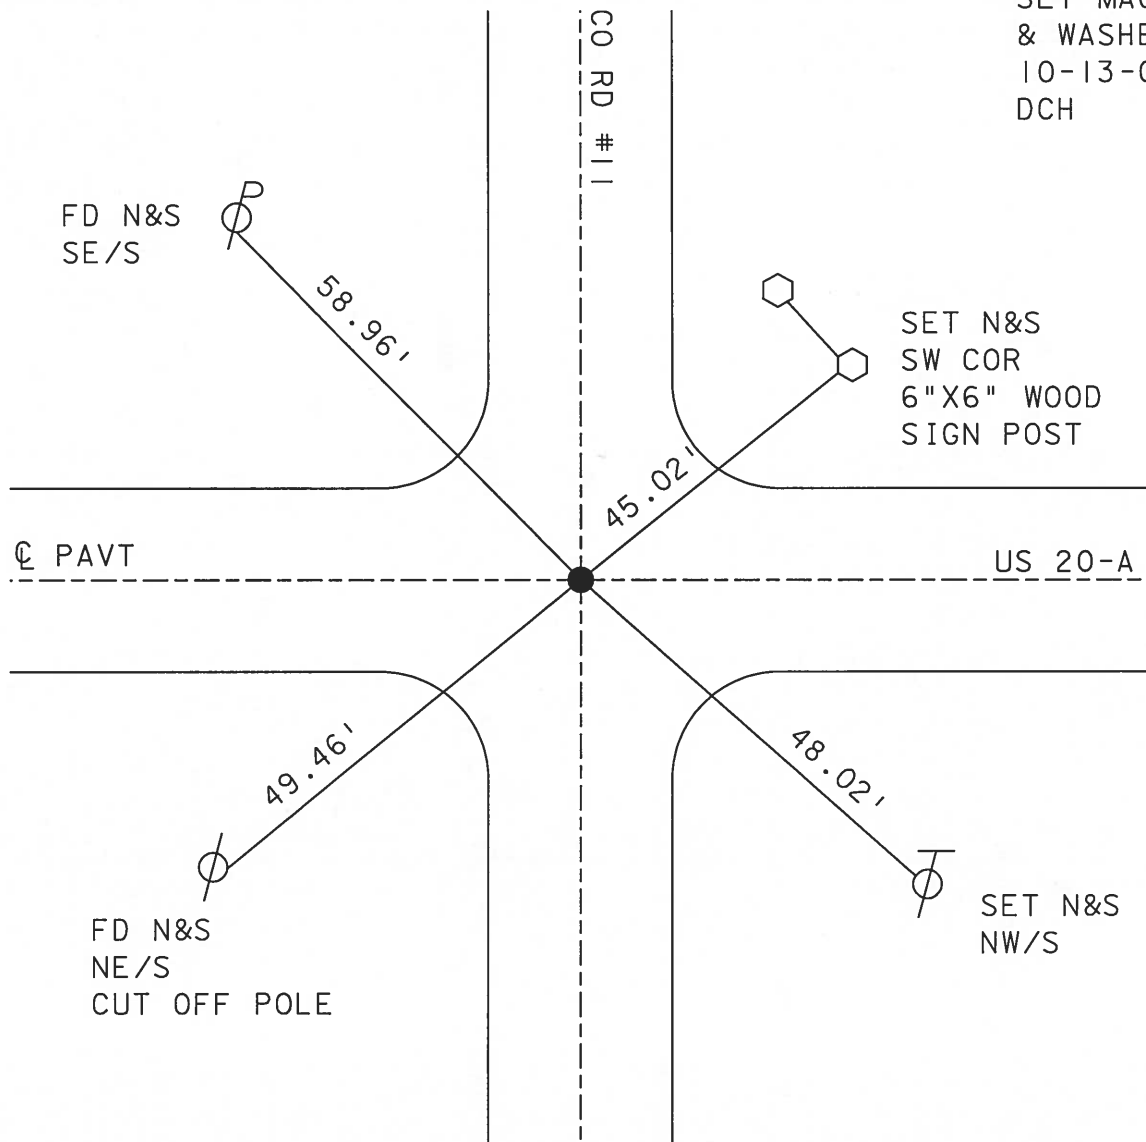

O.D.O.T. DISTRICT 2 SURVEY OFFICE

PERSONNEL

REFERENCE NO. 33

SHEET 10 OF 24

NOTES 1. Stone

H.C. D. Curtis

R.C. J. Hauscholder

DATE 17 Sept. 86

WEATHER Cool

TEMP. 50°

ROUTE US #20-19

COUNTY Fulton

TOWNSHIP York

SECTION 8-9-16-17

T R

TYPE MONUMENT PK Nail

ON SURFACE - BELOW Surface

LEFT- & PAW'T. - RIGHT

TO EDGE PAVEMENT


S.L.M. 849+43

8	9
17	16



SET P.K. NAIL TO SURFACE

4-29-88

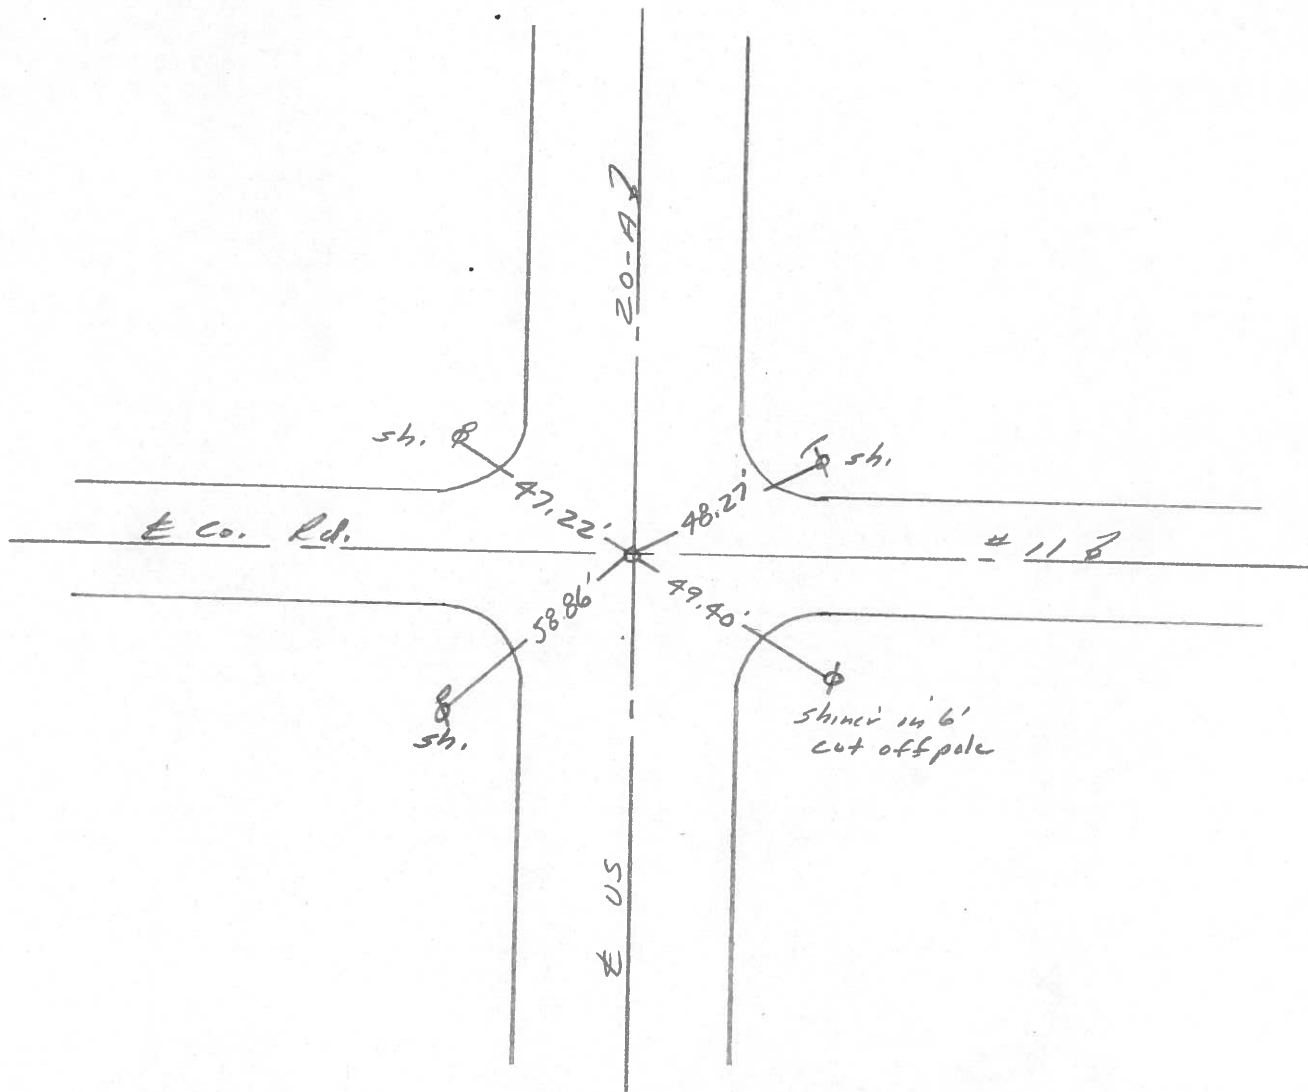

O.D.O.T. DISTRICT 2 SURVEY OFFICE

SHEET

OF

County Fulton S.R. 2 & US20A

Township York

Section NW Cor. 16 NE Cor. Sec. 17
SE Cor. 8 SW Cor. Sec. 9
T1N, R7E


Personnel Smith
Bowers
Mead

OK-10-15-80

Date 6-5-1980

Weather Clear


Temp. +80°

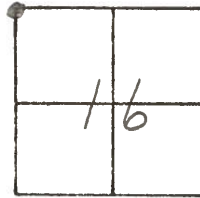

(33)

Fd. 1" Iron Pipe
 @ Surface

SET P.K. & Shi
 BOWERS

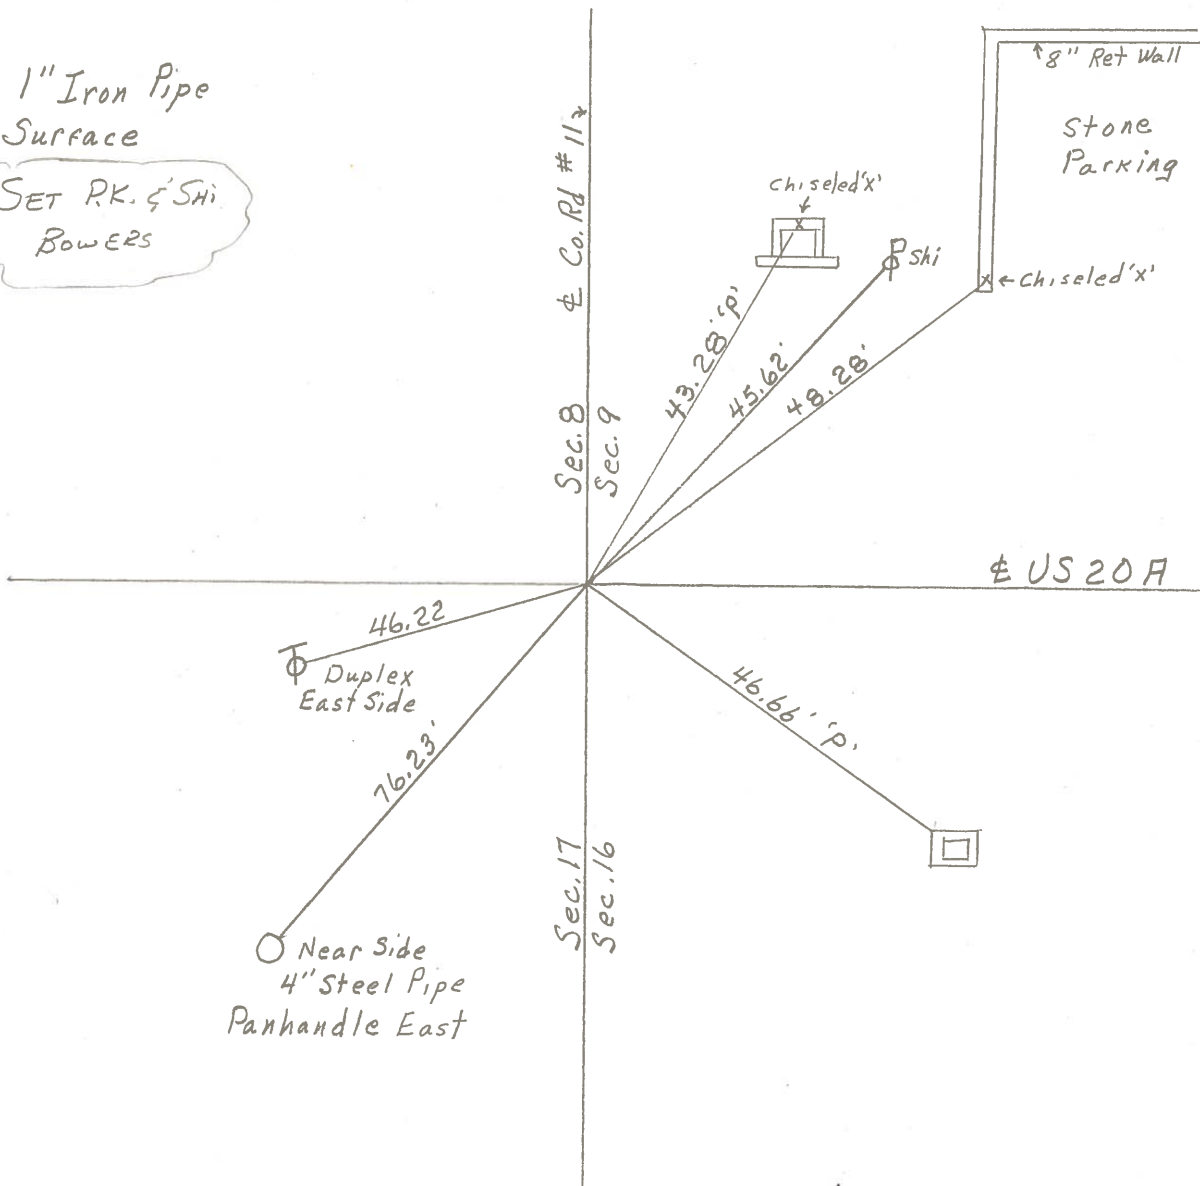

PERSONNEL	TITLE	PERSONNEL	TITLE	COUNTY	DATE	WEATHER	TEMP.
Tomsic				Fulton	April 18, 1973		
Neuser				S. R. U.S. 20A			
Granata							
Vanyo				SEC.			


DESCRIPTION

LEFT


CENTER LINE

RIGHT

JOB NO.

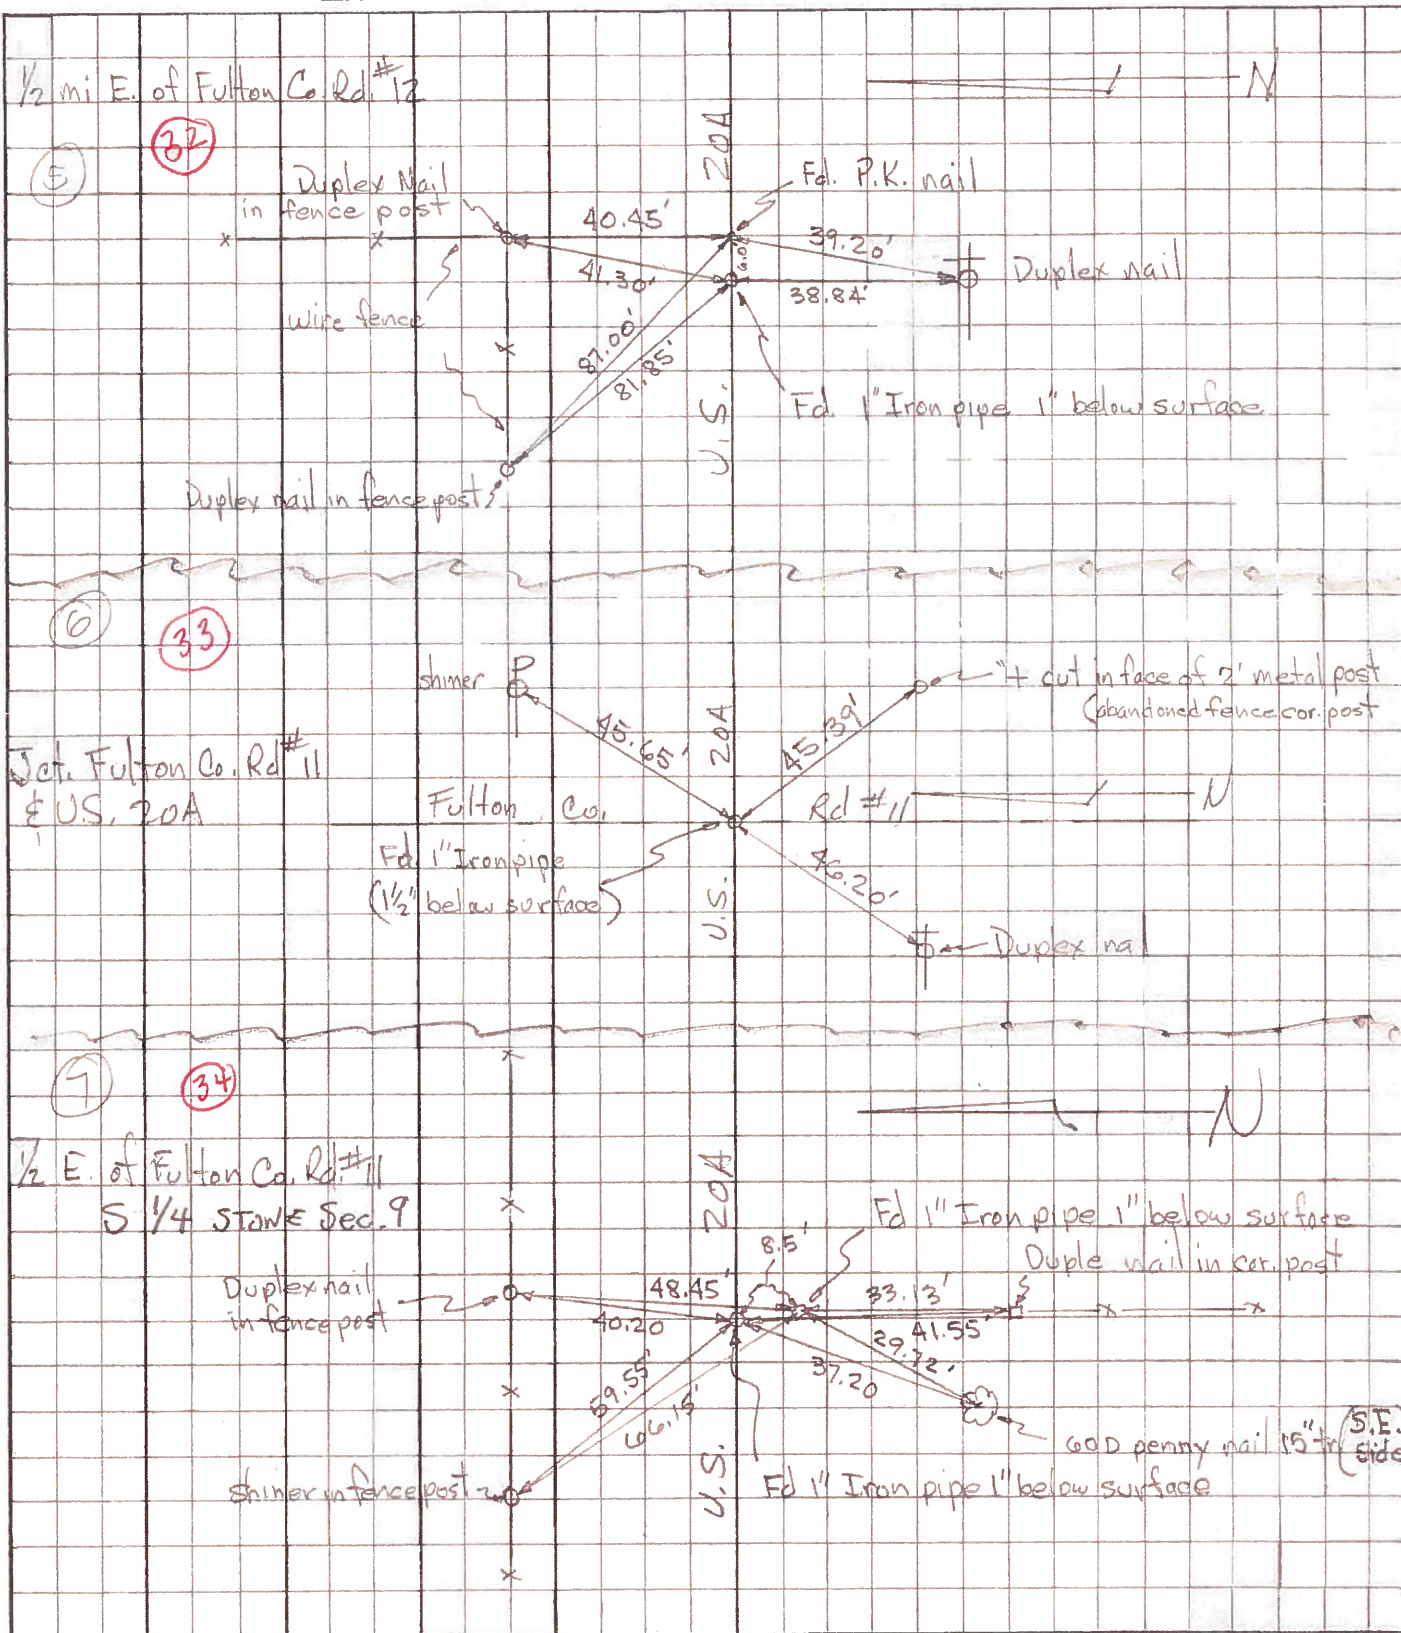

PERSONNEL TITLE PERSONNEL TITLE

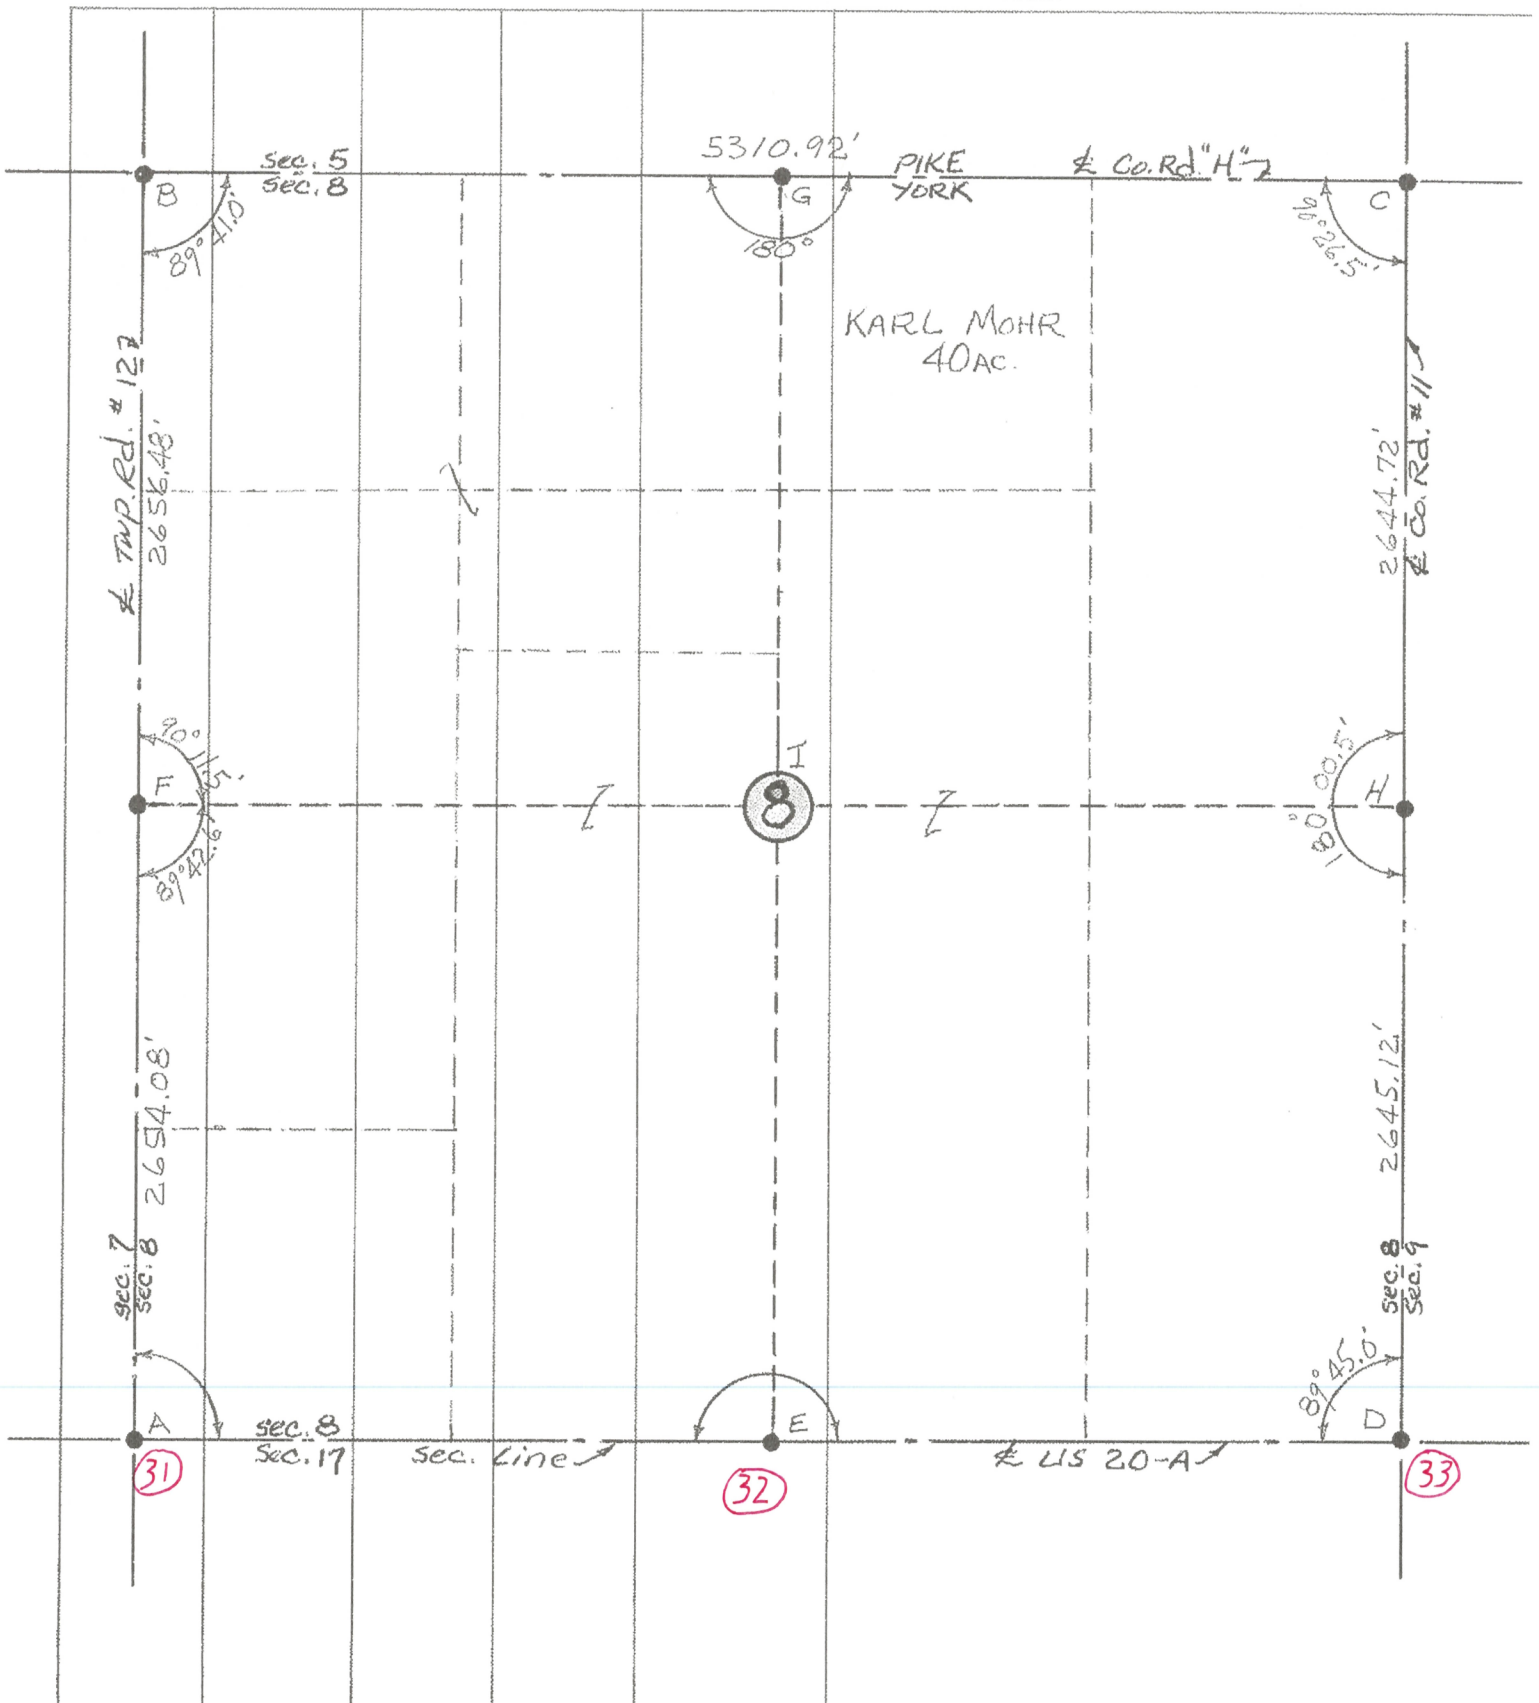Red Beach
Newcomb
KnappeCOUNTY FULTON DATE Dec. 1971S. R. US 20-A WEATHER _____SEC. 8 YORK TWP T-7-N TEMP. _____DESCRIPTION ALIGNMENT & CONTROLS JOB NO. _____

PERSONNEL TITLE

PERSONNEL TITLE

COUNTY FultonDATE Nov '71Red Beachy
Newcomb
KnapeS. R. US 20-A

WEATHER _____

SEC. YORK Twp T-7-N

TEMP. _____

DESCRIPTION

CONTROL POINTS

JOB NO. _____

LEFT

CENTER LINE

RIGHT

E $\frac{1}{4}$ STONE, Sec. 20
W $\frac{1}{4}$ STONE, Sec. 21

YORK TWP.

E $\frac{1}{4}$ post, Sec. 17
W $\frac{1}{4}$ post, Sec. 16


YORK TWP T-7-N

Found 12"x $\frac{3}{4}$ " old beat up lead pipe
over STONE. Found STONE w/ tile
1 1/2" below surface.


M

STONE has notch on ctr. of good
WSW & ENE Ridge.Est. 10 1/2" x 1" pipe over STONE
11 Nov. 1971

Co. Rd. #117

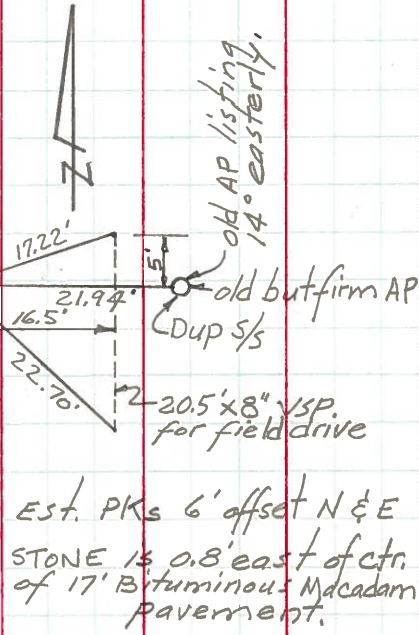EST. PKs 6' offset N & E
STONE is 0.8' east of ctr.
of 17' Bituminous Macadam
pavement.


N

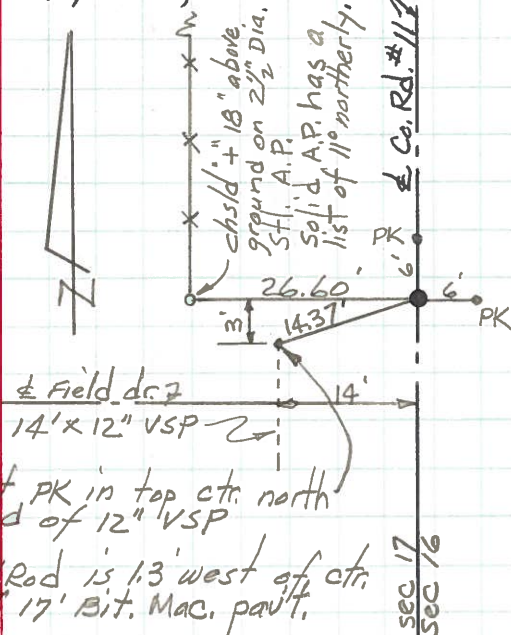set PK in top ctr. north
end of 12" VSP
1 1/2" Rod is 1.3' west of ctr.
of 17' Bit. Mac. pav't.Found recorded 1 1/2" Rod (Vol. B p. 124, 1905)
15 1/2" below pav't. surface.
Est. 14 1/2" x 1" pipe over the 1 1/2" Rod.
15 Nov. '71


COR. STONE, Sec. 16, 17, 20 & 21 YORK TWP

Found 12"x 2" pipe 9 1/2" below pav't surface and approx.
over Corner STONE. Cor. STONE Found 21 3/4" below.
Brought point to surface by nestling a 14"x 1" pipe
inside of the 2" pipe. Offset PKs 6' S & E.

all mens. to CB's are to outside corners as shown

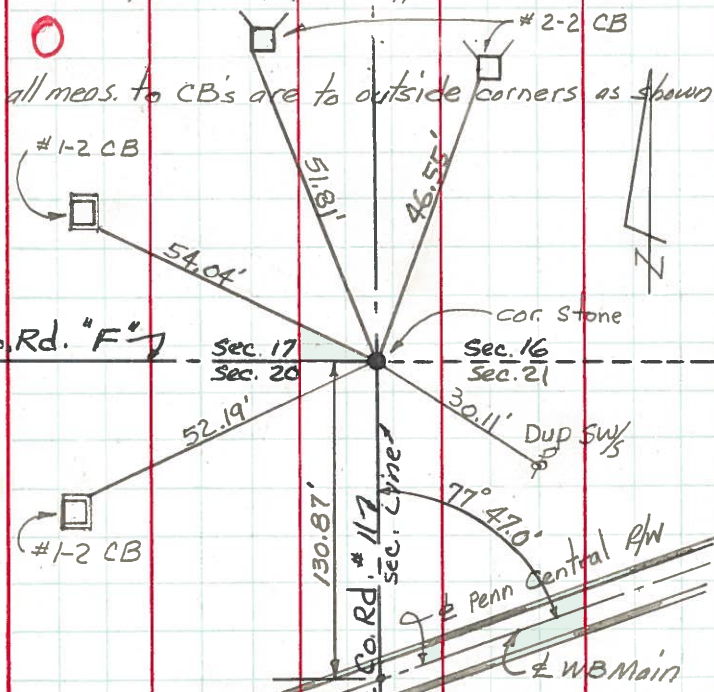COR. STONE, Sec. 4 & 5 Pike Twp.
Sec. 8 & 9 YORK TWP.

P

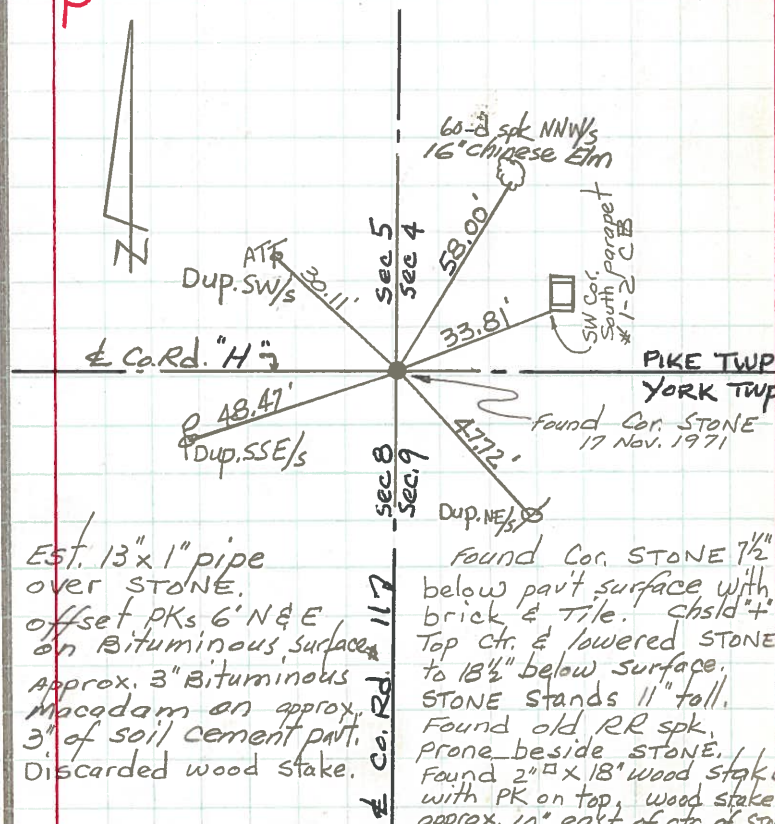Est. 13"x 1" pipe
over STONE.
offset PKs 6' N & E
on Bituminous surface.
approx. 3" Bituminous
Macadam on approx.
3" of soil cement pav't.
Discarded wood stake.Found Cor. STONE 7 1/2"
below pav't surface with
brick & tile. chsd +
Top ctr. & lowered STONE
to 18 1/2" below surface.
STONE stands 11" tall.
Found old RR spk.
prone beside STONE.
Found 2" x 18" wood stake
with PK on top, wood stake
approx. 10" east of ctr. of stone.

PERSONNEL TITLE PERSONNEL TITLE

Red Beach
Newcomb
KnappeCOUNTY FultonDATE Dec 1971S. R. US 20-A

WEATHER _____

SEC. York Twp T-7-N

TEMP. _____

DESCRIPTION



CONTROL POINTS

JOB NO. _____

LEFT


CENTER LINE

RIGHT

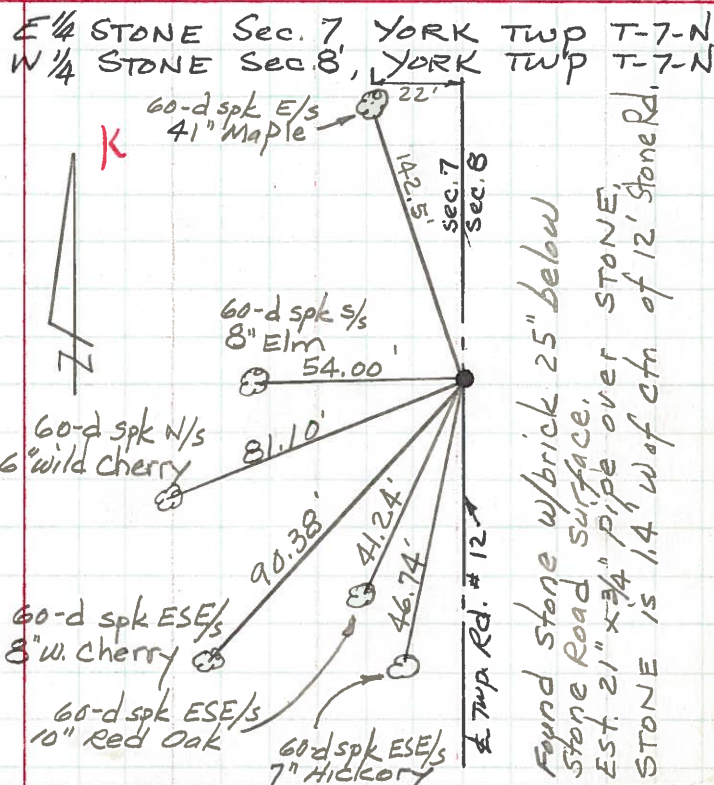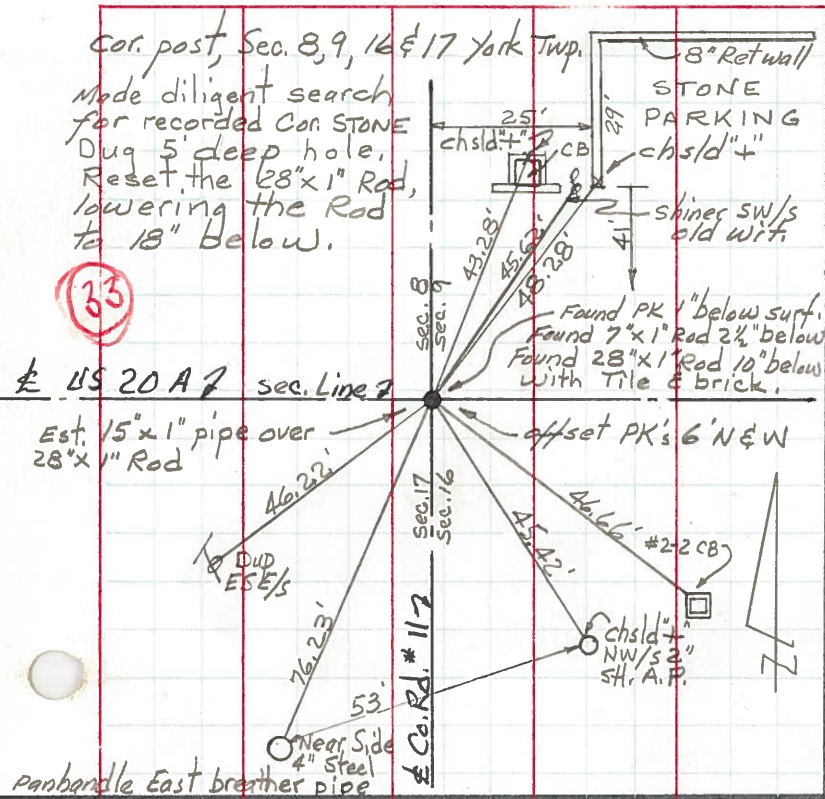


E 1/4 STONE Sec. 8 YORK TWP. T-7-N
W 1/4 STONE Sec. 9 " " " "

Found 1/4 STONE
from 1905 Records

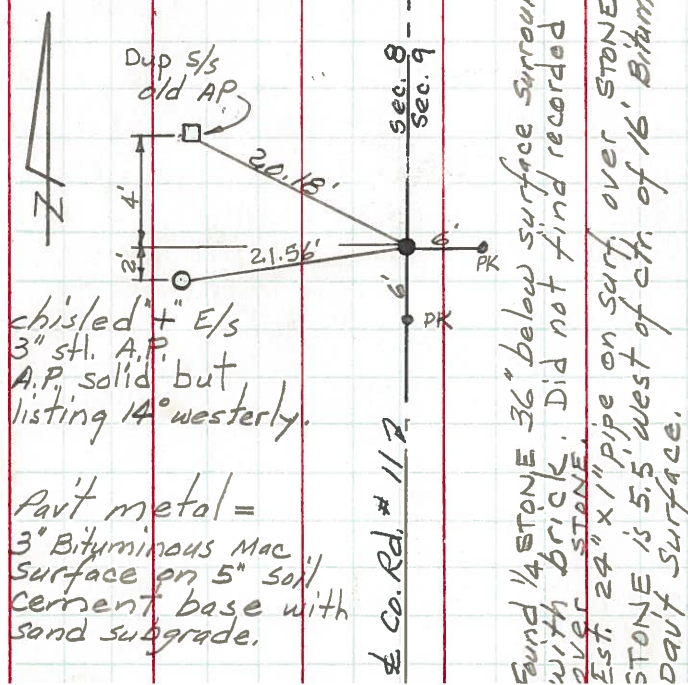

NE Cor Stone Sec. 7 YORK TWP T-7-N
NW Cor. Stone Sec. 8 " " " "

Found 23"x1/2" pipe on surface bent over Cor. STONE
Found STONE w/tile 9 1/2" below surface
chisled "+" top of STONE

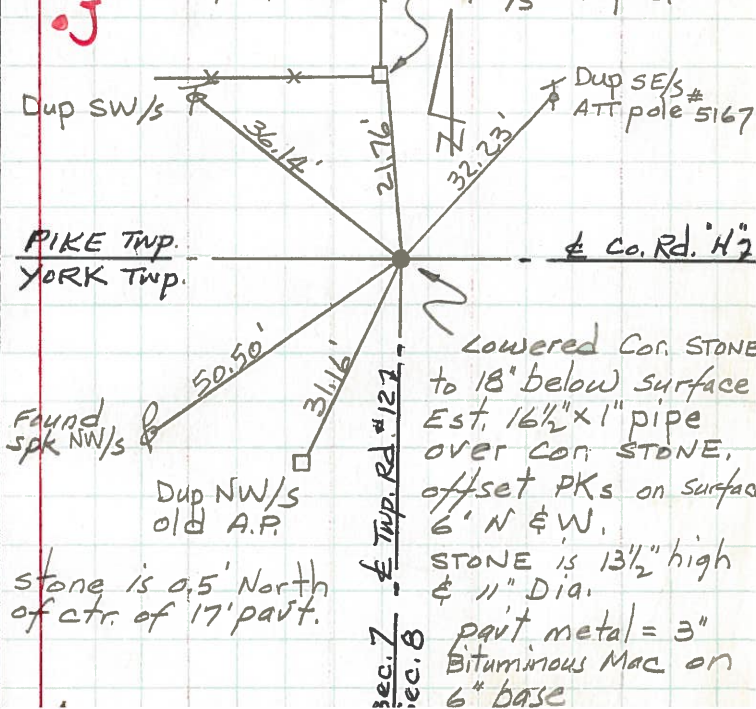

PERSONNEL TITLE PERSONNEL TITLE

COUNTY FultonDATE OK-1-24-58S. R. #20-Alt

WEATHER

SEC.

TEMP.

DESCRIPTION


GERMAN TWA

JOB NO.

LEFT

CENTER LINE

RIGHT

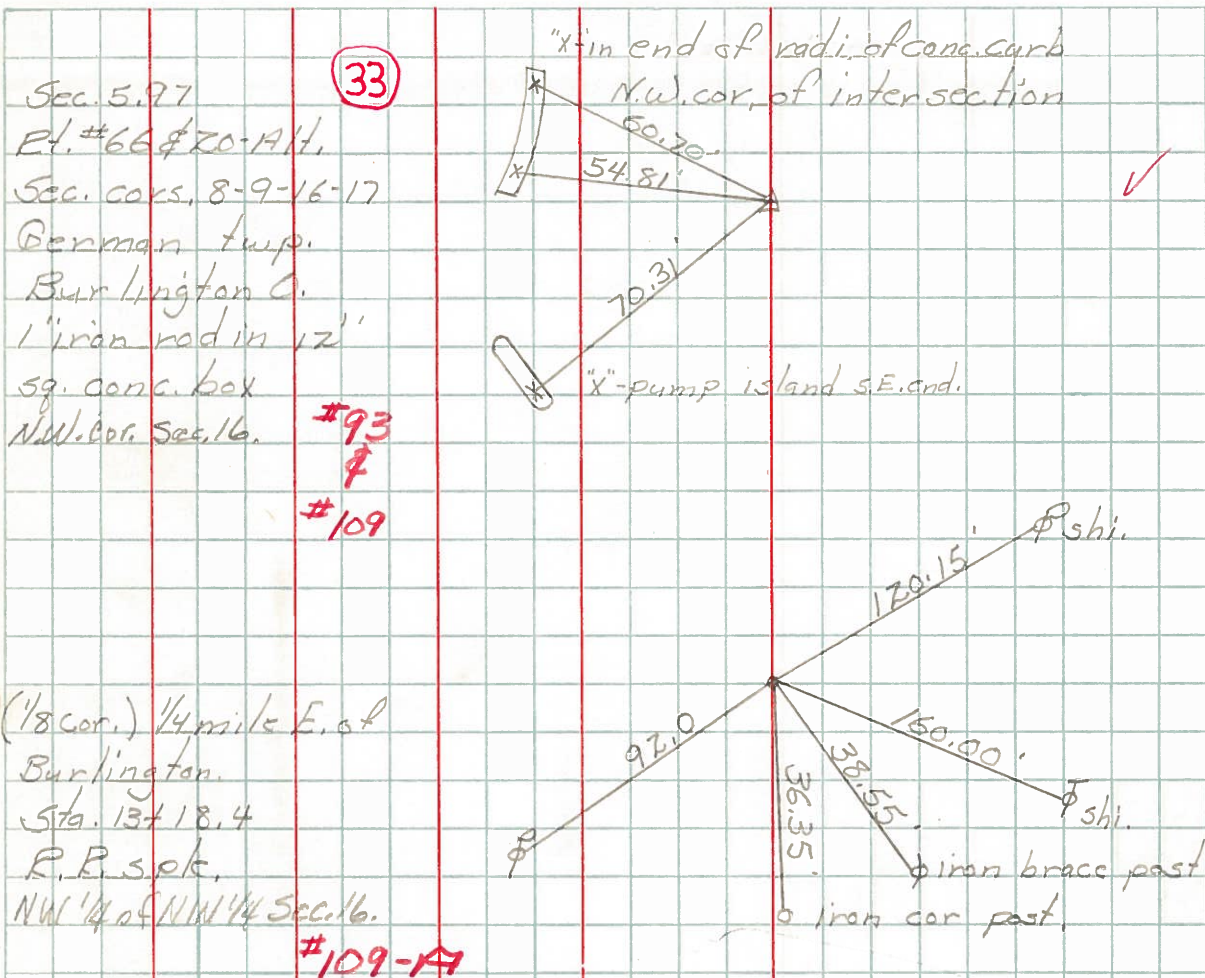

PERSONNEL TITLE PERSONNEL TITLE

COUNTY FultonDATE 3-28-55S. R. #2 & 20 Aft.

WEATHER

SEC. M, A, O,

TEMP.

DESCRIPTION

LEFT

CENTER LINE

RIGHT

JOB NO.

P.I. Sta. 53+62.34

S.W. cor. sec. 7

Fd. iron pin 12" below
surface of pav't.
(Not plum bed.)

#72 ✓

S.E. to shiner in T.P.

45.35'

S.W. to shiner in A. Post

46.90'

S.W. to shiner in T.P.

102.25'

N.W. to shiner in 24" Elm

171.45'

N.E. to shiner in 20" Hickory

51.05'

Sta. 79+78.58

S. 1/4 sec. 7

Fd. iron pin

#73 ✓

N.W. to shiner in 30" walnut

87.25'

S.W. to shiner in T.P.

59.60'

S.E. to iron A.P. 1' above gnd.

44.30'

N.E. to shi. in 24" Spruce N.E.

97.15'

Sta. 106+08.39

S.W. cor. sec. 8

Iron pin

#74 ✓

N.E. to iron post in pump island

62.09'

N.W. to shiner in P.P.

81.90'

S.W. to shiner in 12" maple

54.83'

S.E. to shiner in 30" catalpa

59.70'

Sta. 132+68.17

S. 1/4 sec. 8

Fd. iron pin

#75

N.N.E. to steel sign post stake

40.47'

N.N.E. to shiner in P.P.

40.94 40.88'

N.W. to shiner in 3rd fence post

54.35'

S. to shiner in T.P.

54.24'

Sta. 159+27.37

S.W. cor. sec. 9

Fd. iron pin

#76

S.W. to shiner in T.P.

44.10'

N.E. to shiner in P.P.

45.67'

S.E. to near side of Gov. B.M.

57.13'

N.W. to near side of iron A.P.

56.97'