

O.D.O.T. DISTRICT 2 SURVEY OFFICE (USE ONLY)

PERSONNEL

REFERENCE NO. 34

SHEET 62 OF 63

NOTES RHOADES

DATE 6/11/19

ROUTE US 20A

H.C. O'DONNELL

WEATHER SUNNY

COUNTY FULTON

R.C. MILLER

TEMP. 62°

TOWNSHIP YORK

SECTION 16

DWG BY BALBAUGH PID 101232

T 7 N R 7 E

TYPE MONUMENT MAG/WASHER

ON SURFACE - ~~BELOW~~ ON

OFFSET CL PAVEMENT 0.6' LT : ~~RT~~

14.0' TO RT EDGE PAVEMENT


STATION: 875+46.85

HORIZ.DATUM: NAD83 (2011)

GEOID: 2012A


GRID: NORTHING: 698504.367

EASTING: 1539865.102

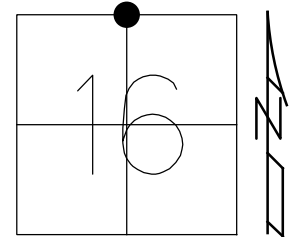

RECORD:  
FD P.K.NAIL  
9/16/04, MC  
SET MAG/WASHER  
10/13/04, DCH  
FD MAG/WASHER  
12/5/17, JFO  
REF34  
12/21/17, JFO  
SET MAG/WASHER  
10/25/19, JFO

DIST. 34-34A=8.62'

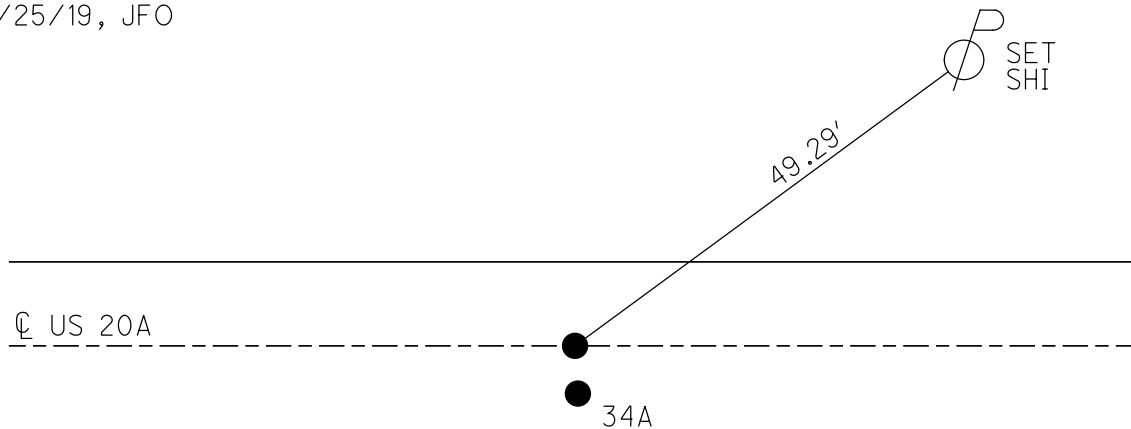

# O.D.O.T. DISTRICT 2 SURVEY OFFICE (USE ONLY)

PERSONNEL

REFERENCE NO. 34

SHEET 60 OF 61

NOTES

HOMAN

DATE

9/16/04

ROUTE

US 20A

H.C.

CANTERBURY

WEATHER

CLOUDY

COUNTY

FULTON

R.C.

BARNHISEL

TEMP.

70°

TOWNSHIP

YORK

SECTION

16

T 7 N R 7 E

TYPE MONUMENT

P.K.NAIL

ON SURFACE - ~~BELOW~~

ON

LEFT - ℄ PAV'T - ~~RIGHT~~

0.6'


14.0' TO RT EDGE PAVEMENT

S.L.M.

875+63

GRID: NORTHING:

EASTING:

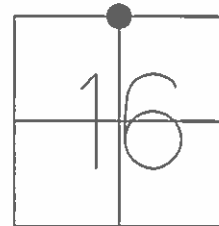

SET MAG/WASHER

10-13-04, DCH

℄ US 20A

● 34A

DIST. 34-34A=8.65'

36.92'



SET N&S  
NEAR FACE  
6"X6" WOOD  
POST BY  
TELE PED

O.D.O.T. DISTRICT 2 SURVEY OFFICE

PERSONNEL

REFERENCE NO. 34

SHEET 7 OF 7

NOTES HOMAN

DATE 9-16-04

ROUTE U.S. 20-A

H.C. CANTERBURY

WEATHER CLOUDY

COUNTY FULTON

R.C. BARNHISEL

TEMP. 70°

TOWNSHIP YORK

SECTION 16

T 7 N R 7 E


TYPE MONUMENT PK NAIL

ON SURFACE - ~~BELOW~~ YES

LEFT - Q PAV'T - RIGHT A 0.6' LT B 8.0' RT


TO EDGE PAVEMENT A 14.0' RT  
B 5.5' RT

S.L.M. 875+63 A, 875+64B

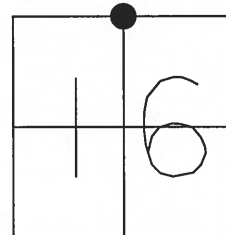

DIST A-B=8.65'

SET MAG NAIL  
& WASHER  
AT BOTH  
LOCATIONS  
10-13-04  
DCH

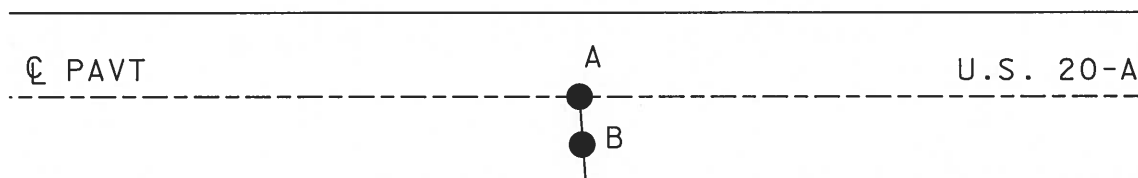

A=36.92'  
B=28.29'

SET N&S  
NEAR FACE  
6"X6" WOOD  
POST BY  
TELE PED

# O.D.O.T. DISTRICT 2 SURVEY OFFICE

PERSONNEL

REFERENCE NO. 34

SHEET 11 OF 24

NOTES 1. Stone

H.C. D. Curtis

R.C. J. Householder

DATE 17 Sept. 86

WEATHER Cloud

TEMP. 50°

ROUTE US#20-A

COUNTY Fulton

TOWNSHIP York

SECTION 16

T     R    


TYPE MONUMENT PK Nails

ON SURFACE - BELOW Surface



LEFT- & PAV'T. - RIGHT    

TO     EDGE PAVEMENT

S.L.M. 875+95

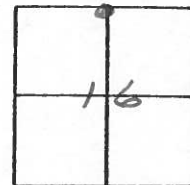

- ① SET P.K. NAIL TO SURFACE
  - ② SET P.K. NAIL TO SURFACE
- 4-29-88

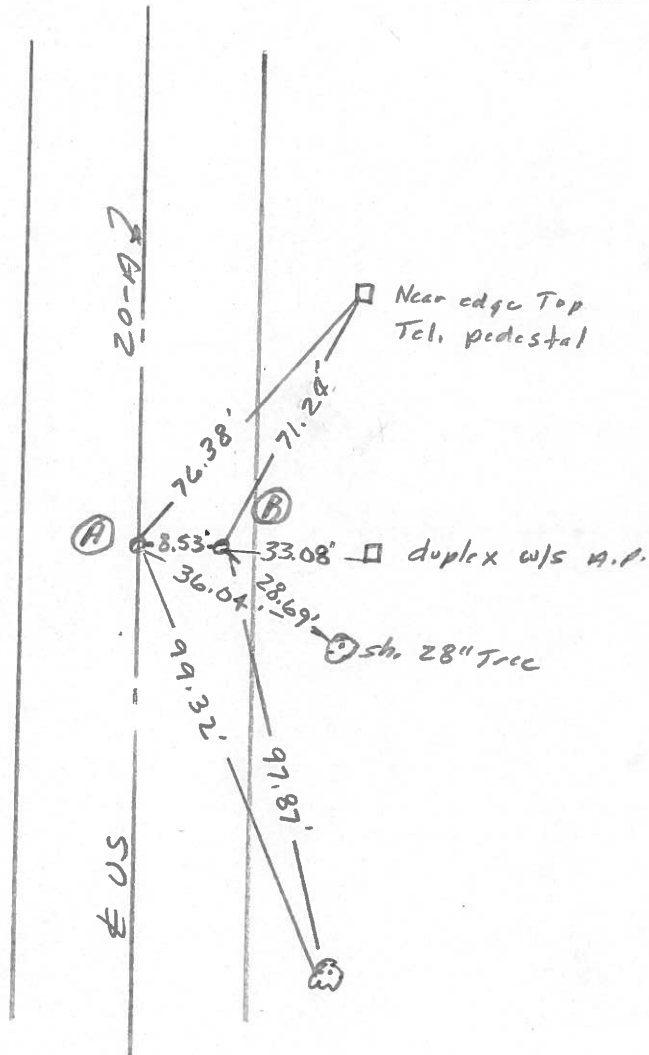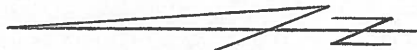

# O.D.O.T. DISTRICT 2 SURVEY OFFICE

SHEET

OF

County Fulton S.R. 2 & US20A

Township York

Section N 1/4 Sec. 16

TZN, RZE

Personnel Smith


Bowers

Mead


Date 6-6-1980

Weather Clear


Temp. +82°

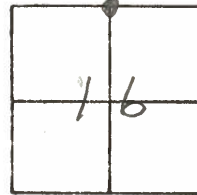

(34)

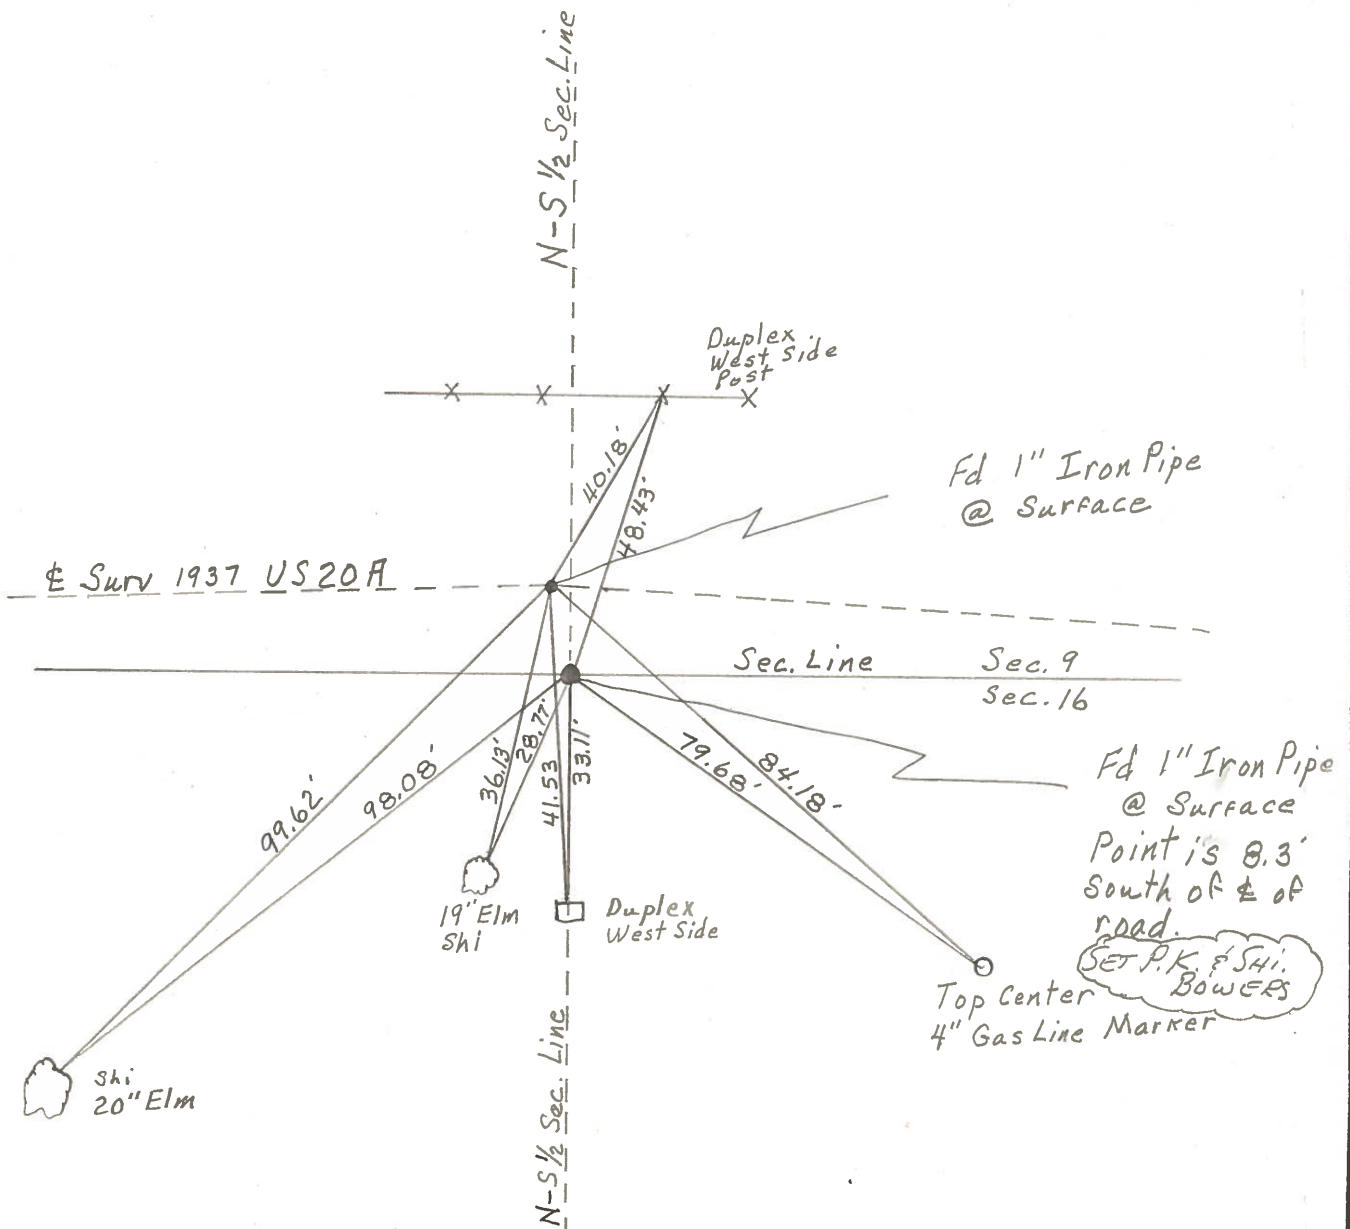

| PERSONNEL | TITLE | PERSONNEL | TITLE | COUNTY         | DATE           | WEATHER | TEMP. |
|-----------|-------|-----------|-------|----------------|----------------|---------|-------|
| Tomsic    |       |           |       | Fulton         | April 18, 1973 |         |       |
| Neuser    |       |           |       | S. R. U.S. 20A |                |         |       |
| Granata   |       |           |       | SEC.           |                |         |       |
| Vanyo     |       |           |       |                |                |         |       |

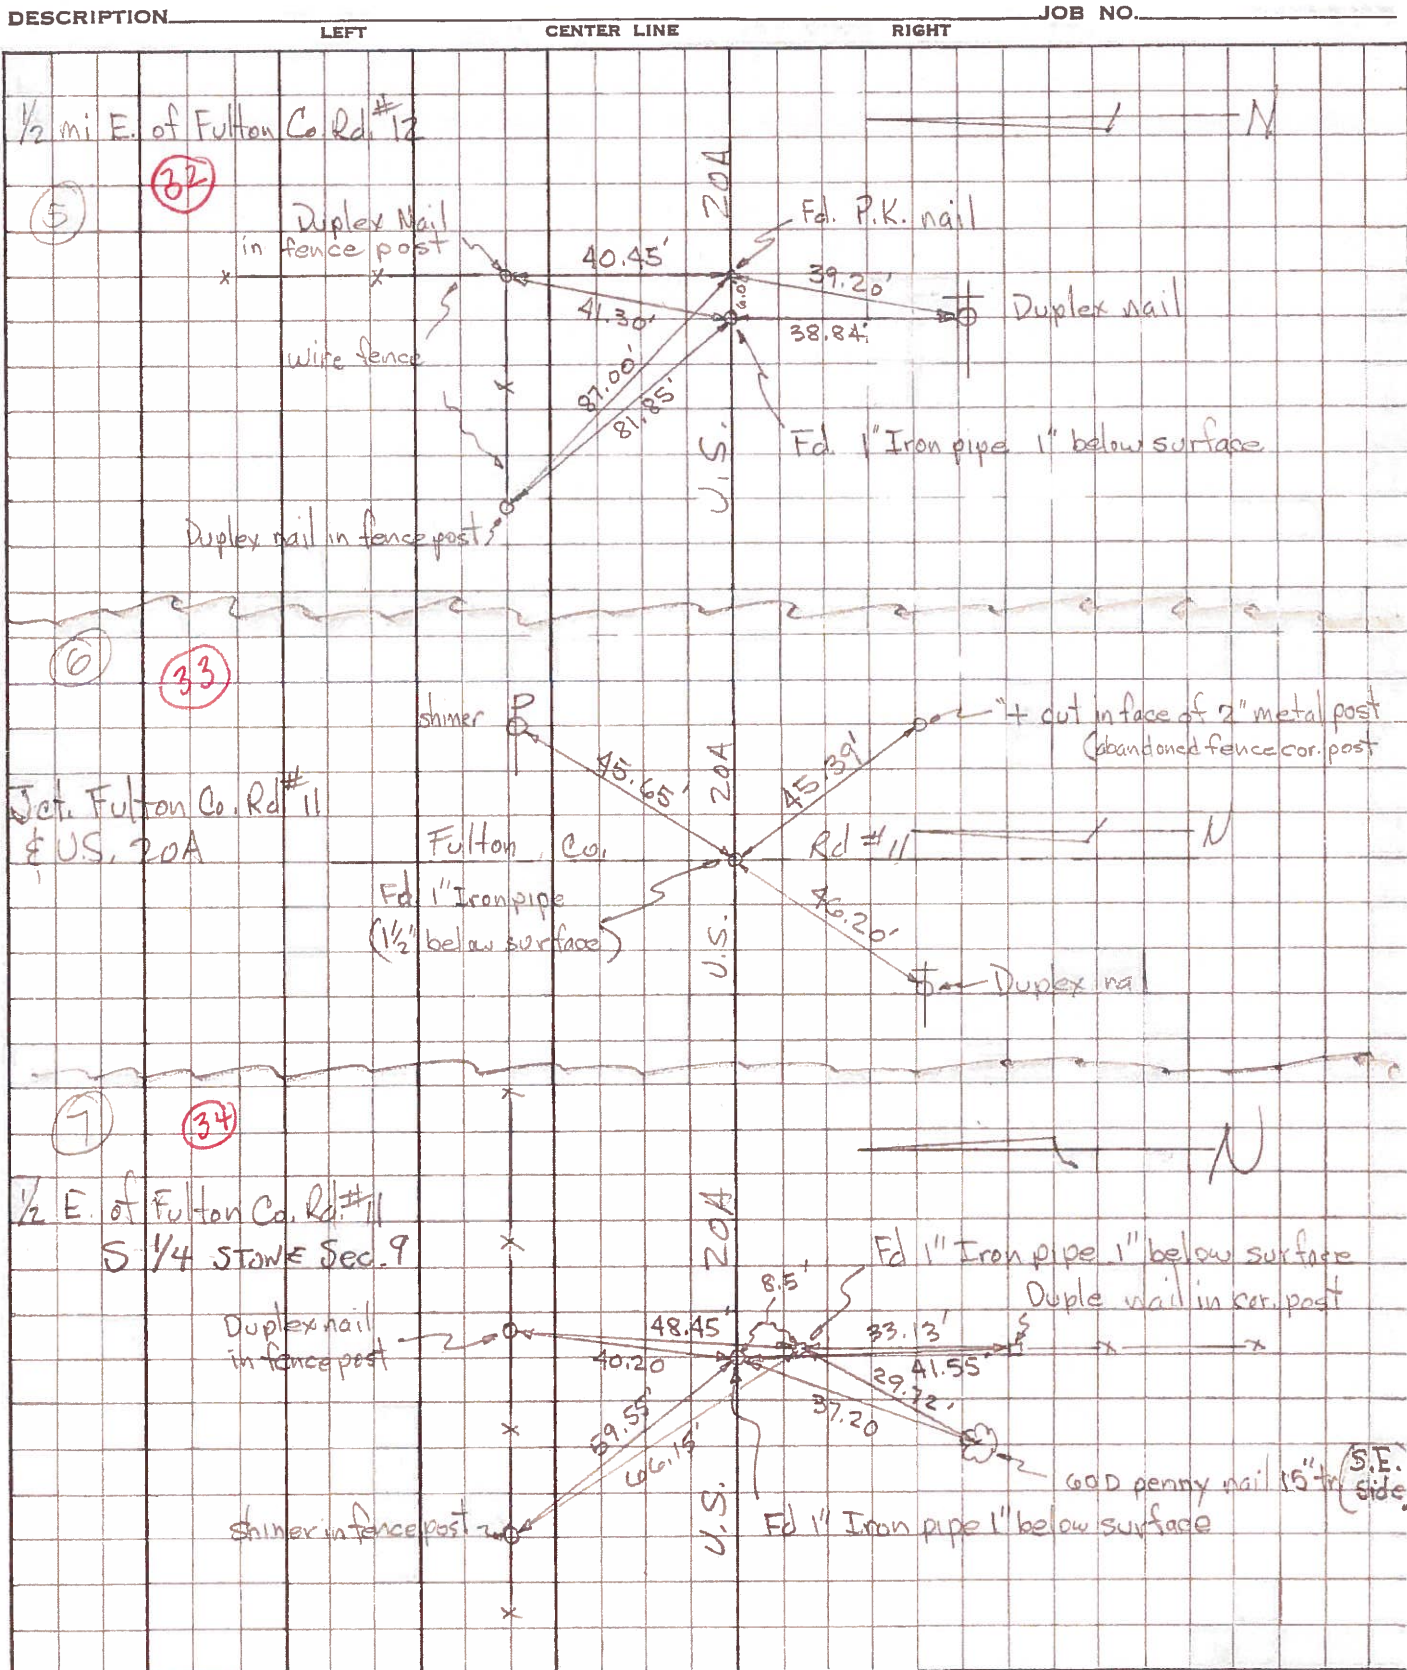



PERSONNEL TITLE  
Red Beach  
Newcomb  
Knape

COUNTY Fulton DATE Dec. 1971  
 S. R. US 20-A WEATHER \_\_\_\_\_  
 SEC. YORK TWP T-7-N TEMP. \_\_\_\_\_

DESCRIPTION CONTROL POINTS JOB NO. \_\_\_\_\_


LEFT

CENTER LINE

RIGHT

S 1/4 STONE Sec. 6, Pike Twp. T-7-N  
 N 1/4 STONE Sec. 7, York Twp T-7-N

used the J in "J.R.D." carved in N. parapet  
 #1-2 CB

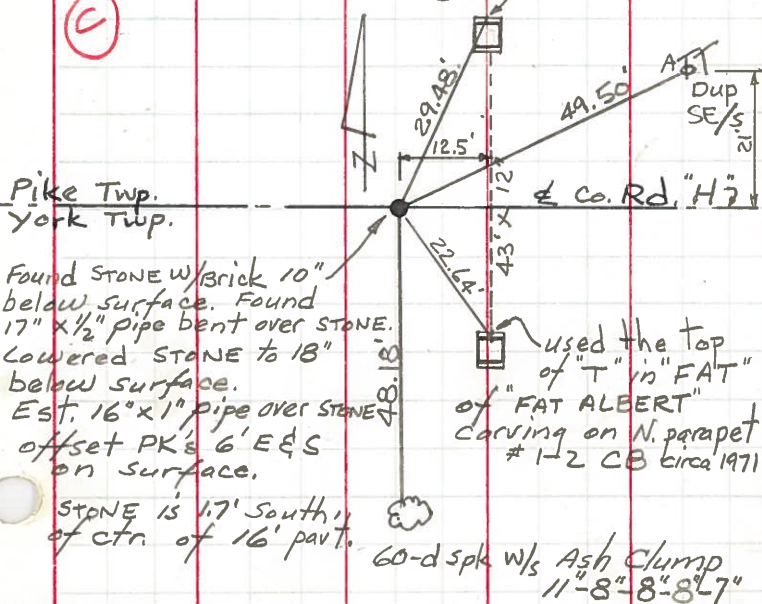


Survey (1937) for Δ @ Qtr. post

Found PK 1" below from old witnesses  
 Found 10" x 3/4" Rod 3" below surface  
 Found old wood stake  
 1" east of Bolt "B" and  
 16" below surface.

Dug 4' deep hole in search of qtr. STONE did not find.


Est. 24" x 1" pipe over bolt "B"  
 3 Jan 1972 bolt 6" x 3/8"  
 Found Bolt "B" 1937 Constr. plans 8" below surface

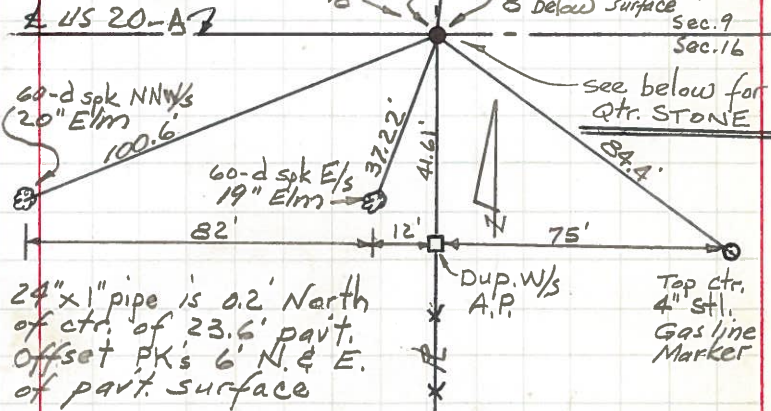

ctr. post STONE, Sec. 9 YORK TWP T-7-N  
 Found large STONE 17" below surface  
 STONE has good Apex. Found old stub wood AP west side of STONE & 10" below surface.


Found Recorded (B/122 1905)  
 Iron bobsled runner shoe under STONE. 6 Jan. 1972

Near side 4" stl. pipe  
 Gas Line Marker

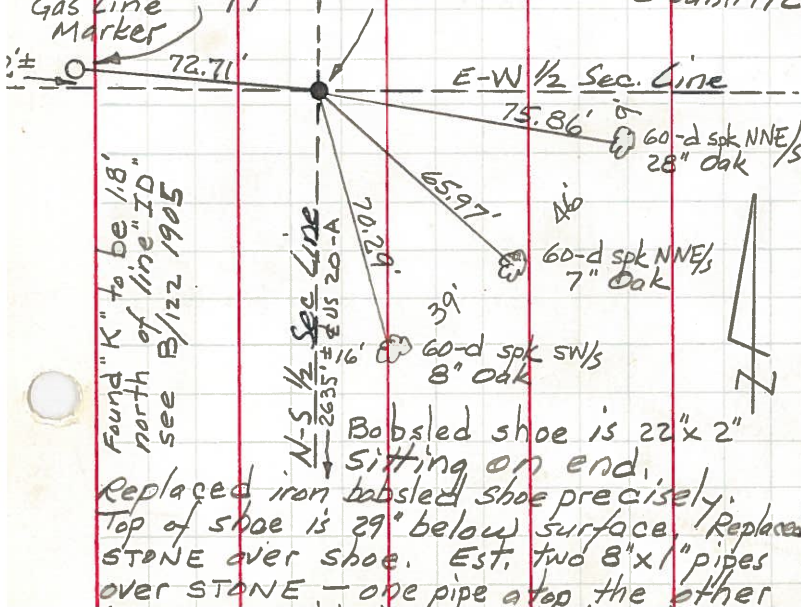

S 1/4 STONE Sec. 9 T-7-N YORK TWP  
 N 1/4 STONE Sec. 16 T-7-N " "

ctr. post, sec. 9  
 Dup w/s panel post

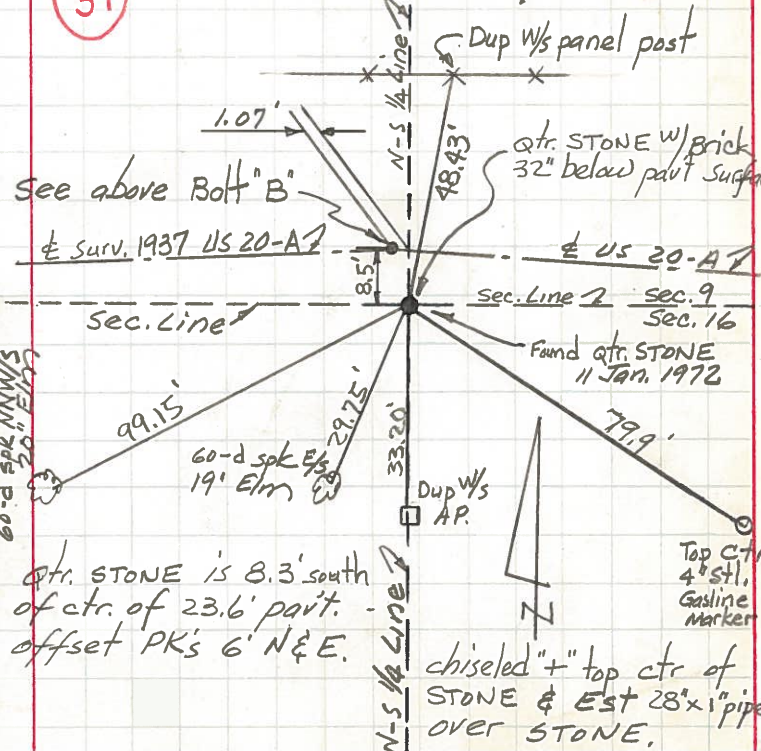

PERSONNEL TITLE

PERSONNEL TITLE

COUNTY FultonDATE Sept. 1971Red Beach  
Newcomb  
Knappe  
WiseS. R. US 20-A

WEATHER \_\_\_\_\_

SEC. York Twp.

TEMP. \_\_\_\_\_

DESCRIPTION

CONTROL

POINTS

JOB NO. \_\_\_\_\_





LEFT

CENTER LINE

RIGHT

S  $\frac{1}{4}$  STONE, Sec. 15 York Twp  
N  $\frac{1}{4}$  STONE, Sec. 22 T-7-N

Cor. Sec. 14, 15, 22 &amp; 23 York Twp. T-7-N

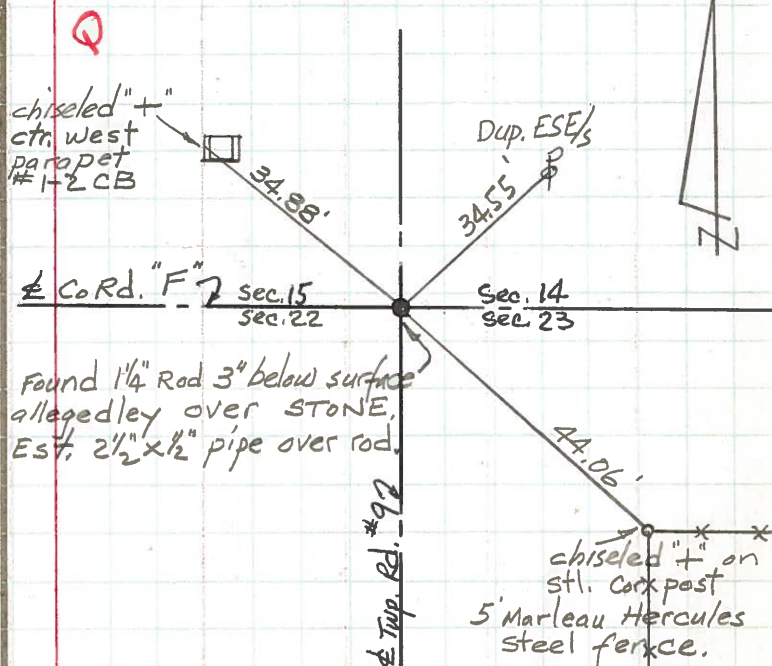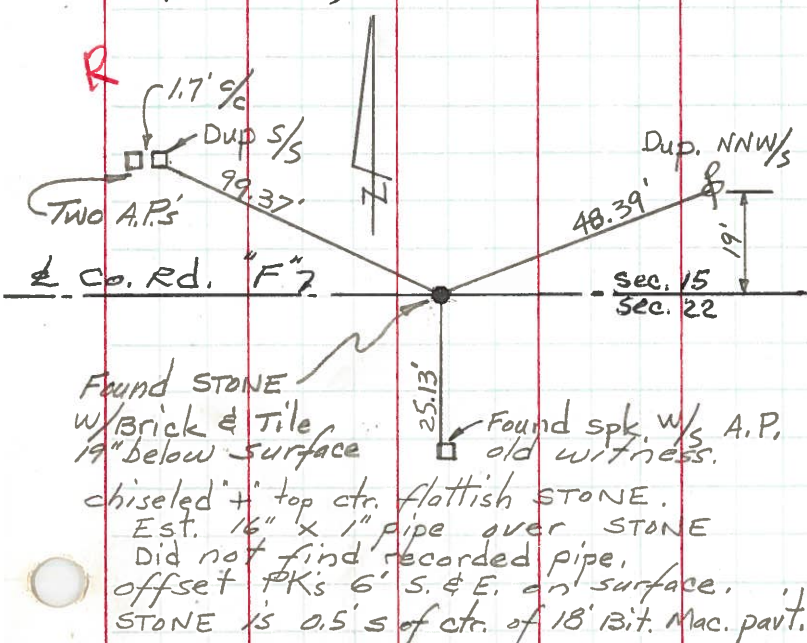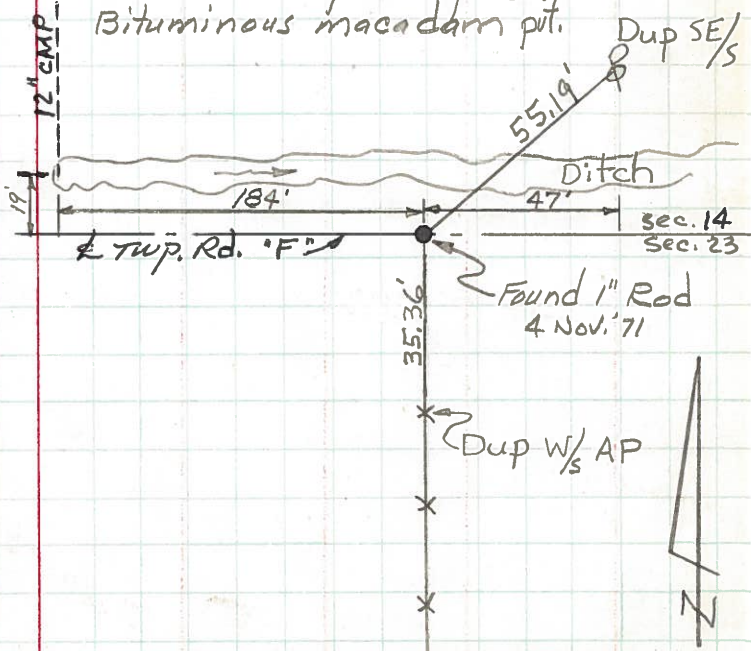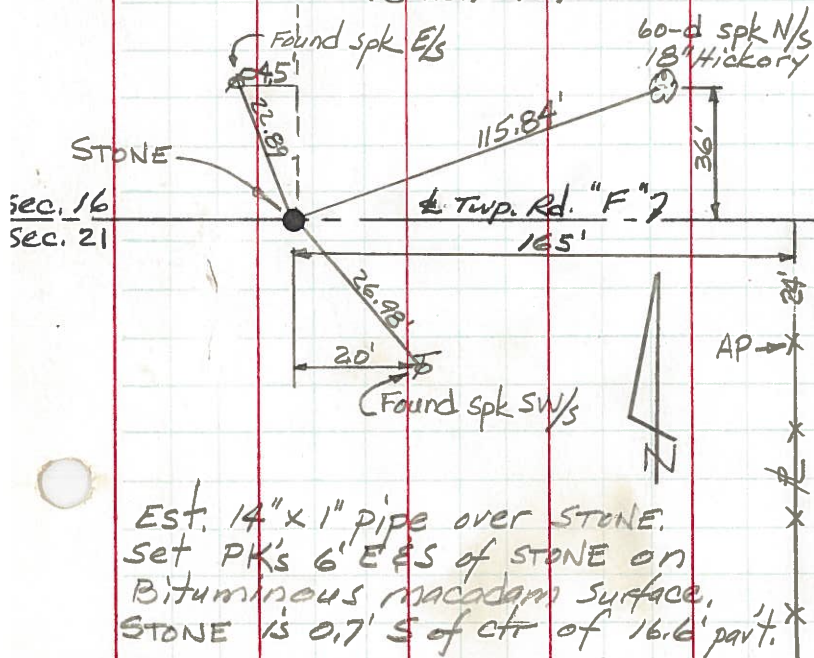S  $\frac{1}{4}$  STONE Sec. 16 YORK TWP T-7-N  
N  $\frac{1}{4}$  STONE Sec. 21S  $\frac{1}{4}$  post, Sec. 14 York Twp.  
N  $\frac{1}{4}$  post, Sec. 23 York Twp.**S** Found  $\frac{1}{4}$  STONE 15  $\frac{3}{4}$ " below surface.  
STONE has chsd "+" w/ old bone remnants about.  
Found spk 2" below surface.  
10 Nov. 1971Found 1" Rod 1" below pav't surface  
from Co. Records.  
Rod is 2.6' N of ctr. of 18'.  
Bituminous macadam pav't.

PERSONNEL TITLE PERSONNEL TITLE

COUNTY FultonDATE OK-1-24-58S. R. #20 R14

WEATHER

SEC.

TEMP.

DESCRIPTION GERMAN TWP.

JOB NO.

LEFT

CENTER LINE

RIGHT


Sta. 26+37.15

Mon.

NW 1/4 Sec. #16

(34)

#110

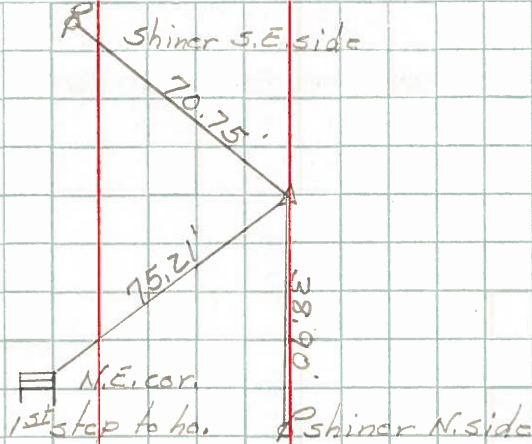


Sta. 39+56.12

E.P. spike

NW 1/4 NE 1/4 Sec. 16

#111

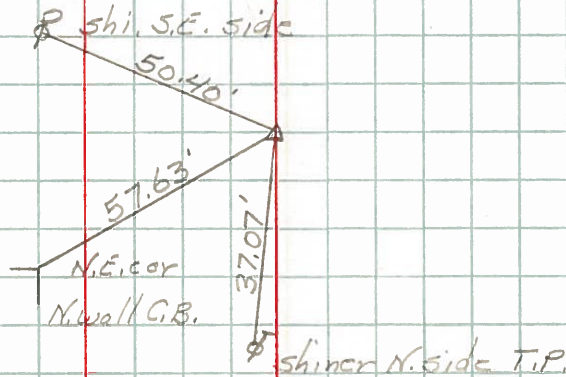

Sec. cor. (1 mile E. Burlington)


Sta. 52+74.04

Stone - mon.

NW cor. Sec. 16

(35)

#112

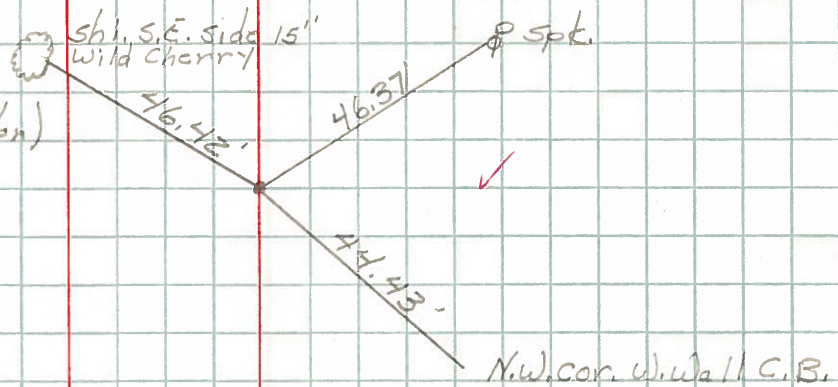

PERSONNEL TITLE PERSONNEL TITLE

COUNTY Fulton DATE 3-28-55

S. R. #2 & 20 Alt. WEATHER Pesefall-9-12-60

SEC. M, A, O, TEMP.

DESCRIPTION LEFT CENTER LINE RIGHT JOB NO.

10-24-61 W. Knape

Iron pin ✓  
S 1/4 Sec. #9  
York Twp.

Shi Fence Post  
#77

Sec. cor. 9-10-16-15 ✓  
York Twp.

Brace Pole  
SE Side pole  
Shi. 12" Elm N.W.  
#78

#79

Intersection S.E. #  
109 & Alt 20-2 ✓  
Iron pin  
S.E. cor. sec. 10

#80

