

O.D.O.T. DISTRICT 2 SURVEY OFFICE (USE ONLY)

PERSONNEL

REFERENCE NO. 34 A

SHEET 63 OF 63

NOTES RHOADES

DATE 6/11/19

ROUTE US 20A

H.C. O'DONNELL

WEATHER SUNNY

COUNTY FULTON

R.C. MILLER

TEMP. 62°

TOWNSHIP YORK

SECTION 16

DWG BY BALBAUGH PID 101232

T 7 N R 7 E

TYPE MONUMENT MAG/WASHER

ON SURFACE - ~~BELOW~~ ON

OFFSET Q PAVEMENT 8.0' ~~LT~~ : RT

5.5' TO RT EDGE PAVEMENT


STATION: 875+47.98

HORIZ.DATUM: NAD83 (2011)

GEOID: 2012A

GRID: NORTHING: 698495.795


EASTING: 1539866.130

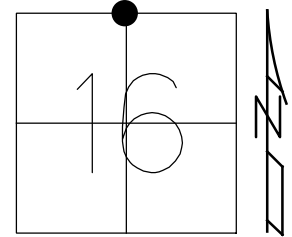

RECORD:

FD P.K.NAIL
9/16/04, MC
SET MAG/WASHER
10/13/04, DCH
FD MAG/WASHER
12/5/17, JFO
REFA34
12/21/17, JFO
SET MAG/WASHER
10/25/19, JFO

DIST. 34-34A=8.62'

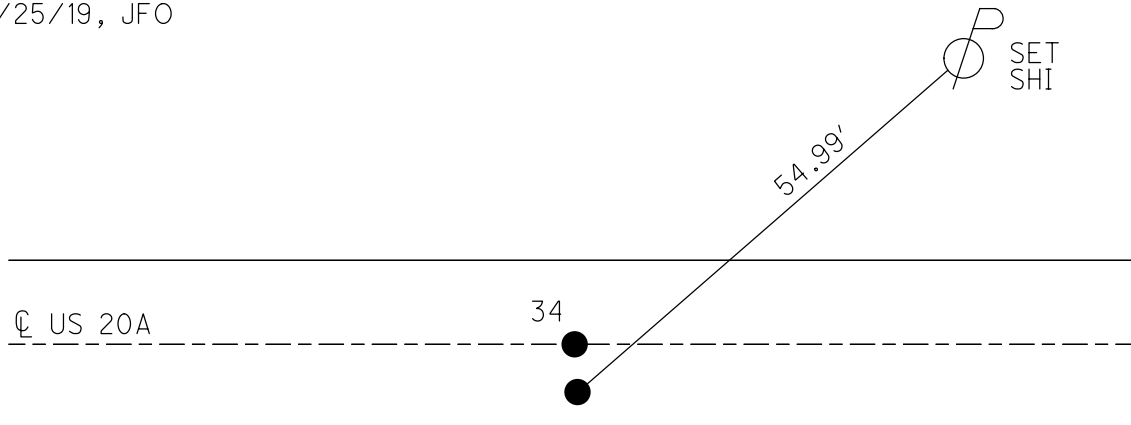

O.D.O.T. DISTRICT 2 SURVEY OFFICE (USE ONLY)

PERSONNEL

REFERENCE NO. 34 A

SHEET 61 OF 61

NOTES

HOMAN

DATE

9/16/04

ROUTE

US 20A

H.C.

CANTERBURY

WEATHER

CLOUDY

COUNTY

FULTON

R.C.

BARNHISEL

TEMP.

70°

TOWNSHIP

YORK

SECTION

16

T 7 N R 7 E

TYPE MONUMENT

P.K.NAIL

ON SURFACE - ~~BELOW~~

ON

LEFT - C PAV'T - RIGHT

8.0'

5.5'


TO RT EDGE PAVEMENT

S.L.M.

875+64

GRID: NORTHING:

EASTING:

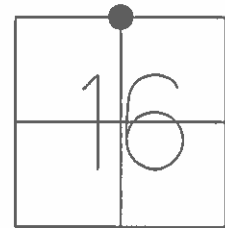

SET MAG/WASHER

10-13-04, DCH

C US 20A

34

DIST. 34-34A=8.65'

28.29'



SET N&S
NEAR FACE
6"X6" WOOD
POST BY
TELE PED

O.D.O.T. DISTRICT 2 SURVEY OFFICE

PERSONNEL

REFERENCE NO. 34

SHEET 7 OF 7

NOTES HOMAN

DATE 9-16-04

ROUTE U.S. 20-A

H.C. CANTERBURY

WEATHER CLOUDY

COUNTY FULTON

R.C. BARNHISEL

TEMP. 70°

TOWNSHIP YORK

SECTION 16

T 7 N R 7 E


TYPE MONUMENT PK NAIL

ON SURFACE - ~~BELOW~~ YES

LEFT - Q PAV'T - RIGHT A 0.6' LT B 8.0' RT


TO EDGE PAVEMENT A 14.0' RT
B 5.5' RT

S.L.M. 875+63 A, 875+64B

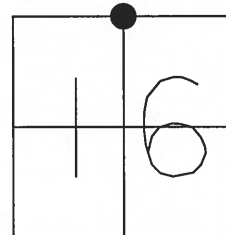

DIST A-B=8.65'

SET MAG NAIL
& WASHER
AT BOTH
LOCATIONS
10-13-04
DCH

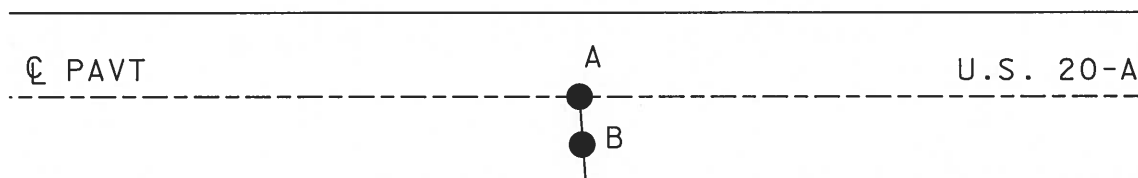

A=36.92'
B=28.29'

SET N&S
NEAR FACE
6"X6" WOOD
POST BY
TELE PED

O.D.O.T. DISTRICT 2 SURVEY OFFICE

PERSONNEL

REFERENCE NO. 34

SHEET 11 OF 24

NOTES 1. Stone

H.C. D. Curtis

R.C. J. Householder

DATE 17 Sept. 86

WEATHER Cloud

TEMP. 50°

ROUTE US#20-A

COUNTY Fulton

TOWNSHIP York

SECTION 16

T R


TYPE MONUMENT PK Nails

ON SURFACE - BELOW Surface



LEFT- & PAV'T. - RIGHT

TO EDGE PAVEMENT

S.L.M. 875+95

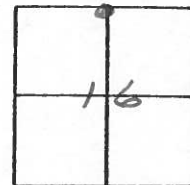


- ① SET P.K. NAIL TO SURFACE
 - ② SET P.K. NAIL TO SURFACE
- 4-29-88

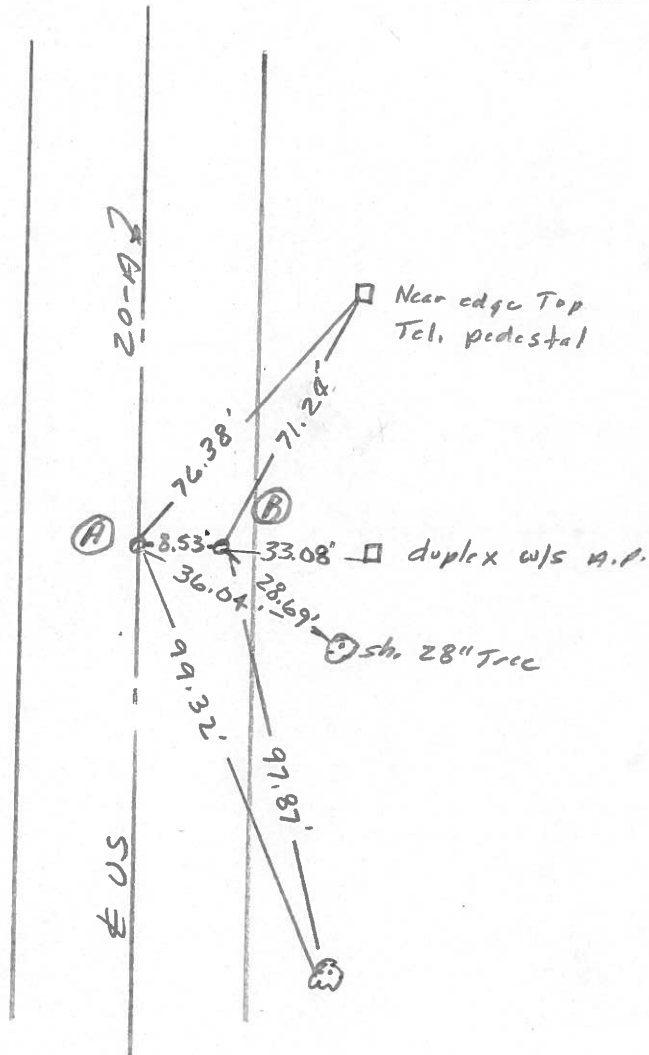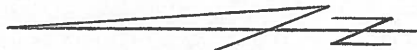


OF

42

(34)

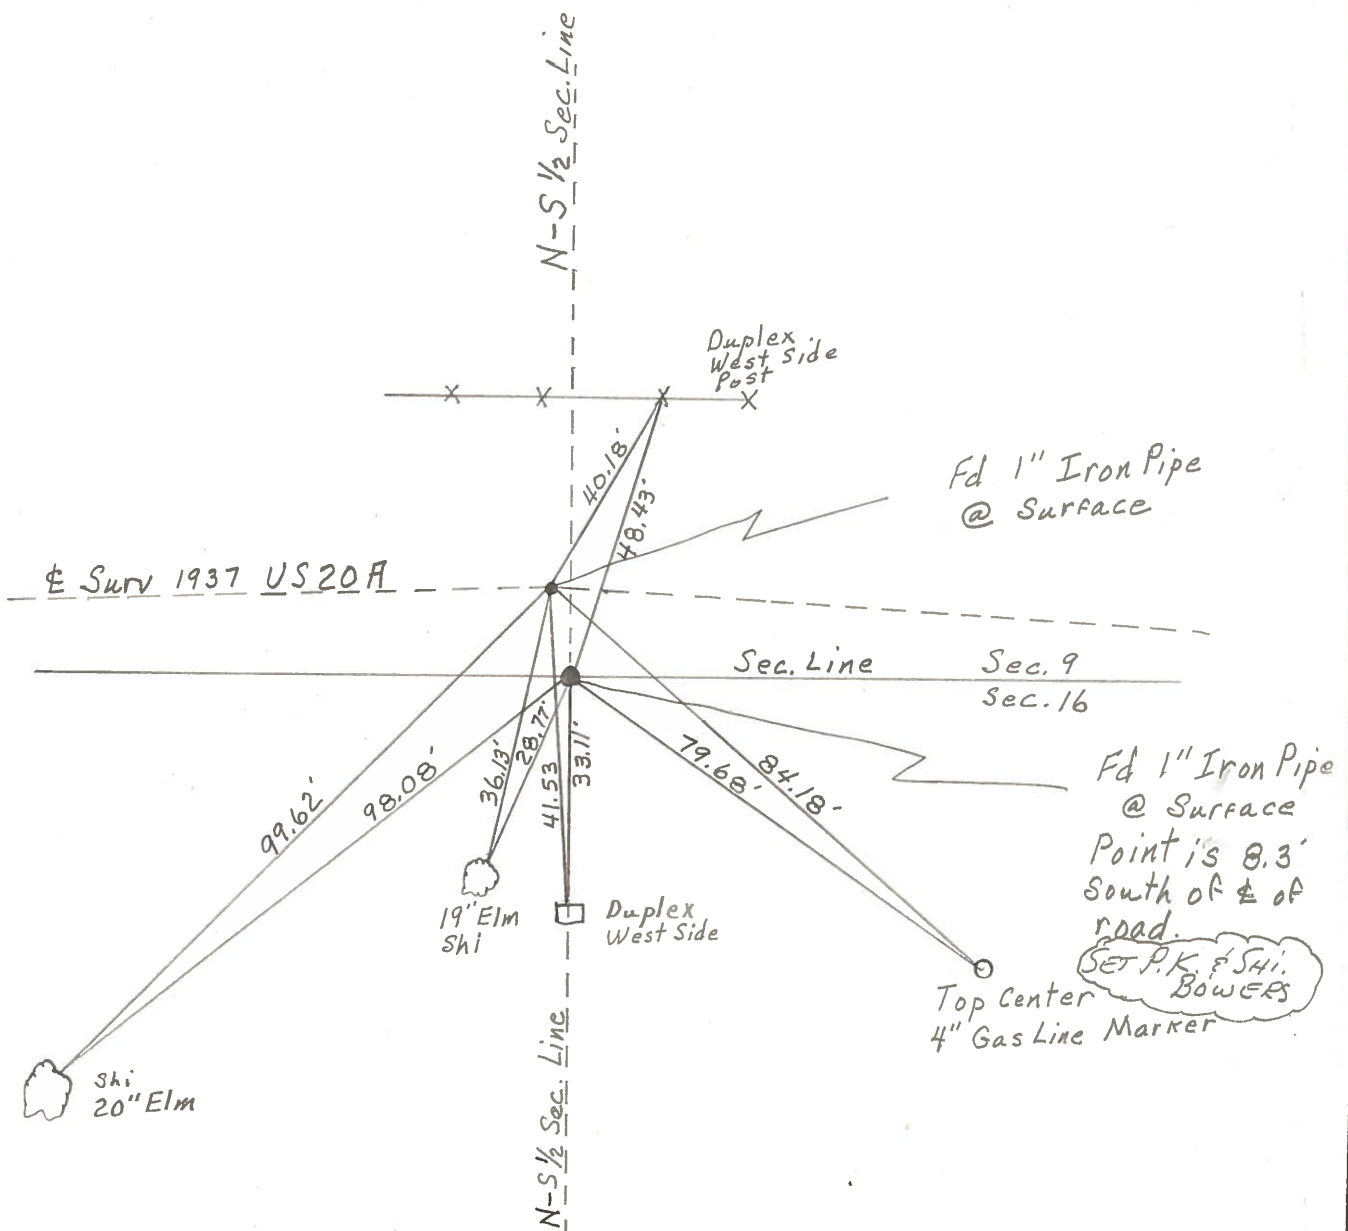

PERSONNEL	TITLE	PERSONNEL	TITLE	COUNTY	Fulton	DATE	April 18, 1973
Tomsic				S. R.	U.S. 20A	WEATHER	
Neuser				SEC.		TEMP.	
Granata							
Vanyo							

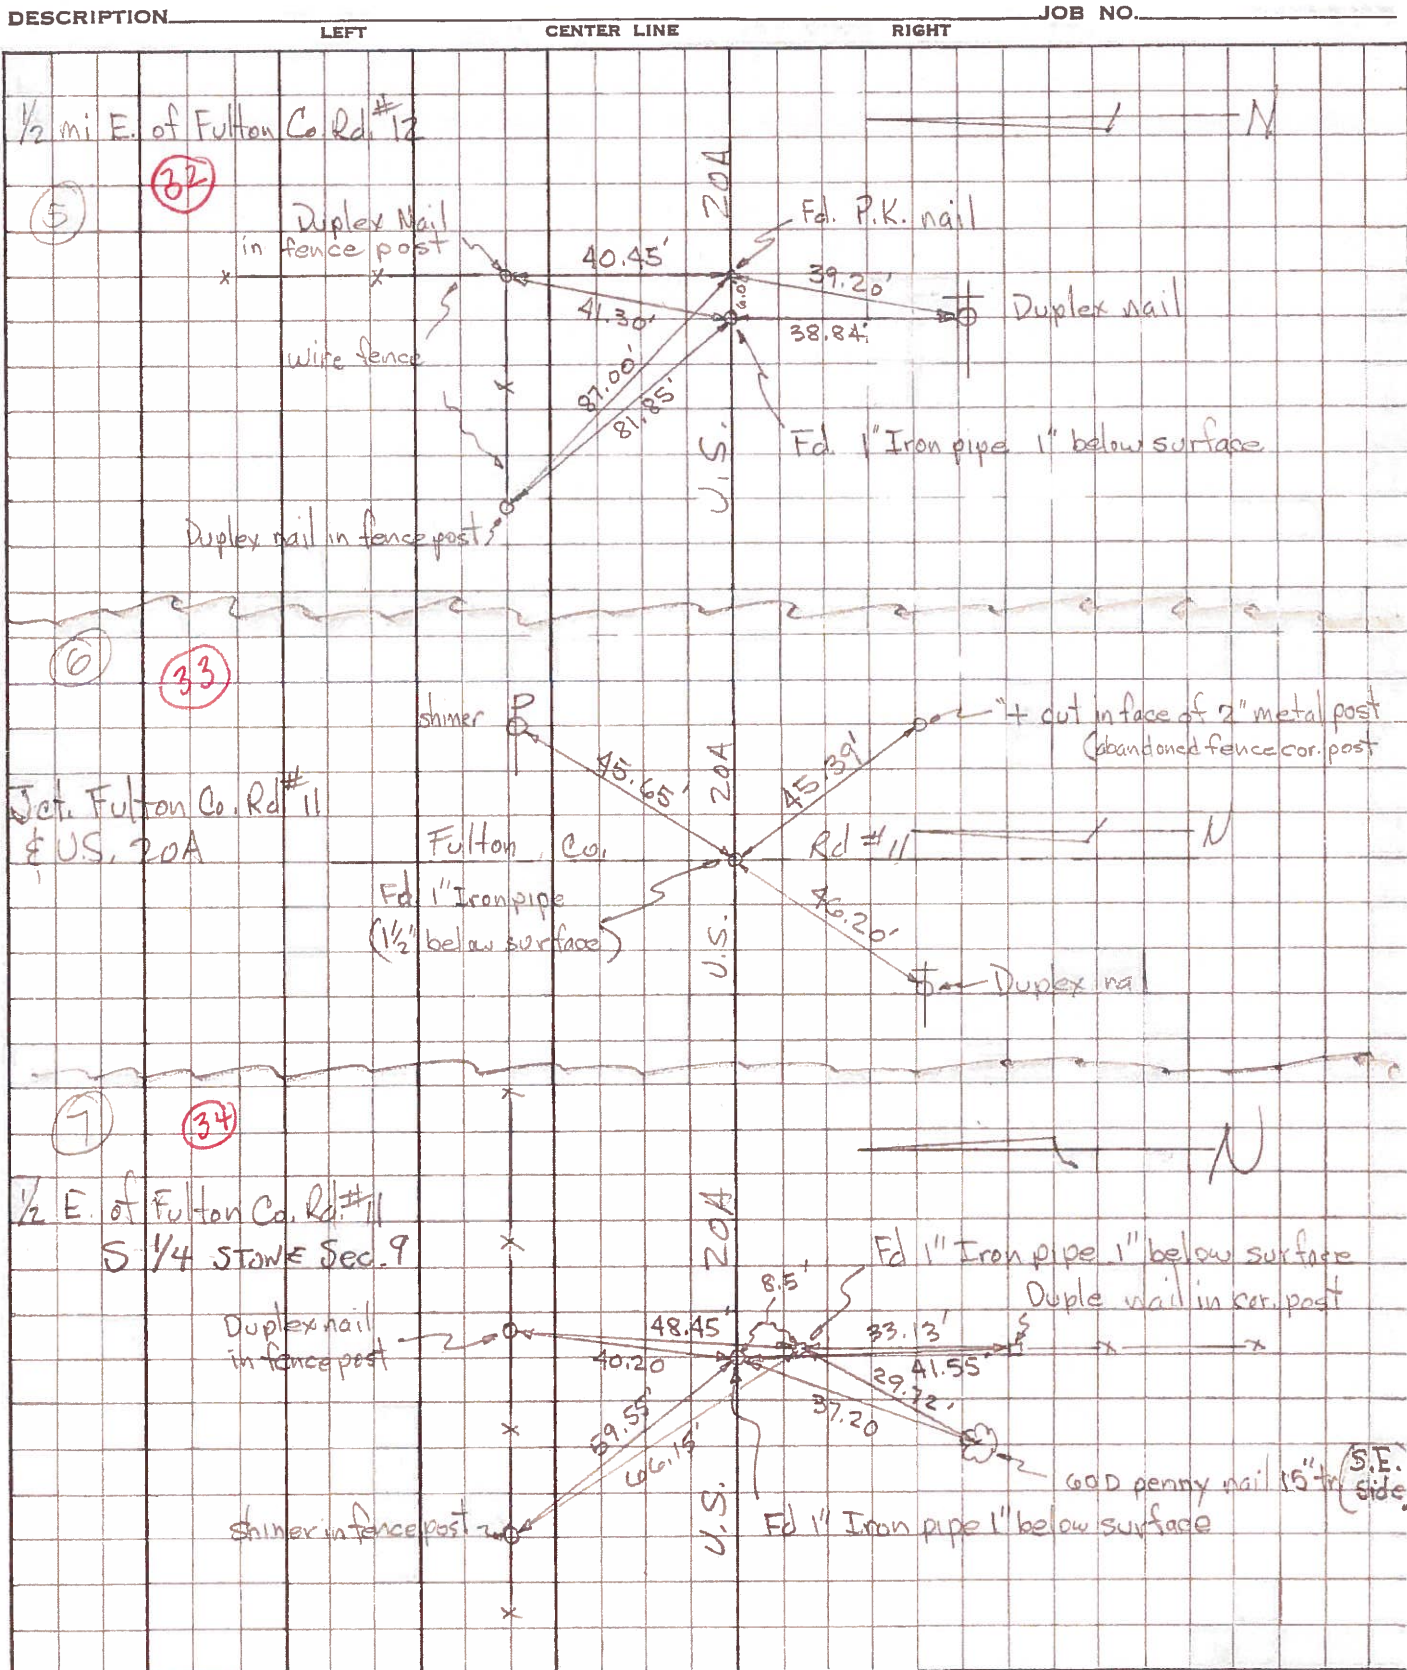

PERSONNEL TITLE PERSONNEL TITLE

Red Beach
Newcomb
Knape


COUNTY FULTON DATE Nov. 1971

S. R. US 20-A WEATHER _____

SEC. 16 YORK TWP T-7-N TEMP. _____

DESCRIPTION ALIGNMENT & CONTROLS JOB NO. _____

LEFT CENTER LINE RIGHT

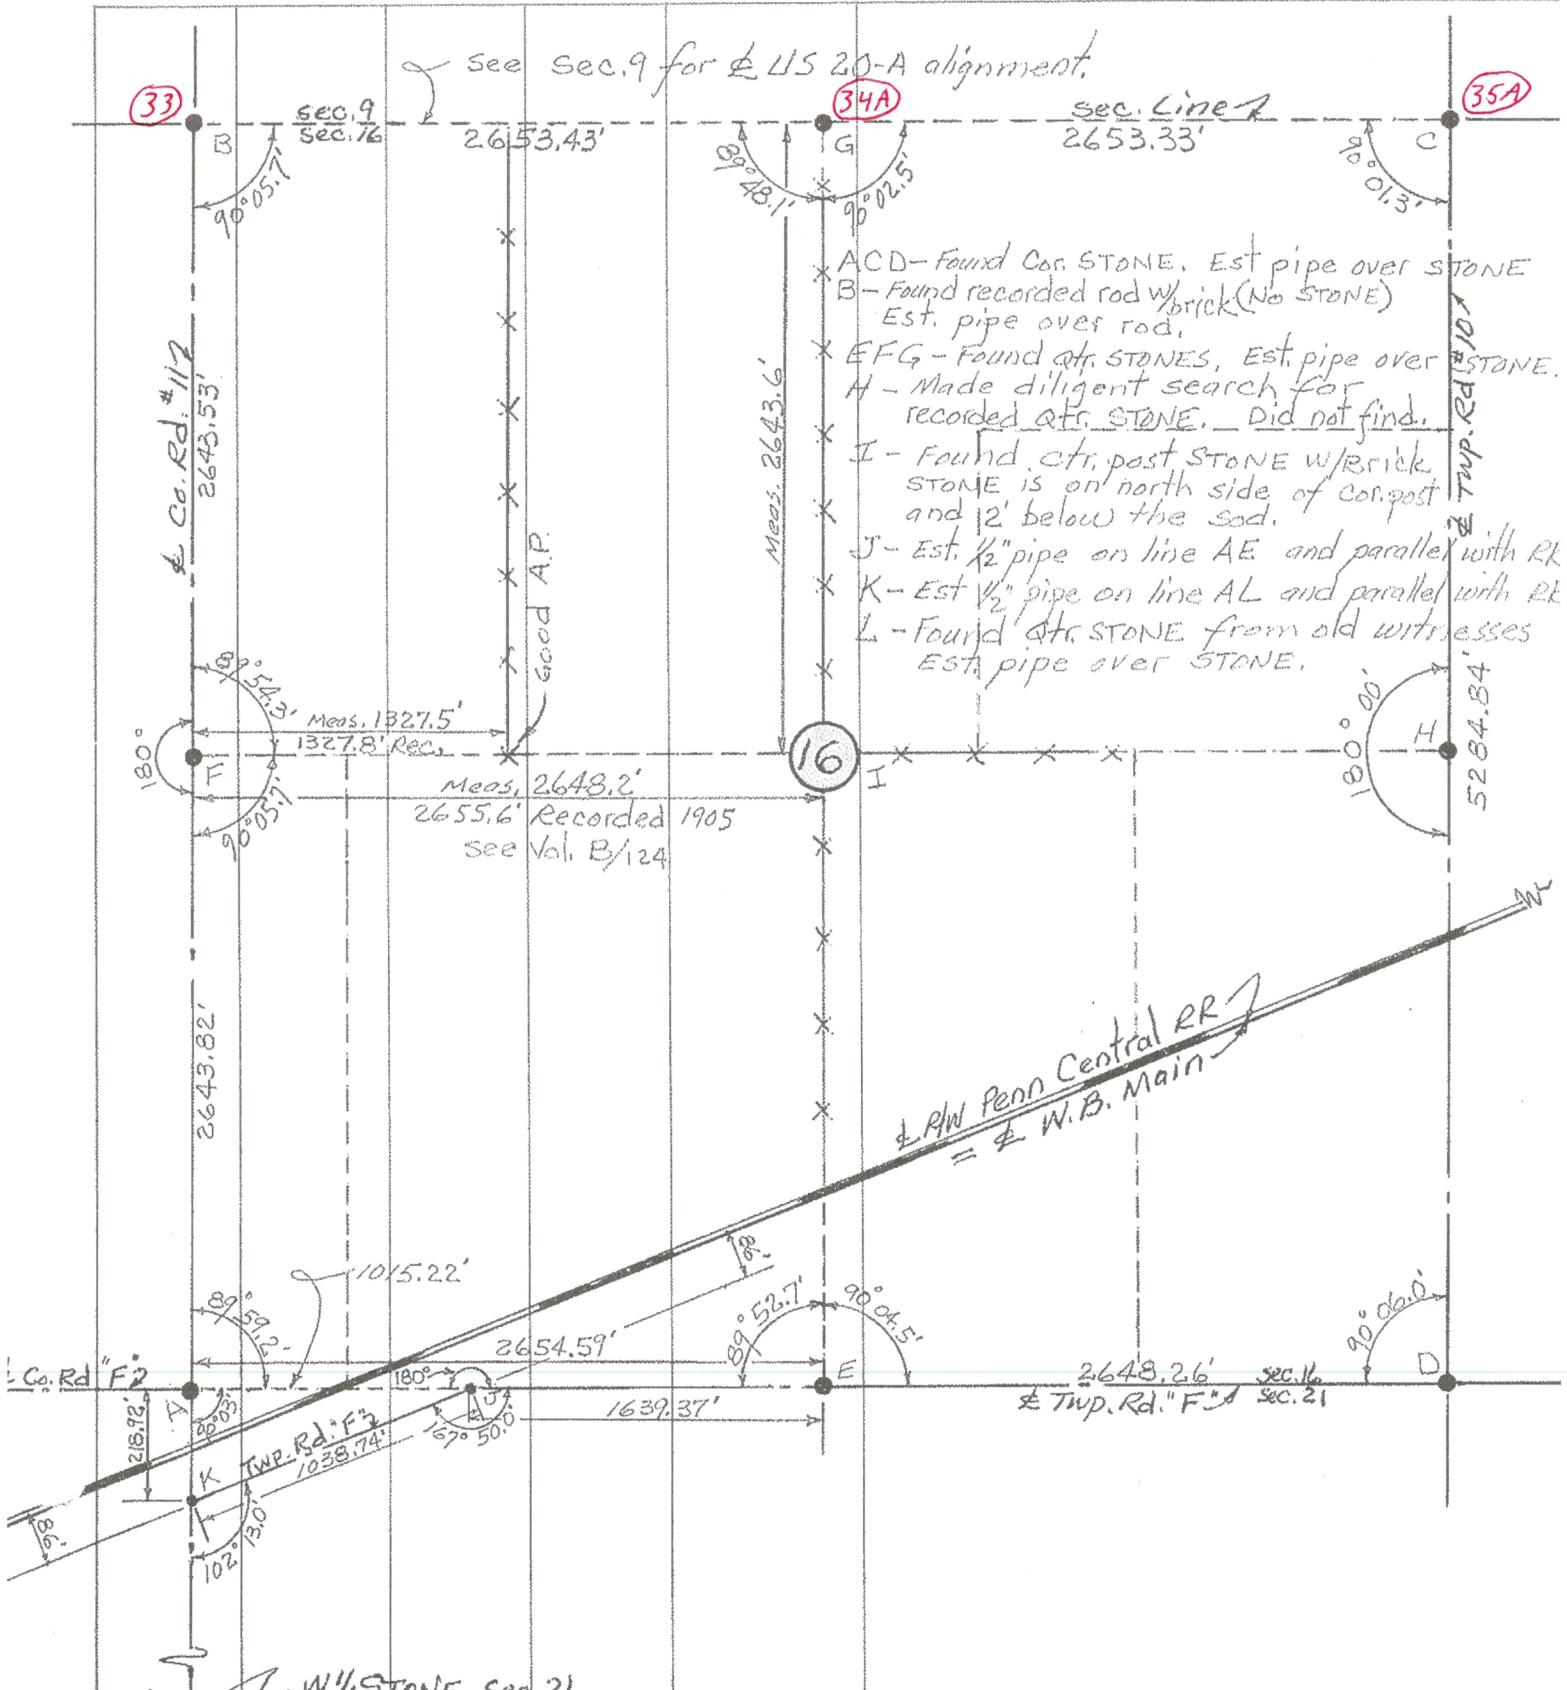

PERSONNEL TITLE PERSONNEL TITLE

Red Beach
Newcomb
KnapeCOUNTY FultonDATE Dec. 1971S. R. US 20-A

WEATHER _____

SEC. YORK TWP T-7-N

TEMP. _____

DESCRIPTION

CONTROL


POINTS

JOB NO. _____


LEFT

CENTER LINE


RIGHT

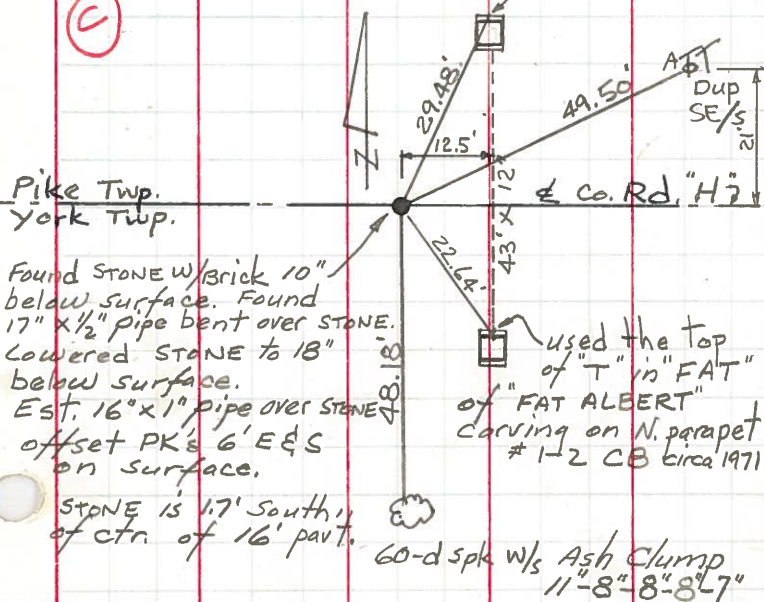S 1/4 STONE Sec. 6, Pike Twp. T-7-N
N 1/4 STONE Sec. 7, York Twp T-7-Nused the J in "J.R.D." carved in N. parapet
#1-2 CBSurvey (1937) for Δ @ Qtr. postFound PK 1" below from old witnesses
Found 10" x 3/4" Rod 3" below surfaceFound old wood stake
1" east of Bolt "B" and
16" below surface.Dug 4' deep hole in search
of qtr. Stone - did not find.Est. 24" x 1" pipe over bolt "B"
3 Jan 1972 bolt 6" x 3/8"

US 20-A

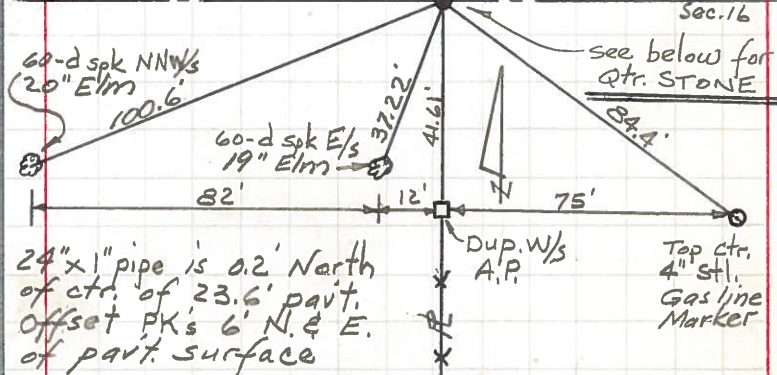

ctr. post STONE, Sec. 9 YORK TWP T-7-N

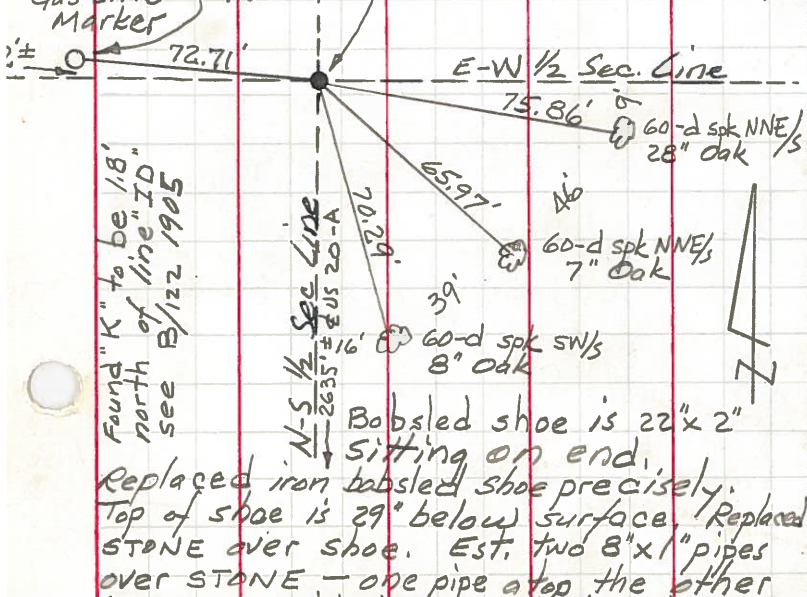Found large STONE 17" below surface
STONE has good Apex. Found old
stub wood AP west side of STONE & 10" below
surface.Found Recorded (B/122 1905)
Iron bobsled runner shoe
under STONE. 6 Jan. 1972Near side 4" stl. pipe
Gas Line
MarkerS 1/4 STONE Sec. 9 T-7-N YORK TWP
N 1/4 STONE Sec. 16 T-7-N

(34)

ctr. post, sec. 9

Dup W/s panel post

See above Bolt "B"

Surv. 1937 US 20-A

Sec. Line

Found Qtr. STONE 11 Jan. 1972

Dup W/s AP.

Top ctr. 4" stl. Gasline Marker

Qtr. STONE is 8.3' south of ctr. of 23.6' part.

offset PK's 6' N & E.

chiseled "+" top ctr of STONE & Est 28" x 1" pipe over STONE.