

O.D.O.T. DISTRICT 2 SURVEY OFFICE (USE ONLY)

PERSONNEL

REFERENCE NO. 35 A

SHEET 2 OF 6

NOTES RHOADES

DATE 6/13/19

ROUTE US 20A

H.C. O'DONNELL

WEATHER CLOUDY

COUNTY FULTON

R.C. MILLER

TEMP. 59°

TOWNSHIP YORK

SECTION 16

DWG BY BALBAUGH

PID 101232

T 7 N R 7 E

TYPE MONUMENT MONBOX W/ 3/4" IPIPE

ON SURFACE - ~~BELOW~~ ON

OFFSET CL PAVEMENT ±8.88' ~~LT~~ : RT

TO EDGE PAVEMENT


STATION: 902+00.67

HORIZ.DATUM: NAD83 (2011)

GEOID: 2012A


GRID: NORTHING: 698447.978

EASTING: 1542518.640

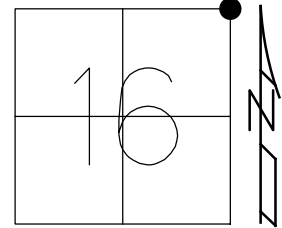

RECORD:
FD IPIPE
6" DOWN
FD STONE
24" DOWN
SET MONBOX
W/ 1 1/2" IPIPE
9/2/98, CL
FD MONBOX
W/ 3/4" IPIPE
REFA35
12/21/17, JFO
FD MONBOX
W/ 3/4" IPIPE
10/25/19, JFO

NOTE:
DIST. 35-35A= 8.88'

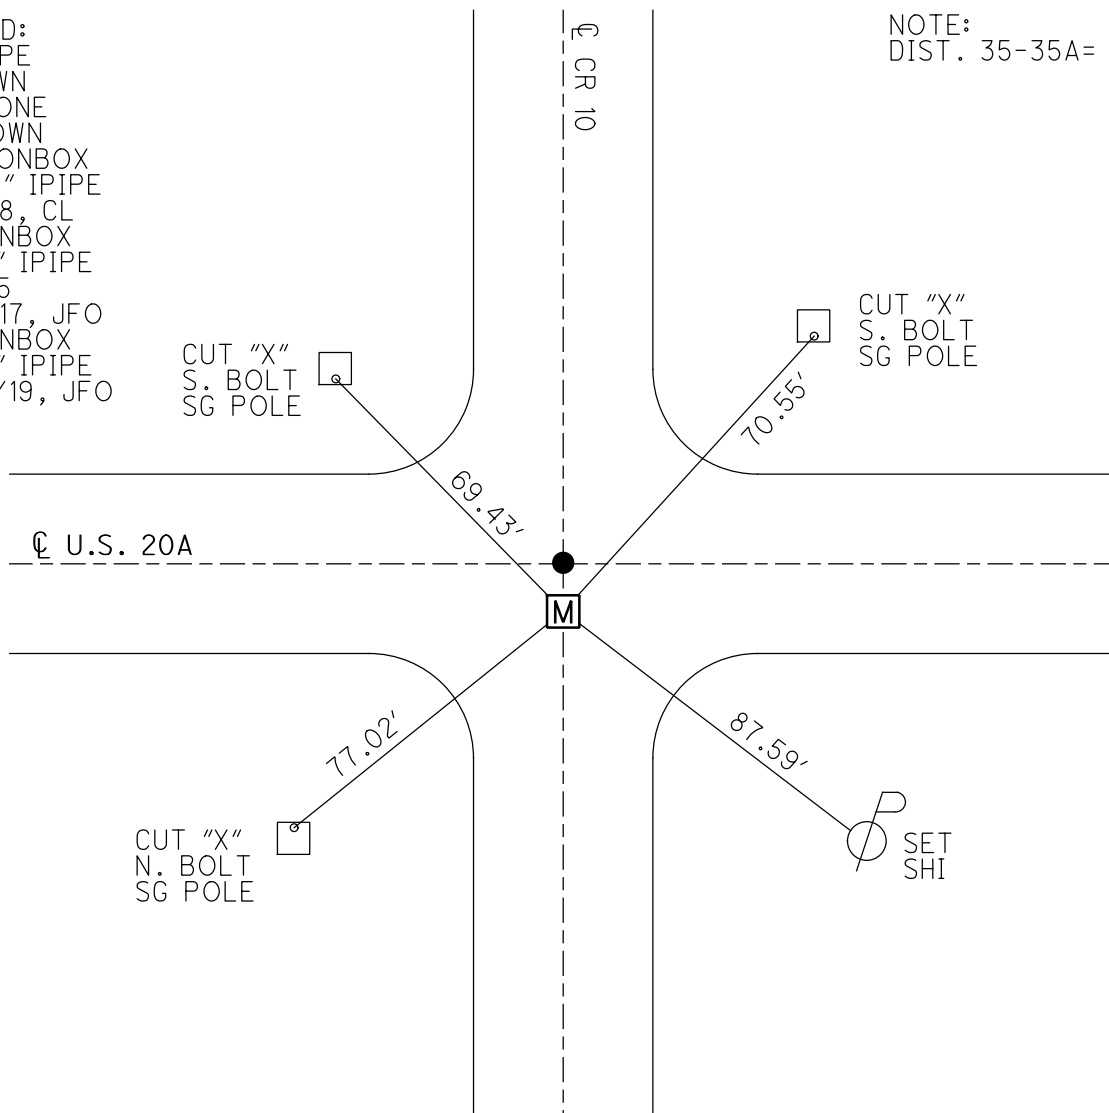

O.D.O.T. DISTRICT 2 SURVEY OFFICE

PERSONNEL

REFERENCE NO. 35

SHEET 1 OF 3

NOTES LOEHRKE

H.C. CORDES

DATE 9-2-98

ROUTE US 20-A

R.C.

WEATHER FAIR

COUNTY FULTON

TEMP. +18°C

TOWNSHIP YORK

SECTION SW of 10

T7 N R7 E

TYPE MONUMENT A = P.K. & Washer - & Survey / R/W


ON SURFACE - BELOW Yes

~~LEFT~~ - & PAW'T. - ~~RIGHT~~ Yes

JO EDGE PAVEMENT

S.L.M. 27+503.74

9	10
16	15

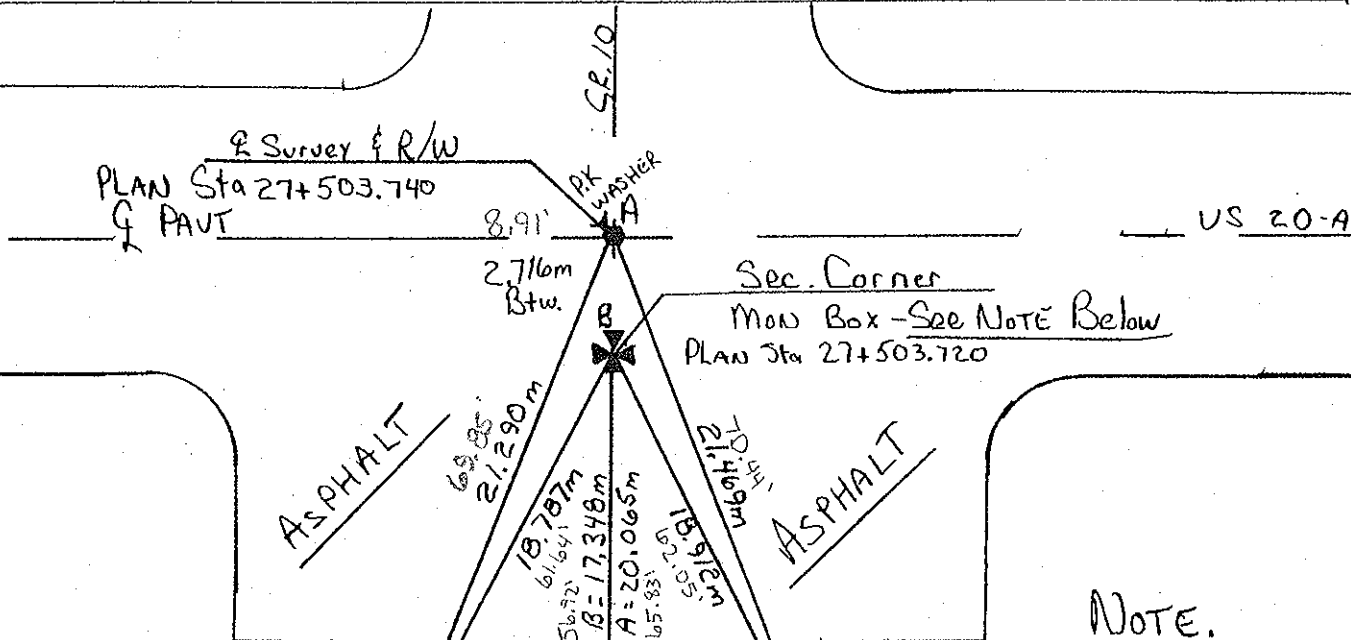

NOTE.

B = Mon Box Set
9-2-98

During INSTALLATION, A 1 1/2" IRON PIPE WAS FD. ± 6" DEEP. PIPE WAS REMOVED AND A STONE WAS FD ± 24" DEEP. (STONE LEFT UNDISTURBED.) SAID 1 1/2" PIPE TO BE RESET OVER STONE IN ITS ORIGINAL LOCATION, COMMON TO STONE. SAID 1 1/2" PIPE TO ACT AS ROD INSIDE MON BOX.

R-S-T => Set P.K. NAILS
IN 2nd EXPANSION
JOINT South of US. 20-A

NOTE: P.K. NAIL & ROD IN Mon.
Box Correspond with & Survey

PLAT for PLANS of
- 20A - (27.251)(28.869)
YORK Township

CORDE
PAW'T.
C.R. 10

Rebuilt to 3 Lanes 1998

O.D.O.T. DISTRICT 2 SURVEY OFFICE

PERSONNEL

REFERENCE NO. 35

SHEET 12 OF 24

NOTES 1. Stone

H.C. D. Curtis

R.C. J. Household

DATE 17 Sept. 86

WEATHER Fair

TEMP. 530

ROUTE US #20-A

COUNTY Fulton

TOWNSHIP York

SECTION 9-10-15-16

T. R.

TYPE MONUMENT PK Nails

ON SURFACE - BELOW Surface

LEFT- & PAW'T. - RIGHT


TO EDGE PAVEMENT

S.L.M. 902+48

9	10
16	15



- ① SET P.K. NAIL TO SURFACE
 - ② SET P.K. NAIL TO SURFACE
- 4-29-88

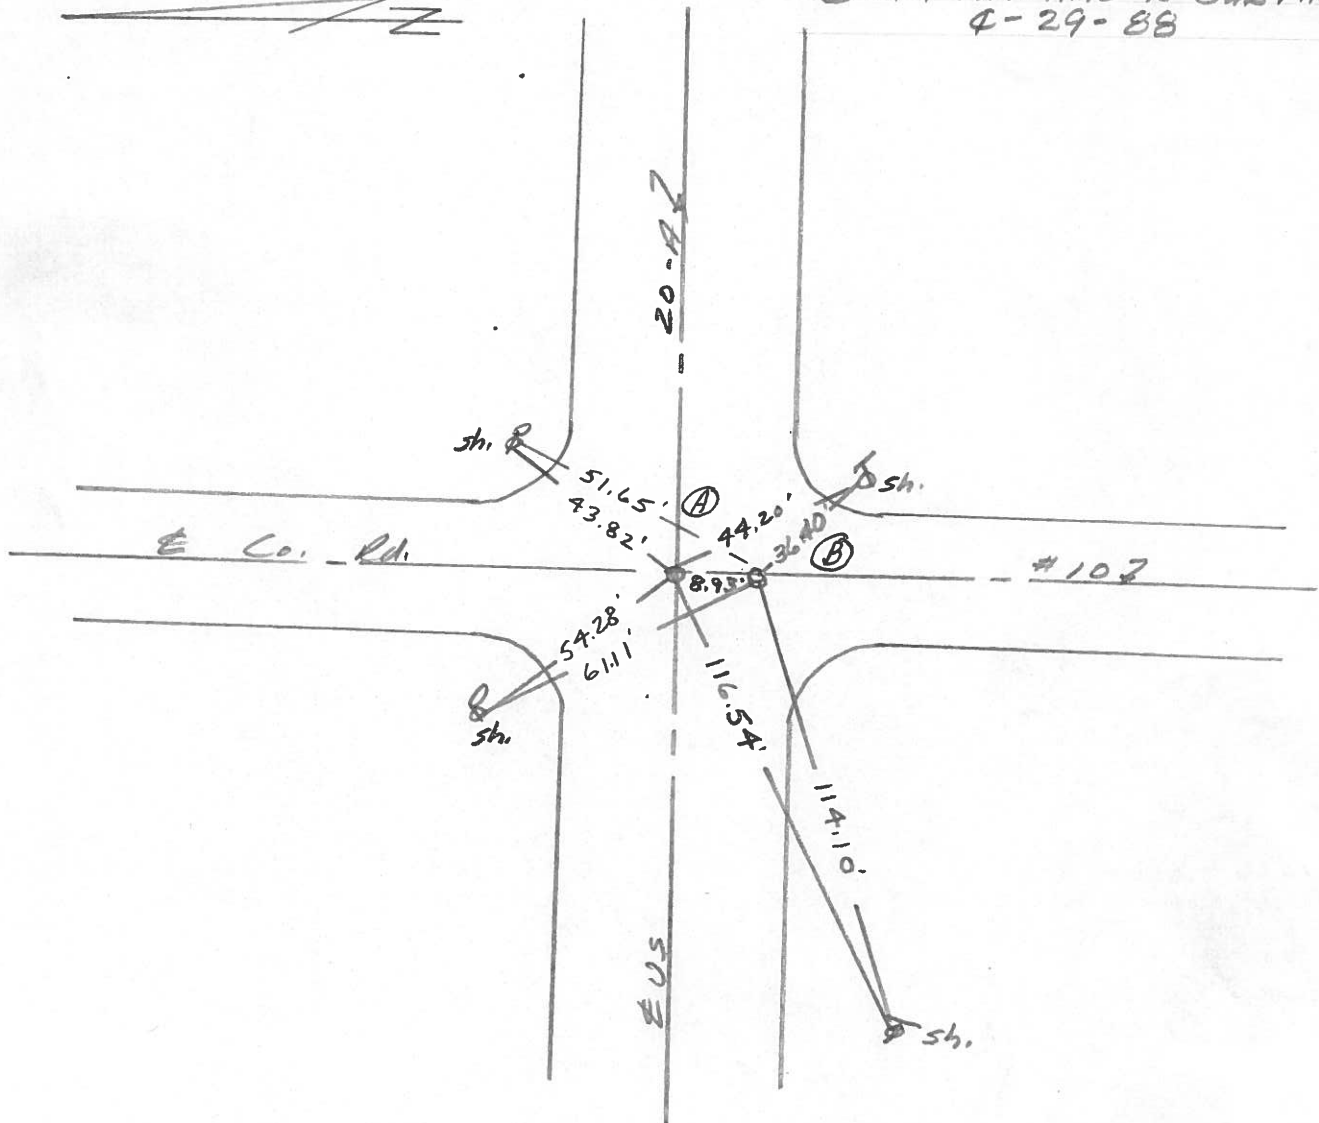

Q.D.O.T. DISTRICT 2 SURVEY OFFICE

SHEET _____ OF _____

County Fulton S.R. 2 & US 20A

Date OK-10-16-80
6-6-1980

Township York


Weather Clear

Section NW Cor. Sec. 15 NE Cor. Sec. 16


Temp. + 82°

T1N, R7E
SE Cor. Sec. 9 SW Cor. Sec. 10

Personnel Smith
Bowers
Mead

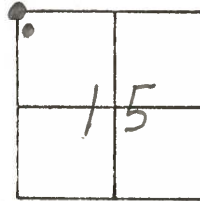


(35)

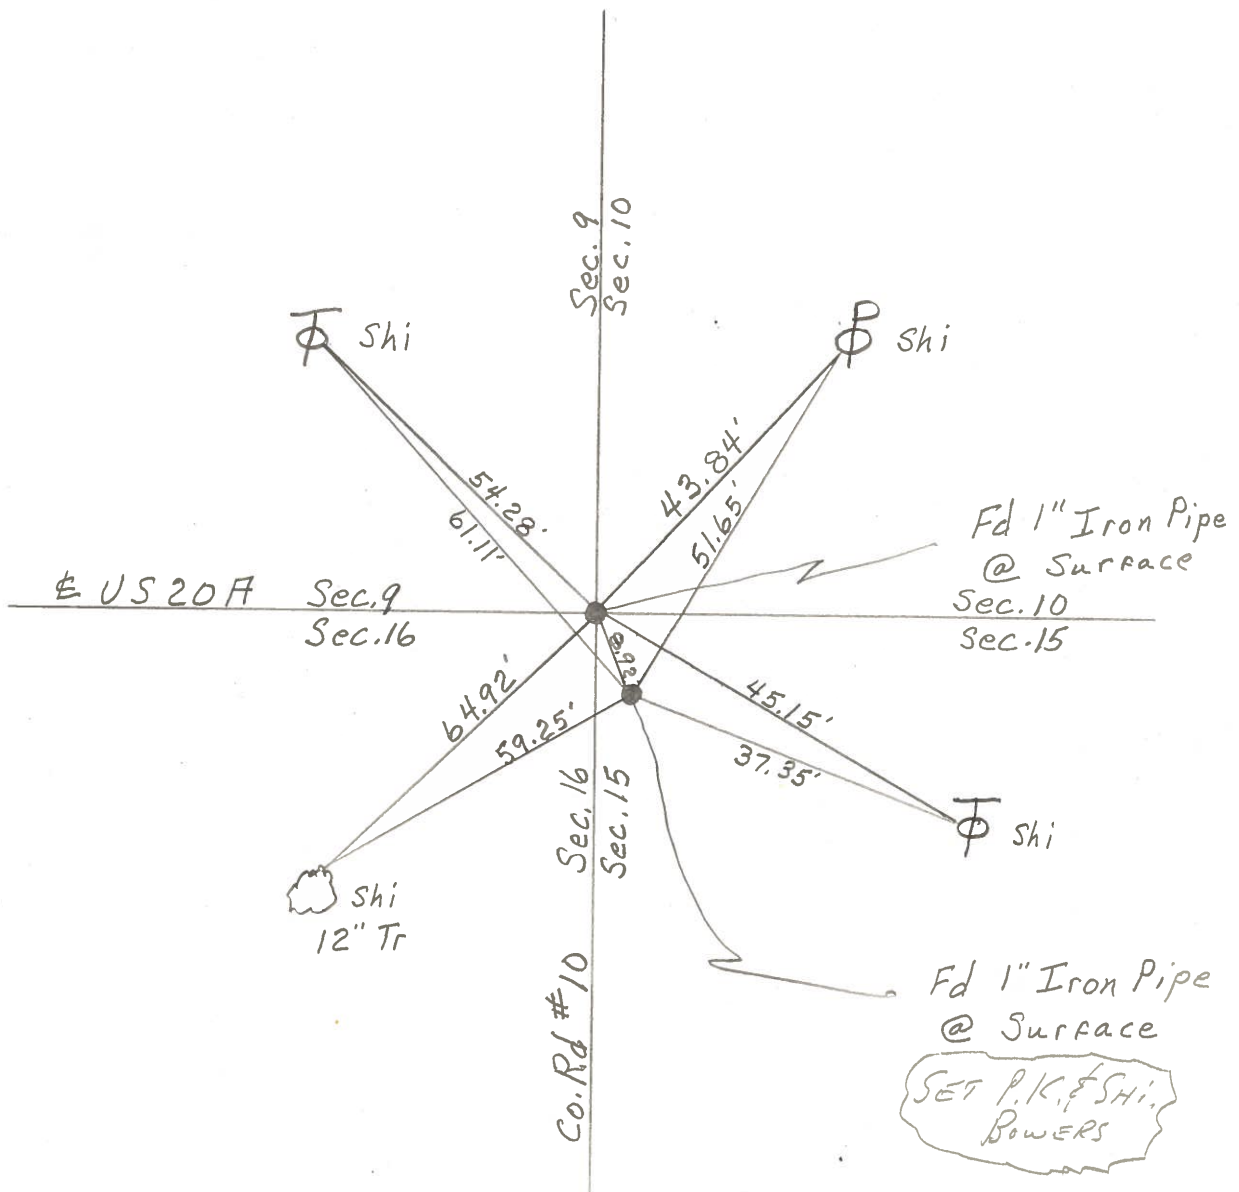

PERSONNEL	TITLE	PERSONNEL	TITLE	COUNTY	DATE	WEATHER	TEMP.
Tomsic				Fulton	April 19, 1973		
Weuser				S. R. US. 20A			
Granata							
Vanyo				SEC.			

DESCRIPTION	LEFT	CENTER LINE	RIGHT	JOB NO.
-------------	------	-------------	-------	---------

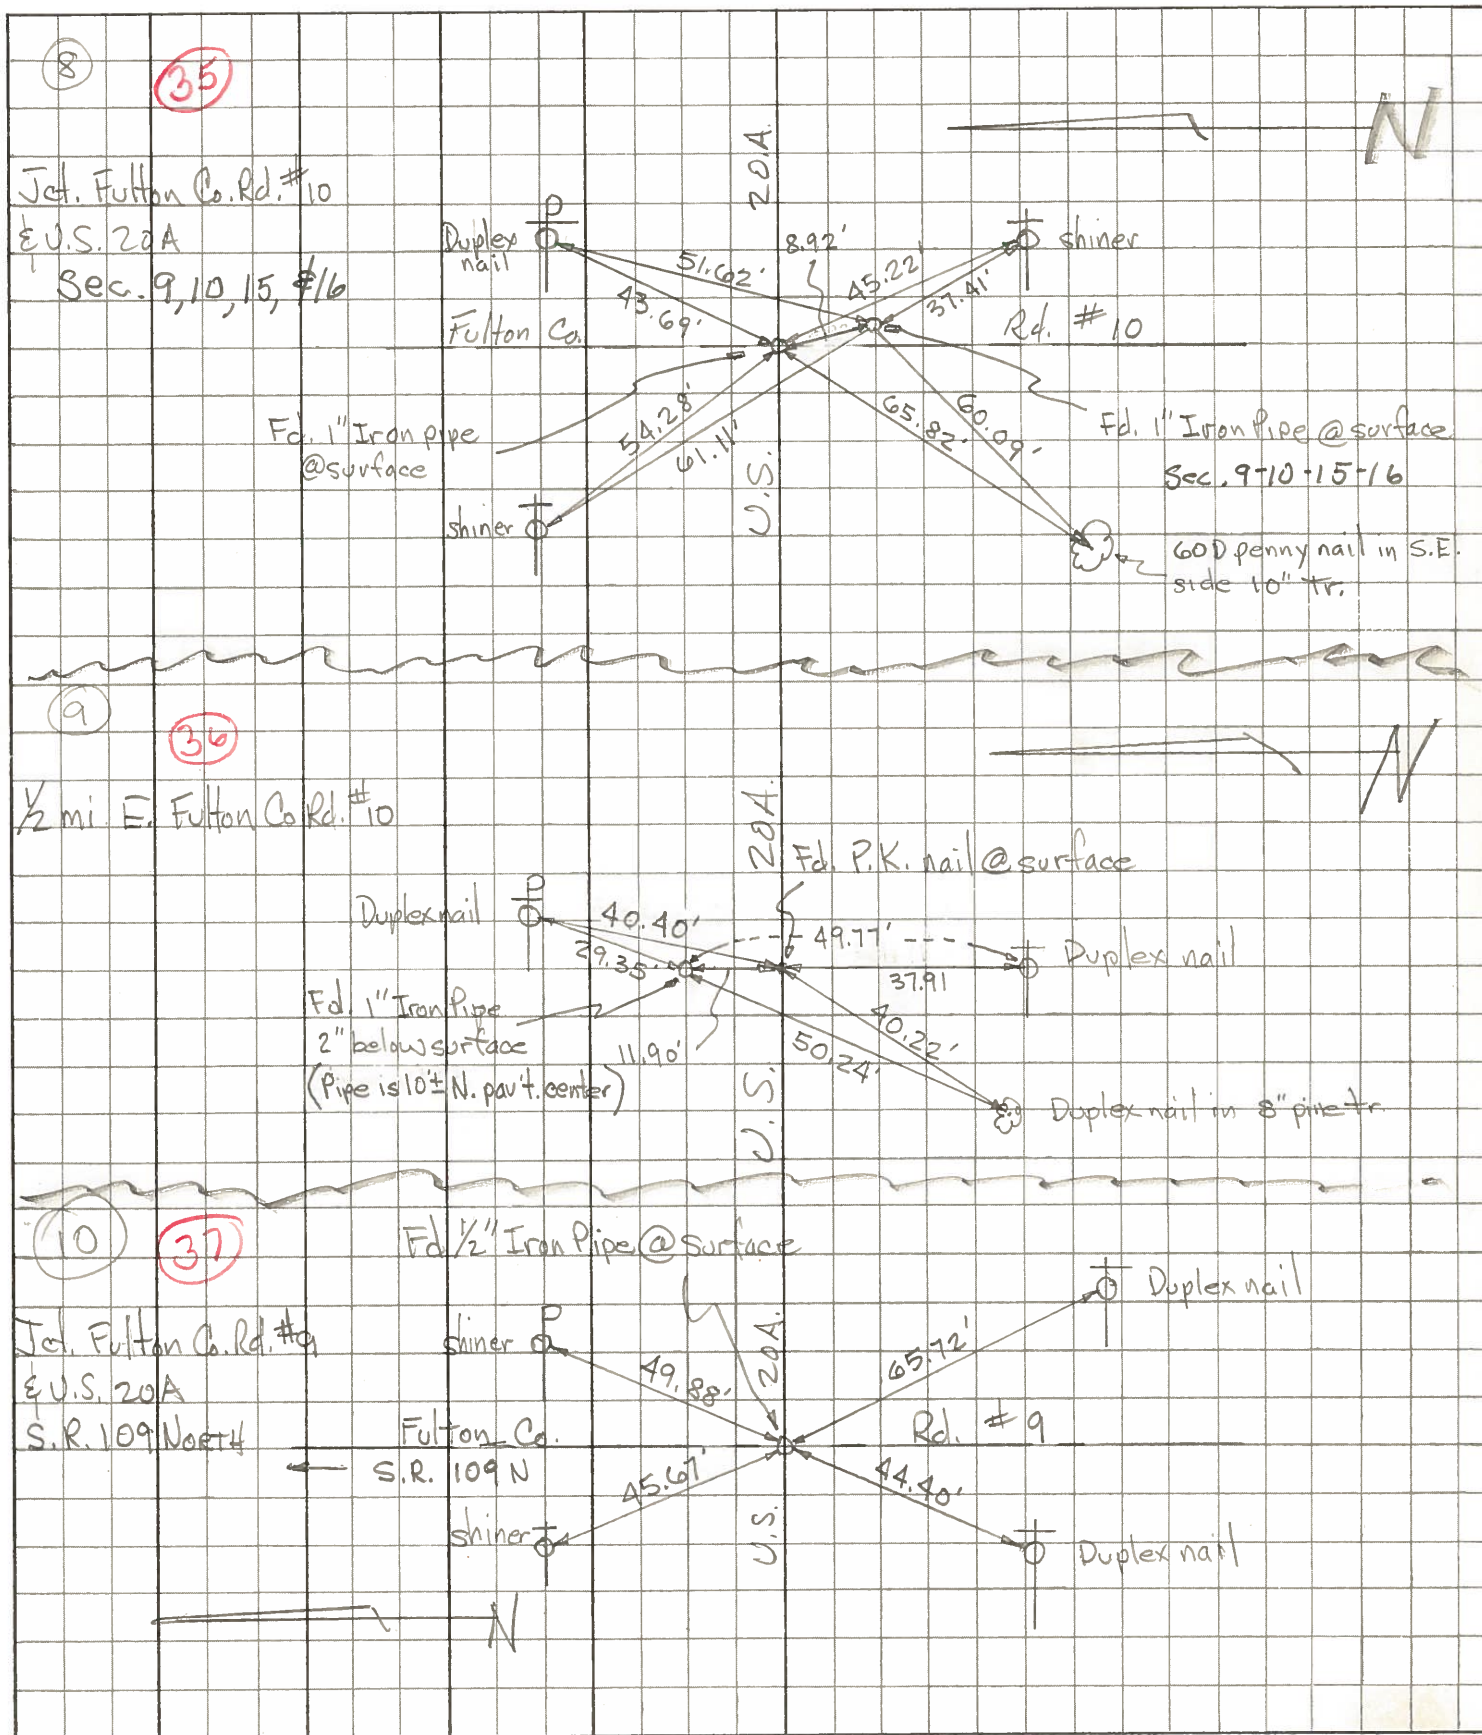

PERSONNEL	TITLE	PERSONNEL	TITLE
-----------	-------	-----------	-------

Red Beach

Newcomb

Ктаре

K  W. Qtz. STONE, Sec. 10

COUNTY FULTON

DATE Nov, 1971

E. qtr STONE Sec. 10

S. R. US 20-A

WEATHER

SEC. 15, YORK TWP T-7-N TEMP.

DESCRIPTION


ALIGNMENT & CONTROLS

JOB NO.

LEFT

CENTER LINE

RIGHT

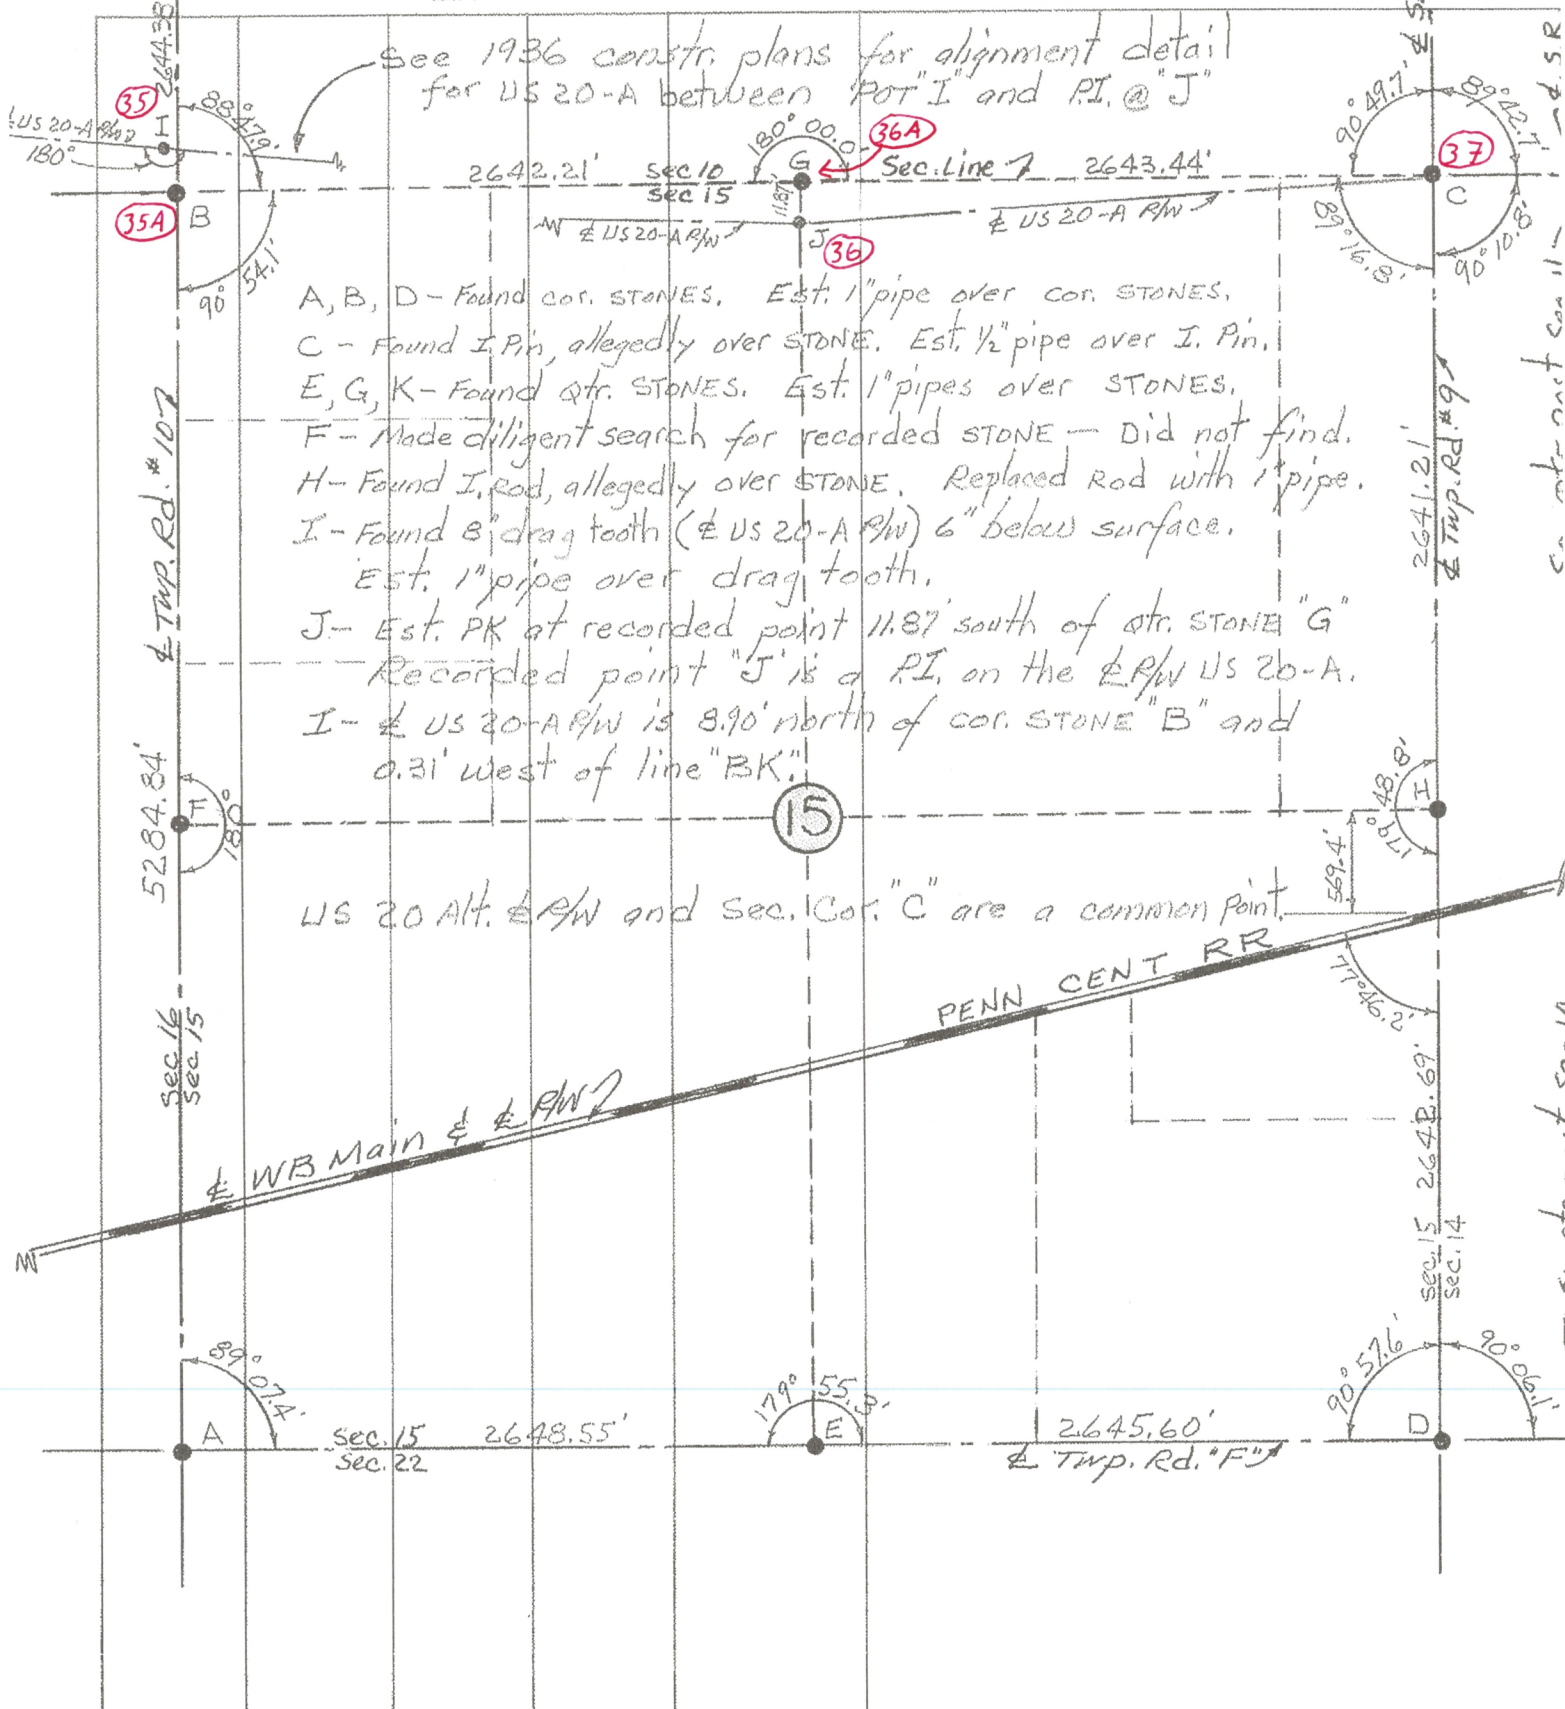

PERSONNEL TITLE PERSONNEL TITLE

Red Beach
Newcomb
Knape
WiseCOUNTY Fulton DATE Sept. 1971
S. R. US-20 Alt. WEATHERSEC. York Twp TEMP.

DESCRIPTION CONTROL POINTS JOB NO.

LEFT


CENTER LINE

RIGHT


JOB NO.

E 1/4 STONE, Sec. 9
W 1/4 STONE, Sec. 10YORK TWP.
T-7-N

Found 1/4 STONE 12" below surface

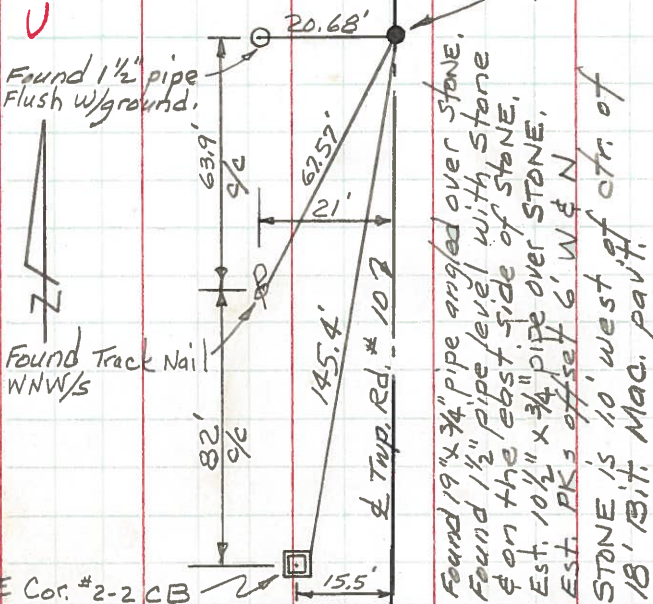
COR. STONE, Sec. 9, 10, 15 & 16 York Twp.
T-7-N

Found STONE w/brick & crockery 16" below surface.
STONE has good chiseled "+"
Found 11" pin approx. over "+"
Est. 14" x 1" pipe over STONE,
offset PK's 6' S & E on surface.

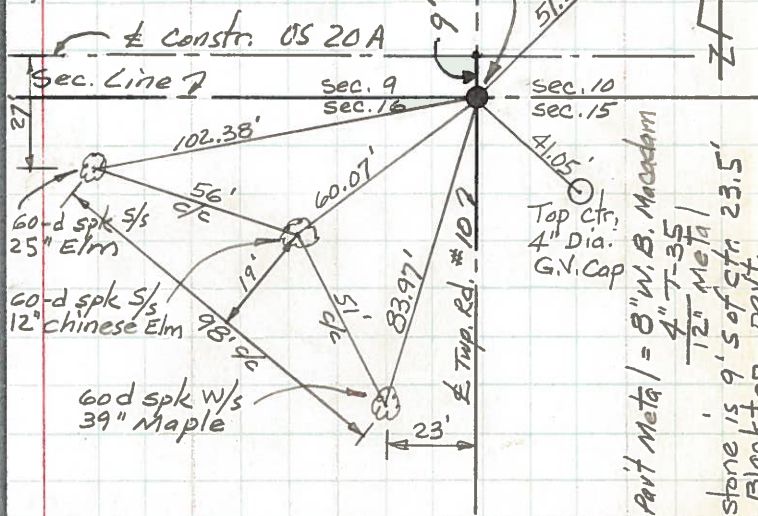
S 1/4 Stone, Sec. 4 Pike Twp.
N 1/4 Stone, Sec. 9 York Twp.

Between Rds. #10 & #11

Found stone w/tile and brick 4 1/2" below surface.
Found 18" x 1" pipe bent over stone.
Found PK's on surface 2' N. & E.
Lowered stone to 19" below surface.

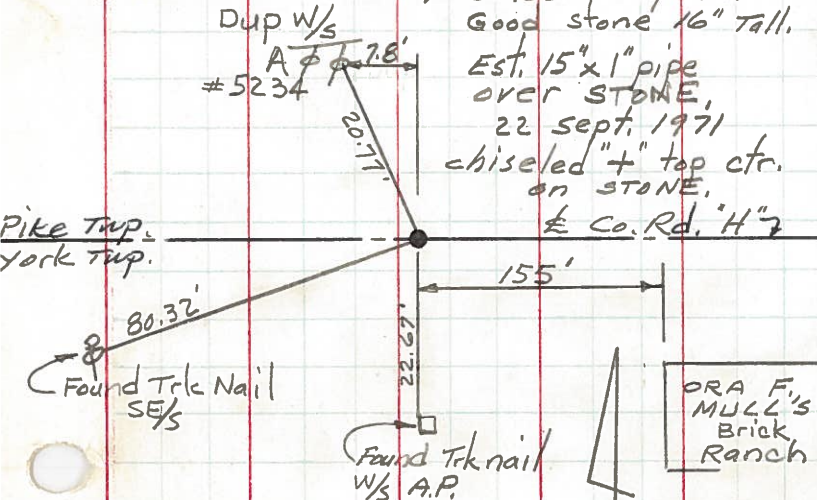COR. STONE, Sec. 15, 16, 21 & 22 York Twp.
T-7-N

Found cor. STONE w/tile 15" below surface.
Found 12" rod on surface over STONE.
chiseled "+" top ctr. of flat top stone.
Est. 13 1/2" x 1" pipe over STONE,
offset PK's 6' S & E on surface.

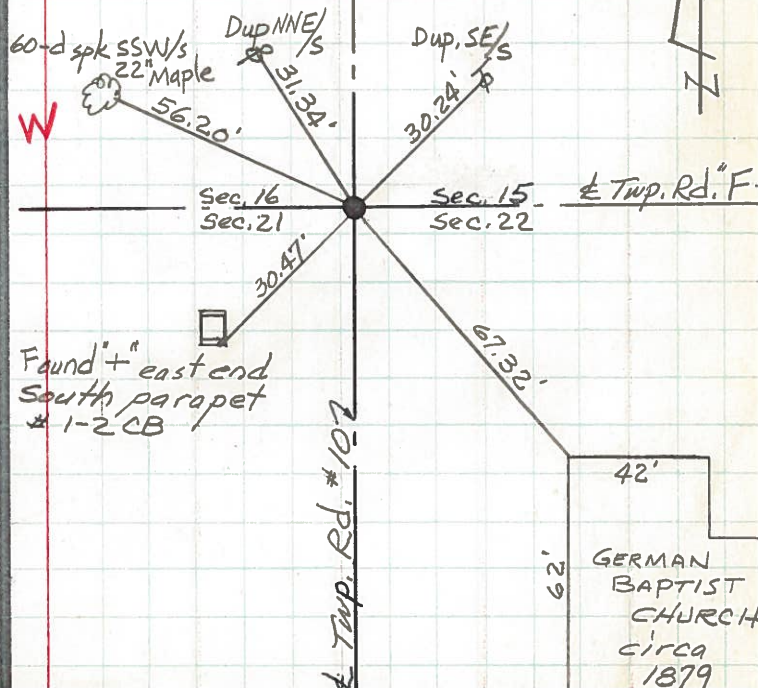

GERMAN
BAPTIST
CHURCH
circa
1879