

O.D.O.T. DISTRICT 2 SURVEY OFFICE (USE ONLY)

PERSONNEL

REFERENCE NO. 36

SHEET 3 OF 6

NOTES RHOADES

DATE 6/13/19

ROUTE US 20A

H.C. O'DONNELL

WEATHER CLOUDY

COUNTY FULTON

R.C. MILLER

TEMP. 60°

TOWNSHIP YORK

SECTION 15

DWG BY BALBAUGH PID 101232

T 7 N R 7 E

TYPE MONUMENT P.K.NAIL

ON SURFACE - ~~BELOW~~ ON

OFFSET CL PAVEMENT ON ~~LEFT~~ : ~~RIGHT~~

TO EDGE PAVEMENT


STATION: 928+42.66

HORIZ.DATUM: NAD83 (2011)

GEOID: 2012A


GRID: NORTHING: 698431.237

EASTING: 1545160.363

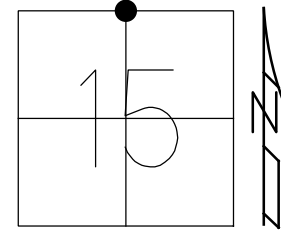

RECORD:
FD P.K./WASHER
9/3/98, CL
FD P.K.NAIL
4" DOWN
REF36
12/21/17, JFO
SET MAG/WASHER
10/25/19, JFO

NOTE:
DIST. 36-36A = 11.88'

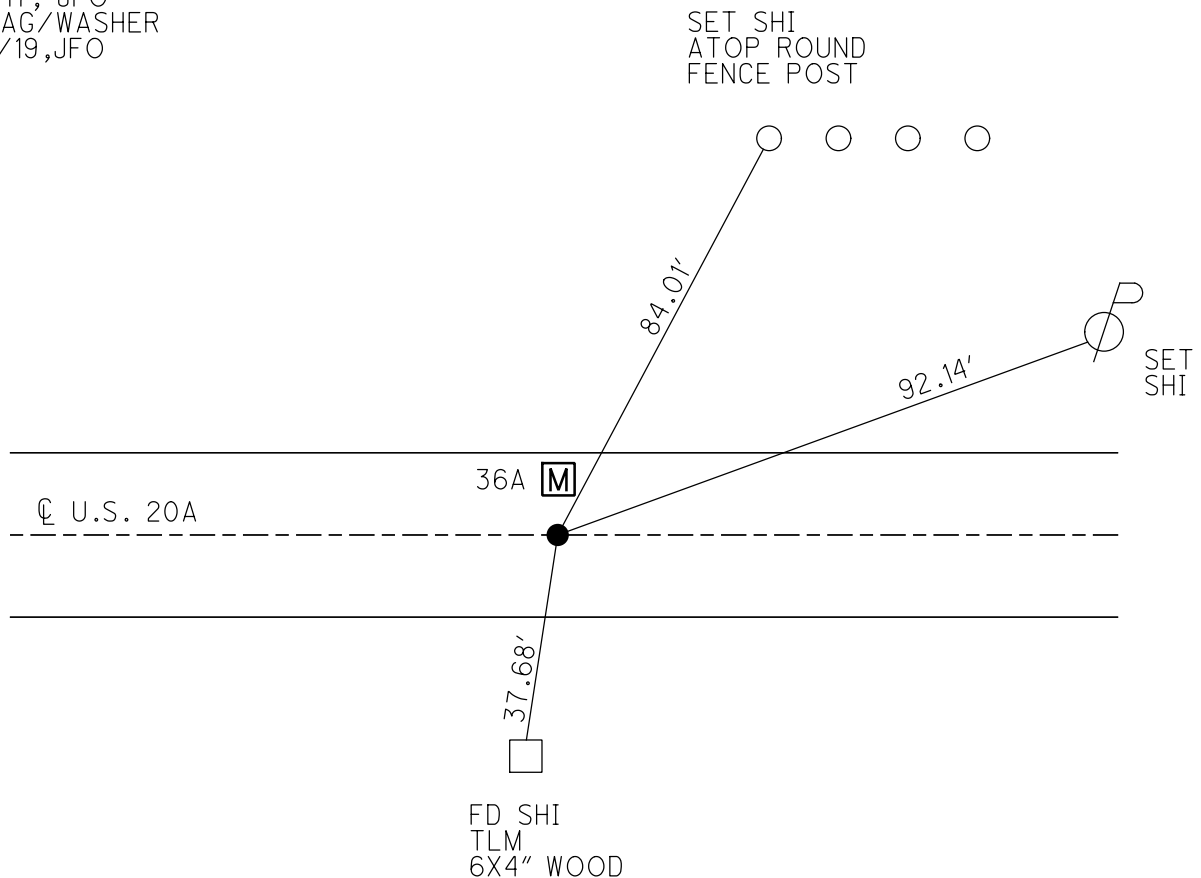

O.D.O.T. DISTRICT 2 SURVEY OFFICE

PERSONNEL

REFERENCE NO. 36

SHEET 2 OF 3

NOTES Loehrke

H.C. Cordes

DATE 9-3-98

ROUTE US 20-A

R.C.

WEATHER FAIR

COUNTY FULTON

TEMP. +18°C

TOWNSHIP YORK

SECTION 3 1/4 Corner of 10

T 7 N R 7 E


TYPE MONUMENT P.K. NAIL & WASHER Q Survey & R/W

ON SURFACE - BELOW Yes

~~FEET~~ - & PAW'T. - RIGHT Yes

TO EDGE PAVEMENT

S.L.M. 28+308.99

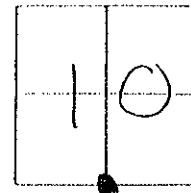

CONC.
Drive

Drillhole
B" from East
and South Edges

Drillhole
SW Corner

CONC. PAD
Utilities
Boxes

A to C = 19.986m

PLAN Sta. 28+308.940

See NOTE Lower Left.

Mon Box

Sec. Corner

US 20-A

Q Survey & R/W

PLAN Sta 28+308.985

29.750m

26.334m

3.670m

Q Survey and R/W

NOTE: B = Mon Box Installed 9-3-98

FD 1 1/2" PIPE OVER STONE: Reset PIPE in it's ORIGINAL

Position As Rod INSIDE Box; NOTE PIPE is

0.06 feet East of and ± 0.06 ft South of the

Stone. SAID PIPE & P.K. NAIL Correspond to

& PLAT of PLAN; FUL-20A-(27.25)(28.869)

York Township

PRINTED B LACK "t"
Near face Round Steel
fence Post.

O.D.O.T. DISTRICT 2 SURVEY OFFICE

PERSONNEL

REFERENCE NO. 36

SHEET 13 OF 24

NOTES 1. Stone

H.C. D. Curtis

R.C. J. Householder

DATE 17 Sept. 86

WEATHER Cool

TEMP. 56

ROUTE US # 20-A

COUNTY Fulton

TOWNSHIP York

SECTION 15

T_____R_____


TYPE MONUMENT PK Nail's

ON SURFACE - BELOW Surface


LEFT - & PAN'T. - RIGHT _____

_____ TO _____ EDGE PAVEMENT

S.L.M. 928+90

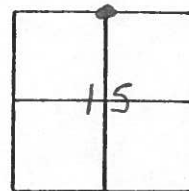

SET P.K. NAILS TO SURFACE
5-13-88

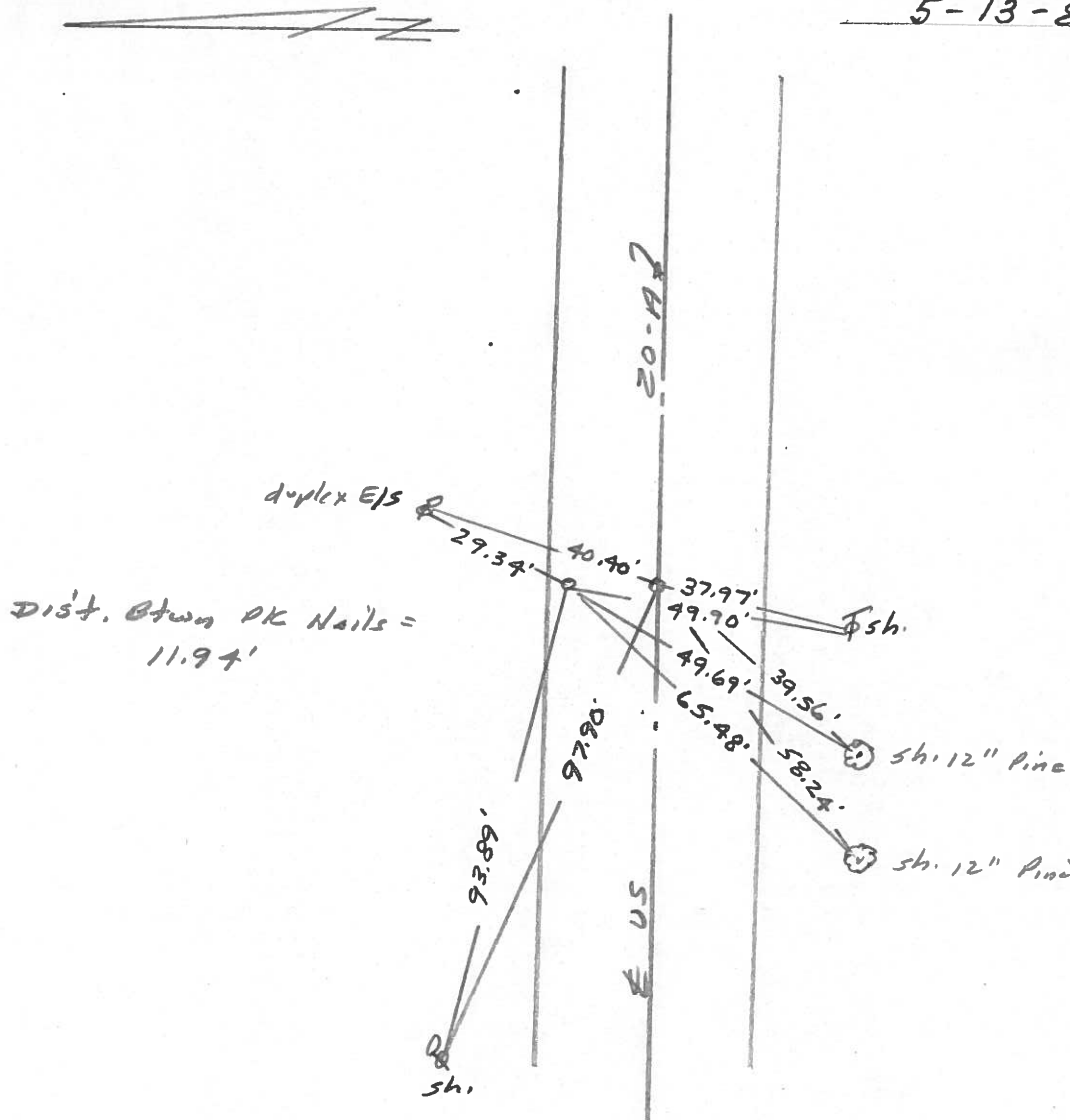

O.D.O.T. DISTRICT 2 SURVEY OFFICE

SHEET _____ OF _____

County Fulton S.R. 2 & US20A

Date OK-10-16-80
6-6-1980

Township York


Weather Clear

Section N 1/4 Cor. Sec. 15

Temp. + 82°

TZN, RZE


Personnel Smith
Bowers
Mead

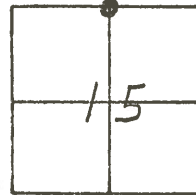

36

Fd 1" Iron Pipe
@ Surface
Pipe is 10'±
North of E Part

SET P.K. & Shi.
BOWERS

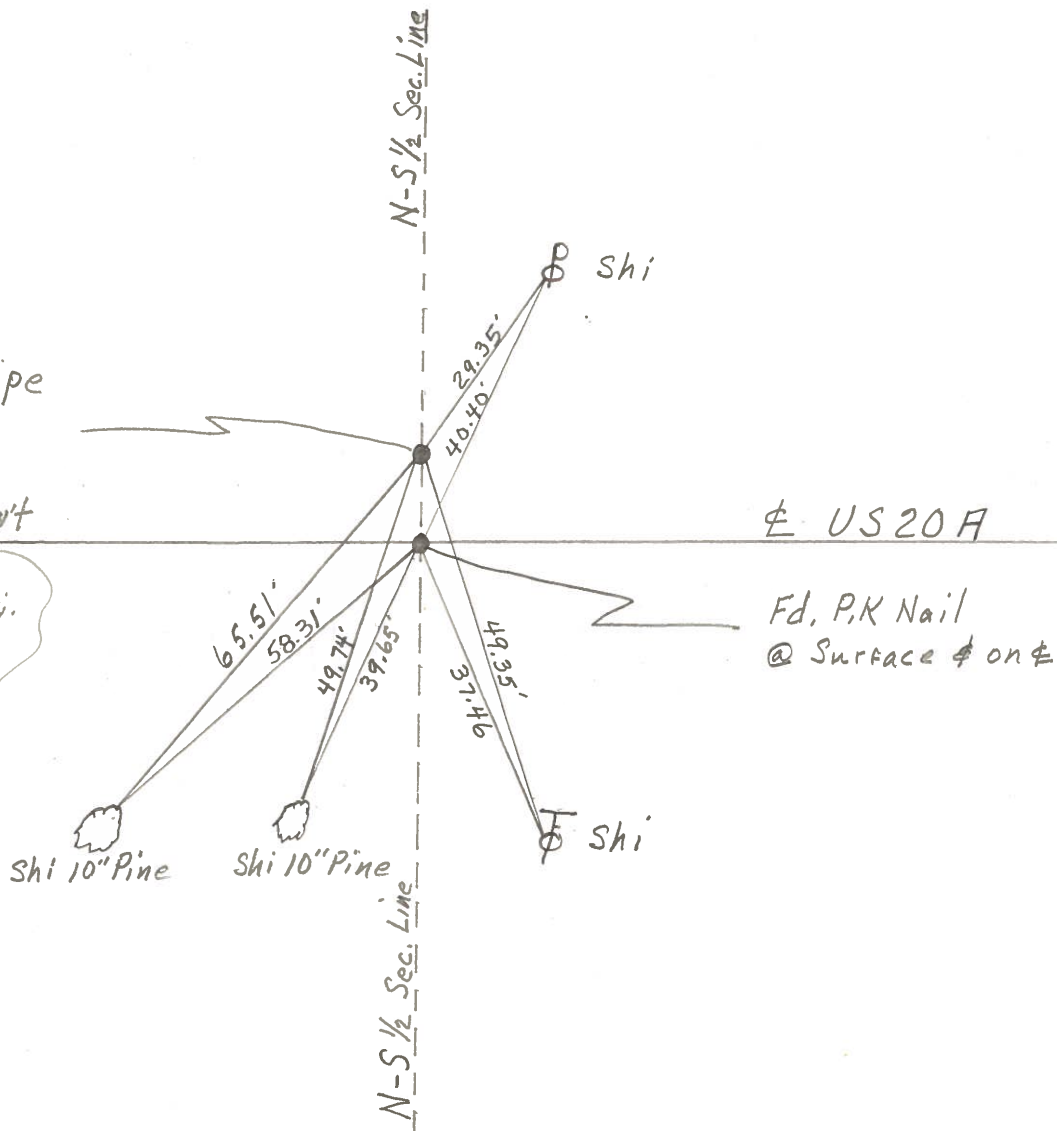


E US20A

Fd, P.K Nail
@ Surface & on E

PERSONNEL	TITLE	PERSONNEL	TITLE	COUNTY	DATE	WEATHER	TEMP.
Tomsic				Fulton	April 19, 1973		
Weuser				S. R. US. 20A			
Granata							
Vanyo				SEC.			

DESCRIPTION	LEFT	CENTER LINE	RIGHT	JOB NO.
-------------	------	-------------	-------	---------

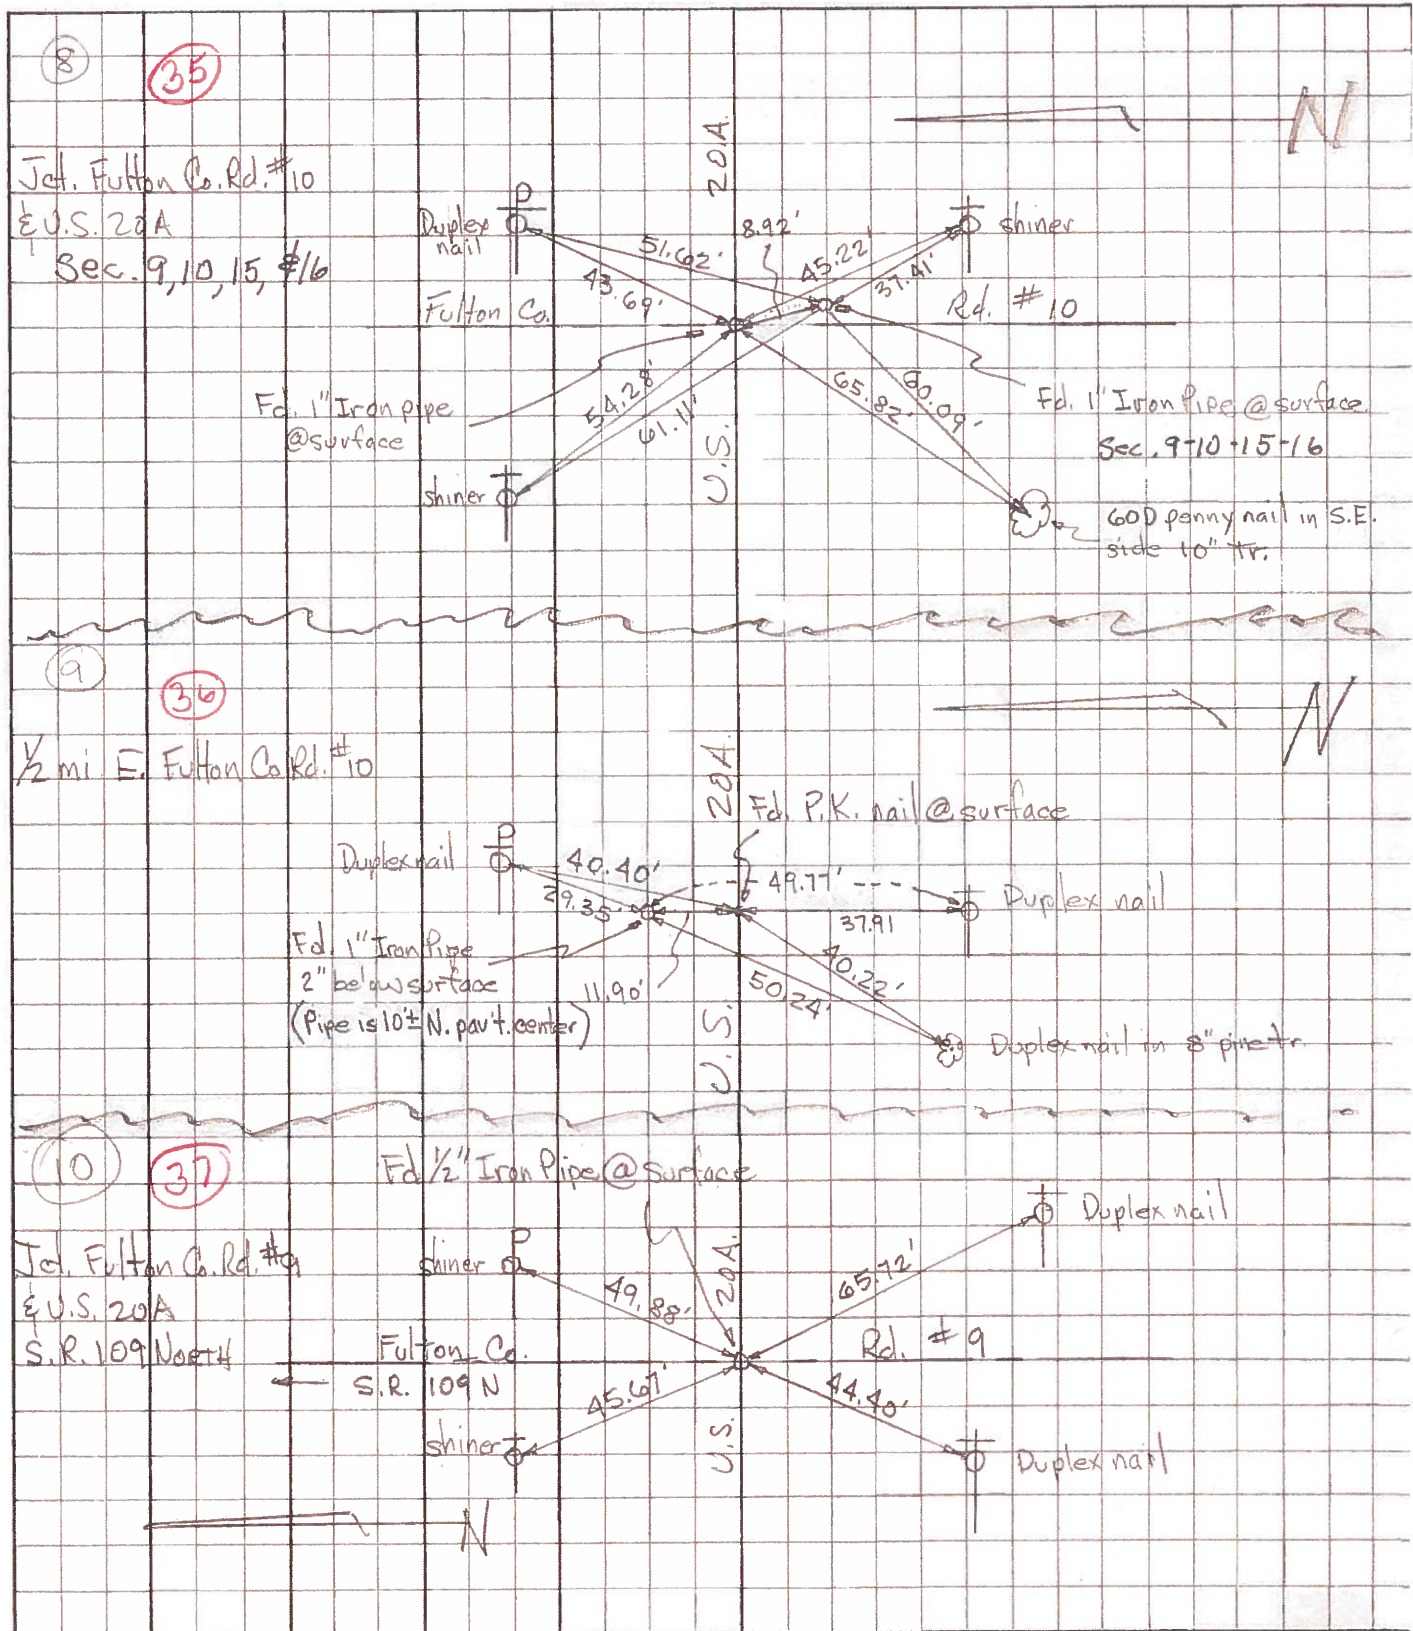

PERSONNEL TITLE PERSONNEL TITLE

Red Beach

COUNTY FULTON DATE SEPT. '71

Newcomb

S. R. US 20-A WEATHER _____

Knappe

SEC. 10, YORK TWP., T-7-N TEMP. _____

DESCRIPTION


ALIGNMENT & CONTROLS

JOB NO. _____

LEFT

CENTER LINE

RIGHT

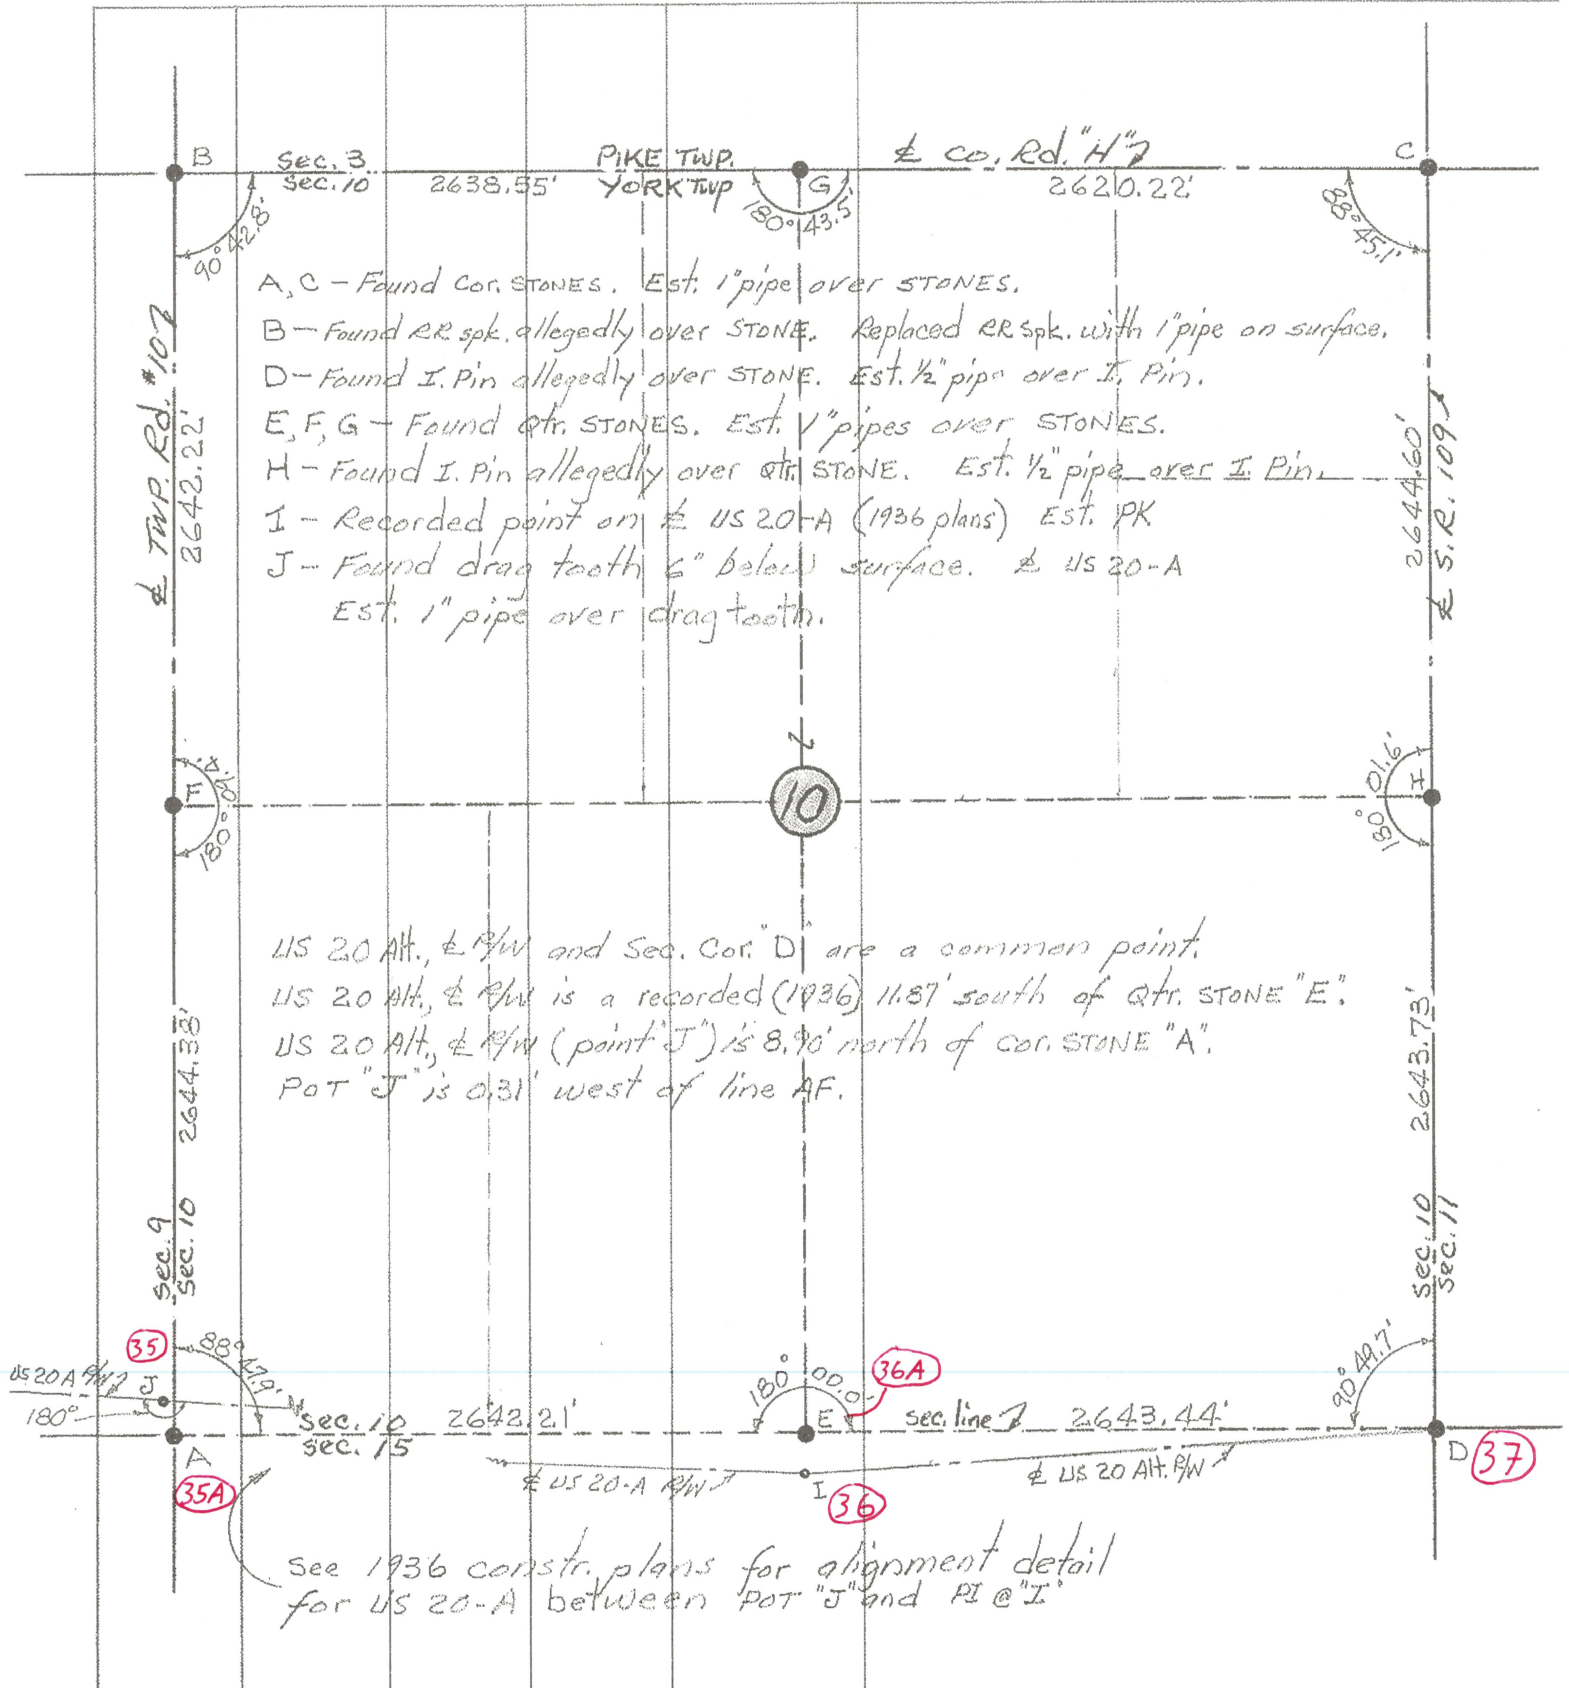

PERSONNEL	TITLE	PERSONNEL	TITLE
-----------	-------	-----------	-------

Red Beach

Newcomb

Кнаре

K  Z W. QTC. STONE, Sec. 10

COUNTY FULTON DATE Nov. 1971

E. qtr STONE Sec. 10

S. R. US 20-A

WEATHER

SEC. 15, YORK TWP T-7-N TEMP.

DESCRIPTION.


ALIGNMENT & CONTROLS

JOB NO.

LEFT

CENTER LINE

RIGHT

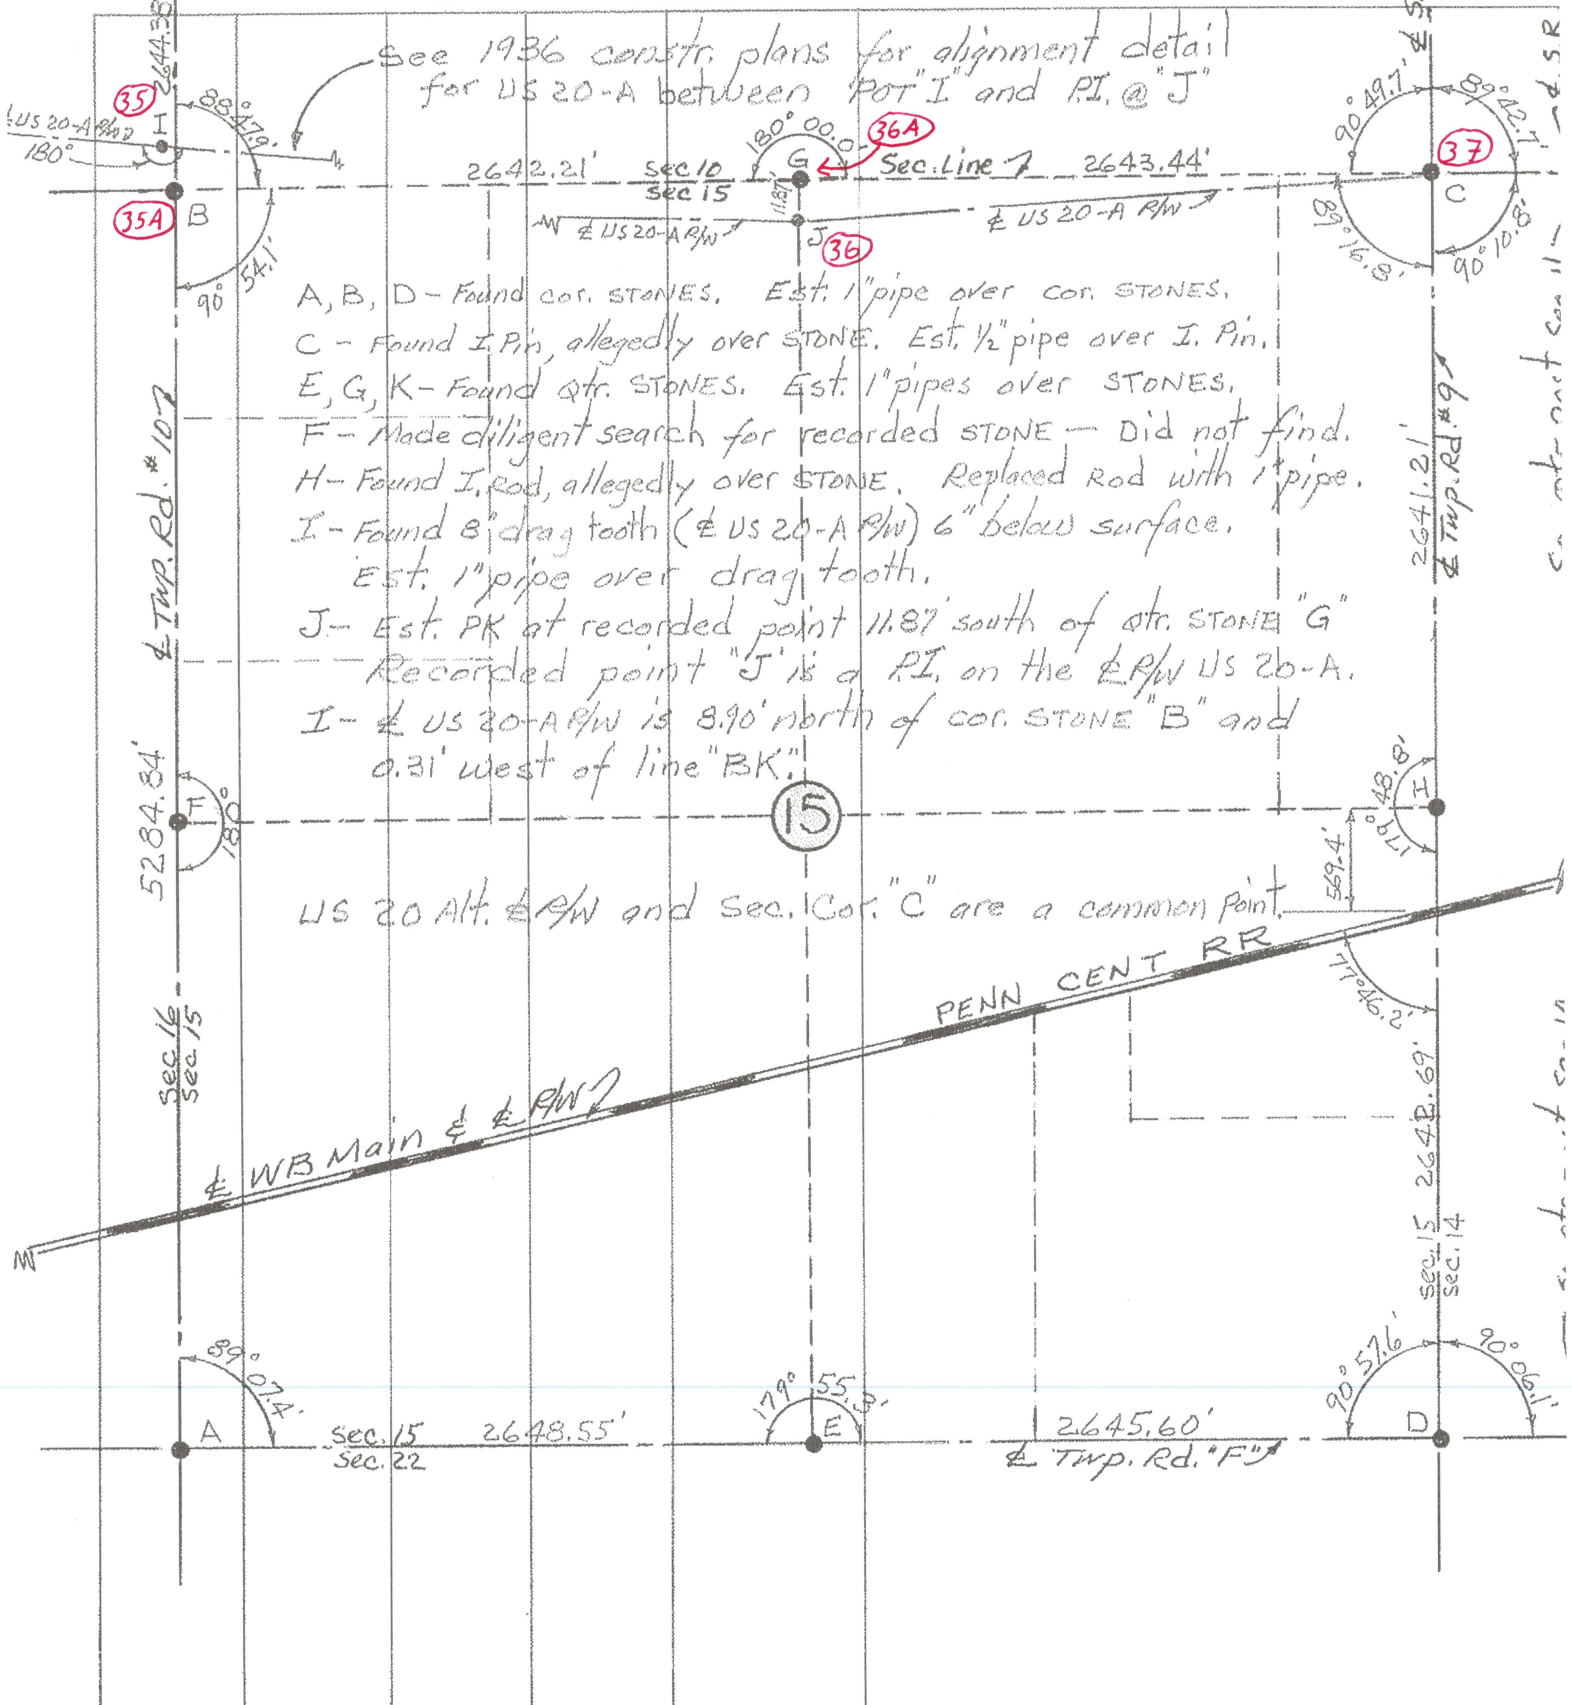

PERSONNEL TITLE PERSONNEL TITLE

COUNTY FultonDATE OK-1-24-58S. R. #20 Alt.

WEATHER

SEC.

TEMP.

DESCRIPTION

JOB NO.

