

O.D.O.T. DISTRICT 2 SURVEY OFFICE (USE ONLY)

PERSONNEL

REFERENCE NO. 36 A

SHEET 4 OF 6

NOTES RHOADES

DATE 6/13/19

ROUTE US 20A

H.C. O'DONNELL

WEATHER CLOUDY

COUNTY FULTON

R.C. MILLER

TEMP. 60°

TOWNSHIP YORK

SECTION 15

DWG BY BALBAUGH

PID 101232

T 7 N R 7 E

TYPE MONUMENT MONBOX W/ 1 1/2" IPIPE

ON SURFACE - ~~BELOW~~ ON

OFFSET $\oslash$ PAVEMENT $\pm 11.88'$ ~~LT~~ : RT

TO EDGE PAVEMENT


STATION: 928+42.66

HORZ.DATUM: NAD83 (2011)

GEOID: 2012A


GRID: NORTHING: 698443.062

EASTING: 1545160.482

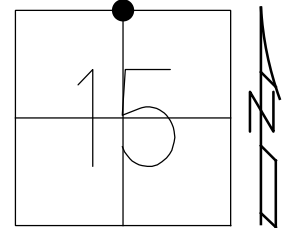

RECORD:
FD 1 1/2" IPIPE
OVER STONE
SET MONBOX
W/ 1 1/2" IPIPE
9/3/98, CL
FD MONBOX
W/ 1 1/2" IPIPE
REFA36
12/21/17, JFO

NOTE:
DIST. 36-36A= 11.88'

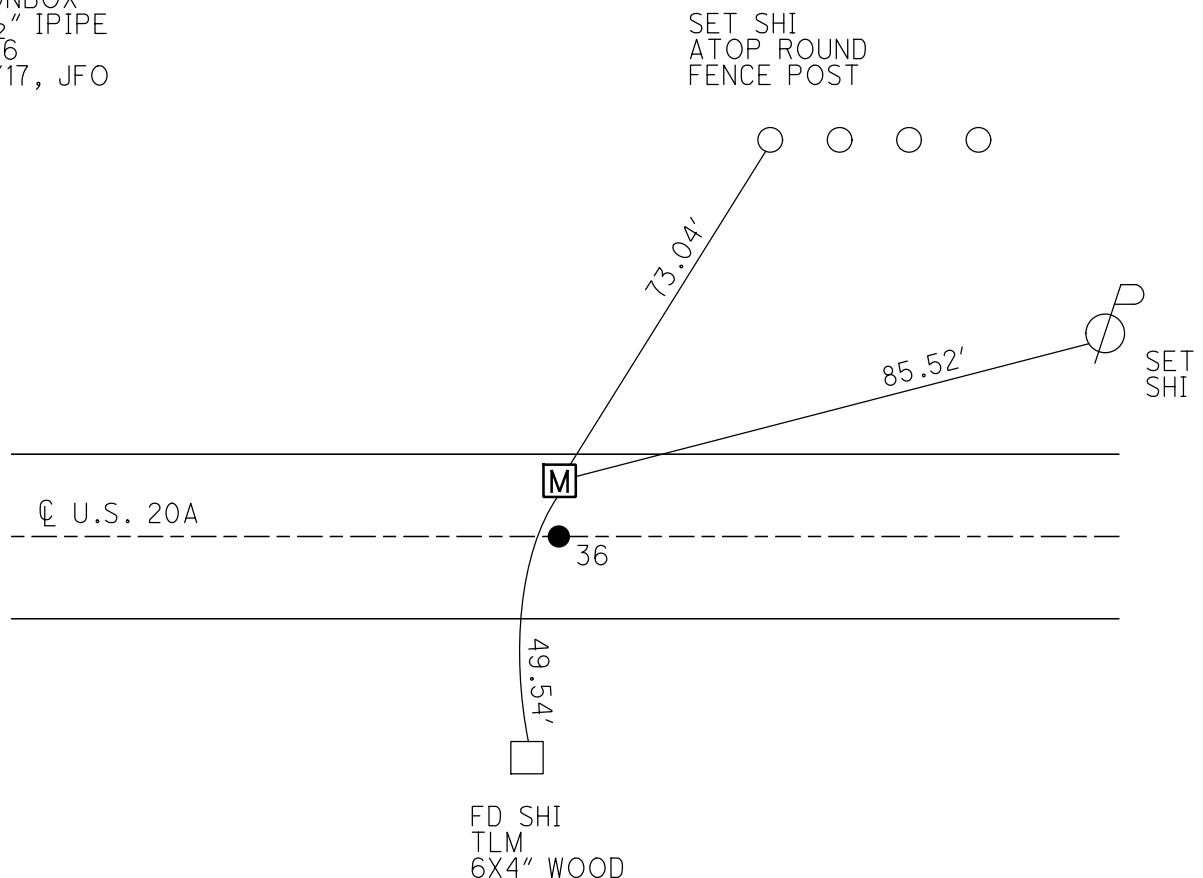

O.D.O.T. DISTRICT 2 SURVEY OFFICE

PERSONNEL

REFERENCE NO. 36

SHEET 2 OF 3

NOTES Loehrke

H.C. CORDS

DATE 9-3-98

ROUTE US 20-A

R.C.

WEATHER FAIR

COUNTY FULTON

TEMP. +18°C

TOWNSHIP YORK

SECTION 3 1/4 Corner of 10

T 7 N R 7 E


TYPE MONUMENT P.K. NAIL & WASHER Q Survey & R/W

ON SURFACE - BELOW Yes

~~FEET~~ - & PAW'T. - RIGHT Yes

TO EDGE PAVEMENT

S.L.M. 28+308.99

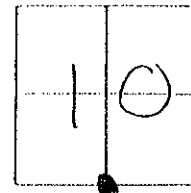

CONC.
Drive

Drillhole
B" from East
and South Edges

Drillhole
SW Corner

CONC. PAD
Utilities
Boxes

A to C = 19.986m

PLAN Sta. 28+308.940

See NOTE Lower Left.

Mon Box
Sec. Corner

US 20-A

Q Survey & R/W

PLAN Sta 28+308.985

Q Survey
and R/W

NOTE: B = Mon Box Installed 9-3-98

FD 1 1/2" PIPE OVER STONE: Reset PIPE in it's ORIGINAL

Position As Rod INSIDE Box; NOTE PIPE is

0.06 feet East of and $\pm$ 0.06 ft South of the

Stone. SAID PIPE & P.K. NAIL Correspond to

& PLAT of PLAN; FUL-20A-(27.25)(28.869)

York Township

PRINTED B LACK "t"
Near face ROAD Steel
fence Post.

O.D.O.T. DISTRICT 2 SURVEY OFFICE

PERSONNEL

REFERENCE NO. 36

SHEET 13 OF 24

NOTES 1. Stone

H.C. D. Curtis

R.C. J. Householder

DATE 17 Sept. 86

WEATHER Cool

TEMP. 56°

ROUTE US #20-A

COUNTY Fulton

TOWNSHIP York

SECTION 15

T R


TYPE MONUMENT PK Nails

ON SURFACE - BELOW Surface


LEFT- & PAV'T. - RIGHT

 TO EDGE PAVEMENT

S.L.M. 928+90

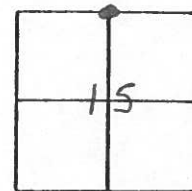

SET P.K. NAILS TO SURFACE
5-13-88

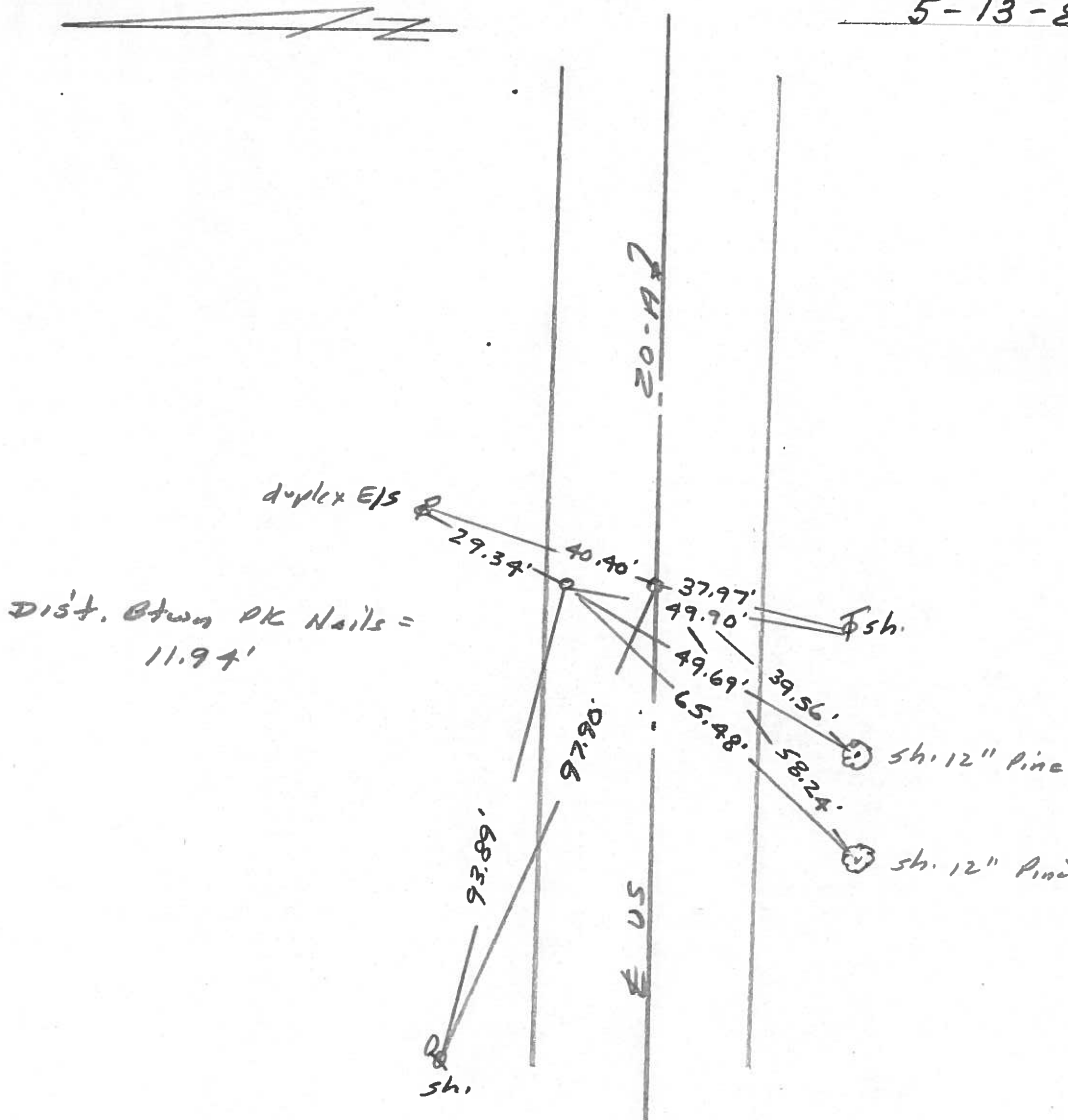

O.D.O.T. DISTRICT 2 SURVEY OFFICE

SHEET _____ OF _____

County Fulton S.R. 2 & US20A

Date OK-10-16-80
6-6-1980

Township York


Weather Clear

Section N 1/4 Cor. Sec. 15

Temp. + 82°

TZN, RZE


Personnel Smith
Bowers
Mead

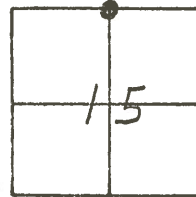

36


Fd 1" Iron Pipe
@ Surface
Pipe is 10'±
North of E Part

SET P.K. & Shi.
BOWERS

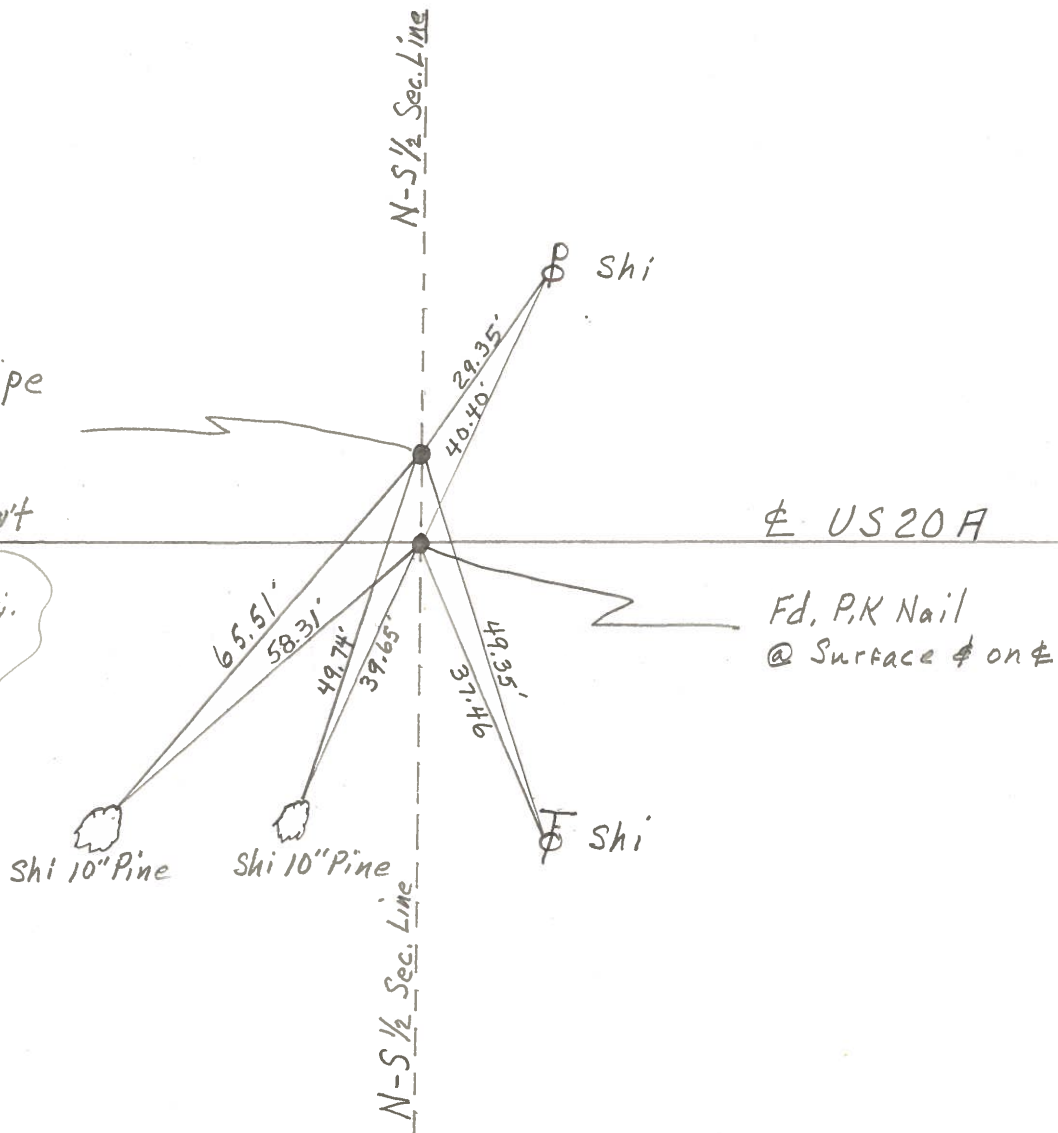

PERSONNEL	TITLE	PERSONNEL	TITLE	COUNTY	DATE	WEATHER	TEMP.
Tomsic				Fulton	April 19, 1973		
Weuser				S. R. US. 20A			
Granata							
Vanyo				SEC.			

DESCRIPTION	LEFT	CENTER LINE	RIGHT	JOB NO.
-------------	------	-------------	-------	---------

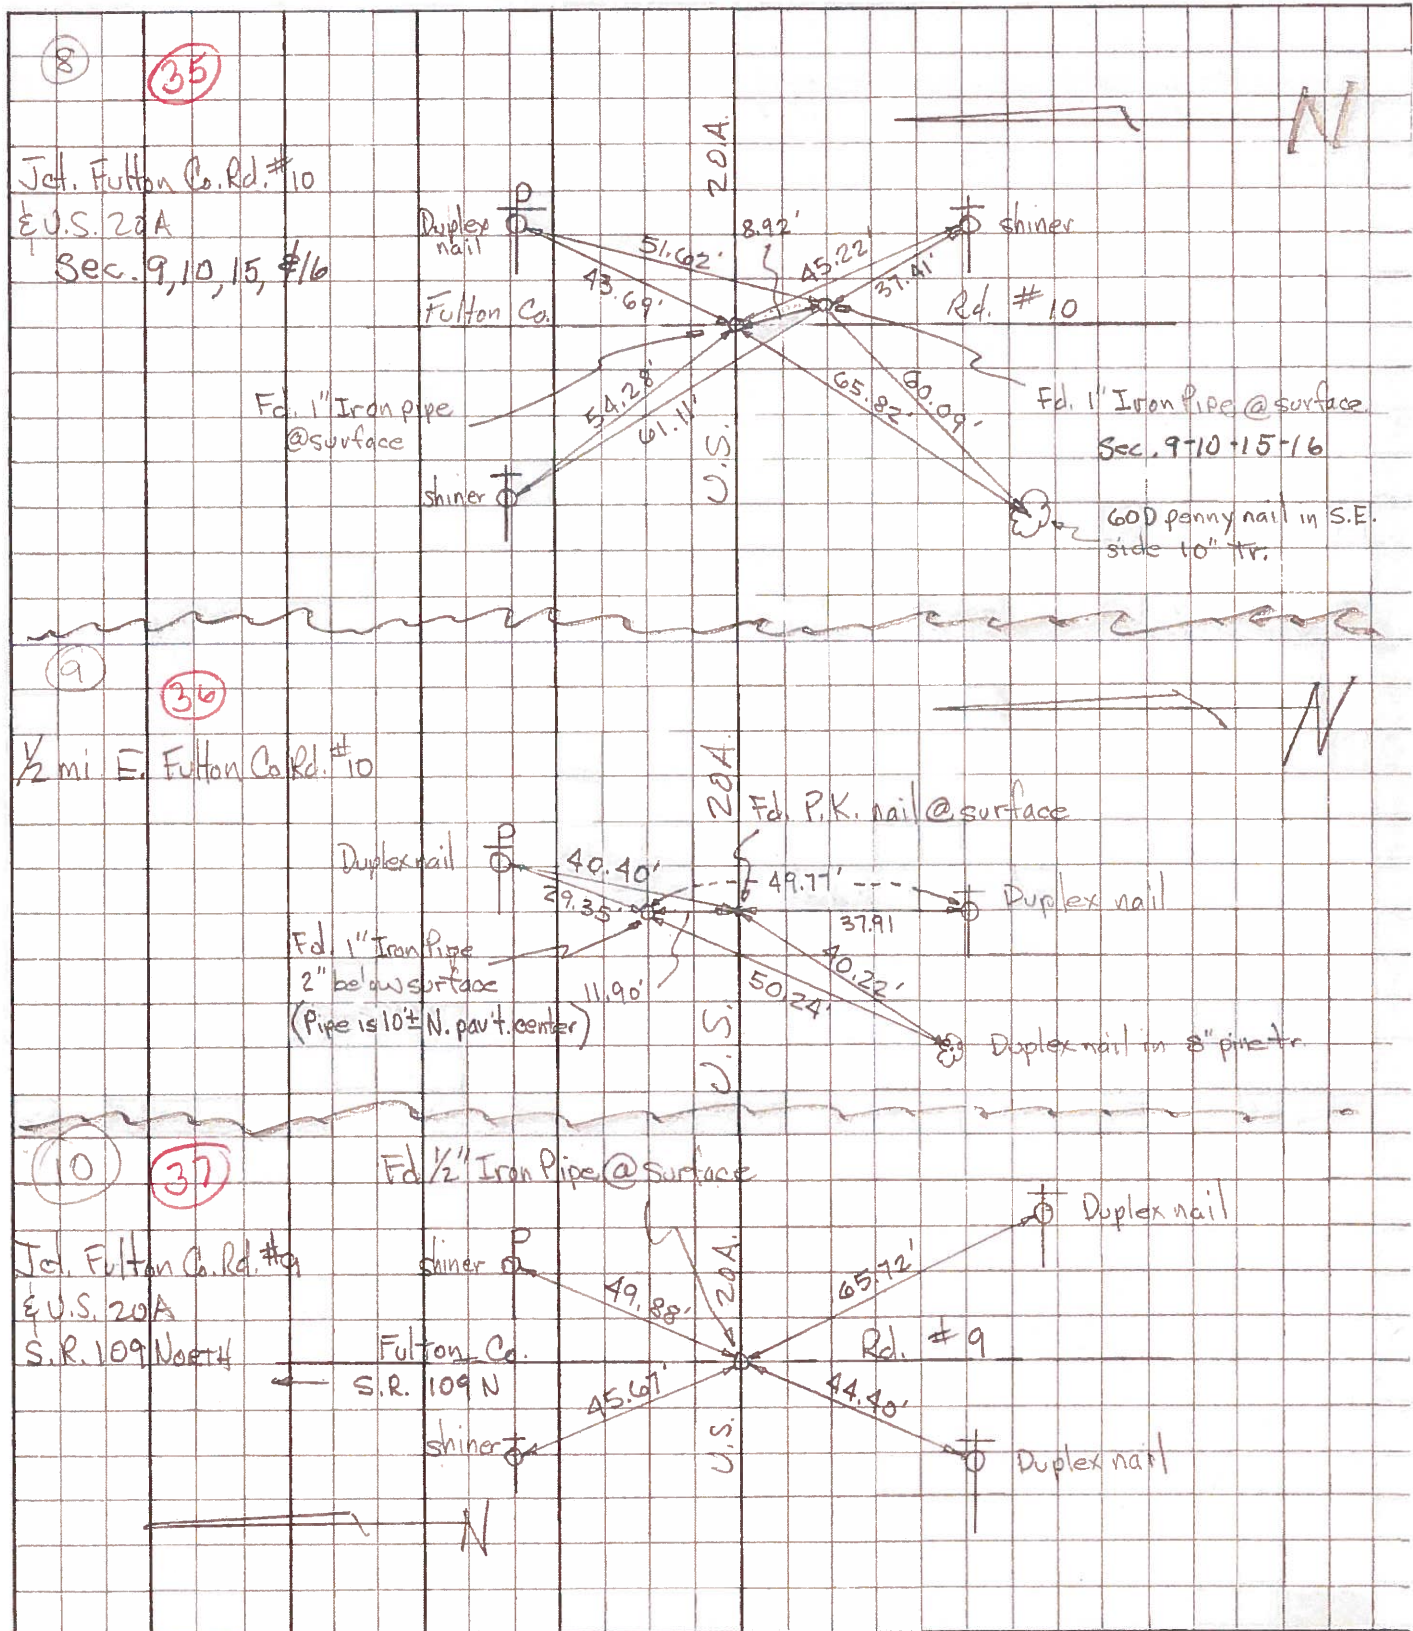

PERSONNEL	TITLE	PERSONNEL	TITLE
1	2	3	4
5	6	7	8
9	10	11	12
13	14	15	16
17	18	19	20
21	22	23	24
25	26	27	28
29	30	31	32
33	34	35	36
37	38	39	40
41	42	43	44
45	46	47	48
49	50	51	52
53	54	55	56
57	58	59	60
61	62	63	64
65	66	67	68
69	70	71	72
73	74	75	76
77	78	79	80
81	82	83	84
85	86	87	88
89	90	91	92
93	94	95	96
97	98	99	100

Red Beach

Newcomb

Ктаре

K  2 W. Qtz. STONE, Sec. 10

COUNTY FULTON

DATE Nov, 1971

E. qtr STONE Sec. 10

S. R. US 20-A

WEATHER

SEC. 15, YORK TWP T-7-N TEMP.

DESCRIPTION


ALIGNMENT & CONTROLS

JOB NO.

LEFT

CENTER LINE

RIGHT

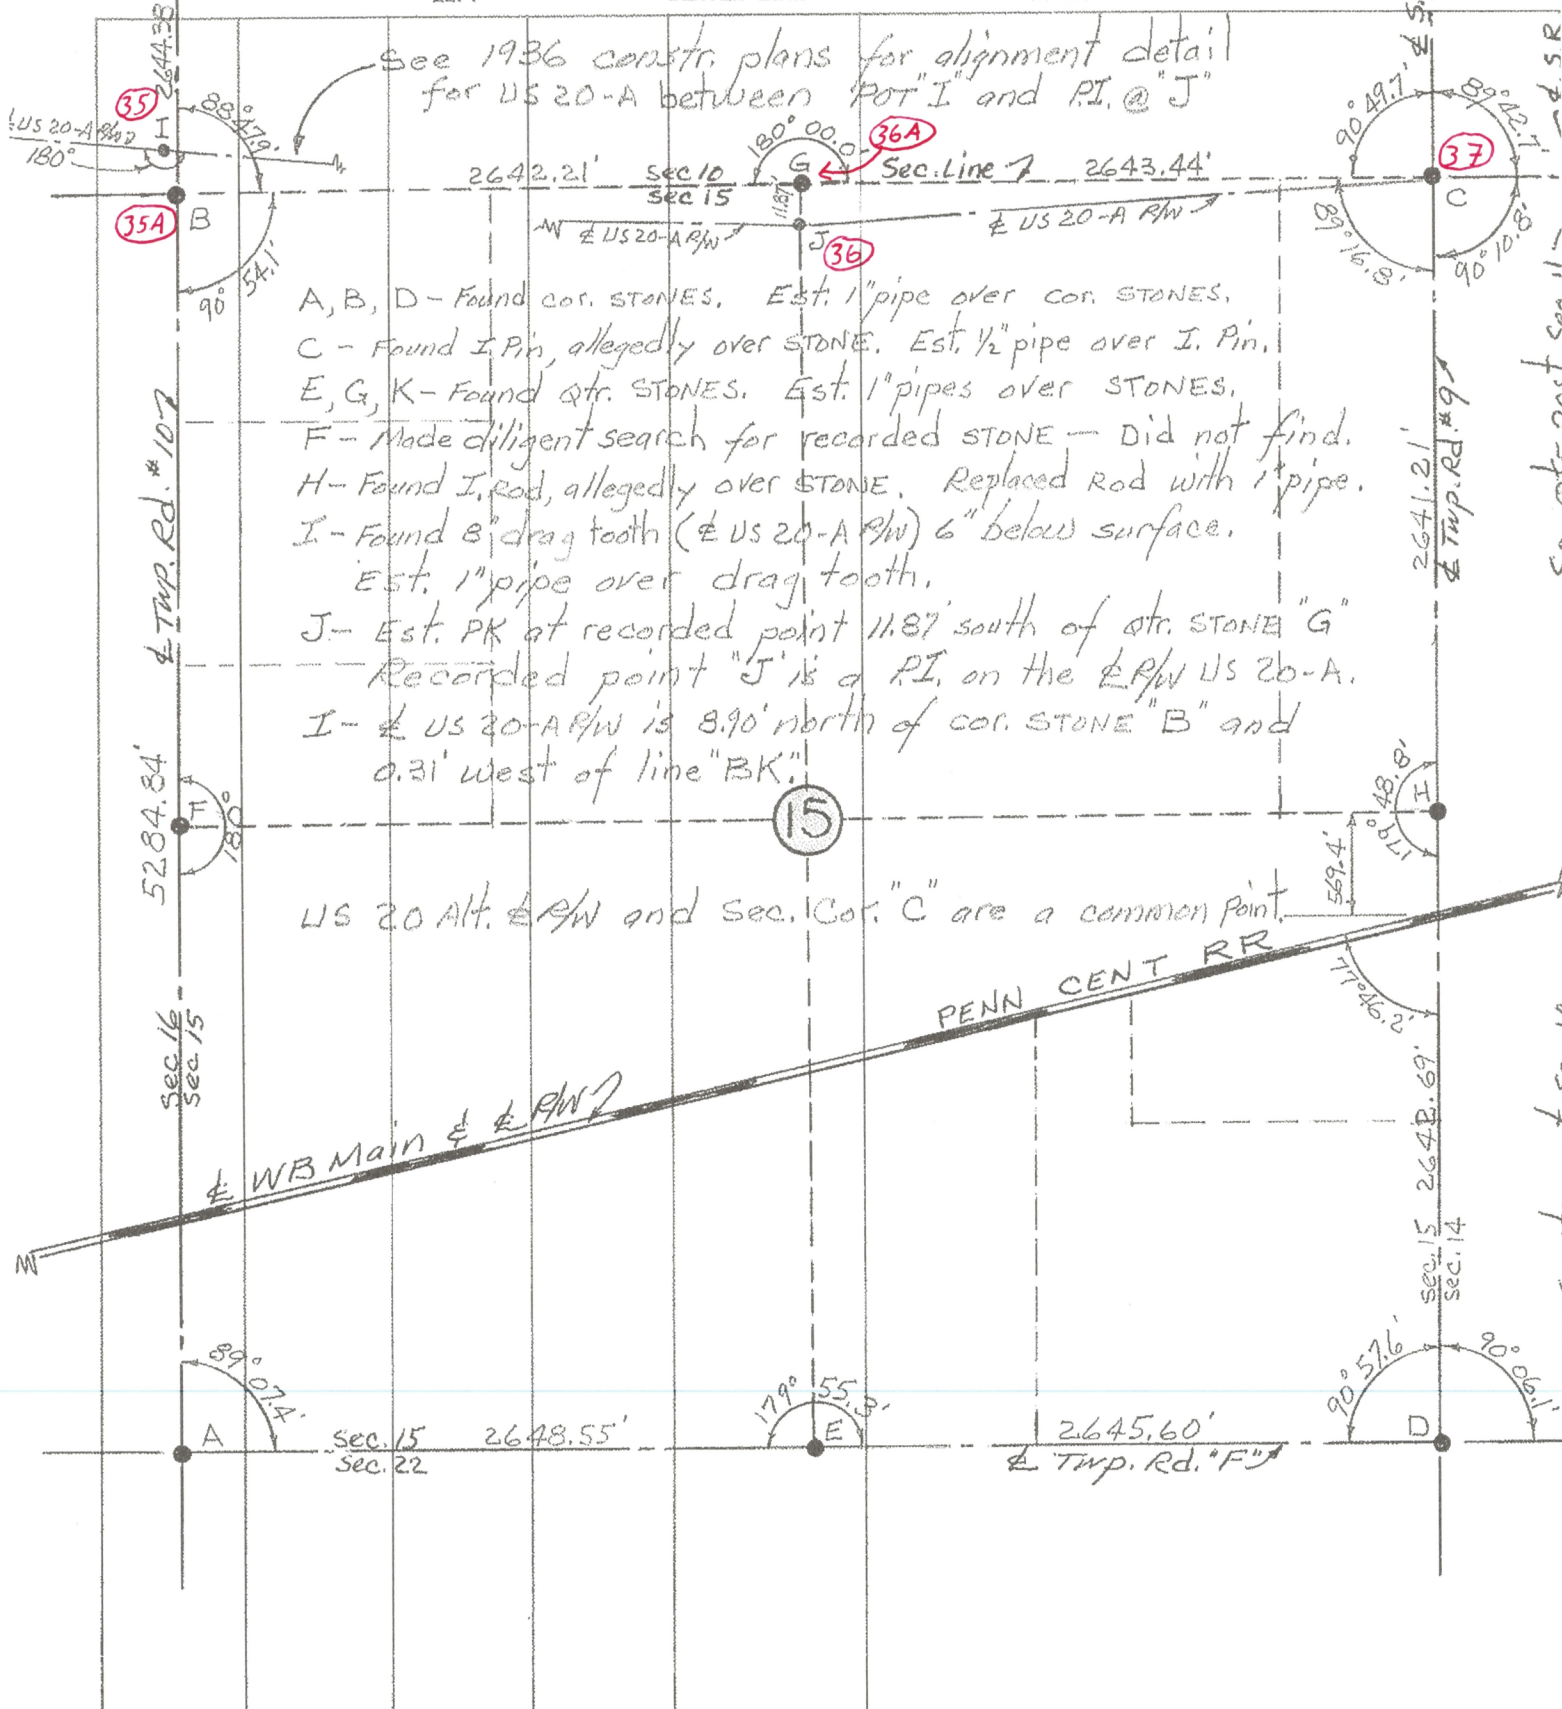

PERSONNEL	TITLE
1. _____	_____
2. _____	_____
PERSONNEL	TITLE
-----------	-------

COUNTY Fulton

DATE Sept. 1971

Red Beach
Newcomb
Knappe
Wise

S. R. US 20-A

WEATHER

SEC. York Twp.

TEMP

CONTROL POINTS

DESCRIPTION

LEFT



CENTER LINE

RIGHT

JOB NO.



S $\frac{1}{4}$ STONE, Sec. 15 York Twp
N $\frac{1}{4}$ STONE, Sec. 22 T-7-N

Cor. Sec. 14, 15, 22 & 23 York Twp. T-7-N

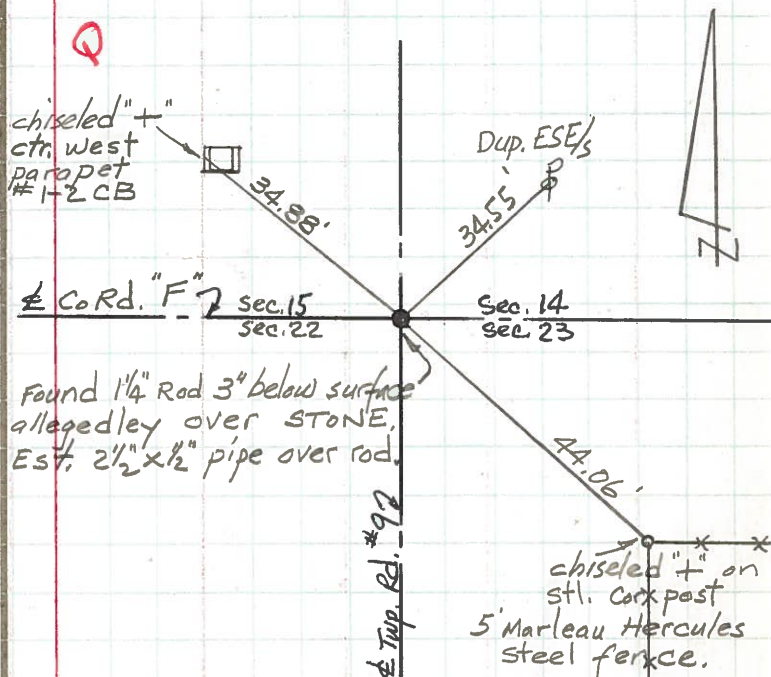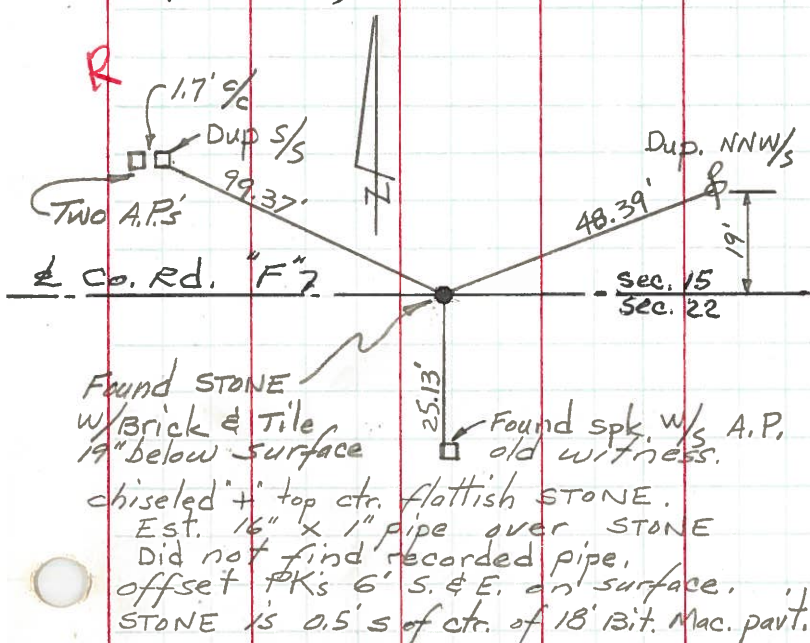

S 1/4	STONE	Sec. 16	YORK TWP	T-7-N
N 1/4	STONE	Sec. 21		

\$\frac{1}{4}\$ post, Sec. 14 York Twp.
N \$\frac{1}{4}\$ post, Sec. 23 York Twp.

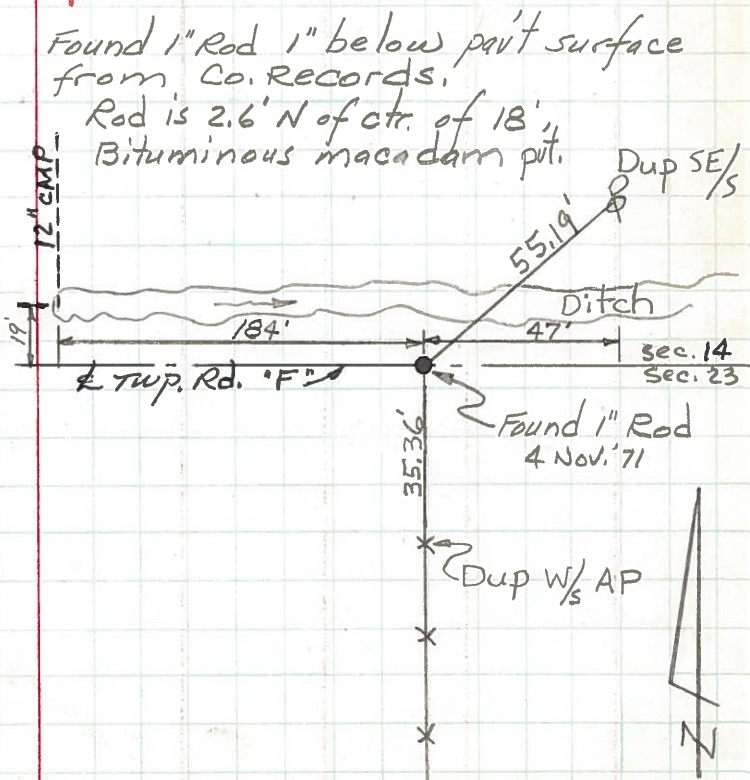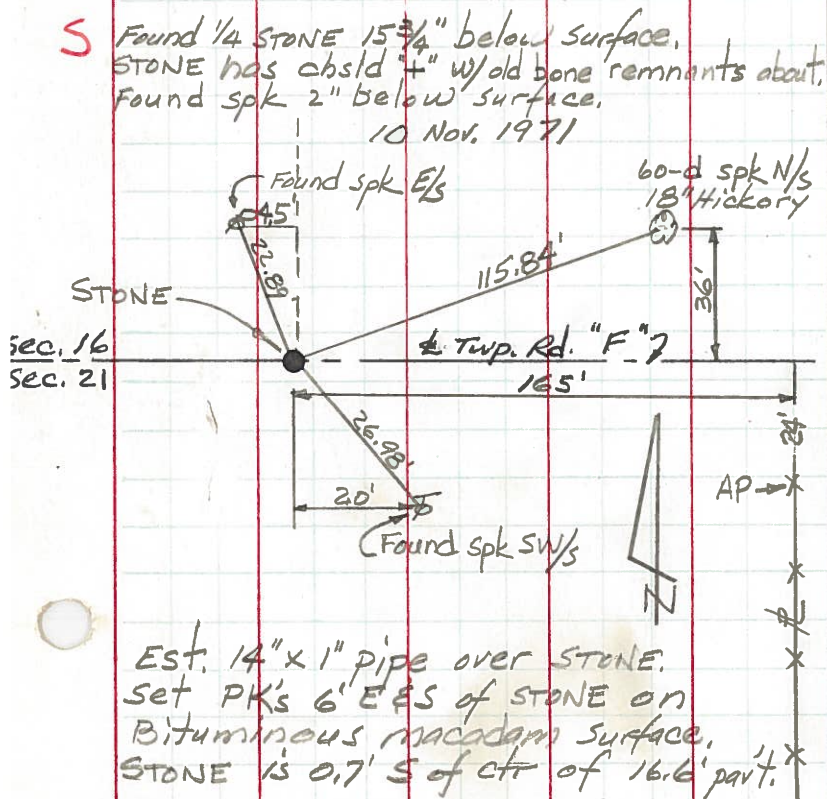

PERSONNEL TITLE PERSONNEL TITLE

COUNTY FultonDATE OK-1-24-58S. R. #20 Alt.

WEATHER

SEC.

TEMP.

DESCRIPTION

JOB NO.

