

O.D.O.T. DISTRICT 2 SURVEY OFFICE (USE ONLY)

PERSONNEL

REFERENCE NO. 37

SHEET 5 OF 6

NOTES RHOADES

DATE 6/13/19

ROUTE US 20A

H.C. O'DONNELL

WEATHER CLOUDY

COUNTY FULTON

R.C. MILLER

TEMP. 60°

TOWNSHIP YORK

DWG BY BALBAUGH PID 101232

SECTION 15

T 7 N R 7 E

TYPE MONUMENT MONBOX W/ 2 1/2" DOMED HEAD IPIN

ON SURFACE - ~~BELOW~~ ON

OFFSET Q PAVEMENT ON ~~LT~~ : ~~RT~~

TO EDGE PAVEMENT


STATION: 954+86.02

HORZ.DATUM: NAD83 (2011)

GEOID: 2012A


GRID: NORTHING: 698438.220

EASTING: 1547803.702

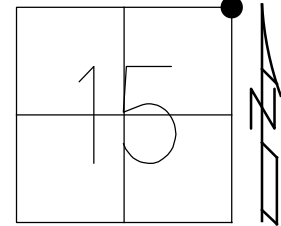

RECORD:
FD DOMED IPIN
5' DOWN
FD STONE
UNDISTURBED
22" DOWN
SET MONBOX
W/ IPIN
9/2/98
FD MONBOX
W/ IPIN
REFA22
6/8/12, MC
FD 2 1/2" IPIN
W/ DOMED HEAD
REF37
12/21/17, JFO

NOTE: SR 109 REFA22

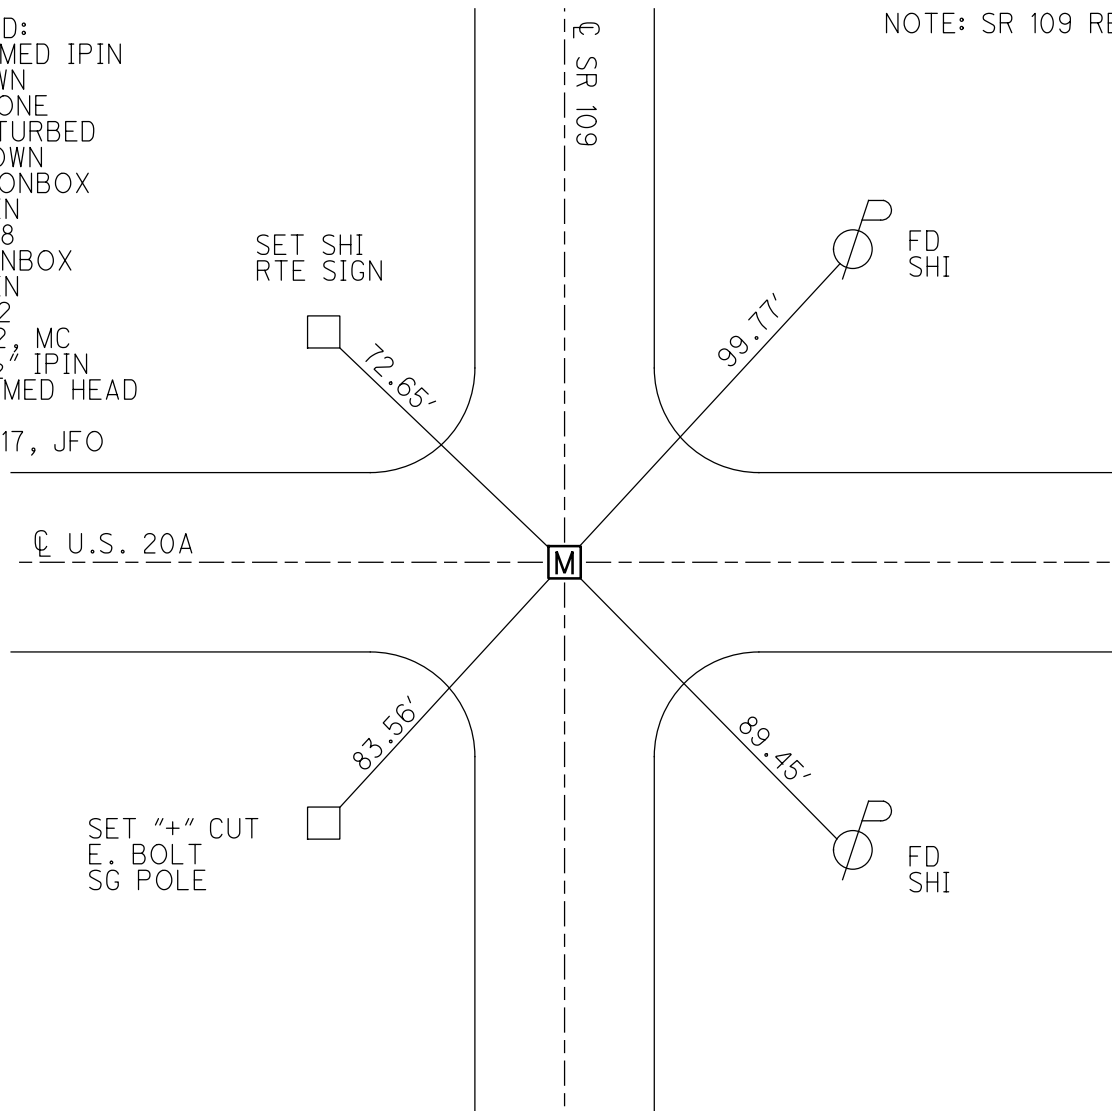

O.D.O.T. DISTRICT 2 SURVEY OFFICE (USE ONLY)

PERSONNEL

REFERENCE NO. 22-A

SHEET 1 OF 35

NOTES HUSS

DATE 06-08-12

ROUTE SR 109

H.C. HUSS

WEATHER FAIR

COUNTY FULTON

R.C. CANTERBURY

TEMP. 76°

TOWNSHIP YORK

HARBAUGH

SECTION 10

COUTCHER

T 7 N R 7 E

TYPE MONUMENT IROD IN MON BOX


ON SURFACE - BELOW ON

LEFT - Q PAV'T - RIGHT ON

- TO - EDGE PAVEMENT


S.L.M. 428+73

Grid: Northing: 698438.228 Easting: 1547803.655

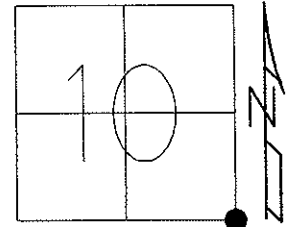

MON BOX INSTALLED 09-02-98
FD "DOMED" IRON PIN $\pm 5"$ BELOW
SURFACE. ROD WAS REMOVED & A
STONE WAS FD $\pm 22"$ BELOW SURFACE
STONE LEFT UNDISTURBED AND IPIN
WAS RESET OVER IT - COMMON TO
STONE SAID PIN TO ACT AS ROD
INSIDE MON. BOX LOCATION OF PIN
BEING COMMON TO STONE

06-08-12 GPS, REF A22
03-04-13 GPS, FIN A22, MC

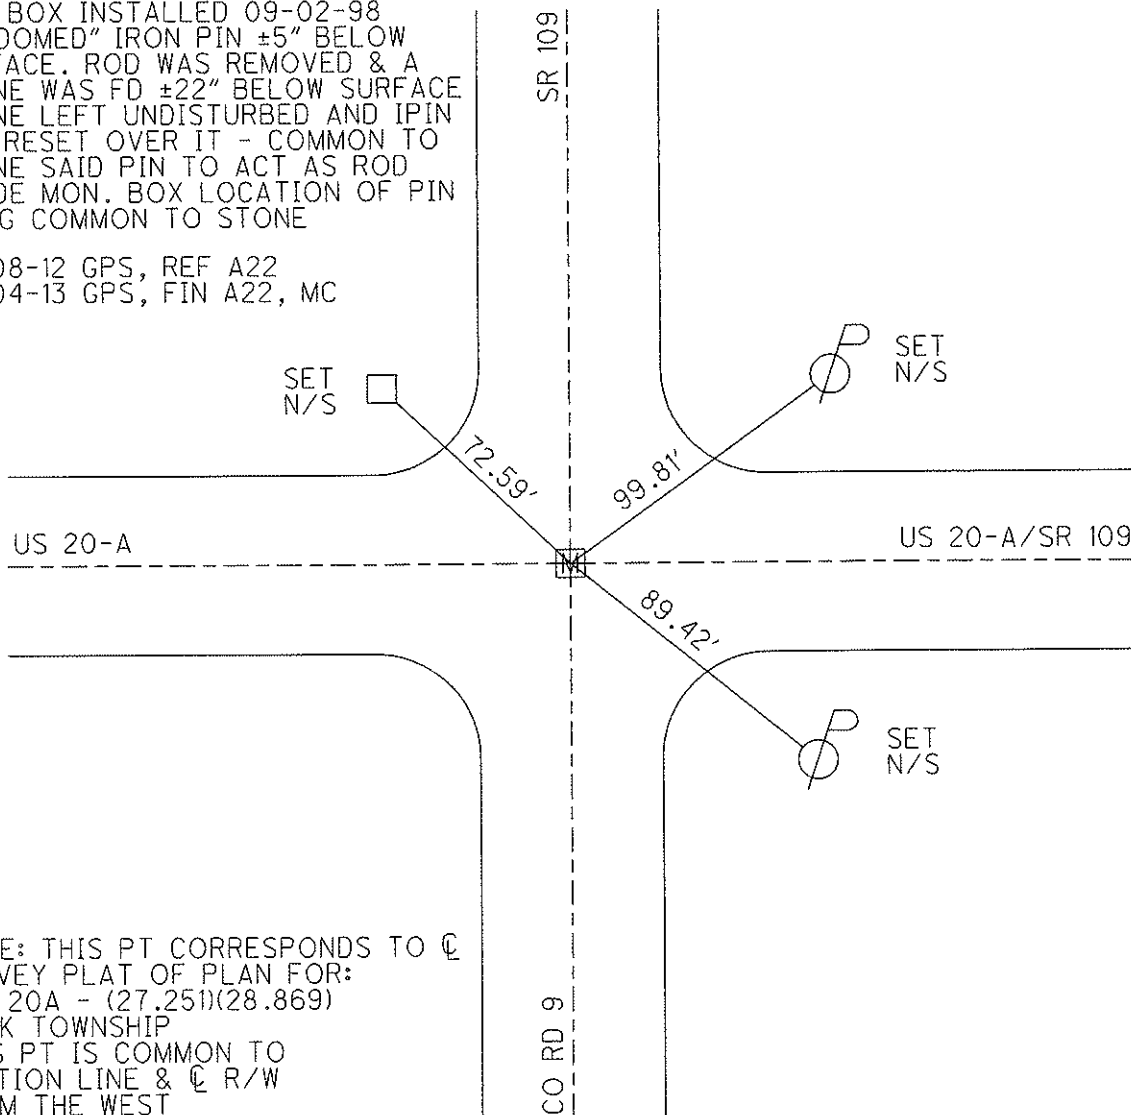

NOTE: THIS PT CORRESPONDS TO Q
SURVEY PLAT OF PLAN FOR:
FUL 20A - (27.251)(28.869)
YORK TOWNSHIP
THIS PT IS COMMON TO
SECTION LINE & Q R/W
FROM THE WEST

O.D.O.T. DISTRICT 2 SURVEY OFFICE

PERSONNEL

REFERENCE NO. 37

SHEET 3 OF 3

NOTES LOEHRKE

H.C. CORDS

R.C. _____

DATE 9-2-98

WEATHER FAIR

TEMP. $\pm 18^{\circ}\text{C}$

ROUTE U.S. 20-A

COUNTY FULTON

TOWNSHIP YORK

SECTION SE of 10

T7 NR 7 E

TYPE MONUMENT I Rod in Mon Box

ON SURFACE - BELOW

LEFT- & PAV'T. - RIGHT

TO EDGE PAVEMENT

S.L.M. 29+114.73 US 20-A

10	11
15	14



MON BOX INSTALLED 9-2-98

Fd "DOMED" IRON PIN $\pm 5"$ Below Surface. ROD WAS REMOVED & A Stone WAS Fd $\pm 22"$ Below Surface Stone Left UNDISTURBED AND I-PIN WAS RESET OVER IT - Common to Stone SAID PIN to Act AS ROD INSIDE MON BOX. LOCATION of PIN Being Common to Stone

NOTE:

This Pt is Common to Section Line & R/W from the West.



NOTE: This Pt Corresponds to & Survey Plat of Plan for:

FUL-20A- (27.251)(28.869)

York Township.

Set Nail/shi
ON White Edge
Line

28.259m

Co. Rd #9

27.955m

Set Nail/shi
on White Edge
Line

26.700m

Cut 4" Near Face
Corner Fence Post

Chain Link
Fence

O.D.O.T. DISTRICT 2 SURVEY OFFICE

PERSONNEL

REFERENCE NO. 37
SR 109 = 22-A

SHEET 14 OF 24

NOTES 1. Stone

H.C. D. Curtis

R.C. J. Householder

DATE 17 Sept. 86

WEATHER Cool

TEMP. 57°

ROUTE US #20-A

COUNTY Fulton

TOWNSHIP York

SECTION 10-11-14-15

T R

TYPE MONUMENT PK Nail

ON SURFACE - BELOW Surface

LEFT - & PAW'T. - RIGHT


 TO EDGE PAVEMENT

S.L.M. 955+34

10	11
15	14



SET P.K. NAIL TO SURFACE
5-13-88

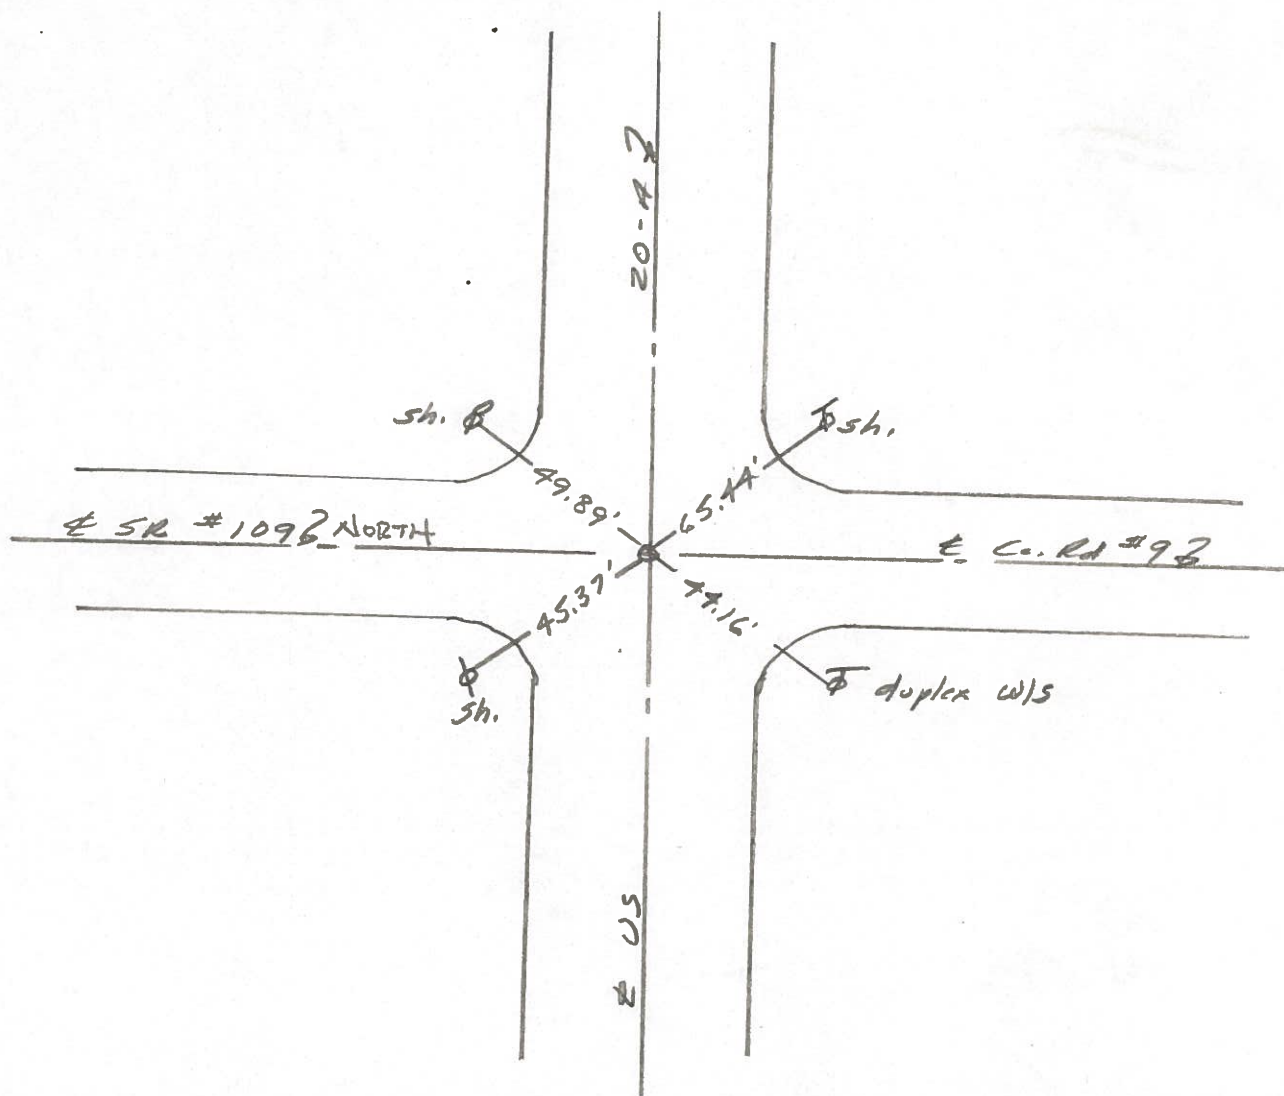

O.D.O.T. DISTRICT 2 SURVEY OFFICE

SHEET

OF

County Fulton S.R. 2 & US20A

Date OK-10-16-80
6-6-1980


Township York

Weather Clear


Section NE Cor. Sec. 15 NW Cor. Sec. 14
SE Cor. Sec. 10 SW Cor. Sec. 11
TZN, R7E

Temp. + 82°

Personnel Smith
Bowers
Mead

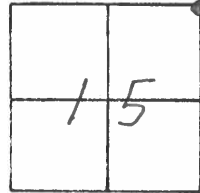


(37)

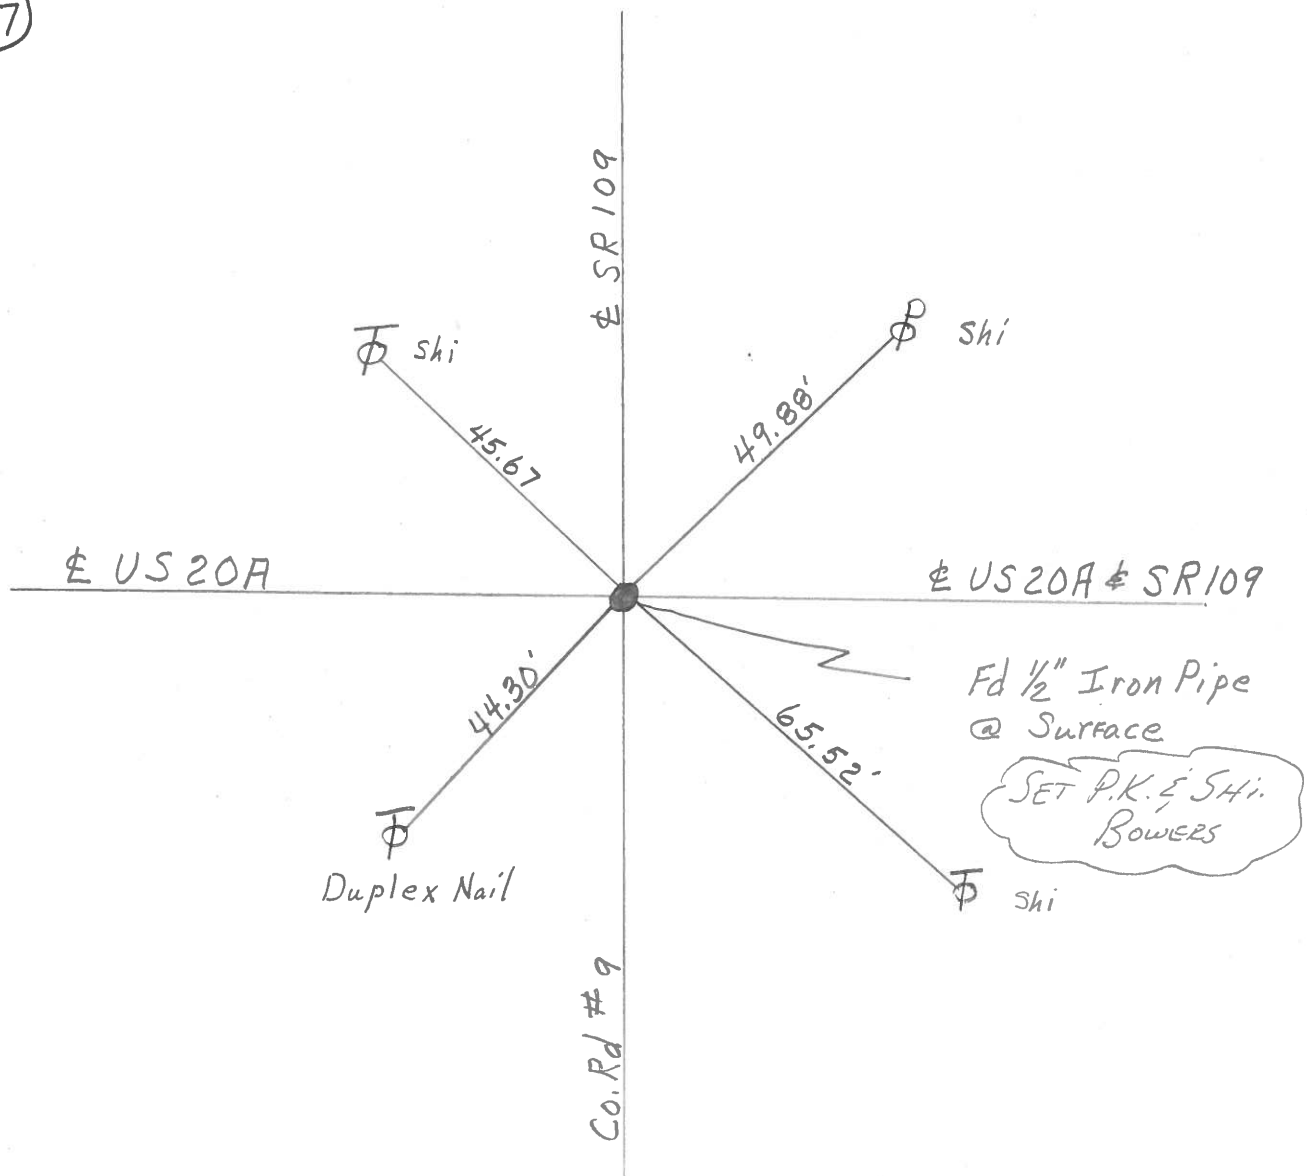

PERSONNEL	TITLE	PERSONNEL	TITLE	COUNTY	DATE	WEATHER	TEMP.
Tomsic				Fulton	April 19, 1973		
Neuser				S. R. US. 20A			
Granata							
Vanyo				SEC.			

DESCRIPTION	LEFT	CENTER LINE	RIGHT	JOB NO.
-------------	------	-------------	-------	---------

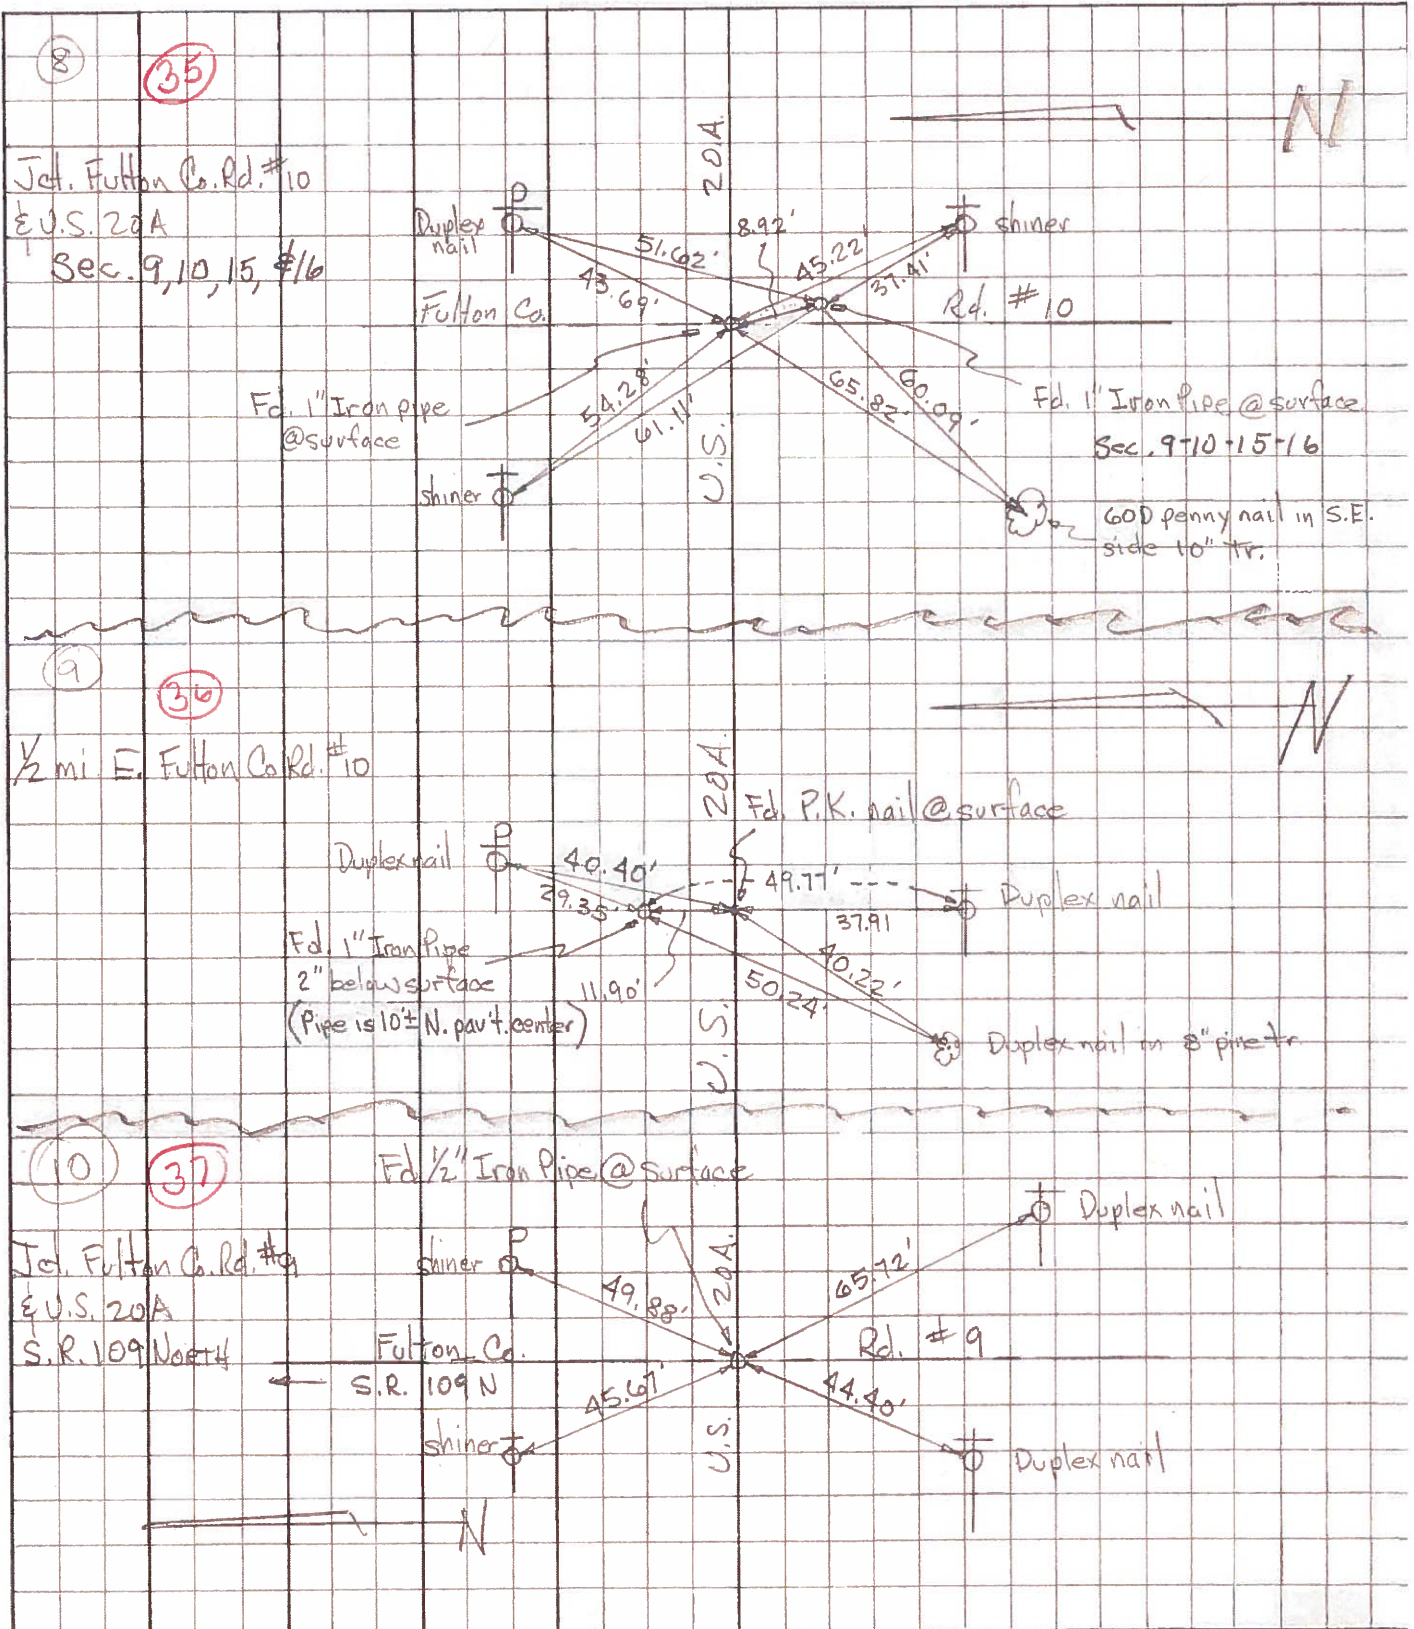

PERSONNEL	TITLE	PERSONNEL	TITLE
-----------	-------	-----------	-------

COUNTY FULTON DATE SEPT. 71

S. R. US 20-A WEATHER


SEC. 10, YORK TWP., T-7-N TEMP.

DESCRIPTION ALIGNMENT & CONTROLS JOB NO.

LEFT

CENTER LINE

RIGHT

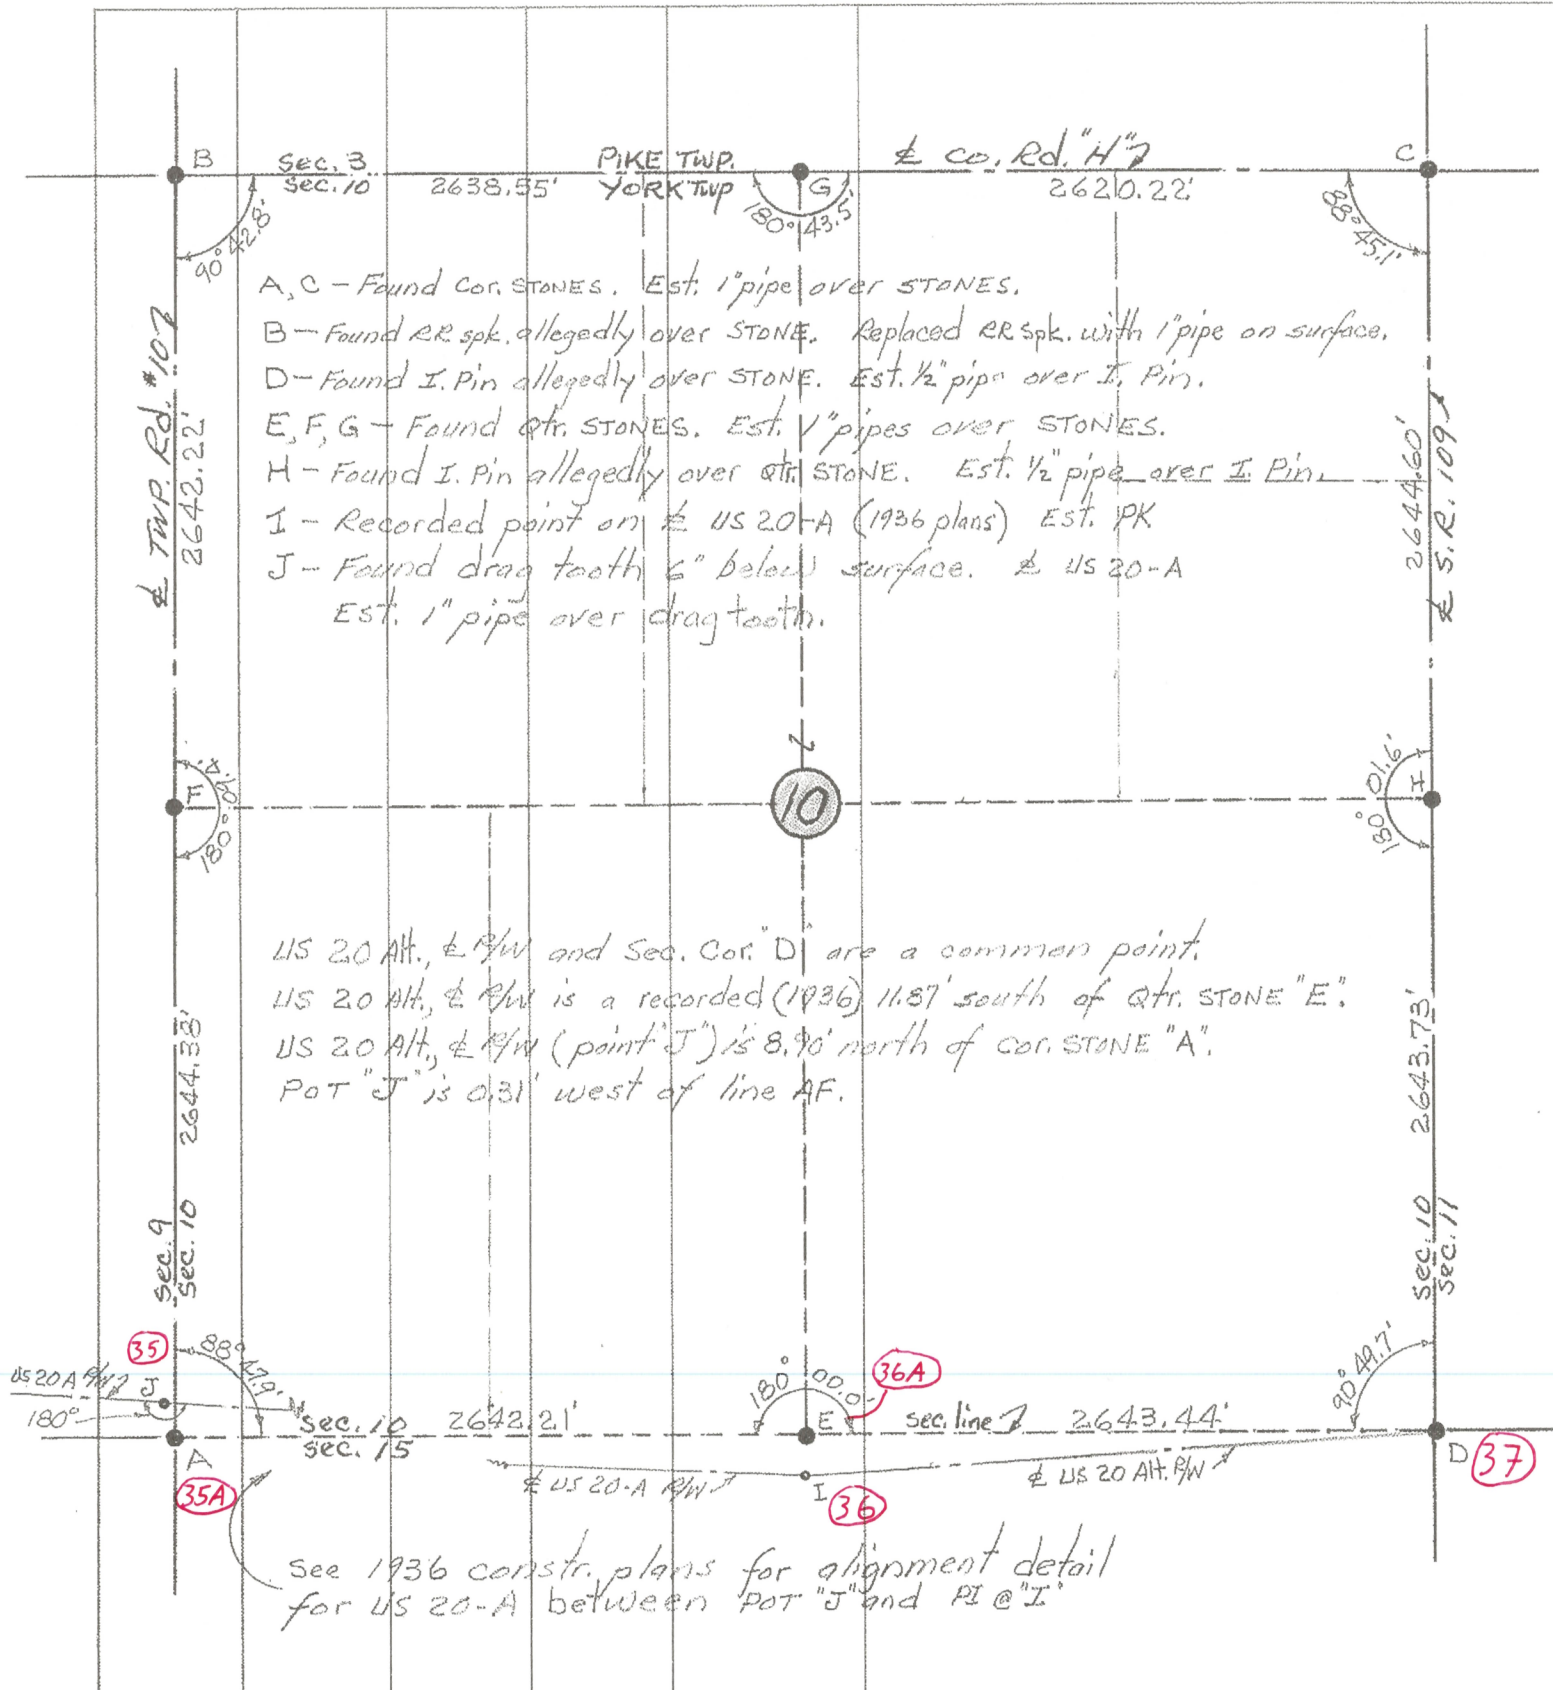

PERSONNEL TITLE PERSONNEL TITLE

Red Beach

Newcomb

Knappe

Knappe

COUNTY FULTON DATE Nov. 1971S. R. US 20-A

E. qtr STONE Sec. 10


WEATHER

SEC. 15, YORK TWP T-7-N TEMP.

DESCRIPTION

ALIGNMENT & CONTROLS

JOB NO.

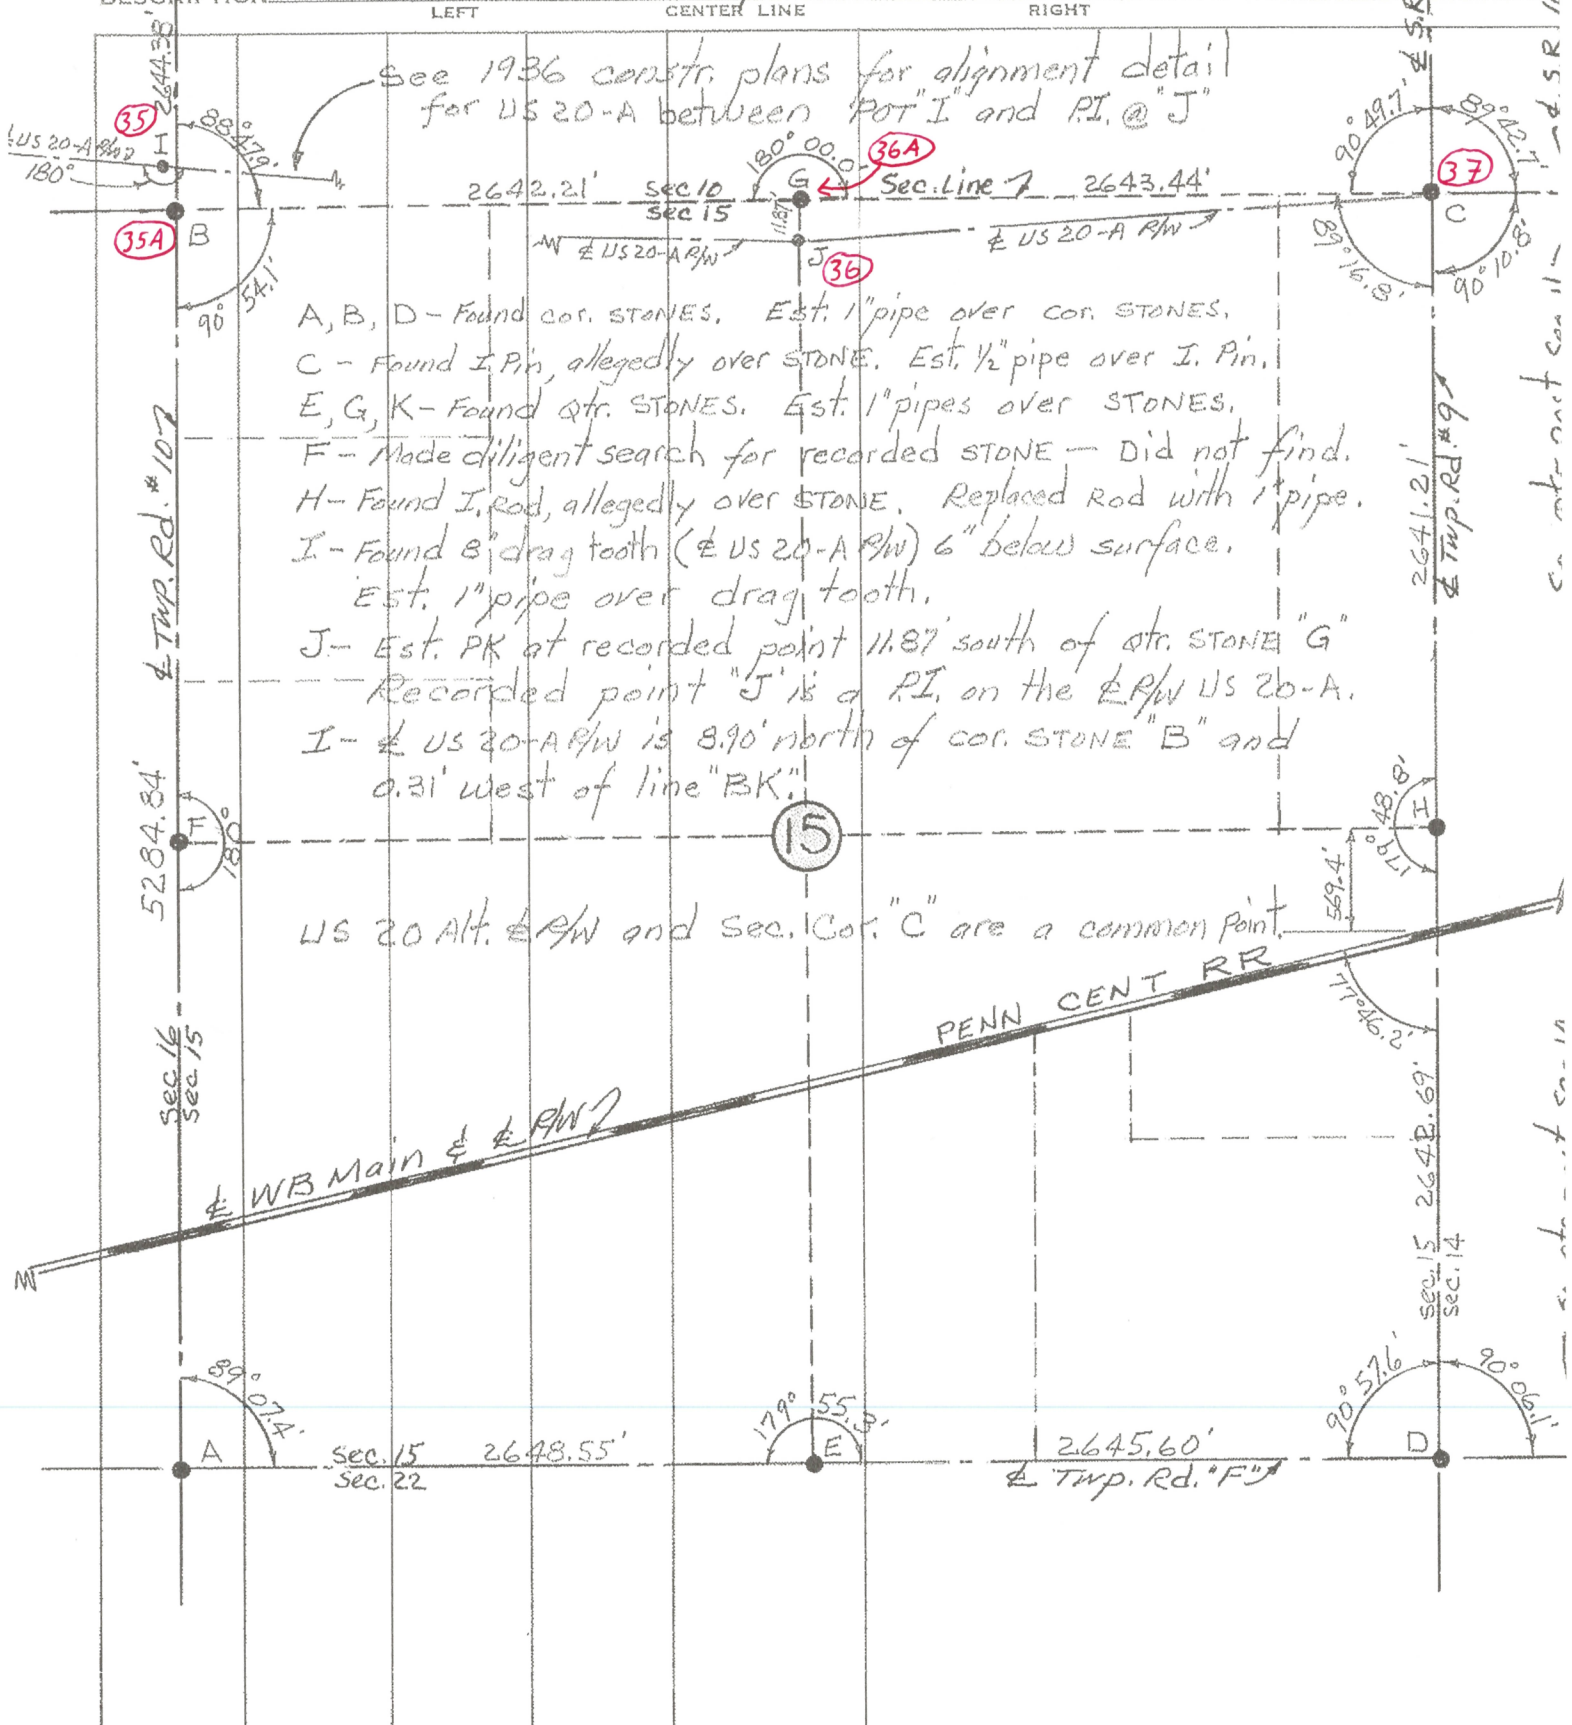

PERSONNEL TITLE PERSONNEL TITLE

Pessefall

COUNTY FultonDATE 9-30-60

Wise

S. R. 20 R & 2WEATHER cloudy

Baird

SEC. _____

TEMP. 55°

Newcomb

DESCRIPTION Wauseon 2 & 20 A To Delta

JOB NO. _____

LEFT

CENTER LINE

RIGHT

O.K. 10-18-61 W. Knapp

80

S.R. 20 R-2-109

Iron Pin

Shi S.E. side TP

Shi S.W. side P.P.

P.K.

Shi 4" wood sign Post

49.90

53.68

45.77

43.09

86.16

Shi N.E. side T.P.

Shi S.E. Side 14" Elm.

79

None

O.K. 10-18-61 W. Knapp

78

Sec Cor-9-10-16-15

York Twp

Shi S.W. Side P.P.

Shi N.W. Side T.P.

P.K.

51.13

43.05

45.36

37.43

Shi S.E. Side Brace Pole

R.R. SPK

P.K.

54.19

61.15

84.12

88.85

83.90

92.67

SPK E. Side 36" maple

Shi S.E. Side 18" Elm

O.K. 10-18-61 W. Knapp

77

Iron Pin

Shi S.W. Side fence Post

P.K.

69.77

39.84

Shi N. Side T.P.

59.53

36.75

37.22

Duplex W. Side

Shi N.E. Side 13" Elm

Shi S.E. Side fence Post

100.05

Shi N.E. Side 14" Elm

PERSONNEL TITLE PERSONNEL TITLE

COUNTY FultonDATE OK-1-24-58S. R. #20 Alt.


WEATHER

SEC.

TEMP.

DESCRIPTION

JOB NO.

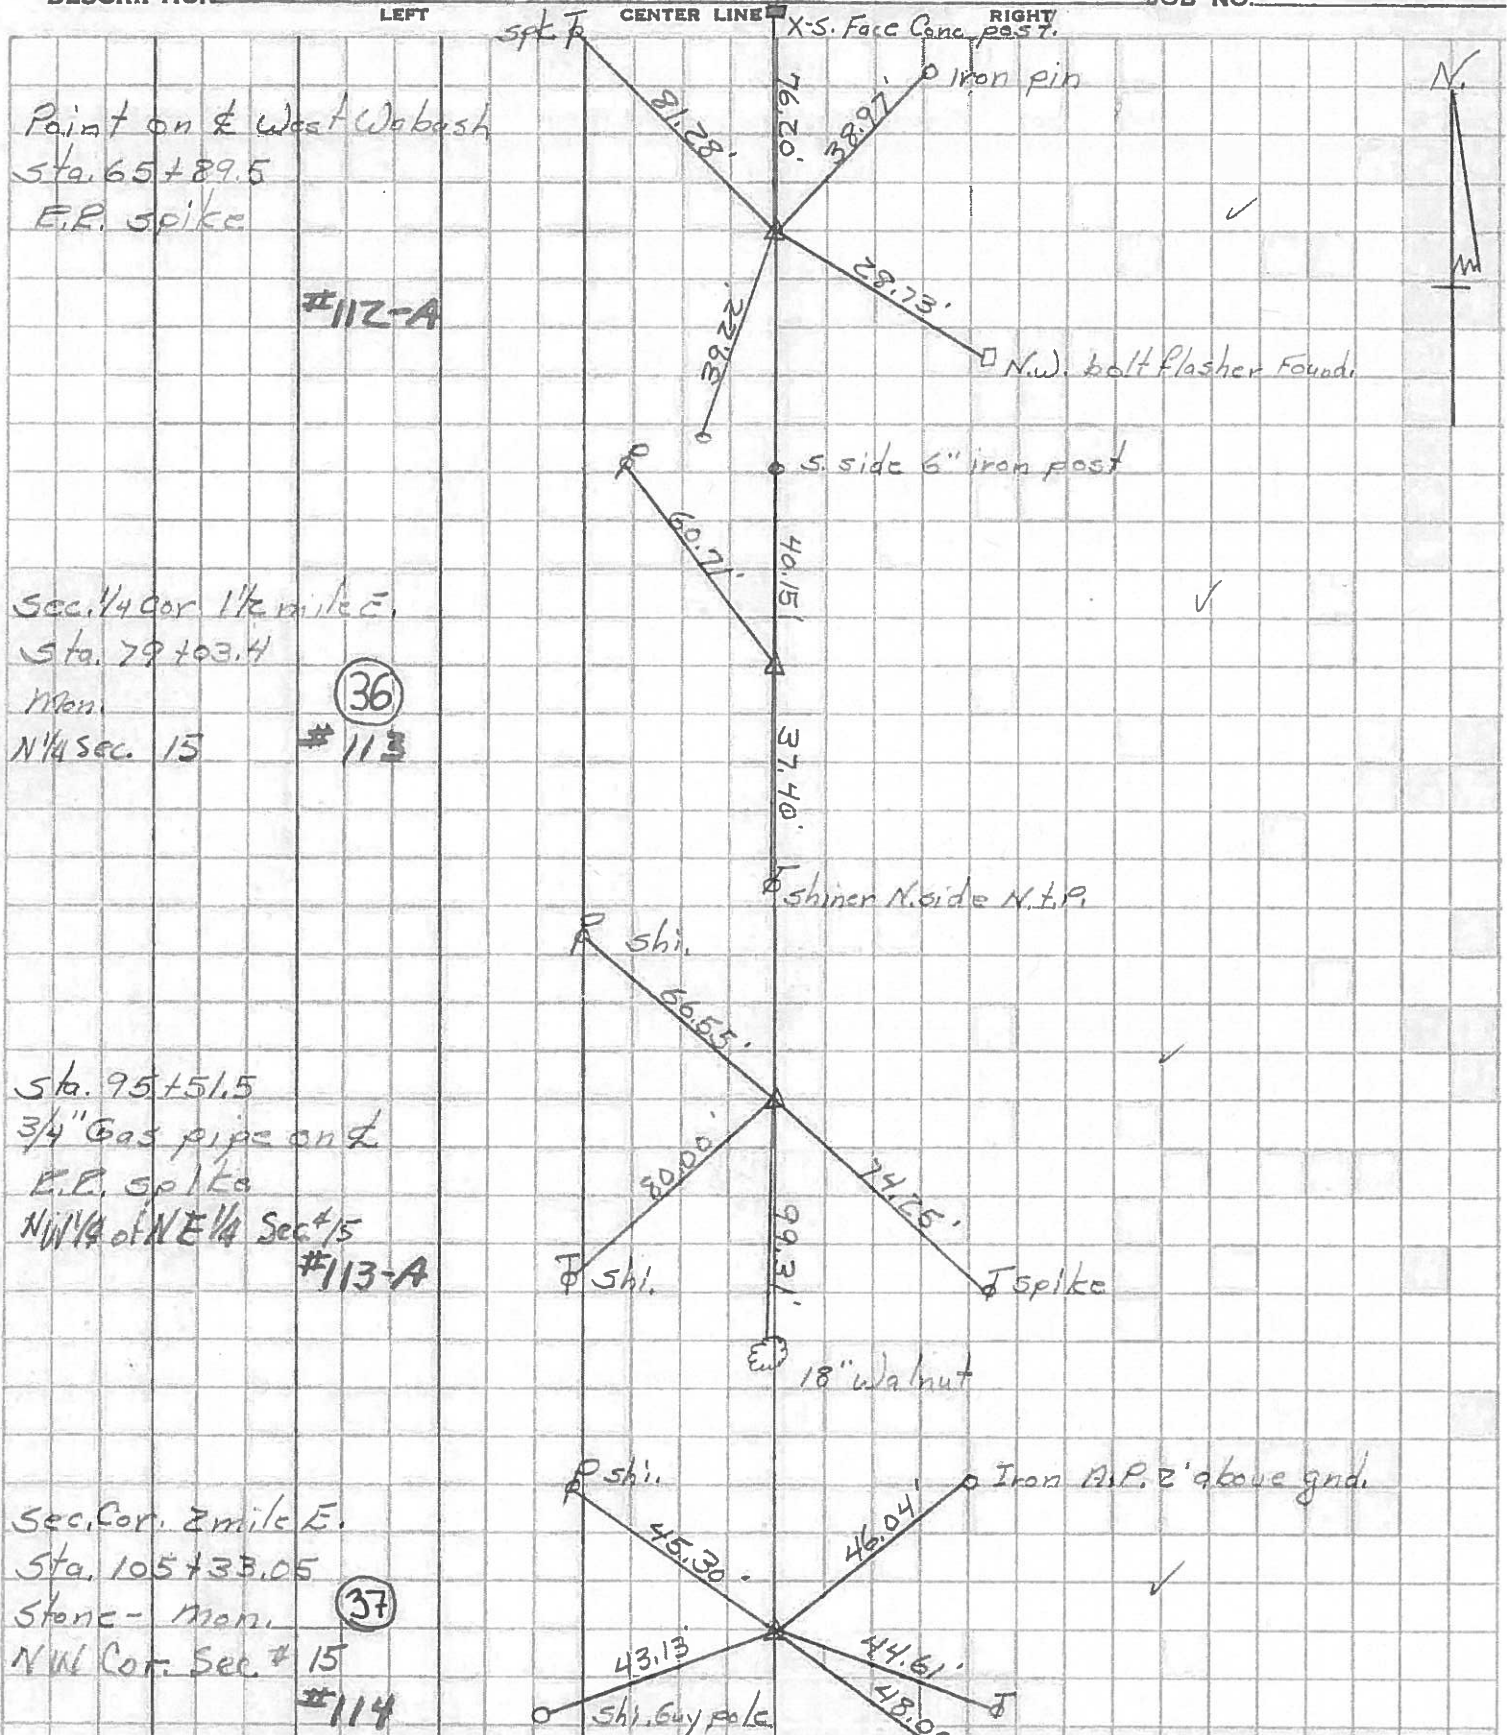

PERSONNEL TITLE PERSONNEL TITLE

COUNTY Fulton DATE 3-28-55

S. R. #2 & 20 Alt. WEATHER Pesefall-9-12-60

SEC. M, A, O. TEMP.

DESCRIPTION LEFT CENTER LINE RIGHT JOB NO.

10-24-61 W. Knape

Iron pin ✓
S 1/4 Sec. #9
York Twp.

Shi Fence Post
#77

Sec. cor. 9-10-16-15 ✓
York Twp.

Brace Pole
SE Side pole
Shi. 12" Elm N.W.
#78

#79

Intersection S.E. #
109 & Alt 20-2 ✓
Iron pin
S.E. cor. sec. 10

#80

