

O.D.O.T. DISTRICT 2 SURVEY OFFICE (USE ONLY)

PERSONNEL

REFERENCE NO. 1

SHEET OF

NOTES RHODES

DATE 7/7/21

ROUTE US 6

H.C. AUBLE

WEATHER HAZY

COUNTY HENRY

R.C. NIESE

TEMP. 77°

TOWNSHIP RIDGEVILLE

SECTION 31

DWG BY BARRIERE

PID 101274

T 6 N R 5 E

TYPE MONUMENT MONBOX W/ 1" IPIN

ON SURFACE - BELOW ON

OFFSET $\mathcal{C}$ PAVEMENT 10.5' RT LT : RT

 TO EDGE PAVEMENT

STATION: 0+00

HORIZ.DATUM: NAD83 2011


GEOID: 18

GRID: NORTHING: 652191.163


EASTING: 1463572.794

LDP: NORTHING:

EASTING:

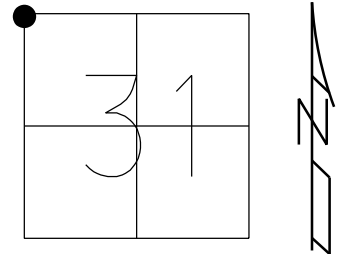

RECORD:
FD R.R.SPIKE
1 1/2" DOWN
5/6/85, MB
SET SM.R.R.SPIKE
6/13/85, SWH
FD R.R.SPIKE SHANK
4" DOWN
HENREF1
2/14/18, JFO
FD MAG SPIKE
REF1
7/7/21, DSA
FD MONBOX W/ 1" IPIN
NEWREF1
12/12/22, TDN

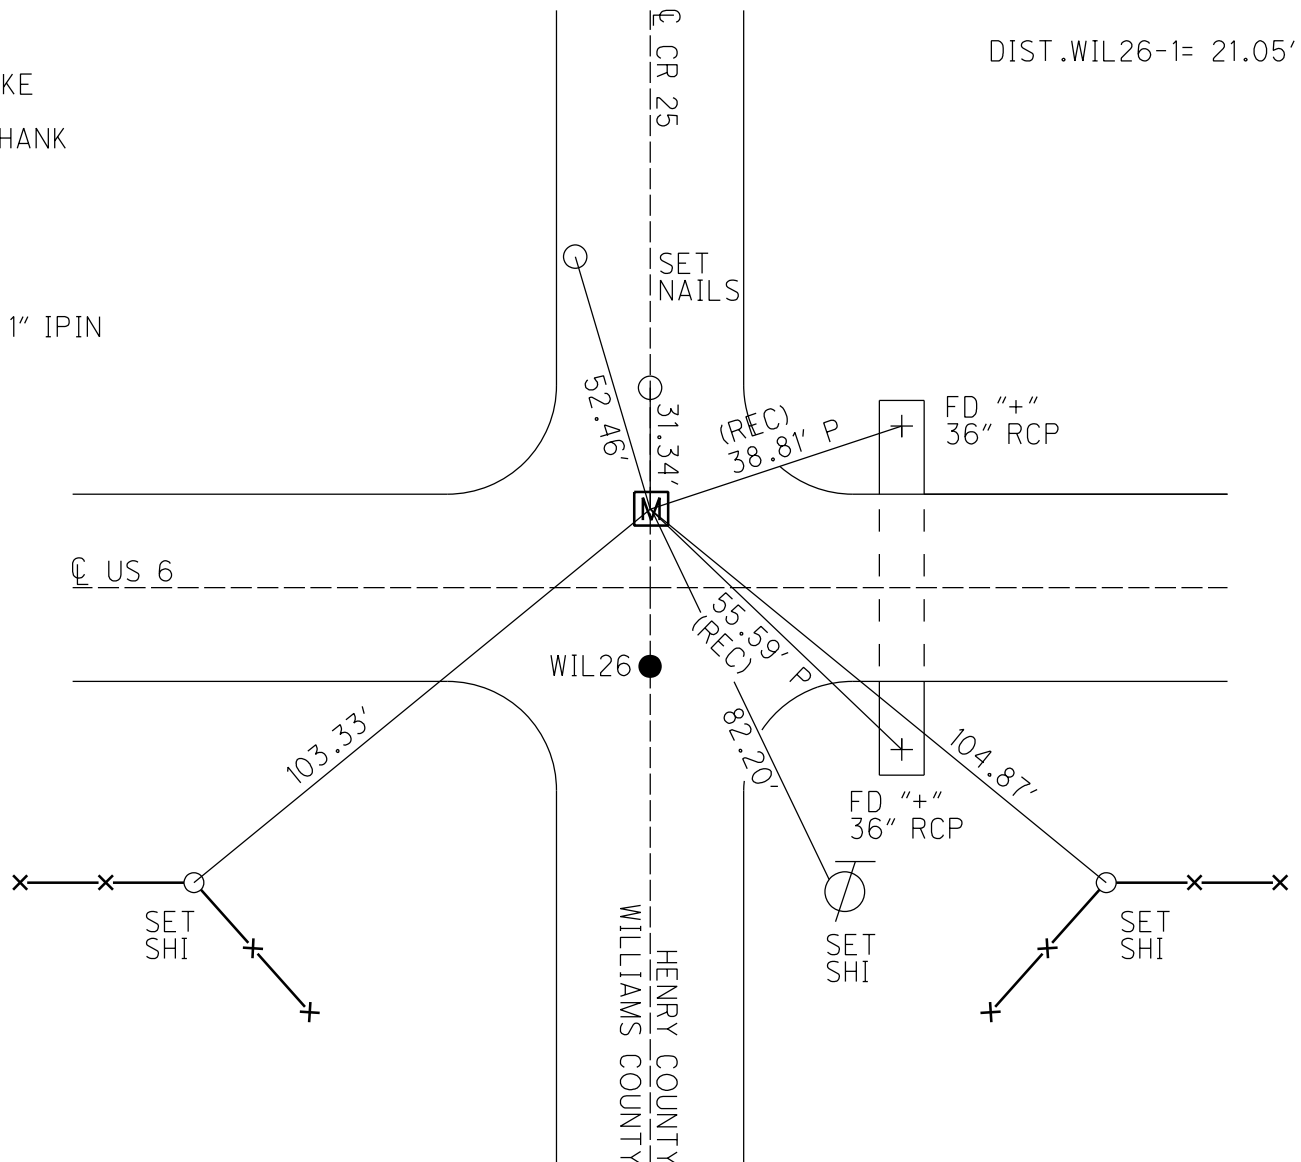

O.D.O.T. DISTRICT 2 SURVEY OFFICE (USE ONLY)

PERSONNEL

REFERENCE NO. 26

SHEET 9 OF 9

NOTES RHOADES

DATE 7/7/21

ROUTE US 6

H.C. AUBLE

WEATHER HAZE

COUNTY WILLIAMS

R.C. NIESE

TEMP. 77°

TOWNSHIP SPRINGFIELD

SECTION 36

DWG BY PRESTON-COLVIN PID 101274

T 6 N R 4 E

TYPE MONUMENT MON BOX

ON SURFACE - ~~BELOW~~ ON

OFFSET Q PAVEMENT 10.5' ~~LT~~ : RT

- TO - EDGE PAVEMENT


STATION: 1280+69.09

HORIZ.DATUM: NAD83 2011


GEOID: NAVD88 2012A

GRID: NORTHING: 652170.116

EASTING: 1463572.583

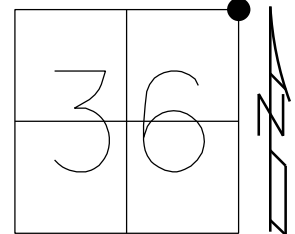

RECORD:
STA. 701+20.5
SET SM.R.R. SPIKE
6/13/85, SWH
FD MAG/WASHER
REF26
2/14/18, JFO
FD MAG SPIKE
(REF26) WIL26
7/7/21, DSA
FD MON BOX
W/1" IPIN
NEWWIL26
12/12/22, TDN

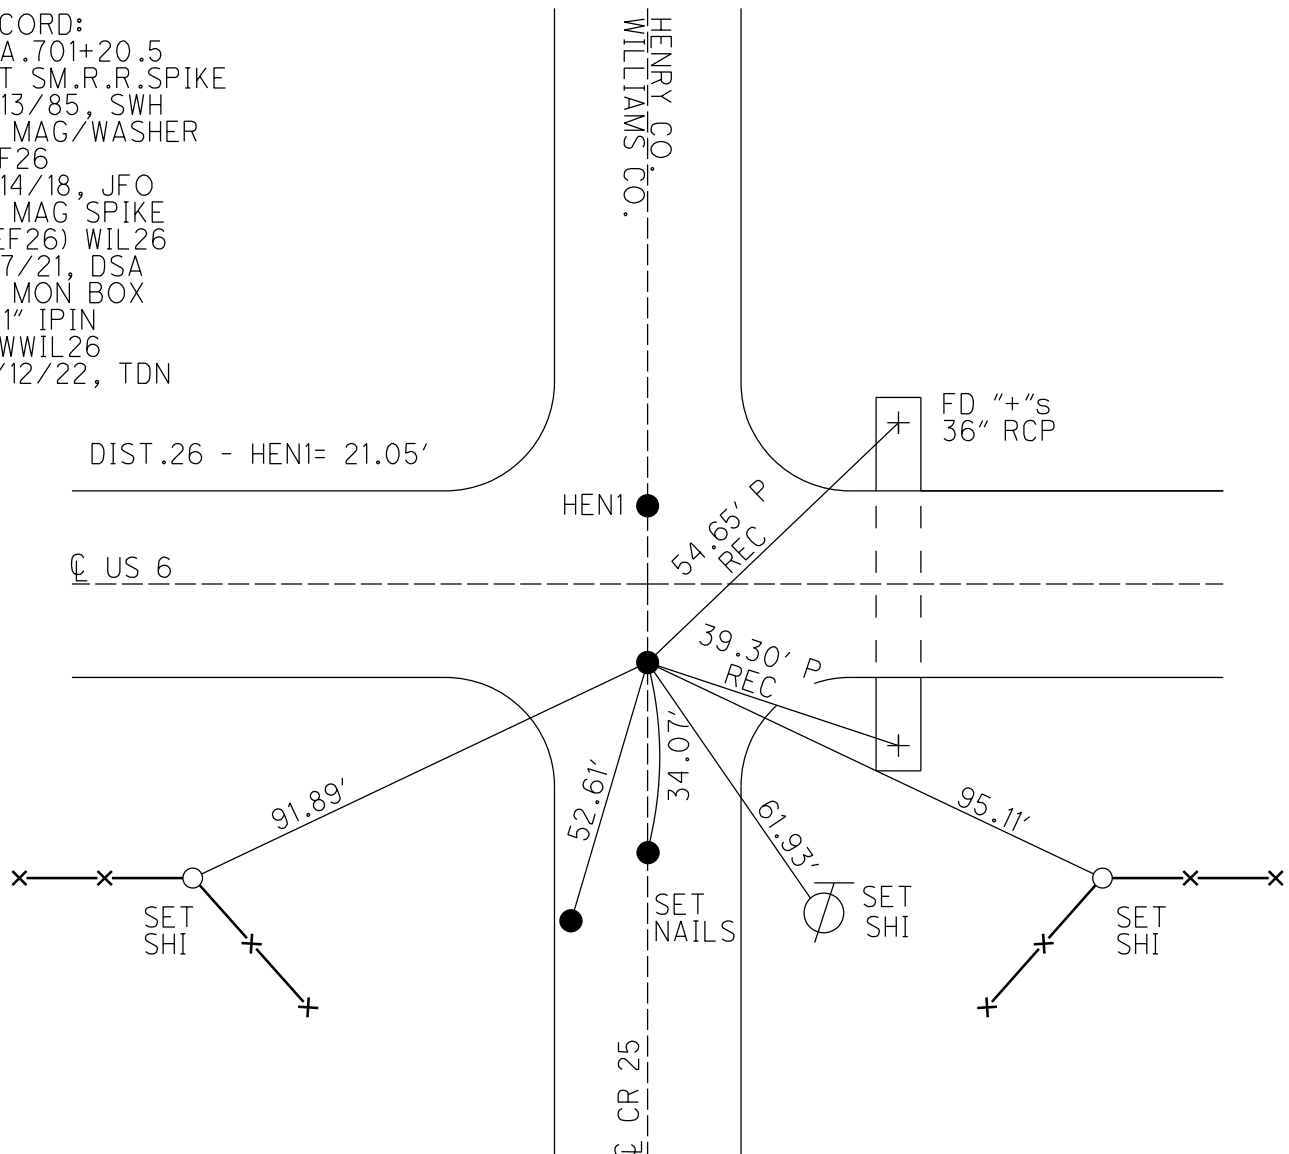

O.D.O.T. DISTRICT 2 SURVEY OFFICE (USE ONLY)

PERSONNEL

REFERENCE NO. 2

SHEET OF

NOTES RHODES

DATE 7/7/21

ROUTE US 6

H.C. AUBLE

WEATHER FAIR

COUNTY HENRY

R.C. NIESE

TEMP. 77°

TOWNSHIP RIDGEVILLE

SECTION 31

DWG BY BARRIERE

PID 101274

T 6 N R 5 E

TYPE MONUMENT MONBOX W/ 1" IPIN

ON SURFACE - BELOW ON

OFFSET $\odot$ PAVEMENT 1.2' LT LT : RT

 TO EDGE PAVEMENT

STATION: 19+87.49

HORZ.DATUM: NAD83 2011


GEOID: 18

GRID: NORTHING: 652146.153


EASTING: 1465559.773

LDP: NORTHING:

EASTING:

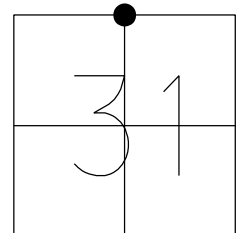

RECORD: P.O.T.
STA. 19+87.65
FD SM.R.R.SPIKE
4/14/97, CL
SET P.K./WASHER
6/26/97, CL
FD P.K./WASHER
HENREF2
2/14/18, JFO
FD MAG SPIKE
REF2
7/7/21, DSA
FD MONBOX W/ 1" IPIN
NEWREF2
12/12/22, TDN

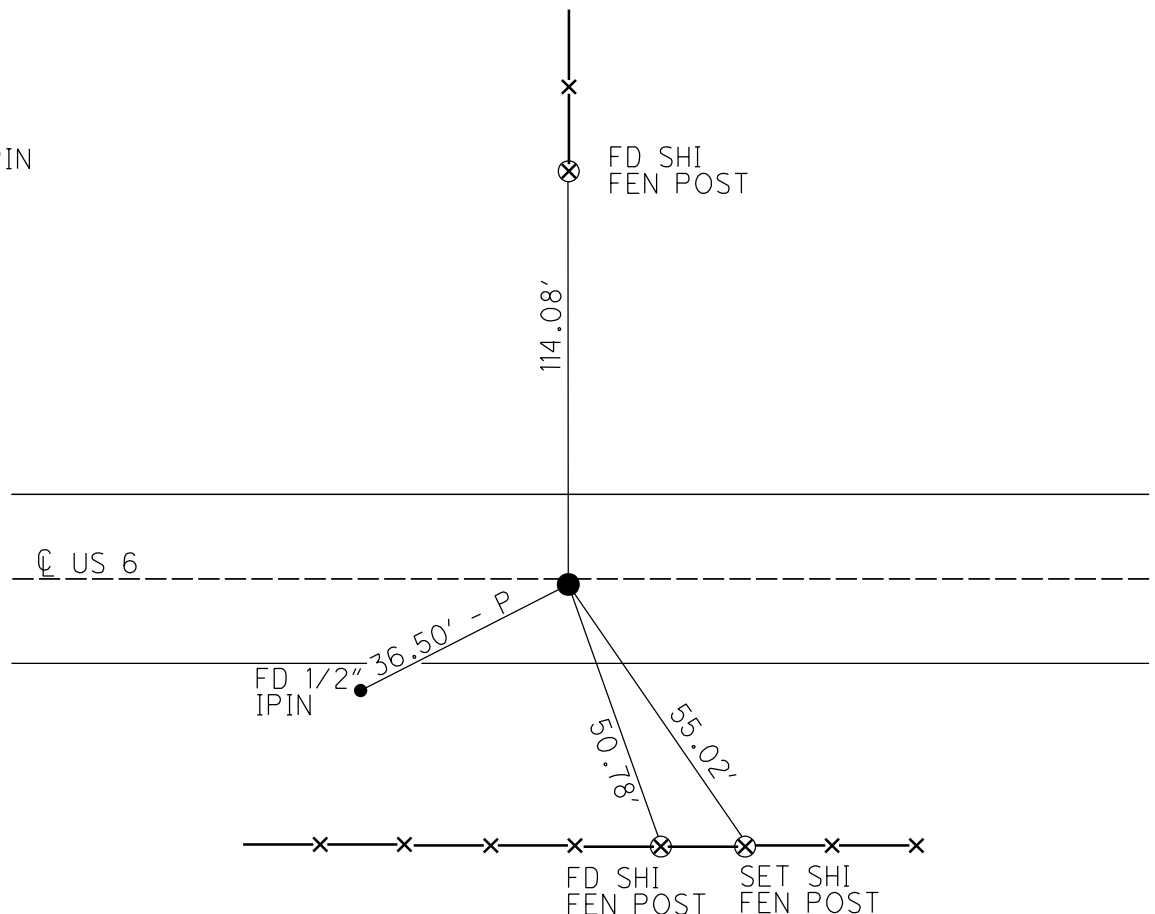

O.D.O.T. DISTRICT 2 SURVEY OFFICE (USE ONLY)

PERSONNEL

REFERENCE NO. 3

SHEET OF

NOTES RHODES

DATE 7/7/21

ROUTE US 6

H.C. AUBLE

WEATHER FAIR

COUNTY HENRY

R.C. NIESE

TEMP. 77°

TOWNSHIP RIDGEVILLE

DWG BY BARRIERE

PID 101274

SECTION 32

T 6 N R 5 E

TYPE MONUMENT MONBOX W/ 1" IPIN

ON SURFACE - BELOW ON

OFFSET $\oslash$ PAVEMENT ON LT : RT

 TO EDGE PAVEMENT

STATION: 46+26

HORZ.DATUM: NAD83 2011


GEOID: 18

GRID: NORTHING: 652086.686


EASTING: 1468190.681

LDP: NORTHING:

EASTING:

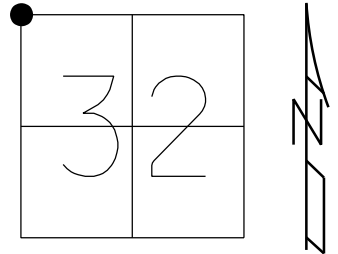

RECORD: P.I.
STA 46+19.55
FD SM R.R. SPIKE
4/14/97, BWC
SET P.K./WASHER
6/26/97
FD MAG SPIKE
REF3
7/7/21, DSA
FD MONBOX W/ 1" IPIN
NEWREF3
12/12/22, TDN

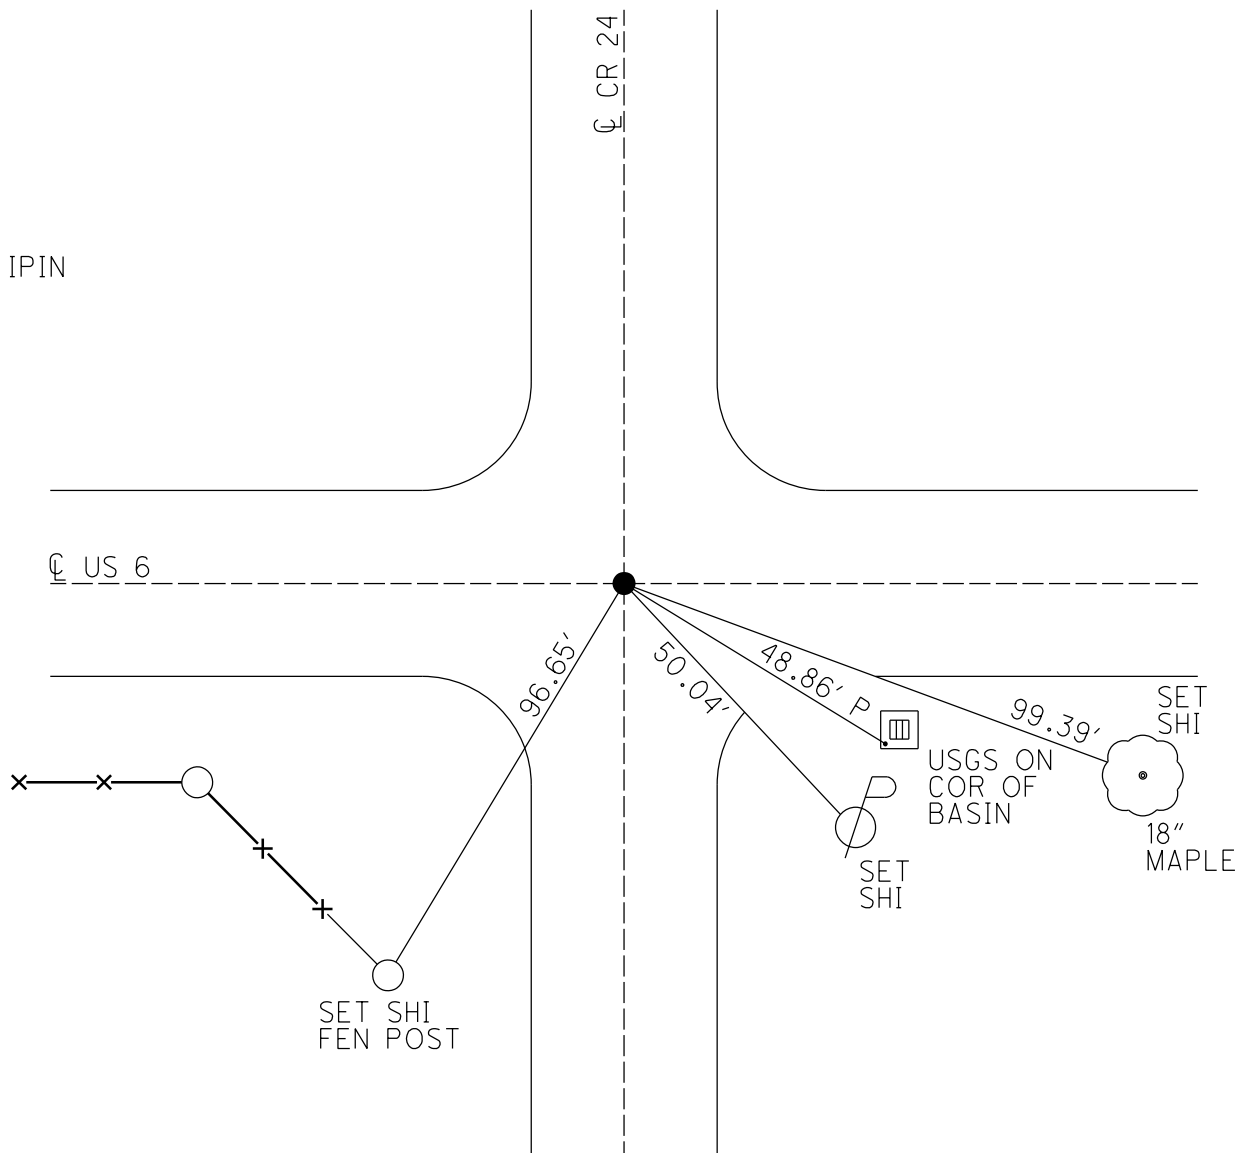

O.D.O.T. DISTRICT 2 SURVEY OFFICE (USE ONLY)

PERSONNEL

REFERENCE NO. 4

SHEET OF

NOTES RHODES

DATE 7/7/21

ROUTE US 6

H.C. AUBLE

WEATHER FAIR

COUNTY HENRY

R.C. NIESE

TEMP. 77°

TOWNSHIP RIDGEVILLE

SECTION 32

DWG BY BARRIERE

PID 101274

T 6 N R 5 E

TYPE MONUMENT MONBOX W/ 1" IPIN

ON SURFACE - BELOW ON

OFFSET Q PAVEMENT ON LT : RT

 TO EDGE PAVEMENT

STATION: 72+67

HORZ.DATUM: NAD83 2011


GEOID: 18

GRID: NORTHING: 652033.630

EASTING: 1470833.475


LDP: NORTHING:

EASTING:

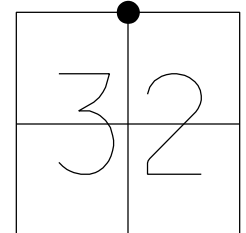

RECORD: P.I.
STA 72+63.84
FD SM R.R. SPIKE
4/14/97, BWC
SET P.K./WASHER
6/26/97, BWC
FD MAG SPIKE
REF4
7/7/21, DSA
FD MONBOX W/ 1" IPIN
NEWREF4
12/12/22, TDN

Q US 6

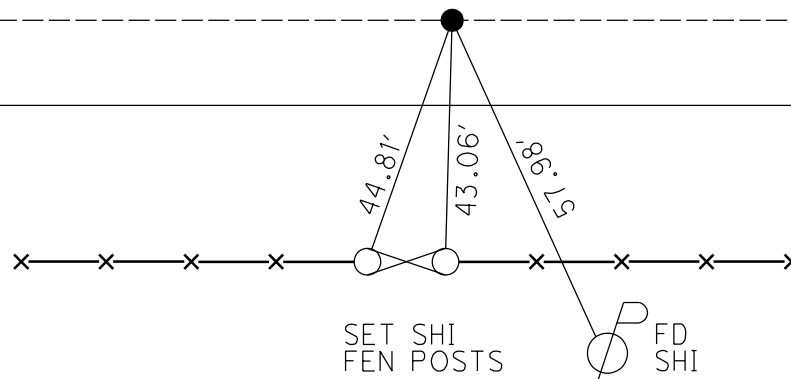

O.D.O.T. DISTRICT 2 SURVEY OFFICE (USE ONLY)

PERSONNEL

REFERENCE NO. A4

SHEET OF

NOTES NIESE

DATE 12/12/22

ROUTE US 6

H.C. NIESE

WEATHER

COUNTY HENRY

R.C. NIESE

TEMP.

TOWNSHIP RIDGEVILLE

DWG BY BARRIERE

PID 101274

SECTION 29

T 6 N R 5 E

TYPE MONUMENT MONBOX W/ 1" IPIN

ON SURFACE - BELOW ON

OFFSET $\oslash$ PAVEMENT ON LT : RT

 TO EDGE PAVEMENT

STATION: 78+51.45

HORZ.DATUM: NAD83 2011


GEOID: 18

GRID: NORTHING: 652023.166

EASTING: 1471421.868

LDP: NORTHING:

EASTING:

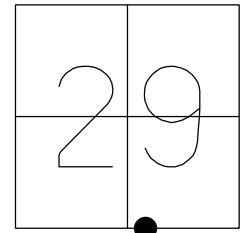

RECORD: P.C.
STA 78+51.45, $\oslash$ CONSTR
PER HEN-6-0.00 (2021)
PID 101274

FD MONBOX W/ 1" IPIN
NEWREFA4
12/12/22, TDN

$\oslash$ US 6



O.D.O.T. DISTRICT 2 SURVEY OFFICE (USE ONLY)

PERSONNEL

REFERENCE NO. B4

SHEET OF

NOTES NIESE

DATE 12/12/22

ROUTE US 6

H.C. NIESE

WEATHER

COUNTY HENRY

R.C. NIESE

TEMP.

TOWNSHIP RIDGEVILLE

DWG BY BARRIERE

PID 101274

SECTION 32

T 6 N R 5 E

TYPE MONUMENT MONBOX W/ 1" IPIN

ON SURFACE - BELOW ON

OFFSET ϕ PAVEMENT ON LT : RT

 TO EDGE PAVEMENT

STATION: 83+24.78

HORZ.DATUM: NAD83 2011


GEOID: 18

GRID: NORTHING: 651995.410

EASTING: 1471894.190

LDP: NORTHING:

EASTING:

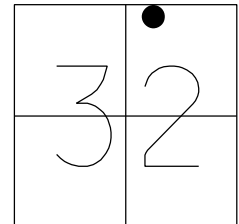

RECORD: P.T.
STA 83+24.78, ϕ CONSTR
PER HEN-6-0.00 (2021)
PID 101274

FD MONBOX W/ 1" IPIN
NEWREFB4
12/12/22, TDN

 ϕ US 6 M

O.D.O.T. DISTRICT 2 SURVEY OFFICE (USE ONLY)

PERSONNEL

REFERENCE NO. C4

SHEET _____ OF _____

NOTES NIESE

DATE 12/12/22

ROUTE US 6

H.C. NIESE

WEATHER _____

COUNTY HENRY

R.C. NIESE

TEMP. _____

TOWNSHIP RIDGEVILLE

DWG BY BARRIERE

PID 101274

SECTION 32

T 6 N R 5 E

TYPE MONUMENT MONBOX W/ 1" IPIN

ON SURFACE - BELOW ON

OFFSET $\odot$ PAVEMENT ON LT : RT

TO EDGE PAVEMENT

STATION: 86+26.93

HORZ.DATUM: NAD83 2011


GEOID: 18

GRID: NORTHING: 651965.167

EASTING: 1472194.791


LDP: NORTHING: _____

EASTING: _____

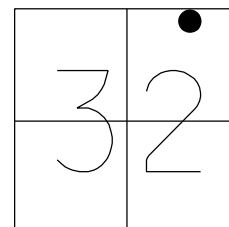

RECORD: P.C.
STA 86+26.93, $\odot$ CONSTR
PER HEN-6-0.00 (2021)
PID 101274

FD MONBOX W/ 1" IPIN
NEWREFC4
12/12/22, TDN

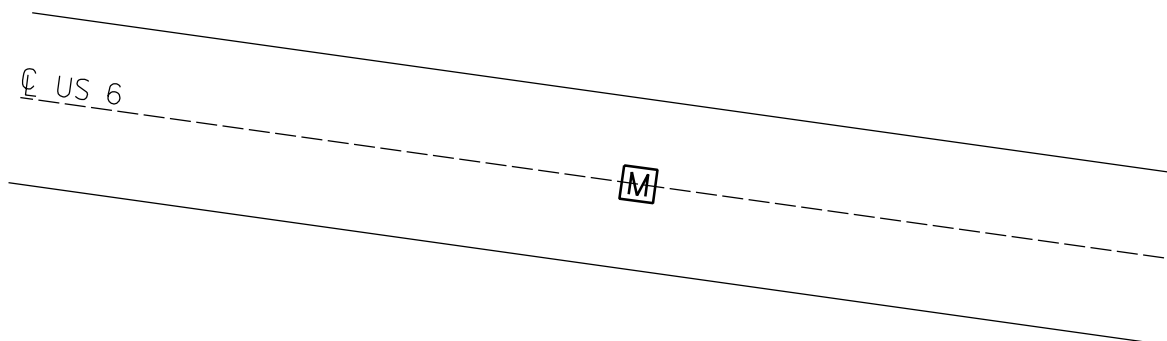

O.D.O.T. DISTRICT 2 SURVEY OFFICE (USE ONLY)

PERSONNEL

REFERENCE NO. D4

SHEET OF

NOTES NIESE

DATE 12/12/22

ROUTE US 6

H.C. NIESE

WEATHER

COUNTY HENRY

R.C. NIESE

TEMP.

TOWNSHIP RIDGEVILLE

DWG BY BARRIERE

PID 101274

SECTION 32

T 6 N R 5 E

TYPE MONUMENT MONBOX W/ 1" IPIN

ON SURFACE - BELOW ON

OFFSET $\varnothing$ PAVEMENT ON LT : RT

 TO EDGE PAVEMENT

STATION: 95+70.26

HORIZ.DATUM: NAD83 2011


GEOID: 18

GRID: NORTHING: 651948.268

EASTING: 1473136.808


LDP: NORTHING:

EASTING:

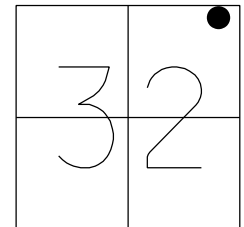

RECORD: P.T.
STA 95+70.26, $\varnothing$ CONSTR
PER HEN-6-0.00 (2021)
PID 101274

FD MONBOX W/ 1" IPIN
NEWREFD4
12/12/22, TDN

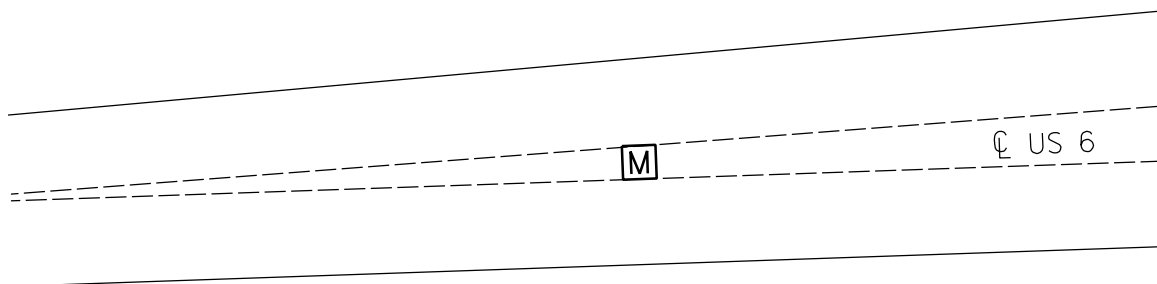

O.D.O.T. DISTRICT 2 SURVEY OFFICE (USE ONLY)

PERSONNEL

REFERENCE NO. E4

SHEET OF

NOTES NIESE

DATE 12/12/22

ROUTE US 6

H.C. NIESE

WEATHER

COUNTY HENRY

R.C. NIESE

TEMP.

TOWNSHIP RIDGEVILLE

DWG BY BARRIERE

PID 101274

SECTION 32

T 6 N R 5 E

TYPE MONUMENT MONBOX W/ 1" IPIN

ON SURFACE - BELOW ON

OFFSET $\oslash$ PAVEMENT ON LT : RT

 TO EDGE PAVEMENT

STATION: 98+69.13

HORZ.DATUM: NAD83 2011


GEOID: 18

GRID: NORTHING: 651967.553

EASTING: 1473435.125


LDP: NORTHING:

EASTING:

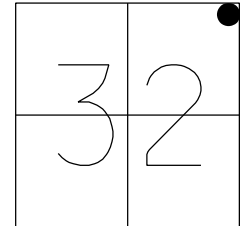

RECORD: P.C.
STA 98+69.13, $\oslash$ CONSTR
PER HEN-6-0.00 (2021)
PID 101274

FD MONBOX W/ 1" IPIN
NEWREFE4
12/12/22, TDN

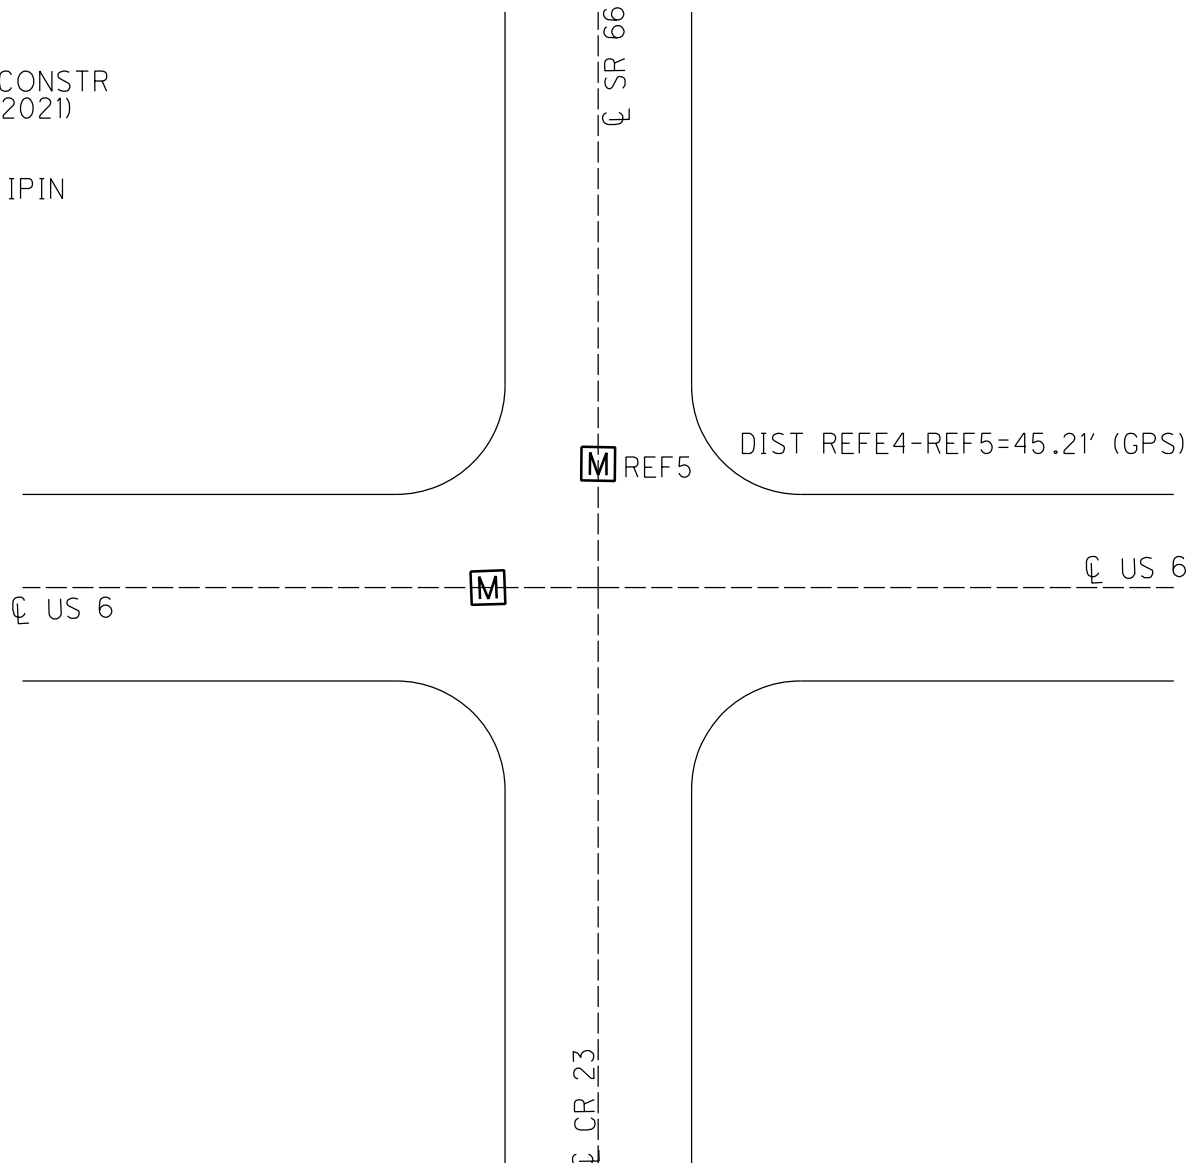

O.D.O.T. DISTRICT 2 SURVEY OFFICE (USE ONLY)

PERSONNEL

REFERENCE NO. 5

SHEET OF

NOTES RHODES

DATE 7/7/21

ROUTE US 6

H.C. AUBLE

WEATHER FAIR

COUNTY HENRY

R.C. NIESE

TEMP. 77°

TOWNSHIP RIDGEVILLE

SECTION 32

DWG BY BARRIERE

PID 101274

T 6 N R 5 E

TYPE MONUMENT MONBOX W/ 1" IPIN

ON SURFACE - BELOW ON

OFFSET $\odot$ PAVEMENT ON LT : RT

 TO EDGE PAVEMENT

STATION: 98+69.13

HORZ.DATUM: NAD83 2011

GEOID: 18


GRID: NORTHING: 651967.553

EASTING: 1473435.125


LDP: NORTHING:

EASTING:

29	28
32	33

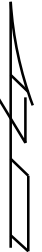

RECORD:
FD RR SPIKE 1 1/2"
BELOW SURFACE
10/22/84, SWH
SET PK/WASHER
6/13/85, SH
FD MAG/SPIKE
REF5
7/7/21, DSA
FD MONBOX W/ 1" IPIN
NEWREF5
12/12/22, TDN

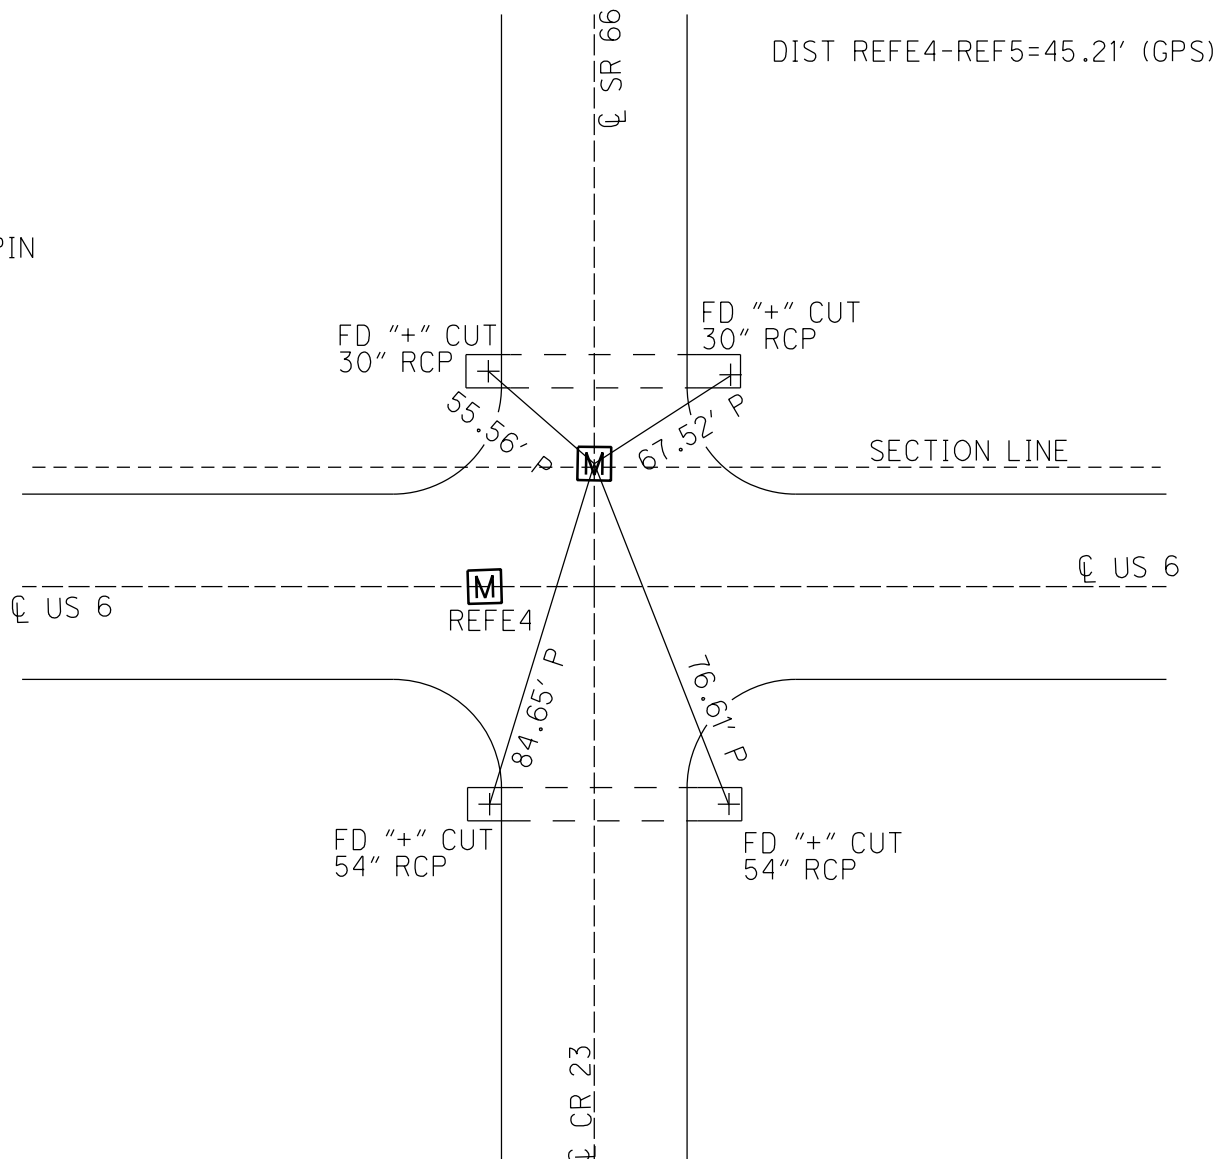

O.D.O.T. DISTRICT 2 SURVEY OFFICE (USE ONLY)

PERSONNEL

REFERENCE NO. CR23

SHEET 3 OF 7

NOTES HOFFMAN

DATE 10/30/87

ROUTE CR 23

H.C. LOEHRKE

WEATHER CLEAR

COUNTY HENRY

R.C. BARNHISEL

TEMP. 55°

TOWNSHIP RIDGEVILLE

SECTION 33

DWG BY NIESE PID

T 6 N R 5 E

TYPE MONUMENT IPIN

~~ON SURFACE~~ - BELOW BELOW


OFFSET Q PAVEMENT 1.0' LT : RT

- TO - EDGE PAVEMENT


STATION: -

HORIZ.DATUM: GEOID:

GRID: NORTHING: EASTING:

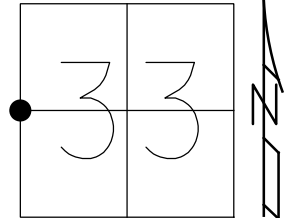

RECORD:
FD IPIN
10/30/87, SWH
SET NAIL/SHINER
FROM CO. REF
10/30/87, SWH

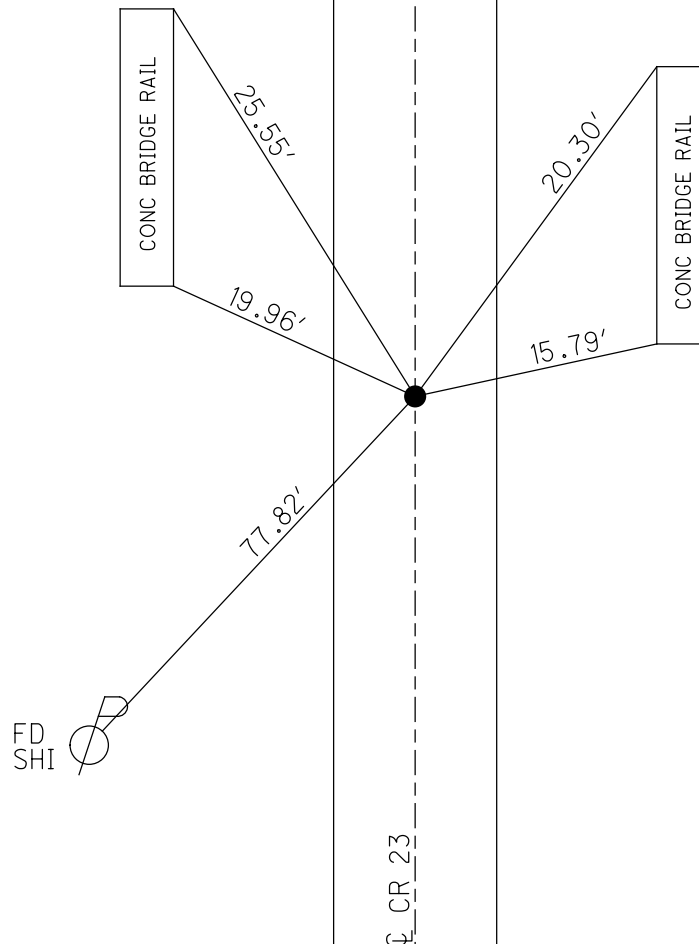

O.D.O.T. DISTRICT 2 SURVEY OFFICE (USE ONLY)

PERSONNEL

REFERENCE NO. A5

SHEET _____ OF _____

NOTES NIESE

DATE 12/12/22

ROUTE US 6

H.C. NIESE

WEATHER FAIR

COUNTY HENRY

R.C. NIESE

TEMP. 77°

TOWNSHIP RIDGEVILLE

DWG BY BARRIERE

PID 101274

SECTION 32

T 6 N R 5 E

TYPE MONUMENT MONBOX W/ 1" IPIN

ON SURFACE - BELOW ON

OFFSET Q PAVEMENT ON LT : RT

TO EDGE PAVEMENT

STATION: 95+70.26

HORIZ.DATUM: NAD83 2011


GEOID: 18

GRID: NORTHING: 651978.199

EASTING: 1473917.850


LDP: NORTHING: _____

EASTING: _____

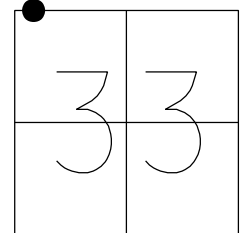

RECORD: P.T.
STA103+52.18, Q CONSTR
PER HEN-6-0.00 (2021)
PID 101274

FD MONBOX W/ 1" IPIN
NEWREFA5
12/12/22, TDN

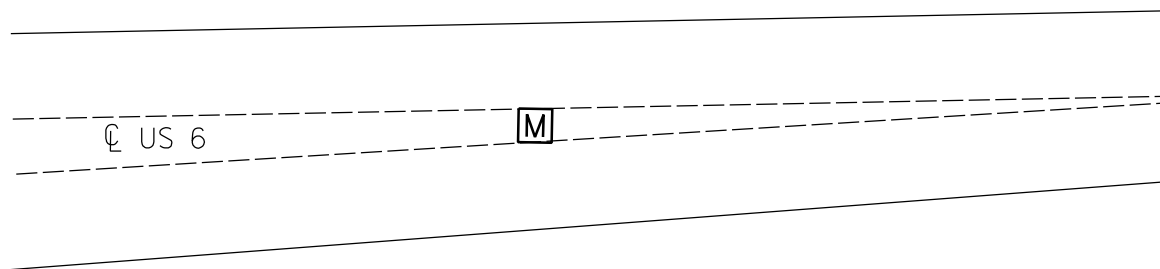

O.D.O.T. DISTRICT 2 SURVEY OFFICE (USE ONLY)

PERSONNEL

REFERENCE NO. 6

SHEET OF

NOTES RHODES

DATE 7/7/21

ROUTE US 6

H.C. AUBLE

WEATHER FAIR

COUNTY HENRY

R.C. NIESE

TEMP. 77°

TOWNSHIP RIDGEVILLE

DWG BY BARRIERE

PID 101274

SECTION 38

T 6 N R 5 E

TYPE MONUMENT MONBOX W/ 1" IPIN

ON SURFACE - BELOW ON

OFFSET $\odot$ PAVEMENT ON LT : RT

 TO EDGE PAVEMENT

STATION: 125+66

HORIZ.DATUM: NAD83 2011


GEOID: 18

GRID: NORTHING: 651934.377

EASTING: 1476116.697


LDP: NORTHING:

EASTING:

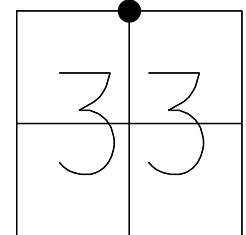

RECORD: P.I.
STA 125+50.64
 $\Delta = 0^\circ 11.5'$ LT

FD SM R.R. SPIKE
4/14/97, BWC
SET SM R.R. SPIKE
6/26/97, BWC
FD MAG SPIKE
REF6
7/7/21, DSA
FD MONBOX W/ 1" IPIN
NEWREF6
12/12/22, TDN

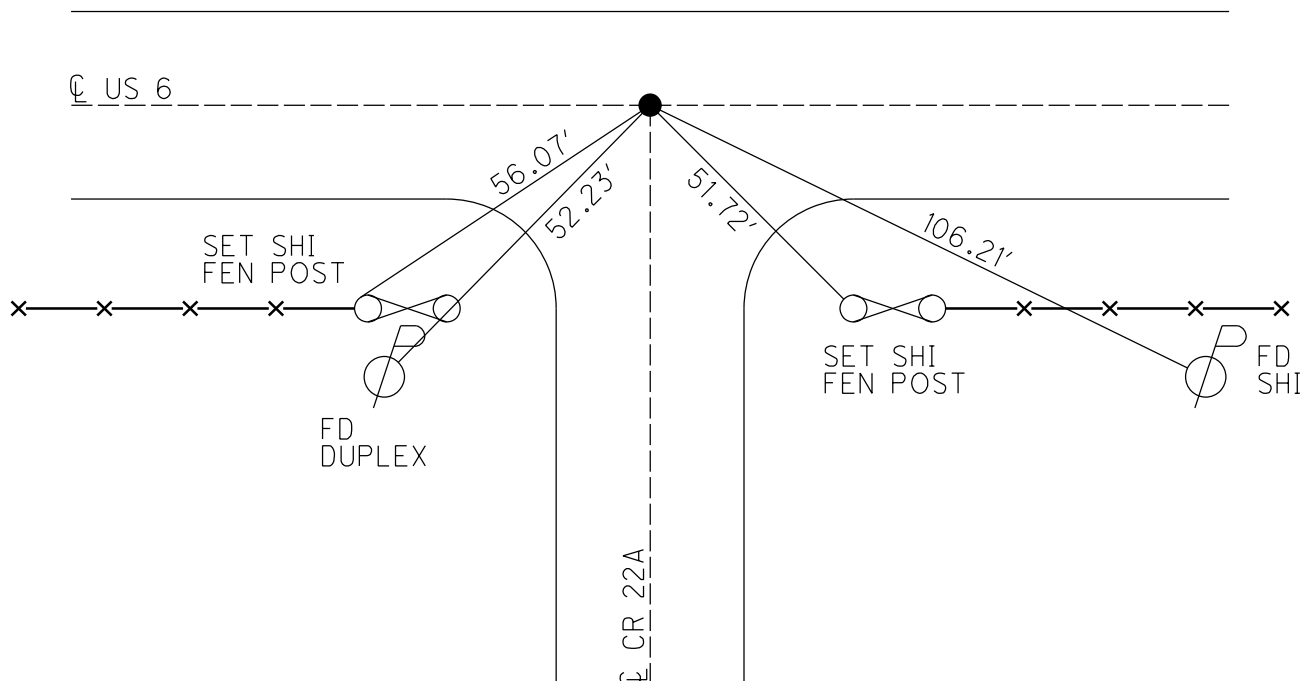

O.D.O.T. DISTRICT 2 SURVEY OFFICE (USE ONLY)

PERSONNEL

REFERENCE NO. 7

SHEET OF

NOTES RHODES

DATE 7/7/21

ROUTE US 6

H.C. AUBLE

WEATHER FAIR

COUNTY HENRY

R.C. NIESE

TEMP. 77°

TOWNSHIP RIDGEVILLE

DWG BY BARRIERE

PID 101274

SECTION 38

T 6 N R 5 E

TYPE MONUMENT MONBOX W/ 1" IPIN

ON SURFACE - BELOW ON

OFFSET $\varnothing$ PAVEMENT ON LT : RT

 TO EDGE PAVEMENT

STATION: 151+67

HORIZ.DATUM: NAD83 2011


GEOID: 18

GRID: NORTHING: 651890.506

EASTING: 1478757.983


LDP: NORTHING:

EASTING:

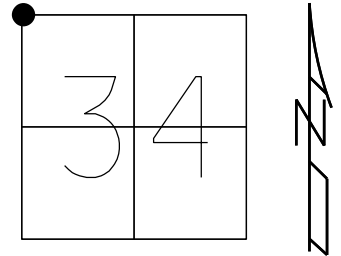

RECORD: P.I.
STA 151+92.72
 $\Delta = 0^\circ 02' \text{ LT}$

FD SM R.R. SPIKE
4/14/97, BWC
SET P.K./WASHER
7/1/97
FD MONBOX W/ 1" IPIN
NEWREF7
12/12/22, TDN

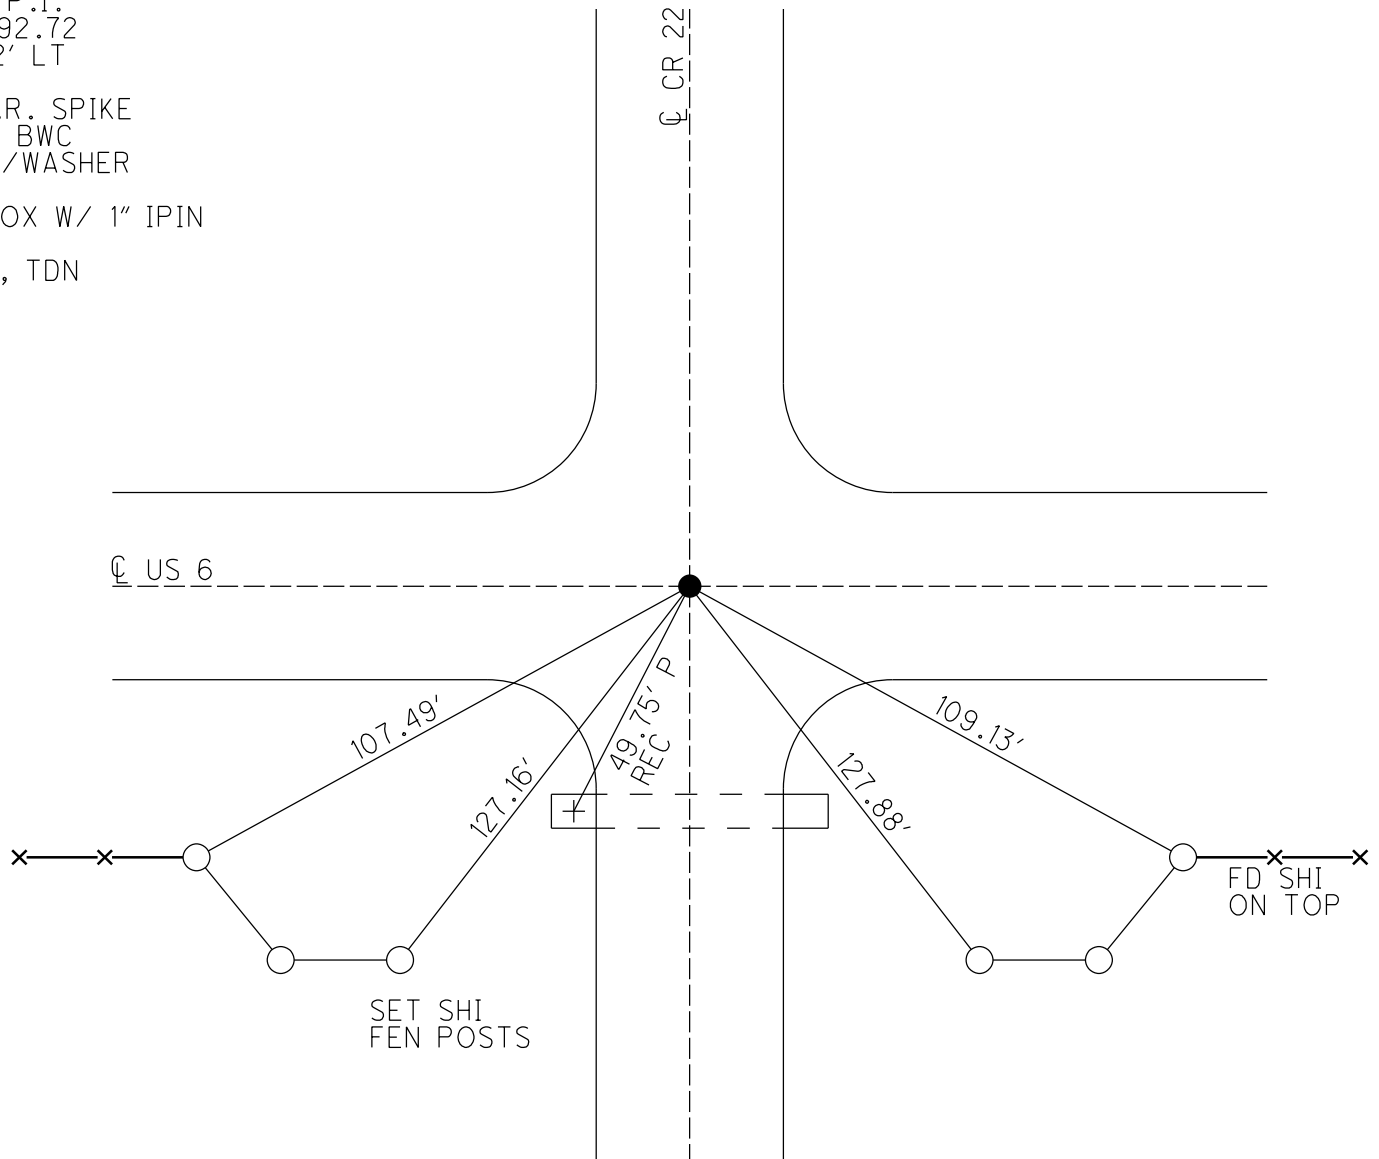

O.D.O.T. DISTRICT 2 SURVEY OFFICE (USE ONLY)

PERSONNEL

REFERENCE NO. 8

SHEET OF

NOTES RHODES

DATE 7/7/21

ROUTE US 6

H.C. AUBLE

WEATHER FAIR

COUNTY HENRY

R.C. NIESE

TEMP. 77°

TOWNSHIP RIDGEVILLE

SECTION 27

DWG BY BARRIERE

PID 101274

T 6 N R 5 E

TYPE MONUMENT MONBOX W/ 1" IPIN

ON SURFACE - BELOW ON

OFFSET $\varnothing$ PAVEMENT ON LT : RT

 TO EDGE PAVEMENT

STATION: 178+70.38

HORIZ.DATUM: NAD83 2011



GEOID: 18

GRID: NORTHING: 651848.026

EASTING: 1481413.679


LDP: NORTHING:

EASTING:

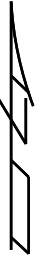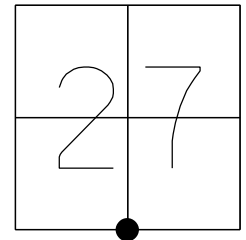

RECORD: P.I.
STA. 178+49.81

FD R.R.SPIKE
ON CONC. SURFACE
7/9/74, BEACH
FD SM.R.R.SPIKE
4/14/97, CL
SET P.K./WASHER
6/26/97, BWC
FD NAIL
SR6-REF8
3/7/16, JFO
FD MAG SPIKE
REF8
7/7/21, DSA
FD MONBOX W/ 1" IPIN
NEWREF8
12/12/22, TDN

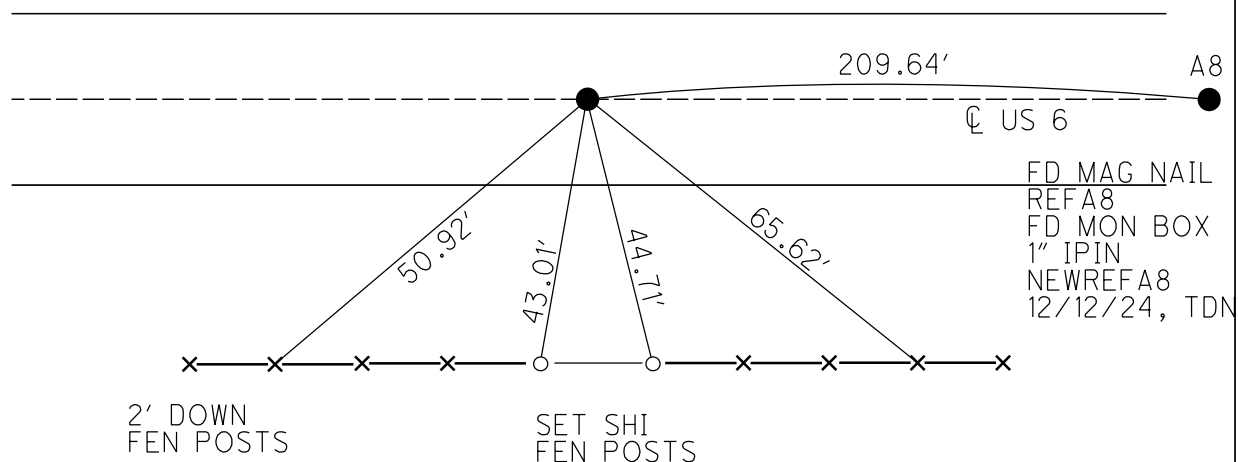

O.D.O.T. DISTRICT 2 SURVEY OFFICE (USE ONLY)

PERSONNEL

REFERENCE NO. A8

SHEET OF

NOTES NIESE

DATE 12/12/22

ROUTE US 6

H.C. NIESE

WEATHER FAIR

COUNTY HENRY

R.C. NIESE

TEMP. 77°

TOWNSHIP RIDGEVILLE

DWG BY BARRIERE

PID 101274

SECTION 34

T 6 N R 5 E

TYPE MONUMENT MONBOX W/ 1" IPIN

ON SURFACE - BELOW ON

OFFSET $\text{\textcircled{C}}$ PAVEMENT ON LT : RT

 TO EDGE PAVEMENT

STATION: 180+59.34

HORIZ.DATUM: NAD83 2011


GEOID: 18

GRID: NORTHING: 651844.644

EASTING: 1481623.278

LDP: NORTHING:

EASTING:

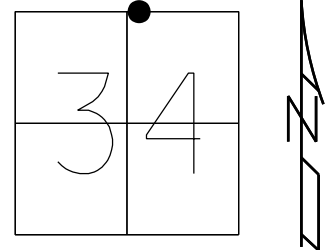

RECORD: P.C.
STA. 180+59.34
PER HEN-6-0.00 (2021)
PID 101274 PLANS

FD MAG NAIL
REF A8
7/7/21, DSA
FD MONBOX W/ 1" IPIN
NEW REF A8
12/12/22, TDN

-----  ----- $\text{\textcircled{C}}$ US 6

O.D.O.T. DISTRICT 2 SURVEY OFFICE (USE ONLY)

PERSONNEL	REFERENCE NO. <u>10</u>	SHEET <u>2</u> OF <u>47</u>
NOTES <u>BARNHISEL</u>	DATE <u>4/5/00</u>	ROUTE <u>US 6</u>
H.C. <u>CANTERBURY</u>	WEATHER <u>WINDY</u>	COUNTY <u>HENRY</u>
R.C. <u>BARNHISEL</u>	TEMP. <u>45°</u>	TOWNSHIP <u>RIDGEVILLE</u>
		SECTION <u>34</u>
		T <u>6</u> N R <u>5</u> E


TYPE MONUMENT 1/2" IPIPE

~~ON SURFACE~~ - BELOW 6"


LEFT - ℄ PAV'T - ~~RIGHT~~ 1.0', 14.5' W OF ℄ N
12.7' TO RT EDGE PAVEMENT

S.L.M. 206+18.40

Grid: Northing: 651172.009 Easting: 1484050.943

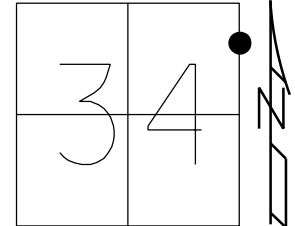

RECORD: P.I.
 STA. 205+98.25
 FD 1/2" IPIPE
 ATOP BOLT
 3/17/77, BEACH
 FD 1/2" IPIPE
 6" DOWN
 4/5/00, MB
 SET P.K./WASHER
 10/23/00, MDB
 FD MONBOX W/ 1" IPIN
 SR6-REF10
 3/7/16, JFO

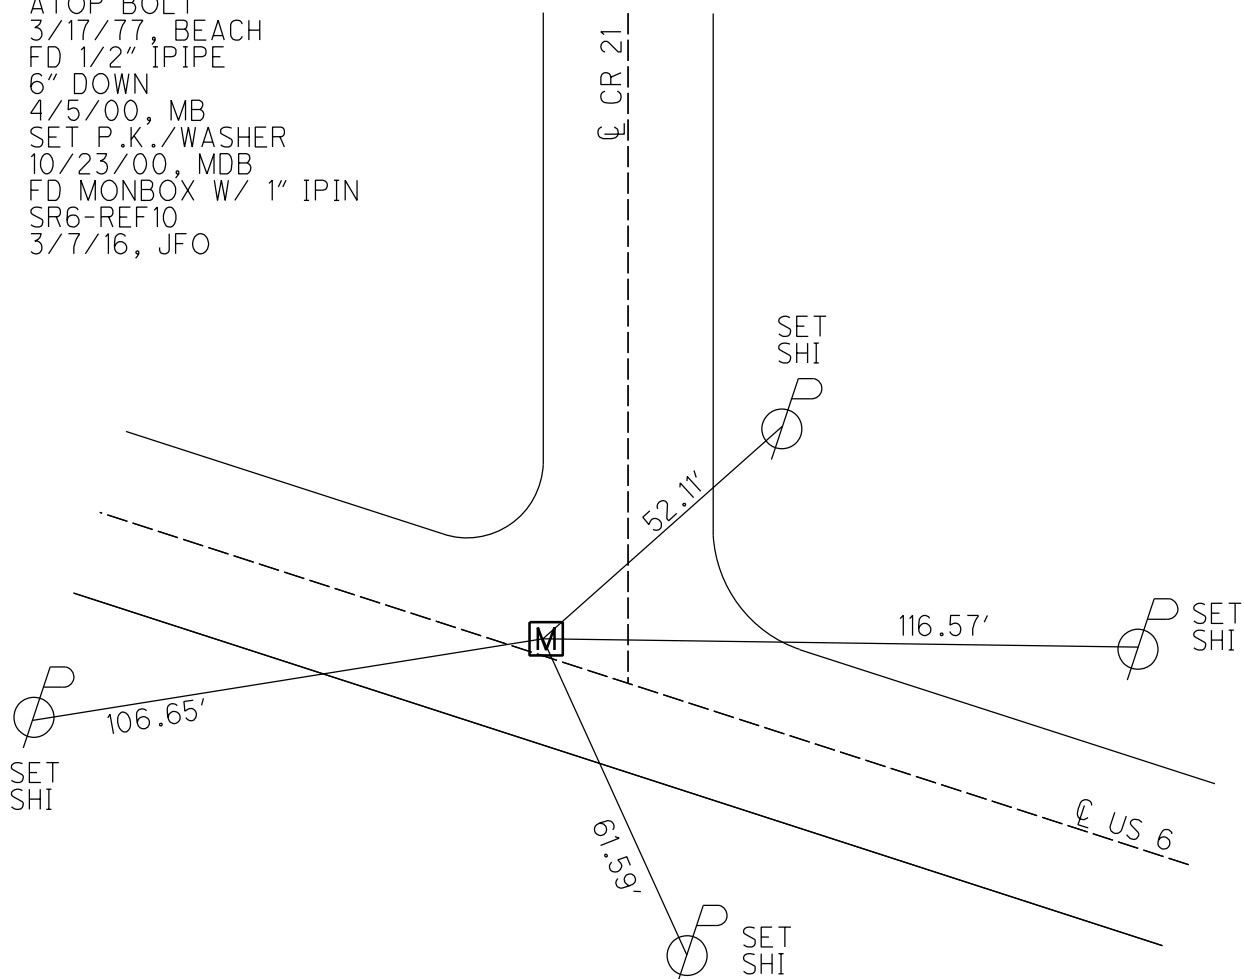

O.D.O.T. DISTRICT 2 SURVEY OFFICE (USE ONLY)

PERSONNEL

REFERENCE NO. 11

SHEET 3 OF 37


NOTES POORE
H.C. LEU
R.C. CARSON
RHOADES

DATE 5/17/17
WEATHER CLOUDY
TEMP. 70°

ROUTE US 6
COUNTY HENRY
TOWNSHIP RIDGEVILLE
SECTION 35
T 6 N R 5 E

TYPE MONUMENT P.K./WASHER
ON SURFACE - ~~BELOW~~ ON
~~LEFT~~ - Q PAV'T - RIGHT 1.5'
10.1' TO RT EDGE PAVEMENT
S.L.M. 215+54.76

Grid: Northing: 650815.940 Easting: 1484916.954

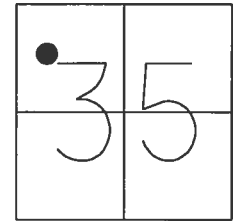

FD
SHI

134.76'

SET
SHI

68.32'

FD "+" 9' E.
OF APRON
BEGINNING

+ 13.68'

CONC.DRIVE TO
GAS STATION

127.40'

FD
DUPLEX

RECORD: P.I.
STA. 215+34.52
 $\Delta = 1^\circ 19' 15''$ LT
FD R.R.SPIKE
1 3/4" DOWN
3/17/77, BEACH
FD P.K./WASHER
4" DOWN
4/5/00, MB
SET P.K./WASHER
10/23/00, MDB
FD P.K./WASHER
SR6-REF11
3/7/16, JFO
SET MAG/WASHER
9/11/17, JFO

Q US 6

O.D.O.T. DISTRICT 2 SURVEY OFFICE (USE ONLY)

PERSONNEL

REFERENCE NO. 13

SHEET 4 OF 37

NOTES POORE

DATE 5/17/17

ROUTE US 6

H.C. LEU

WEATHER CLOUDY

COUNTY HENRY

R.C. CARSON

TEMP. 71°

TOWNSHIP RIDGEVILLE

HOMAN

SECTION 35

RHOADES

T 6 N R 5 F

TYPE MONUMENT P.K./WASHER


ON SURFACE - ~~BELOW~~ ON _____

LEFT - C PAV'T - ~~RIGHT~~ 1.7'


9.3' TO LT EDGE PAVEMENT

S.L.M. 225+01.40

Grid: Northing: 650476.189 Easting: 1485800.526

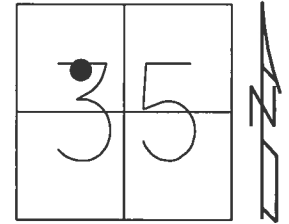

RECORD: P.I.
STA. 224+81.38
 $\Delta = 0^{\circ} 37' 30''$
FD P.K.NAIL
4" DOWN
8/30/00, MB
SET P.K./WASHER
10/23/00, MDB
FD P.K./WASHER
SR6-REF13
3/7/16, JFO
SET MAG/WASHER
9/11/17, JFO

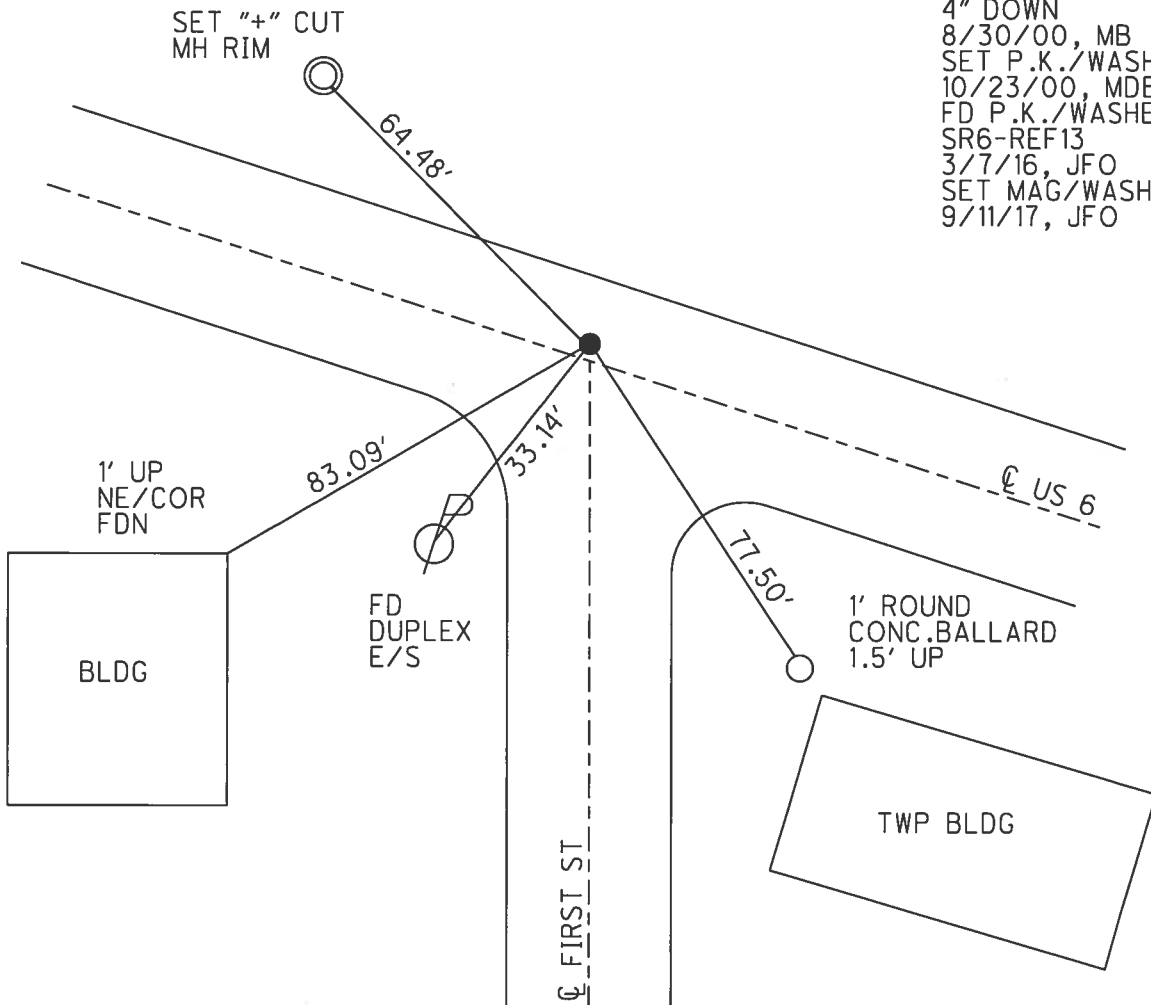

O.D.O.T. DISTRICT 2 SURVEY OFFICE (USE ONLY)

PERSONNEL

REFERENCE NO.

14

SHEET 5 OF 37

NOTES POORE

DATE _____

5/17/17

ROUTE US 6

H.C. LEU

WEATHER

CLOUDY

COUNTY HENRY

R.C. CARSON

TEMP.

 72° TOWNSHIP RIDGEVILLE

HOMAN

SECTION 35

RHOADES

T_6_N R_5_E

TYPE MONUMENT MAG/WASHER



ON SURFACE - ~~BELOW~~ ON

~~LEFT~~ - C PAV'T - RIGHT 2.5'

9.8' TO RT EDGE PAVEMENT

S.L.M. 230+03.58

Grid: Northing: 650290.968 Easting: 1486267.256

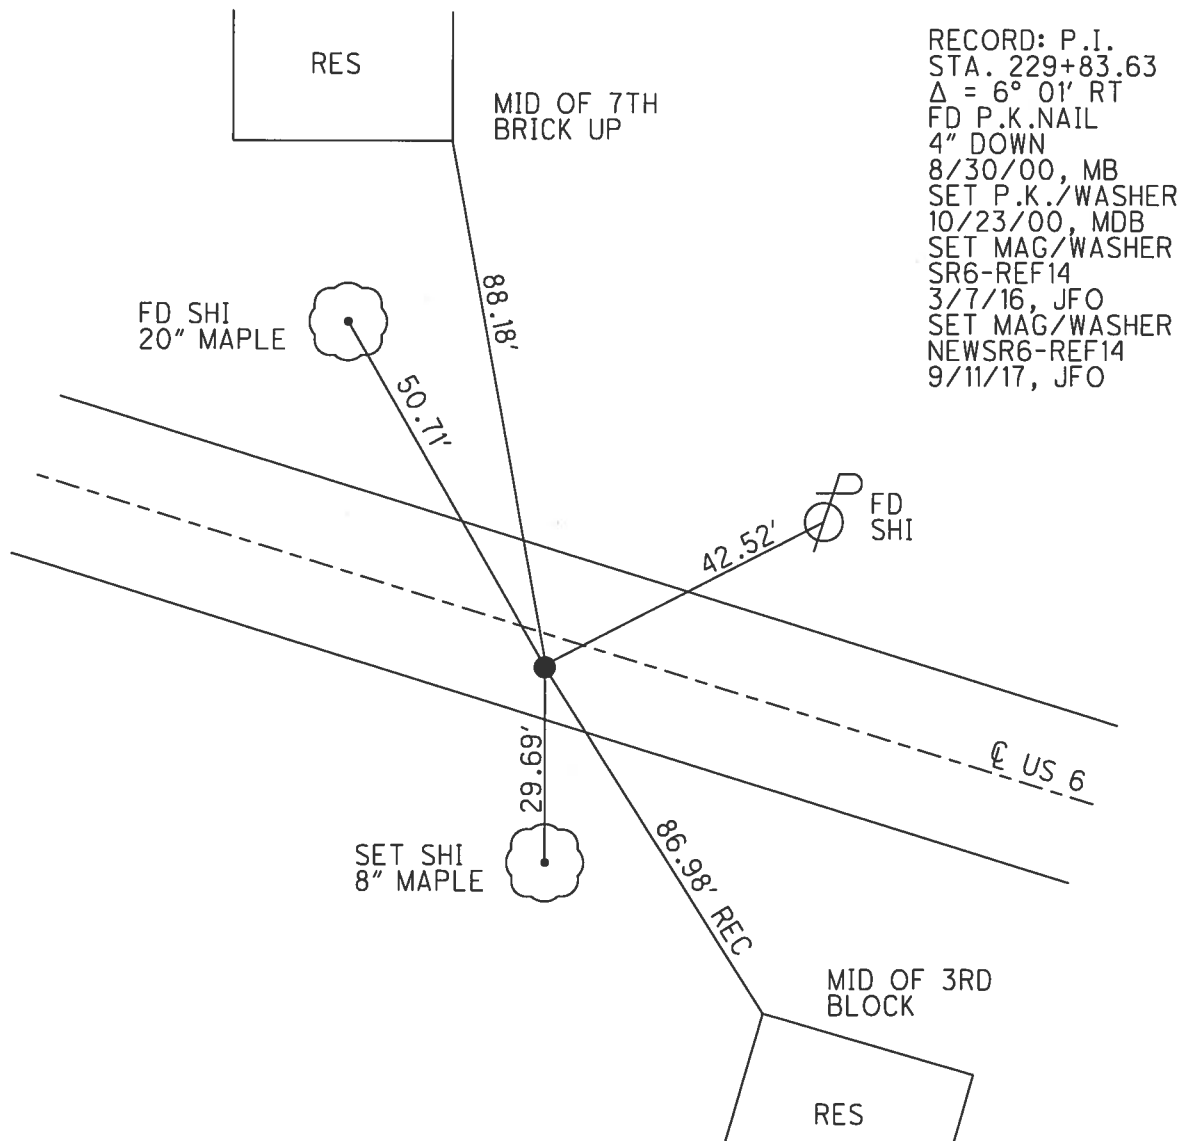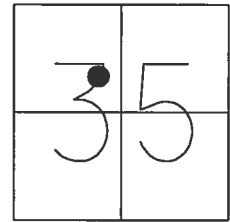

O.D.O.T. DISTRICT 2 SURVEY OFFICE (USE ONLY)

PERSONNEL

REFERENCE NO. 15

SHEET 6 OF 37

NOTES O'DONNELL

DATE 10/20/17

ROUTE US 6

H.C. LEU

WEATHER SUNNY

COUNTY HENRY

R.C. FARKAS

TEMP. 59°

TOWNSHIP RIDGEVILLE

SECTION 35

T 6 N R 5 E

TYPE MONUMENT P.K./WASHER


ON SURFACE - ~~BELOW~~ ON

~~LEFT~~ - ℄ PAV'T - RIGHT 2.6'


22.2' TO RT EDGE PAVEMENT

S.L.M. 234+17.59

Grid: Northing: 650179.284 Easting: 1486665.918

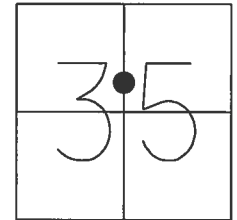

RECORD: P.I.
STA. 233+97.81
FD P.K.NAIL
4" DOWN
8/30/00, MB
SET P.K./WASHER
10/23/00, MDB
FD P.K./WASHER
SR6-REF15
3/7/16, JFO
SET MAG/WASHER
NEWSR6-REF15
9/11/17, JFO

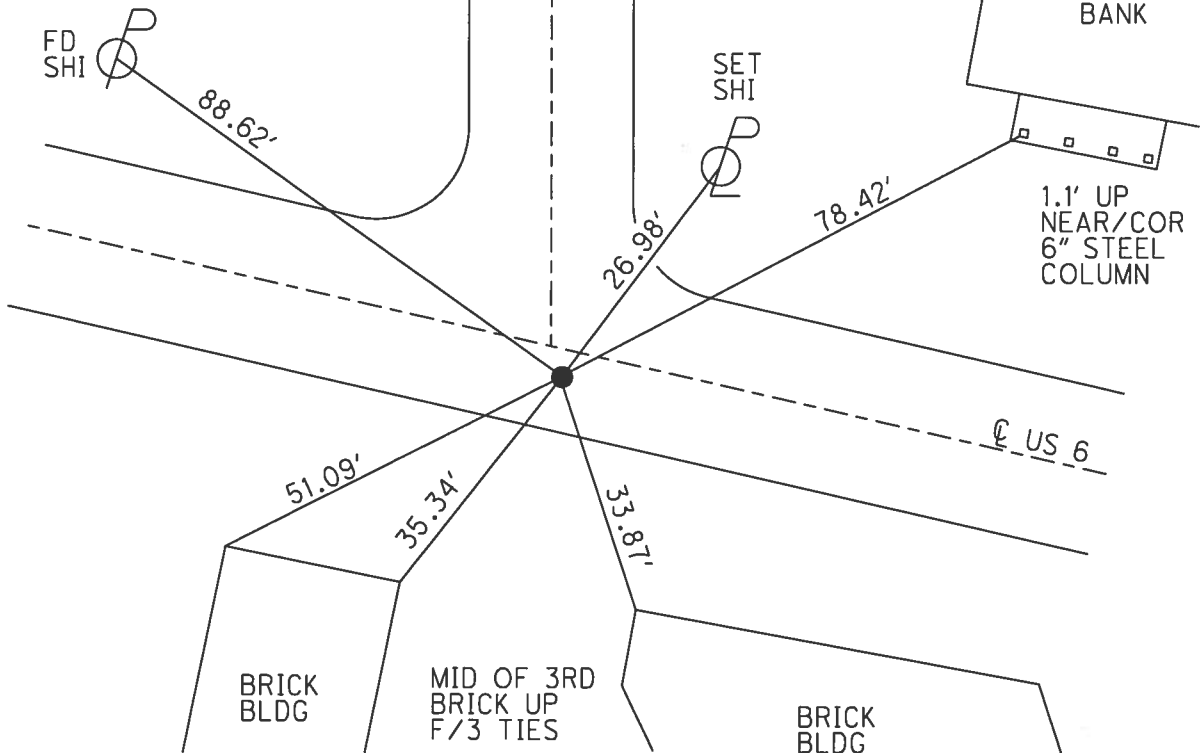

O.D.O.T. DISTRICT 2 SURVEY OFFICE (USE ONLY)

PERSONNEL

REFERENCE NO.

16

SHEET

7

OF 37

NOTES

POORE

DATE

5/17/17

ROUTE

US 6

H.C.

LEU

WEATHER

CLOUDY

COUNTY

HENRY

R.C.

CARSON

TEMP.

74°

TOWNSHIP

RIDGEVILLE

HOMAN

SECTION

35

RHOADES

T 6 N

R 5 E

TYPE MONUMENT

P.K./WASHER

ON SURFACE -

~~BELOW~~

ON

~~LEFT~~ - C PAV'T - RIGHT 3.8', 3.6' E OF C S

- TO - EDGE PAVEMENT


S.L.M. 236+21.60

Grid: Northing:

650128.245

Easting:

1486863.487

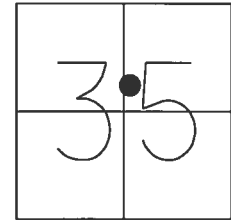

RECORD: P.I.

STA. 236+01.75

FD LG.R.R.SPIKE

4" DOWN

8/30/00, MB

SET P.K./WASHER

10/23/00, MDB

FD P.K./WASHER


SR6-REF16

3/7/16, JFO

SET MAG/WASHER

NEWSR6-REF16

9/11/17, JFO

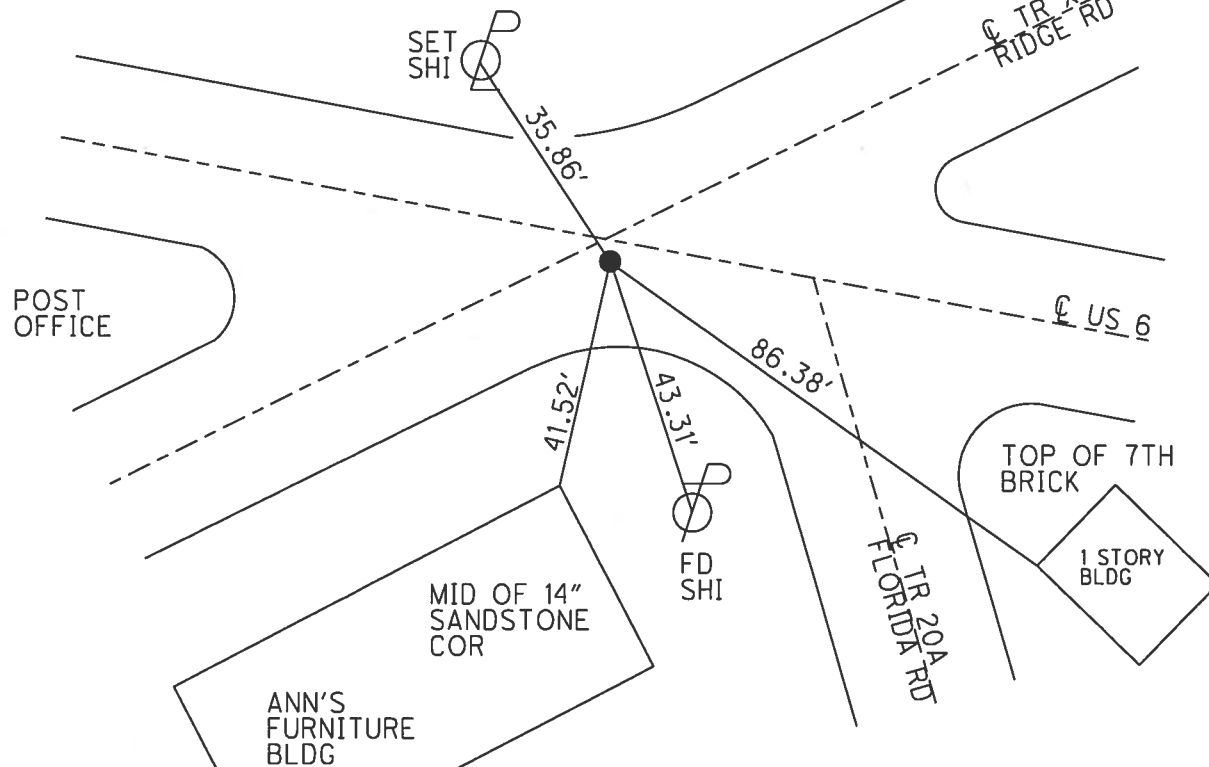

O.D.O.T. DISTRICT 2 SURVEY OFFICE (USE ONLY)

PERSONNEL

REFERENCE NO. 17

SHEET 8 OF 37

NOTES POORE

DATE 5/17/17

ROUTE US 6

H.C. LEU

WEATHER CLOUDY

COUNTY HENRY

R.C. CARSON

TEMP. 74°

TOWNSHIP RIDGEVILLE

HOMAN

SECTION 35

RHOADES

T 6 N R 5 E

TYPE MONUMENT MAG/WASHER


ON SURFACE - ~~BELOW~~ ON

~~LEFT~~ - ℄ PAV'T - RIGHT 0.5'


11.1' TO RT EDGE PAVEMENT

S.L.M. 242+10.25

Grid: Northing: 650002.626 Easting: 1487438.511

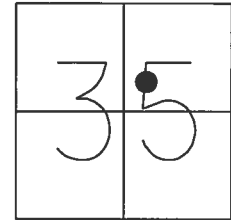


RECORD: P.O.T.
STA. 241+90.63
FD LG.R.R.SPIKE
4" DOWN
8/30/00, MB
SET P.K./WASHER
10/23/00, MDB
SET MAG/WASHER
SR6-REF17
3/7/16, JFO
SET MAG/WASHER
NEWSR6-REF17
9/11/17, JFO

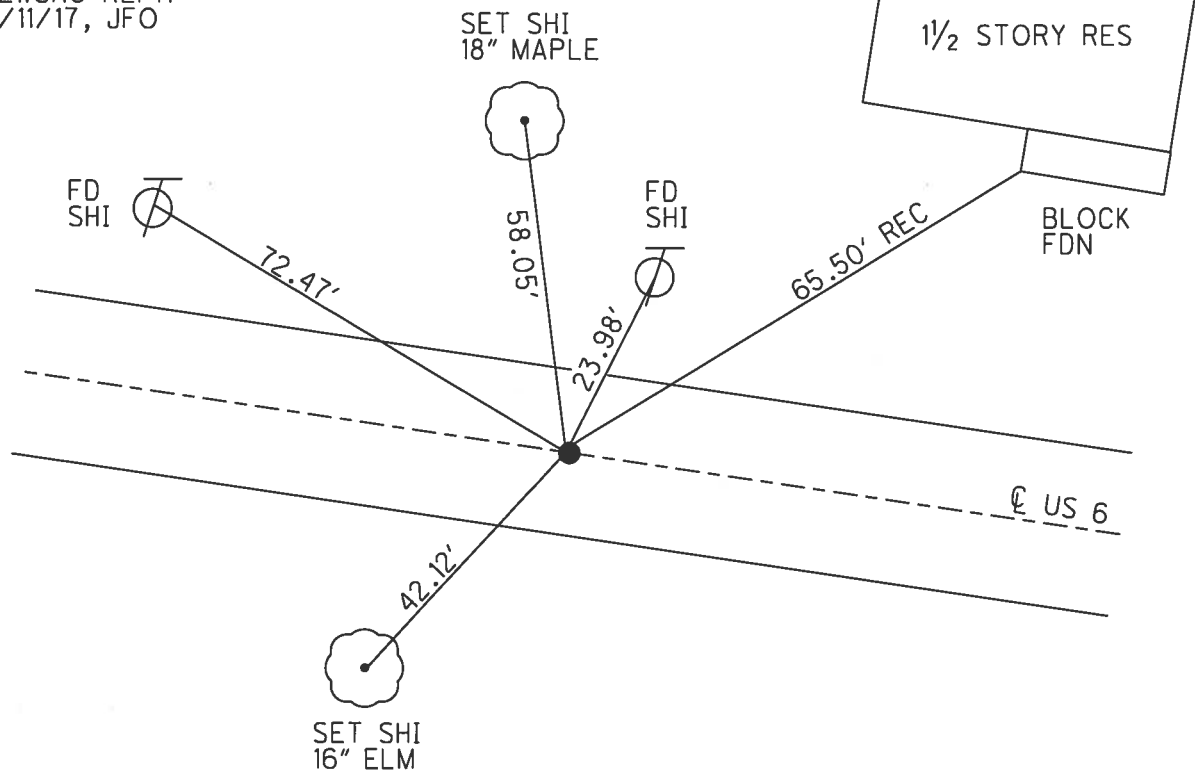

O.D.O.T. DISTRICT 2 SURVEY OFFICE (USE ONLY)


PERSONNEL	REFERENCE NO. <u>18</u>	SHEET <u>9</u> OF <u>37</u>
NOTES POORE	DATE <u>5/17/17</u>	ROUTE <u>US 6</u>
H.C. LEU	WEATHER <u>CLOUDY</u>	COUNTY <u>HENRY</u>
R.C. CARSON	TEMP. <u>76°</u>	TOWNSHIP <u>RIDGEVILLE</u>
HOMAN		SECTION <u>35</u>
RHOADES		T <u>6</u> N R <u>5</u> E

TYPE MONUMENT P.K.NAIK
 ON SURFACE - ~~BELOW~~ ON
 LEFT - ℄ PAV'T - ~~RIGHT~~ 0.5'
12.4' TO RT EDGE PAVEMENT
 S.L.M. 245+89.75

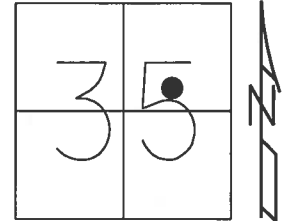

Grid: Northing: 649921.365 Easting: 1487809.384

RECORD: P.O.T.
 STA. 245+70.35
 FD P.K.NAIL
 8/30/00, MB
 SET P.K./WASHER
 10/23/00, MDB
 FD P.K.NAIL
 SR6-REF18
 3/7/16, JFO
 SET MAG/WASHER
 NEWSR6-REF18
 9/11/17, JFO


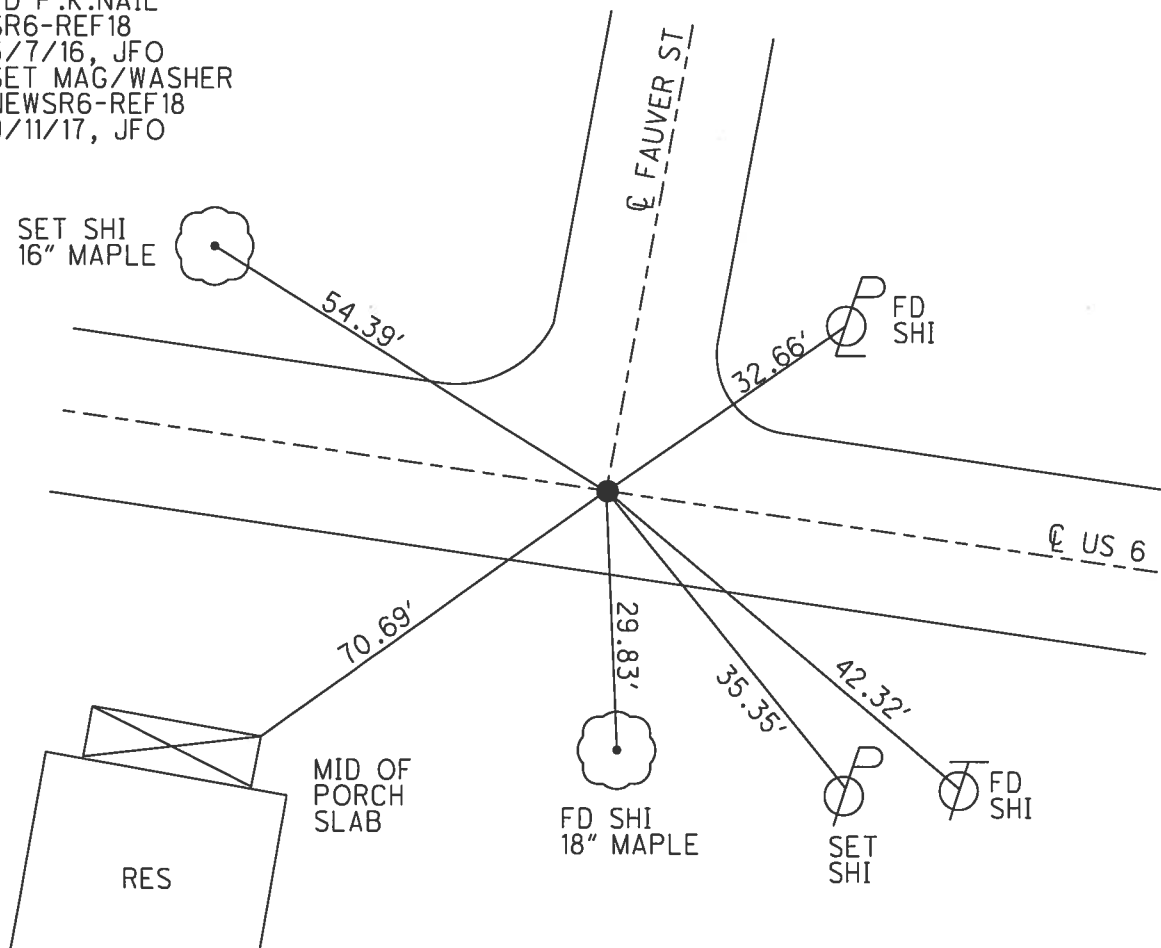


O.D.O.T. DISTRICT 2 SURVEY OFFICE (USE ONLY)

PERSONNEL _____ REFERENCE NO. 19 SHEET 10 OF 37
NOTES POORE DATE 5/17/17 ROUTE US 6
H.C. LEU WEATHER CLOUDY COUNTY HENRY
R.C. CARSON TEMP. 76° TOWNSHIP RIDGEVILLE
HOMAN SECTION 35
RHOADES T 6 N R 5 E

TYPE MONUMENT P.K./WASHER
ON SURFACE - ~~BELOW~~ ON
LEFT - ℄ PAV'T - ~~RIGHT~~ 1.7'
10.5' TO LT EDGE PAVEMENT
S.L.M. 247+68.83

Grid: Northing: 649883.172 Easting: 1487984.229

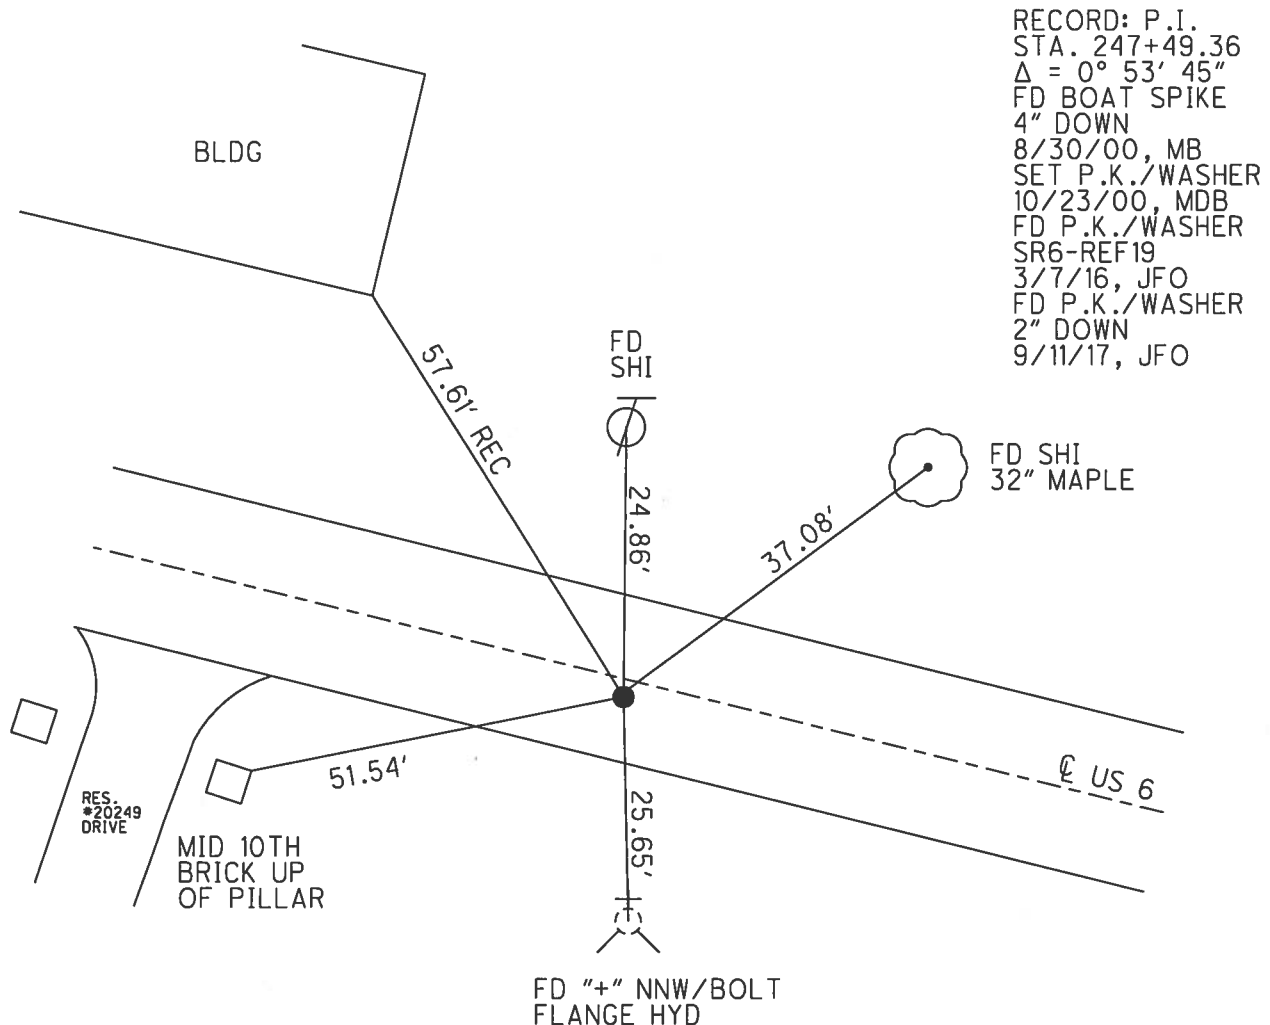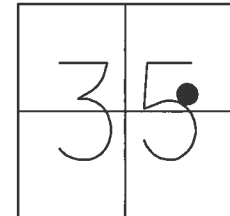

O.D.O.T. DISTRICT 2 SURVEY OFFICE (USE ONLY)

PERSONNEL

REFERENCE NO.

20

SHEET

11

OF 37

NOTES

POORE

DATE

5/17/17

ROUTE

US 6

H.C.

LEU

WEATHER

CLOUDY

COUNTY

HENRY

R.C.

CARSON

TEMP.

75°

TOWNSHIP

RIDGEVILLE

HOMAN

SECTION

36

RHOADES

T 6 N

R 5 E

TYPE MONUMENT

MAG/WASHER

ON SURFACE - ~~BELOW~~



ON

~~LEFT~~ - Q PAV'T - RIGHT 0.5'

12.5' TO LT EDGE PAVEMENT

S.L.M. 261+19.91

Grid: Northing: 649574.103 Easting: 1489299.440

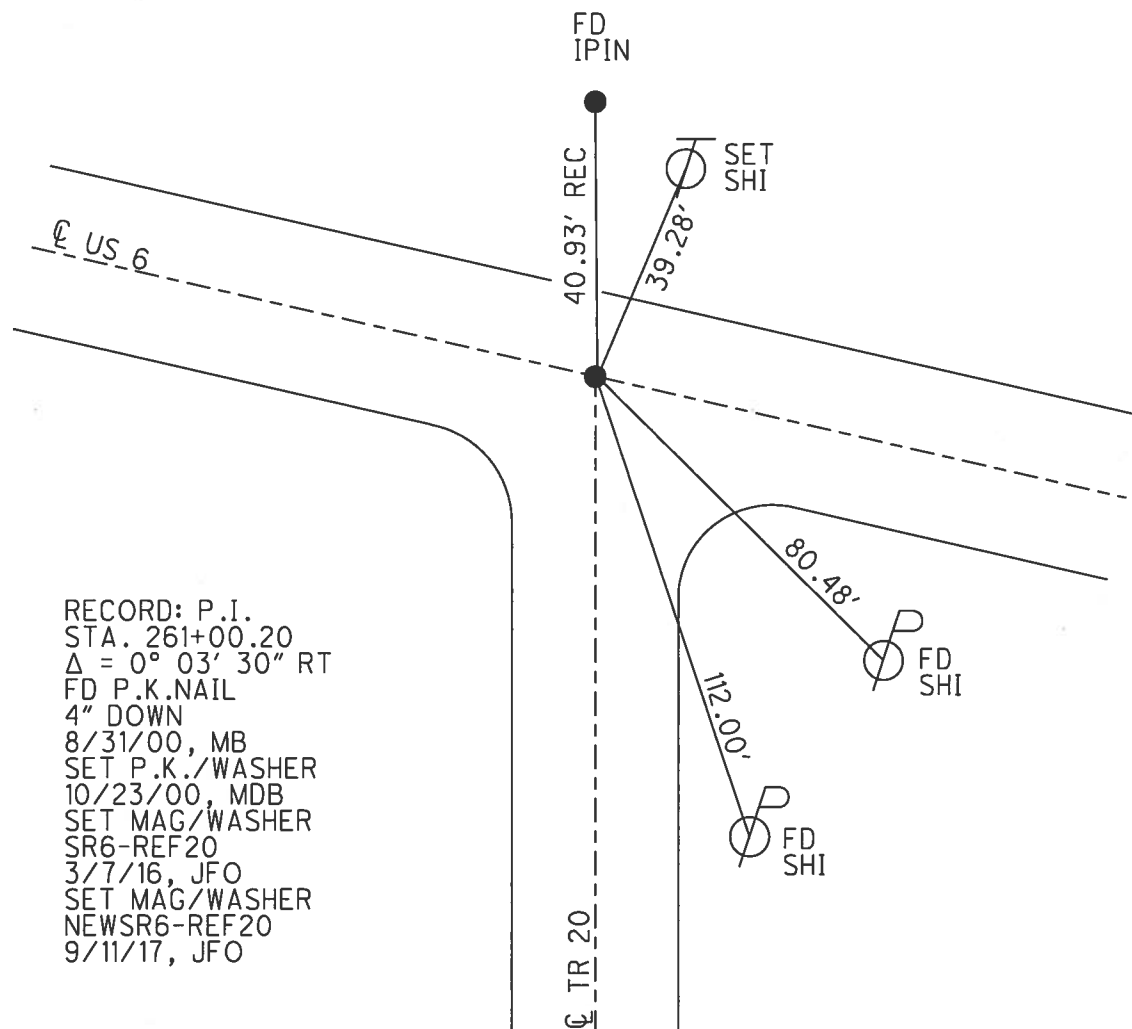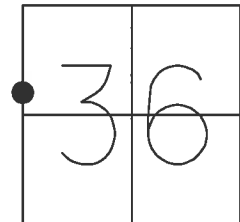


RECORD: P.I.
STA. 261+00.20
 $\Delta = 0^\circ 03' 30''$ RT
FD P.K.NAIL
4" DOWN
8/31/00, MB
SET P.K./WASHER
10/23/00, MDB
SET MAG/WASHER
SR6-REF20
3/7/16, JFO
SET MAG/WASHER
NEWSR6-REF20
9/11/17, JFO

O.D.O.T. DISTRICT 2 SURVEY OFFICE (USE ONLY)


PERSONNEL	REFERENCE NO. <u>21</u>	SHEET <u>12</u> OF <u>37</u>
NOTES <u>POORE</u>	DATE <u>5/17/17</u>	ROUTE <u>US 6</u>
H.C. <u>LEU</u>	WEATHER <u>CLOUDY</u>	COUNTY <u>HENRY</u>
R.C. <u>CARSON</u>	TEMP. <u>75°</u>	TOWNSHIP <u>RIDGEVILLE</u>
<u>HOMAN</u>		SECTION <u>36</u>
<u>RHOADES</u>		T <u>6</u> N R <u>5</u> E

TYPE MONUMENT MAG/WASHER
 ON SURFACE - ~~BELOW~~ ON
 LEFT - ℄ PAV'T - ~~RIGHT~~ 1"
11.1' TO LT EDGE PAVEMENT
 S.L.M. 270+42.25

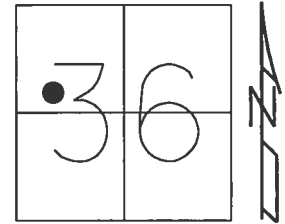

Grid: Northing: 649362.103 Easting: 1490197.130

RECORD: P.I.
 STA. 270+22.85
 $\Delta = 2^\circ 16' \text{ RT}$
 FD LG.R.R.SPIKE
 4" DOWN
 8/31/00, MB
 SET P.K./WASHER
 10/23/00, MDB
 SET MAG/WASHER
 SR6-REF21
 3/7/16, JFO
 SET MAG/WASHER
 9/25/17, JFO

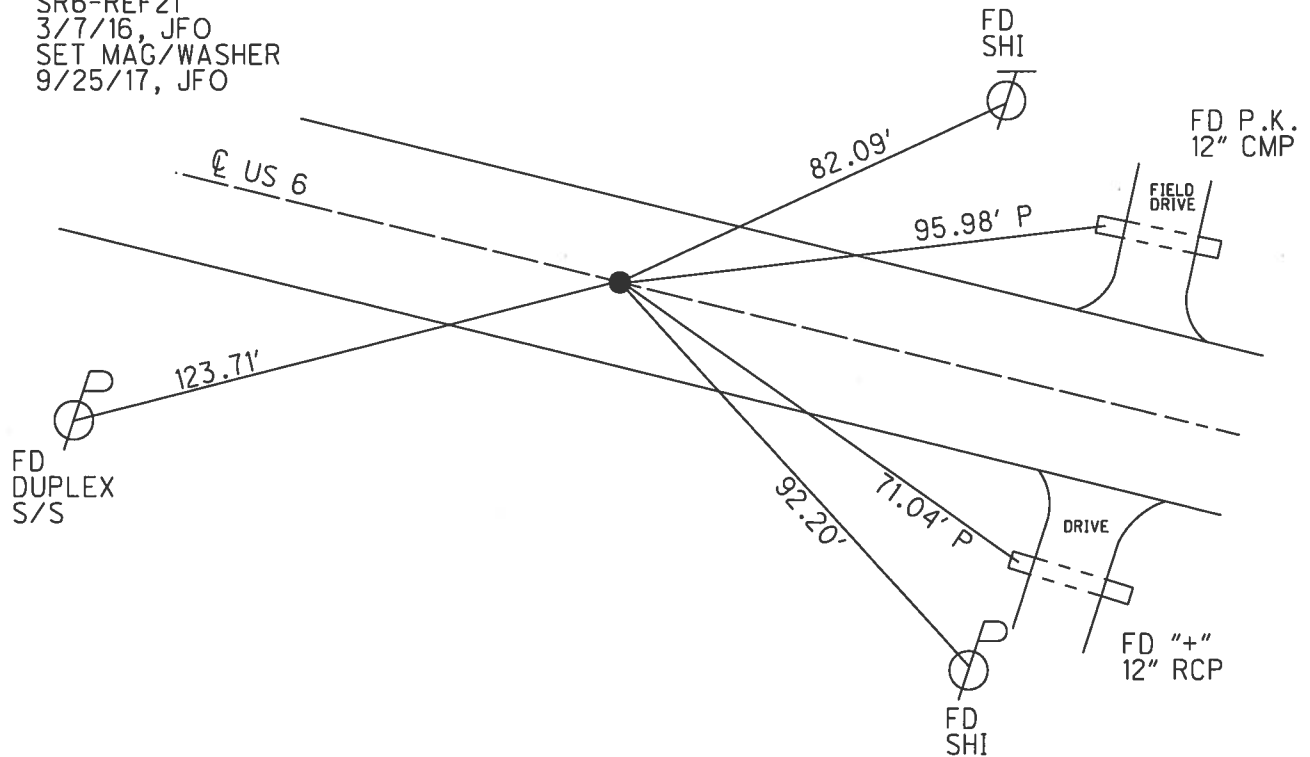

O.D.O.T. DISTRICT 2 SURVEY OFFICE (USE ONLY)

PERSONNEL _____ REFERENCE NO. 22 SHEET 13 OF 37

NOTES POORE DATE 5/17/17 ROUTE US 6

H.C. LEU WEATHER CLOUDY COUNTY HENRY

R.C. CARSON TEMP. 77° TOWNSHIP RIDGEVILLE

HOMAN SECTION 36

RHOADES T 6 N R 5 E

TYPE MONUMENT MAG/WASHER


ON SURFACE - ~~BELOW~~ ON

~~LEFT~~ - ℄ PAV'T - RIGHT 5.5'


6.8' TO RT EDGE PAVEMENT

S.L.M. 283+36.59

Grid: Northing: 649015.058 Easting: 1491444.075

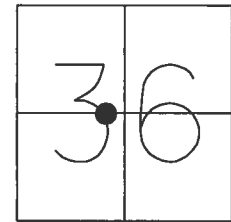

RECORD: P.I.
STA. 283+17.65
 $\Delta = 2^\circ 35' \text{ LT}$
FD P.K.NAIL
4" DOWN
8/31/00, MB
SET P.K./WASHER
10/23/00, MDB
SET MAG/WASHER
SR6-REF22
3/7/16, JFO
SET MAG/WASHER
9/25/17, JFO

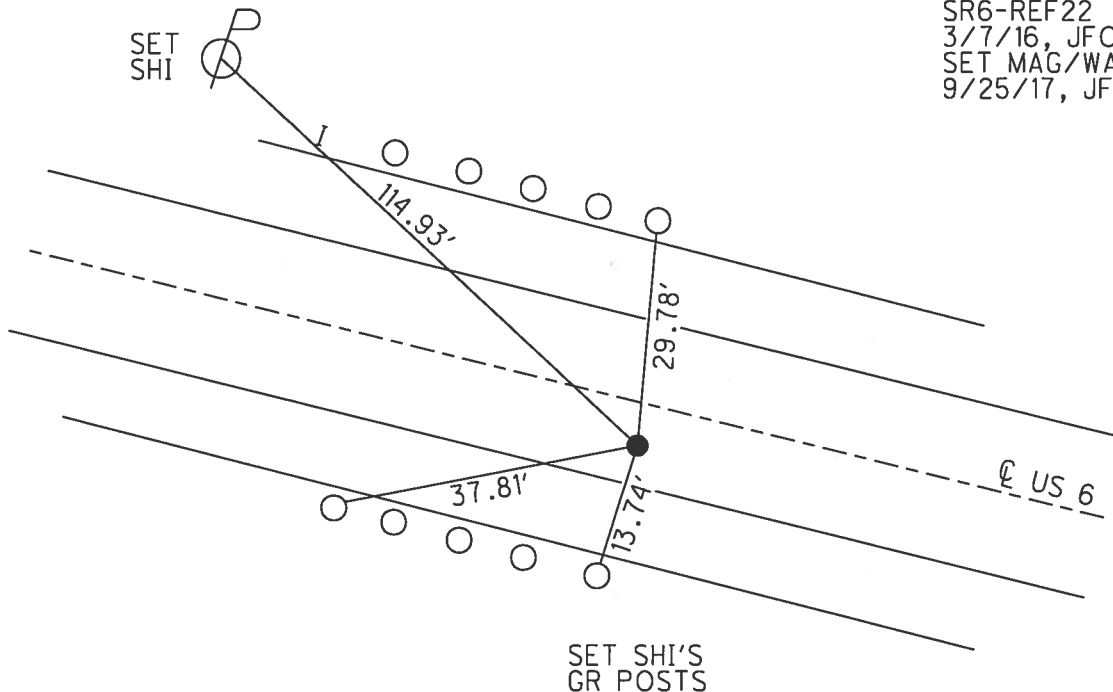


O.D.O.T. DISTRICT 2 SURVEY OFFICE (USE ONLY)


PERSONNEL	REFERENCE NO. <u>23</u>	SHEET <u>14</u> OF <u>37</u>
NOTES POORE	DATE <u>5/17/17</u>	ROUTE <u>US 6</u>
H.C. LEU	WEATHER <u>CLOUDY</u>	COUNTY <u>HENRY</u>
R.C. CARSON	TEMP. <u>80°</u>	TOWNSHIP <u>RIDGEVILLE</u>
HOMAN		SECTION <u>36</u>
RHOADES		T <u>6</u> N R <u>5</u> E

TYPE MONUMENT P.K./WASHER
 ON SURFACE - ~~BELOW~~ ON
 LEFT - Q PAV'T - ~~RIGHT~~ 0.8'
11' TO LT EDGE PAVEMENT
 S.L.M. 288+38.45

Grid: Northing: 648902.540 Easting: 1491933.167

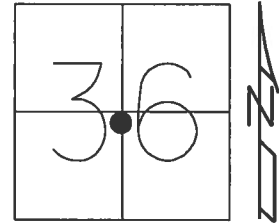


RECORD: P.O.T.
 STA. 288+20.68
 FD P.K.NAIL
 8/31/00, MB
 SET P.K./WASHER
 10/23/00, MDB
 FD P.K./WASHER
 SR6-REF23
 3/7/16, JFO
 SET MAG/WASHER
 NEWSR6-REF23
 ON N. END OF RPM
 9/11/17, JFO

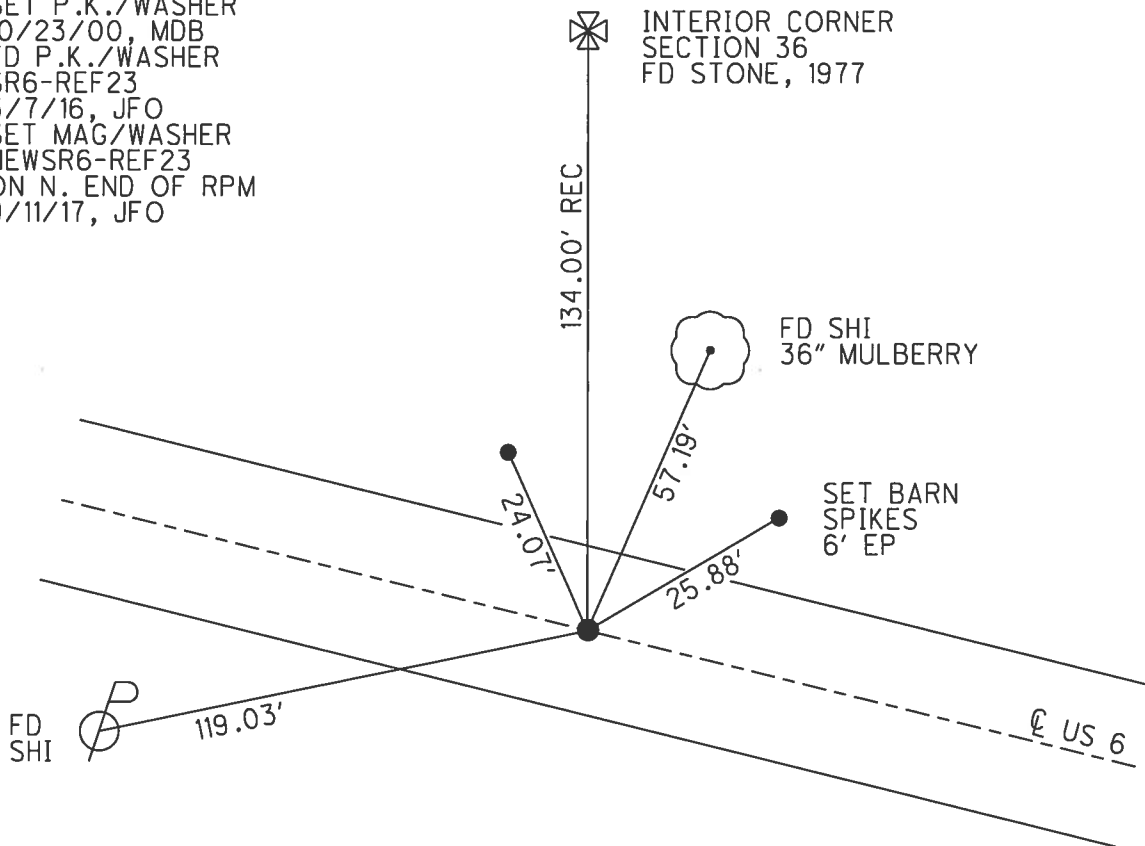

O.D.O.T. DISTRICT 2 SURVEY OFFICE (USE ONLY)


PERSONNEL	REFERENCE NO. <u>24</u>	SHEET <u>15</u> OF <u>37</u>	
NOTES	POORE	DATE	5/17/17
H.C.	LEU	WEATHER	CLOUDY
R.C.	CARSON	TEMP.	80°
	HOMAN	ROUTE	US 6
	RHOADES	COUNTY	HENRY
		TOWNSHIP	RIDGEVILLE
		SECTION	36
		T	6 N
		R	5 E

TYPE MONUMENT P.K.NAIL
 ON SURFACE - ~~BELOW~~ ON
 LEFT - ℄ PAV'T - RIGHT ON
- TO - EDGE PAVEMENT
 S.L.M. 315+46.42

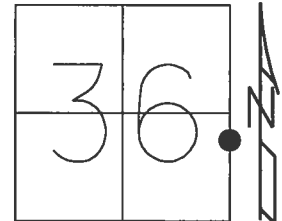

Grid: Northing: 648294.838 Easting: 1494572.063

RECORD: P.I.
 STA. 315+29.06
 $\Delta = 0^\circ 01' 30''$ LT
 FD LG.R.R.SPIKE
 5" DOWN
 8/31/00, MB
 SET P.K./WASHER
 10/23/00, MDB
 FD P.K.NAIL
 SR6-REF24
 3/7/16, JFO
 SET MAG/WASHER
 9/25/17, JFO

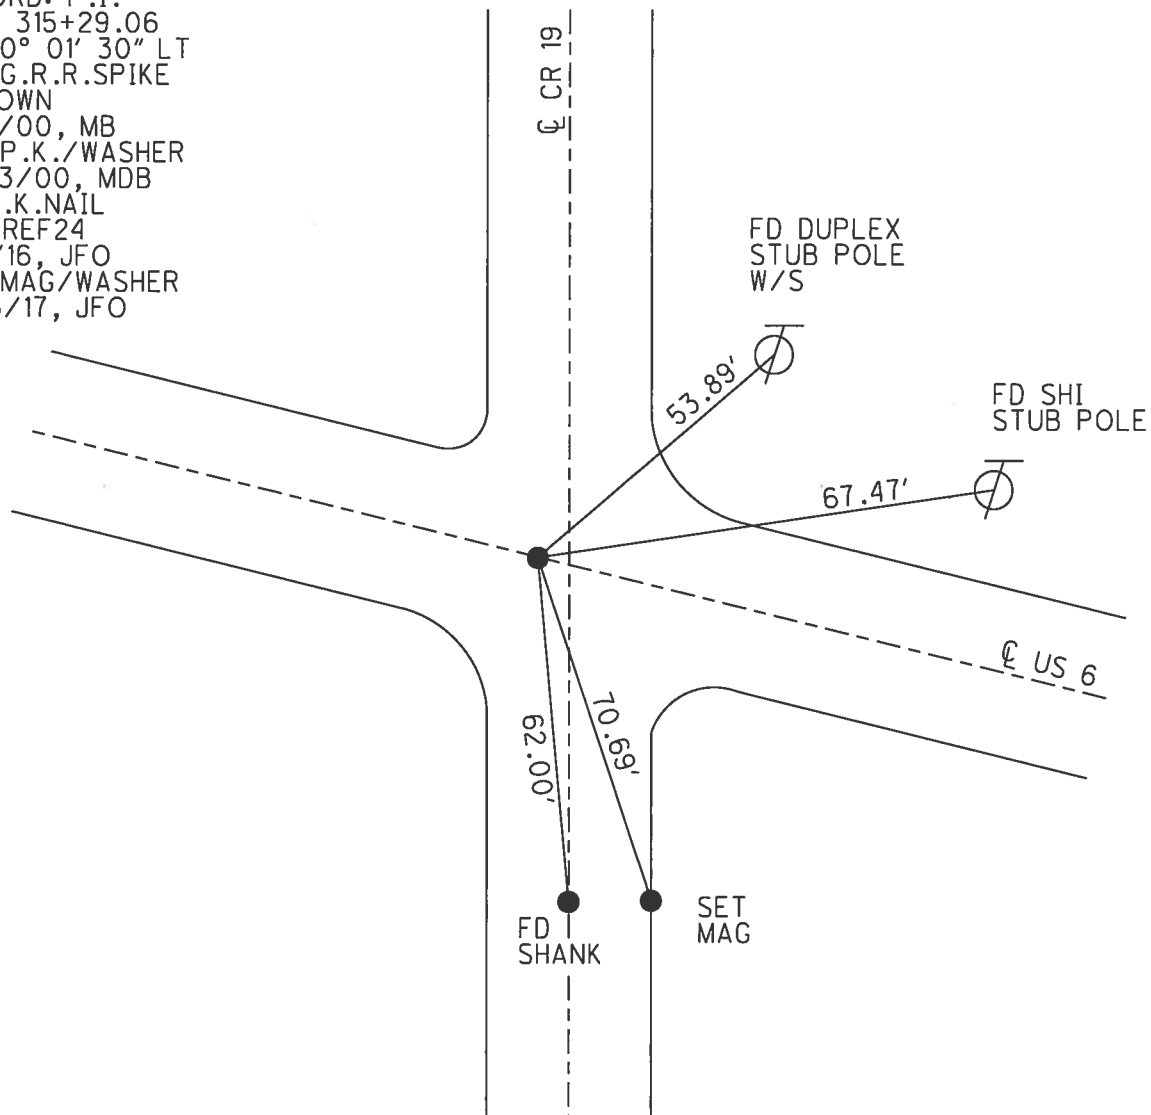

O.D.O.T. DISTRICT 2 SURVEY OFFICE (USE ONLY)

PERSONNEL

REFERENCE NO.

25

SHEET 16 OF 37

NOTES POORE

DATE 5/17/17

ROUTE US 6

H.C. LEU

WEATHER WINDY

COUNTY HENRY

R.C. CARSON

TEMP. 81°

TOWNSHIP FREEDOM

HOMAN

SECTION 31

RHOADES

T 6 N R 6 E

TYPE MONUMENT P.K./WASHER


ON SURFACE - ~~BELOW~~ ON

LEFT - Q PAV'T - ~~RIGHT~~ 0.5'


12.5' TO RT EDGE PAVEMENT

S.L.M. 335+80.89

Grid: Northing: 647839.006 Easting: 1496554.809

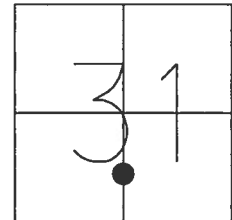

RECORD: P.I.
STA. 335+63.91
 $\Delta = 0^\circ 12' 30''$
FD P.K.NAIL
8/31/00, MB
SET P.K./WASHER
10/23/00, MDB
FD P.K./WASHER
SR6-REF25
3/7/16, JFO
SET MAG/WASHER
BY COORD'S
9/25/17, JFO

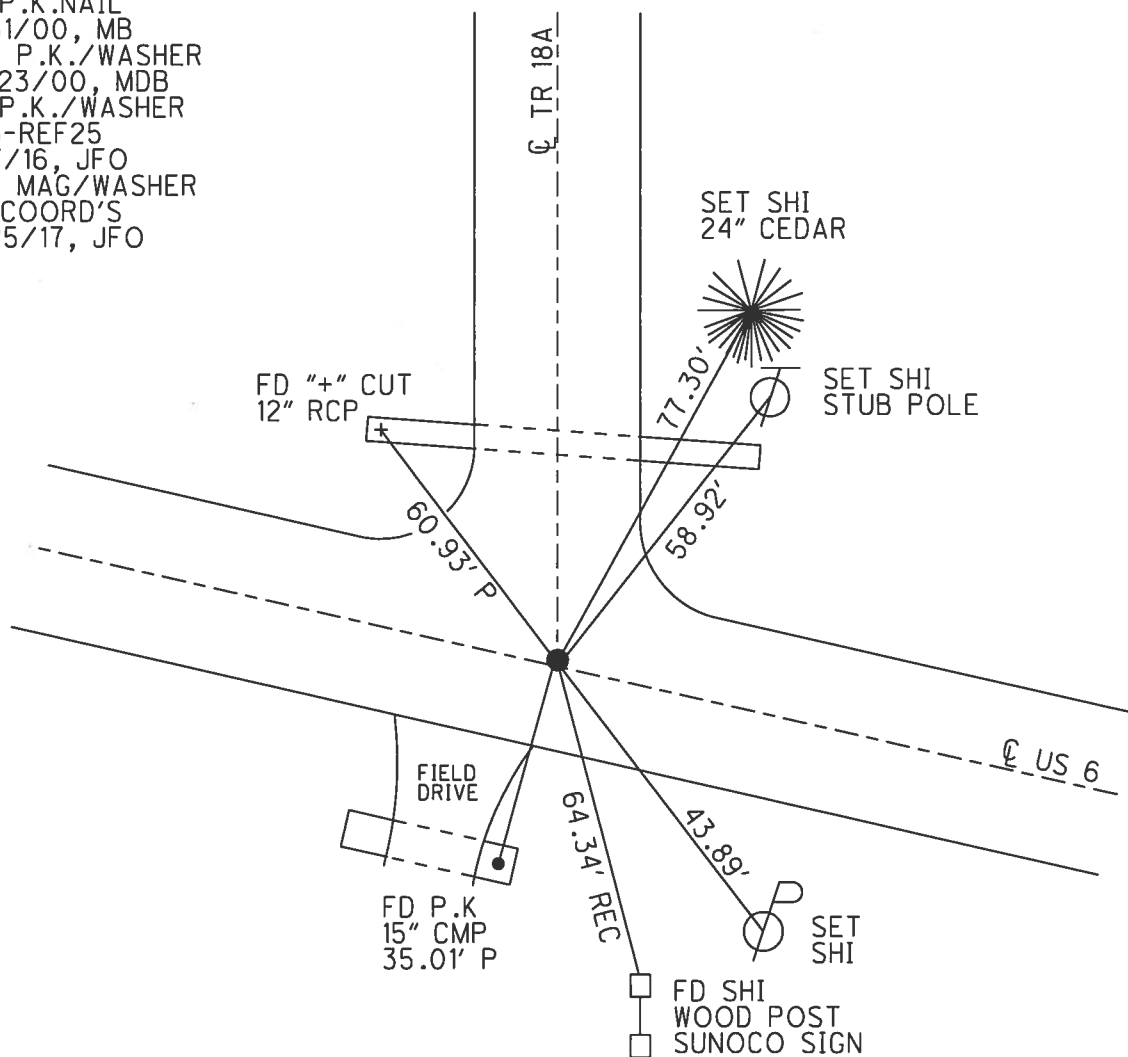

O.D.O.T. DISTRICT 2 SURVEY OFFICE (USE ONLY)

PERSONNEL	REFERENCE NO. <u>26</u>	SHEET <u>17</u> OF <u>37</u>
NOTES <u>POORE</u>	DATE <u>5/17/17</u>	ROUTE <u>US 6</u>
H.C. <u>LEU</u>	WEATHER <u>WINDY</u>	COUNTY <u>HENRY</u>
R.C. <u>CARSON</u>	TEMP. <u>83°</u>	TOWNSHIP <u>FREEDOM</u>
<u>HOMAN</u>		SECTION <u>31</u>
<u>RHOADES</u>		T <u>6</u> N R <u>6</u> E

TYPE MONUMENT R.R.SPIKE


~~ON SURFACE~~ - BELOW 8"

LEFT - CL PAV'T - RIGHT ON


12' TO RT EDGE PAVEMENT

S.L.M. 362+99.32

Grid: Northing: 647219.948 Easting: 1499201.820

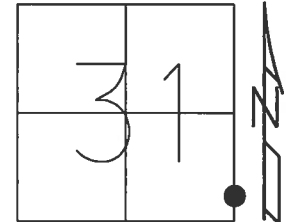

RECORD: P.I.
 STA. 362+81.78
 $\Delta = 0^\circ 07' 30''$ RT
 FD LG.R.R.SPIKE
 8/31/00, MB
 SET P.K./WASHER
 10/23/00, MDB
 FD R.R.SPIKE
 8" DOWN
 SR6-REF26
 3/7/16, JFO
 SET MAG/WASHER
 9/25/17, JFO

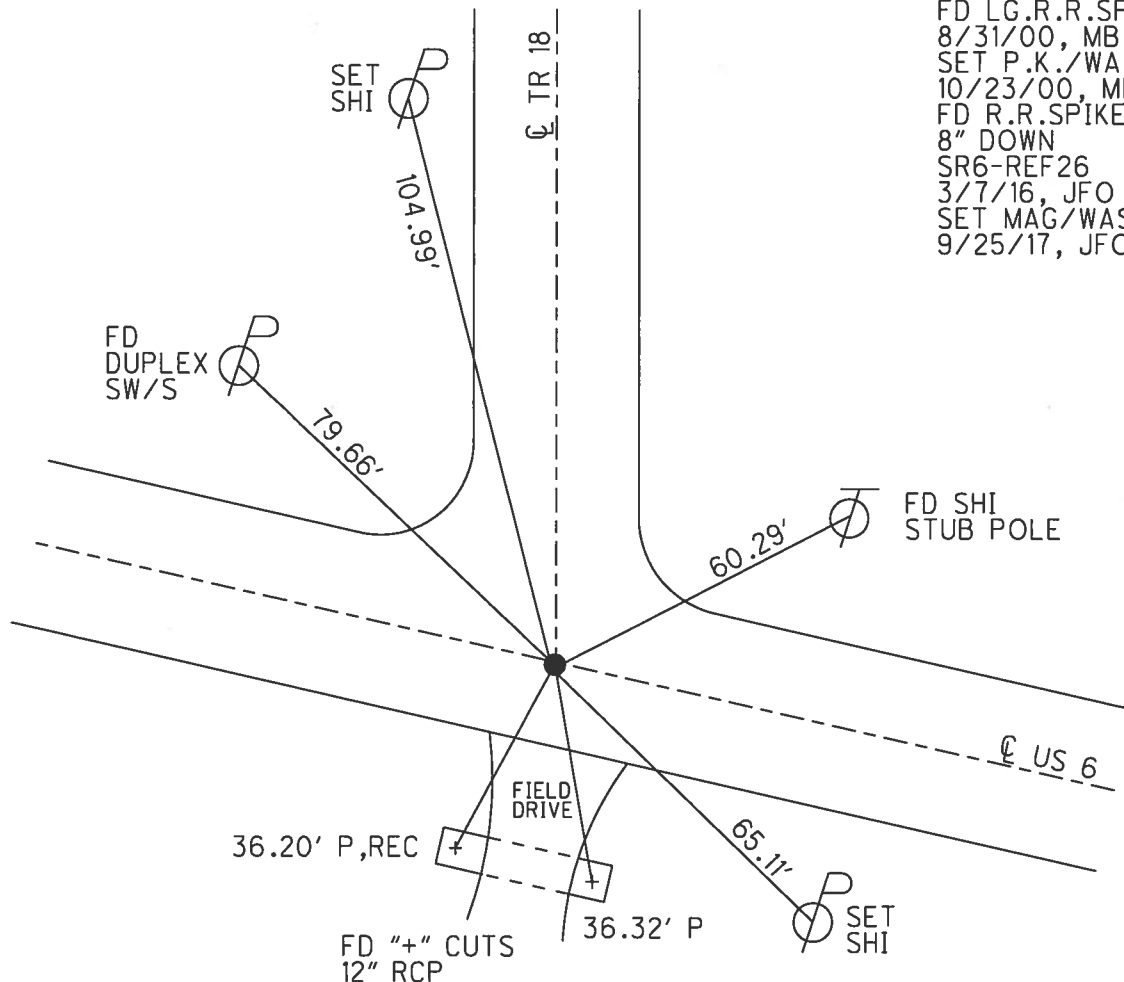


O.D.O.T. DISTRICT 2 SURVEY OFFICE (USE ONLY)


PERSONNEL _____ REFERENCE NO. 26 A SHEET 18 OF 37
 NOTES O'DONNELL DATE 10/2/17 ROUTE US 6
 H.C. LEU WEATHER SUNNY COUNTY HENRY
 R.C. FARKAS TEMP. 56° TOWNSHIP FREEDOM
 SECTION 32
 T 6 N R 6 E

TYPE MONUMENT MAG/WASHER
 ON SURFACE - ~~BELOW~~ ON _____
~~LEFT~~ - CL PAV'T - RIGHT 0.6'
12.6' TO LT EDGE PAVEMENT
 S.L.M. 371+01.33

Grid: Northing: 647036.269 Easting: 1499979.830

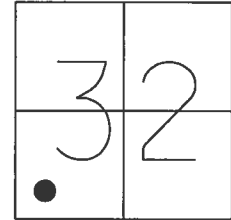

RECORD: P.O.T.
 STA. 370+81.14
 FD LG.R.R.SPIKE
 4" DOWN
 9/5/00, MB
 SET P.K./WASHER
 11/03/00, MDB
 FD LG.R.R.SPIKE
 6" DOWN
 SR6-REFA26
 3/8/16, JFO
 SET MAG/WASHER
 10/2/17, JFO

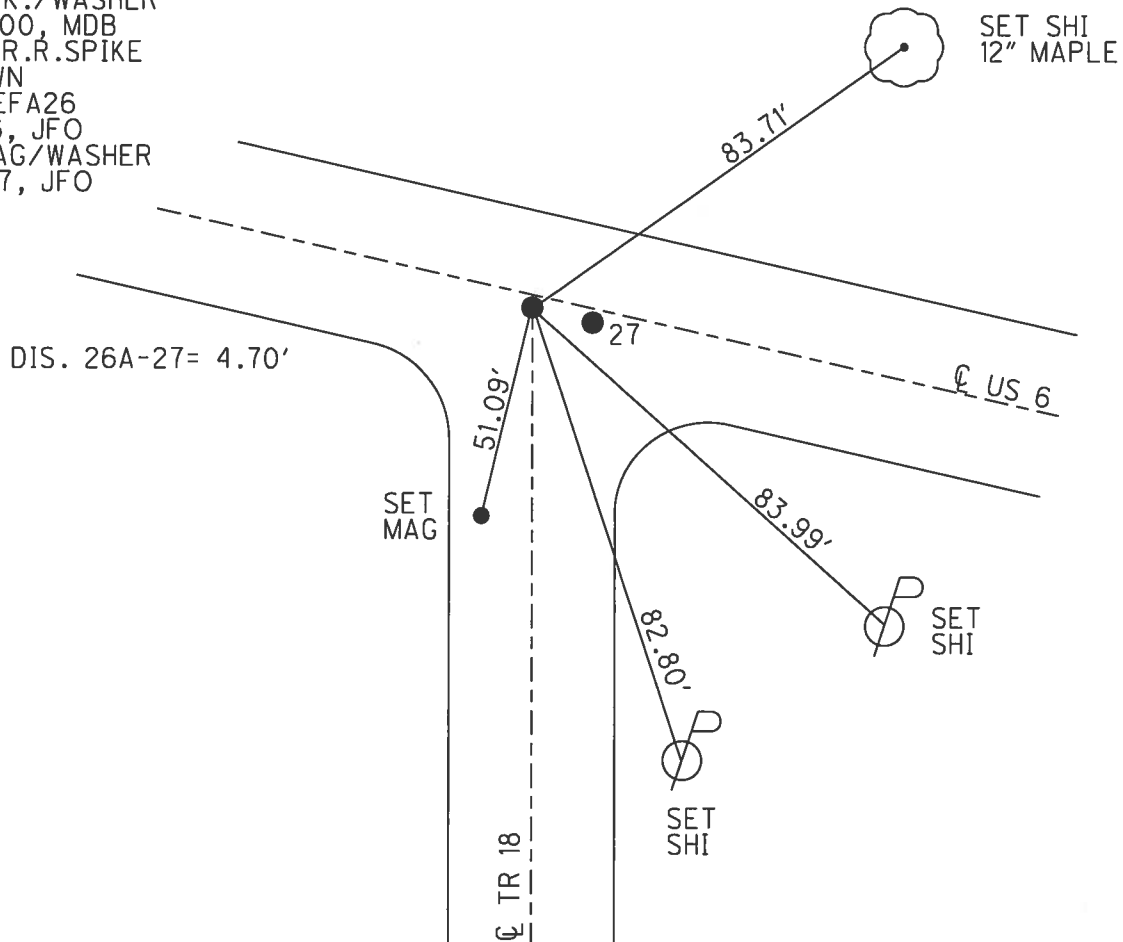

O.D.O.T. DISTRICT 2 SURVEY OFFICE (USE ONLY)

PERSONNEL _____ REFERENCE NO. 27 A SHEET 20 OF 37

NOTES O'DONNELL DATE 10/2/17 ROUTE US 6

H.C. LEU WEATHER SUNNY COUNTY HENRY

R.C. FARKAS TEMP. 56° TOWNSHIP FREEDOM

SECTION 32

T 6 N R 6 E

TYPE MONUMENT P.K./WASHER


ON SURFACE - ~~BELOW~~ ON

LEFT - Q PAV'T - ~~RIGHT~~ 1.5'


10.3' TO LT EDGE PAVEMENT

S.L.M. 372+48.47

Grid: Northing: 647003.788 Easting: 1500116.079

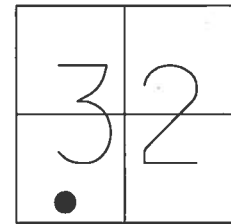

RECORD: P.I.
 STA. 372+21.11
 $\Delta = 0^\circ 32' 45''$ RT
 FD LG.R.R.SPIKE
 4" DOWN
 9/5/00, MB
 SET P.K./WASHER
 11/3/00, MDB
 FD PK./WASHER
 SR6-REFA27
 3/8/16, JFO
 SET MAG/WASHER
 BY COORD'S
 10/2/17, JFO


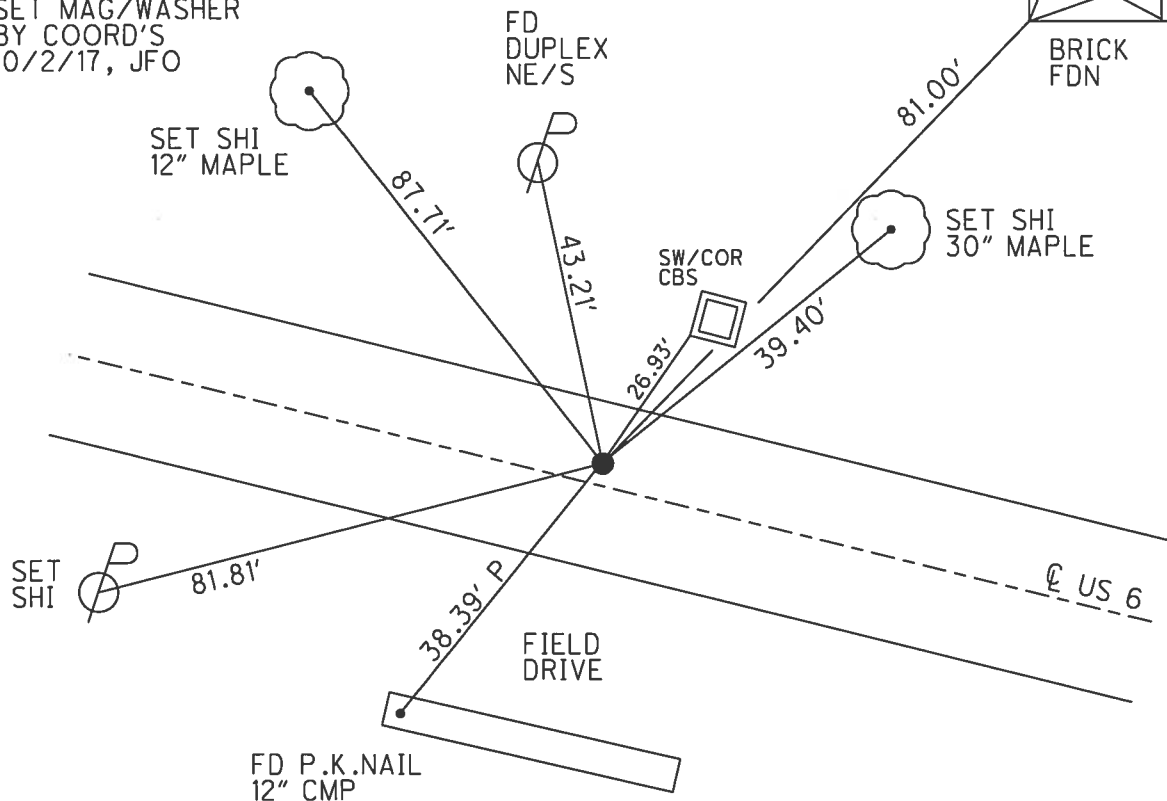


O.D.O.T. DISTRICT 2 SURVEY OFFICE (USE ONLY)

PERSONNEL _____ REFERENCE NO. 27 B SHEET 21 OF 37
 NOTES O'DONNELL DATE 10/2/17 ROUTE US 6
 H.C. LEU WEATHER SUNNY COUNTY HENRY
 R.C. FARKAS TEMP. 63° TOWNSHIP FREEDOM
 SECTION 32
 T 6 N R 6 E

TYPE MONUMENT MAG/WASHER
 ON SURFACE - ~~BELOW~~ ON
 LEFT - ℄ PAV'T - ~~RIGHT~~ 5.8'
6.2' TO LT EDGE PAVEMENT
 S.L.M. 374+28.10

Grid: Northing: 646958.931 Easting: 1500297.376

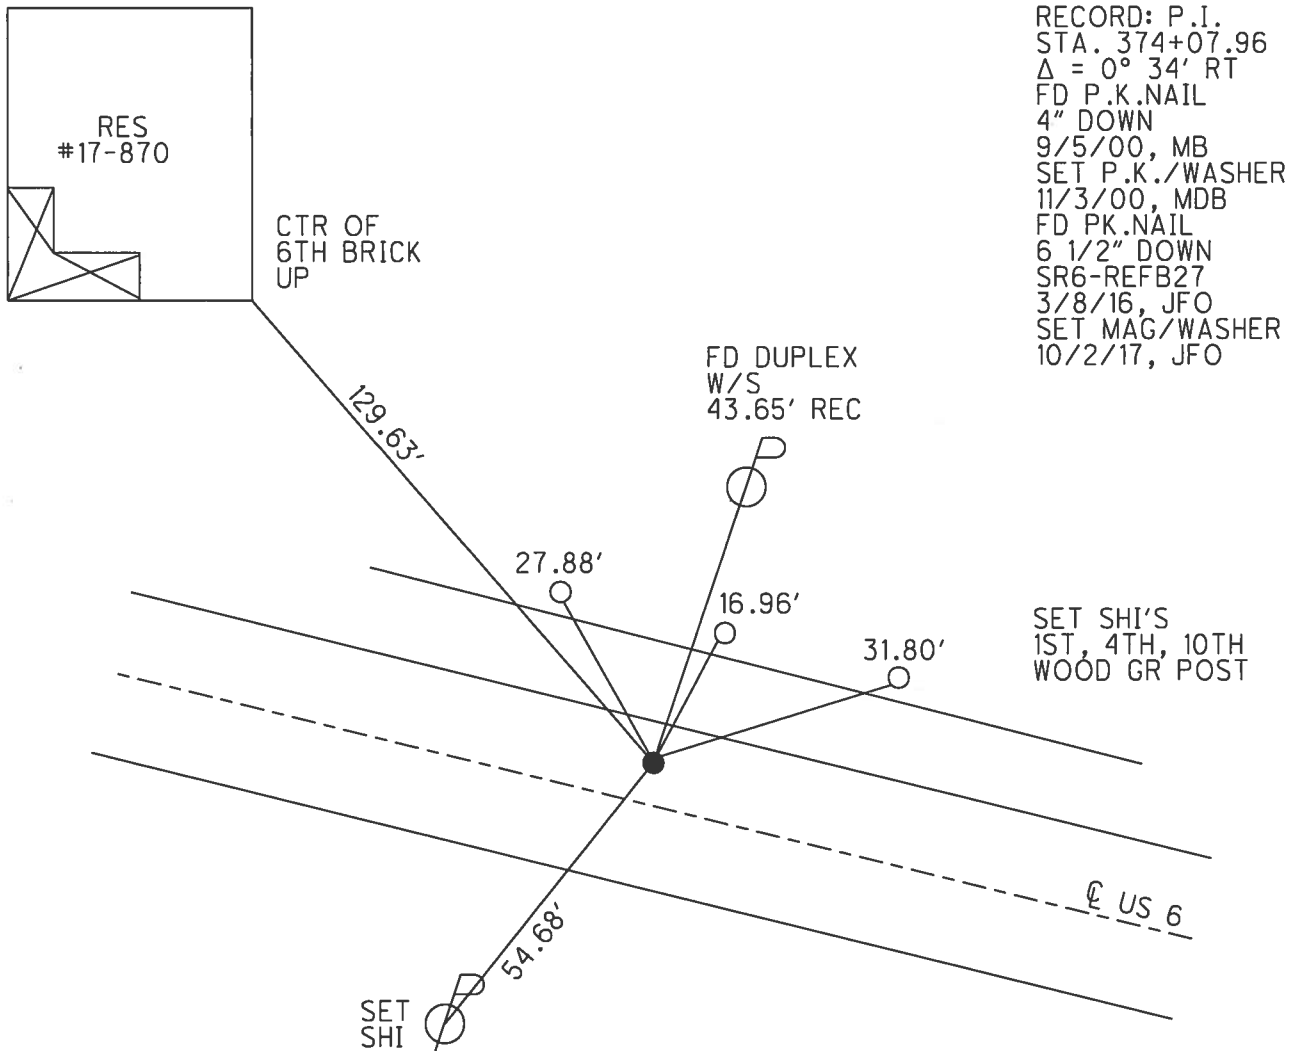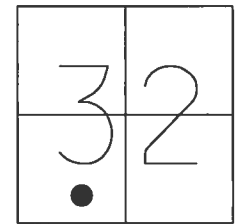

O.D.O.T. DISTRICT 2 SURVEY OFFICE (USE ONLY)

PERSONNEL

REFERENCE NO. 28

SHEET 22 OF 37

NOTES BARNHISEL

DATE 9/5/00

ROUTE US 6

H.C. MOSER

WEATHER CLOUDY

COUNTY HENRY

R.C. CORDES

TEMP. 65°

TOWNSHIP FREEDOM

HUSS

SECTION 32

ROUSOS

T 6 N R 6 E

TYPE MONUMENT 1" IPIPE


~~ON SURFACE~~ - BELOW 2"

LEFT - ℄ PAV'T - ~~RIGHT~~ 54.44'


42.7' LT TO LT EDGE PAVEMENT

S.L.M. 377+88.89

Grid: Northing: 646866.083 Easting: 1500657.544

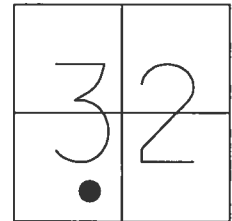

RECORD: P.I.
STA. 377+80.06
 $\Delta = 28^\circ 23' \text{ RT}$
FD 1" IPIPE
2" DOWN
9/5/00, MB
FD 1" IPIPE
2" DOWN
SR6-REF28
3/8/16, JFO

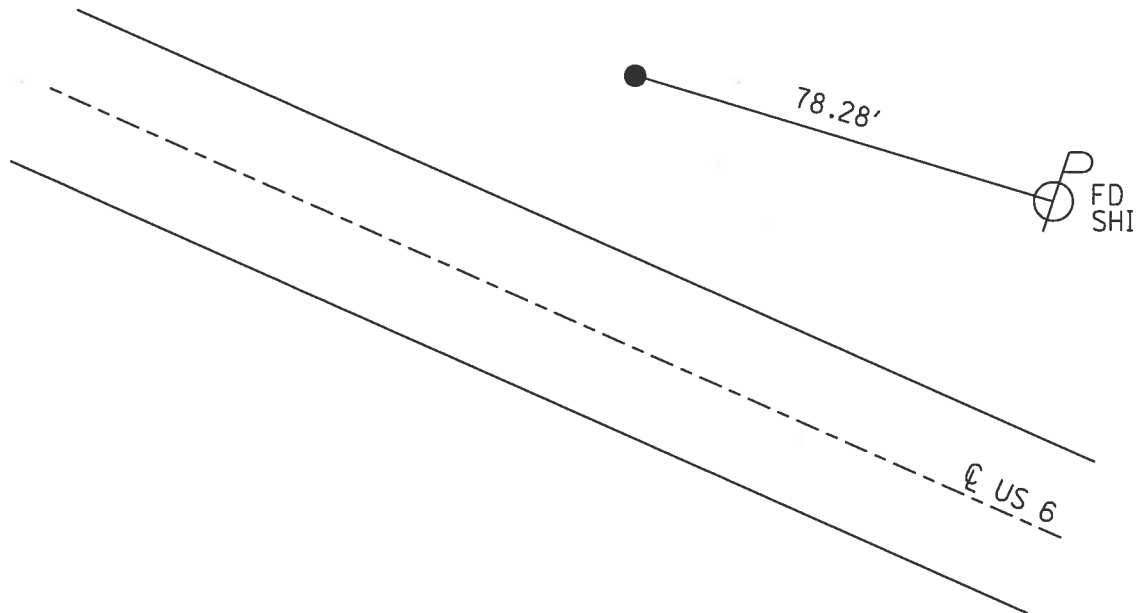


O.D.O.T. DISTRICT 2 SURVEY OFFICE (USE ONLY)


PERSONNEL	REFERENCE NO.	<u>28 A</u>	SHEET	<u>23</u>	OF	<u>37</u>
NOTES	<u>BARNHISEL</u>	DATE	<u>9/5/00</u>	ROUTE	<u>US 6</u>	
H.C.	<u>MOSER</u>	WEATHER	<u>CLOUDY</u>	COUNTY	<u>HENRY</u>	
R.C.	<u>CORDES</u>	TEMP.	<u>65°</u>	TOWNSHIP	<u>FREEDOM</u>	
	<u>HUSS</u>			SECTION	<u>32</u>	
	<u>ROUSOS</u>			T <u>6</u> N	R <u>6</u> E	

TYPE MONUMENT 1" IPIPE
~~ON SURFACE~~ - BELOW 10"
LEFT - CL PAV'T - ~~RIGHT~~ 16.6'
4.7' LT TO LT EDGE PAVEMENT
S.L.M. 379+92.53

Grid: Northing: 646723.286 Easting: 1500811.570

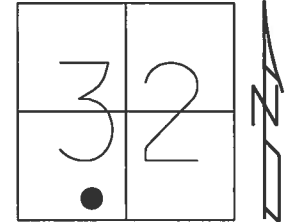

RECORD: P.I.
STA. 379+85.92
 $\Delta = 1^\circ 35' 30''$
FD 1" IPIPE
10" DOWN
9/5/00, MB
FD 1" IPIPE
10" DOWN
SR6-REFA28
3/8/16, JFO

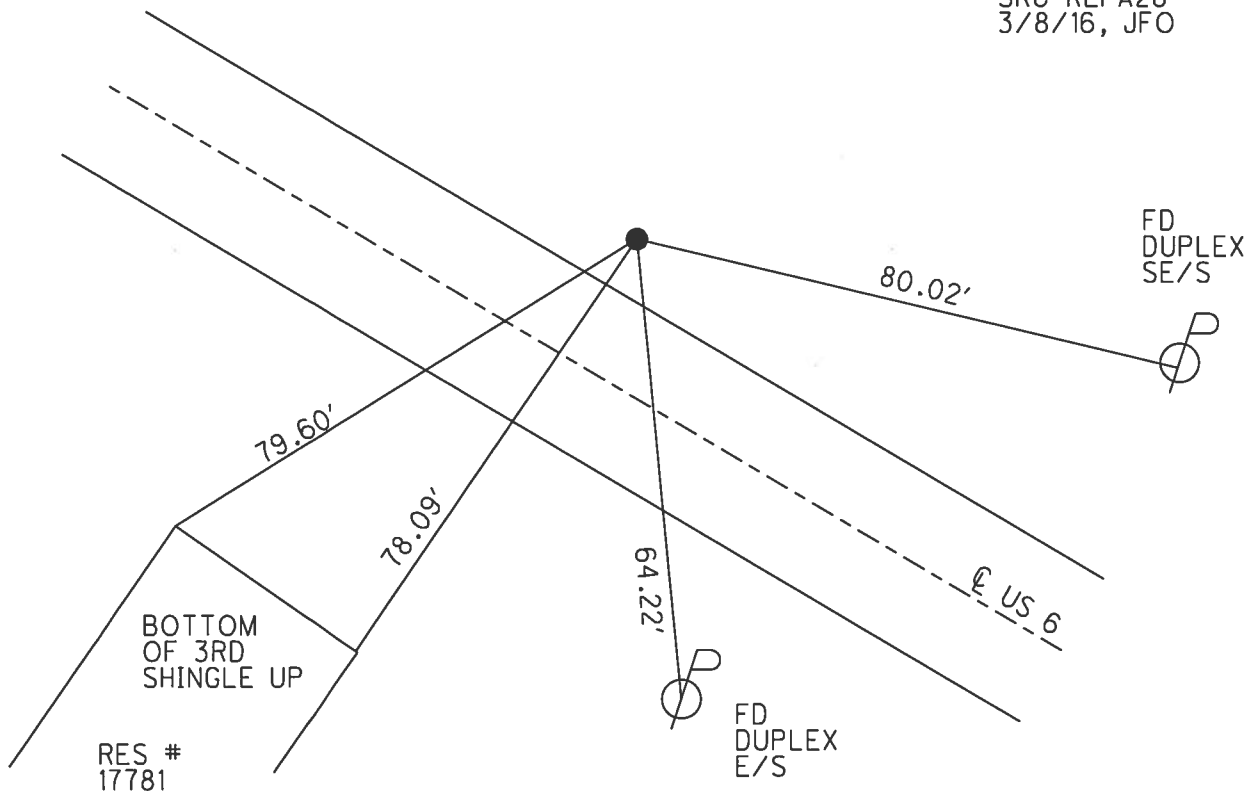

O.D.O.T. DISTRICT 2 SURVEY OFFICE (USE ONLY)

PERSONNEL

REFERENCE NO. 28 B SHEET 24 OF 37

NOTES O'DONNELL

DATE 10/2/17

ROUTE US 6

H.C. LEU

WEATHER SUNNY

COUNTY HENRY

R.C. FARKAS

TEMP. 63°

TOWNSHIP FREEDOM

SECTION

32

T_6_N R_6_E

TYPE MONUMENT MAG/WASHER


ON SURFACE - ~~BELOW~~ ON

~~LEFT~~ - C PAV'T - RIGHT 1.5'

9.8' TO RT EDGE PAVEMENT

S.L.M. 383+03.49

Grid: Northing: 646504.771 Easting: 1501034.495

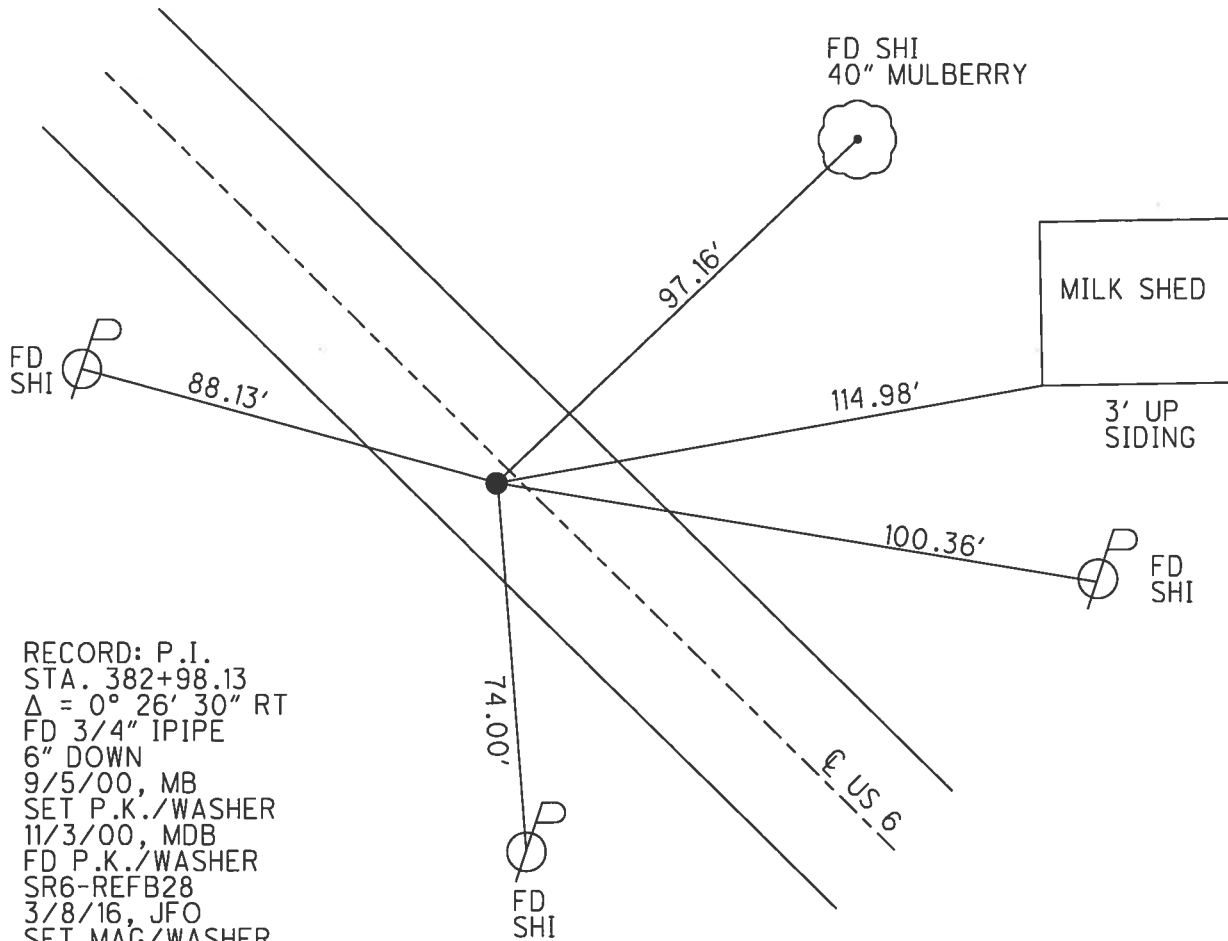


RECORD: P.I.
STA. 382+98.13
 $\Delta = 0^{\circ} 26' 30''$ RT
FD 3/4" IPIPE
6" DOWN
9/5/00, MB
SET P.K./WASHER
11/3/00, MDB
FD P.K./WASHER
SR6-REFB28
3/8/16, JFO
SET MAG/WASHER
10/2/17, JFO

O.D.O.T. DISTRICT 2 SURVEY OFFICE (USE ONLY)


PERSONNEL _____ REFERENCE NO. 29 SHEET 25 OF 37
 NOTES O'DONNELL DATE 10/2/17 ROUTE US 6
 H.C. LEU WEATHER SUNNY COUNTY HENRY
 R.C. FARKAS TEMP. 63° TOWNSHIP NAPOLEON
 _____ SECTION 5
 _____ T 5 N R 6 E

TYPE MONUMENT MAG/WASHER
 ON SURFACE - ~~BELOW~~ ON
~~LEFT~~ - CL PAV'T - RIGHT 1.9'
9.8' TO RT EDGE PAVEMENT
 S.L.M. 386+29.17

Grid: Northing: 646276.534 Easting: 1501263.783

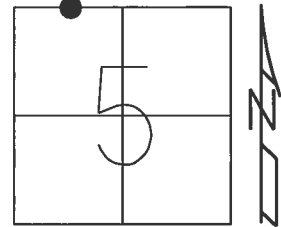

RECORD: P.I.
 STA. 386+21.67
 $\Delta = 0^\circ 07' \text{ LT}$
 FD P.K./WASHER
 4" DOWN
 9/5/00, MB
 SET P.K./WASHER
 11/3/00, MDB
 FD P.K./WASHER
 SR6-REF29
 3/8/16, JFO
 SET MAG/WASHER
 10/2/17, JFO


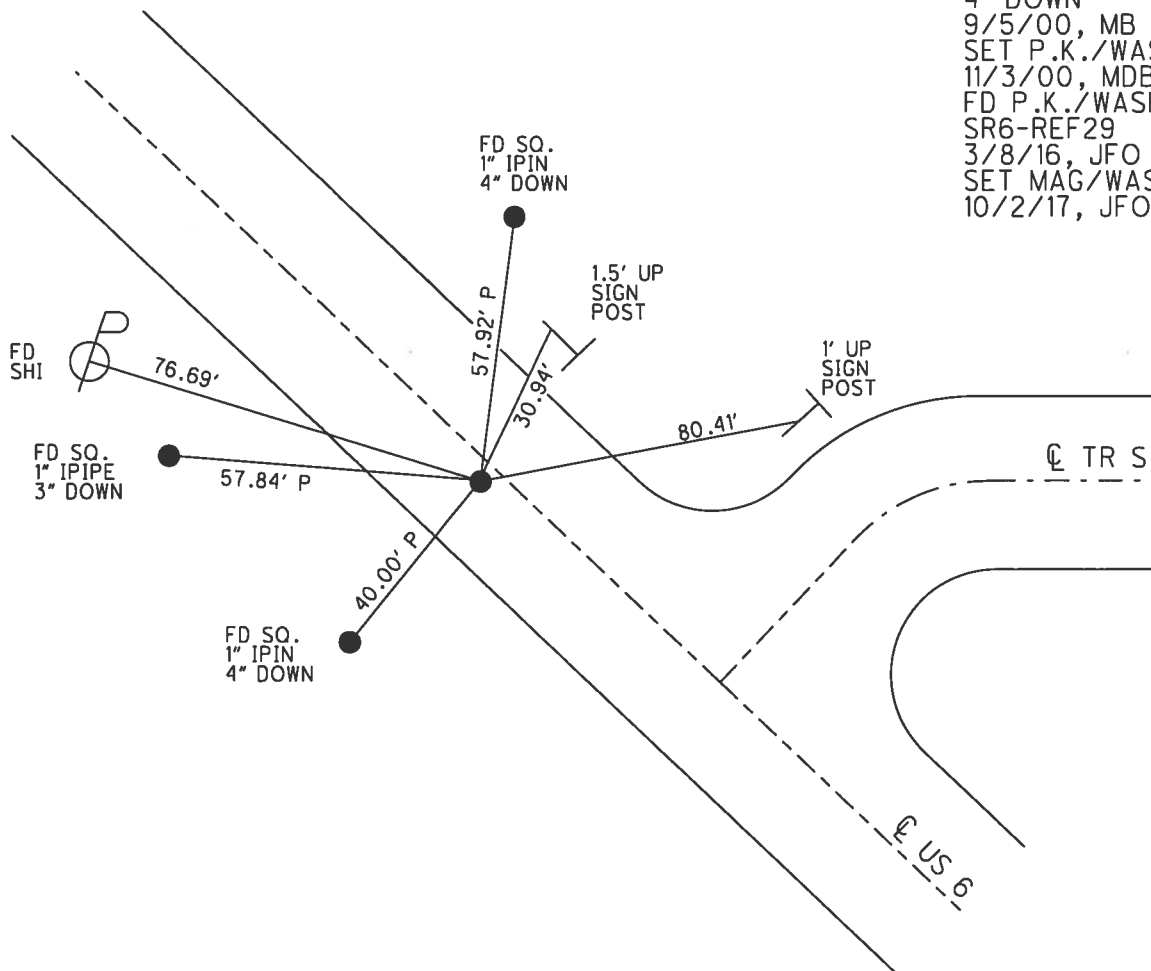


O.D.O.T. DISTRICT 2 SURVEY OFFICE (USE ONLY)

PERSONNEL _____ REFERENCE NO. 29 A SHEET 26 OF 37
 NOTES O'DONNELL DATE 10/2/17 ROUTE US 6
 H.C. LEU WEATHER SUNNY COUNTY HENRY
 R.C. FARKAS TEMP. 70° TOWNSHIP NAPOLEON
 _____ SECTION 5
 _____ T 5 N R 6 E

TYPE MONUMENT MAG/WASHER
 ON SURFACE - ~~BELOW~~ ON
~~LEFT~~ - CL PAV'T - RIGHT 2.3'
9.6' TO RT EDGE PAVEMENT
 S.L.M. 404+60.49

Grid: Northing: 644987.256 Easting: 1502564.350

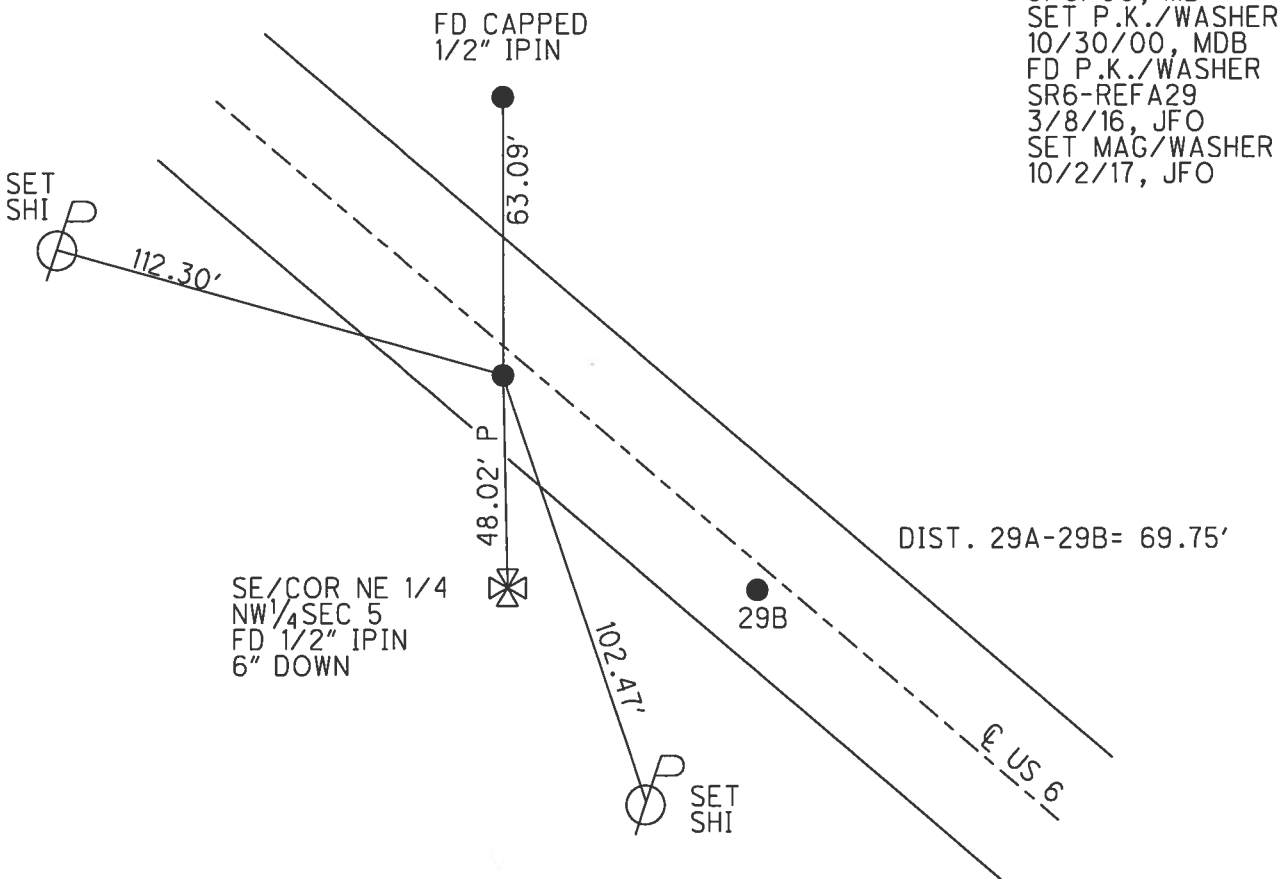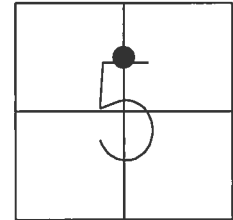

O.D.O.T. DISTRICT 2 SURVEY OFFICE (USE ONLY)

PERSONNEL

REFERENCE NO. 29 B

SHEET 27 OF 37

NOTES O'DONNELL

DATE 10/2/17

ROUTE US 6

H.C. LEU

WEATHER SUNNY

COUNTY HENRY

R.C. FARKAS

TEMP. 70°

TOWNSHIP NAPOLEON

SECTION 5

T 5 N R 6 E

TYPE MONUMENT MAG/WASHER


ON SURFACE - ~~BELOW~~ ON

~~LEFT~~ - CL PAV'T - RIGHT 2.3'


9.6' TO RT EDGE PAVEMENT

S.L.M. 405+30.24

Grid: Northing: 644938.056 Easting: 1502613.784

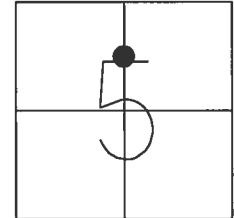

RECORD: P.O.T.
STA. 405+22.63
FD P.K./WASHER
4" DOWN
9/6/00, MB
SET P.K./WASHER
10/30/00, MDB
FD P.K./WASHER
SR6-REFB29
3/8/16, JFO
SET MAG/WASHER
10/2/17, JFO

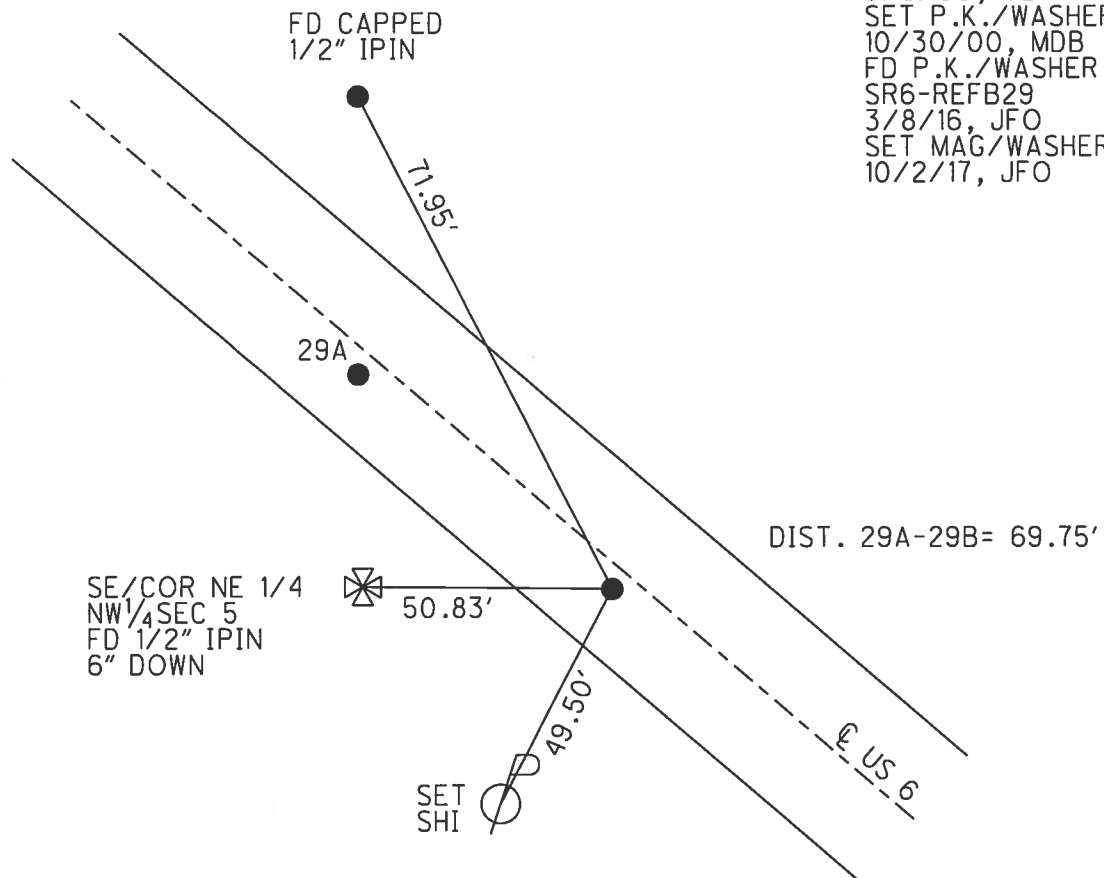

O.D.O.T. DISTRICT 2 SURVEY OFFICE (USE ONLY)

PERSONNEL

REFERENCE NO.

30

SHEET 28 OF 37

NOTES O'DONNELL

DATE _____

10/16/17

ROUTE US 6

H.C. LEU

WEATHER

SUNNY

COUNTY HENRY

R.C. FARKAS

TEMP.

$$\overline{47^\circ}$$

TOWNSHIP NAPOLEON

SECTION

51

T_5_N R_6_E

TYPE MONUMENT MAG/WASHER


ON SURFACE - ~~BELOW~~ ON

~~LEFT~~ - C PAV'T - RIGHT 2.2'


10' TO RT EDGE PAVEMENT

S.L.M. 424+51.20

Grid: Northing: 643585.729 Easting: 1503978.084

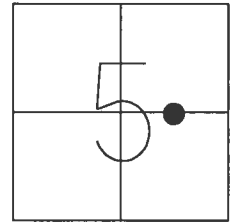

RECORD: P.I.
STA. 424+43.44
 $\Delta = 0^{\circ} 02' \text{ LT}$
FD P.K./NAIL
4" DOWN
9/6/00, MB
SET P.K./WASHER
10/31/00, MDB
FD P.K./WASHER
SR6-REF30
3/8/16, JFO
SET MAG/WASHER
10/16/17, JFO

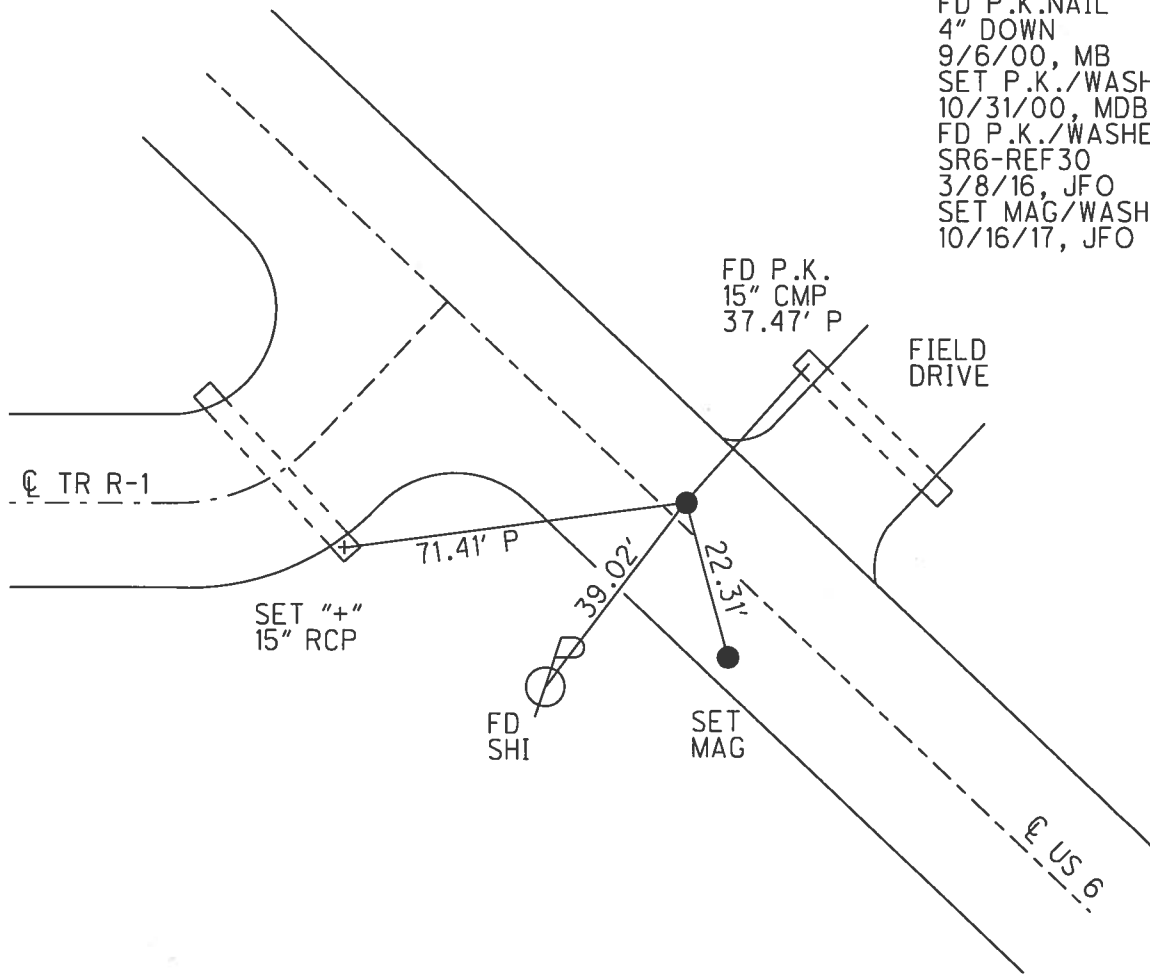

O.D.O.T. DISTRICT 2 SURVEY OFFICE (USE ONLY)

PERSONNEL _____ REFERENCE NO. 31 SHEET 29 OF 37

NOTES	<u>O'DONNELL</u>	DATE	<u>10/16/17</u>	ROUTE	<u>US 6</u>
H.C.	<u>LEU</u>	WEATHER	<u>SUNNY</u>	COUNTY	<u>HENRY</u>
R.C.	<u>FARKAS</u>	TEMP.	<u>47°</u>	TOWNSHIP	<u>NAPOLEON</u>
				SECTION	<u>5</u>
				T <u>5</u> N	R <u>6</u> E

TYPE MONUMENT MAG/WASHER


ON SURFACE - ~~BELOW~~ ON _____

~~LEFT~~ - CL PAV'T - RIGHT 1.6'


10.9' TO RT EDGE PAVEMENT

S.L.M. 440+66.08

Grid: Northing: 642449.198 Easting: 1505125.315

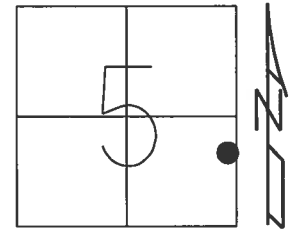

RECORD: P.I.
STA. 440+58.09
 $\Delta = 0^\circ 07' \text{ RT}$
FD P.K.NAIL
4" DOWN
9/7/00, MB
SET P.K./WASHER
11/6/00, MDB
FD P.K.NAIL
5" DOWN
SR6-REF31
3/9/16, JFO
SET MAG/WASHER
BY COORD'S
10/16/17, JFO

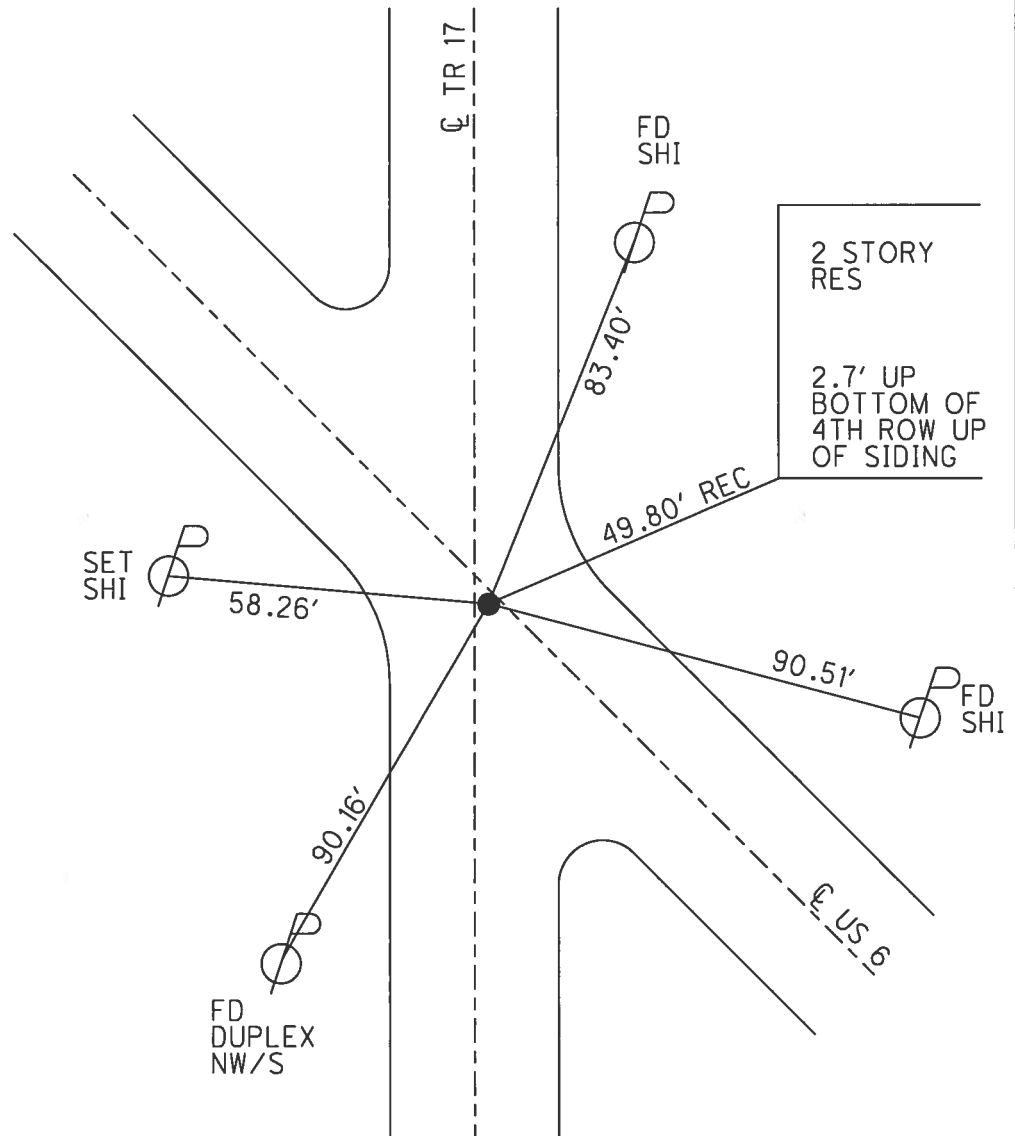


O.D.O.T. DISTRICT 2 SURVEY OFFICE (USE ONLY)


PERSONNEL	REFERENCE NO. <u>31 A</u>	SHEET <u>30</u> OF <u>37</u>
NOTES <u>O'DONNELL</u>	DATE <u>10/16/17</u>	ROUTE <u>US 6</u>
H.C. <u>LEU</u>	WEATHER <u>SUNNY</u>	COUNTY <u>HENRY</u>
R.C. <u>FARKAS</u>	TEMP. <u>47°</u>	TOWNSHIP <u>NAPOLEON</u>
		SECTION <u>4</u>
		T <u>5</u> N R <u>6</u> E

TYPE MONUMENT MAG/WASHER
 ON SURFACE - ~~BELOW~~ ON
~~LEFT~~ - ℄ PAV'T - RIGHT 3.8'
8.6' TO RT EDGE PAVEMENT
 S.L.M. 443+61.55

Grid: Northing: 642237.222 Easting: 1505331.153

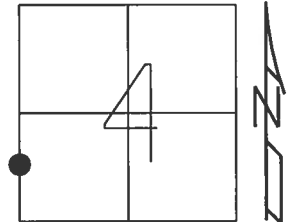

RECORD: P.O.T.
 STA. 443+53.46
 FD P.K./WASHER
 4" DOWN
 9/7/00, MB
 SET P.K./WASHER
 11/06/00, MDB
 FD P.K./WASHER
 SR6-REFA31
 3/9/16, JFO
 SET MAG/WASHER
 10/16/17, JFO

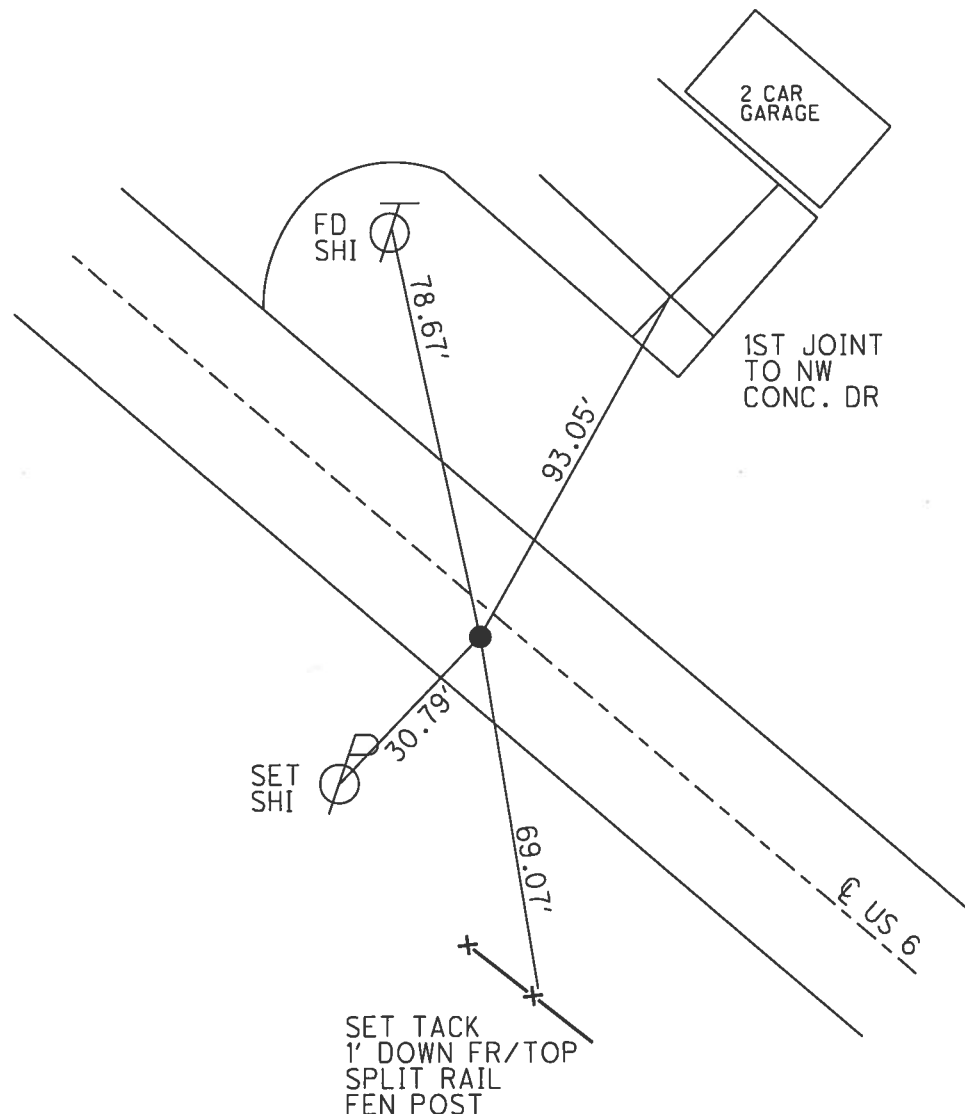

O.D.O.T. DISTRICT 2 SURVEY OFFICE (USE ONLY)

PERSONNEL

REFERENCE NO.

32

SHEET

31

OF 37

NOTES O'DONNELL

DATE

10/16/17

ROUTE US 6

H.C. LEU

WEATHER

SUNNY

COUNTY HENRY

R.C. FARKAS

TEMP.

47°

TOWNSHIP NAPOLEON

SECTION

4

T 5 N R 6 E

TYPE MONUMENT MAG/WASHER


ON SURFACE - ~~BELOW~~ ON

~~LEFT~~ - CL PAV'T - RIGHT 3'


9.2' TO RT EDGE PAVEMENT

S.L.M. 462+03.29

Grid: Northing: 640915.701 Easting: 1506613.964

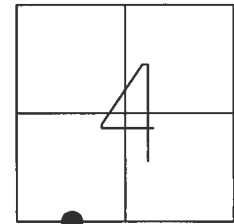

RECORD: P.I.
STA. 460+78
FD LG.R.R.SPIKE
5" DOWN
9/7/00, MB
SET P.K./WASHER
11/6/00, MDB
FD P.K./WASHER
SR6-REF32
3/9/16, JFO
SET MAG/WASHER
10/16/17, JFO

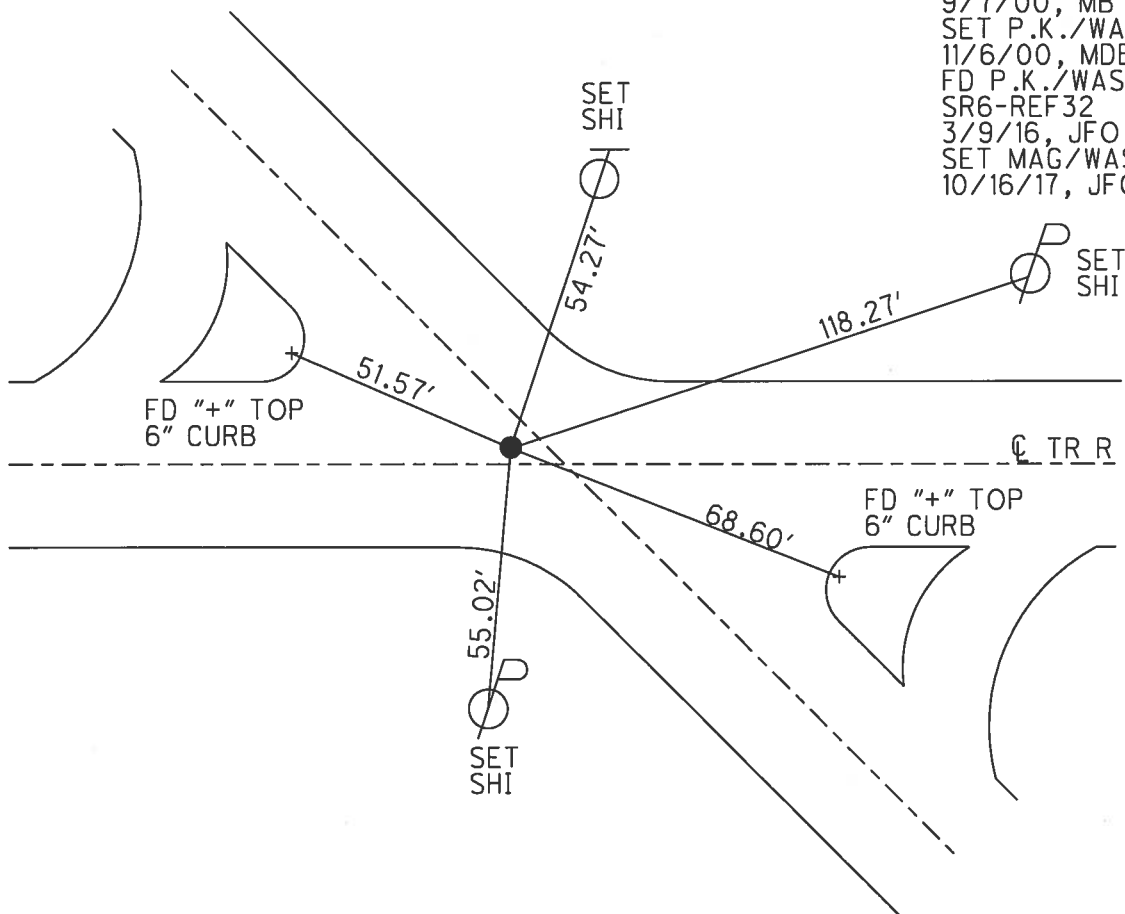

O.D.O.T. DISTRICT 2 SURVEY OFFICE (USE ONLY)

PERSONNEL

REFERENCE NO.

33

SHEET 32 OF 37

NOTES O'DONNELL

DATE 10/16/17

ROUTE US 6

H.C. LEU

WEATHER SUNNY

COUNTY HENRY

R.C. FARKAS

TEMP. 47°

TOWNSHIP NAPOLEONSECTION 9

T_5_N R_6_E

TYPE MONUMENT MAG/WASHER


ON SURFACE - ~~BELOW~~ ON

~~LEFT~~ - C PAV'T - RIGHT 0.7'


11.0' TO RT EDGE PAVEMENT

S.L.M. 506+00

Grid: Northing: 638251.134 Easting: 1510069.596

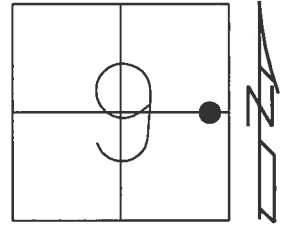

RECORD: P.O.T.
STA. 505+95.65
FD P.K./WASHER
4" DOWN
9/7/00, MB
SET P.K./WASHER
11/6/00, MDB
FD P.K.NAIL
SR6-REF33
3/9/16, JFO
SET MAG/WASHER
10/16/17, JFO


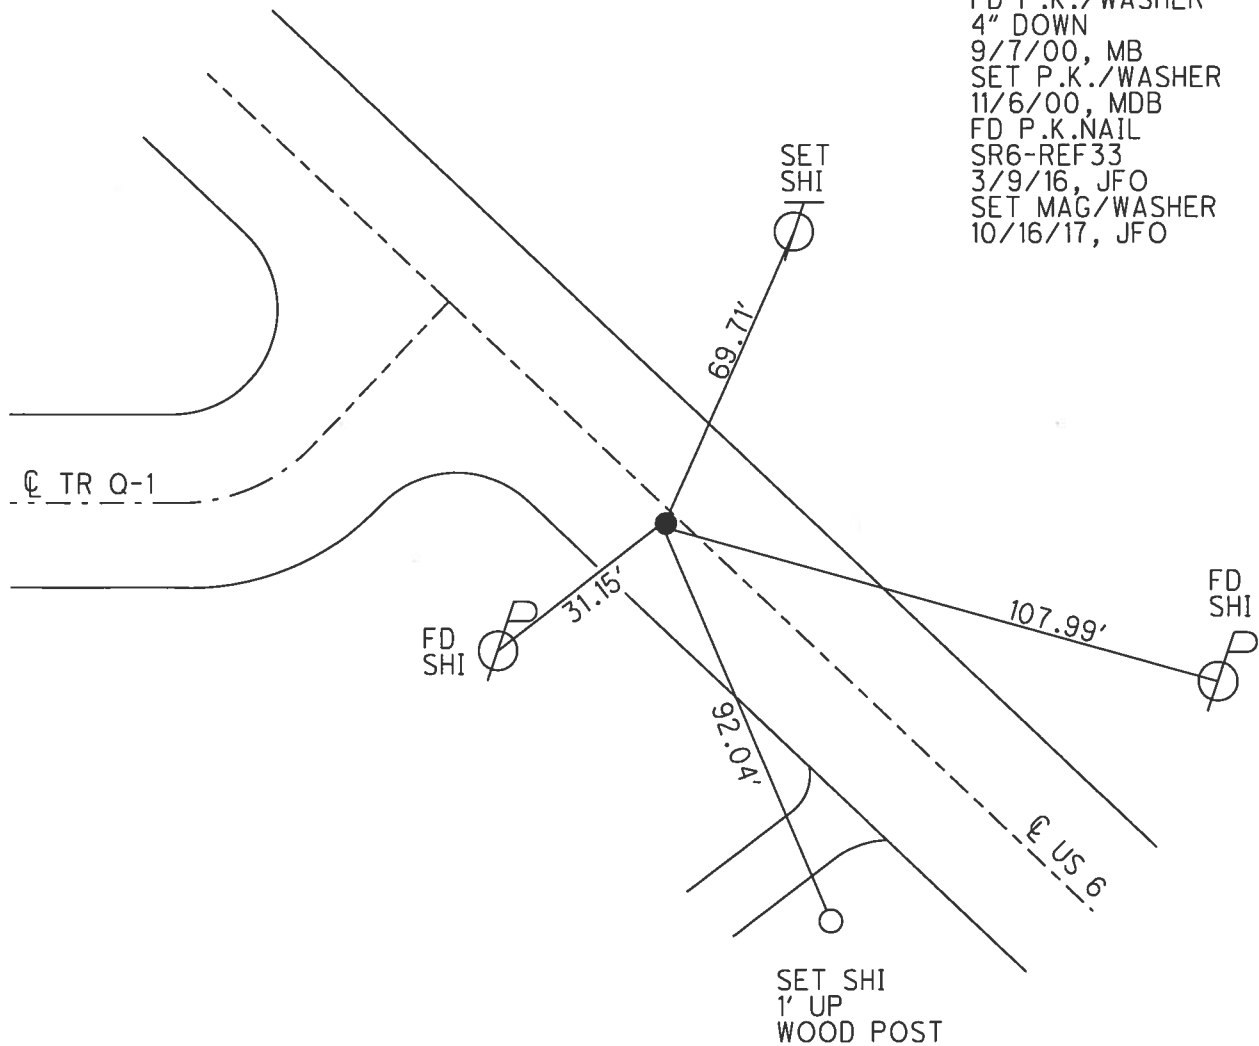


O.D.O.T. DISTRICT 2 SURVEY OFFICE (USE ONLY)

PERSONNEL	REFERENCE NO.	<u>34</u>	SHEET	<u>33</u>	OF	<u>37</u>
NOTES	<u>O'DONNELL</u>	DATE	<u>10/16/17</u>	ROUTE	<u>US 6</u>	
H.C.	<u>LEU</u>	WEATHER	<u>SUNNY</u>	COUNTY	<u>HENRY</u>	
R.C.	<u>FARKAS</u>	TEMP.	<u>52°</u>	TOWNSHIP	<u>NAPOLEON</u>	
				SECTION	<u>9</u>	
				T	<u>5</u>	R
					<u>6</u>	<u>E</u>

TYPE MONUMENT MAG/WASHER
ON SURFACE - ~~BELOW~~ ON
~~LEFT~~ - ℄ PAV'T - RIGHT 0.9'
10.7' TO RT EDGE PAVEMENT
S.L.M. 508+78.90

Grid: Northing: 638107.569 Easting: 1510308.757

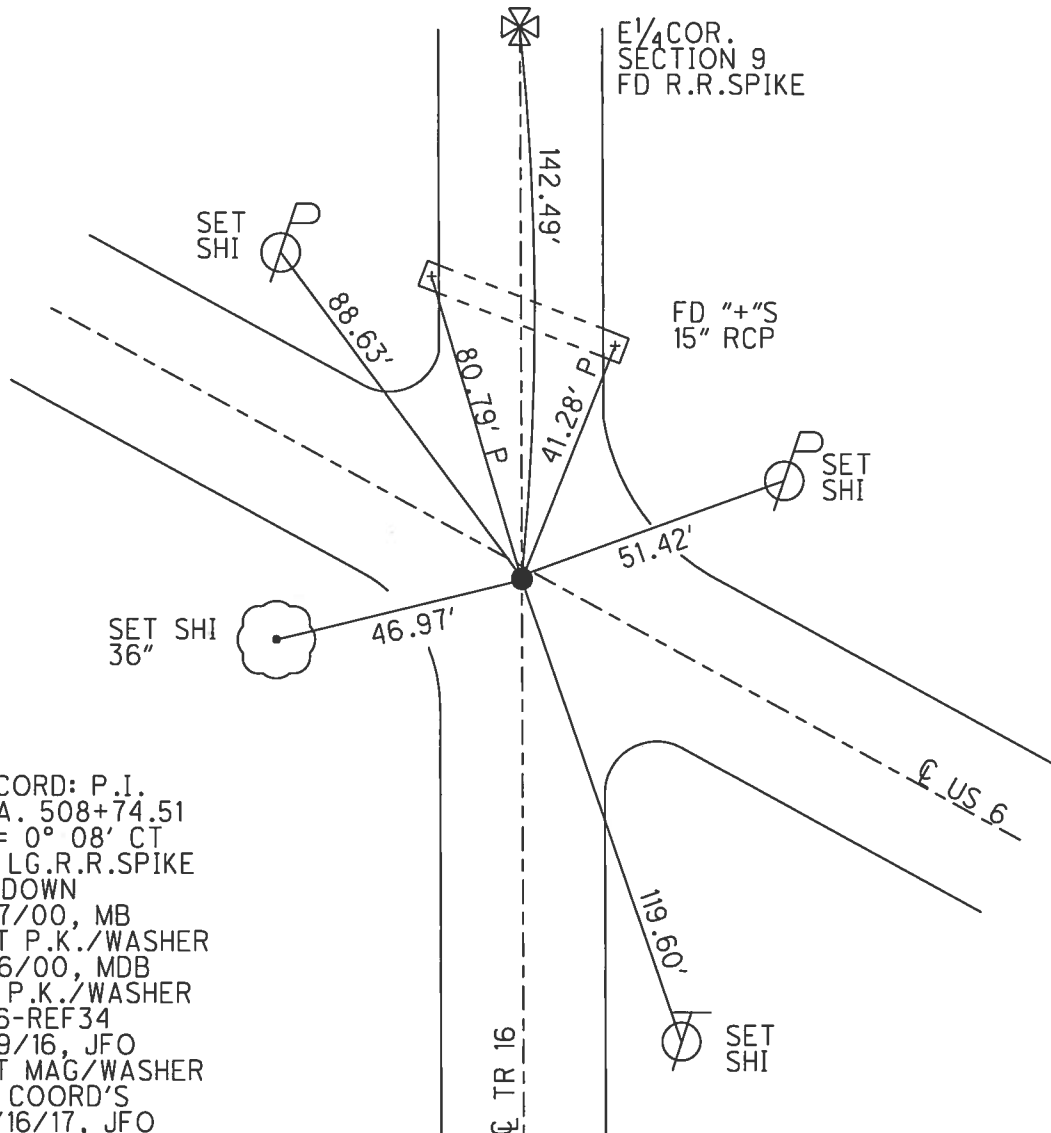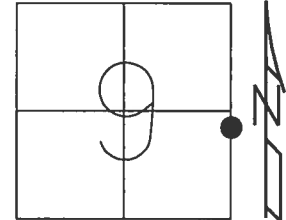

RECORD: P.I.
STA. 508+74.51
 $\Delta = 0^{\circ} 08' \text{ CT}$
FD LG.R.R.SPIKE
6" DOWN
9/7/00, MB
SET P.K./WASHER
11/6/00, MDB
FD P.K./WASHER
SR6-REF34
3/9/16, JFO
SET MAG/WASHER
BY COORD'S
10/16/17, JFO

O.D.O.T. DISTRICT 2 SURVEY OFFICE (USE ONLY)

PERSONNEL

REFERENCE NO.

34 A

SHEET 34 OF 37

NOTES O'DONNELL

DATE 10/16/17

ROUTE US 6

H.C. LEU

WEATHER SUNNY

COUNTY HENRY

R.C. FARKAS

TEMP. 52°

TOWNSHIP NAPOLEON

SECTION 10

T 5 N R 6 E

TYPE MONUMENT MAG/WASHER


ON SURFACE - ~~BELOW~~ ON

~~LEFT~~ - C PAV'T - RIGHT 2.6'


9.6' TO RT EDGE PAVEMENT

S.L.M. 524+14.91

Grid: Northing: 637320.275 Easting: 1511627.598

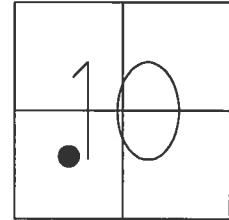

RECORD: P.O.T.
STA. 524+10.63
FD P.K./WASHER
5" DOWN
9/8/00, MB
SET P.K./WASHER
11/6/00, MDB
FD P.K./WASHER
SR6-REFA34
3/9/16, JFO
SET MAG/WASHER
10/16/17, JFO


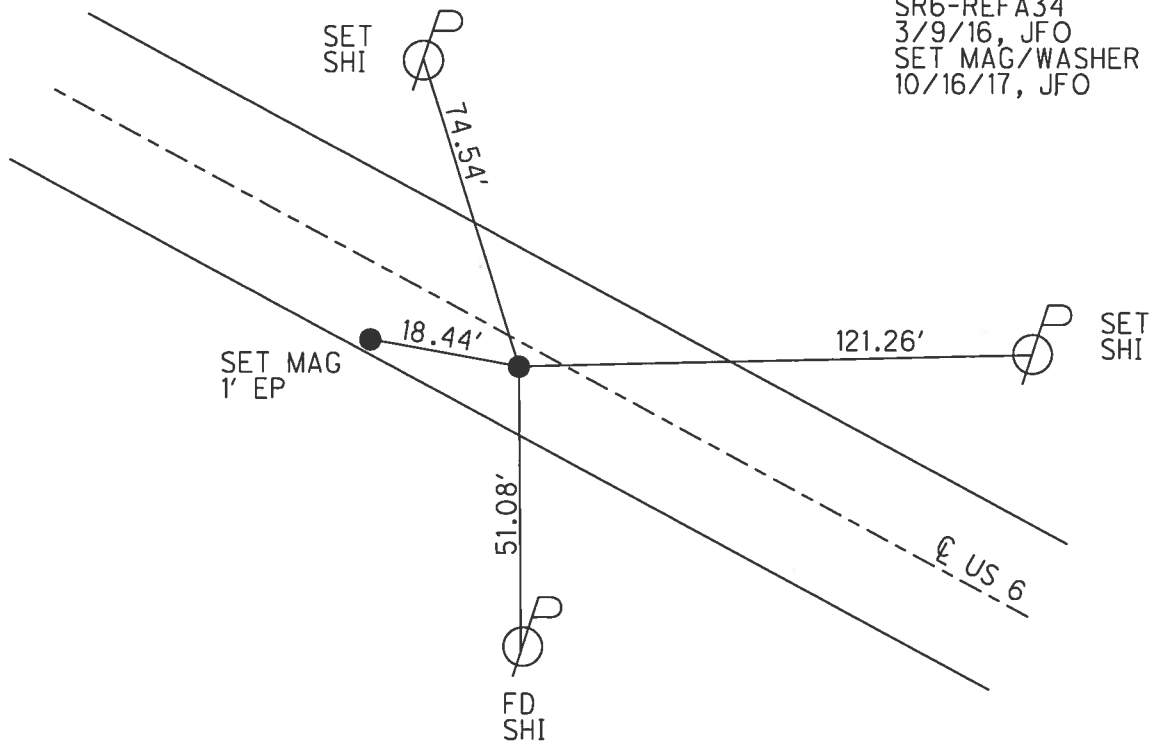


O.D.O.T. DISTRICT 2 SURVEY OFFICE (USE ONLY)

PERSONNEL _____ REFERENCE NO. 34 B SHEET 35 OF 37
 NOTES O'DONNELL DATE 10/16/17 ROUTE US 6
 H.C. LEU WEATHER SUNNY COUNTY HENRY
 R.C. FARKAS TEMP. 52° TOWNSHIP NAPOLEON
 SECTION 10
 T 5 N R 6 E

TYPE MONUMENT MAG/WASHER
 ON SURFACE - ~~BELOW~~ ON _____
~~LEFT~~ - CL PAV'T - RIGHT 1.1'
11.4' TO RT EDGE PAVEMENT
 S.L.M. 539+48.58

Grid: Northing: 636534.255 Easting: 1512944.535

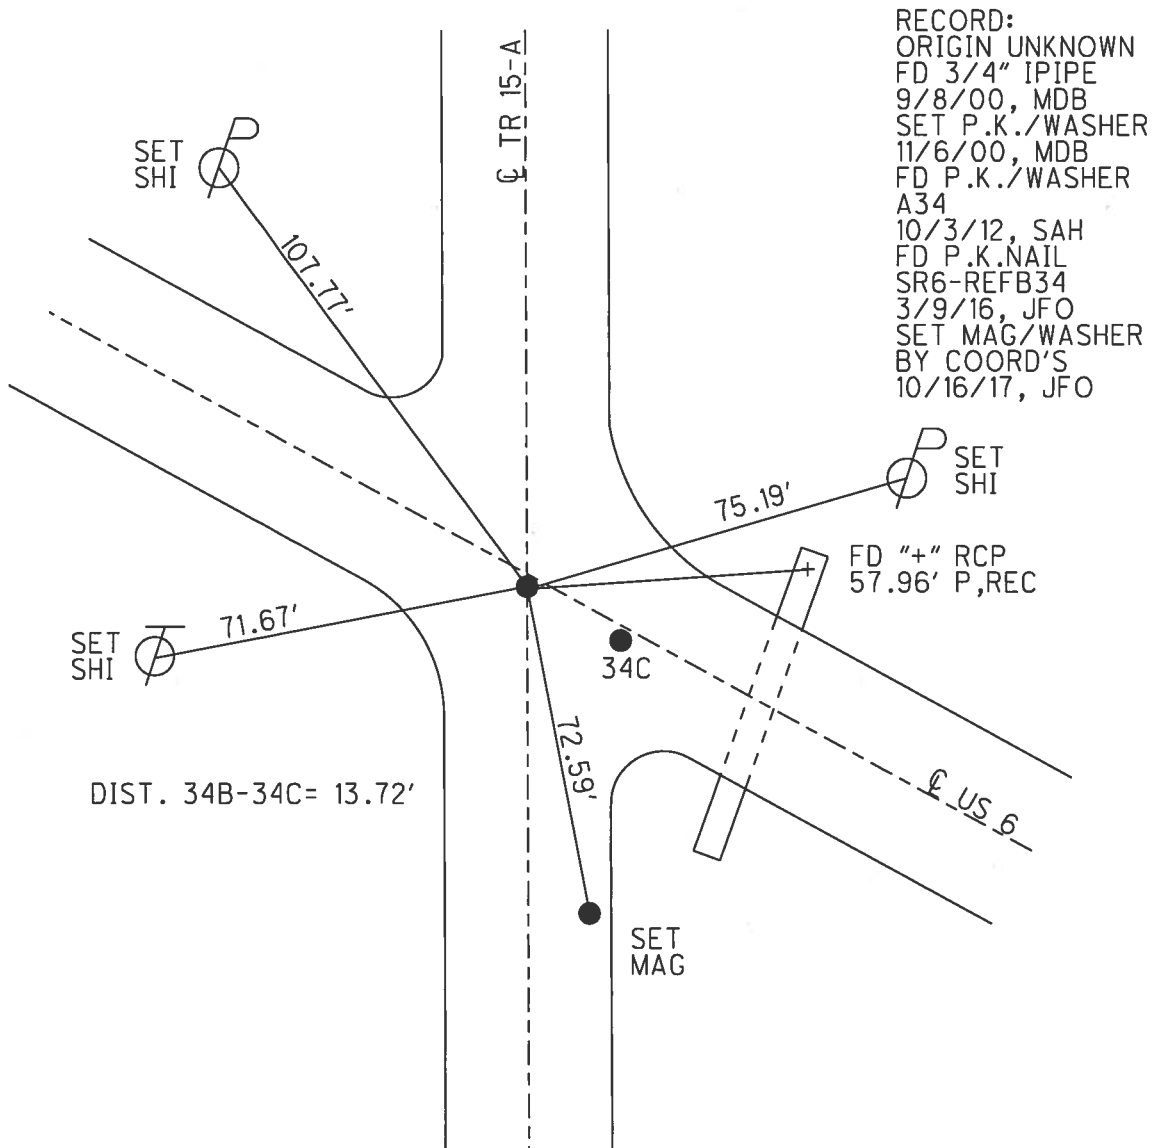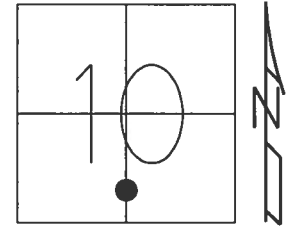

O.D.O.T. DISTRICT 2 SURVEY OFFICE (USE ONLY)

PERSONNEL

REFERENCE NO.

34 C

SHEET 36 OF 37

NOTES O'DONNELL

DATE 10/16/17

ROUTE US 6

H.C. LEU

WEATHER SUNNY

COUNTY HENRY

R.C. FARKAS

TEMP. 52°

TOWNSHIP NAPOLEONSECTION 10

T_5_N R_6_E

TYPE MONUMENT MAG/WASHER



ON SURFACE - ~~BELOW~~ ON

~~LEFT~~ - C PAV'T - RIGHT 0.9'

11.4' TO RT EDGE PAVEMENT

S.L.M. 539+62.29

Grid: Northing: 636527.251 Easting: 1512956.320

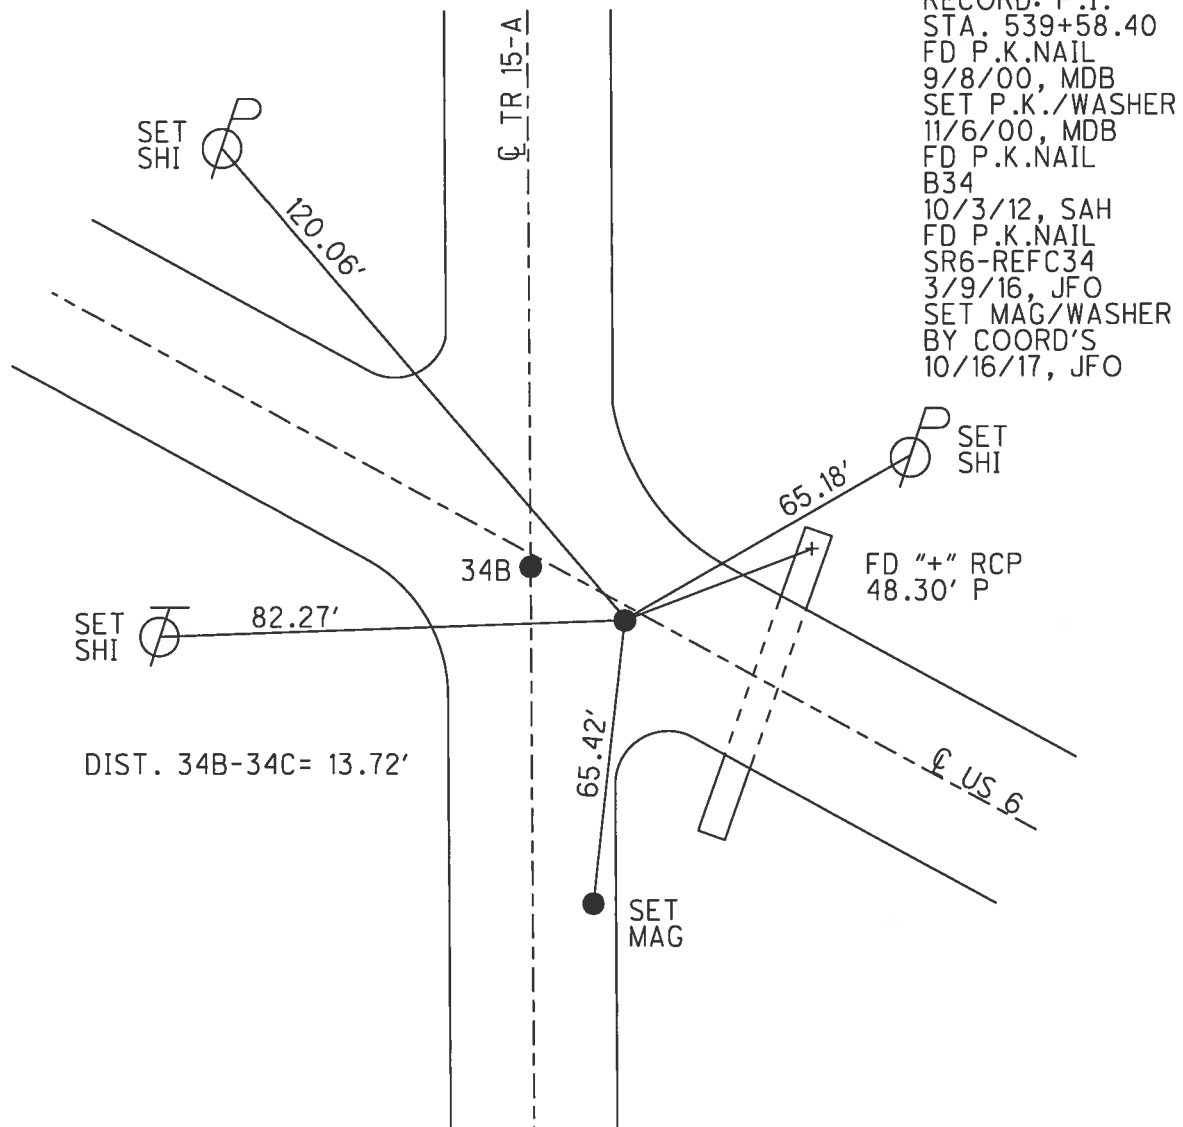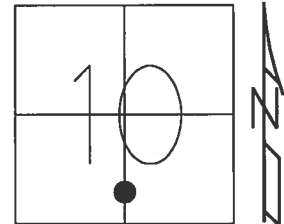

O.D.O.T. DISTRICT 2 SURVEY OFFICE (USE ONLY)

PERSONNEL

REFERENCE NO. 35

SHEET 37 OF 47

NOTES RHOADES

DATE 3/9/16

ROUTE US 6

H.C. O'DONNELL

WEATHER CLEAR

COUNTY HENRY

R.C. _____

TEMP. 61°

TOWNSHIP NAPOLEON

DWG BY NIESE PID 95744

SECTION 15

T 5 N R 6 E

TYPE MONUMENT MONBOX W/1" IPIN

ON SURFACE - ~~BELOW~~ ON

OFFSET CL PAVEMENT 0.3' LT : RT

28.7' TO LT EDGE PAVEMENT


STATION: 560+41.04

HORZ.DATUM: NAD83 2011


GEOID: NAVD88 2012A

GRID: NORTHING: 635460.811

EASTING: 1514740.691

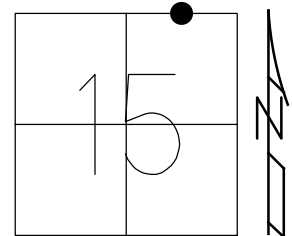

RECORD:
FD MONBOX
W/1" IPIN
9/8/00, MDB
10/3/12, SAH
FD MONBOX
W/1" IPIN
SR6-REF35
3/9/16, JFO

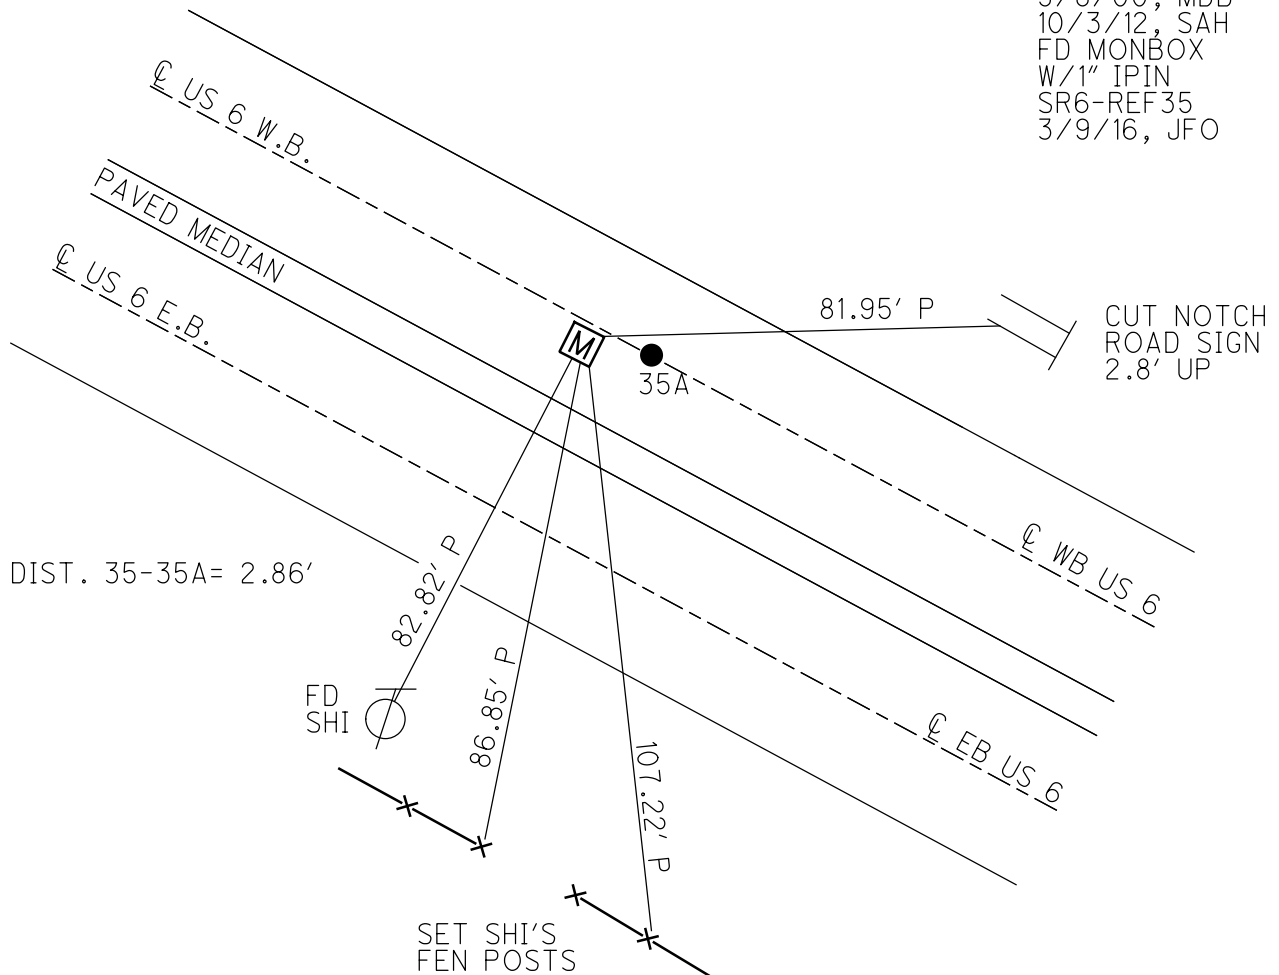

O.D.O.T. DISTRICT 2 SURVEY OFFICE (USE ONLY)

PERSONNEL

REFERENCE NO. 35 A

SHEET 38 OF 47

NOTES BARNHISEL

DATE 9/8/00

ROUTE US 6

H.C. MOSE

WEATHER CLEAR

COUNTY HENRY

R.C. CANTERBURY

TEMP. 75°

TOWNSHIP NAPOLEON

HUSS

SECTION 15

DWG BY NIESE

PID _____

T 5 N R 6 E

TYPE MONUMENT P.K./WASHER

~~ON SURFACE~~ - BELOW 4"

OFFSET Q PAVEMENT ON Q WB LANE LT : RT

28.7' TO LT EDGE PAVEMENT


STATION: 560+41.04

HORIZ.DATUM: _____


GEOID: _____

GRID: NORTHING: _____

EASTING: _____

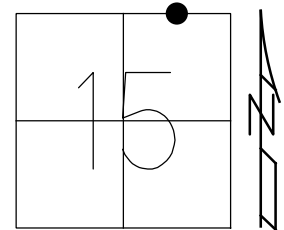

RECORD:
999.23' MEAS.EDM
TO MONBOX AT
N-S SEC. LINE
FD P.K./WASHER
4" BELOW
9/8/00, MDB
SET P.K./WASHER
11/6/00, MDB

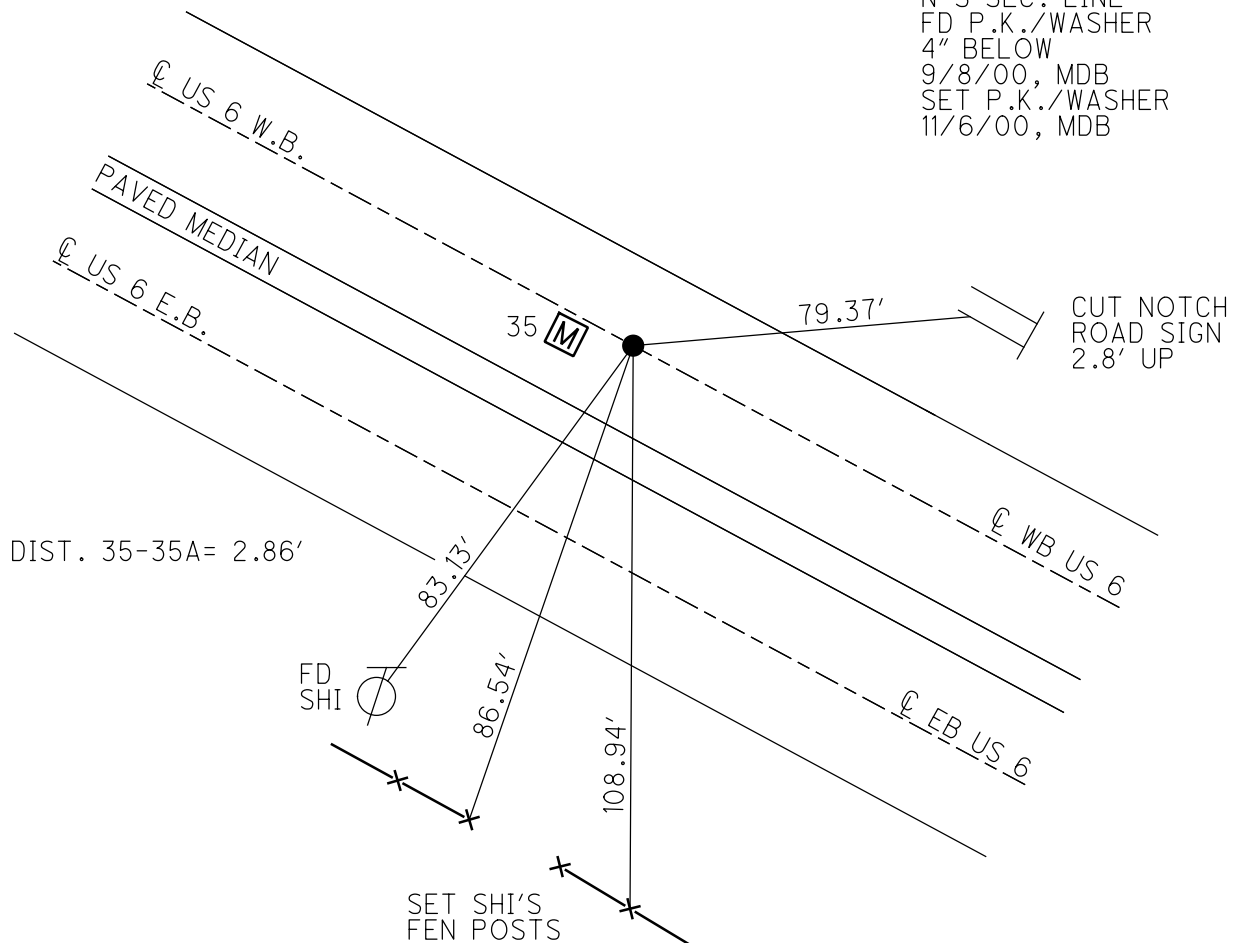

O.D.O.T. DISTRICT 2 SURVEY OFFICE (USE ONLY)

PERSONNEL

REFERENCE NO. 36

SHEET 39 OF 47

NOTES BARNHISEL

DATE 9/8/00

ROUTE US 6

H.C. MOSER

WEATHER SUNNY

COUNTY HENRY

R.C. CANTERBURY

TEMP. 75°

TOWNSHIP NAPOLEON

HUSS

SECTION 15

DWG BY NIESE PID

T 5 N R 6 E

TYPE MONUMENT MONBOX W/ 1" IPIN

ON SURFACE - ~~BELOW~~ ON

OFFSET ℄ PAVEMENT ON NORTH BERM LT : RT

2.4' LT TO LT EDGE PAVEMENT



STATION: 569+20

HORIZ.DATUM:

GEOID:

GRID: NORTHING:

EASTING:

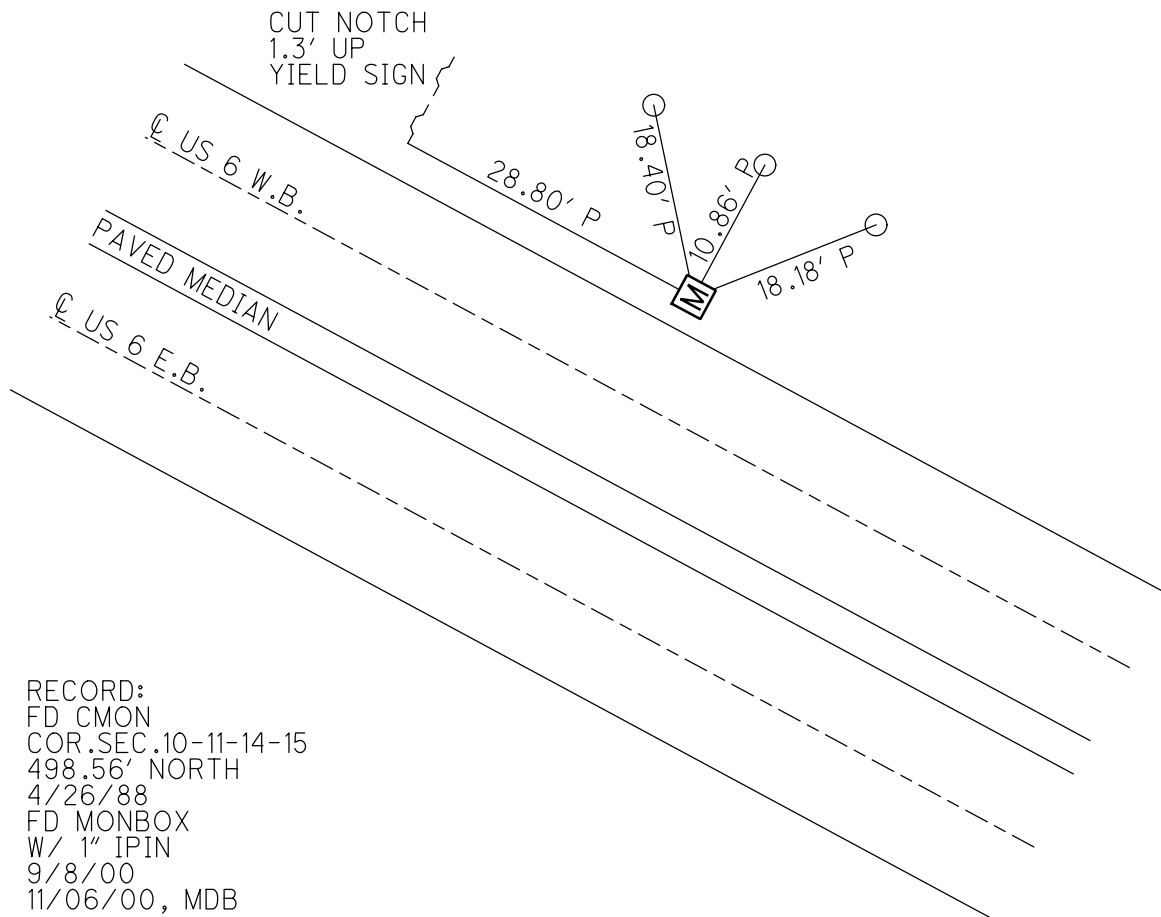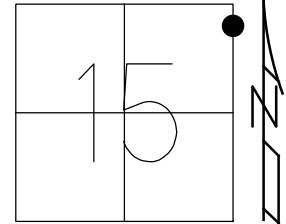

O.D.O.T. DISTRICT 2 SURVEY OFFICE (USE ONLY)

PERSONNEL

REFERENCE NO. 37

SHEET 40 OF 47

NOTES BARNHISEL

DATE 9/8/00

ROUTE US 6

H.C. MOSER

WEATHER SUNNY

COUNTY HENRY

R.C. CANTERBURY

TEMP. 75°

TOWNSHIP NAPOLEON

HUSS

SECTION 14

DWG BY NIESE PID _____

T 5 N R 6 E

TYPE MONUMENT MONBOX W/ 1" IPIN

ON SURFACE - ~~BELOW~~ ON

OFFSET Q PAVEMENT 14.0' LT : ~~RT~~

15.4' TO LT EDGE PAVEMENT OF RAMP



STATION: 575+94

HORZ.DATUM: _____

GEOID: _____

GRID: NORTHING: _____

EASTING: _____

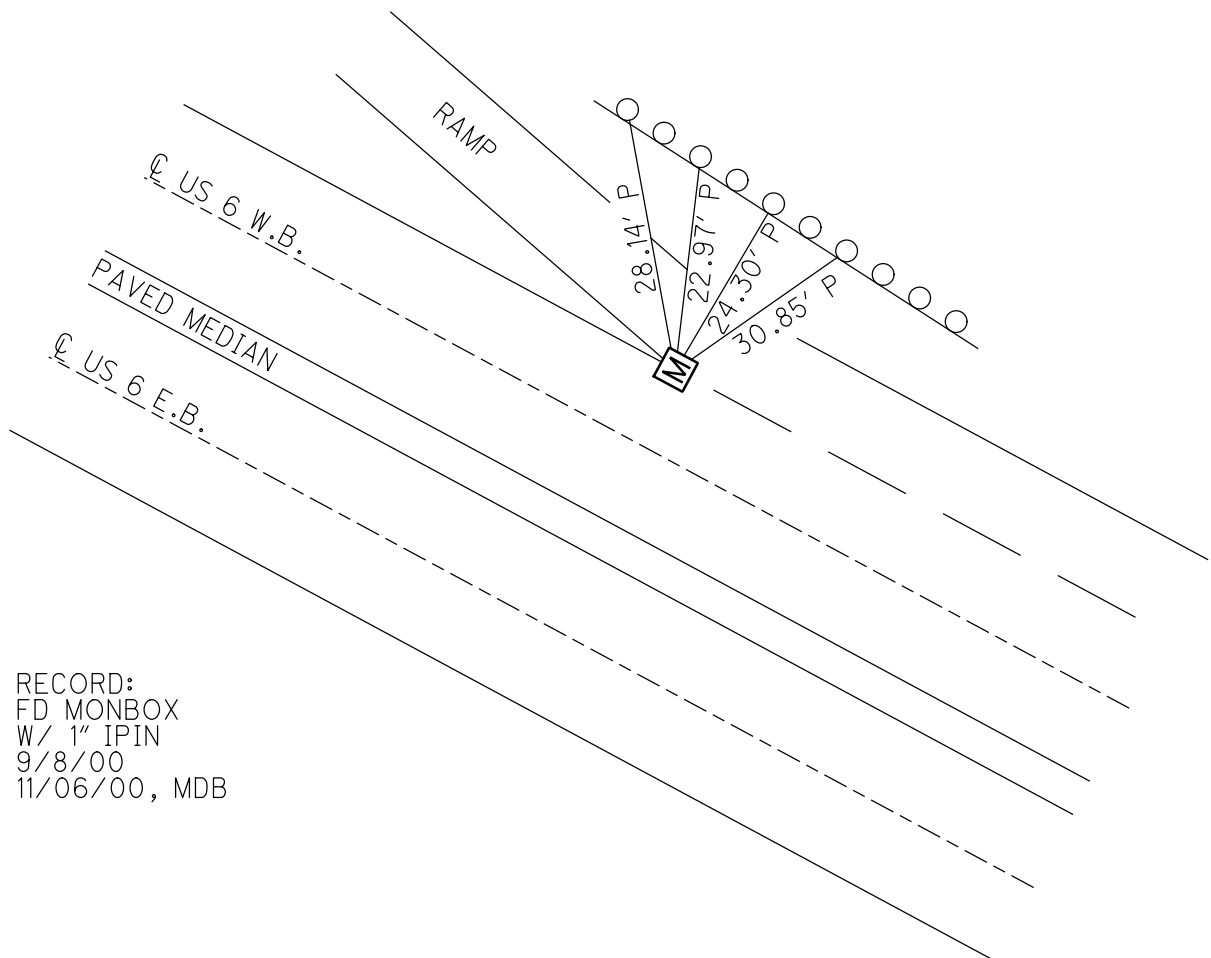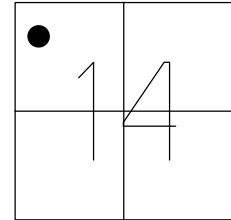

RECORD:
FD MONBOX
W/ 1" IPIN
9/8/00
11/06/00, MDB

O.D.O.T. DISTRICT 2 SURVEY OFFICE (USE ONLY)

PERSONNEL

REFERENCE NO. 37 A

SHEET 41 OF 47

NOTES HOFFMAN

DATE 10/15/84

ROUTE TR R

H.C. LOEHRKE

WEATHER CLOUDY

COUNTY HENRY

R.C. HOUSEHOLDER

TEMP. 60°

TOWNSHIP NAPOLEON
SECTION 18

DWG BY NIESE PID

T 5 N R 6 E

TYPE MONUMENT IPIPE

~~ON SURFACE~~ - BELOW 7"


OFFSET @ PAVEMENT _____ LT : RT

_____TO_____EDGE PAVEMENT


STATION: _____

HORZ.DATUM: _____ GEOID: _____

GRID: NORTHING:_____ EASTING:_____

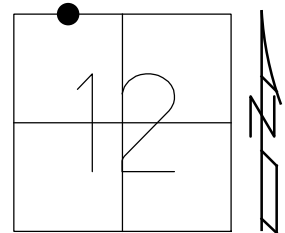

RECORD:
FD IPIPE
7" DOWN
10/15/84, CL

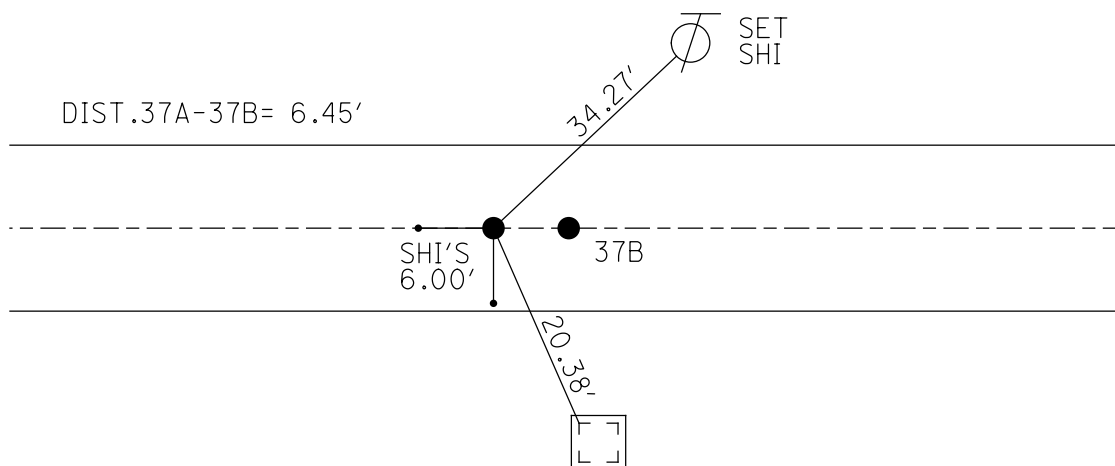

NEAR SIDE OF
NW LEG OF TOWER
ABOVE STEEL BASE

O.D.O.T. DISTRICT 2 SURVEY OFFICE (USE ONLY)

PERSONNEL

REFERENCE NO. 37 A

SHEET 42 OF 47

NOTES HOFFMAN

DATE 10/15/84

ROUTE TR R

H.C. LOEHRKE

WEATHER CLOUDY

COUNTY HENRY

R.C. HOUSEHOLDER

TEMP. 60°

TOWNSHIP NAPOLEON

SECTION 12

DWG BY NIESE PID _____

T 5 N R 6 E

TYPE MONUMENT IPIN

~~ON SURFACE~~ - BELOW 4 1/2"


OFFSET Q PAVEMENT _____ LT : RT

_____ TO _____ EDGE PAVEMENT


STATION: _____

HORIZ.DATUM: _____ GEOID: _____

GRID: NORTHING: _____ EASTING: _____

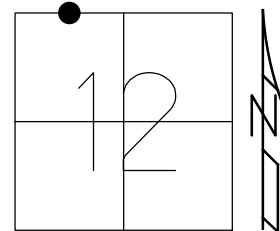

RECORD:
FD IPIN
4 1/2" DOWN
ORIGIN UNKNOWN
10/15/84, CL

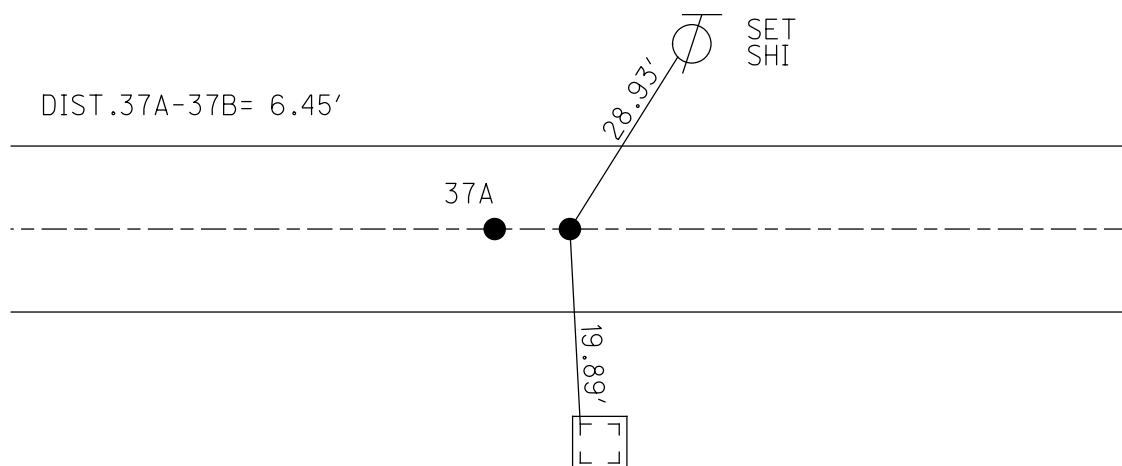

NEAR SIDE OF
NW LEG OF TOWER
ABOVE STEEL BASE

O.D.O.T. DISTRICT 2 SURVEY OFFICE (USE ONLY)

PERSONNEL

REFERENCE NO. 38

SHEET 43 OF 47

NOTES BURNSIDE

DATE 4/26/79

ROUTE US 6

H.C. SMITH

WEATHER CLOUDY

COUNTY HENRY

R.C. BOWERS

TEMP. 60°

TOWNSHIP LIBERTY

SECTION 6

DWG BY NIESE PID

T 6 N R 7 E

TYPE MONUMENT CMON W/ 1/4" IPIN

ON SURFACE - ~~BELOW~~ ON

OFFSET Q PAVEMENT ON LT : RT

- TO - EDGE PAVEMENT


STATION: 731+89.90

HORZ.DATUM:


GEOID:

GRID: NORTHING:

EASTING:

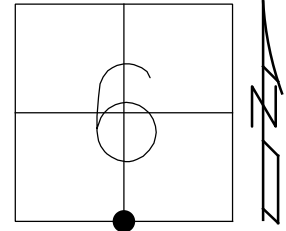

RECORD:
FD CMON
W/ 1/4" IPIN
4/26/79, BURNSIDE

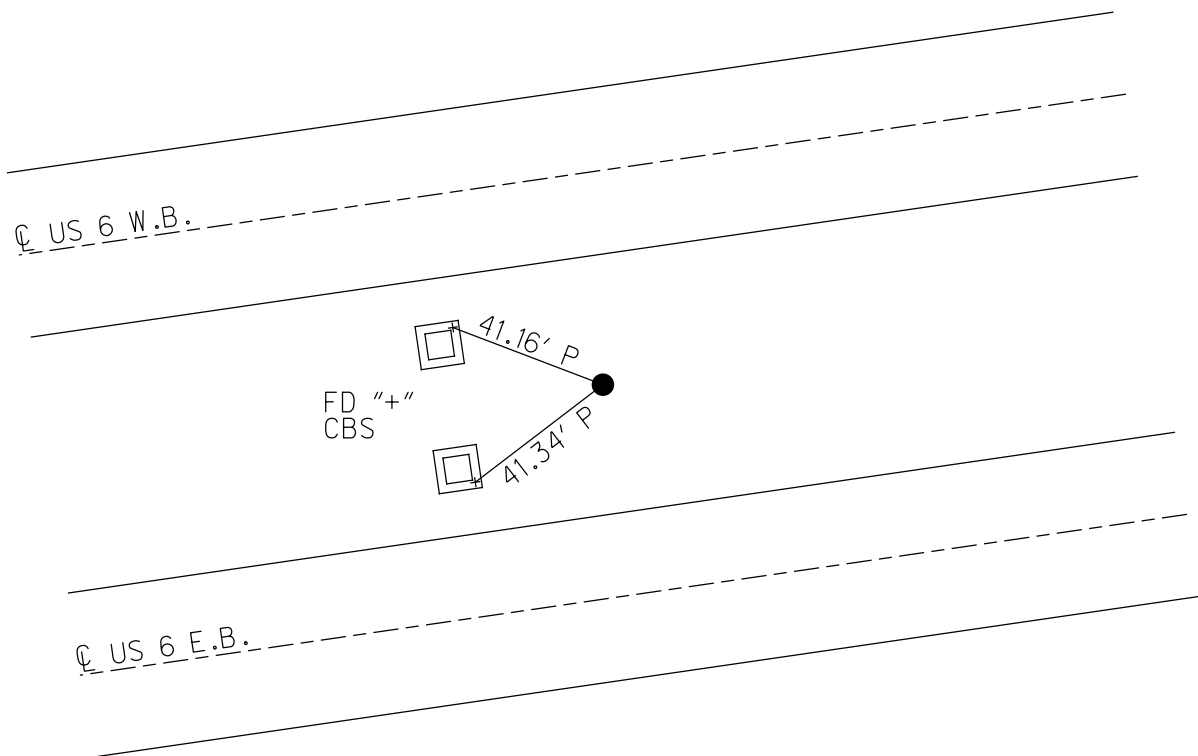

O.D.O.T. DISTRICT 2 SURVEY OFFICE (USE ONLY)

PERSONNEL

REFERENCE NO. 39

SHEET 44 OF 47

NOTES BURNSIDE

DATE 4/27/79

ROUTE US 6

H.C. SMITH

WEATHER CLOUDY

COUNTY HENRY

R.C. BOWERS

TEMP. 50°

TOWNSHIP LIBERTY

SECTION 6

DWG BY NIESE

PID

T 6 N R 7 E

TYPE MONUMENT MONBOX W/ 1" IPIN

ON SURFACE - ~~BELOW~~ ON

OFFSET ℄ PAVEMENT ON LT : RT

- TO - EDGE PAVEMENT


STATION: 759+07

HORZ.DATUM:


GEOID:

GRID: NORTHING:

EASTING:

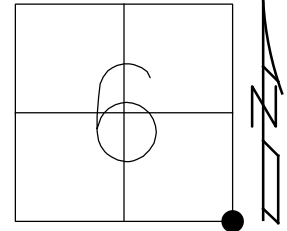

RECORD:
MONBOX
W/ 1" IPIN
4/27/79

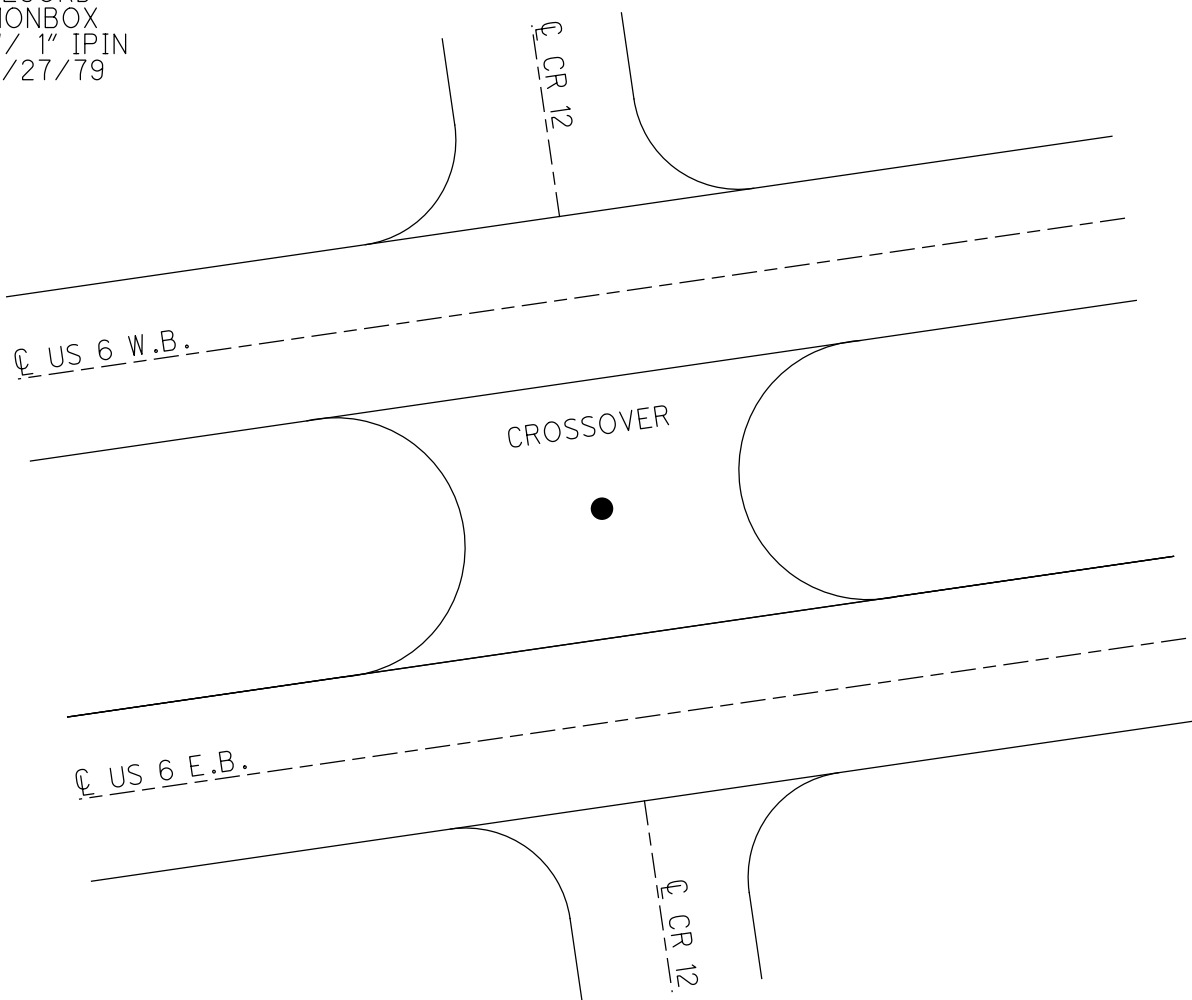

O.D.O.T. DISTRICT 2 SURVEY OFFICE (USE ONLY)

PERSONNEL

REFERENCE NO. 40

SHEET 45 OF 7

NOTES BURNSIDE

DATE 4/26/79

ROUTE US 6

H.C. SMITH

WEATHER CLOUDY

COUNTY HENRY

R.C. BOWERS

TEMP. 60°

TOWNSHIP LIBERTY

SECTION 5

DWG BY NIESE PID

T 6 N R 7 E

TYPE MONUMENT CMON W/ 1/4" IPIN

ON SURFACE - ~~BELOW~~ ON


OFFSET ☉ PAVEMENT ON LT : RT

- TO - EDGE PAVEMENT

STATION: 763+59.01

HORIZ.DATUM: GEOID:

GRID: NORTHING: EASTING:

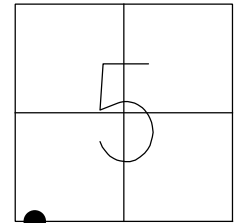

RECORD: P.C.
STA 763+57.53
FD CMON
W/ 1/4" IPIN
4/26/79

☉ US 6 W.B.

☉ US 6 E.B.

O.D.O.T. DISTRICT 2 SURVEY OFFICE (USE ONLY)

PERSONNEL

REFERENCE NO. 41

SHEET 46 OF 47

NOTES BURNSIDE

DATE 4/26/79

ROUTE US 6

H.C. SMITH

WEATHER CLOUDY

COUNTY HENRY

R.C. BOWERS

TEMP. 60°

TOWNSHIP LIBERTY

DWG BY NIESE

PID _____

SECTION 5

T 6 N R 7 E

TYPE MONUMENT CMON W/ 1/4" IPIN

ON SURFACE - ~~BELOW~~ ON

OFFSET Q PAVEMENT ON LT : RT

- TO - EDGE PAVEMENT


STATION: 786+10.80

HORIZ.DATUM: _____

GEOID: _____

GRID: NORTHING: _____


EASTING: _____

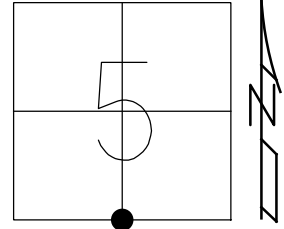

RECORD: P.O.C.
STA 786+10.80
FD CMON
W/ 1/4" IPIN
4/26/79

Q US 6 W.B.

"+" IN CORNER
CONC CB

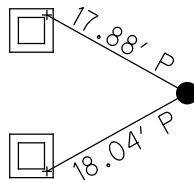

Q US 6 E.B.

O.D.O.T. DISTRICT 2 SURVEY OFFICE (USE ONLY)

PERSONNEL

REFERENCE NO. 42

SHEET 47 OF 47

NOTES HARBAUGH

DATE 8/10/11

ROUTE US 6

H.C. LUMBREZER

WEATHER FAIR

COUNTY HENRY

R.C.

TEMP. 75°

TOWNSHIP HARRISON

SECTION 9

DWG BY NIESE PID 25529

T 5 N R 7 E

TYPE MONUMENT MONBOX

~~ON SURFACE~~ - BELOW ON

OFFSET 1.6' ~~LT~~ : RT

13.5' TO LT EDGE PAVEMENT



STATION: 884+31

HORZ.DATUM:

GEOID:

GRID: NORTHING: 637881.318

EASTING: 1541352.708

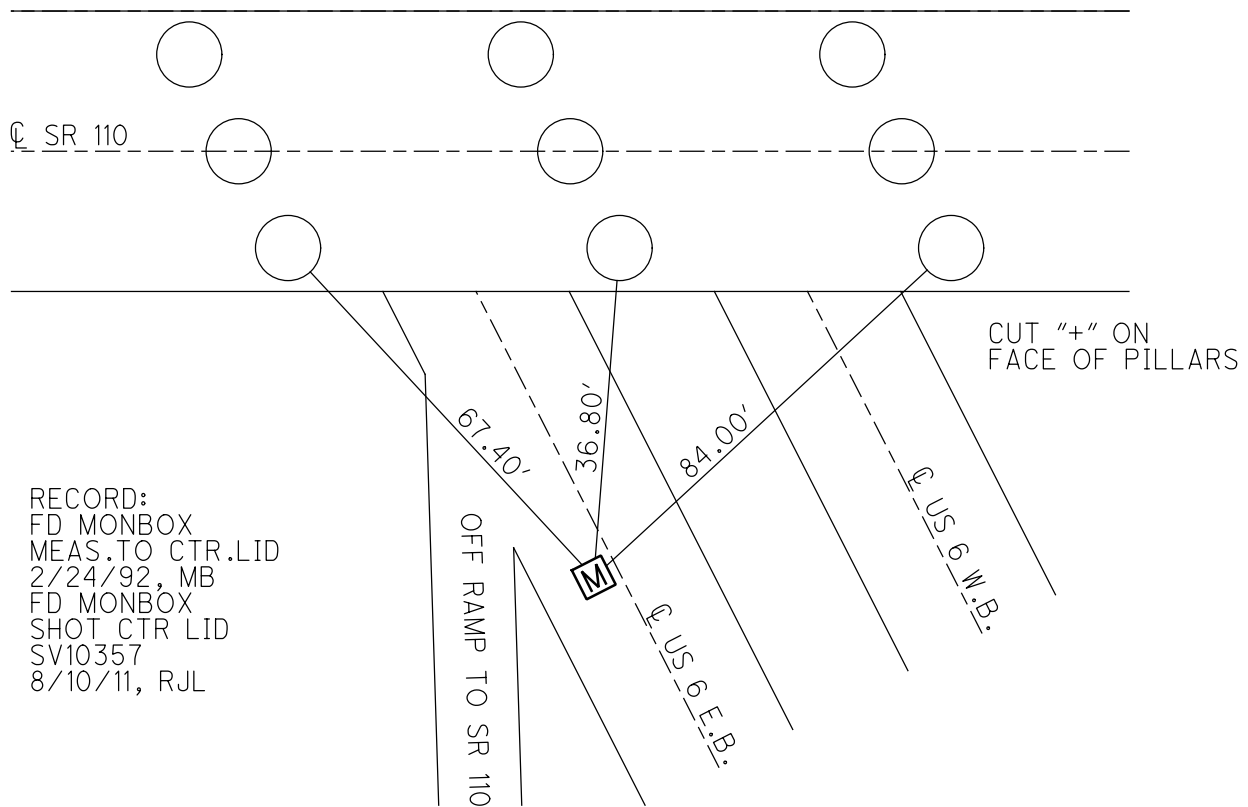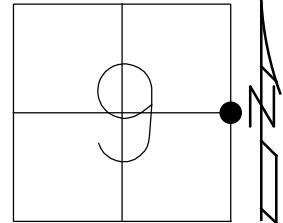

O.D.O.T. DISTRICT 2 SURVEY OFFICE (USE ONLY)

PERSONNEL _____ REFERENCE NO. 42 A SHEET 1 OF 24
NOTES HOMAN DATE 3/23/16 ROUTE US 6
H.C. HOMAN WEATHER FAIR COUNTY HENRY
R.C. LEU TEMP. 55° TOWNSHIP HARRISON
SECTION 22
T 5 N R 7 E

TYPE MONUMENT 1" IPIPE


~~ON SURFACE~~ - BELOW 1.5'

LEFT - C PAV'T - ~~RIGHT~~ 42' LT


- TO - EDGE PAVEMENT

S.L.M. 923+95.38

Grid: Northing: 634226.6716 Easting: 1542736.362

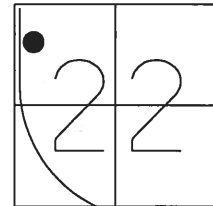

RECORD: P.T.
FD 1" IPIPE
GOOD COND
3-16

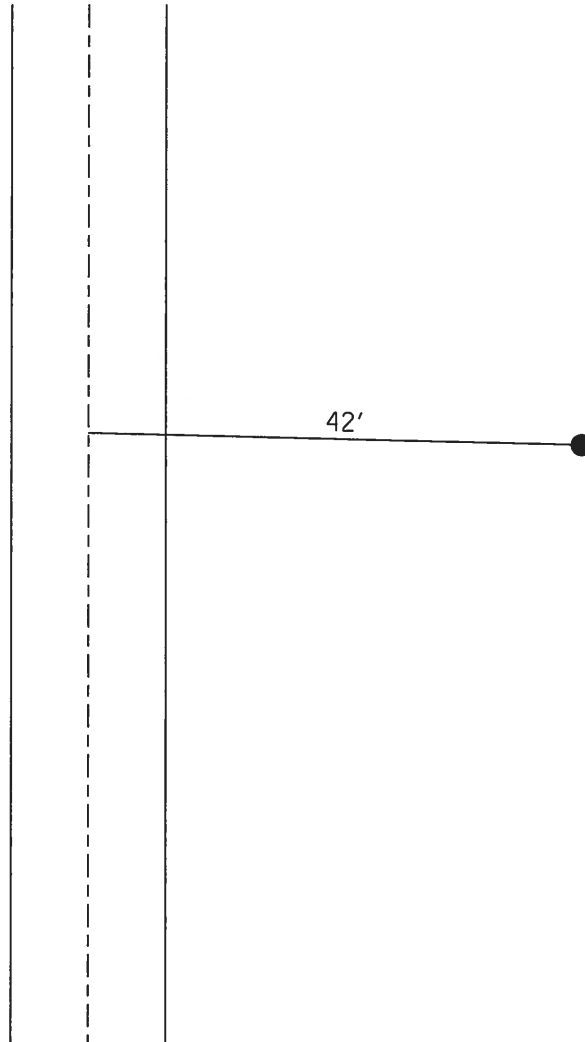

O.D.O.T. DISTRICT 2 SURVEY OFFICE (USE ONLY)

PERSONNEL

REFERENCE NO. 42 B SHEET 2 OF 24

NOTES HOMAN
H.C. HOMAN
R.C. LEU

DATE 3/23/16
WEATHER FAIR
TEMP. 55°

ROUTE US 6
COUNTY HENRY
TOWNSHIP HARRISON
SECTION 22
T 5 N R 7 E

TYPE MONUMENT 1" IPIPE


~~ON SURFACE~~ - BELOW 0.6'

LEFT - C PAV'T - ~~RIGHT~~ 42'


30.5' TO LT EDGE PAVEMENT

S.L.M. 998+20.68

Grid: Northing: 626803.4451 Easting: 1542560.89

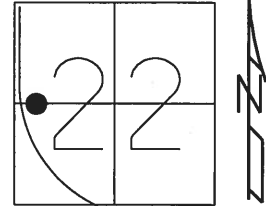

RECORD: T.S.
FD 1" IPIPE
GOOD COND
3-16

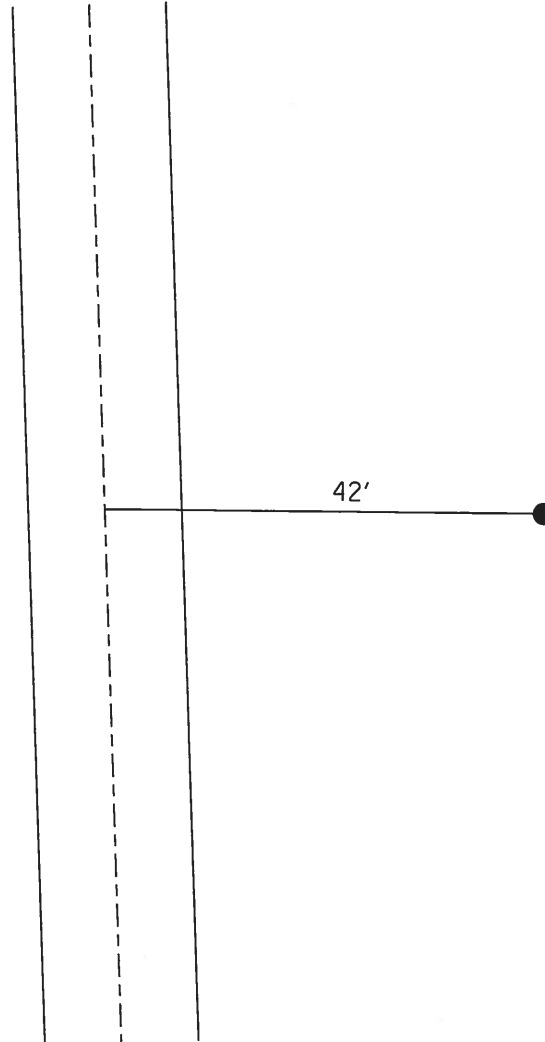

O.D.O.T. DISTRICT 2 SURVEY OFFICE (USE ONLY)

PERSONNEL

REFERENCE NO.

42 C

SHEET

3

OF 24

NOTES

HOMAN

DATE

3/23/16

ROUTE

US 6

H.C.

HOMAN

WEATHER

FAIR

COUNTY

HENRY

R.C.

LEU

TEMP.

55°

TOWNSHIP

HARRISON

SECTION

22

T 5 N R 7 E

TYPE MONUMENT

1" IPIPE

~~ON SURFACE~~ - BELOW

0.6'


LEFT - ℄ PAV'T - ~~RIGHT~~

41.88'


27.98' TO LT EDGE PAVEMENT

S.L.M. 1002+24.95

Grid: Northing: 626403.8274 Easting: 1542565.253

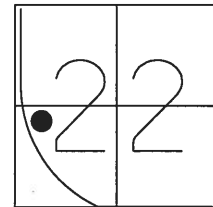


RECORD: S.C.
FD 1" IPIPE
GOOD COND
3-16

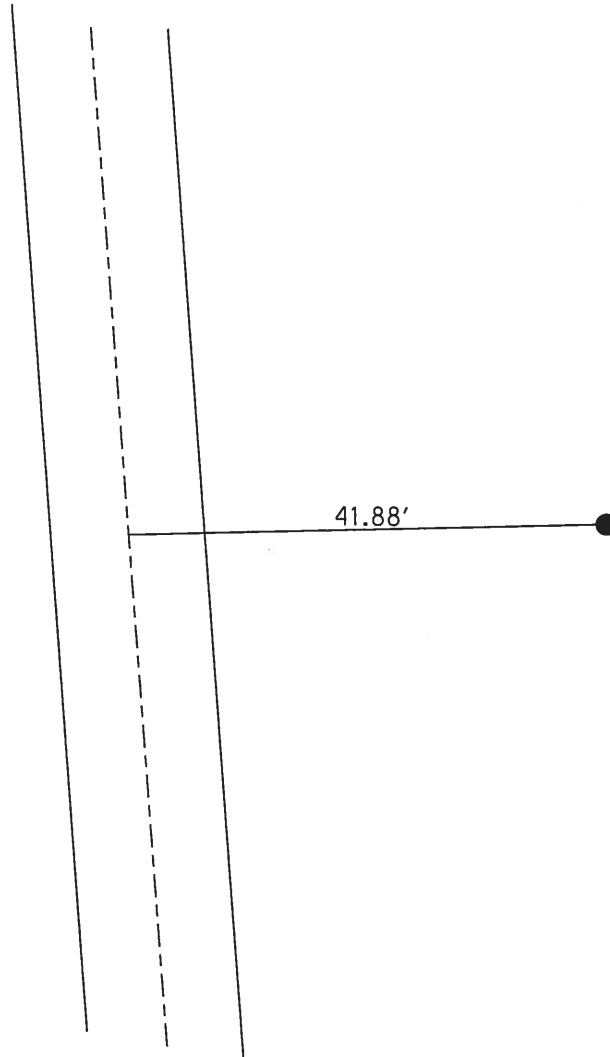

PERSONNEL	TITLE	PERSONNEL	TITLE	COUNTY	DATE
BURNSIDE		BAGDONAS		HENRY	6-21-73
SMITH				S. R. U.S. 6	WEATHER CLEAR
BOWERS				SEC.	TEMP. +80
KIOWSKI					

DESCRIPTION 1/4 Post Sec. 22 HARRISON Twp JOB NO. _____

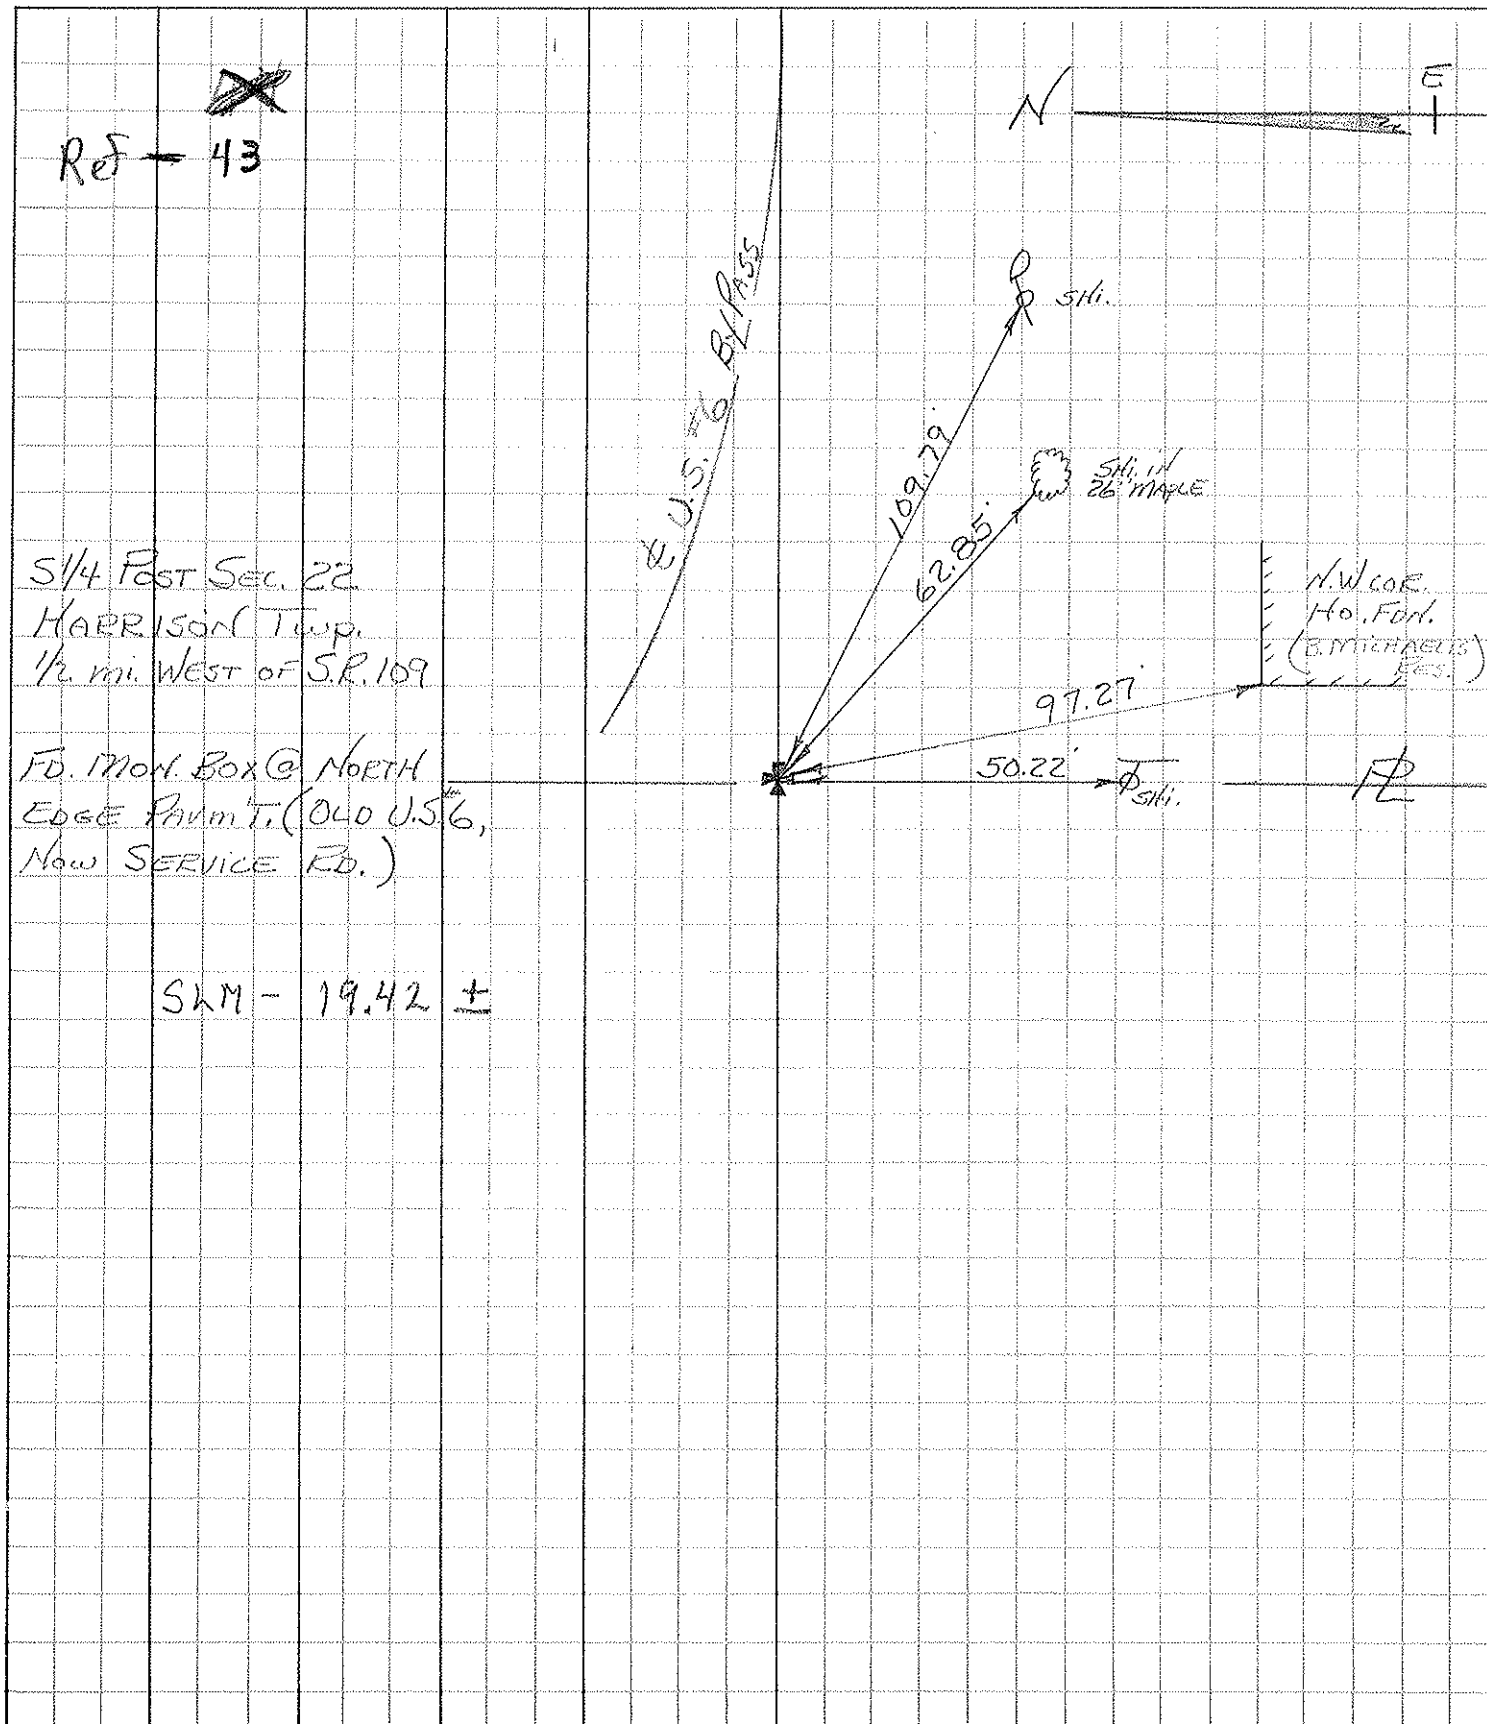


O.D.O.T. DISTRICT 2 SURVEY OFFICE (USE ONLY)


PERSONNEL _____ REFERENCE NO. 44 SHEET 4 OF 24
NOTES HOMAN DATE 3/23/16 ROUTE US 6
H.C. HOMAN WEATHER FAIR COUNTY HENRY
R.C. LEU TEMP. 55° TOWNSHIP HARRISON
SECTION 22
T 5 N R 7 E

TYPE MONUMENT _____ 1' IPIPE
~~ON SURFACE~~ - BELOW _____ 0.33'
LEFT - Q PAV'T - ~~RIGHT~~ _____ 41.96'
29.53' TO LT EDGE PAVEMENT
S.L.M. 1028+99.48

Grid: Northing: 624662.134 Easting: 1544241.183

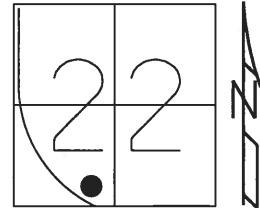

RECORD: C.S.
FD 1" IPIPE
GOOD COND
3-16

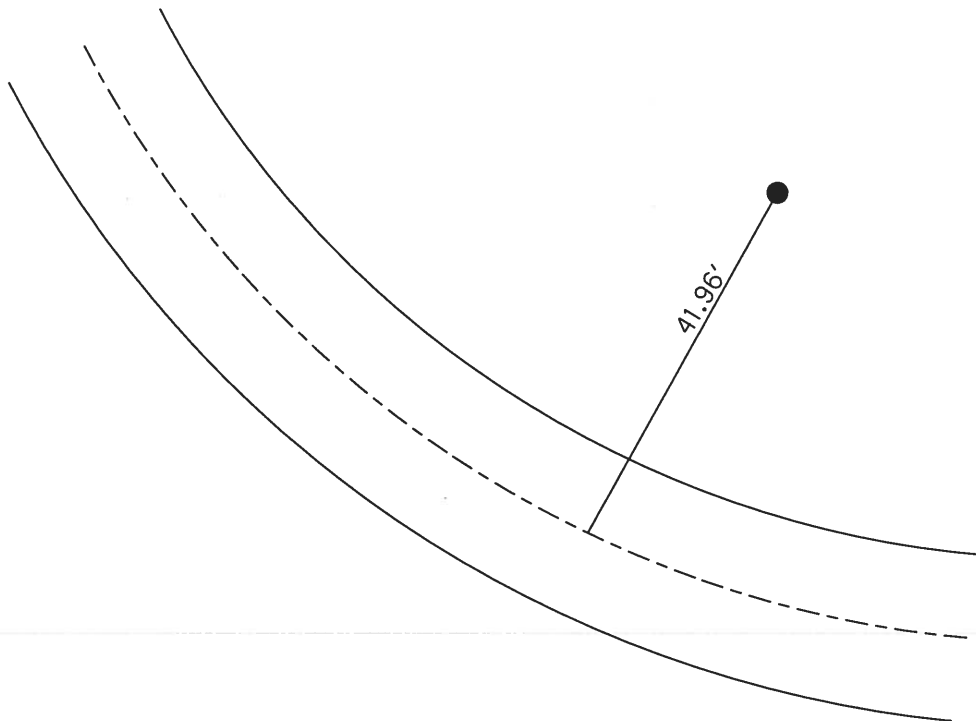

O.D.O.T. DISTRICT 2 SURVEY OFFICE (USE ONLY)

PERSONNEL _____ REFERENCE NO. 44 A SHEET 5 OF 24
NOTES HOMAN DATE 3/23/16 ROUTE US 6
H.C. HOMAN WEATHER FAIR COUNTY HENRY
R.C. LEU TEMP. 55° TOWNSHIP HARRISON
SECTION 22
T 5 N R 7 E

TYPE MONUMENT 1" IPIPE


~~ON SURFACE~~ - BELOW 0.5'

LEFT - ℄ PAV'T - ~~RIGHT~~ 41.94'


30.8' TO LT EDGE PAVEMENT

S.L.M. 1033+03.91

Grid: Northing: 624642.2876 Easting: 1544640.474

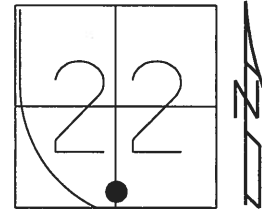


RECORD: S.T.
FD 1" IPIPE
GOOD COND
3-16

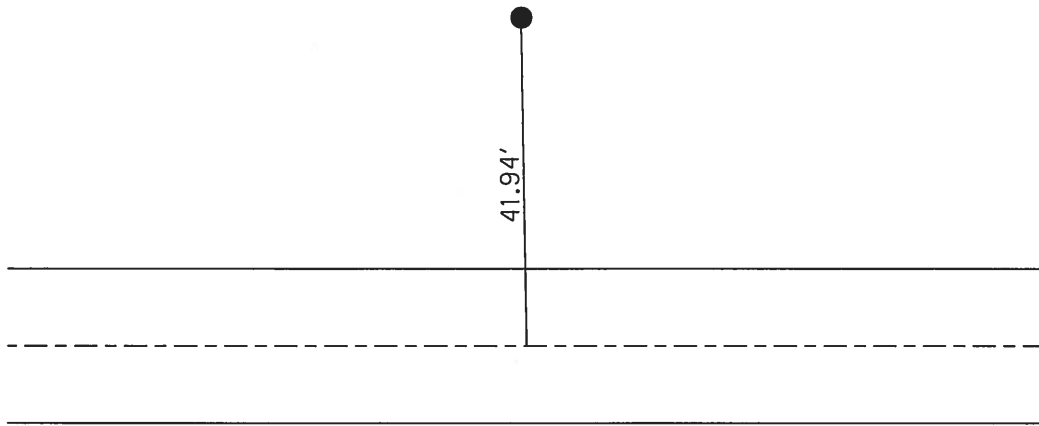

O.D.O.T. DISTRICT 2 SURVEY OFFICE (USE ONLY)


PERSONNEL	REFERENCE NO. <u>45</u>	SHEET <u>6</u> OF <u>24</u>
NOTES	DATE <u>4/24/17</u>	ROUTE <u>US 6</u>
H.C. <u>RHOADES</u>	WEATHER <u>SUNNY</u>	COUNTY <u>HENRY</u>
R.C. <u>LEU</u>	TEMP. <u>55°</u>	TOWNSHIP <u>HARRISON</u>
		SECTION <u>26</u>
		T <u>5</u> N R <u>7</u> E

TYPE MONUMENT SM.R.R.SPIKE
~~ON SURFACE~~ - BELOW 4"
 LEFT - ℄ PAV'T - ~~RIGHT~~ 0.7'
 - TO - EDGE PAVEMENT
 S.L.M. 1049+75.72

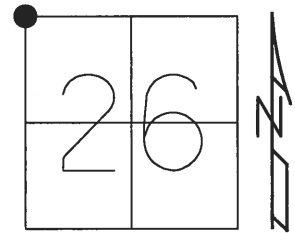

GRID: NORTHING: 624575.8611 EASTING: 1546311.491

RECORD:
 SET SM.R.R.SPIKE
 6-20-88, SWH
 SET MAG/WASHER
 4/21/03, DCH
 FD MAG/WASHER
 REF45
 4-24-17, JLL
 SET MAG/WASHER
 10/26/17, JLL

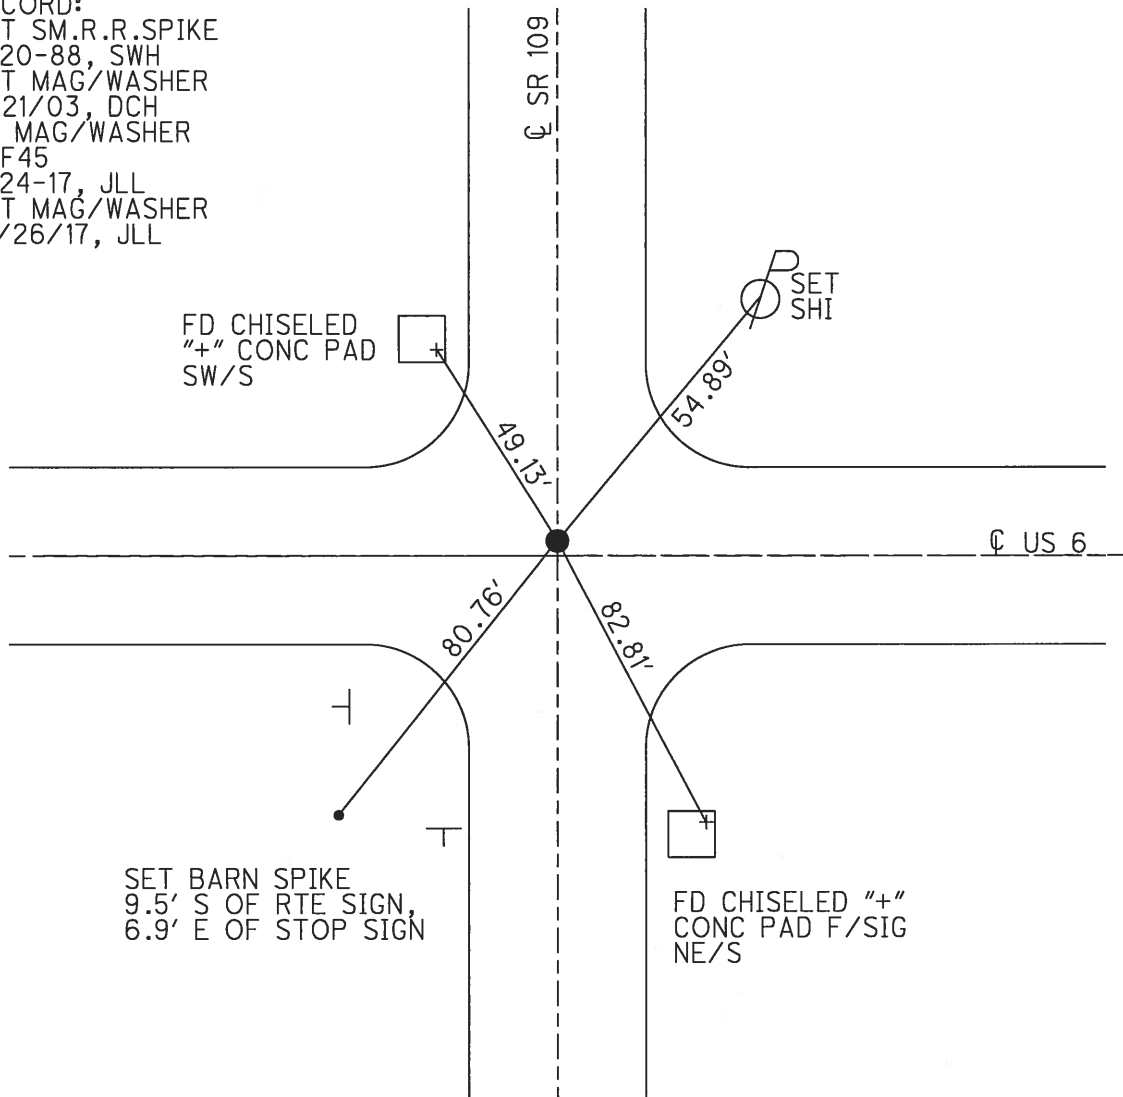

O.D.O.T. DISTRICT 2 SURVEY OFFICE (USE ONLY)

PERSONNEL

REFERENCE NO. 45 A SHEET 7 OF 24

NOTES RHOADES

DATE 4/24/17

ROUTE US 6

H.C. LEU

WEATHER SUNNY

COUNTY HENRY

R.C. HELDMAN

TEMP. 55°

TOWNSHIP HARRISON

SECTION 26

T 5 N R 7 E

TYPE MONUMENT MAG/WASHER


ON SURFACE - ~~BELOW~~ ON

LEFT - CL PAV'T - ~~RIGHT~~ 2.5'


9.2' TO LT EDGE PAVEMENT

S.L.M. 1076+25.31

GRID: NORTHING: 624542.7092 EASTING: 1548960.868

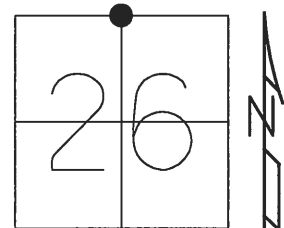

RECORD:
SET MAG/WASHER
4/21/03, DCH
FD MAG/WASHER
REFA45
4-24-17, JLL
SET MAG/WASHER
10/26/17, JLL

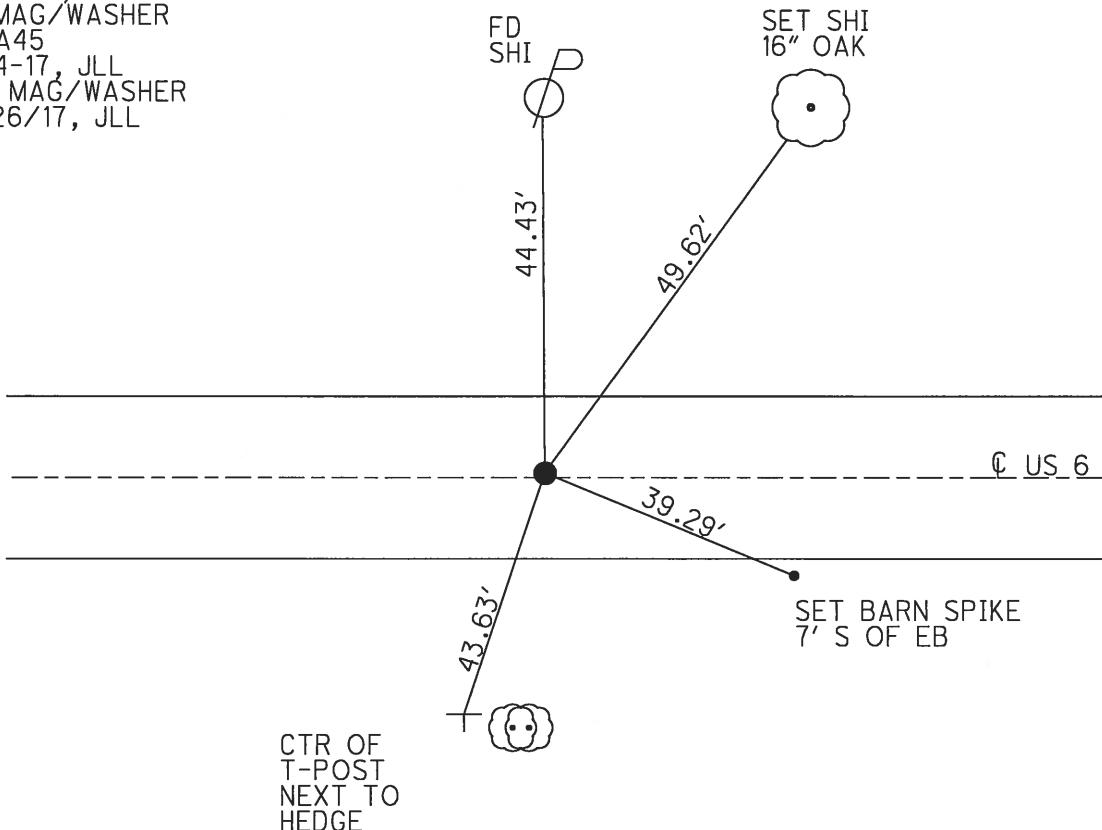

O.D.O.T. DISTRICT 2 SURVEY OFFICE (USE ONLY)

PERSONNEL _____ REFERENCE NO. 46 SHEET 8 OF 24

NOTES _____ DATE 4/24/17 ROUTE US 6

H.C. RHOADES WEATHER SUNNY COUNTY HENRY

R.C. LEU TEMP. 55° TOWNSHIP HARRISON

SECTION 26

T 5 N R 7 E


TYPE MONUMENT MAG/WASHER

ON SURFACE - ~~BELOW~~ ON

LEFT - ℄ PAV'T - ~~RIGHT~~ 4.7'


- TO - EDGE PAVEMENT

S.L.M. 1102+50.73

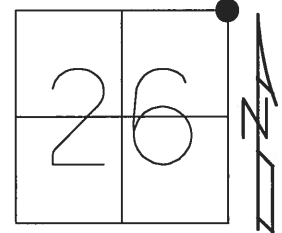

GRID: NORTHING: 624506.1951 EASTING: 1551586.042

RECORD:
 SET SM.R.R.SPIKE
 6-20-88, SWH
 SET MAG/WASHER
 4/21/03, DCH
 FD MAG NAIL
 REF46
 4-25-17, JLL
 SET MAG/WASHER
 10/26/17, JLL

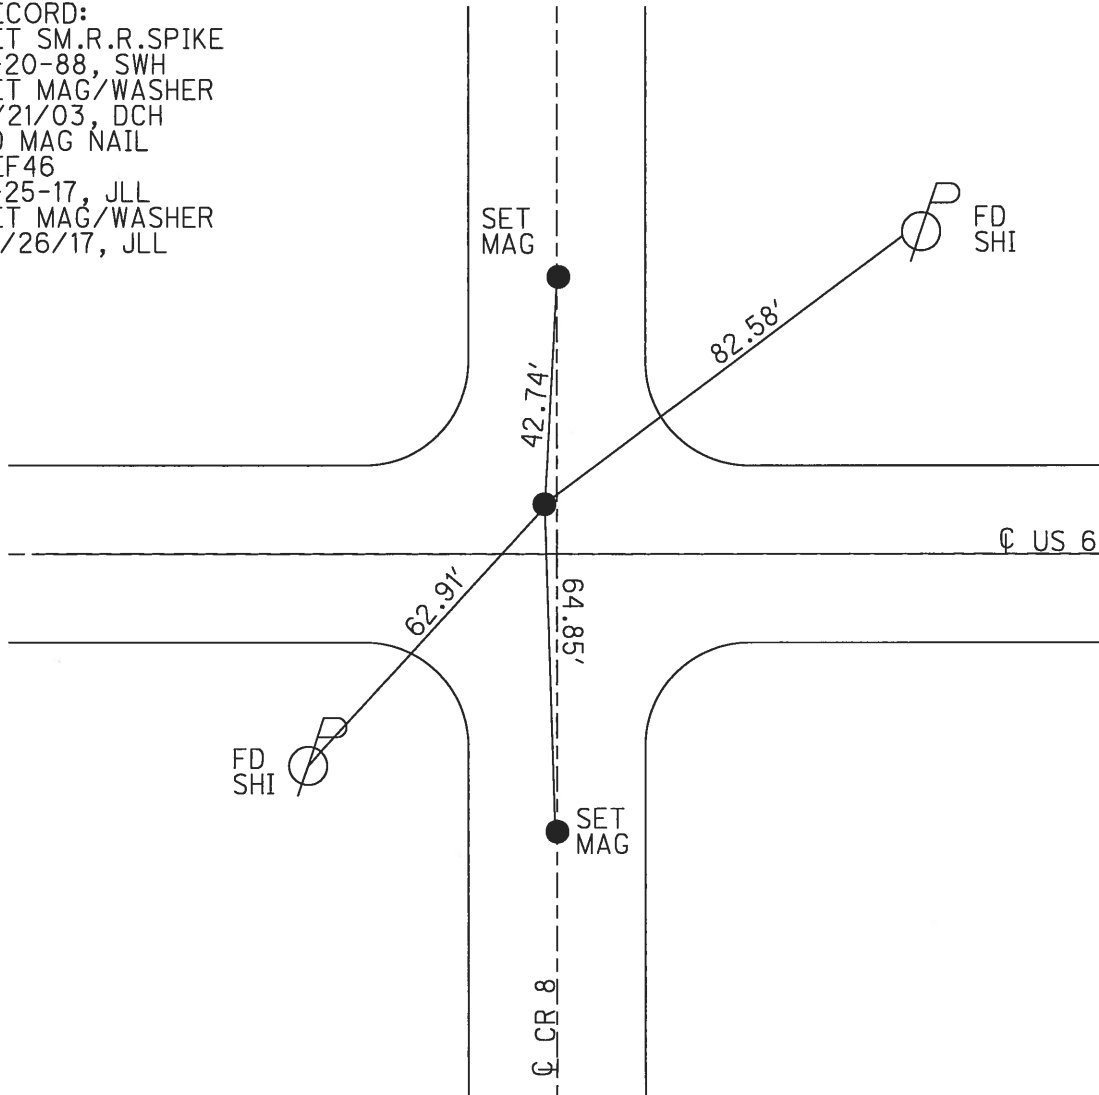

O.D.O.T. DISTRICT 2 SURVEY OFFICE (USE ONLY)

PERSONNEL _____ REFERENCE NO. 47 SHEET 9 OF 24
 NOTES RHOADES DATE 4/24/17 ROUTE US 6
 H.C. LEU WEATHER SUNNY COUNTY HENRY
 R.C. HELDMAN TEMP. 55° TOWNSHIP HARRISON
 _____ SECTION 25
 _____ T 5 N R 7 E

TYPE MONUMENT MAG/WASHER


ON SURFACE - ~~BELOW~~ ON

~~LEFT~~ - CL PAV'T - RIGHT 0.5'


12' TO RT EDGE PAVEMENT

S.L.M. 1129+11.71

GRID: NORTHING: 624461.4353 EASTING: 1554246.626

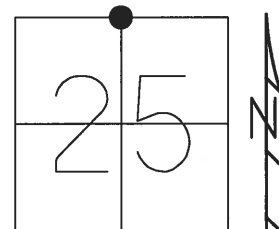

RECORD:
 SET MAG/WASHER
 9-20-02, DCH
 FD MAG NAIL
 REF47
 4-24-17, JLL
 SET MAG/WASHER
 10/26/17, JLL

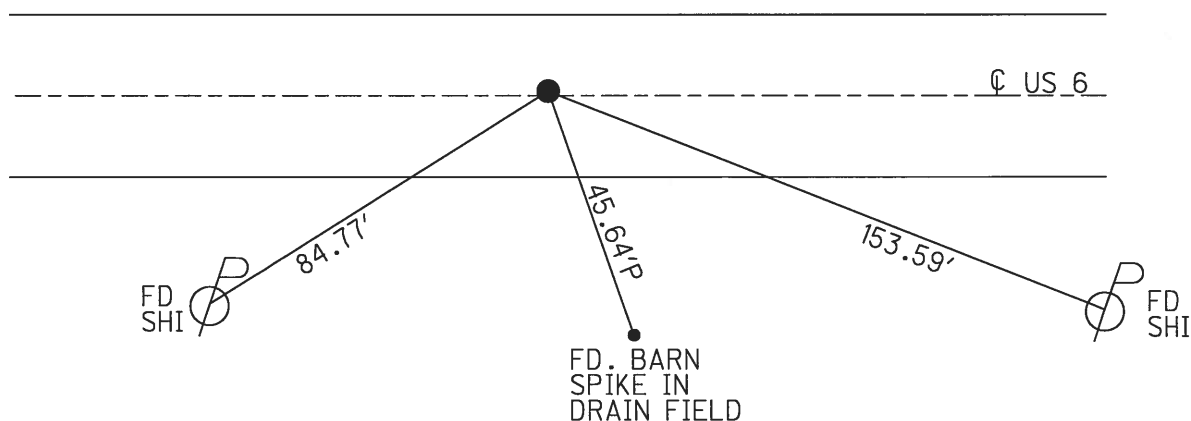


O.D.O.T. DISTRICT 2 SURVEY OFFICE (USE ONLY)


PERSONNEL _____ REFERENCE NO. 48 SHEET 10 OF 24
 NOTES _____ DATE 4/20/17 ROUTE US 6
 H.C. LEU WEATHER WINDY COUNTY HENRY
 R.C. HELDMAN TEMP. 80° TOWNSHIP HARRISON
 _____ SECTION 25
 _____ T 5 N R 7 E

TYPE MONUMENT _____ MAG/WASHER
 ON SURFACE - ~~BELOW~~ ON _____
~~LEFT~~ - Q PAV'T - RIGHT 0.3'
 - TO - EDGE PAVEMENT
 S.L.M. 1155+79.26

GRID: NORTHING: 624442.6588 EASTING: 1556914.101

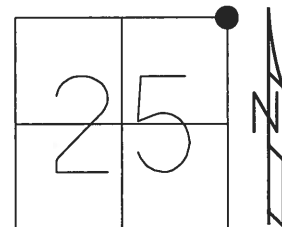

RECORD:
 SET SM.R.R.SPIKE
 6/20/88, SWH
 SET MAG/WASHER
 4/21/03, DCH
 FD MAG NAIL
 REF48
 4-20-17, JLL
 SET MAG/WASHER
 10/26/17, JFO

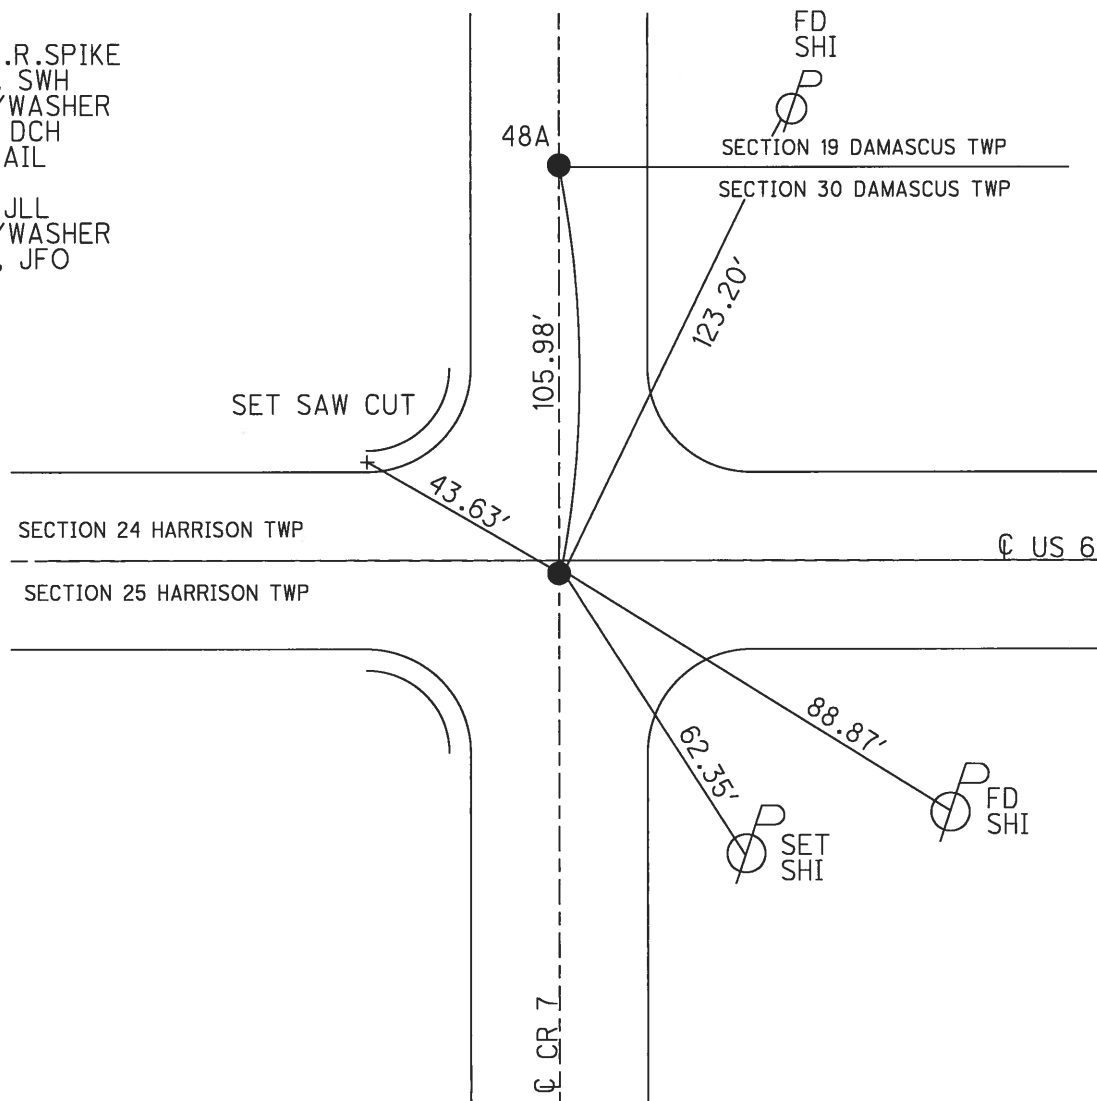

O.D.O.T. DISTRICT 2 SURVEY OFFICE (USE ONLY)

PERSONNEL

REFERENCE NO. 48 A

SHEET 11 OF 24

NOTES

LEU

DATE

4/20/17

ROUTE

US 6

H.C.

LEU

WEATHER

WINDY

COUNTY

HENRY

R.C.

HELDMAN

TEMP.

80°

TOWNSHIP

HARRISON

SECTION

25

T 5 N R 7 E

TYPE MONUMENT

SM.R.R.SPIKE

ON SURFACE - ~~BELOW~~

ON

~~LEFT~~ - Q PAV'T - RIGHT

1.5'

10.3'

TORT

EDGE PAVEMENT

S.L.M.


1155+80

GRID: NORTHING:

624548.594

EASTING:

1556916.213

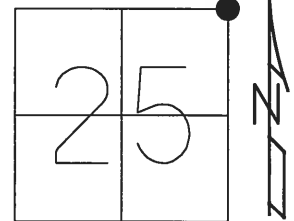


RECORD:

FD SM.R.R.SPIKE

REFA48

4-20-17, JLL

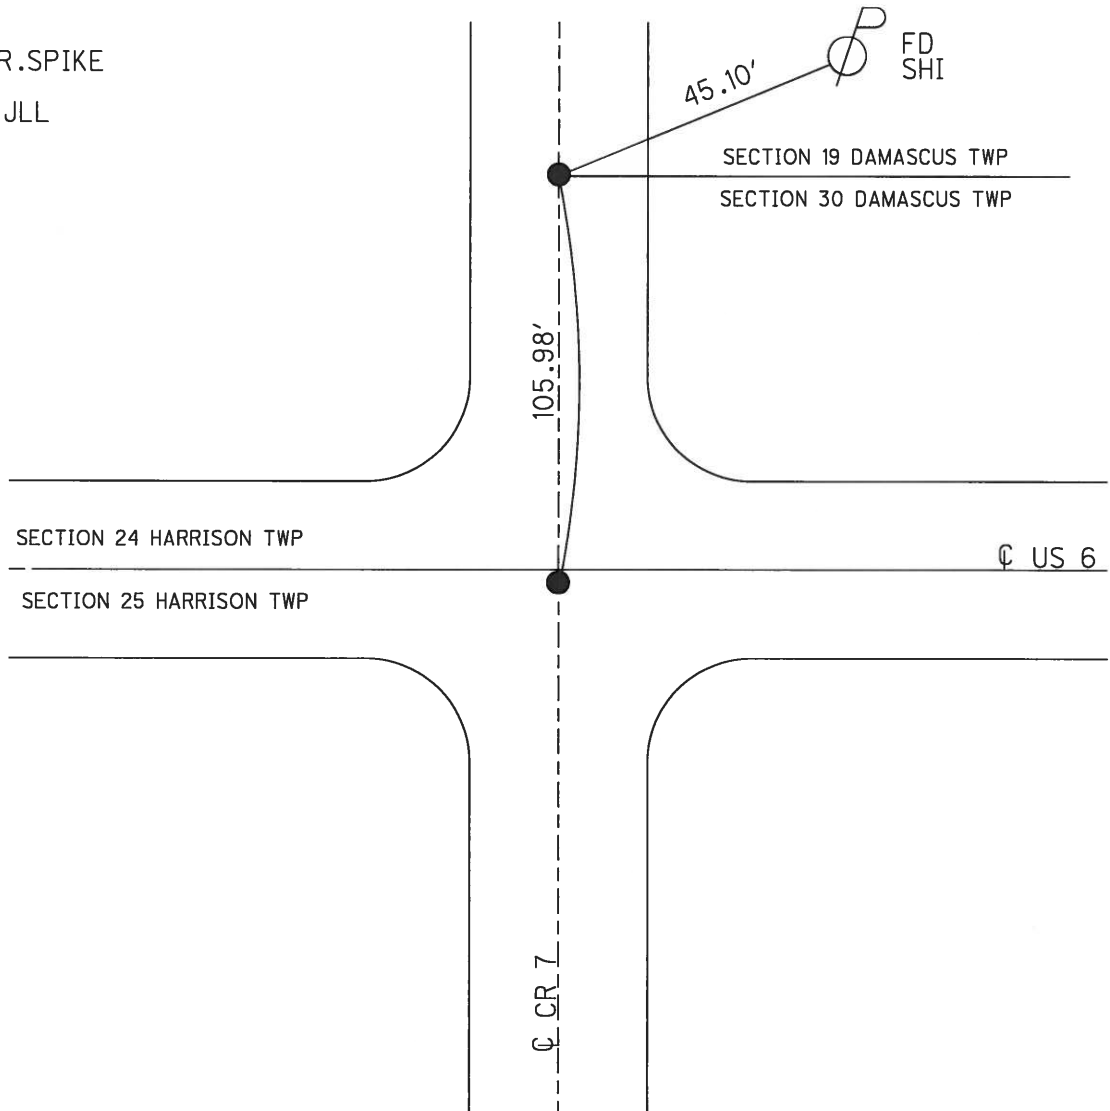

O.D.O.T. DISTRICT 2 SURVEY OFFICE (USE ONLY)

PERSONNEL

REFERENCE NO.

49

SHEET

12

OF 24

NOTES

LEU

DATE

4/20/17

ROUTE

US 6

H.C.

LEU

WEATHER

WINDY

COUNTY

HENRY

R.C.

HELDMAN

TEMP.

80°

TOWNSHIP

DAMASCUS

SECTION

30

T 5 N R 8 E

TYPE MONUMENT MAG/WASHER


ON SURFACE - ~~BELOW~~ ON

~~LEFT~~ - C PAV'T - RIGHT 0.8', 3.8' W OF C S


- TO - EDGE PAVEMENT

S.L.M. 1182+75.53

GRID: NORTHING: 624502.6765 EASTING: 1559607.544

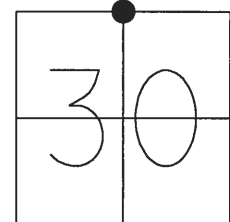


RECORD:
SET MAG/WASHER
4-21-03, DCH
FD MAG NAIL
REF49
4-20-17, JLL
SET MAG/WASHER
10/26/17, JLL

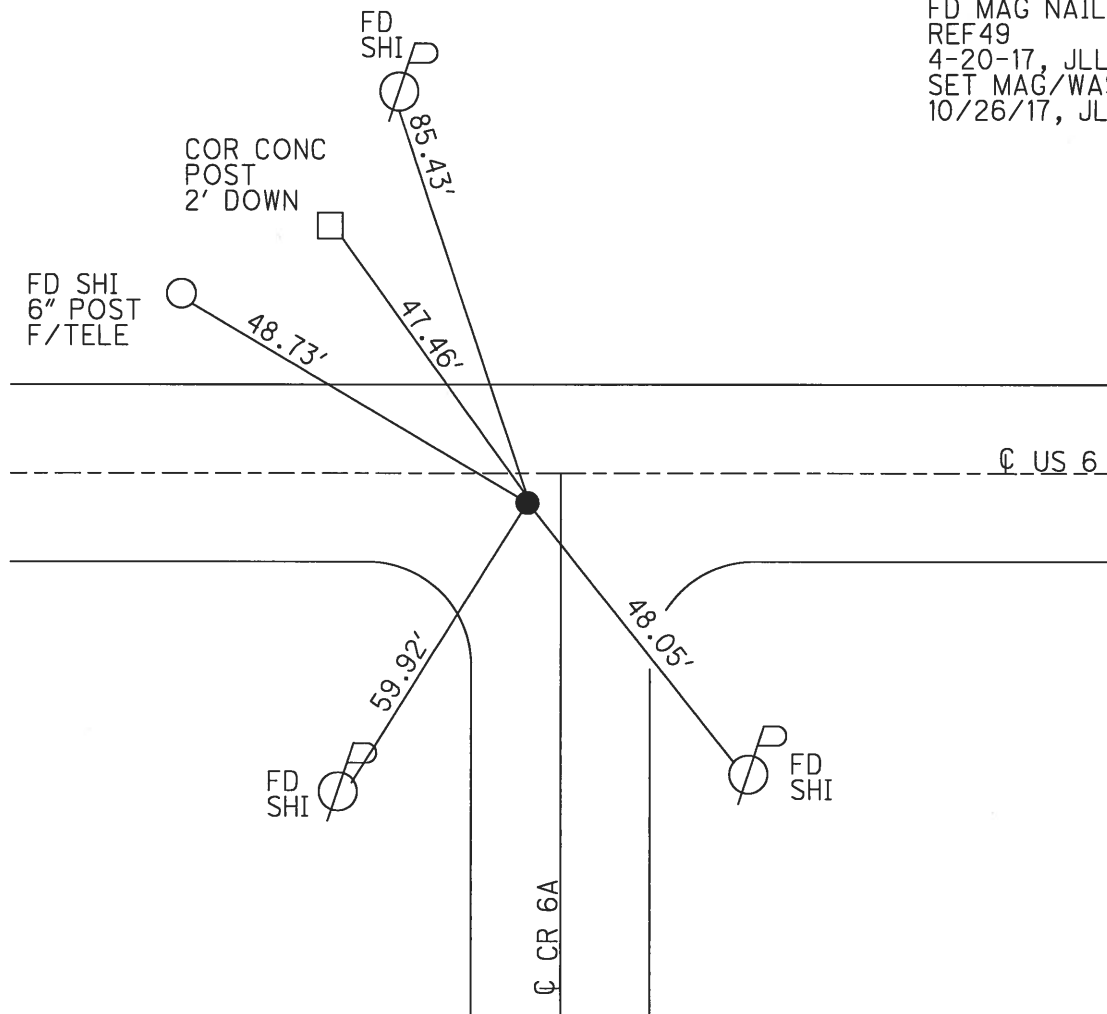

O.D.O.T. DISTRICT 2 SURVEY OFFICE (USE ONLY)


PERSONNEL	REFERENCE NO. <u>50</u>	SHEET <u>13</u> OF <u>24</u>
NOTES <u>LEU</u>	DATE <u>4/20/17</u>	ROUTE <u>US 6</u>
H.C. <u>LEU</u>	WEATHER <u>WINDY</u>	COUNTY <u>HENRY</u>
R.C. <u>HELDMAN</u>	TEMP. <u>79°</u>	TOWNSHIP <u>DAMASCUS</u>
		SECTION <u>30</u>
		T <u>5</u> N R <u>8</u> E

TYPE MONUMENT MAG/WASHER
 ON SURFACE - ~~BELOW~~ ON
~~LEFT~~ - CL PAV'T - RIGHT 1.1'
12.5' TO LT EDGE PAVEMENT
 S.L.M. 1209+33.35

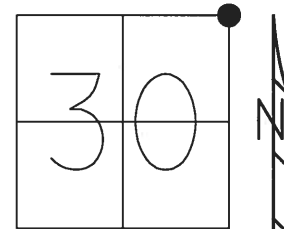

GRID: NORTHING: 624460.5264 EASTING: 1562265.026

RECORD:
 SET MAG/ WASHER
 4-21-03, DCH
 FD MAG NAIL
 REF50
 4-20-17, JLL
 SET MAG/WASHER
 10/26/17, JLL

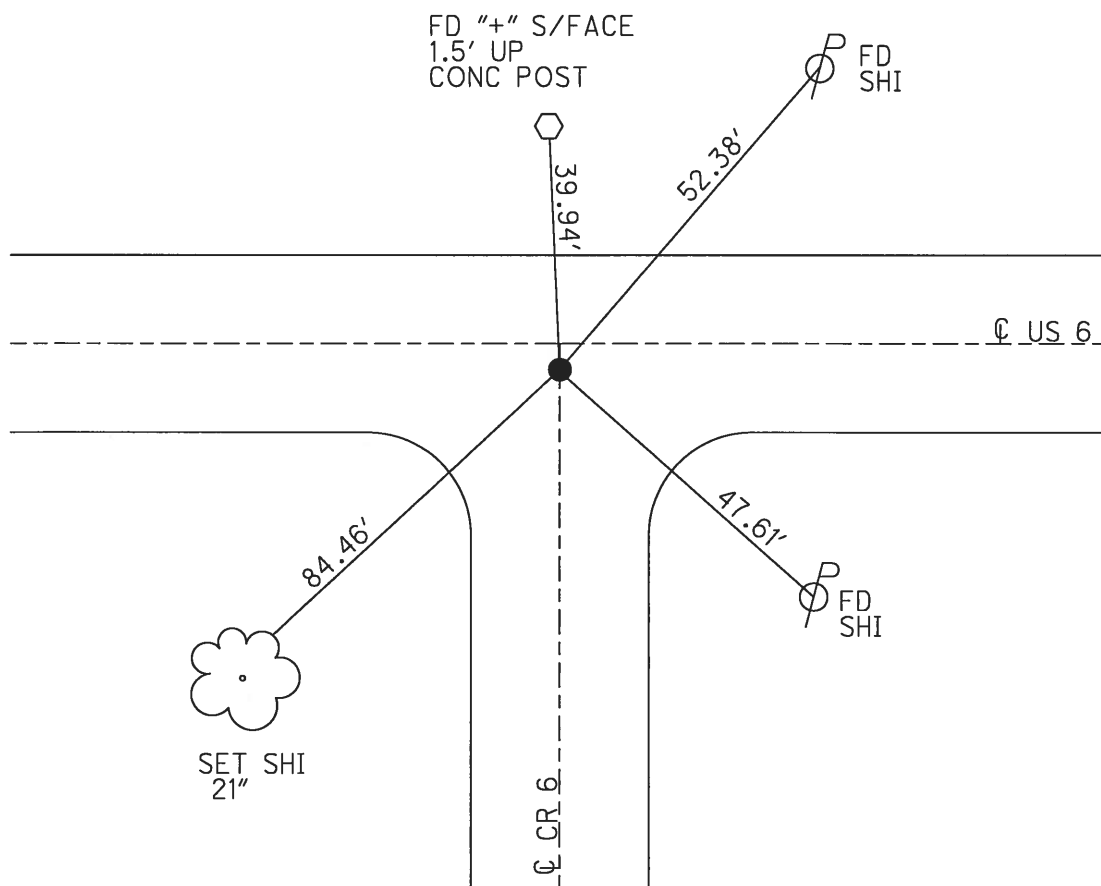


O.D.O.T. DISTRICT 2 SURVEY OFFICE (USE ONLY)


PERSONNEL _____ REFERENCE NO. 51 SHEET 14 OF 24
 NOTES LEU DATE 4/20/17 ROUTE US 6
 H.C. LEU WEATHER PARTLY CLOUDY COUNTY HENRY
 R.C. HELDMAN TEMP. 79° TOWNSHIP DAMASCUS
 SECTION 29
 T 5 N R 8 E

TYPE MONUMENT SM.R.R.SPIKE
 ON SURFACE - ~~BELOW~~ ON
~~LEFT~~ - ℄ PAV'T - RIGHT 0.5'
- TO - EDGE PAVEMENT
 S.L.M. 1235+83.82

Grid: Northing: 624433.0849 Easting: 1564915.356

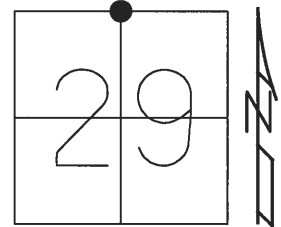

RECORD:
 SET SM.R.R.SPIKE
 6/20/88, SWH
 SET MAG/WASHER
 4/21/03, DCH
 FD MAG NAIL
 REF51
 4-20-17, JLL
 SET MAG/WASHER
 10/30/17, JLL

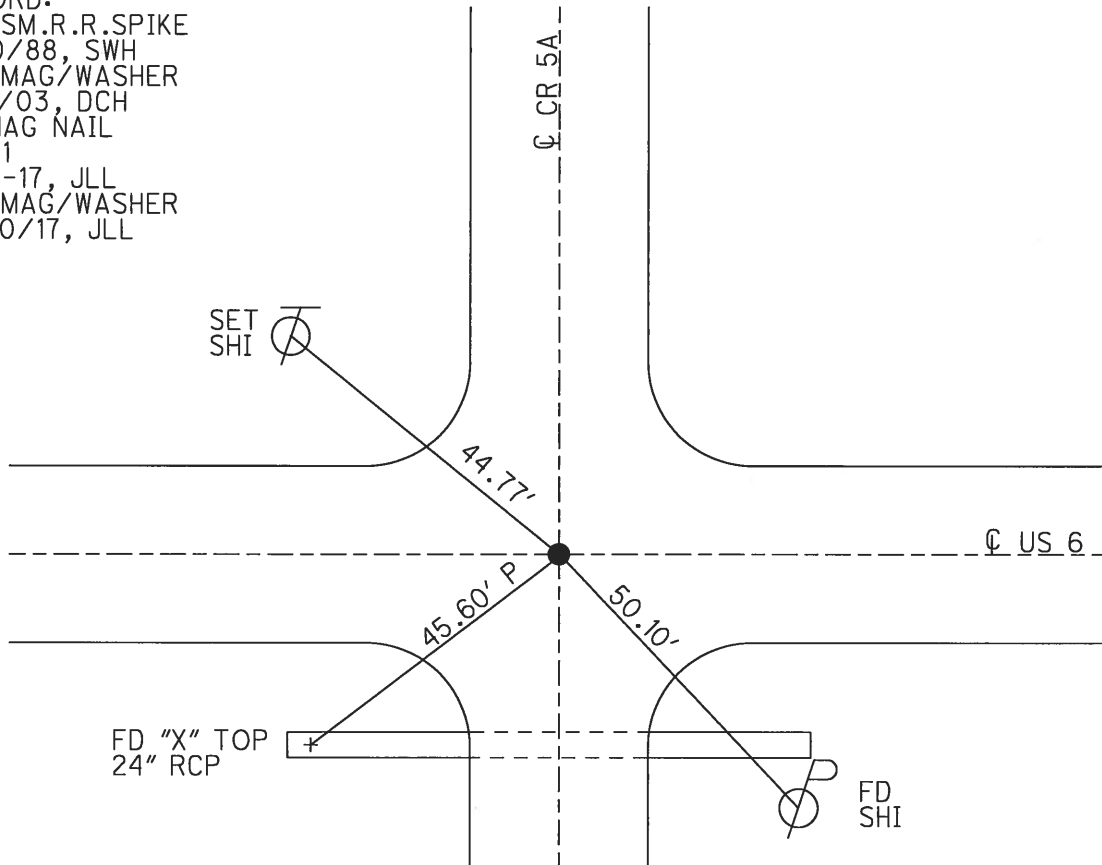


NOTES:
 SET R.R.SPIKE, USING 1' OFFSETS,
 OVER BRASS MON. GPS COORDINATE
 WAS SHOT ON BRASS MON. 11/4/15
 N= 624433.062
 E= 1564915.350
 ELEV= 697.384
 HENRY CO. ENGR.
 JUSTIN NIESE


O.D.O.T. DISTRICT 2 SURVEY OFFICE (USE ONLY)

PERSONNEL	REFERENCE NO. <u>52</u>	SHEET <u>15</u> OF <u>24</u>
NOTES	DATE <u>4/20/17</u>	ROUTE <u>US 6</u>
H.C. <u>LEU</u>	WEATHER <u>PARTLY CLOUDY</u>	COUNTY <u>HENRY</u>
R.C. <u>HELDMAN</u>	TEMP. <u>79°</u>	TOWNSHIP <u>DAMASCUS</u>
		SECTION <u>29</u>
		T <u>5</u> N R <u>8</u> E

TYPE MONUMENT MAG/WASHER
 ON SURFACE - ~~BELOW~~ ON
~~LEFT~~ - CL PAV'T - ~~RIGHT~~ ON
11.6' TO LT EDGE PAVEMENT
 S.L.M. 1262+36.60
 GRID: NORTHING: 624413.1485 EASTING: 1567568.058

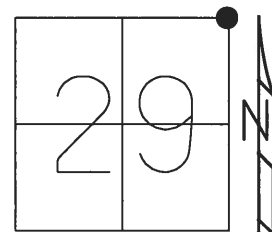


RECORD:
 SET MAG/ WASHER
 4-21-03, DCH
 FD MAG NAIL
 REF52
 4/20/17, JLL
 SET MAG/WASHER
 10-26-17, JLL

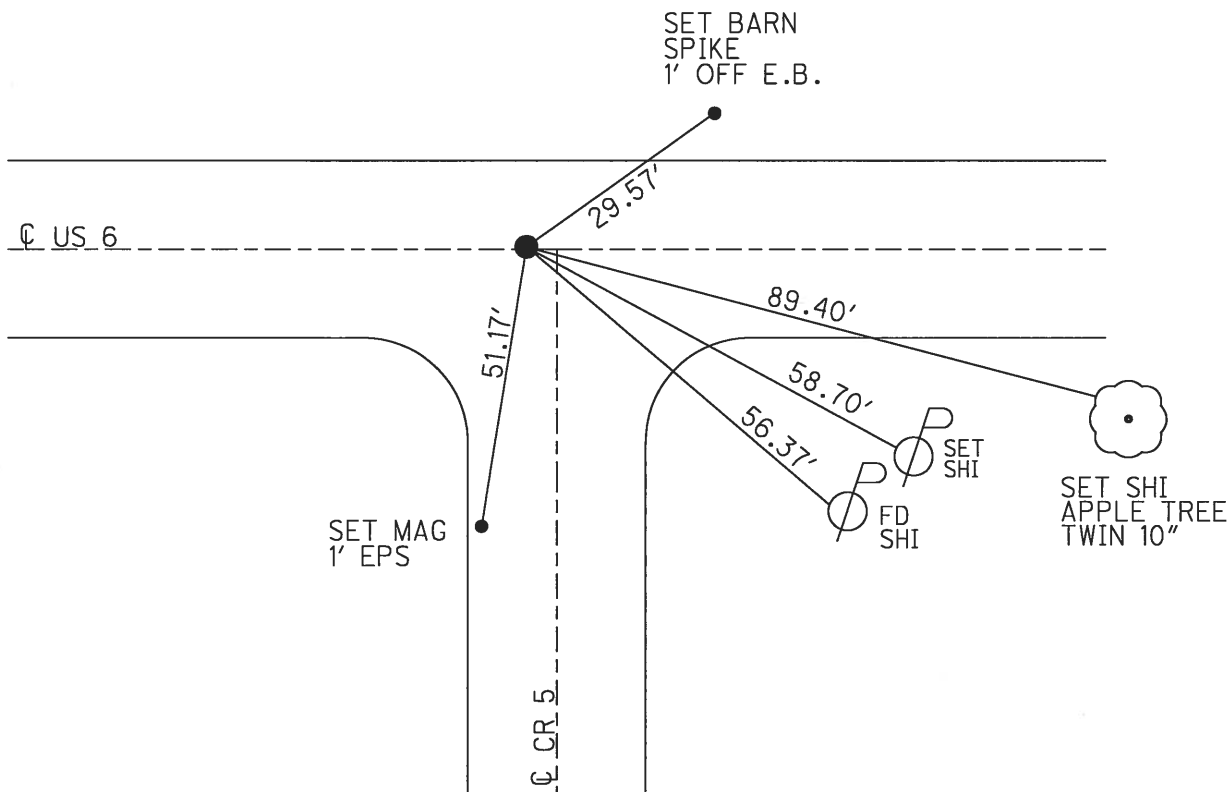

O.D.O.T. DISTRICT 2 SURVEY OFFICE (USE ONLY)


PERSONNEL _____ REFERENCE NO. 53 SHEET 16 OF 24
 NOTES HELDMAN DATE 4/20/17 ROUTE US 6
 H.C. LEU WEATHER PARTLY CLOUDY COUNTY HENRY
 R.C. HELDMAN TEMP. 79° TOWNSHIP DAMASCUS
 SECTION 28
 T 5 N R 8 E

TYPE MONUMENT MAG/WASHER
 ON SURFACE - ~~BELOW~~ ON
 LEFT - CL PAV'T - ~~RIGHT~~ 0.4'
12' TO LT EDGE PAVEMENT
 S.L.M. 1289+04.26

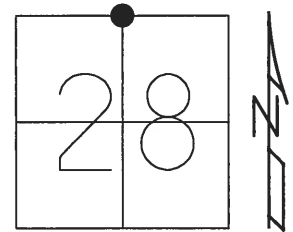

GRID: NORTHING: 624381.3986 EASTING: 1570235.527

RECORD:
 SET MAG/ WASHER
 4-21-03, DCH
 FD MAG NAIL
 REF53
 4/20/17, JLL
 SET MAG/WASHER
 10-30-17, JLL

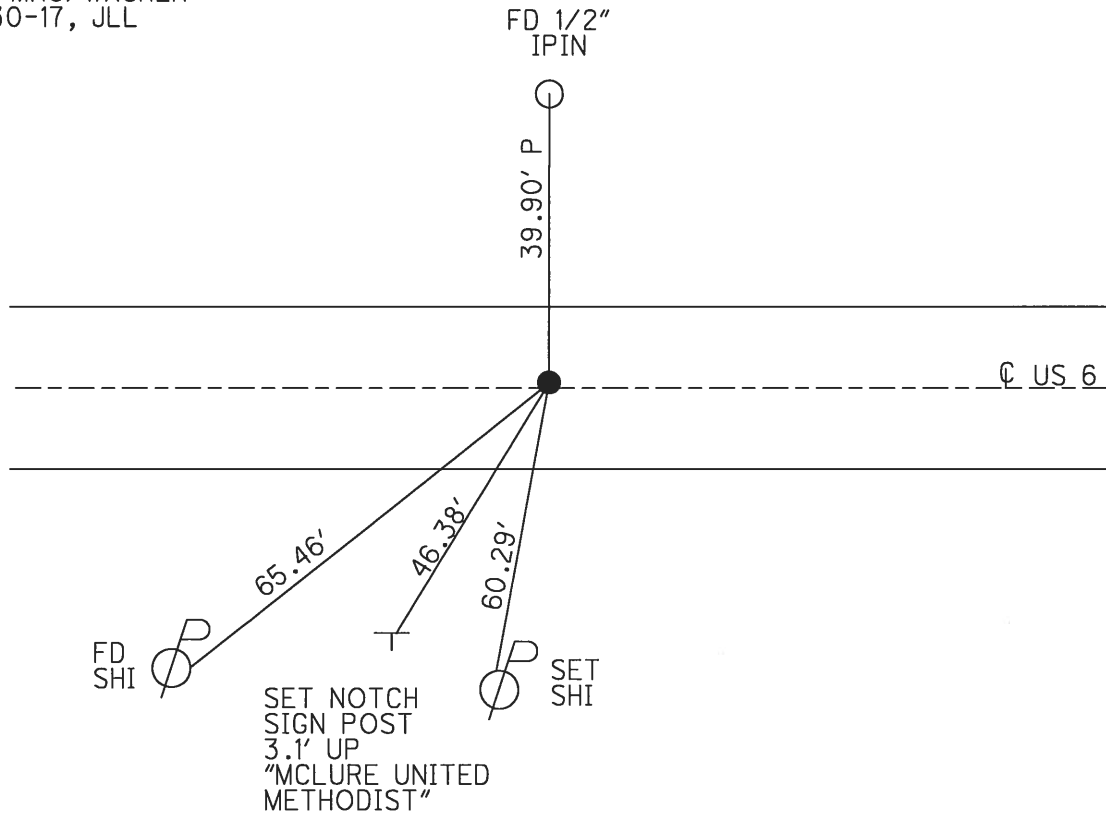

O.D.O.T. DISTRICT 2 SURVEY OFFICE (USE ONLY)

PERSONNEL _____ REFERENCE NO. 54 SHEET 17 OF 24
 NOTES HELDMAN DATE 4/20/17 ROUTE US 6
 H.C. LEU WEATHER PARTLY CLOUDY COUNTY HENRY
 R.C. HELDMAN TEMP. 79° F TOWNSHIP DAMASCUS
 SECTION 28
 T 5 N R 8 E

TYPE MONUMENT IPIN SHAFT F/BRASS "MOBORA" MON


~~ON SURFACE~~ - BELOW 5"

~~LEFT~~ - CL PAV'T - ~~RIGHT~~ ON

- TO - EDGE PAVEMENT

S.L.M. 24.96 STA: 1315+69.45


GRID: NORTHING: 624351.3697 EASTING: 1572900.554

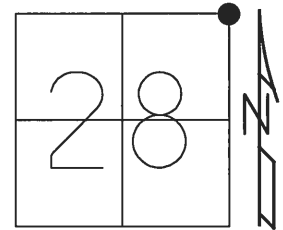

NOTE: SR 65 REF 28C

RECORD:

FD IPIN
 2-19-52
 6-09-54
 SET MOBARA
 (BRASS) MON
 8-20-54
 FD BRASS MON
 5-10-72
 FD BRASS MON
 W/"+" ON TOP
 2-01-84, SWH
 FD R.R.SPIKE
 4-08-88, SWH
 SET SM R.R.SPIKE
 6-20-88, SWH
 FD SM.R.R.SPIKE
 10-10-96, BVD
 7-18-02, DCH
 SET MAG/WASHER
 4-21-03, DCH
 FD MAG/WASHER
 9-29-10, JMH
 FIN C28
 3-15-13, MC
 SET MAG/WASHER
 10/30/17, JLL

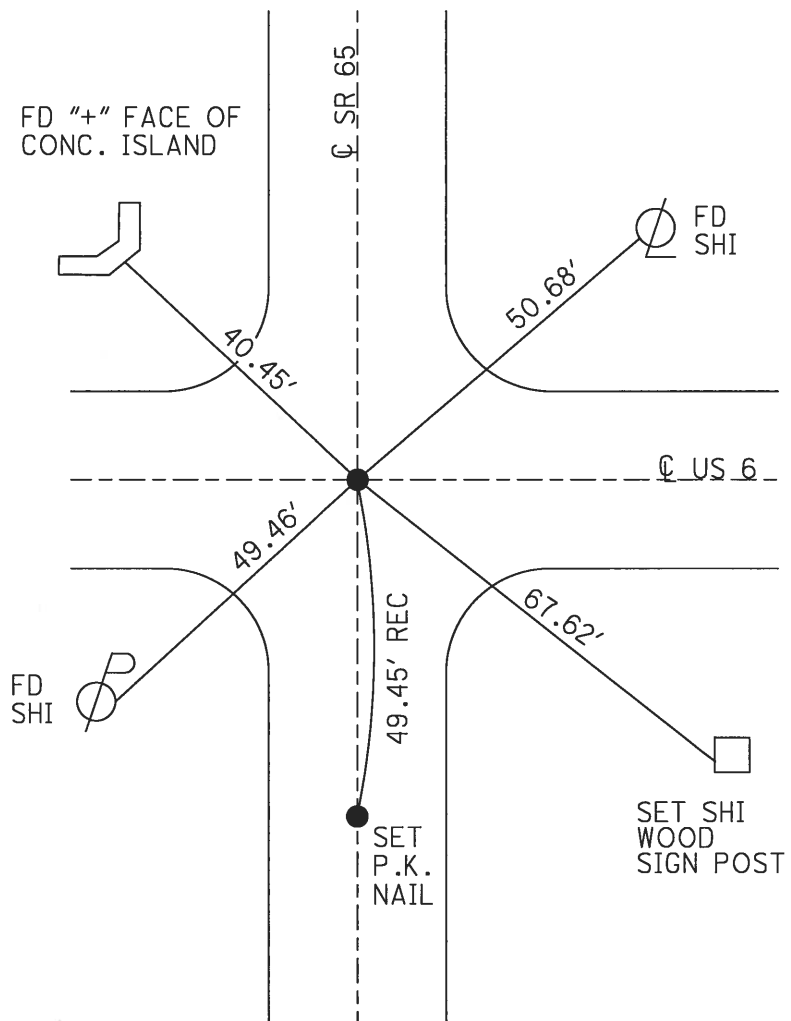

O.D.O.T. DISTRICT 2 SURVEY OFFICE (USE ONLY)

PERSONNEL

REFERENCE NO. 55

SHEET 18 OF 24

NOTES RHOADES

DATE 4/24/17

ROUTE US 6

H.C. LEU

WEATHER SUNNY

COUNTY HENRY

R.C. HELDMAN

TEMP. 44°

TOWNSHIP DAMASCUS

SECTION 27

T 5 N R 8 E

TYPE MONUMENT P.K./WASHER


ON SURFACE - ~~BELOW~~ ON

~~LEFT~~ - CL PAV'T - RIGHT 0.5'


12.0' TO RT EDGE PAVEMENT

S.L.M. 1342+18.90

GRID: NORTHING: 624329.1229 EASTING: 1575549.91

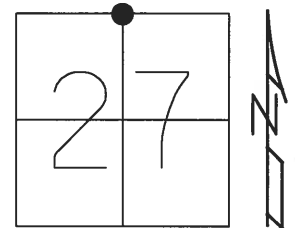


RECORD:
SET SM.R.R.SPIKE
6-20-88, SWH
SET MAG/WASHER
4/21/03, DCH
FD MAG NAIL
REF55
4-24-17, JLL
SET MAG/WASHER
10/30/17, JLL

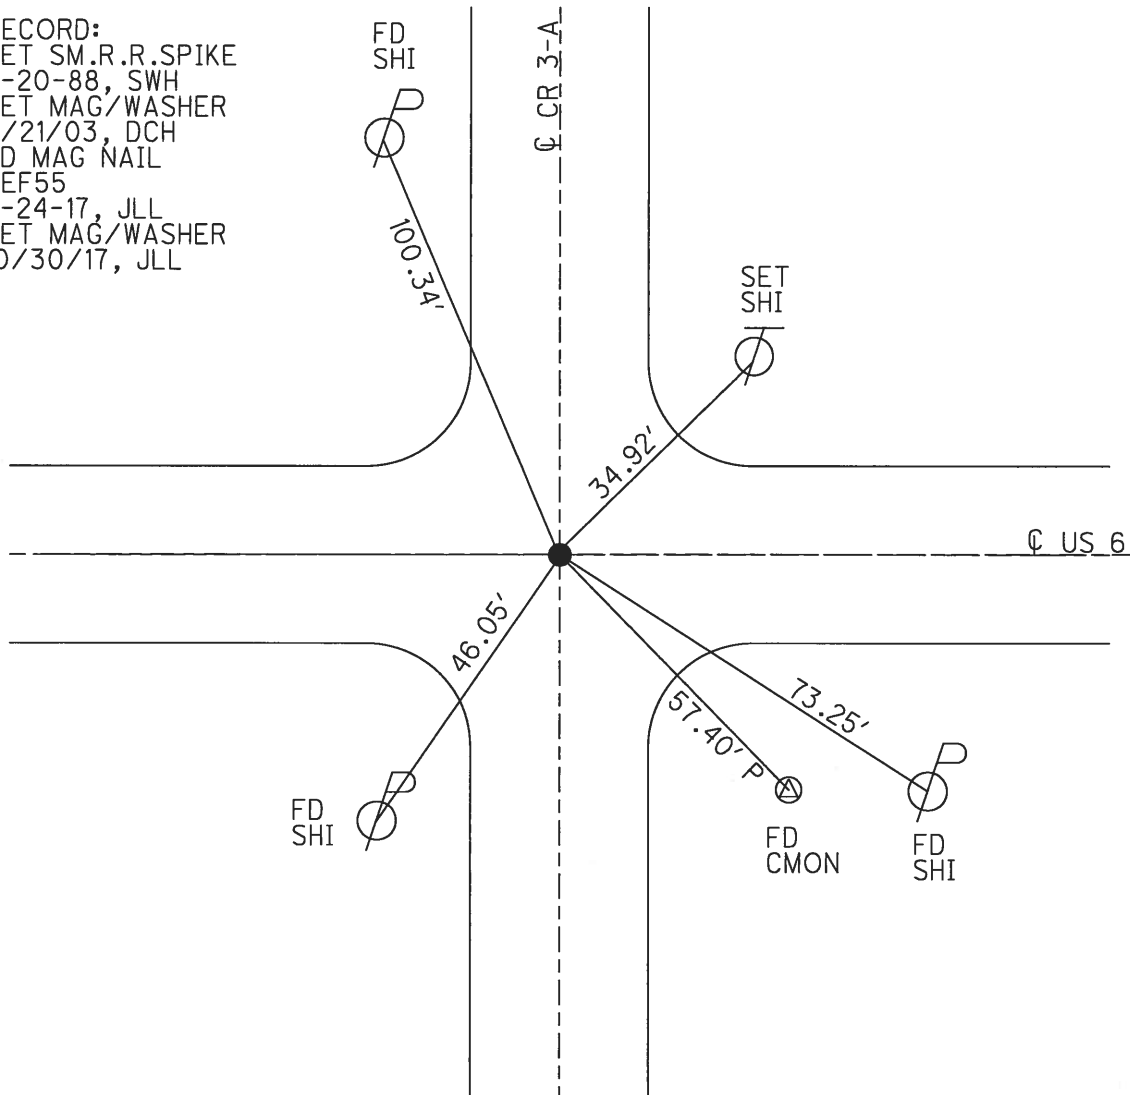

O.D.O.T. DISTRICT 2 SURVEY OFFICE (USE ONLY)


PERSONNEL _____ REFERENCE NO. 56 SHEET 19 OF 24
 NOTES RHOADES DATE 4/24/17 ROUTE US 6
 H.C. LEU WEATHER SUNNY COUNTY HENRY
 R.C. HELDMAN TEMP. 44° TOWNSHIP DAMASCUS
 _____ SECTION 27
 _____ T 5 N R 8 E

TYPE MONUMENT _____ P.K./WASHER
 ON SURFACE - ~~BELOW~~ ON _____
 LEFT - ℄ PAV'T - ~~RIGHT~~ 0.4'
11.6' TO LT EDGE PAVEMENT
 S.L.M. 1368+61.70

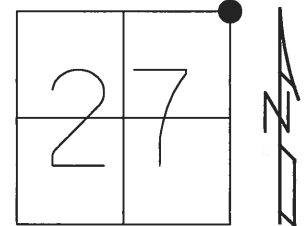

GRID: NORTHING: 624306.9965 EASTING: 1578192.657

RECORD:
 FD BRASS MON
 1" DOWN
 SET SQ. HEADED
 SPIKE/WASHER
 5-18-82, HOFFMAN
 SET P.K./WASHER
 10/10/96, BVD
 FD P.K.NAIL
 REF56
 4-24-17, JLL
 SET MAG/WASHER
 10/30/17, JLL

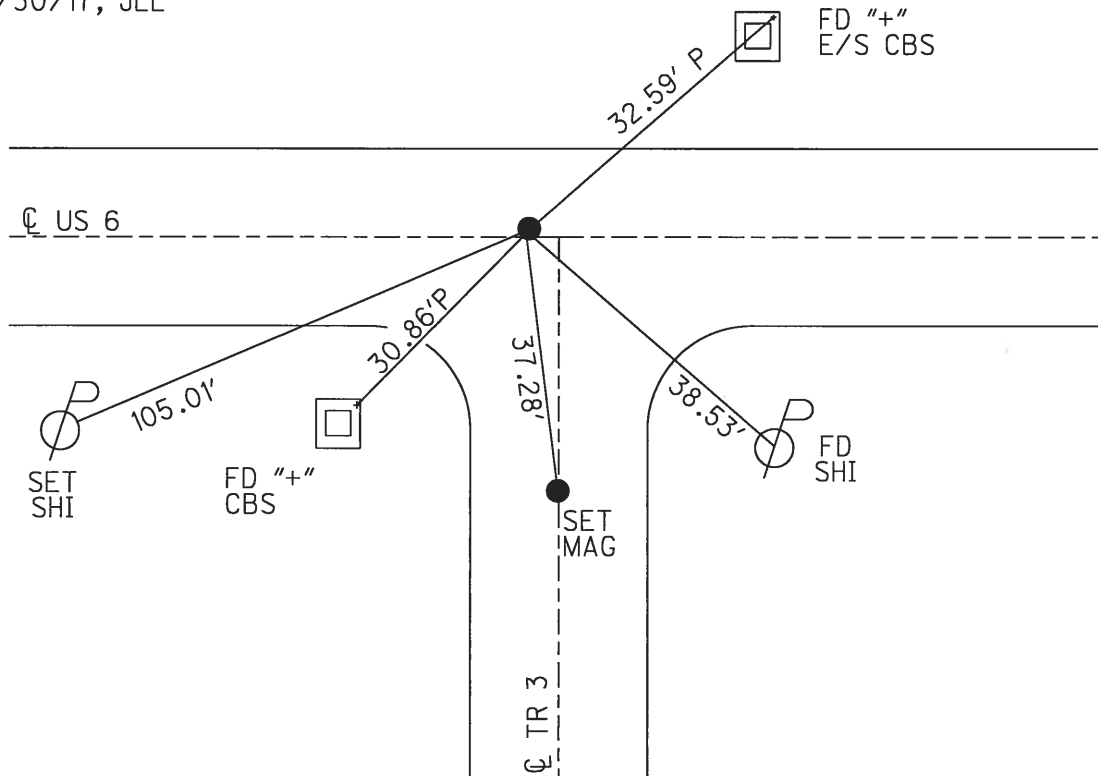

O.D.O.T. DISTRICT 2 SURVEY OFFICE (USE ONLY)

PERSONNEL

REFERENCE NO. 57

SHEET 20 OF 24

NOTES RHOADES

DATE 4/24/17

ROUTE US 6

H.C. LEU

WEATHER SUNNY

COUNTY HENRY

R.C. HELDMAN

TEMP. 44°

TOWNSHIP DAMASCUS

SECTION 26

T 5 N R 8 E

TYPE MONUMENT P.K./WASHER


ON SURFACE - ~~BELOW~~ ON

~~LEFT~~ - CL PAV'T - ~~RIGHT~~ ON


12.4' TO LT EDGE PAVEMENT

S.L.M. 1395+10.94

GRID: NORTHING: 624276.5485 EASTING: 1580841.701

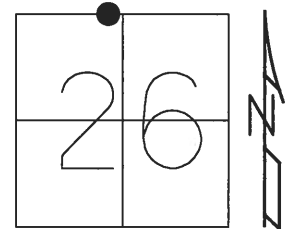


RECORD:
FD BRASS MON
1" BELOW
SET SQ. HEAD
SPIKE/WASHER
5-18-82, HOFFMAN
SET PK/WASHER
10-10-96, BVD
FD P.K.
REF57
4-24-17, JLL
SET MAG/WASHER
10/30/17, JLL

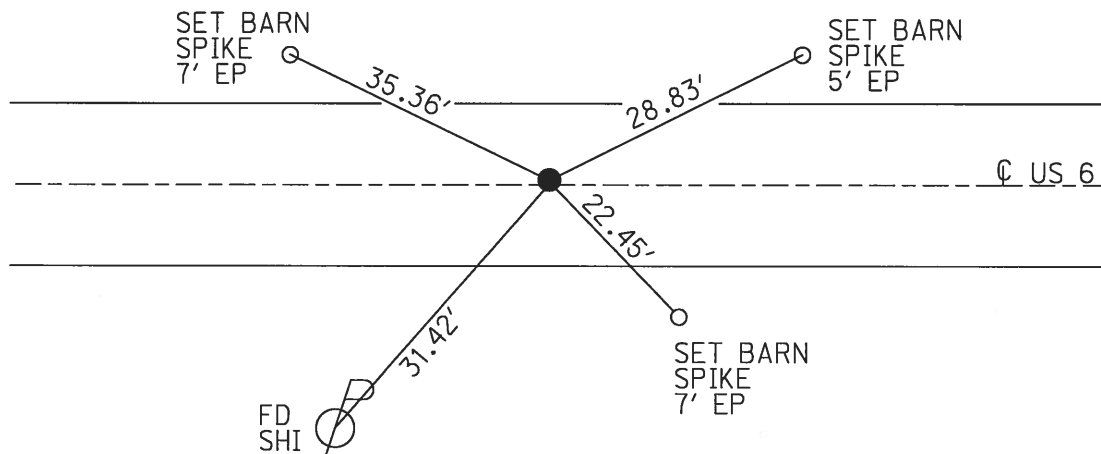


O.D.O.T. DISTRICT 2 SURVEY OFFICE (USE ONLY)

PERSONNEL	REFERENCE NO. <u>58</u>	SHEET <u>21</u> OF <u>24</u>
NOTES	DATE <u>4/24/17</u>	ROUTE <u>US 6</u>
H.C. <u>RHOADES</u>	WEATHER <u>SUNNY</u>	COUNTY <u>HENRY</u>
R.C. <u>LEU</u>	TEMP. <u>44°</u>	TOWNSHIP <u>DAMASCUS</u>
		SECTION <u>26</u>
		T <u>5</u> N R <u>8</u> E

TYPE MONUMENT P.K.NAIL
 ON SURFACE - ~~BELOW~~ ON
 LEFT - ℄ PAV'T - ~~RIGHT~~ ON, 1.5' LT ℄ CR 2
13.0' TO LT EDGE PAVEMENT
 S.L.M. 1421+59.09
 GRID: NORTHING: 624245.8205 EASTING: 1583489.721

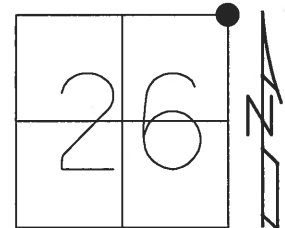


RECORD:
 FD BRASS MON.
 1" BELOW
 SET SQ. HEAD
 SPIKE/WASHER
 5-18-82, SHOFFMAN
 SET PK/WASHER
 10-10-96, BVD
 FD P.K. REF58
 4-24-17, JLL
 SET MAG/WASHER
 10-30-17, JLL

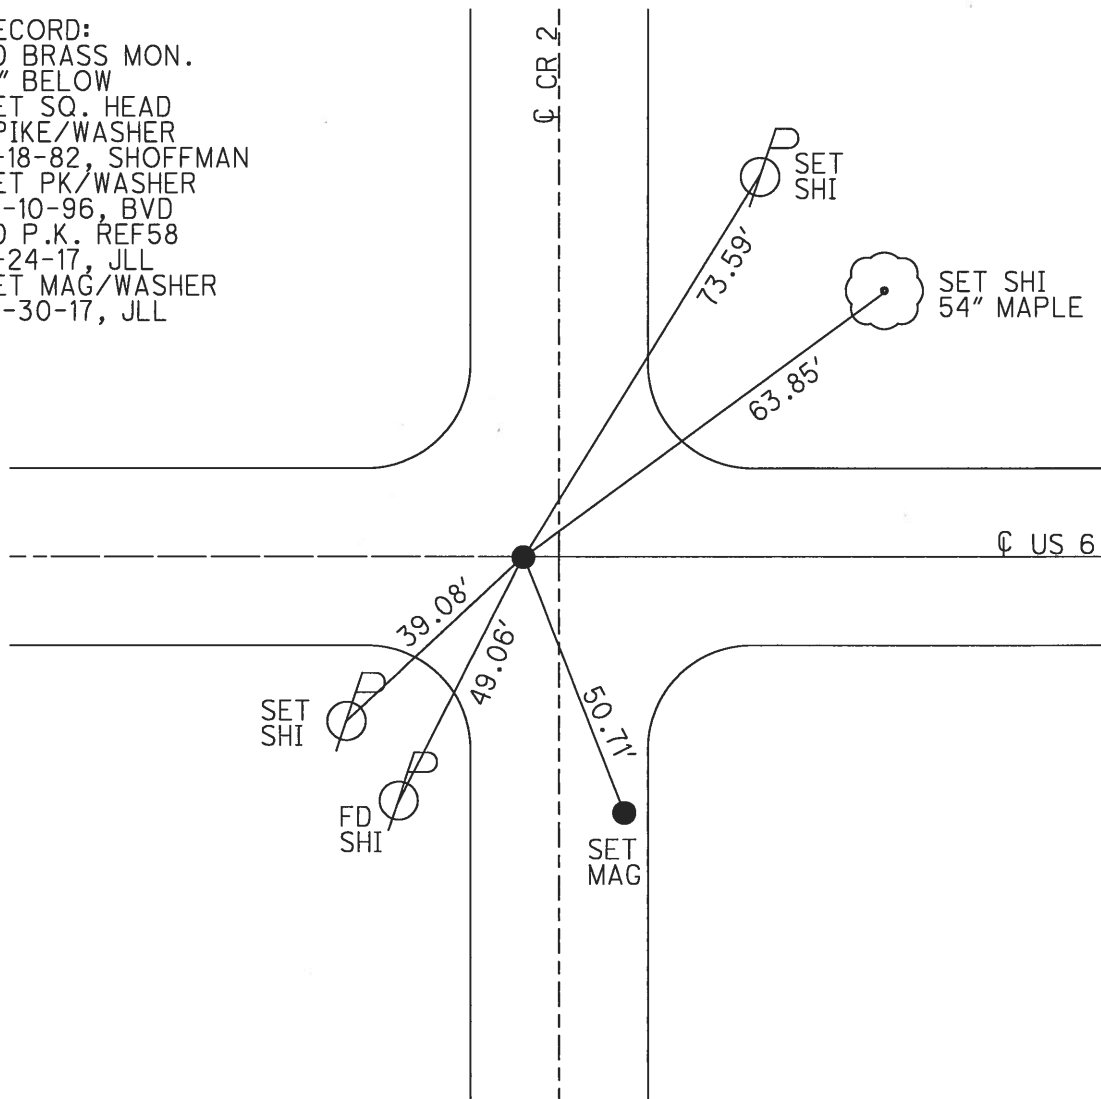


O.D.O.T. DISTRICT 2 SURVEY OFFICE (USE ONLY)

PERSONNEL _____ REFERENCE NO. 59 SHEET 22 OF 24
NOTES RHOADES DATE 4/24/17 ROUTE SR 6
H.C. LEU WEATHER SUNNY COUNTY HENRY
R.C. HELDMAN TEMP. 44° TOWNSHIP DAMASCUS
SECTION 25
T 5 N R 8 E

TYPE MONUMENT SM.R.R.SPIKE
~~ON SURFACE~~ - BELOW 1"
~~LEFT~~ - ℄ PAV'T - RIGHT 0.5'
12' TO LT EDGE PAVEMENT
S.L.M. 1448+20.32
Grid: Northing: 624216.0386 Easting: 1586150.81

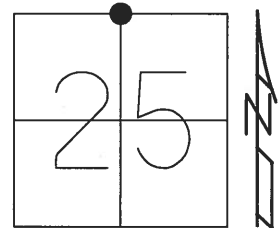

RECORD:
FD BRASS MON
2 1/2" BELOW
SET SQ.HEAD SPIKE
5-18-82, SH
SET P.K./WASHER
10-10-96, SAH
SET SM.R.R.SPIKE
6-20-88, SWH
FD P.K NAIL
REF59
4-24-17, JLL
SET MAG/WASHER
10-30-17, JLL

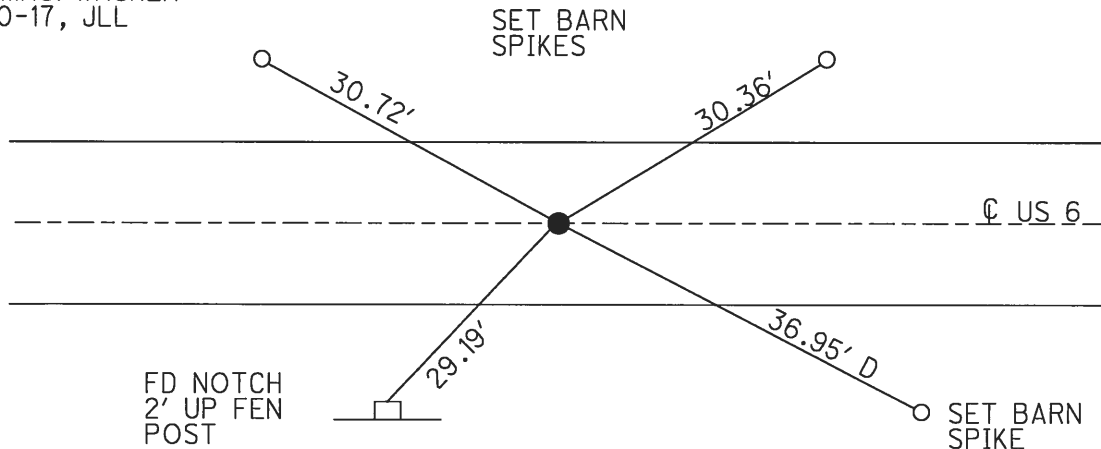

NOTES:
SET R.R.SPIKE, USING 1' OFFSETS,
OVER BRASS MON. GPS COORDINATE
WAS SHOT ON BRASS MON.
11/4/15
N= 624216.017
E= 1586150.715
ELEV= 676.758
HENRY CO. ENGR.
JUSTIN NIESE

O.D.O.T. DISTRICT 2 SURVEY OFFICE (USE ONLY)

PERSONNEL

REFERENCE NO.

60

SHEET

23

OF 24

NOTES

HUSS

DATE

10/30/01

ROUTE

US 6

H.C.

ROUSOS

WEATHER

CLOUDY

COUNTY

HENRY

R.C.

VAN DUSEN

TEMP.

57°

TOWNSHIP

DAMASCUS

SECTION

25

T 5 N R 8 R

TYPE MONUMENT PK/WASHER


ON SURFACE - ~~BELOW~~ ON

~~LEFT~~ - C PAV'T - RIGHT 2'

9.6' TO RT EDGE PAVEMENT

S.L.M. 1474+93.24

GRID: NORTHING: 624190.0343 EASTING: 1588823.504

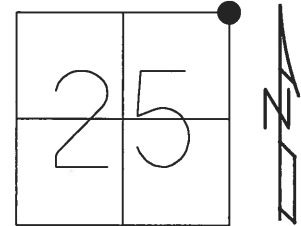

RECORD:

FD BRASS MON

3" BELOW

1.9'S. OF C US 6

5.0' E. OF C CR 1

SET P.K./WASHER

1-23-02, SAH

FD P.K.NAIL

REF60


4-24-17, JLL

SET MAG/WASHER

10-30-17, JLL

DIST. 60-60A = 6.02'


FD "+" WEST END
CONC. HDWL.

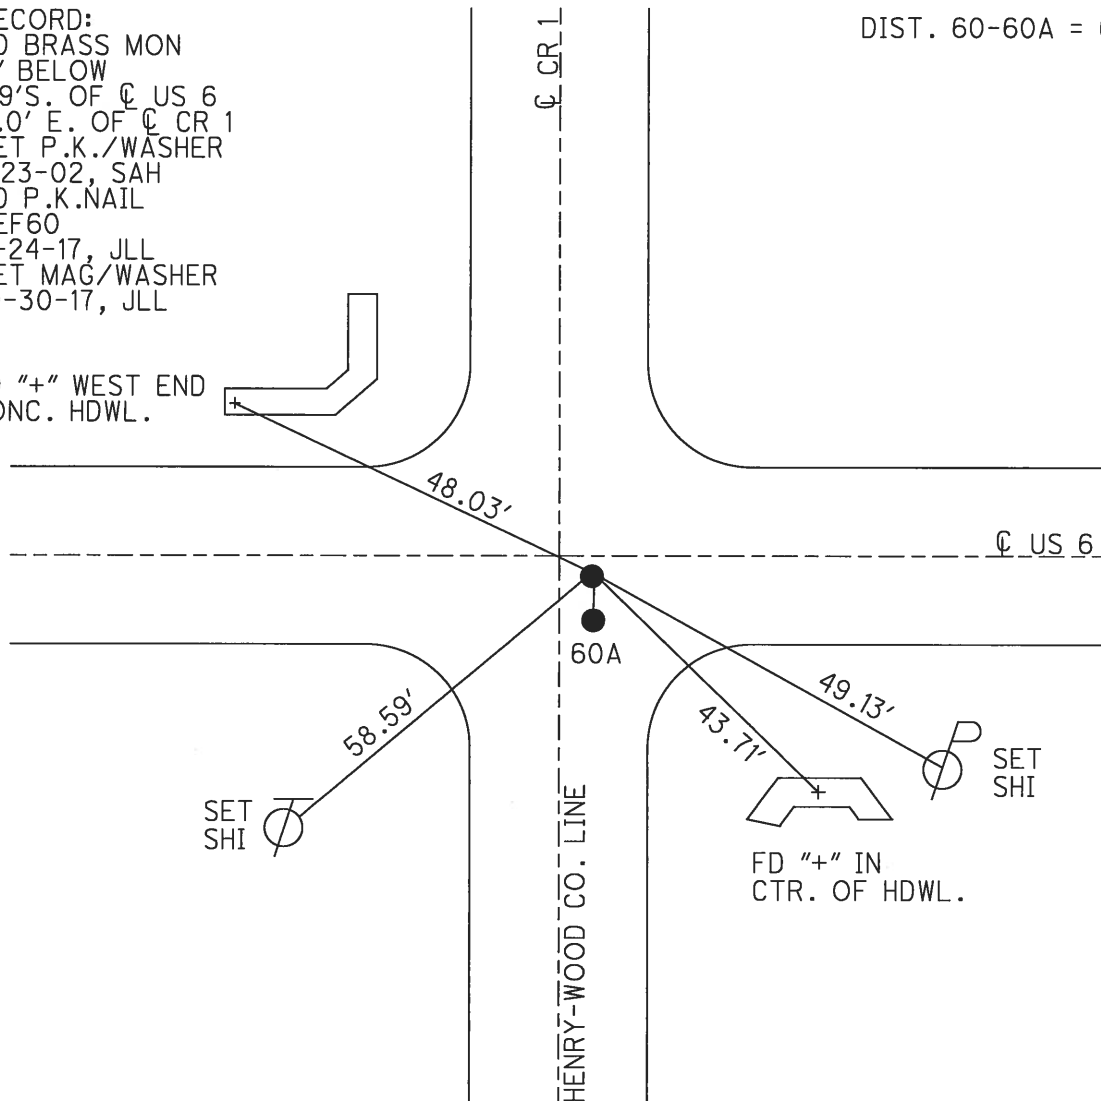

O.D.O.T. DISTRICT 2 SURVEY OFFICE (USE ONLY)

PERSONNEL _____ REFERENCE NO. 60 A SHEET 24 OF 24
 NOTES HUSS DATE 10/30/01 ROUTE US 6
 H.C. ROUSOS WEATHER CLOUDY COUNTY HENRY
 R.C. VAN DUSEN TEMP. 57° TOWNSHIP DAMASCUS
 SECTION 25
 T 5 N R 8 R

TYPE MONUMENT P.K.NAIL
 ON SURFACE - ~~BELOW~~ ON _____
~~LEFT~~ - ℄ PAV'T - RIGHT 8'
 - TO - EDGE PAVEMENT
 S.L.M. 1474+93
 GRID: NORTHING: _____ EASTING: _____

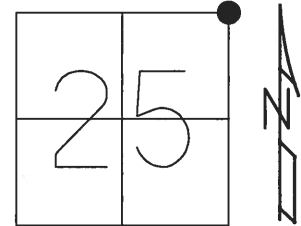

RECORD:
 FD PK @ SURFACE
 ORIGIN UNKNOWN
 POSSIBLE OFFSET
 D.N.F.
 4/24/17, JLL

DIST. 60-60A = 6.02'

