

O.D.O.T. DISTRICT 2 SURVEY OFFICE (USE ONLY)

PERSONNEL

REFERENCE NO. 1

SHEET OF

NOTES RHODES

DATE 7/7/21

ROUTE US 6

H.C. AUBLE

WEATHER HAZY

COUNTY HENRY

R.C. NIESE

TEMP. 77°

TOWNSHIP RIDGEVILLE

SECTION 31

DWG BY BARRIERE

PID 101274

T 6 N R 5 E

TYPE MONUMENT MONBOX W/ 1" IPIN

ON SURFACE - BELOW ON

OFFSET $\mathcal{C}$ PAVEMENT 10.5' RT LT : RT

 TO EDGE PAVEMENT

STATION: 0+00

HORZ.DATUM: NAD83 2011


GEOID: 18

GRID: NORTHING: 652191.163


EASTING: 1463572.794

LDP: NORTHING:

EASTING:

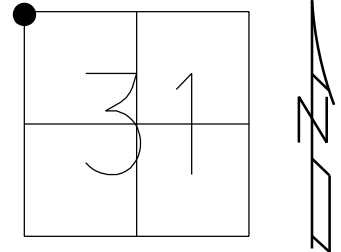

RECORD:
FD R.R.SPIKE
1 1/2" DOWN
5/6/85, MB
SET SM.R.R.SPIKE
6/13/85, SWH
FD R.R.SPIKE SHANK
4" DOWN
HENREF1
2/14/18, JFO
FD MAG SPIKE
REF1
7/7/21, DSA
FD MONBOX W/ 1" IPIN
NEWREF1
12/12/22, TDN

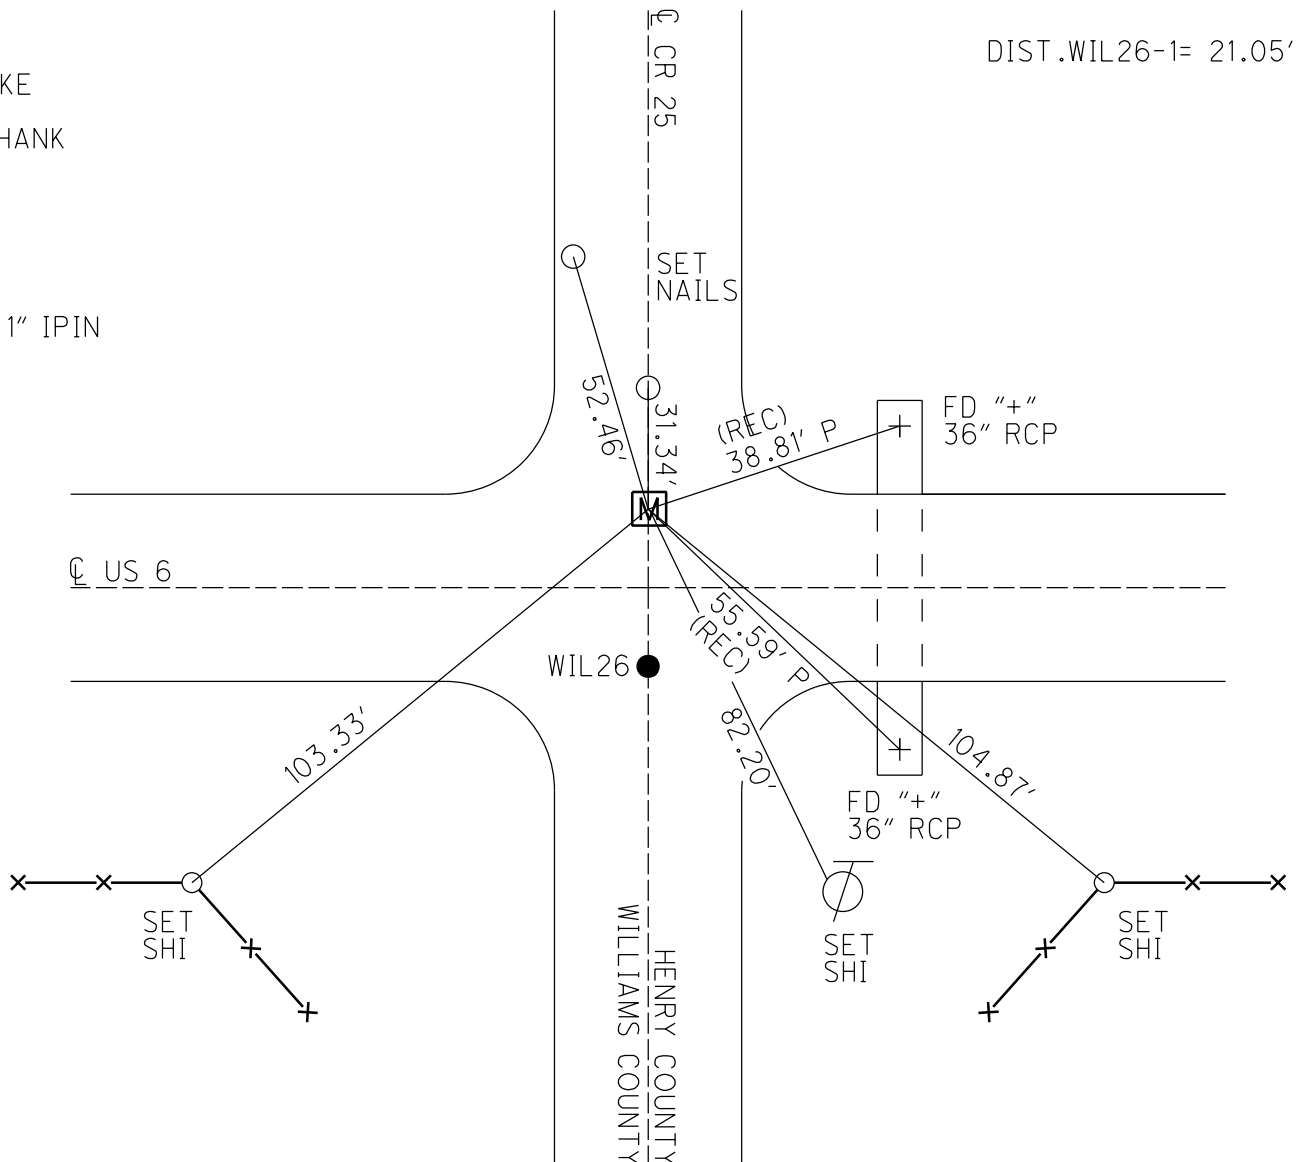

O.D.O.T. DISTRICT 2 SURVEY OFFICE (USE ONLY)

PERSONNEL

REFERENCE NO. 1

SHEET 9 OF 9

NOTES O'DONNELL

DATE 2/14/18

ROUTE US 6

H.C. _____

WEATHER FAIR

COUNTY HENRY

R.C. _____

TEMP. 33°

TOWNSHIP RIDGEVILLE

SECTION 31

DWG BY RHOADES

PID 95792

T 6 N R 5 E

TYPE MONUMENT R.R.SPIKE SHANK

~~ON SURFACE~~ - BELOW 4"

OFFSET CL PAVEMENT 10.5' ~~LT~~ : RT

- TO - EDGE PAVEMENT


STATION: 0+00

HORZ.DATUM: NAD83 2011

GEOID: NAVD88 2012A


GRID: NORTHING: 652191.163

EASTING: 1463572.794

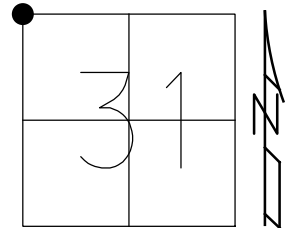

RECORD:
FD R.R.SPIKE
1 1/2" DOWN
5/6/85, MB
SET SM.R.R.SPIKE
6/13/85, SWH
FD R.R.SPIKE SHANK
4" DOWN
HENREF1
2/14/18, JFO

DIST.WIL26-1= 20.99'

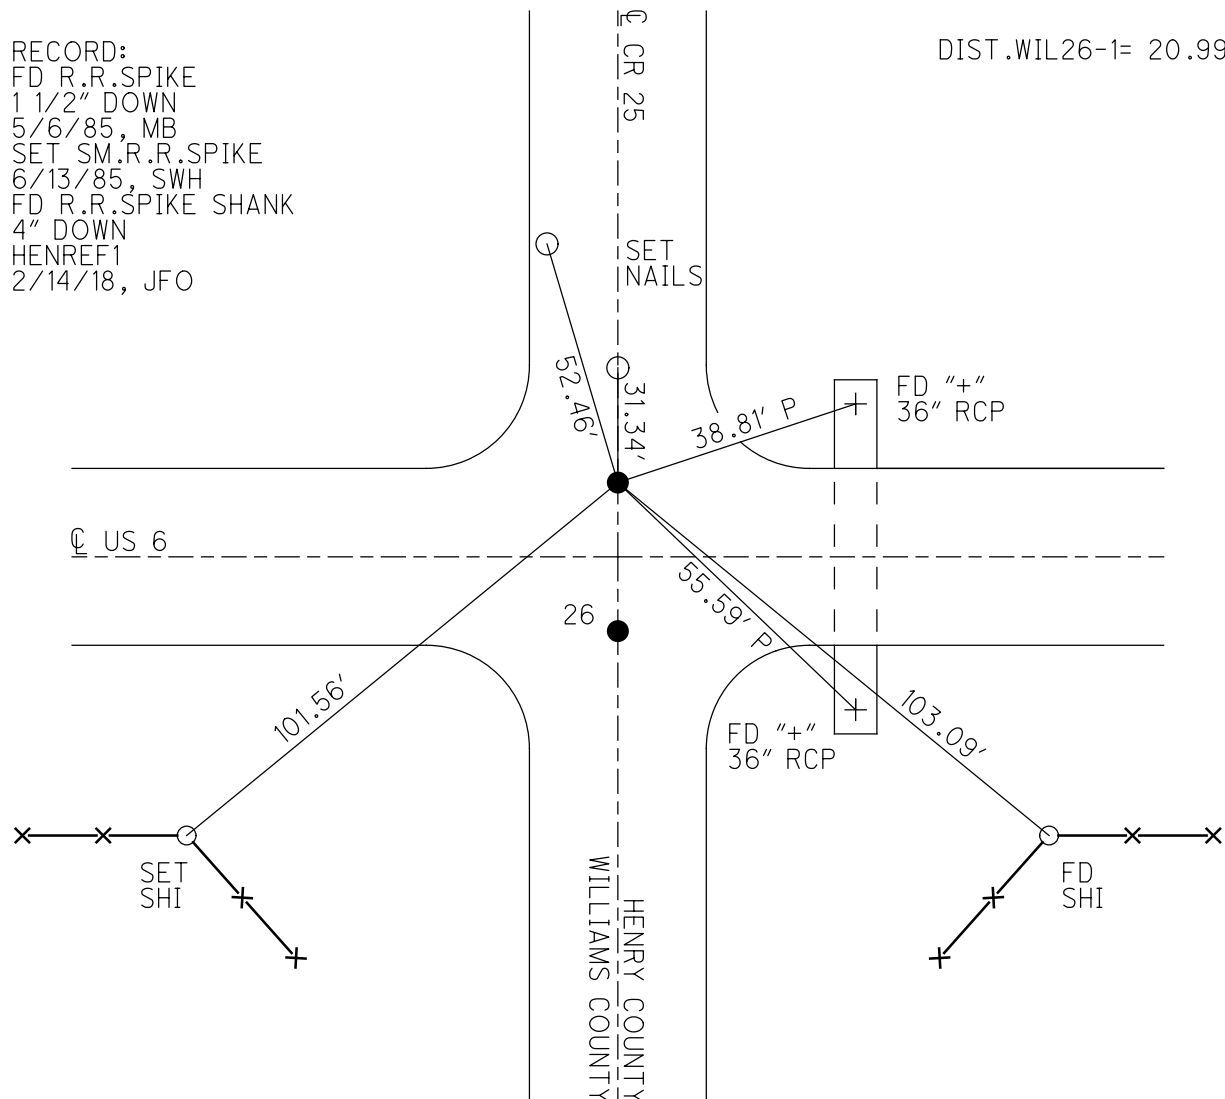

O.D.O.T. DISTRICT 2 SURVEY OFFICE

PERSONNEL

REFERENCE NO. 7

SHEET 1 OF 7

NOTES CozDeS

H.C. LOENHKE

R.C. MUSER

9 HOSS

DATE 4-14-97

WEATHER SUN

TEMP. +4°C

ROUTE 6

COUNTY Henrico

TOWNSHIP Livingstone

SECTION 30

T6NR5E



TYPE MONUMENTS sm. IR SPIKES

~~SECRET~~ ~~XXXXXXXXXX~~ - BELOW _____"

LEFT - ~~3.2m~~ - RIGHT 3.2m FT, 3.2m LT, BOTH POINTS

—TO—EDGE PAVEMENT

S.L.M. 0400

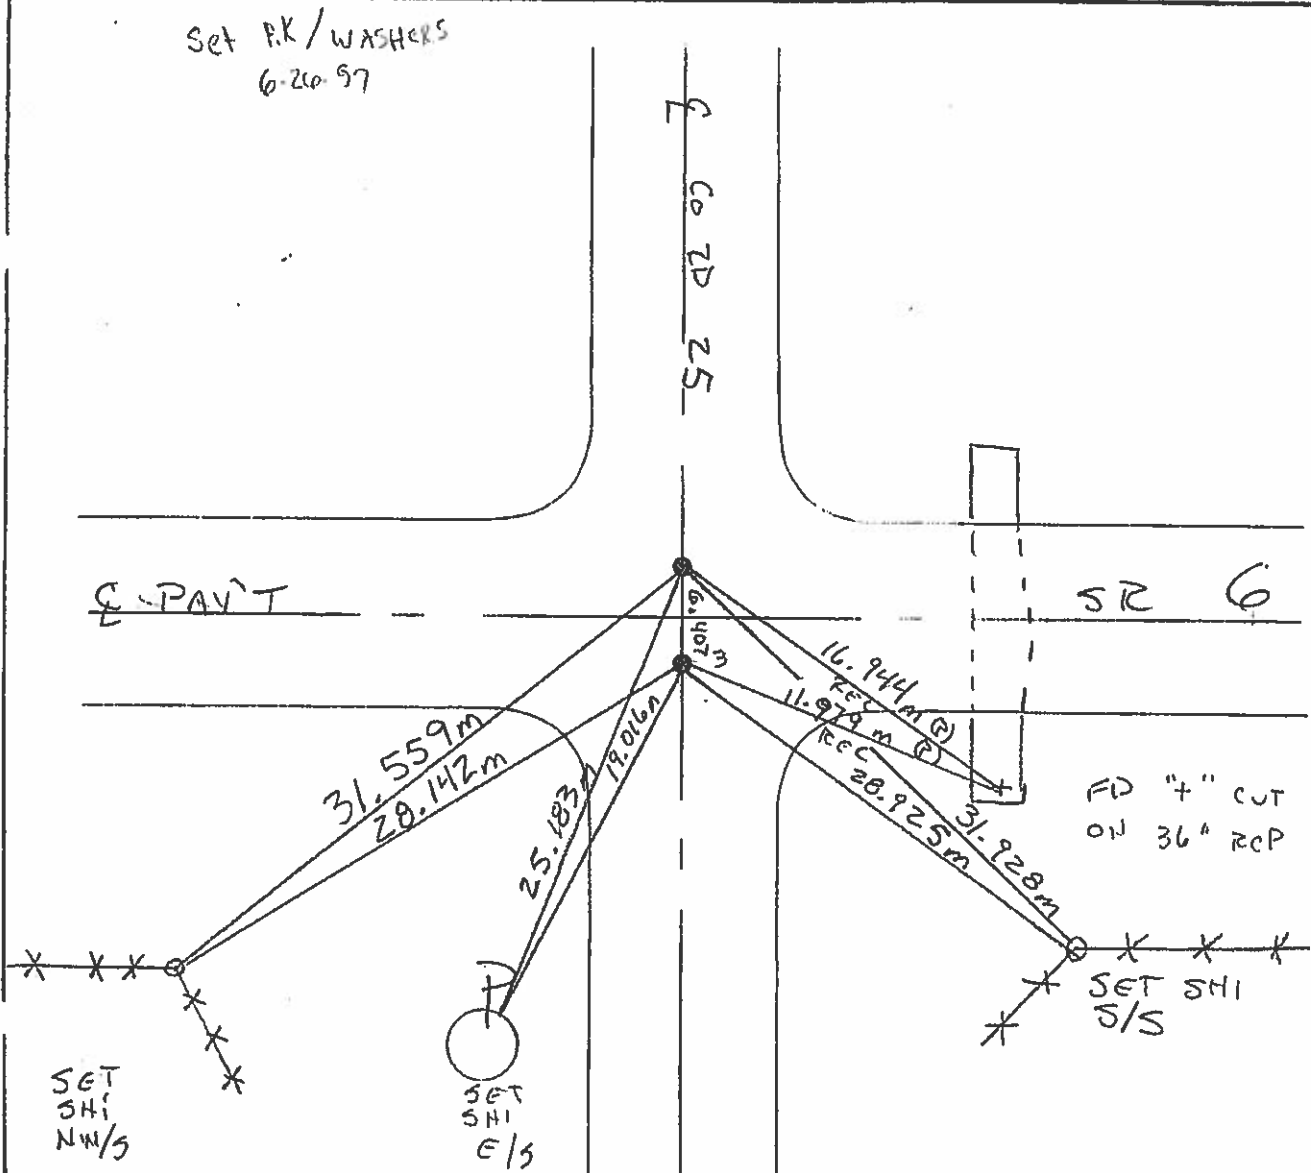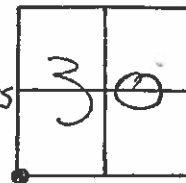

O.D.O.T. DISTRICT 2 SURVEY OFFICE

PERSONNEL

REFERENCE NO. 1

SHEET _____ OF _____

NOTES Hoffman P.C.

H.C. BARNHISEL

R.C. _____

DATE 5-6-85

WEATHER Cloudy

TEMP. 65°

ROUTE US 6

COUNTY HENRY

TOWNSHIP Ridgeville

SECTION 30



T6 N R S E

TYPE MONUMENT P.R. SPIKES Set Small
ON SURFACE - BELOW 1 1/2" P.R. SPIKES
6-13-85

LEFT - ~~C~~ PAV¹ T. - RIGHT 10.5 L + 10.5 RT

____ TO ____ EDGE PAVEMENT

S.L.M. 0 + 00

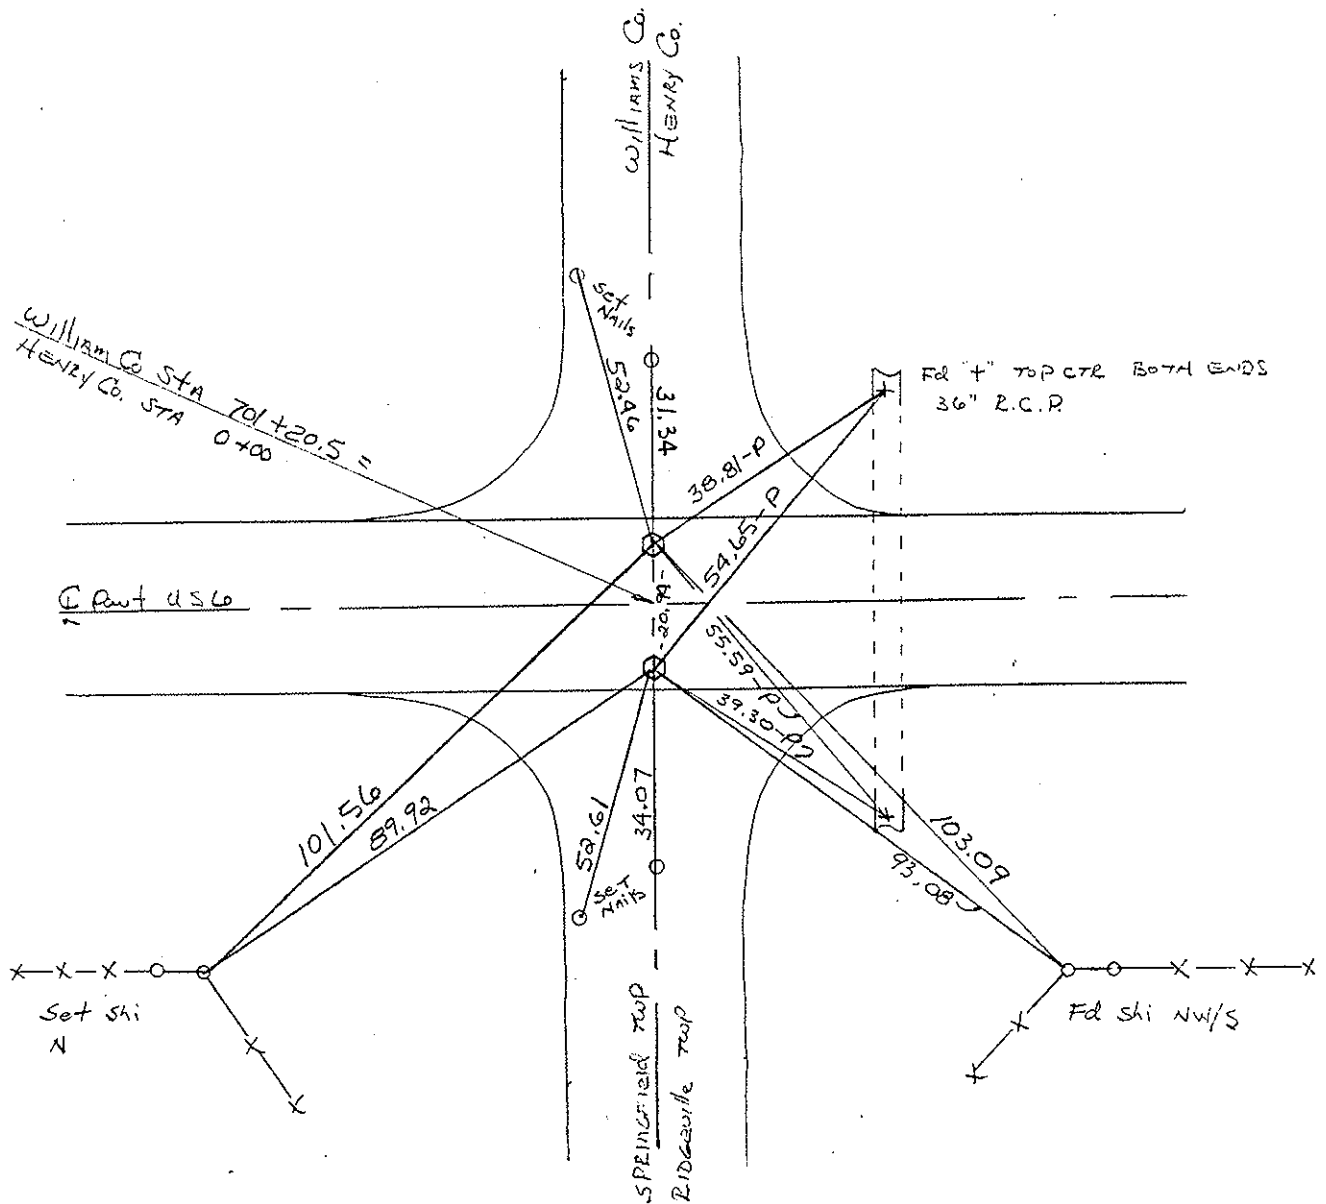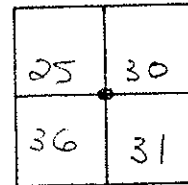

PERSONNEL	TITLE	PERSONNEL	TITLE
1			
2			
COUNTY HENRY DATE 5 July 1974

S. R. 45 6 WEATHER


SEC. Ridgeville Twp. TEMP. _____

DESCRIPTION CONTROL POINTS JOB NO.

3.74 miles of control
points on Henry US6
before proposed blacktop
surfacing

Resurfacing completed
20 Sept. 1974

He Co 0+00 to 198+00±
De-lathed. 30 Sept. 74

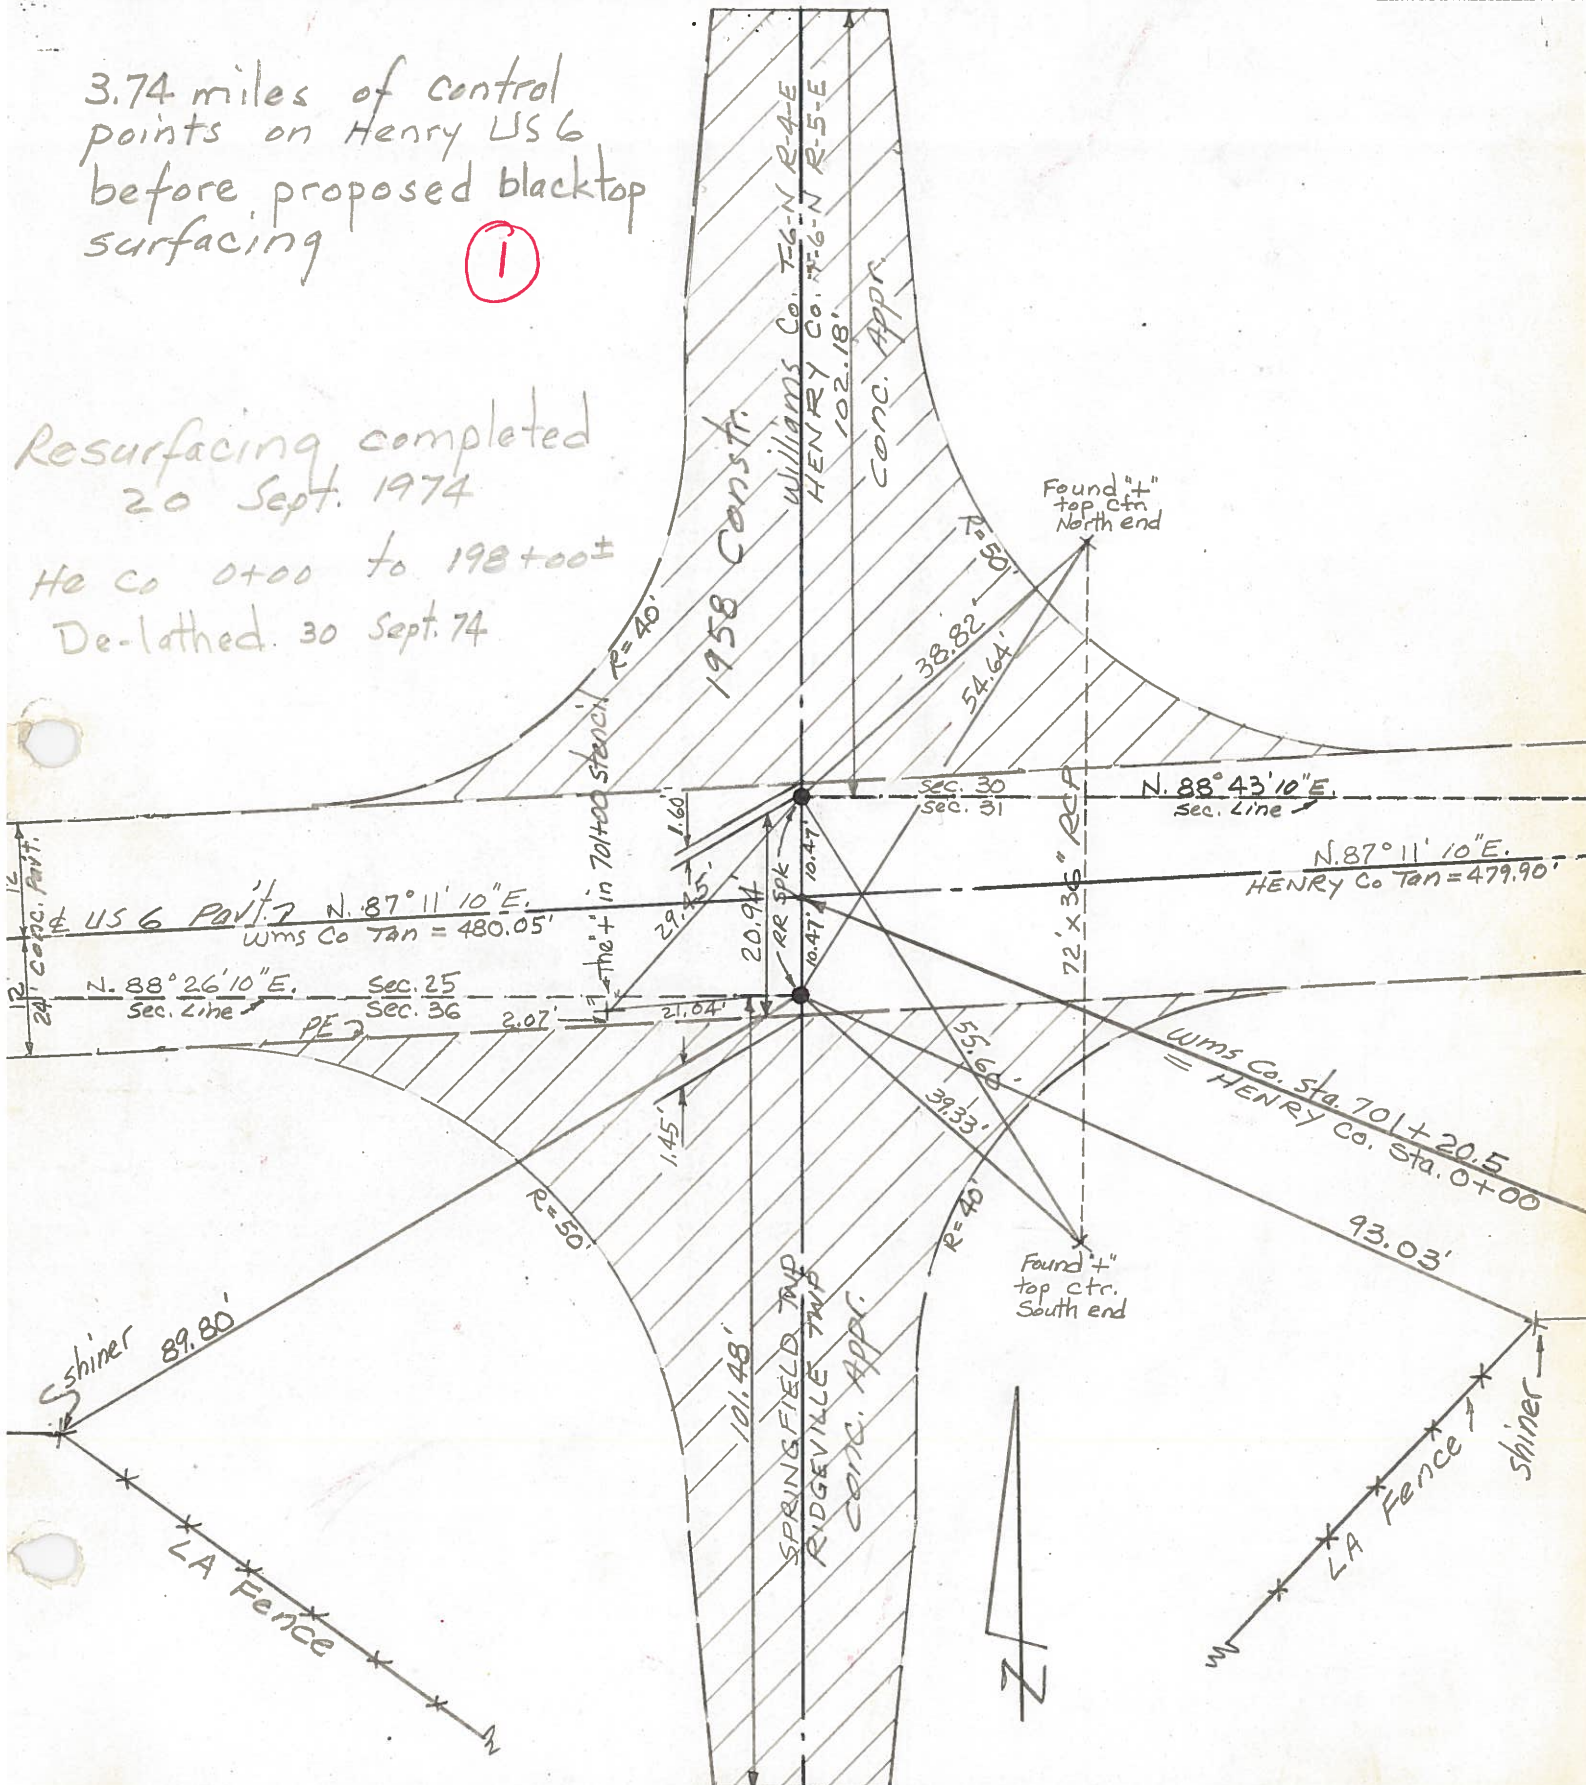

PERSONNEL	TITLE	PERSONNEL	TITLE	COUNTY	DATE
				Henry	Jan 1951
				S. R. #384	WEATHER
				SEC.	TEMP.
DESCRIPTION	LEFT	CENTER LINE	RIGHT	JOB NO.	


10/9/56

Williams-Henry Co Line

Sta 70+20.00 = Sta. 0+00

Found Stone Sta 70+20.00

Established Tacked Hub 20.94 North

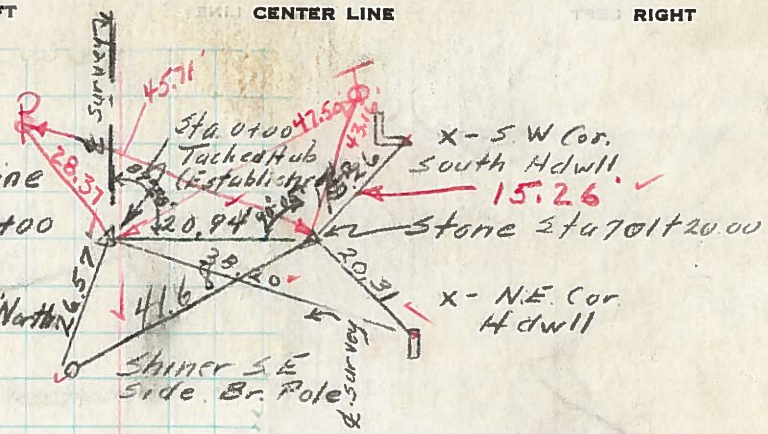


Recorded
Mon. book
He. Co.

10/9/56

Sta. 19+87.65

L = 0° 00'

Found Stone

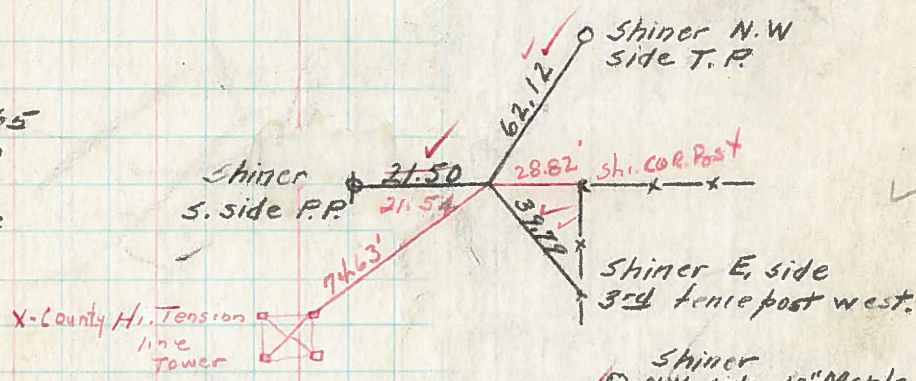


10/9/56

Sta. 46+19.55

L = 0° 10' Lt

Found I.P. over Stone

S.R. #384 & Twp. Rd #24

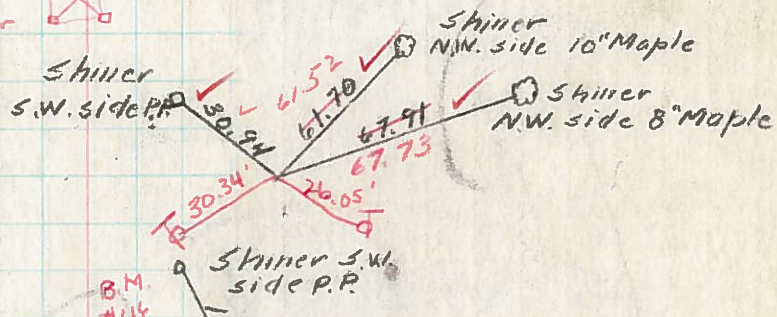


10/9/56

Sta. 72+63.84

L = 0° 08' Lt.

Found Stone

Set R.R. Spk.

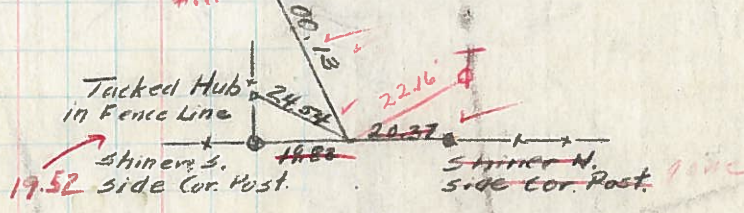

10/9/56

Sta. 99+17.62

L = 0° 8' Rt.

Established Tacked Hub

Set R.R. Spk

S.R. #384 & S.R. #66

