

O.D.O.T. DISTRICT 2 SURVEY OFFICE (USE ONLY)

PERSONNEL

REFERENCE NO. 2

SHEET OF

NOTES RHODES

DATE 7/7/21

ROUTE US 6

H.C. AUBLE

WEATHER FAIR

COUNTY HENRY

R.C. NIESE

TEMP. 77°

TOWNSHIP RIDGEVILLE

DWG BY BARRIERE

PID 101274

SECTION 31

T 6 N R 5 E

TYPE MONUMENT MONBOX W/ 1" IPIN

ON SURFACE - BELOW ON

OFFSET $\odot$ PAVEMENT 1.2' LT LT : RT

 TO EDGE PAVEMENT

STATION: 19+87.49

HORZ.DATUM: NAD83 2011


GEOID: 18

GRID: NORTHING: 652146.153


EASTING: 1465559.773

LDP: NORTHING:

EASTING:

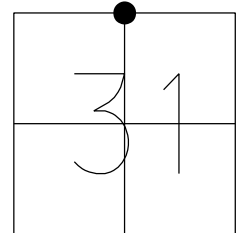

RECORD: P.O.T.
STA. 19+87.65
FD SM.R.R.SPIKE
4/14/97, CL
SET P.K./WASHER
6/26/97, CL
FD P.K./WASHER
HENREF2
2/14/18, JFO
FD MAG SPIKE
REF2
7/7/21, DSA
FD MONBOX W/ 1" IPIN
NEWREF2
12/12/22, TDN

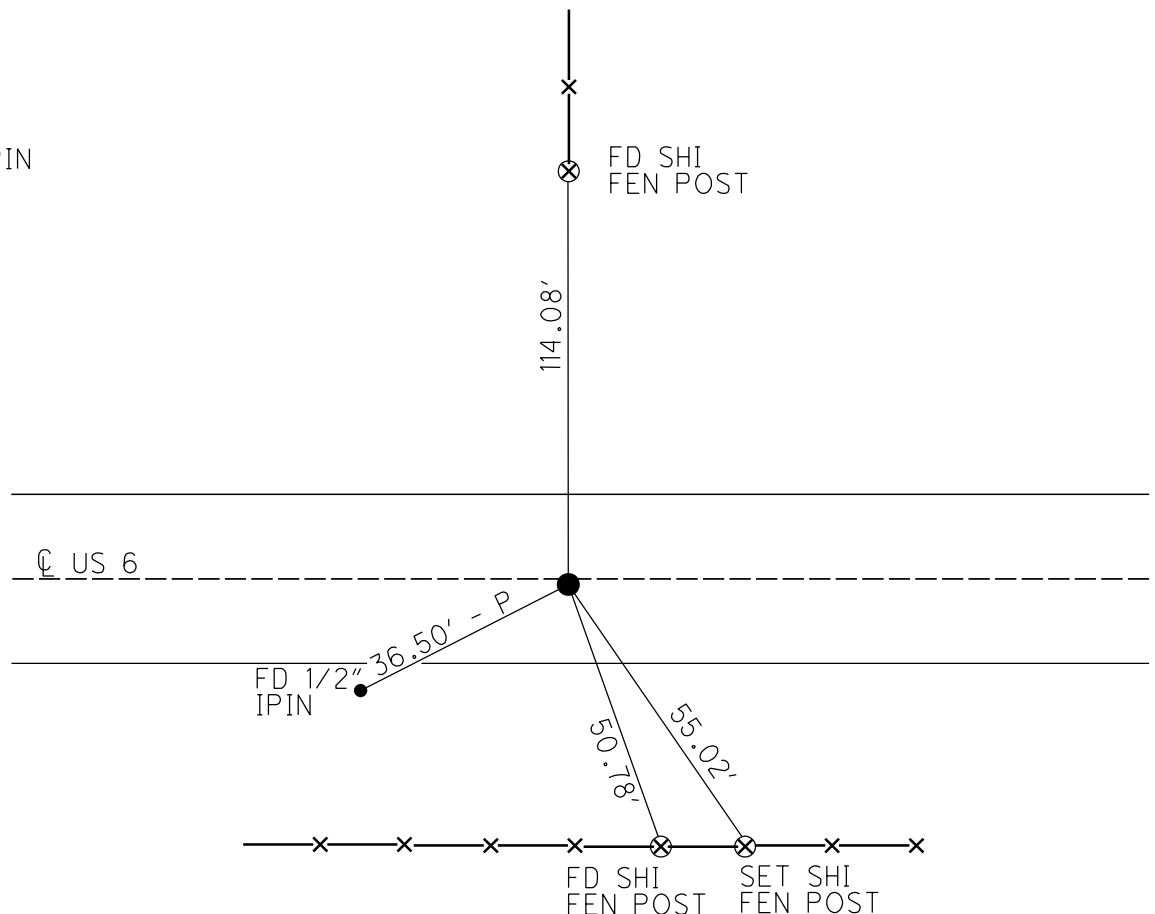

O.D.O.T. DISTRICT 2 SURVEY OFFICE (USE ONLY)

PERSONNEL

REFERENCE NO. 2

SHEET 9 OF 9

NOTES O'DONNELL

DATE 2/14/18

ROUTE US 6

H.C.

WEATHER FAIR

COUNTY HENRY

R.C.

TEMP. 33°

TOWNSHIP RIDGEVILLE

SECTION 31

DWG BY RHOADES PID 95792

T 6 N R 5 E

TYPE MONUMENT P.K./WASHER

~~ON SURFACE~~ - BELOW ON

OFFSET CL PAVEMENT ON LT : RT

12.4' TO RT EDGE PAVEMENT


STATION: 19+87.49

HORIZ.DATUM: NAD83 2011


GEOID: NAVD88 2012A

GRID: NORTHING: 652146.153

EASTING: 1465559.773

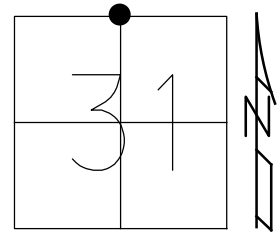

RECORD: P.O.T.
STA. 19+87.65
FD SM.R.R.SPIKE
4/14/97, CL
SET P.K./WASHER
6/26/97, CL
FD P.K./WASHER
HENREF2
2/14/18, JFO

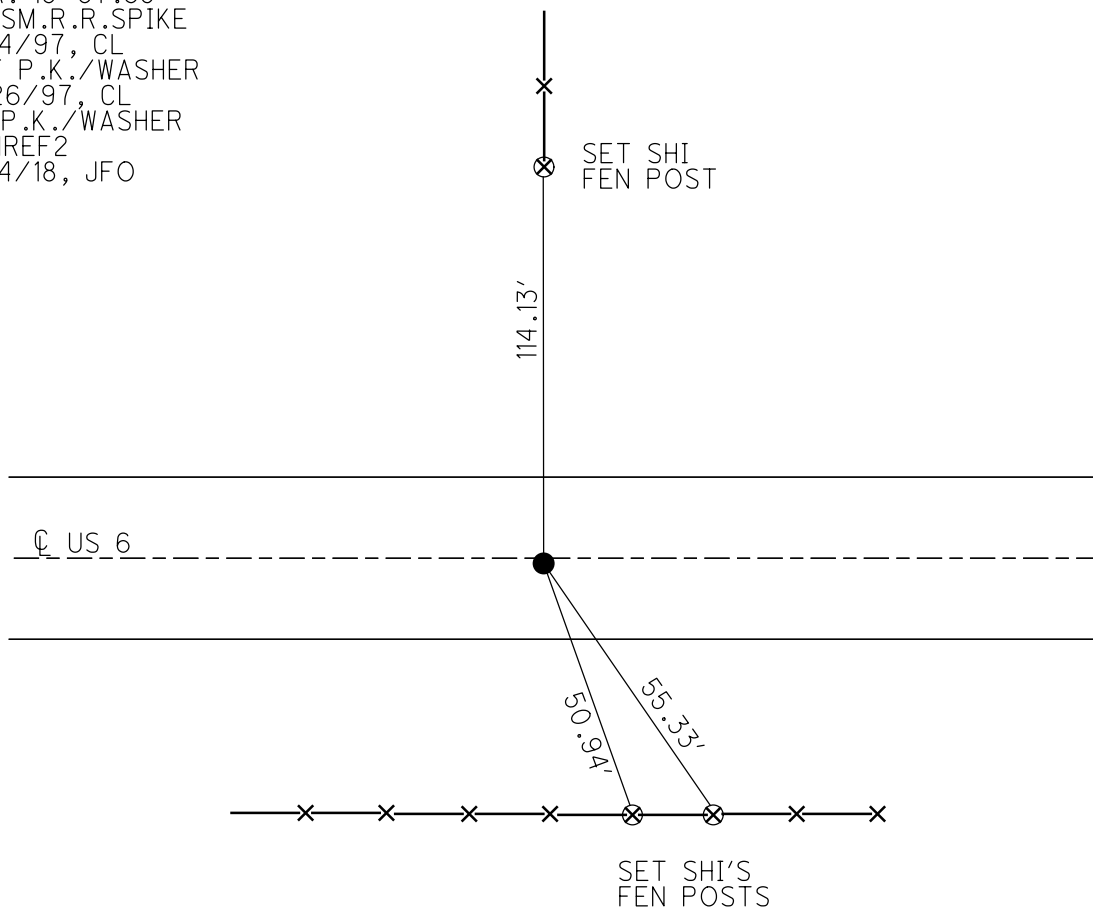

O.D.O.T. DISTRICT 2 SURVEY OFFICE

PERSONNEL

REFERENCE NO. 2

SHEET 2 OF 7

NOTES CORDES

H.C. LOENCKE

R.C. MOSEK

HUSS

DATE 4-14-97

WEATHER SUN

TEMP. +9°C

ROUTE 6

COUNTY HENRY

TOWNSHIP RIDGEVILLE

SECTION 30

T. 6 N. R. 5 E.

Set P.K. / WASHER
6-26-97


TYPE MONUMENT SM RR SPIKE

ON SURFACE - YES


PAV'T. - YES

3.78m TO RT EDGE PAVEMENT

S.L.M. 0+607

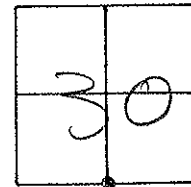

REC. POT
19+87.65

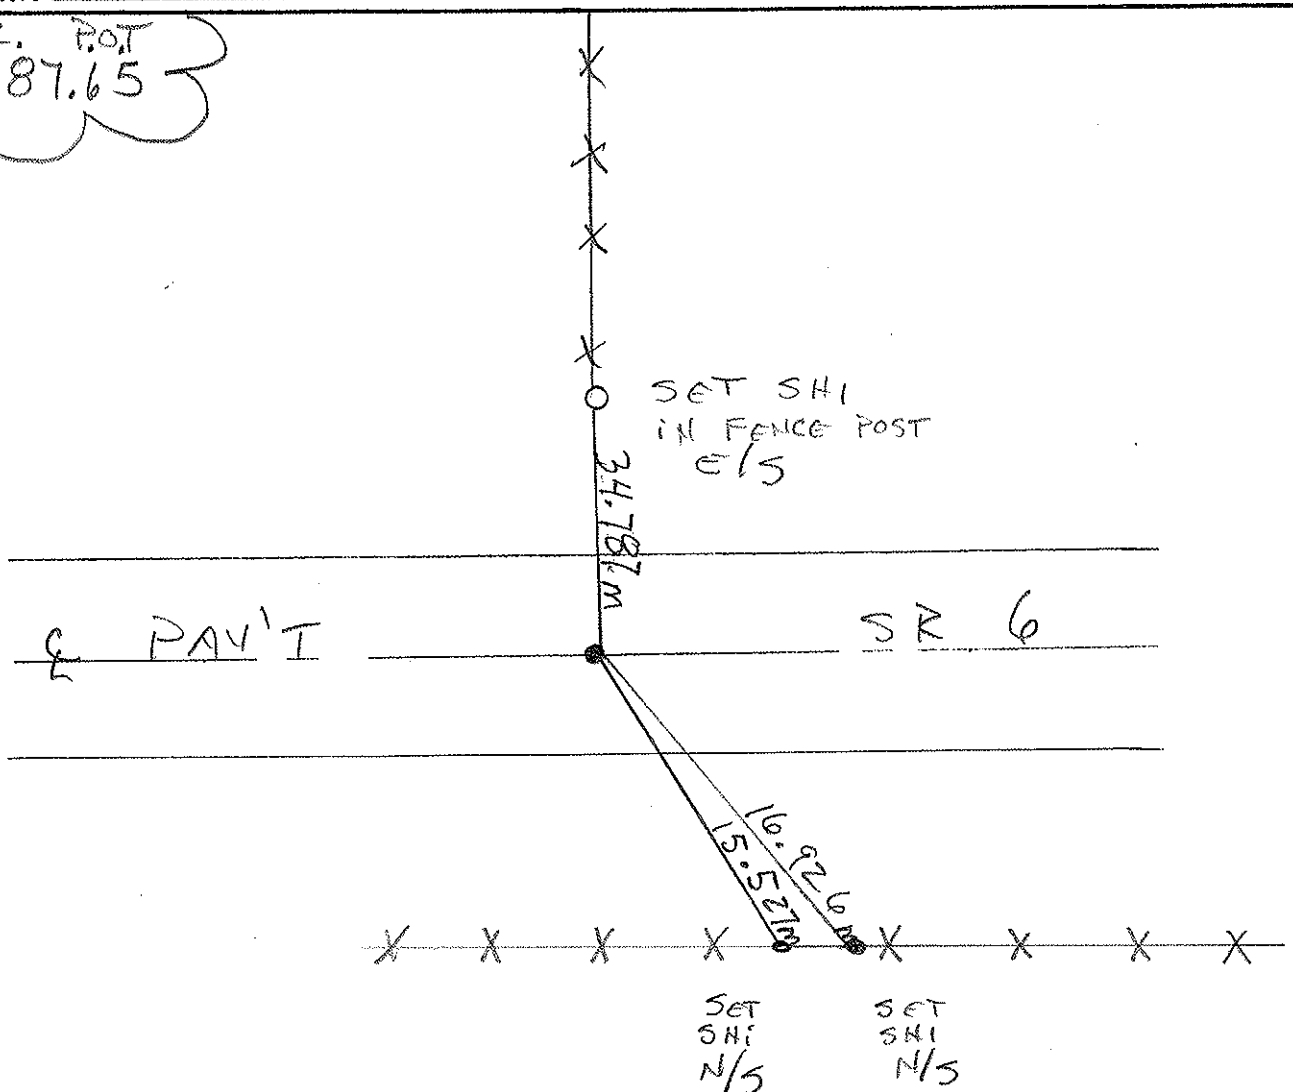

O.D.O.T. DISTRICT 2 SURVEY OFFICE

PERSONNEL

REFERENCE NO. 2

SHEET OF

NOTES Hoffman R.C.

H.C. BARNHISEL

R.C.

DATE 5-6-85

WEATHER Cloudy

TEMP. 65°

ROUTE US 6

COUNTY HENRY

TOWNSHIP RIDGEVILLE

SECTION 30

T 6 N R 5 E


TYPE MONUMENT R.R. SPIKE Set Small R.R. spike

ON SURFACE - BELOW 2" 6-13-85 SCUL

LEFT- & PAV'T. - RIGHT on &


12' TO RT. EDGE PAVEMENT

S.L.M. 19+88

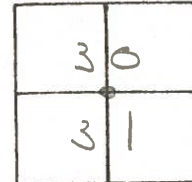

P.O.T. 19+87.65

$\Delta = 0^{\circ}00'$

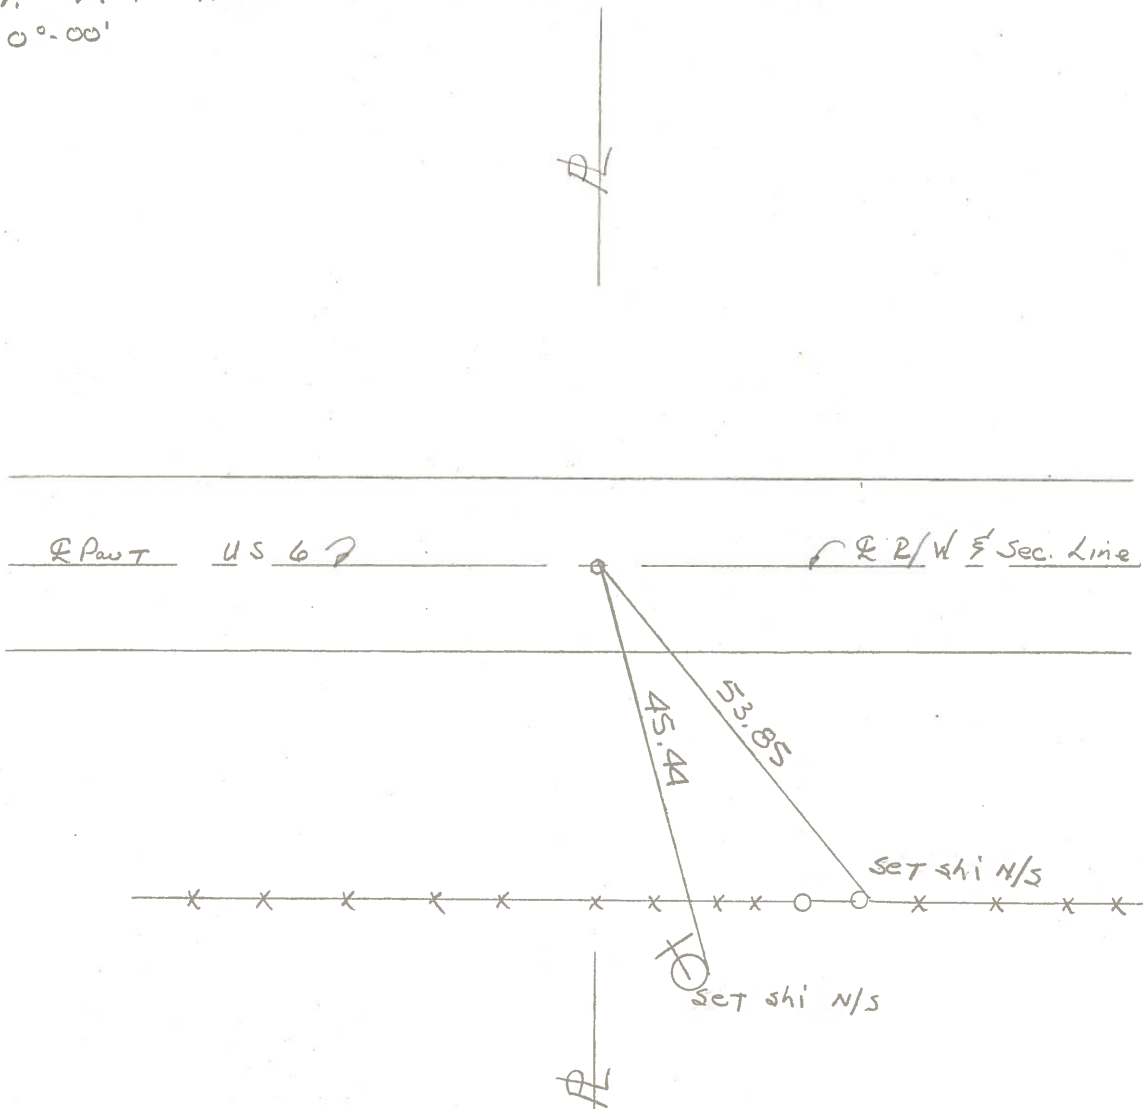

DATE 5 July 1974

WEATHER

TEMP.....

JOB NO. _____



✓ 9/11/1951

WEATHER

TEMP.

JOB NO.

RIGHT

X-County H. Tension
line
Tower

Shiner
S.W. side P.P.

Shiner
N.W. side 10" Maple

Shiner
N.W. side 8" Maple

Shiner S.W. side P.P.

R.M.

Angles and Distances (in red ink):

- 30.24'
- 61.52'
- 61.70'
- 67.91'
- 67.73'
- 26.05'
- 30.34'

Hill

Tacked Hub in Fence Line

100.13

24.54

22.16

20.27

Shiner S.

Shiner N. side Cor. Post.

19.52 side Cor. Post.

SE. Cor. W. Conc.
Culvert Railing.

411.04

211.3

98.45

Spk (head)
N. side P.P.

SW. Cor. E. Conc.
Culvert Railing

~~Tacked Hub.~~
R R Spk

~~Near side Iron Cor. Post~~
1' above ground.