

O.D.O.T. DISTRICT 2 SURVEY OFFICE (USE ONLY)

PERSONNEL

REFERENCE NO. 7

SHEET OF

NOTES RHODES

DATE 7/7/21

ROUTE US 6

H.C. AUBLE

WEATHER FAIR

COUNTY HENRY

R.C. NIESE

TEMP. 77°

TOWNSHIP RIDGEVILLE

DWG BY BARRIERE

PID 101274

SECTION 38

T 6 N R 5 E

TYPE MONUMENT MONBOX W/ 1" IPIN

ON SURFACE - BELOW ON

OFFSET $\varnothing$ PAVEMENT ON LT : RT

 TO EDGE PAVEMENT

STATION: 151+67

HORZ.DATUM: NAD83 2011


GEOID: 18

GRID: NORTHING: 651890.506

EASTING: 1478757.983


LDP: NORTHING:

EASTING:

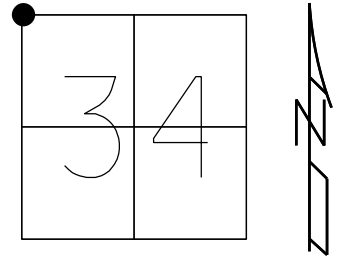

RECORD: P.I.
STA 151+92.72
 $\Delta = 0^\circ 02' \text{ LT}$

FD SM R.R. SPIKE
4/14/97, BWC
SET P.K./WASHER
7/1/97
FD MONBOX W/ 1" IPIN
NEWREF7
12/12/22, TDN

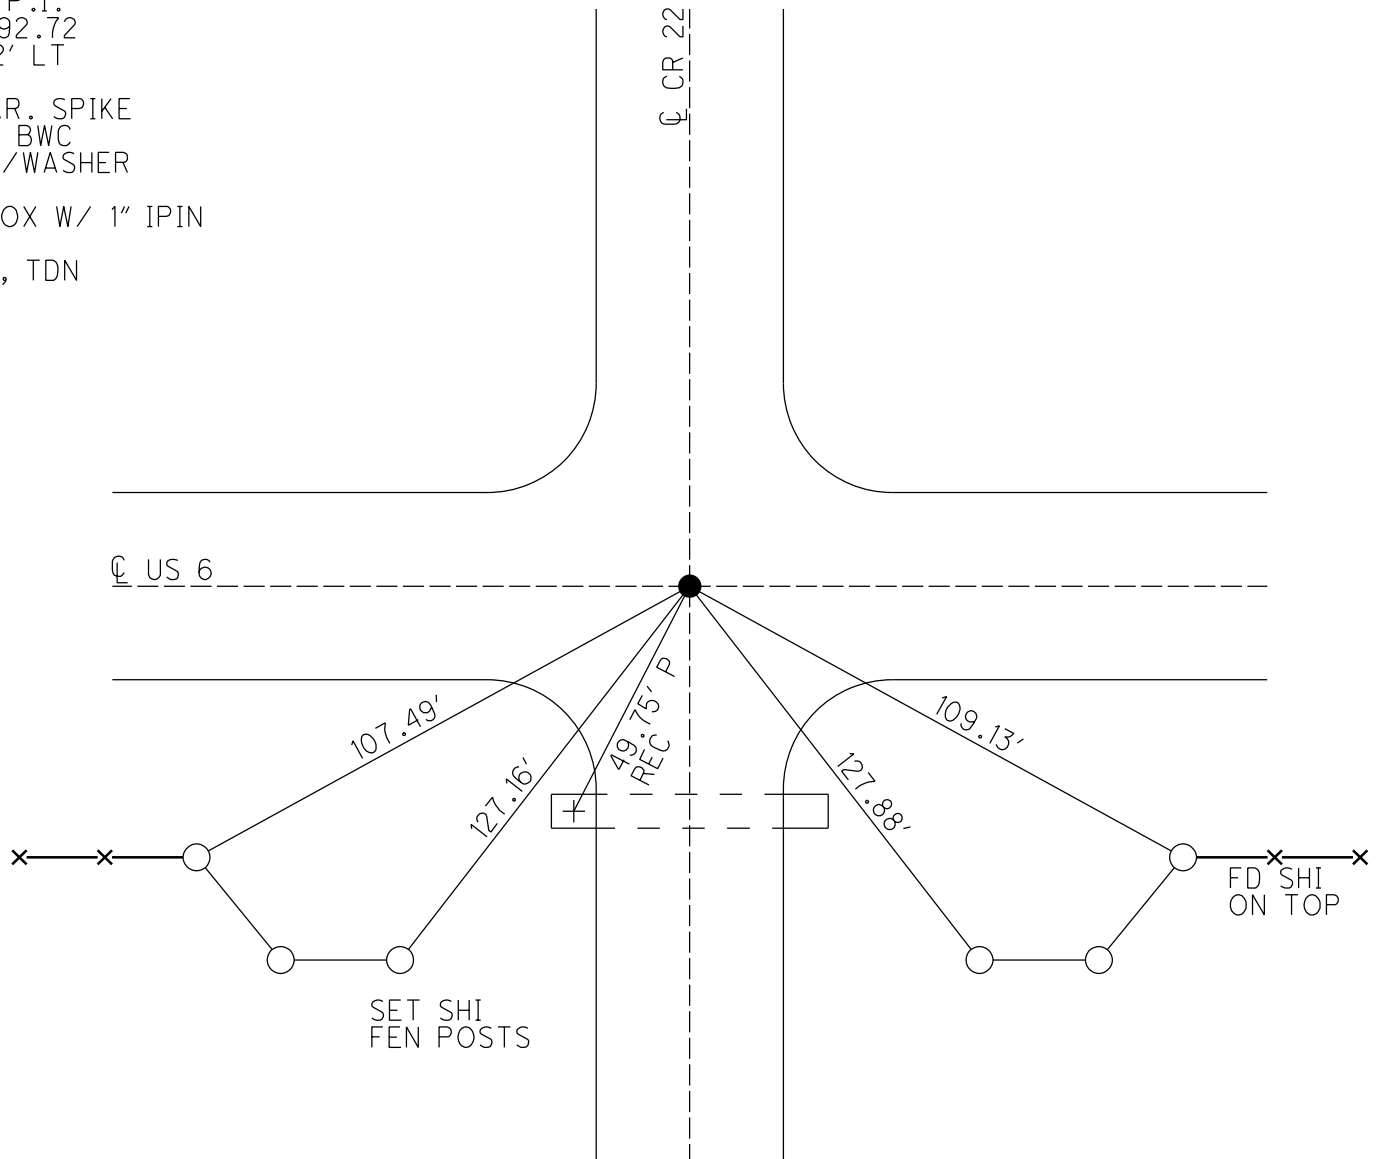

O.D.O.T. DISTRICT 2 SURVEY OFFICE (USE ONLY)

PERSONNEL

REFERENCE NO. 7

SHEET 7 OF 7

NOTES CORDES

DATE 4/14/97

ROUTE US 6

H.C. MOSER

WEATHER SUN

COUNTY HENRY

R.C. HUSS

TEMP. 32°

TOWNSHIP RIDGEVILLE

LOEHRKE

SECTION 34

DWG BY NIESE

PID _____

T 6 N R 5 E

TYPE MONUMENT SM.R.R.SPIKE

ON SURFACE - ~~BELOW~~ ON

OFFSET ℄ PAVEMENT ON LT : RT

12.4' TO RT EDGE PAVEMENT


STATION: 151+67

HORIZ.DATUM: _____


GEOID: _____

GRID: NORTHING: _____

EASTING: _____

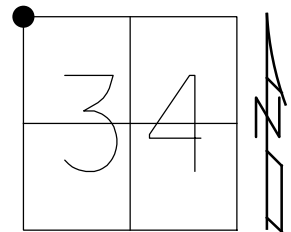

RECORD: P.I.
STA 151+92.72
 $\Delta = 0^\circ 02' \text{ LT}$
FD SM R.R. SPIKE
4/14/97, BWC
SET P.K./WASHER
7/1/97

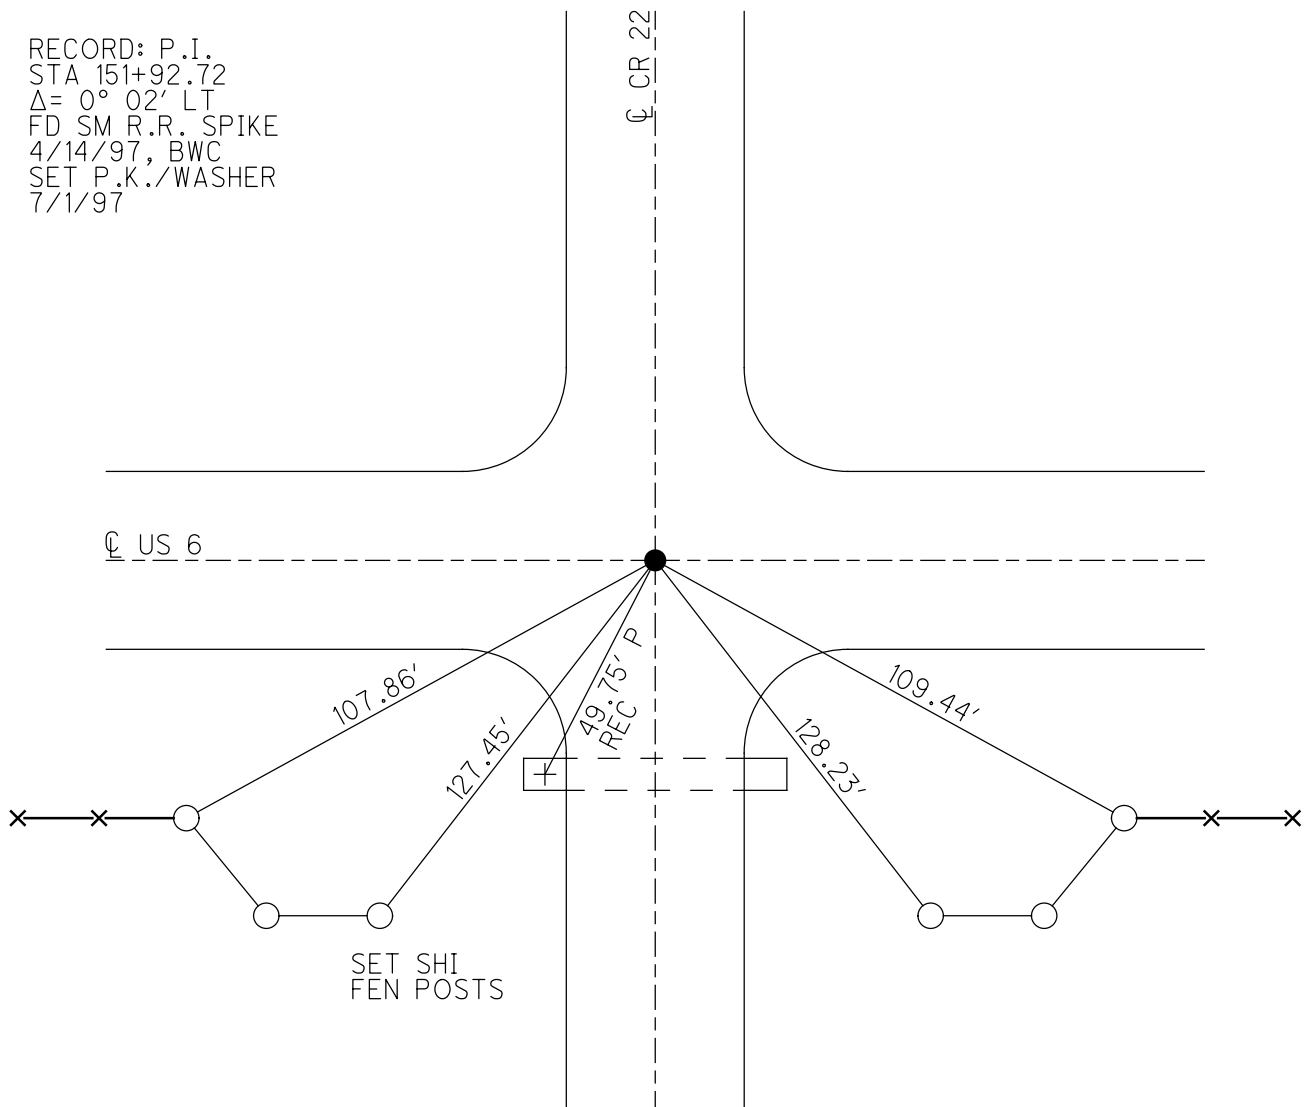

O.D.O.T. DISTRICT 2 SURVEY OFFICE

PERSONNEL

REFERENCE NO. 7

SHEET 6 OF 7

NOTES COEDS

H.C. MOSER

R.C. HUSS

F LOEHRKE

DATE 4-14-97

WEATHER SUN

TEMP. +4°C

Set PK, WASJEF
7-1-97

ROUTE 6

COUNTY HENRY

TOWNSHIP RIDGEMILL

SECTION 27

T 6 N R 5 E


TYPE MONUMENT 3M ZR SPIKE

ON SURFACE - ~~BELOW~~ YES


~~LEFT~~ - & PAV'T. - ~~RIGHT~~ YES

3.78m TO RT EDGE PAVEMENT

S.L.M. 44623 151+67 (2.87)

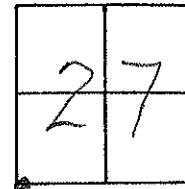

RECORD P.T.
STA: 151+92.72
Δ 0°-02' LT

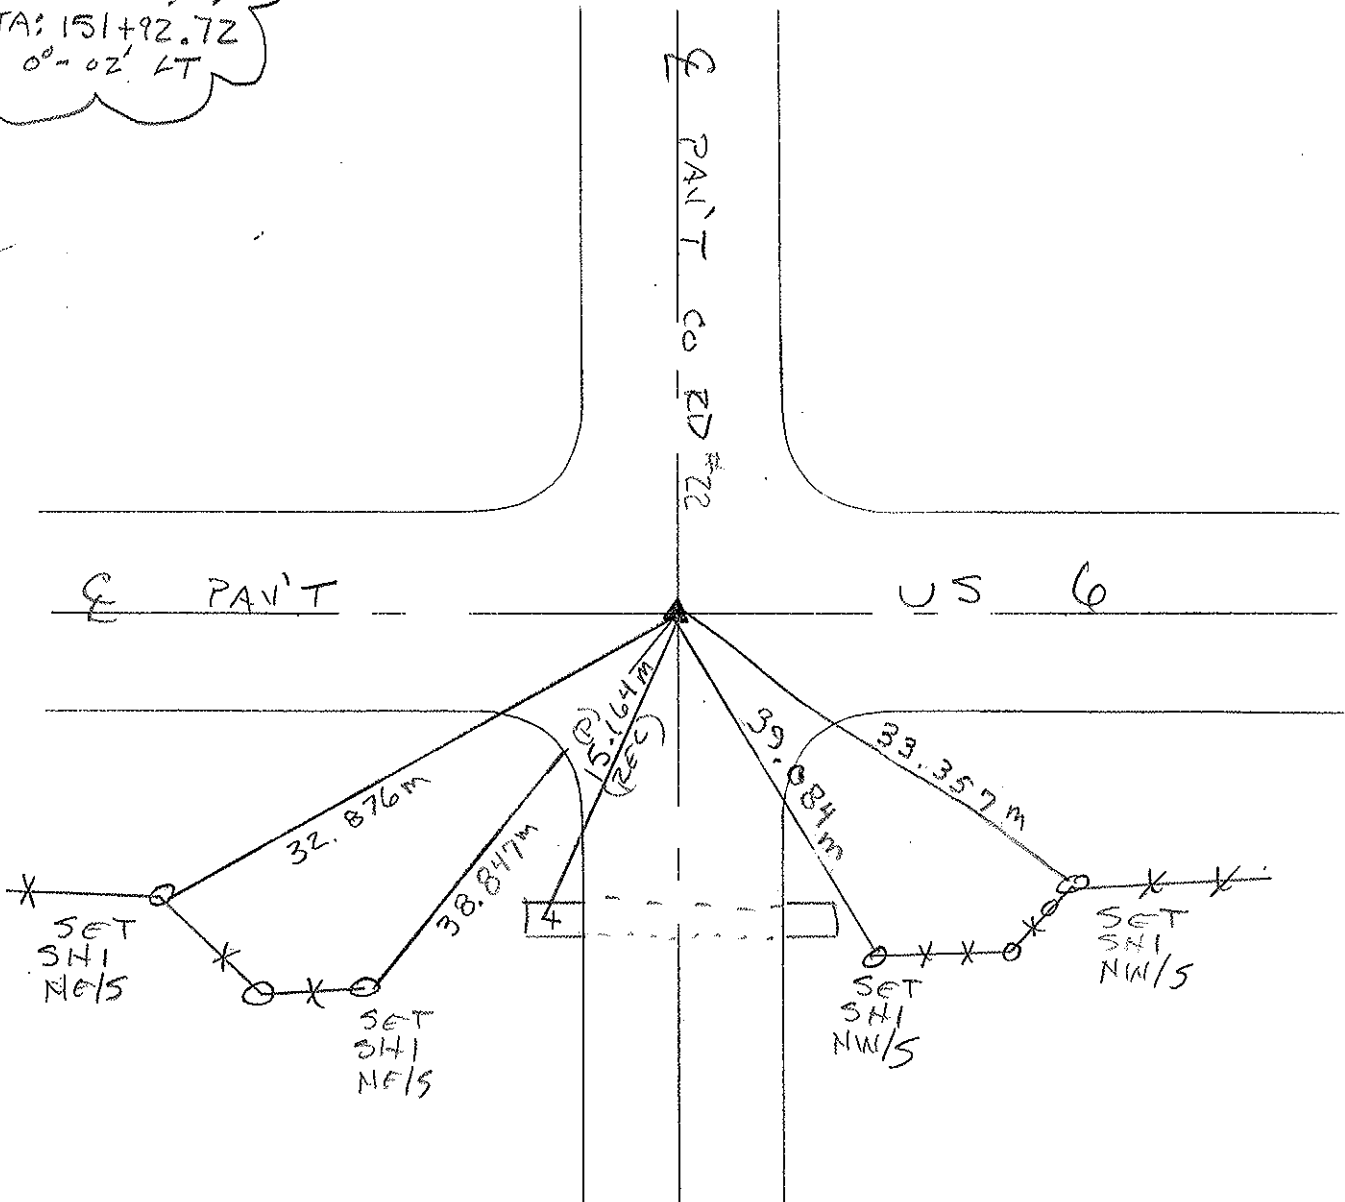

O.D.O.T. DISTRICT 2 SURVEY OFFICE

PERSONNEL

REFERENCE NO. 7

SHEET OF

NOTES Hoffman

H.C. LOEHKE

R.C. BARNHISEL

DATE 5-17-85

WEATHER Cloudy

TEMP. 60°

ROUTE U.S. 6

COUNTY HENRY

TOWNSHIP Ridgelyville

SECTION 27

T6 N R 5 E

TYPE MONUMENT R.R. SPL.

ON SURFACE - BELOW 1 1/2"

LEFT-~~C~~ PAV'T. - RIGHT ON C

12.0 TO RT EDGE PAVEMENT

S.L.M. 151+94


Set small R.R. SPL
6-13-85 SWH

28	27
33	34



P.I. STA 151+92.72

$\Delta = 0^\circ - 02' 24''$ Recorded

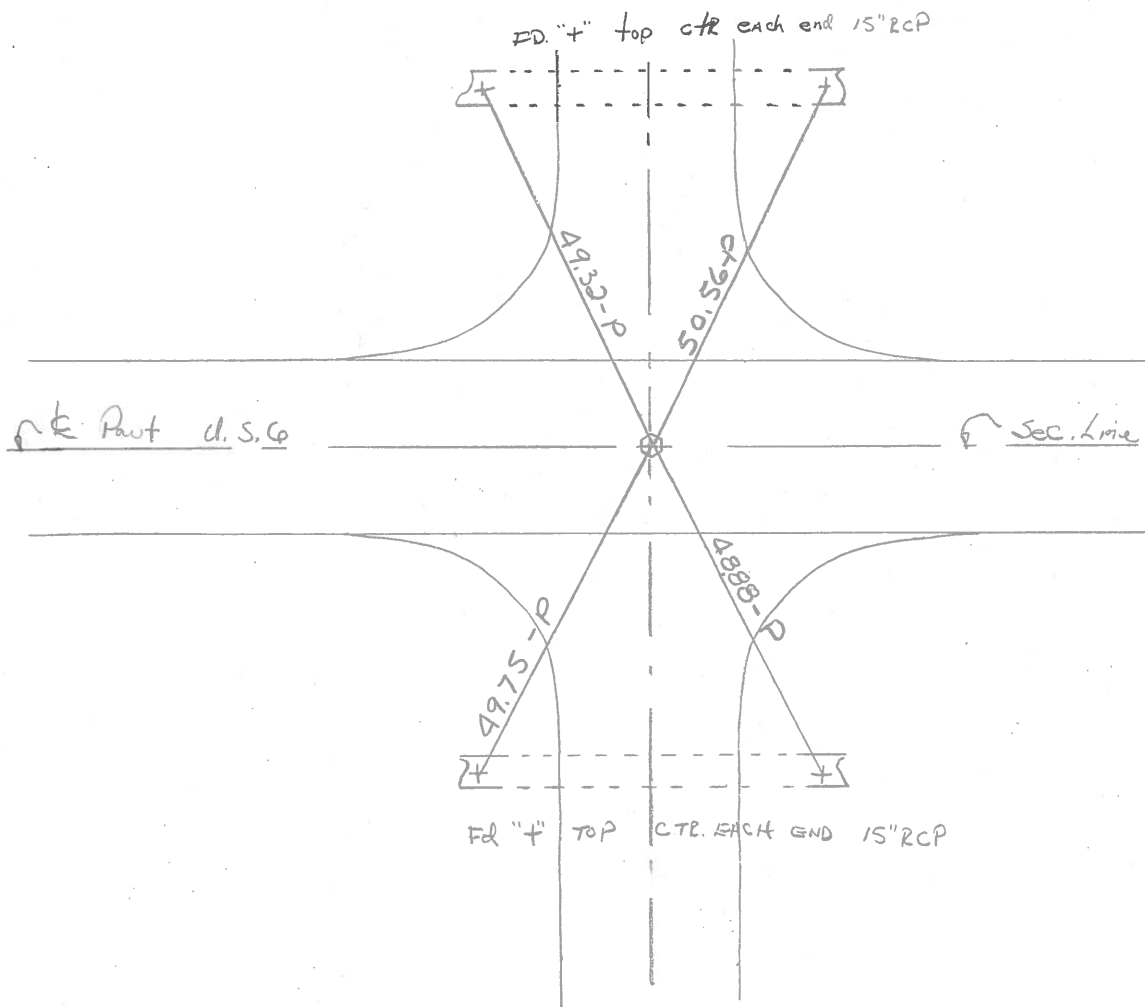

PERSONNEL TITLE PERSONNEL TITLE

Red Beach

COUNTY HENRY

DATE 9 July '74

W. Knappe

S. R. US 6

WEATHER

D. Boyle

SEC Ridgeville Twp.

TEMP



J. Bagdonas

DESCRIPTION

CONTROL

POINTS

JOB NO.

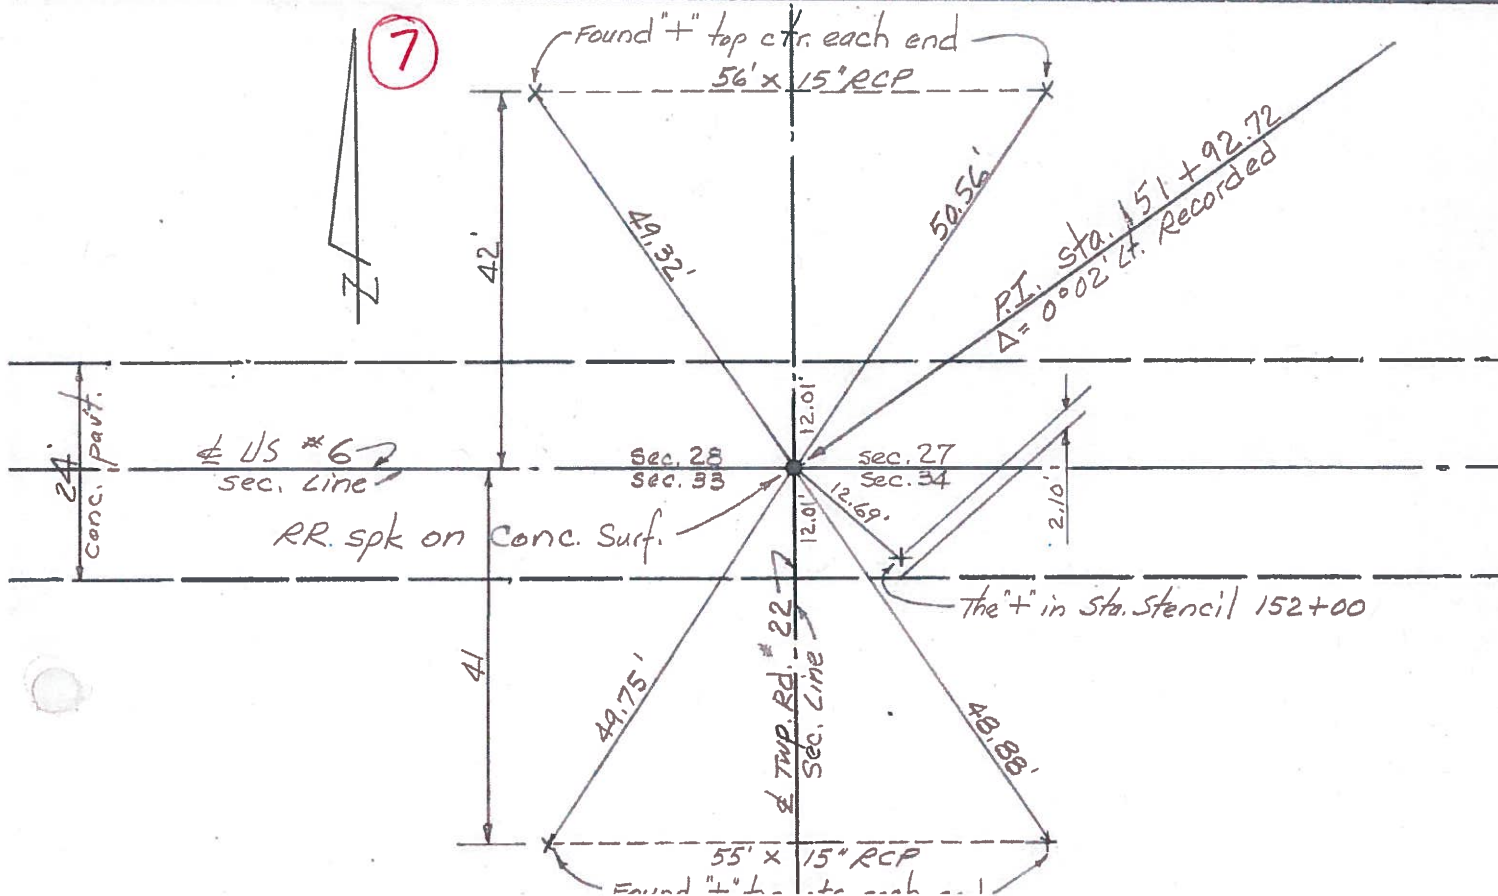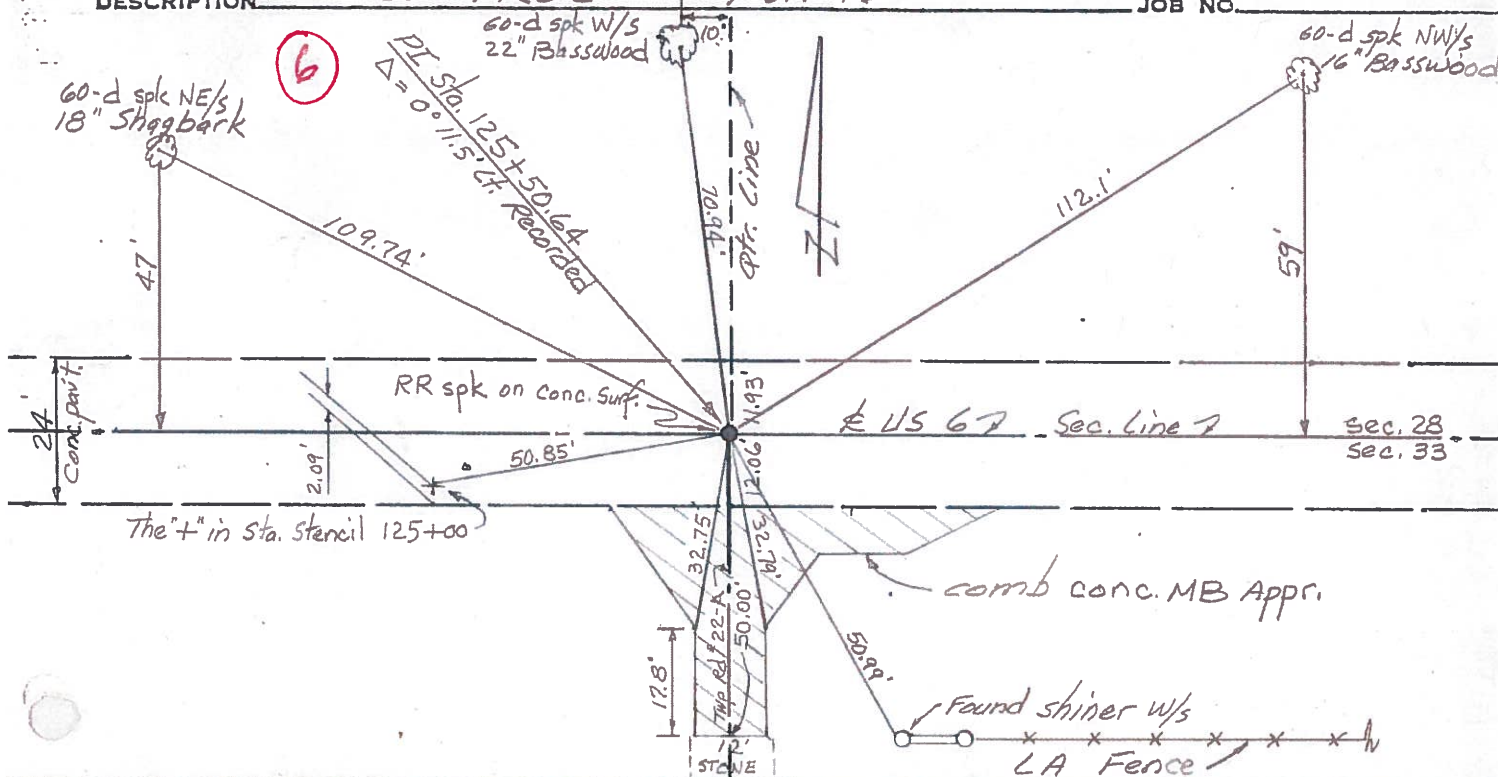

PERSONNEL TITLE PERSONNEL TITLE

COUNTY Henry DATE Jan 1951S. R. 384 WEATHER _____

SEC. _____ TEMP. _____

DESCRIPTION _____ JOB NO. _____

LEFT

CENTER LINE

RIGHT

10/9/56

Sta. 125+50.64

 $L = 0^{\circ} 11' 30''$ Lt

Found Small Stone

Set R.R. Spk

Shiner
S. side 24" Basswood

61.45

Shiner SE
side 20" Maple

47.84

Shiner NE
side TPX-NE Cor.
N. Hdwall.X-S.E. Cor.
S. Hdwall.

10/9/56

Sta. 151+92.72

 $L = 0^{\circ} 02'$ Lt

Found I.P. over Stone

Set Nail & Shi

Near side
Pump 1' from ground.

10/9/56

Sta. 178+49.81

 $L = 0^{\circ} 10'$ LtEstablished Tacked Hub
(from old ties)

Set R.R. Spk.

Tacked
Hub

R.R. Spk.

Shiner NW
side TPShiner N.
side Cor PostIron post sign stk
Top

Tacked Hub

1' W of 1st fence post west.

GONE

Sta 188+56.43

 L

Established R.R. Spk

Face
Gas Pipe
Gas valve

Gone

Conc. R/R Markers

30.05

25.98

149.95

18.00

18.00

Shiner N.E. side
38" LocustNote:
Nail & Shi
8.0' E of P.K.Note: Found Stone on qtr qtr line 316.87 East of R.R. Spk
at Sta 188+56.43. - Stone is 4' south of con post