


O.D.O.T. DISTRICT 2 SURVEY OFFICE (USE ONLY)


PERSONNEL	REFERENCE NO. <u>45</u>	SHEET <u>6</u> OF <u>24</u>	
NOTES	DATE <u>4/24/17</u>	ROUTE <u>US 6</u>	
H.C. <u>RHOADES</u>	WEATHER <u>SUNNY</u>	COUNTY <u>HENRY</u>	
R.C. <u>LEU</u>	TEMP. <u>55°</u>	TOWNSHIP <u>HARRISON</u>	
		SECTION <u>26</u>	
		T <u>5</u> N R <u>7</u> E	

TYPE MONUMENT SM.R.R.SPIKE
~~ON SURFACE~~ - BELOW 4"
 LEFT - ℄ PAV'T - ~~RIGHT~~ 0.7'
 - TO - EDGE PAVEMENT
 S.L.M. 1049+75.72

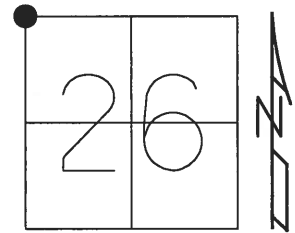

GRID: NORTHING: 624575.8611 EASTING: 1546311.491

RECORD:
 SET SM.R.R.SPIKE
 6-20-88, SWH
 SET MAG/WASHER
 4/21/03, DCH
 FD MAG/WASHER
 REF45
 4-24-17, JLL
 SET MAG/WASHER
 10/26/17, JLL

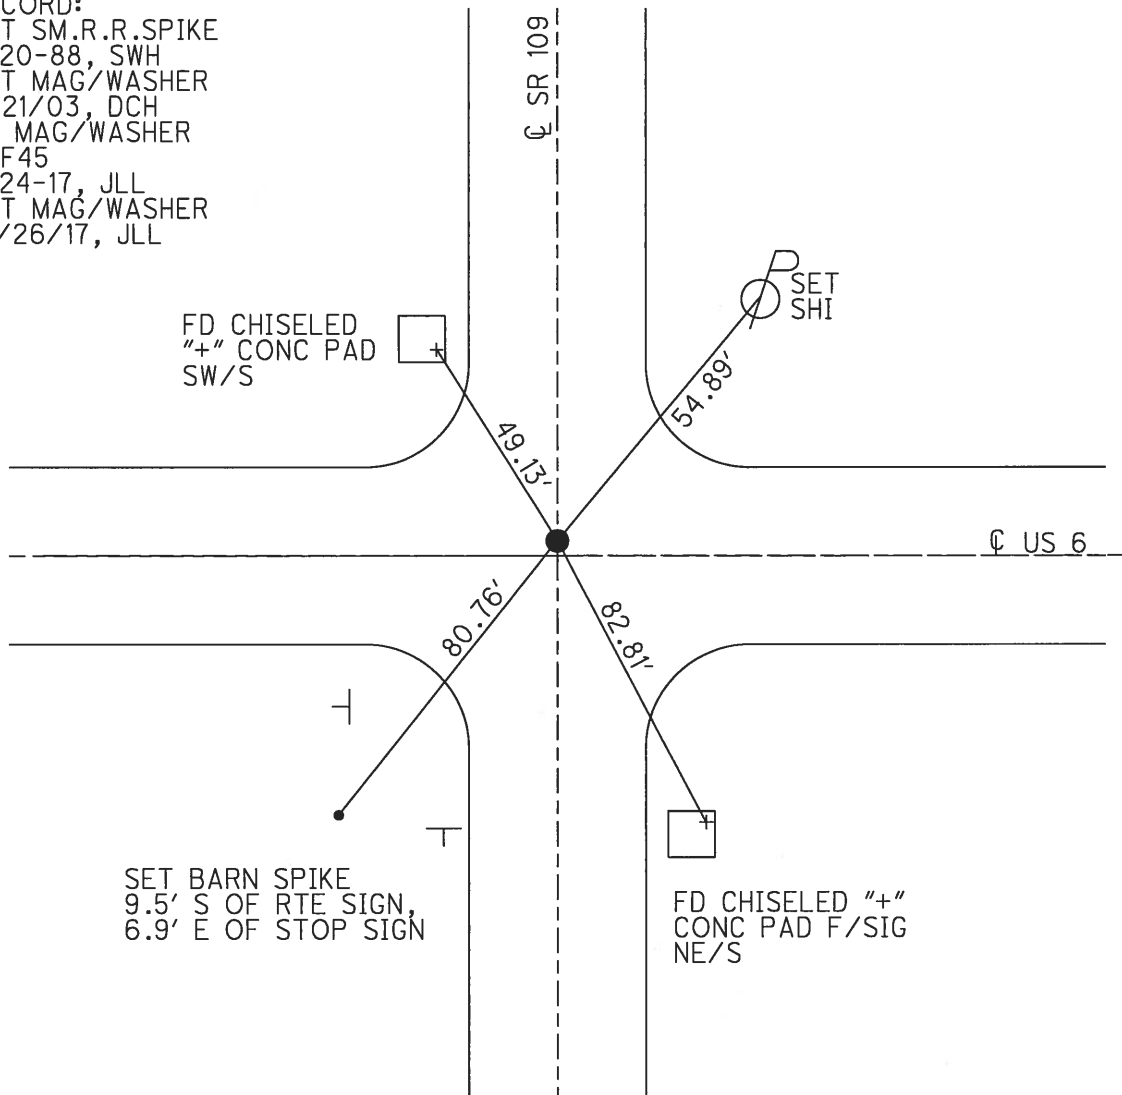

O.D.O.T. DISTRICT 2 SURVEY OFFICE (USE ONLY)

PERSONNEL

REFERENCE NO. 45

SHEET 1 OF 18


NOTES HOMAN
H.C. ROUSOS
R.C. BEAUMONT
CHLEBECK

DATE 7/18/02
WEATHER SUNNY
TEMP. 90°

ROUTE US 6
COUNTY HENRY
TOWNSHIP HARRISON
SECTION 26
T 5 N R 7 E


TYPE MONUMENT SM.R.R.SPIKE
ON SURFACE - ~~BELOW~~ ON
~~LEFT~~ - ℄ PAV'T - RIGHT 4.4'
- TO - EDGE PAVEMENT
S.L.M. 1051+77.6

GRID: NORTHING: _____ EASTING: _____

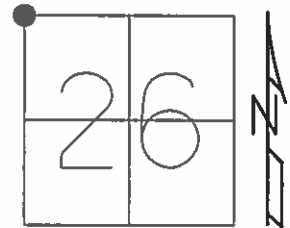

RECORD:
SET SM RR SPIKE
6-20-88, SWH

SET MAG/WASHER
4/21/03, DCH

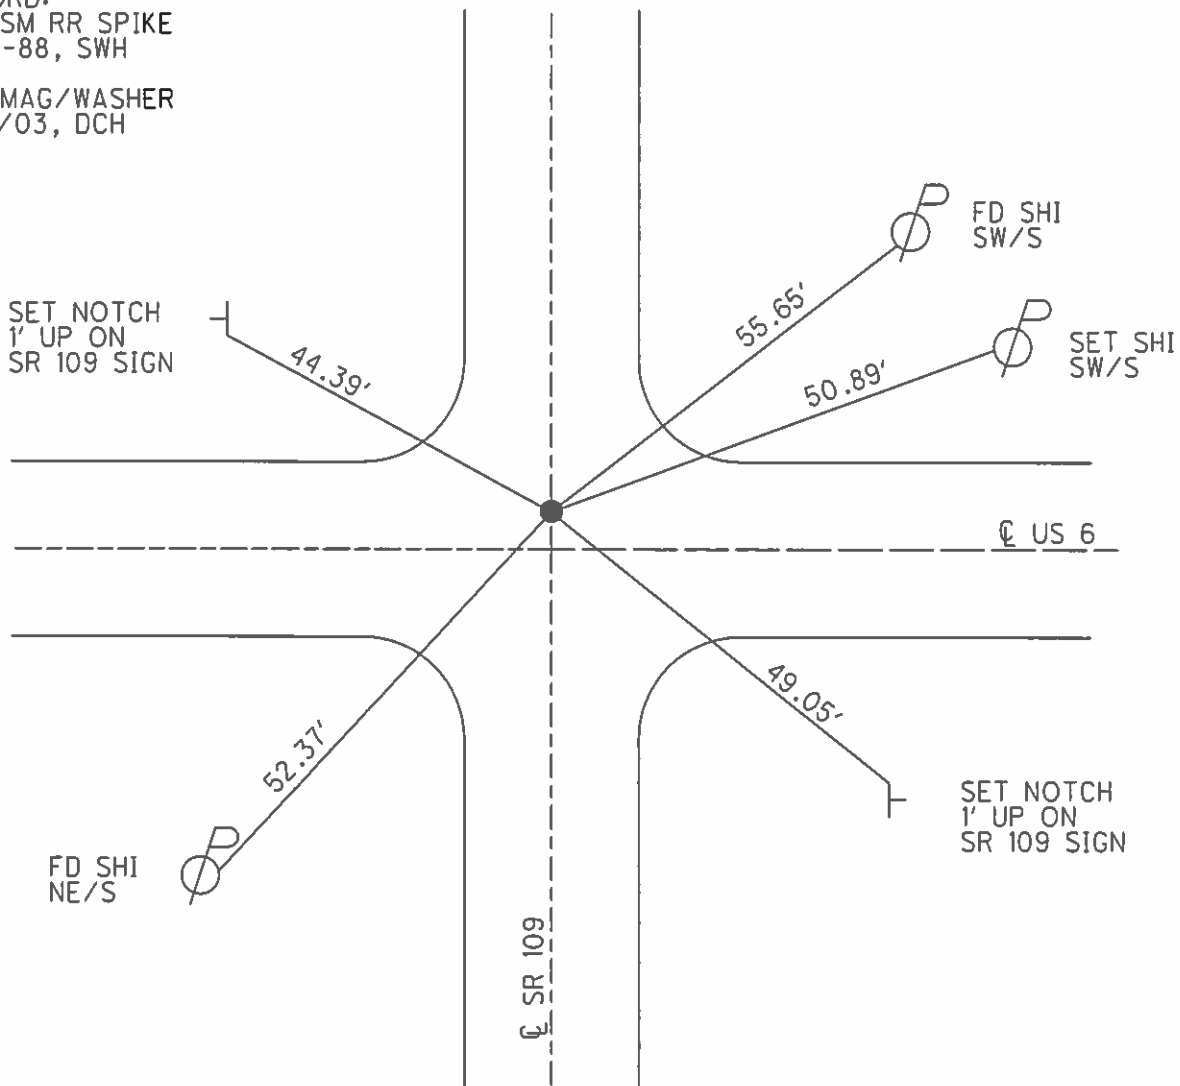

Resurfaced 2002 / 2003

O.D.O.T. DISTRICT 2 SURVEY OFFICE

PERSONNEL

REFERENCE NO. 45

SHEET 1 OF

NOTES HOFFMAN

H.C. BARNARD

R.C. LOSHKES

DATE 4-8-88

WEATHER CLEAR

TEMP. 40°

ROUTE US 6

COUNTY HENRY

TOWNSHIP HARRISON

SECTION 26

T.S. N R. 7 E

TYPE MONUMENT P.K. / WASHER


ON SURFACE -BELOW YES

LEFT-& PAV'T. -RIGHT 1.0'


TO EDGE PAVEMENT ON & Pavt SR 109

S.L.M. US 6 = 937 + 20

Set small RR spike
6-20-88 SWA

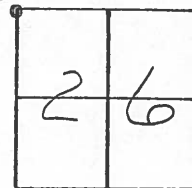

1051+77.6

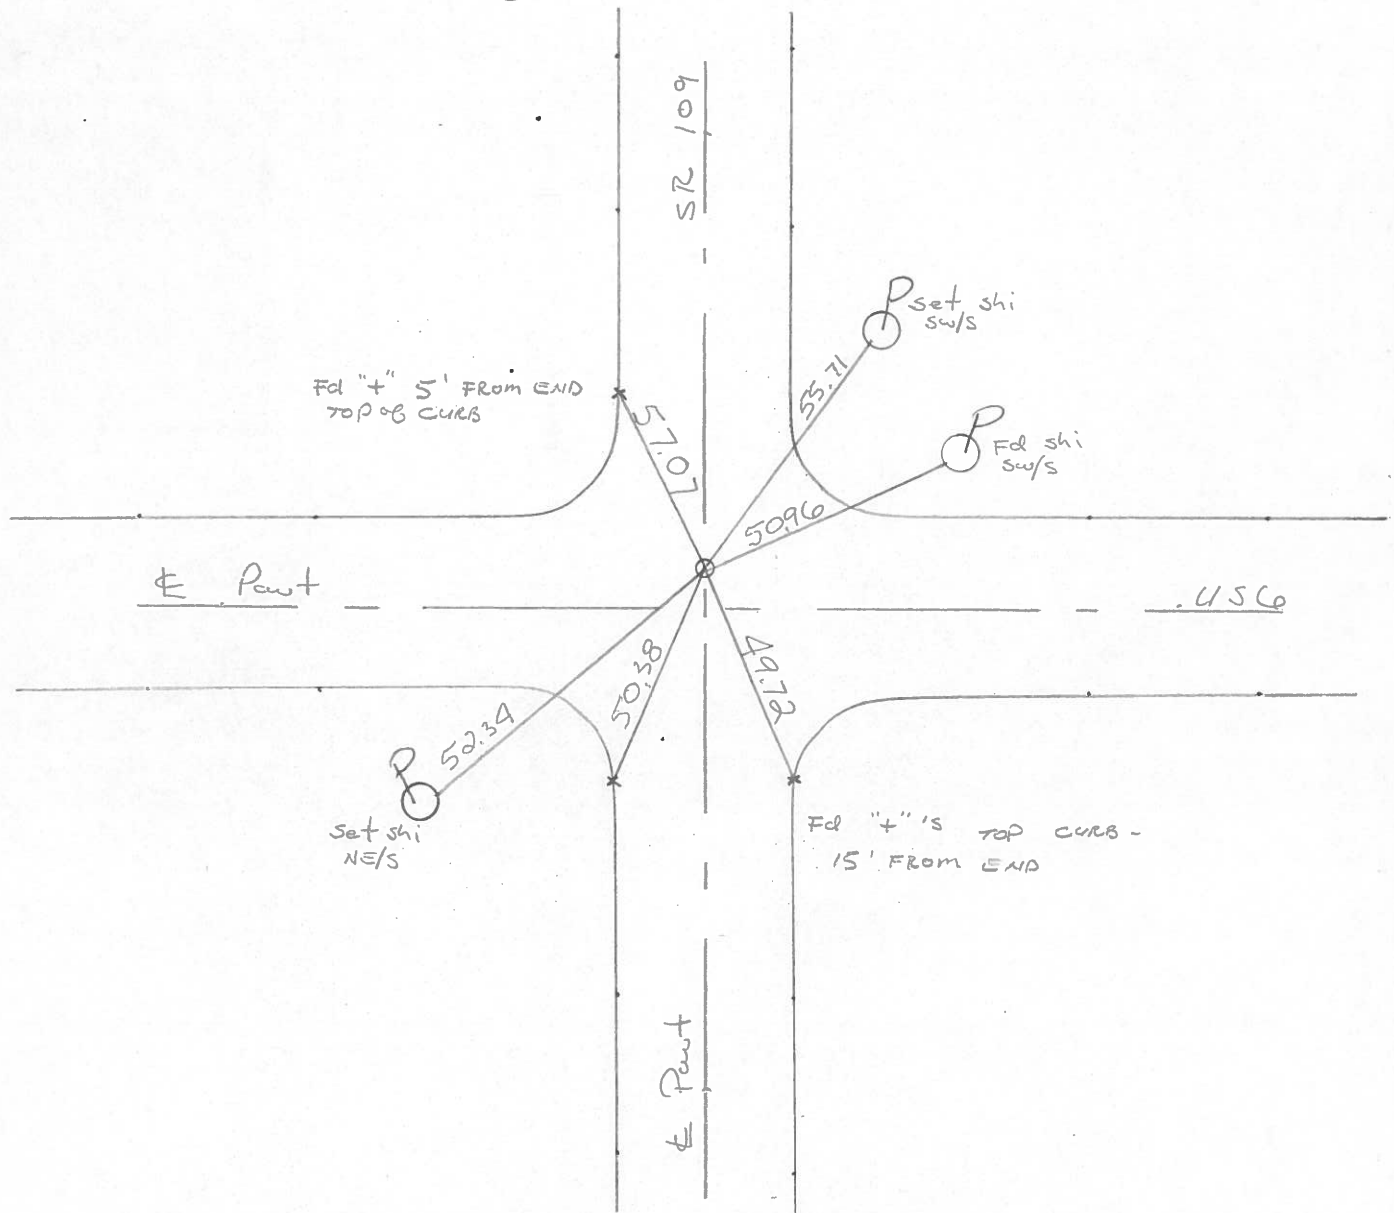

Q.D.O.T. DISTRICT 2 SURVEY OFFICE

SHEET _____ OF _____

County HENRY S.R. 109 & U.S. 6

Township HARRISON

Section 26

T5N, R7E

Personnel HOFFMAN

#30 - SR 109

LOSHREE

#45 - US 6


HOUSEHOLDER R.C.

BACHMEL H.C.

Date 3-19-84

Weather OVERCAST

Temp. +30°

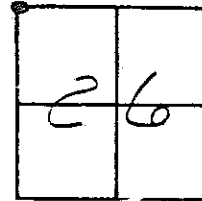


Fd P.K. Nail @ Surface

ON & PAUT SR 109

1.0' N. of & PAUT US 6

SR 109 SLM = 743 + 95

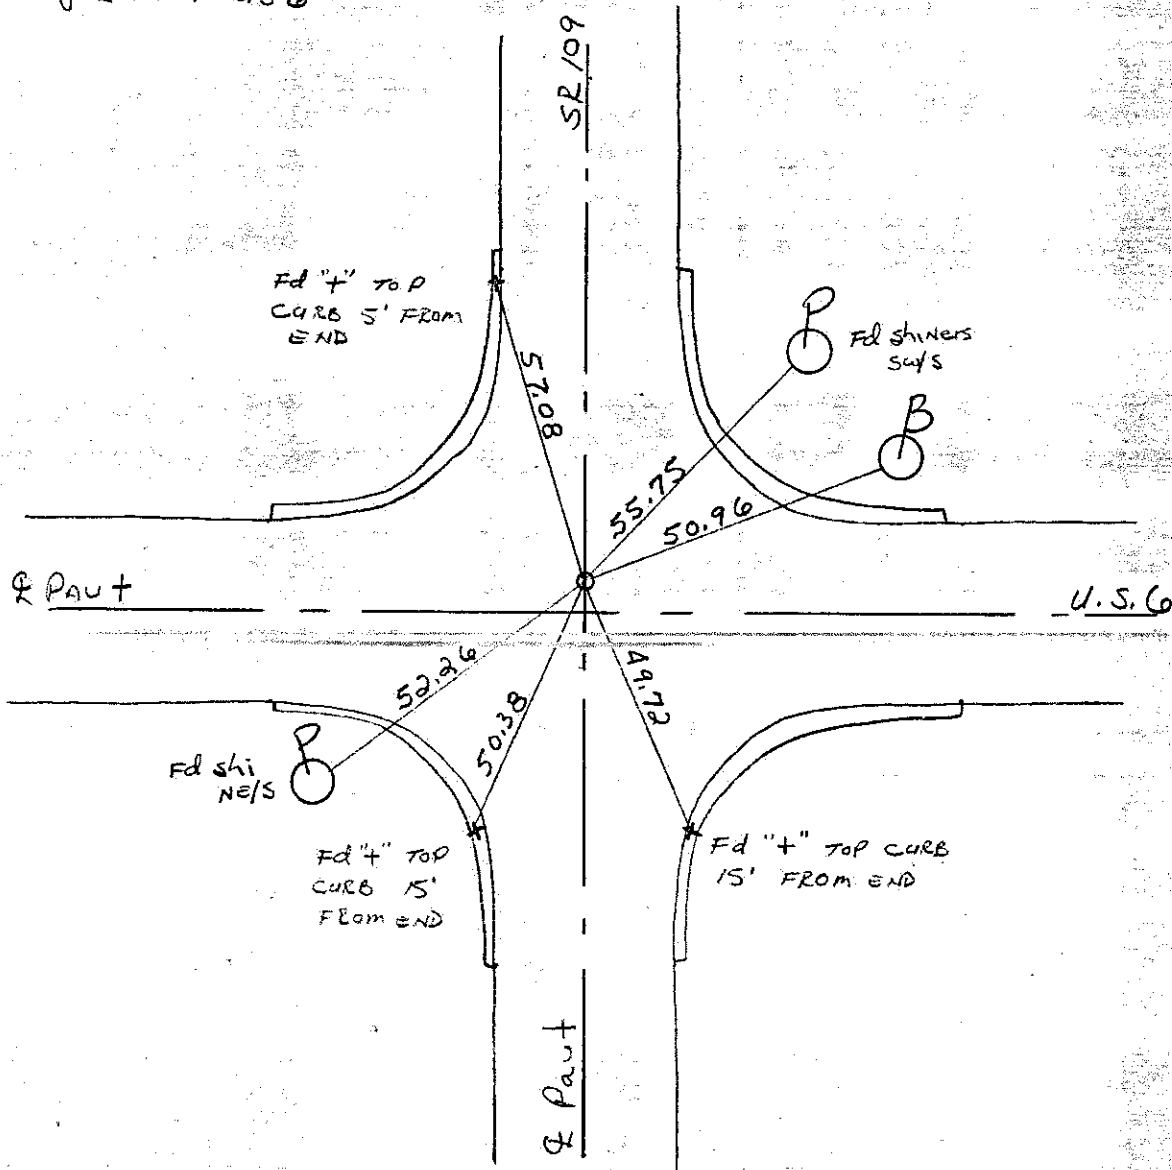

SHEET NO.

PERSONNEL

TITLE

PERSONNEL

TITLE

BURNSIDE

COUNTY.

HENRY

DATE _____

6-1-71

SHAW

E.I.T.

~~S. R.~~

U.S. #6

WEATHER

Cloudy

SEC.

TEMP.

 $+ 72^\circ$

DESCRIPTION

BEGIN POINT CHECK TO HENRY-WOOD CO. LINE

JOB NO

LEFT

CENTER LINE

RIGHT

45

" + Top CURB
CTR. RAD.

BRASS MON
2" DEEP

S. R.

109

N.W. COR. SEC. 26
HARRISON TWP.

Spt. E. Side

PERSONNEL

TITLE

PERSONNEL

TITLE

COUNTY.

DATE _____

S. R.

WEATHER

SEC.

TEMP


DESCRIPTION.

LEFT

CENTER LINE

RIGHT


JOB NO.

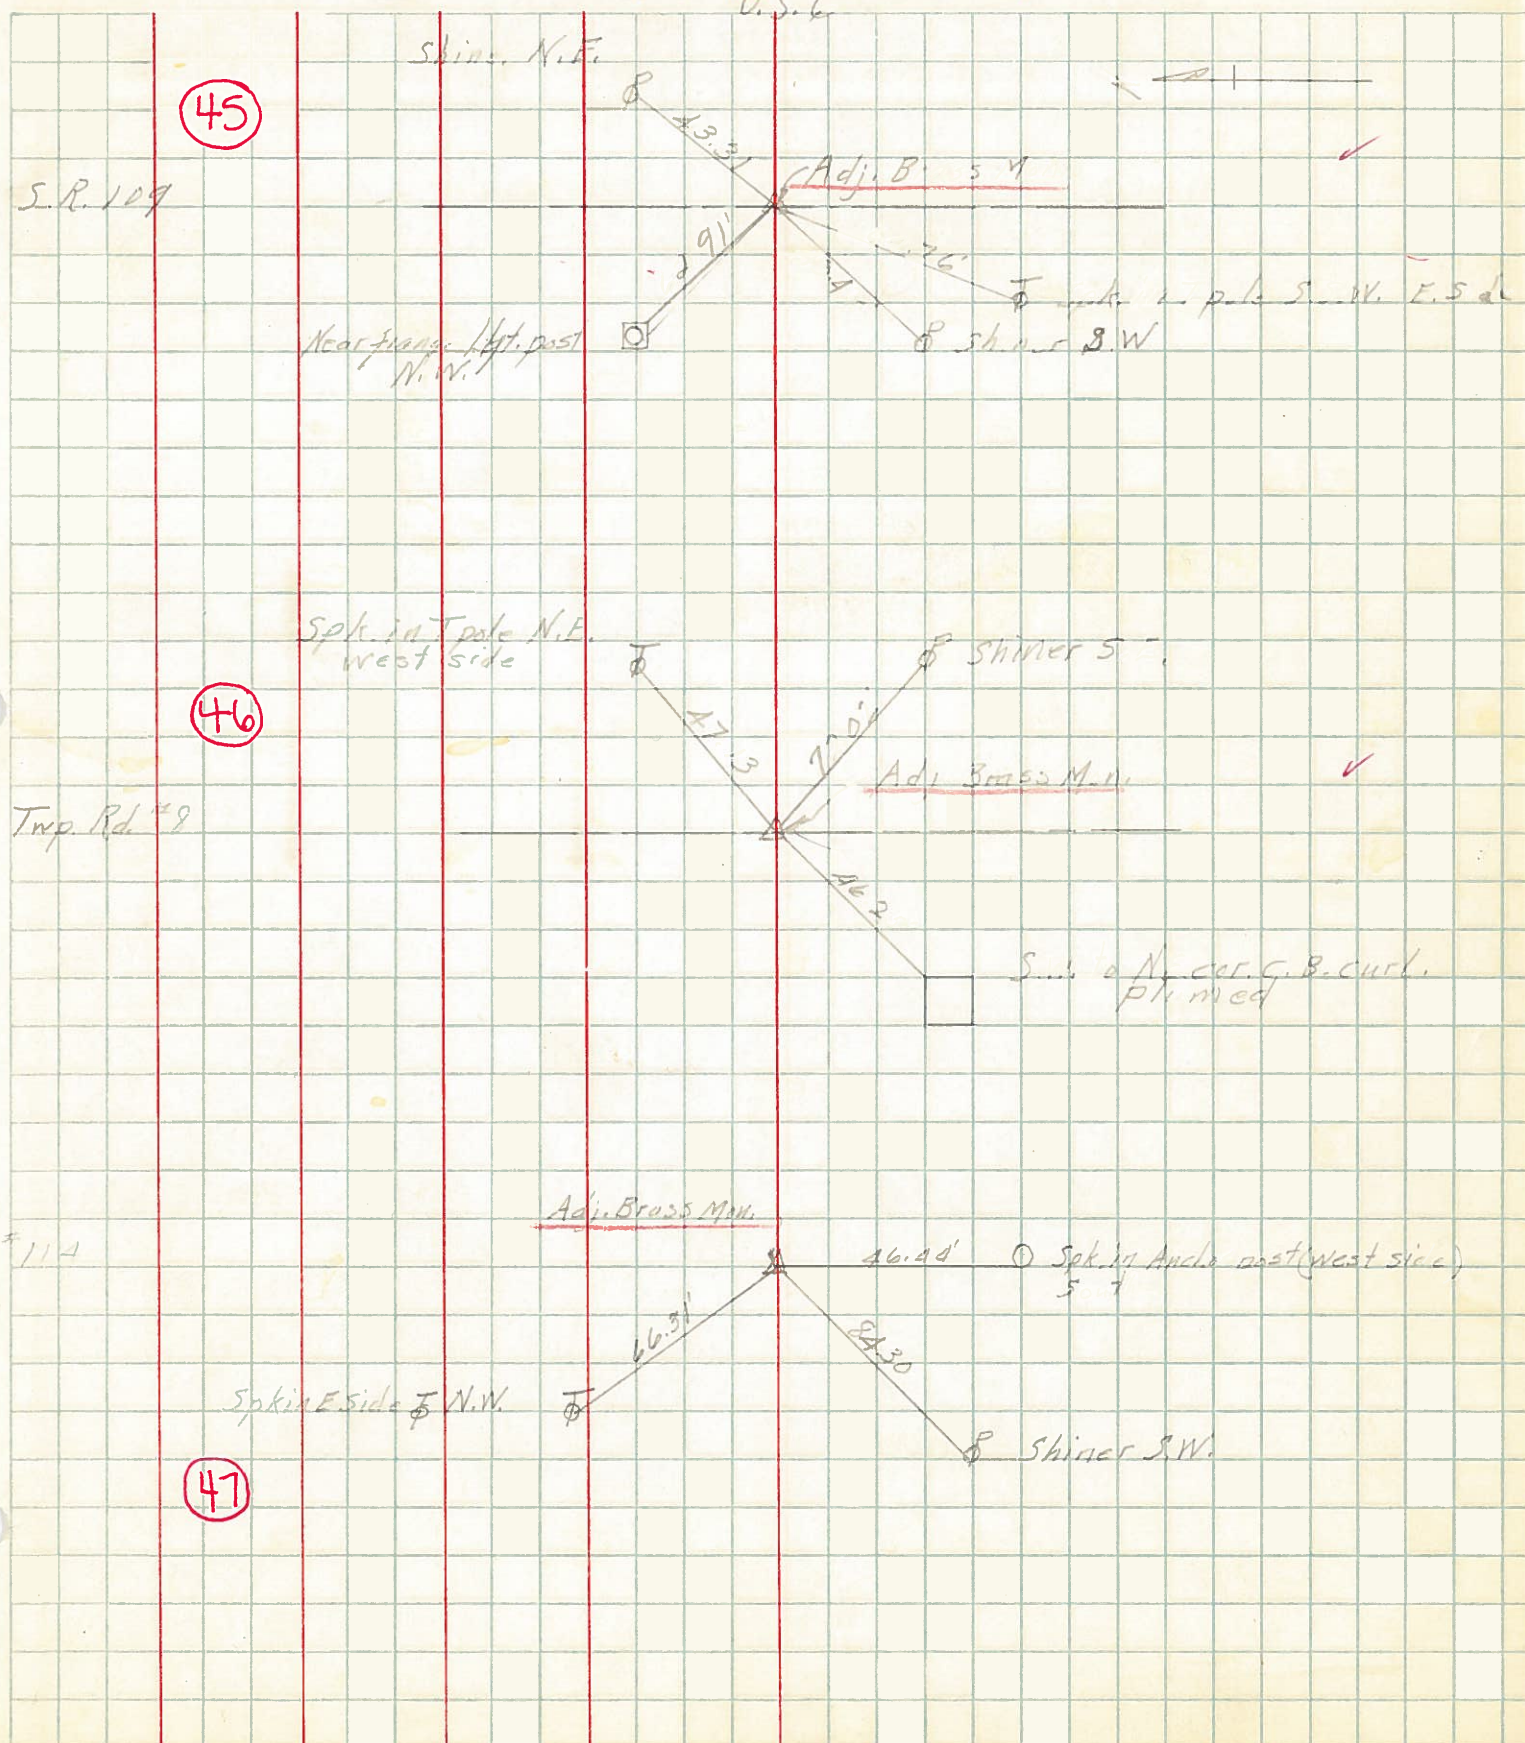

PERSONNEL TITLE PERSONNEL TITLE

COUNTY Henry DATE Jan-Feb 1961




Beach
Ambrister
Knappe
Gunter
Mohler

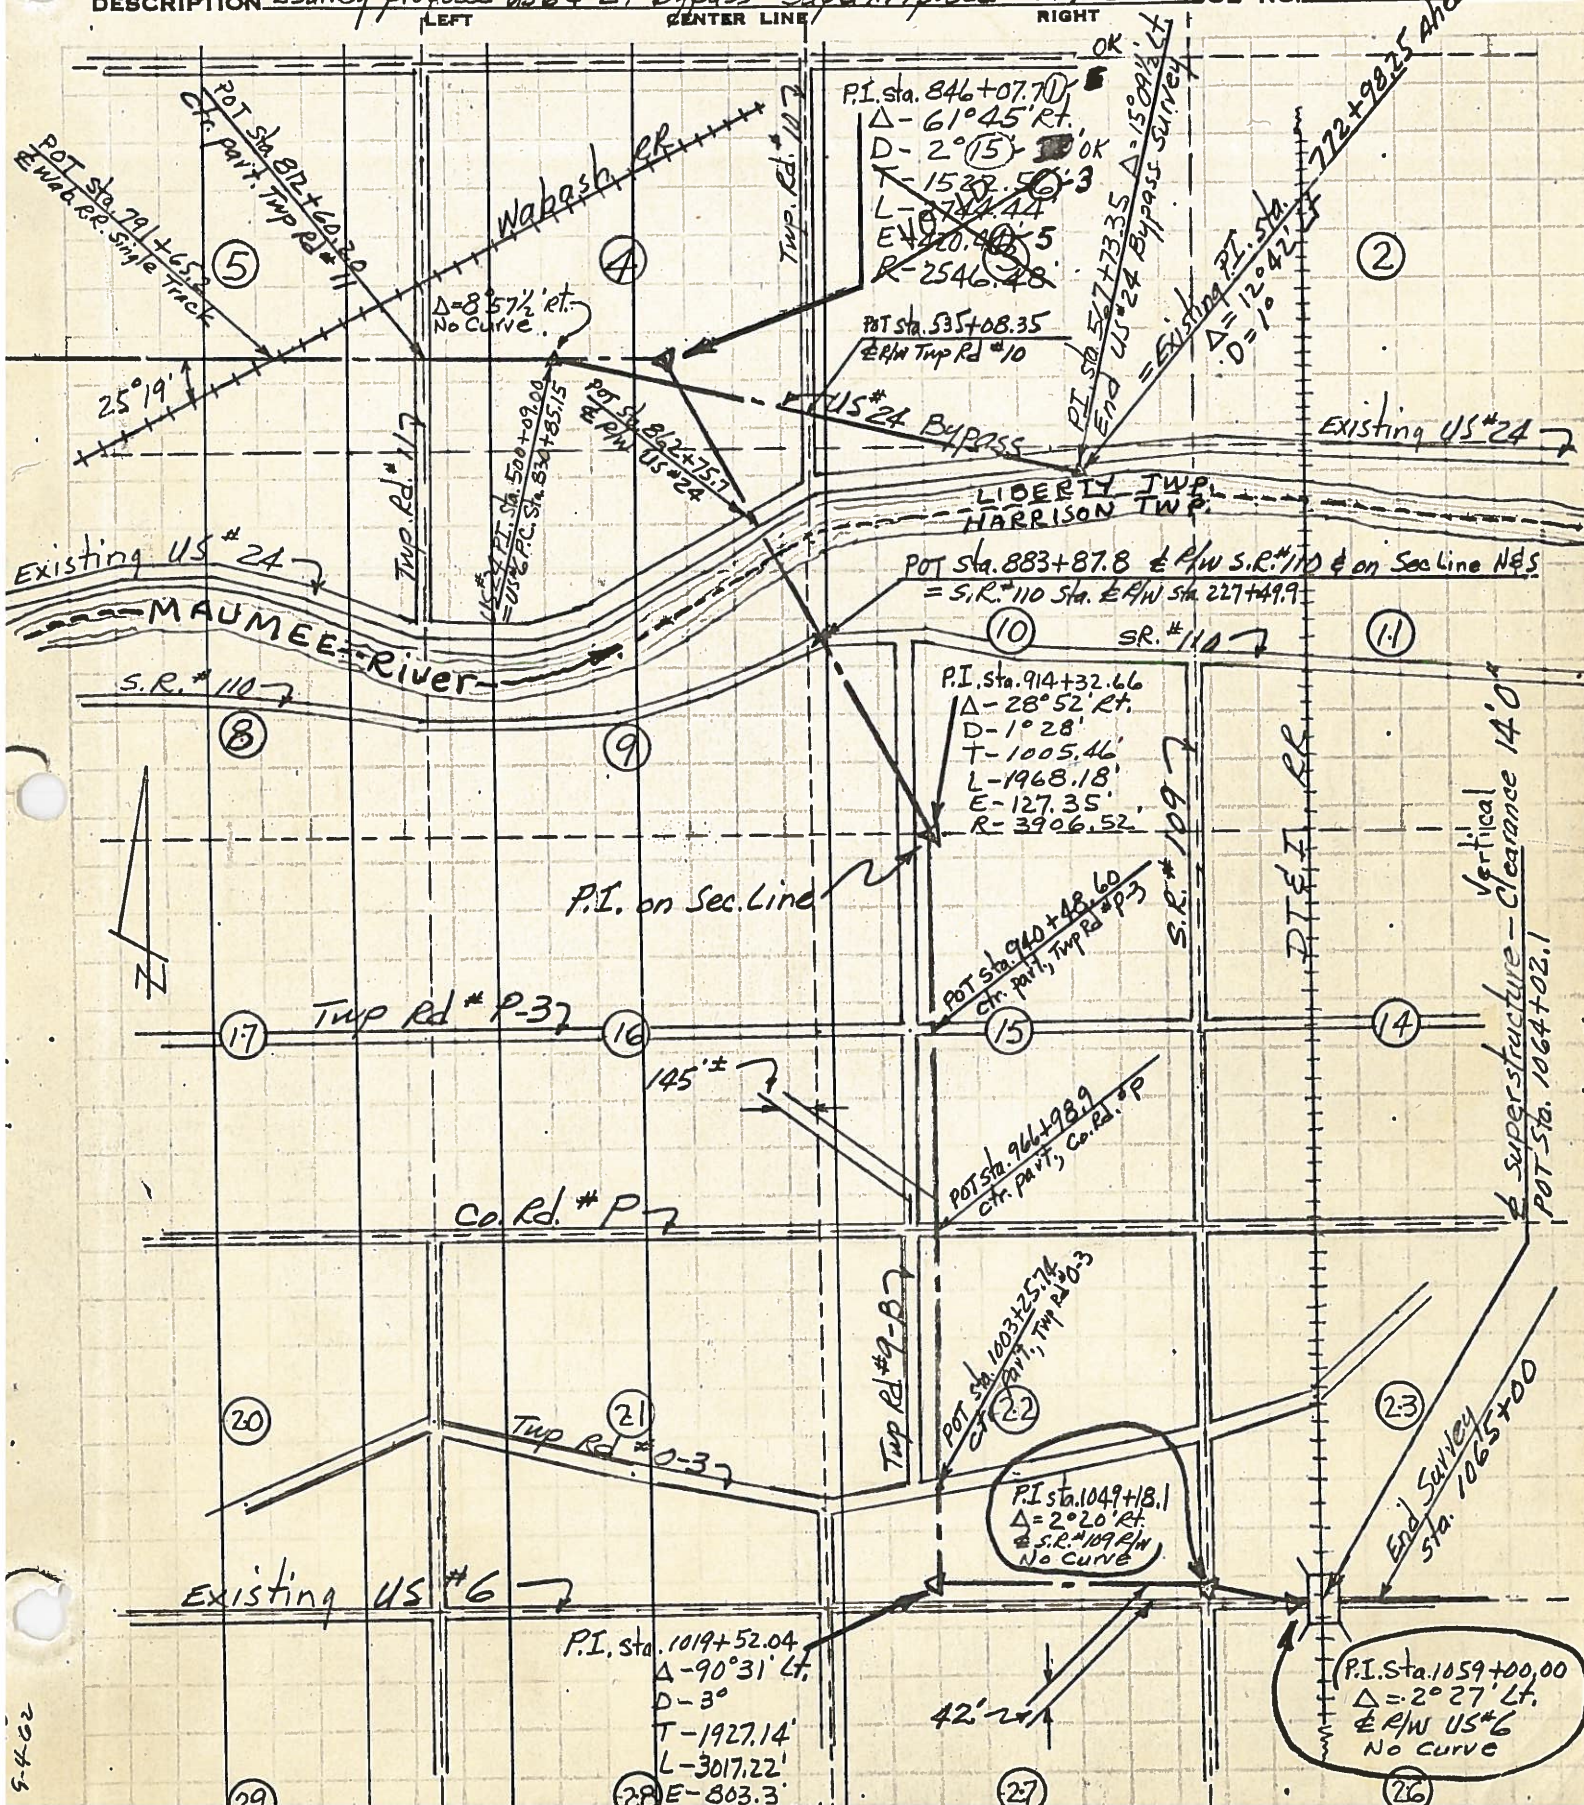S. R. US#6 & #24 Bypass WEATHERSEC. Liberty & Harrison Twp. TEMP.DESCRIPTION Survey proposed US#6 & #24 Bypass superimposed on section lines

PERSONNEL	TITLE	PERSONNEL	TITLE	COUNTY	DATE	WEATHER	TEMP.
Pessefall				Henry	Aug-23-51		
Smith				S. R. # 6			
Carpenter				SEC.			
Kearnes							

DESCRIPTION Witness Points JOB NO. _____

LEFT CENTER LINE RIGHT

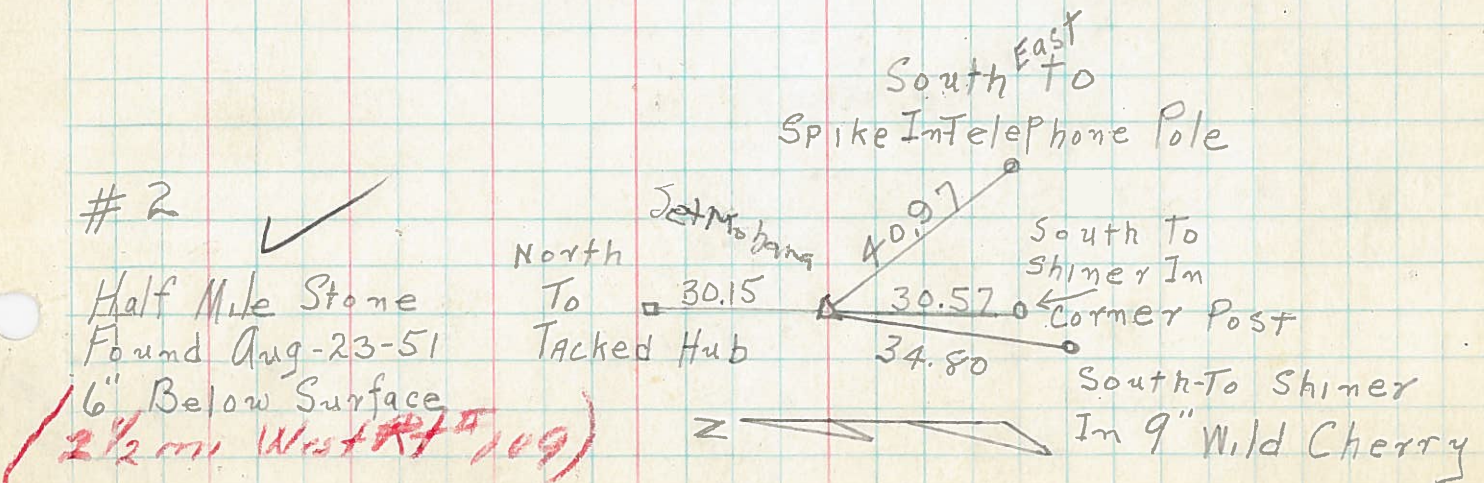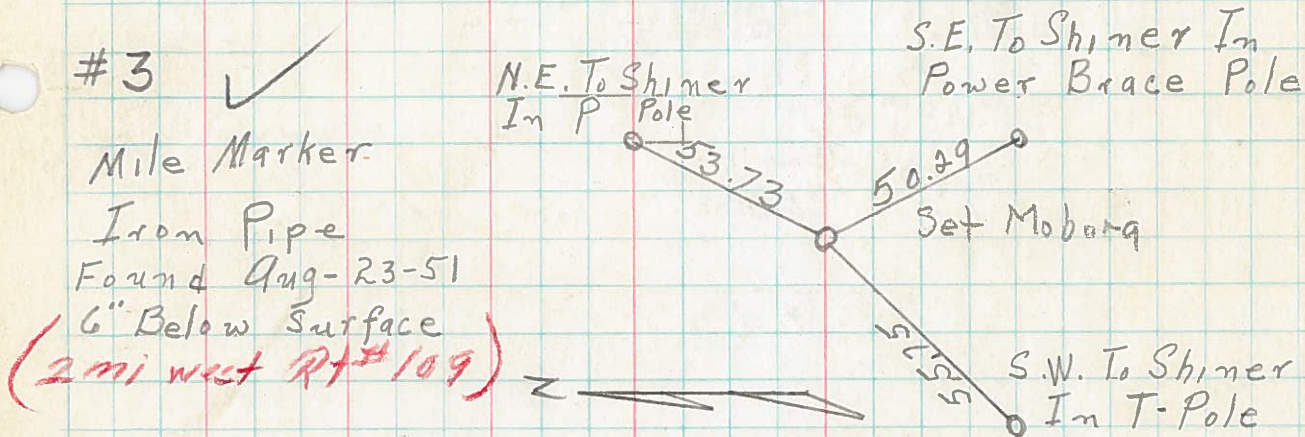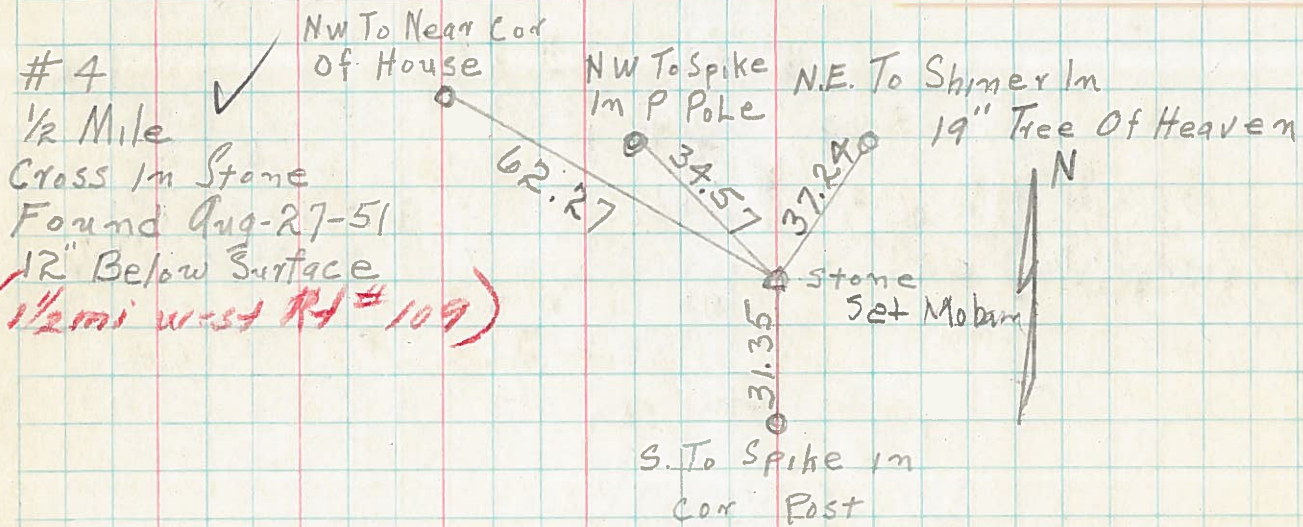

PERSONNEL	TITLE	PERSONNEL	TITLE	COUNTY	DATE	WEATHER	TEMP.	JOB NO.
Pesefall				Henry	Aug-23-51			
Smith				S. R. #6				
Carpenter				SEC. Q & P-1				
Kernes								

DESCRIPTION Witness Points

#5 (1-mi West
1 Mile of Rt #109)
Found Stone
15" Below Surface
Aug-27-51

NE To Shiner In
P Pole 50.02
Set Mobara
Stone
50.42
34.10
S.W. To Cross
In Corner Post
1' above ground
NW To Shiner
In T Pole

Recorded in
Henry co. Mon
bk. Pg. 60



#6 (2-mi West
Half Mile of Rt #109)
Found Tacked Hub
In Berm

N.E. To Shiner In
P Pole 27.09
S.E. To Shiner
In P Pole 46.95
S. To Shiner
In 36" Cottonwood
Stamp 27.06
S.W. To Shiner
In T Pole 28.93
Tacked
Hub
RR. Spike



#1
1 Mile
Found Stone
18" Below Surface
(3mi West Rt #109)

NE To Shiner In
T Pole 95.76
SE To Shiner In
T Pole 46.47
Stone
39.90
29.98
NW To Shiner
In 36" Maple
SW To Shiner In
P Pole



PERSONNEL TITLE PERSONNEL TITLE

COUNTY He DATE 2-28-58

S. R. 6 WEATHER _____

SEC. Relocation over Pt. #384 TEMP. _____

DESCRIPTION Curve DATA LEFT CENTER LINE RIGHT JOB NO. _____

P.I. = Sta. 4+36.12

P.C. = Sta. 1+79.82

2

3

4

5

6

P.T. = Sta. 6+92.32

0°-00'

0°-02'

0°-10'

0°-18'

0°-26'

0°-34'

0°-41'

$\Delta = 1^{\circ}-22'$ RT.

D = 0°-16'

R = 21486.2'

T = 256.30'

L = 512.50'

E = 1.53'