

O.D.O.T. DISTRICT 2 SURVEY OFFICE (USE ONLY)

PERSONNEL

REFERENCE NO. 22 A

SHEET 24 OF 31

NOTES CANTERBURY

DATE 8/18/98

ROUTE SR 18, 109

H.C. ROUSOS

WEATHER PTLY CLDY

COUNTY HENRY

R.C. BARNHISEL

TEMP. 80°

TOWNSHIP MARION

SECTION 3

T 3 N R 7 E

TYPE MONUMENT SM.R.R.SPIKE, IN WOOD HUB


~~ON SURFACE~~ - BELOW 2"

~~LEFT~~ - CL PAV'T - RIGHT 20.3' W. OF CL

10' E. TO W EDGE PAVEMENT

S.L.M. 565+13

Grid: Northing: _____ Easting: _____

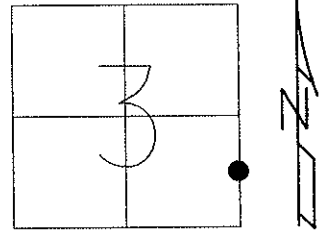


NOTE:

ALSO FD. CAPPED IPIN
STAMPED "#RLS 5922"
3.5" TO N.E. OF R.R.SPIKE.
*THERE IS A 0.43' DIFFERENCE
BETWEEN SPIKE AND IPIN,
SM.SPIKE IN HUB IS UNSTABLE.

RECORD:

FD. SM.R.R.SPIKE SET
IN WOOD HUB, 2' BELOW
SURFACE. 10' W. OF W.
E.P., 20.3' W. OF CL
PAV'T SR 18.

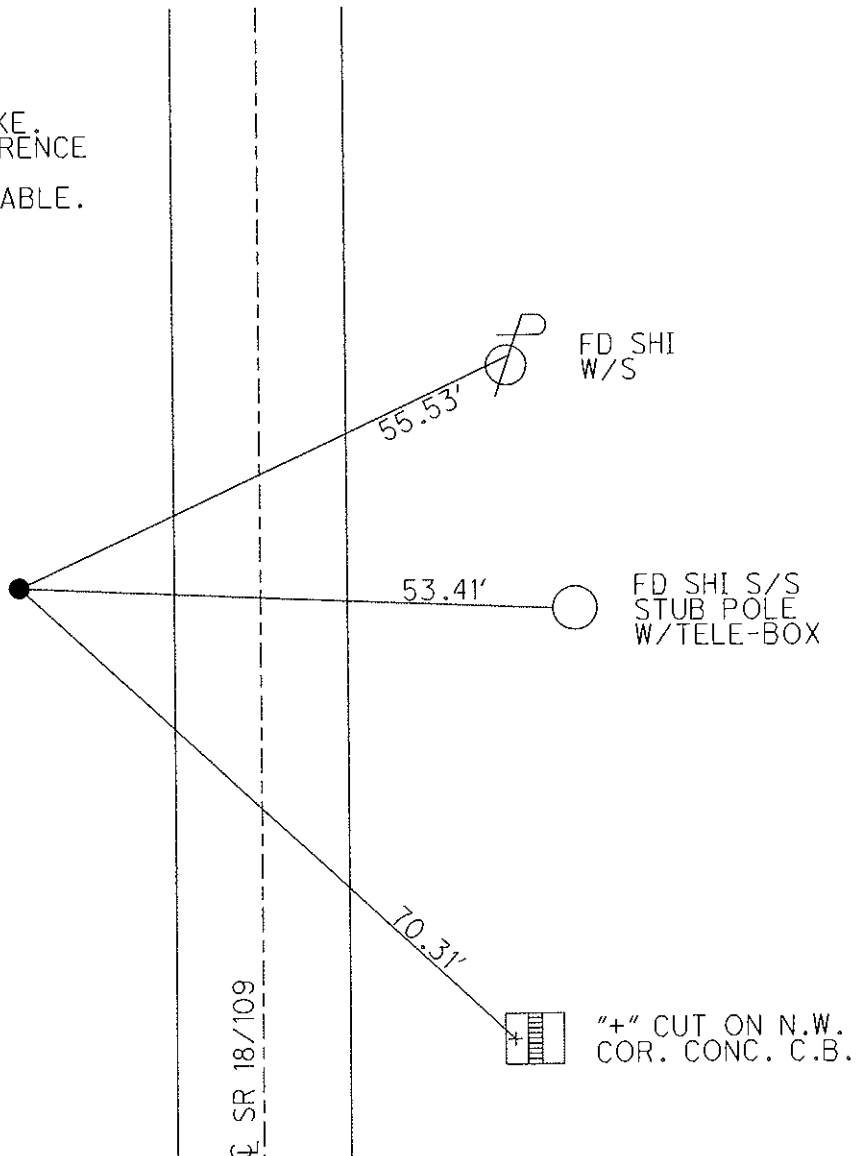

O.D.O.T. DISTRICT 2 SURVEY OFFICE

PERSONNEL _____

REFERENCE NO. 22 A

SHEET 11 OF _____

NOTES CANTERBURY

H.C. ROUSOS

R.C. BARNHISEL

DATE 8-18-98

WEATHER PRTLY CLOY

TEMP. +80° F

ROUTE 18 & 109

COUNTY HENRY

TOWNSHIP MARION

SECTION 3

T 3 N R 7 E


TYPE MONUMENT SM. R.R. SPIKE IN WOOD HUB

~~ON SURFACE~~ - BELOW 2" BELOW

~~LEFT- & PAV'T.~~ - RIGHT 20.3' W OF &

10' E TO W. EDGE PAVEMENT

S.L.M. 565 + 13

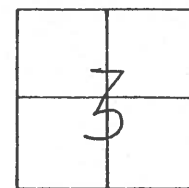

OFF PAVEMENT

NOTE:


ALSO FOUND CAPPED I - PIN

STAMPED #RLS 5922

3.5" TO N.E. OF R.R. SPIKE

* THERE IS A 0.43' DIFFERENCE
BETWEEN SPK. & I-ROD

- SMALL SPK. IN HUB IS UNSTABLE

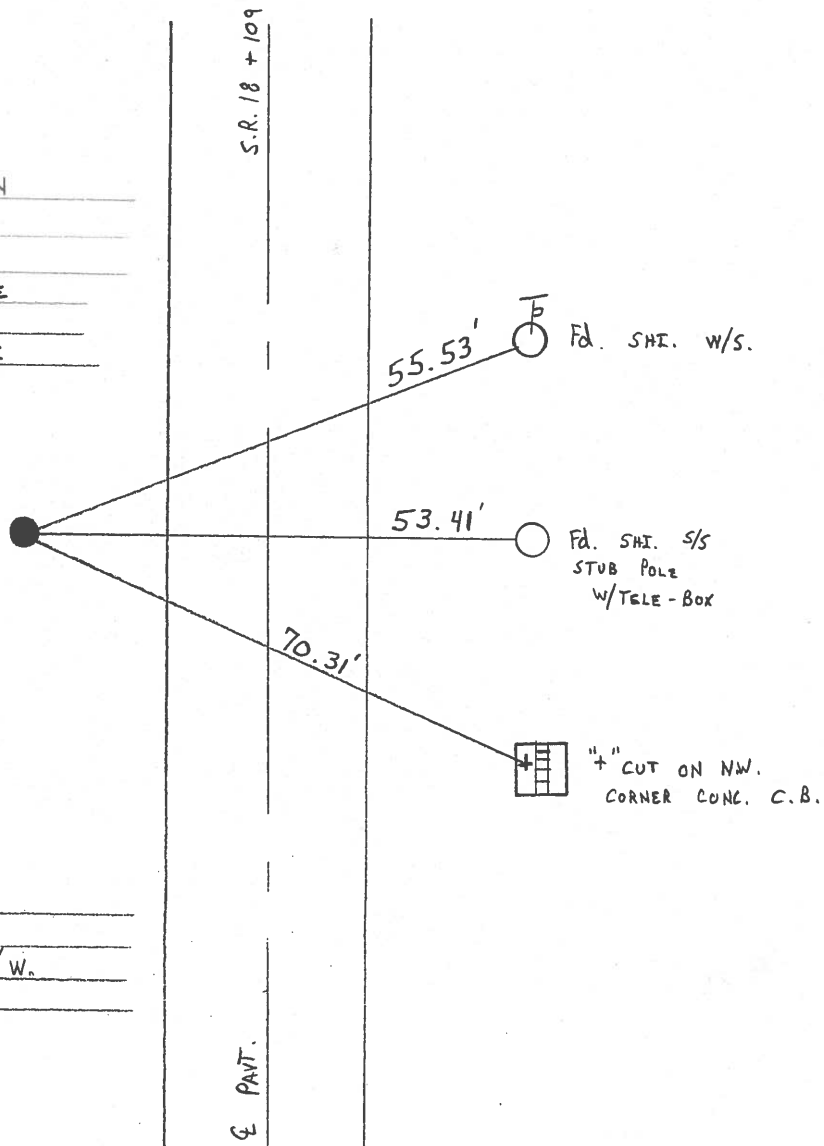

RECORD:

FND. SMALL R.R. SPK SET IN

WOOD HUB 2" BELOW SURFACE

10' W. OF W. EDGE OF PAVT & 20.3' W.

OF & PAVT. S.R. 18

O.D.O.T. DISTRICT 2 SURVEY OFFICE

PERSONNEL

REFERENCE NO. 22 A

SHEET 11 OF

NOTES BARNHISEL

H.C. " "

R.C. Loehake

DATE 4-3-89

WEATHER cloudy

TEMP. +48°

ROUTE 18 & 109

COUNTY HENRY

TOWNSHIP MARION

SECTION 3

T 3 N R 7 E



TYPE MONUMENT R.R. SPIKE

ON SURFACE - BELOW 2"

LEFT - & PAV'T. - RIGHT 20.3

10' TO W EDGE PAVEMENT

S.L.M. 565+13 (SR. 18)

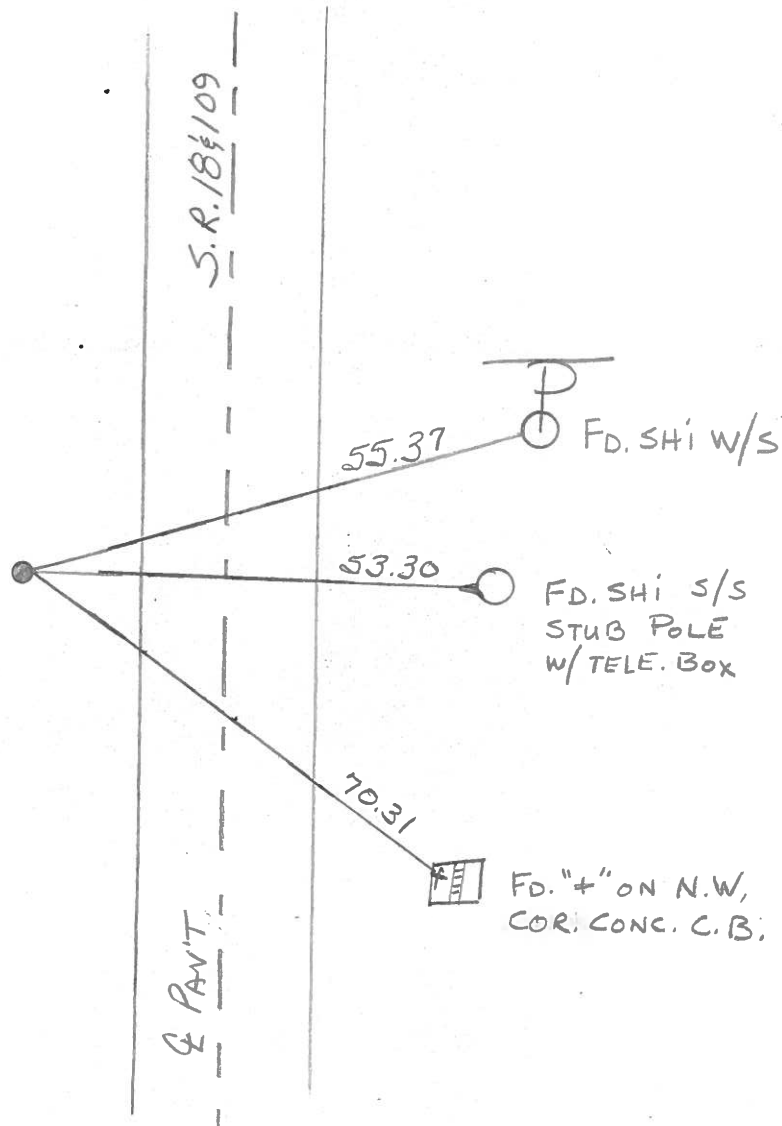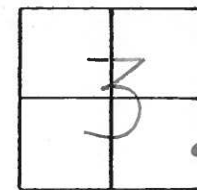

Q.D.O.T. DISTRICT 2 SURVEY OFFICE

SHEET _____ OF _____

County HENRY S.R. 18 of 109

Township MARION

Section 3

T3N, R2E

Personnel HOFFMAN

LOEHRKE

HOUSEHOLDER


BARNHISEL

#22-A


Date 4/25/83

Weather CLEAR

Temp. +60°

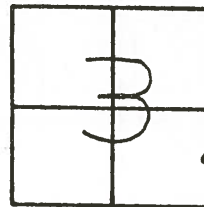

FD. SMALL R.R. SPK. SET
IN WOOD HUB 2"
BELOW SURFACE
10' WEST OF WEST. E.P. &
20.3' WEST OF & PAUT.
S.R. 18/109
S.L.M. STA. 565 +02 ±

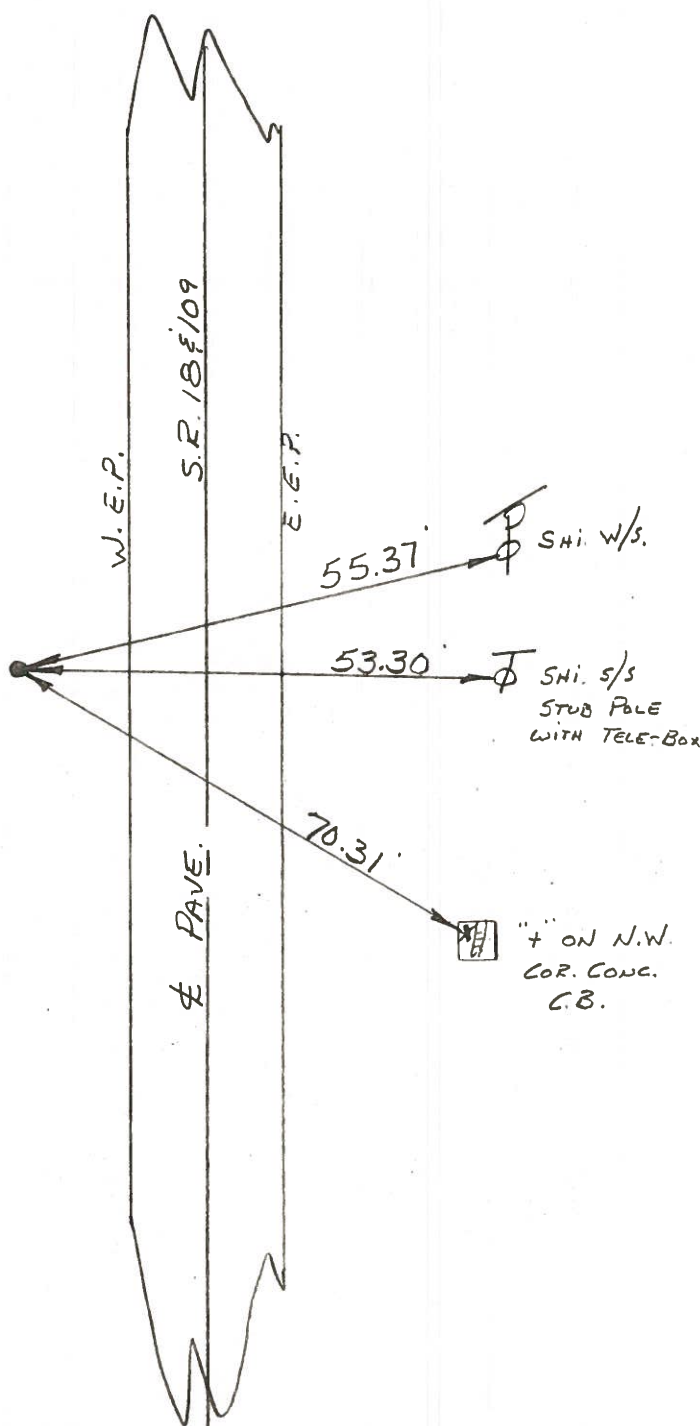

O.D.O.T. DISTRICT 2 SURVEY OFFICE

SHEET 18 OF

County HENRY S.R. 18-109

Date 5-29-81

Township MARION

Weather PARTLY CLOUDY

Section 3

Temp. +75°


T3N, R7E

Personnel J. Hoffman


C. Loehrke

L. Householder

22A

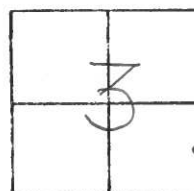

Fd. SMALL R.R. SPK. SET IN wood HUB 2" below surface -
10.0' west of W. E.P.

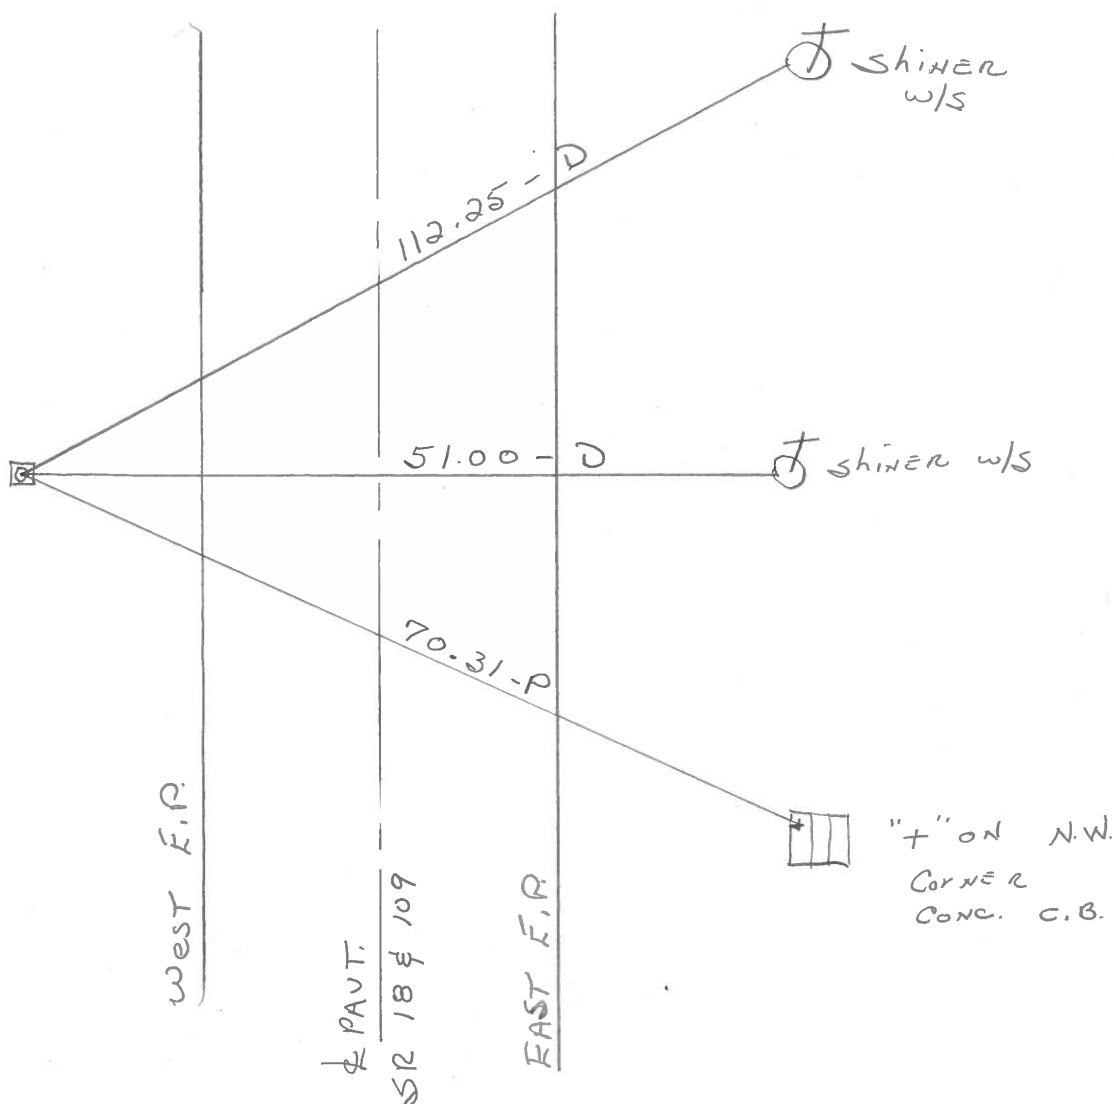

PERSONNEL TITLE PERSONNEL TITLE

COUNTY Henry DATE 13 May 77

S. R. #18 WEATHER Cloudy

SEC. Marion Twp TEMP. 50°

DESCRIPTION Refs. to Control Points JOB NO. 02999(0)

LEFT

CENTER LINE

RIGHT

