
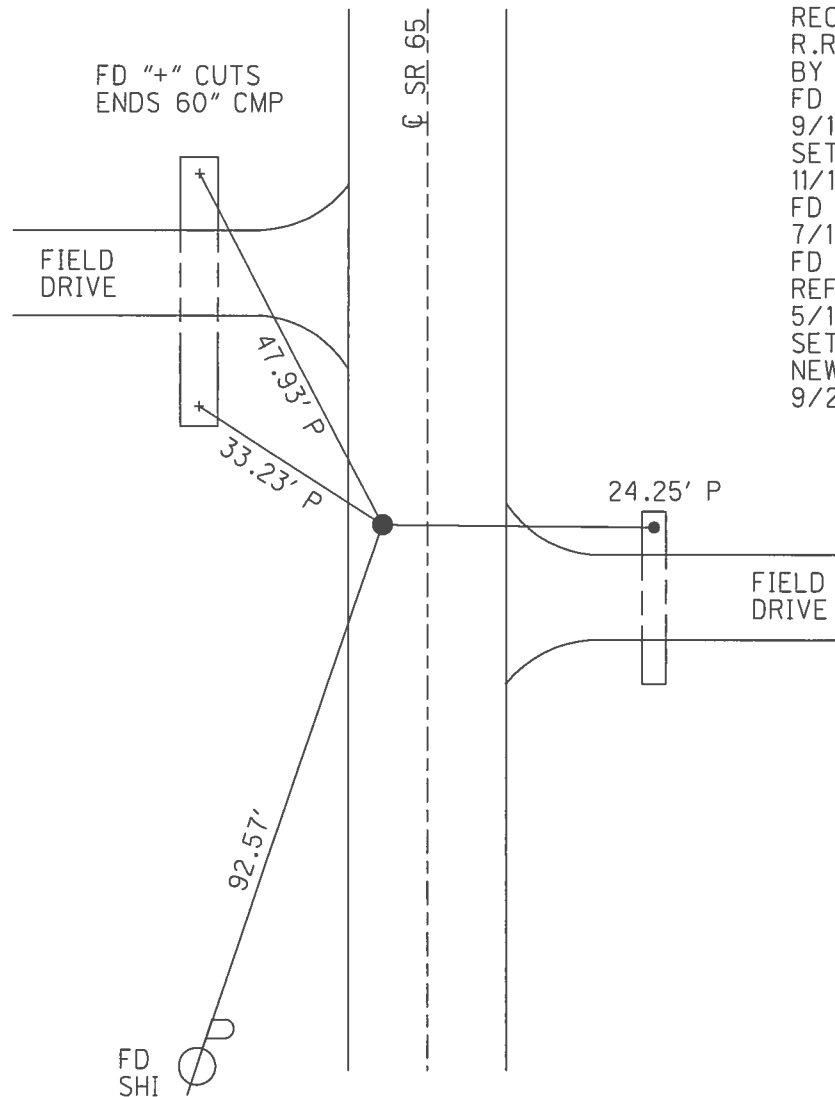


O.D.O.T. DISTRICT 2 SURVEY OFFICE (USE ONLY)

PERSONNEL	REFERENCE NO. <u>18</u>	SHEET <u>21</u> OF <u>42</u>
NOTES	DATE <u>5/8/17</u>	ROUTE <u>SR 65</u>
H.C. <u>RHOADES</u>	WEATHER <u>SUNNY</u>	COUNTY <u>HENRY</u>
R.C. <u>O'DONNELL</u>	TEMP. <u>44°</u>	TOWNSHIP <u>RICHFIELD</u>
		SECTION <u>21</u>
		T <u>4</u> N R <u>8</u> E

TYPE MONUMENT MAG/WASHER
 ON SURFACE - ~~BELOW~~ ON
 LEFT - CL PAV'T - ~~RIGHT~~ 4.9'
3.6' TO LT EDGE PAVEMENT
 S.L.M. 449+99

GRID: NORTHING: 595091.897 EASTING: 1572562.053

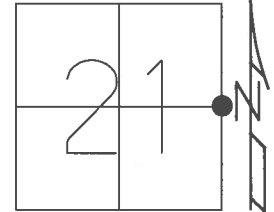

RECORD:
 R.R.SPIKE SET
 BY COUNTY ENGR.
 FD MAG NAIL
 9/16/02, DCH
 SET MAG/WASHER
 11/14/02, MB
 FD MAG/WASHER
 7/11/12, MC
 FD MAG/WASHER
 REF18
 5/10/17, JFO
 SET MAG/WASHER
 NEWREF18
 9/26/17, JFO

O.D.O.T. DISTRICT 2 SURVEY OFFICE (USE ONLY)

PERSONNEL

REFERENCE NO. 18

SHEET 21 OF 42



NOTES BARNHISEL
H.C. CANTERBURY
R.C. BARNHISEL

DATE 9/16/02
WEATHER SUNNY
TEMP. 75°

ROUTE SR 65
COUNTY HENRY
TOWNSHIP RICHFIELD
SECTION 21
T 4 N R 8 E

TYPE MONUMENT MAG NAIL
ON SURFACE - ~~BELOW~~ ON
LEFT - Q PAV'T - ~~RIGHT~~ 4.9'
3.6' TO LT EDGE PAVEMENT
S.L.M. 449+99

Grid: Northing: 595091.923 Easting: 1572561.960

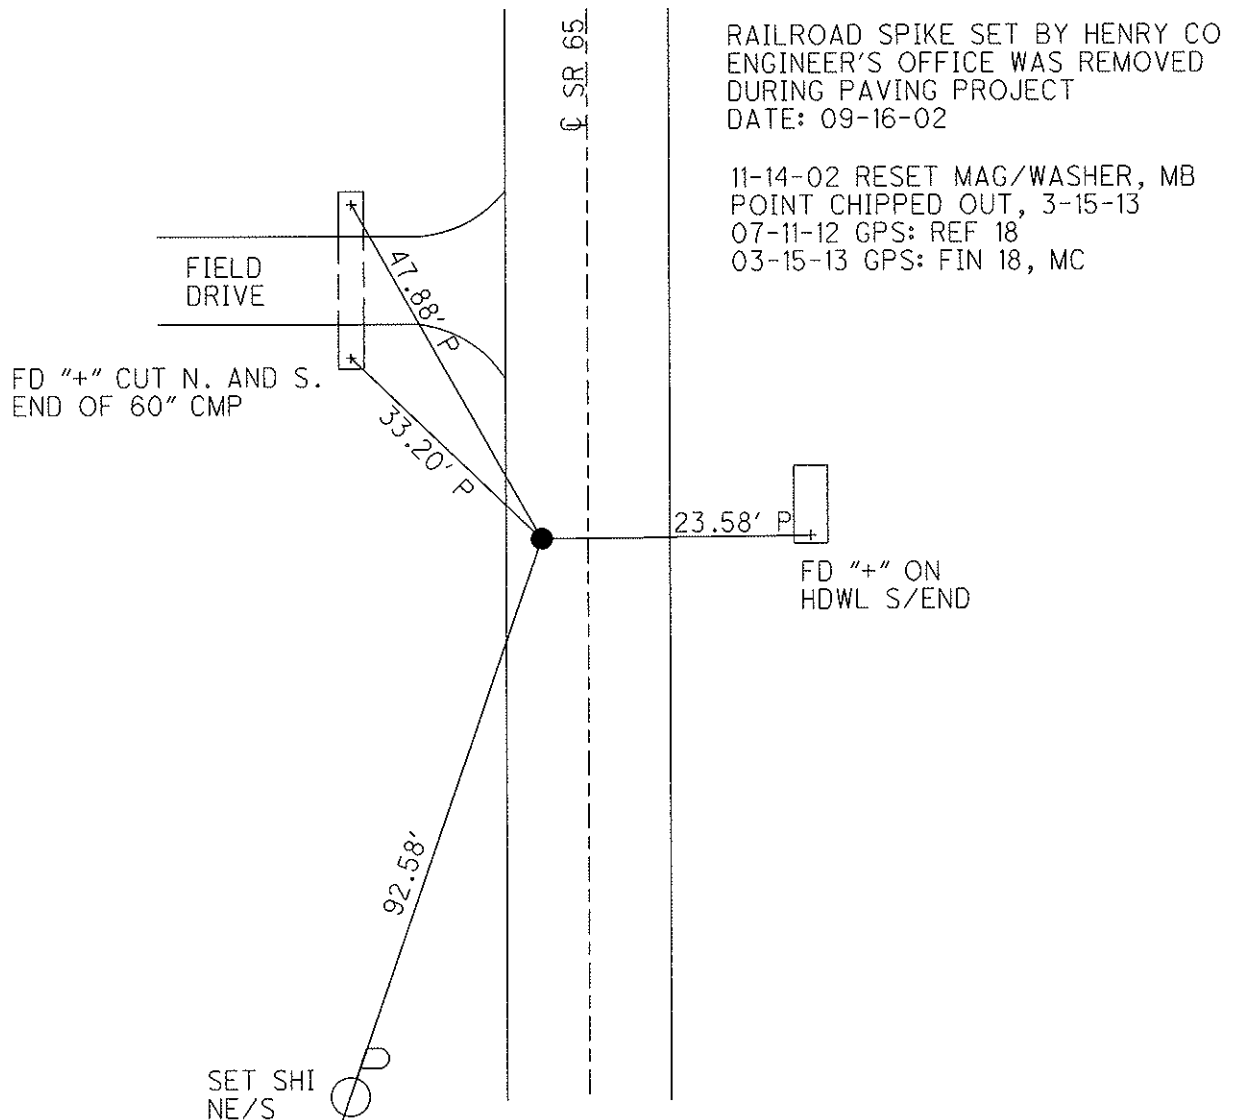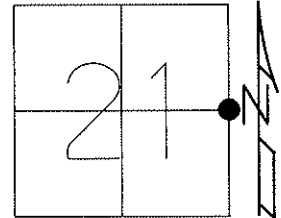

O.D.O.T. DISTRICT 2 SURVEY OFFICE

PERSONNEL

REFERENCE NO. 18

SHEET 19 OF 29

NOTES BARNHISEL "RC"

H.C. CANTERBURY

R.C. _____

DATE 9-16-02

WEATHER SUNNY

TEMP. +75°

ROUTE 65

COUNTY HENRY

TOWNSHIP RICHFIELD

SECTION 21

T 4 N R 8 E


TYPE MONUMENT PK & WASHER

ON SURFACE - BELOW YES

LEFT- & PAU'T. - RIGHT 4.9'

3.6' TO LT. EDGE PAVEMENT


S.L.M. 449+99

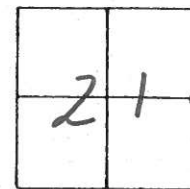

Reset Mag Nail & WASHER

11-14-02
MB

Mag Nail Removed,
Railroad Spike Reset
Date _____

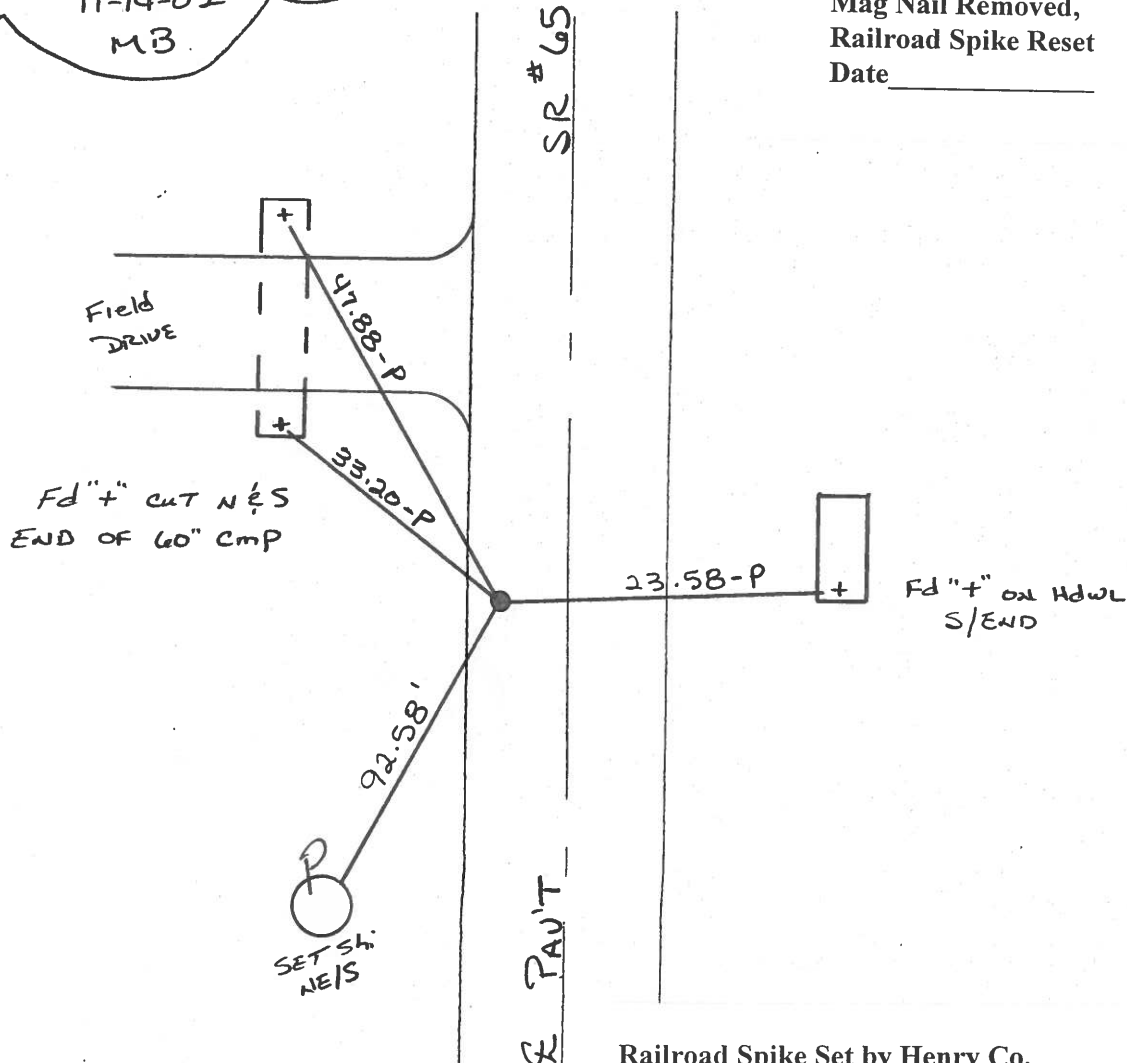

Railroad Spike Set by Henry Co.
Engineer's Office was Removed
During Paving Project
Date 9-16-02

O.D.O.T. DISTRICT 2 SURVEY OFFICE

PERSONNEL

REFERENCE NO. 18

SHEET ____ OF ____

NOTES BARNHISEL ✓

H.C.  H.C.

R.C. HOFFMAN MB

DATE 4-11-90

WEATHER Sunny ✓

TEMP. ~~+35°~~ +75

ROUTE 65

COUNTY HENRY

TOWNSHIP Richfield

SECTION 21

T 4 N R 8 E

TYPE MONUMENT P.K. & Washee ✓ *Removed*

ON SURFACE - ~~BELOW~~ yes 

LEFT - & PAN'T. - RIGHT 6.3 4.9


~~4.1~~ TO LT EDGE PAVEMENT

S.I. M. ~~450 + 10~~ ~~443 + 46~~ 440



Set P.K. & Wlshere
5-15-90
m13

RESET MAG NAIL / WASHER
11-14-02
MB

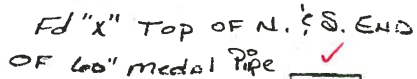

Field DRIVE

~~Fd "x" out~~
~~24" Conic Pipe~~

Handwritten diagram showing a path from a circle labeled "F00 Shi NE/S" to a circle labeled "F01 Shi". A red line connects the two circles, with the number "92.5" written next to it. There are also some other handwritten notes and markings, including "H01 B" and "Bo. 30" near the top.

50.65

PAV +
Q

23.49-F

Find "X" on the wall

QD.O.T. DISTRICT 2 SURVEY OFFICE

SHEET _____ OF _____

County HENRY S.R. 65

Township RICHFIELD

Section 21

T4N, R8E

Personnel HOFFMAN

LOEHKE H.C.

HOUSEHOLDER R.C.


BARNHISEL

18

Date 1-27-84

Weather Cloudy

Temp. +30°

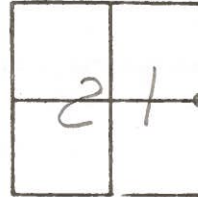

Fd. R.R. SPK/CTR. PUNCHED, set BY County

@ SURFACE

6.0' Lt. of & PAUT SR65


3.0' TO Lt. EP

S.L.M. 450+11

Set PK/WASHER

8-28-84

Fd "+" TOP NORTH
SOUTH END OF
60" METAL PIPE
Field Dr.

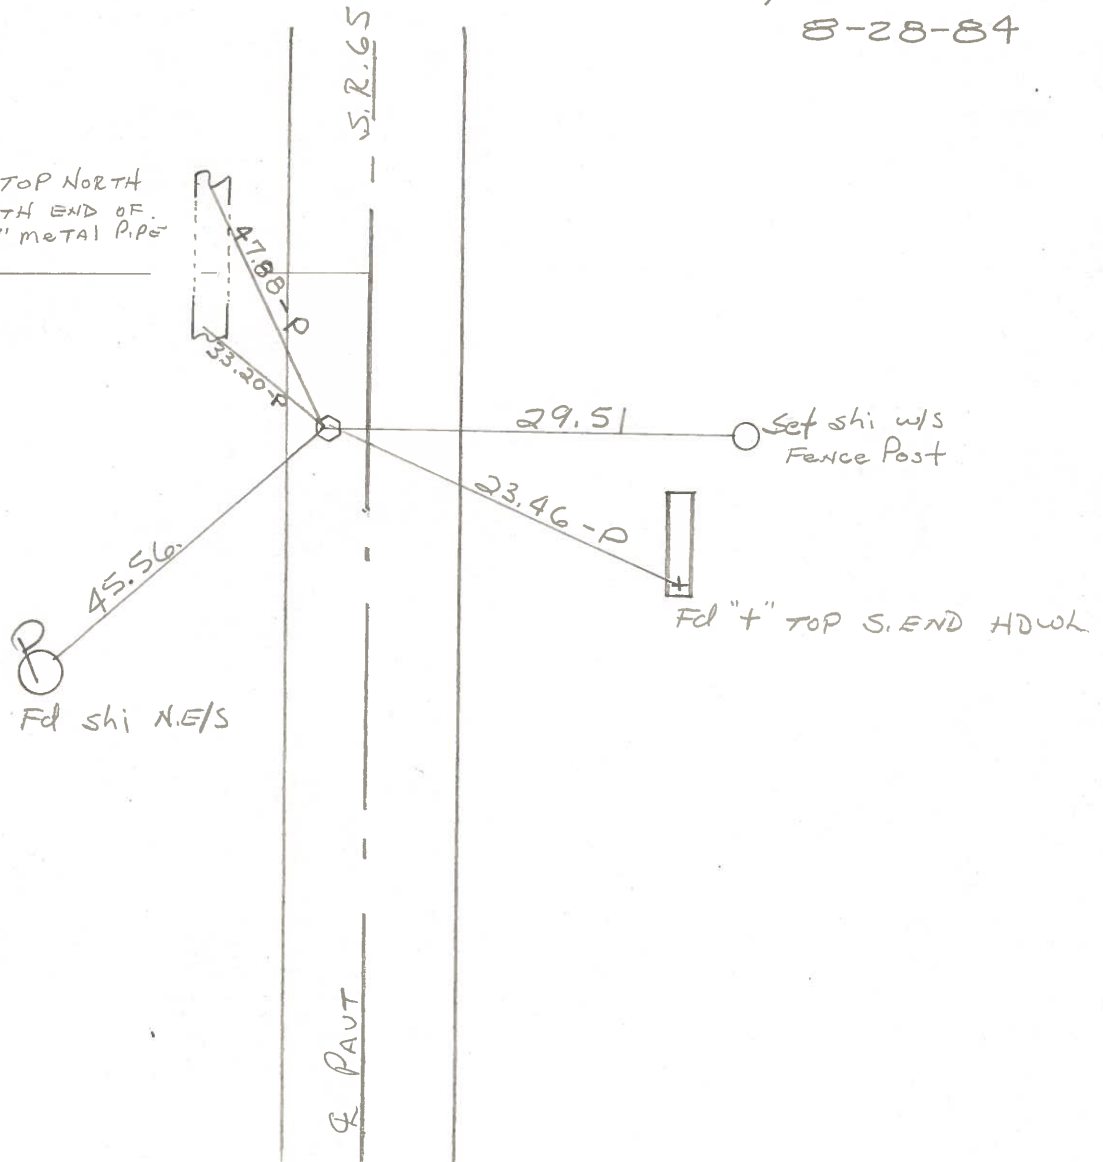

Q.D.O.T. DISTRICT 2 SURVEY OFFICE

SHEET _____ OF _____

County HENRY S.R. 65

Township RICHFIELD

Section 21

T4N, R8E

Personnel HOFFMAN

LOEHKE H.C.


HOUSEHOLDER R.C.

BARNHISEL

Date 1-27-84

Weather Cloudy

Temp. +30°

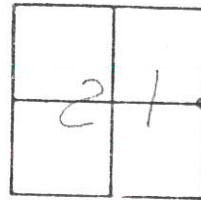

18


Fd. R.P. SPK/CTR. PUNCHED, SET BY COUNTY
@ SURFACE
6.0' LT. of & PAUT SR65
3.0' TO LT. SP


S.L.M. 450+11

SET PK/WASHER
8-28-84

Fd "+" TOP NORTH
SOUTH END OF
60" METAL PIPE
Field DR.

P.K. 1/2 Washer
450+10
6.3 LT OF &
4.1 TO LT ED

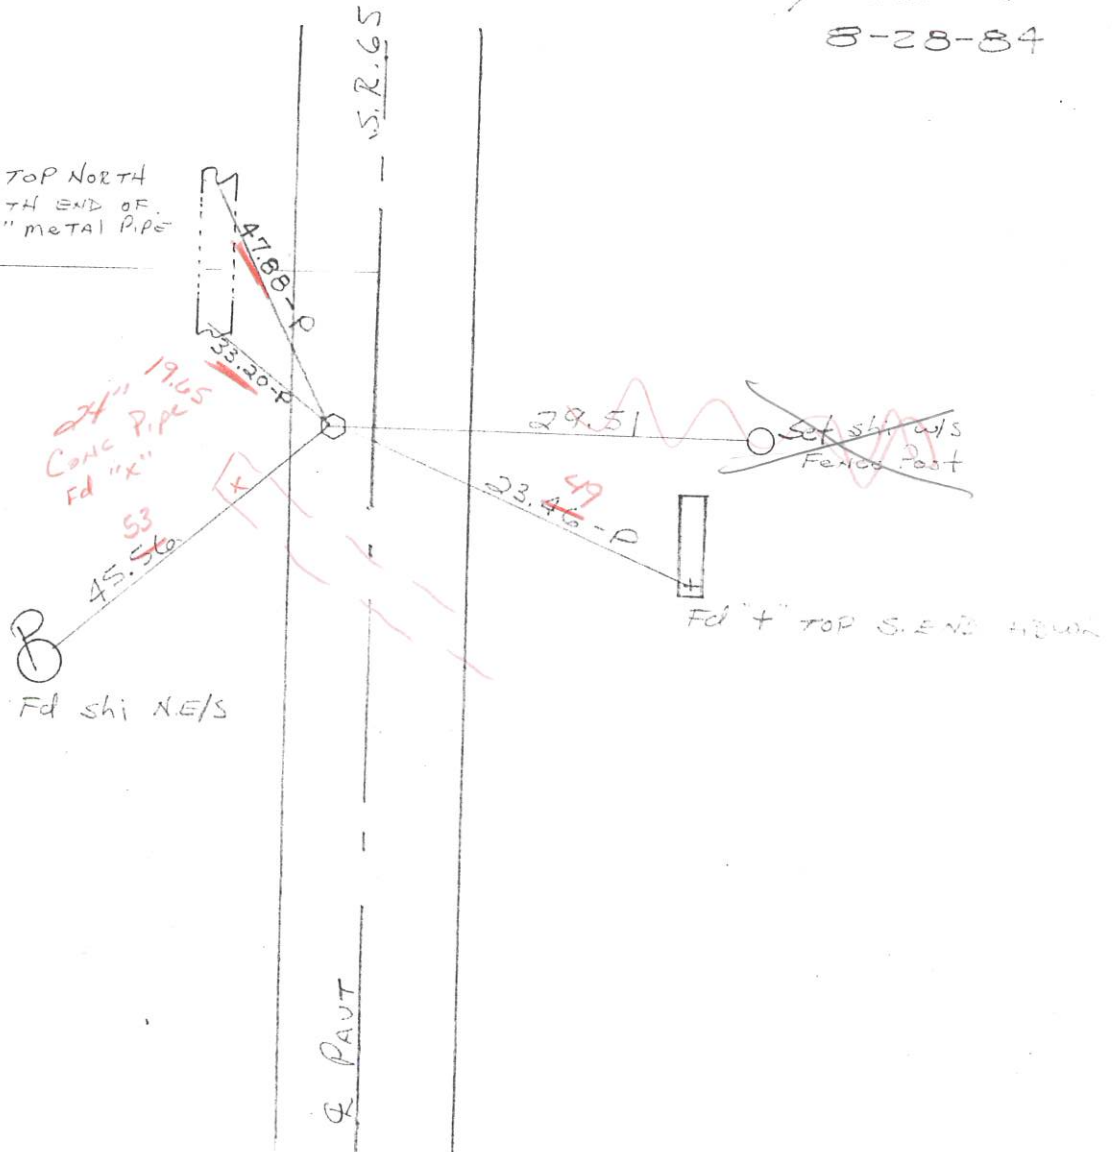

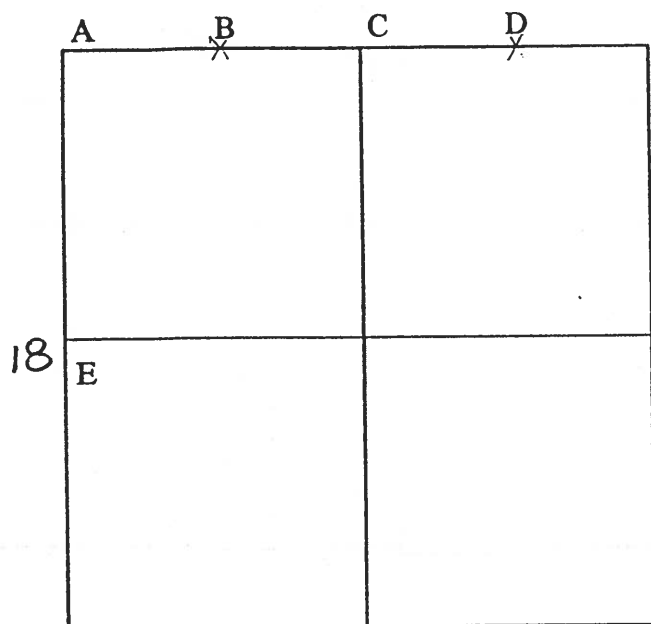

COUNTY: HENRY

TOWNSHIP: RICHFIELD

T- 4 -N R- 8 - E

SECTION: 22

18 E - 7/26/79 R.W., J.J., G.M.
Found recorded RR spike over stones, 0.22' north and 0.04' east of high point of true stone (3"x5"x19") 17" below road surface. Removed top stones and placed center punched RR spike on surface over high point of true stone. Pk's 6' north and east. Stone is 2.9' east of west edge 18' pavement.

54.57' W. to "+" in conc. corn crib foundation. GONE
33.19' N.N.W. to "+" S. end 60" metal pipe.
47.85' N.N.W. to "+" N. end 60" metal pipe.
29.45' E. to shiner w/s corner fence post.
45.54' S.S.W. to shiner ne/s power pole.
29.17' S.W. to "+" in end of 21" CMP.
23.35' E.S.E. to "+" S. end conc. headwall.

7/25/88 R.W., S.K.
19.61' N.W. to "+" NW end conc. pipe. (P)
33.19' N.W. to "+" south end metal pipe. (P)
47.87' N.N.W. to "+" north end metal pipe.
23.44' E.S.E. to "+" south end conc. headwall. (P)
45.53' S.W. to nail/shiner ne/s power pole.
29.18' S.W. to "+" east end CMP. (P)

PERSONNEL TITLE PERSONNEL TITLE

BURNSIDE

SMITH

BOWERS

MEAD

COUNTY HENRYDATE 5-12-75S. R. 65WEATHER CLOUDYSEC. E 1/4 Post Sec. 21 Richfield Twp. TEMP. +60°DESCRIPTION REF. SECTION CORNER

LEFT

CENTER LINE

RIGHT

JOB NO.

18

E. 1/4 Post Sec. 21
T-4N R-8-E
Richfield Twp.
Henry Co

"4" TOP NORTH
SOUTH END 5' W
METAL PIPE
FOR FIELD
DRIVE

"4" TOP CONC. CORNER FB
FDN.

E. 1/4 INTERIOR SEC. 21

FOUND LARGE STONE
4" DEEP.
SET BOAT SPIKE E
TINE OVER STONE.

SET R.R. SPK

9-23-75

