
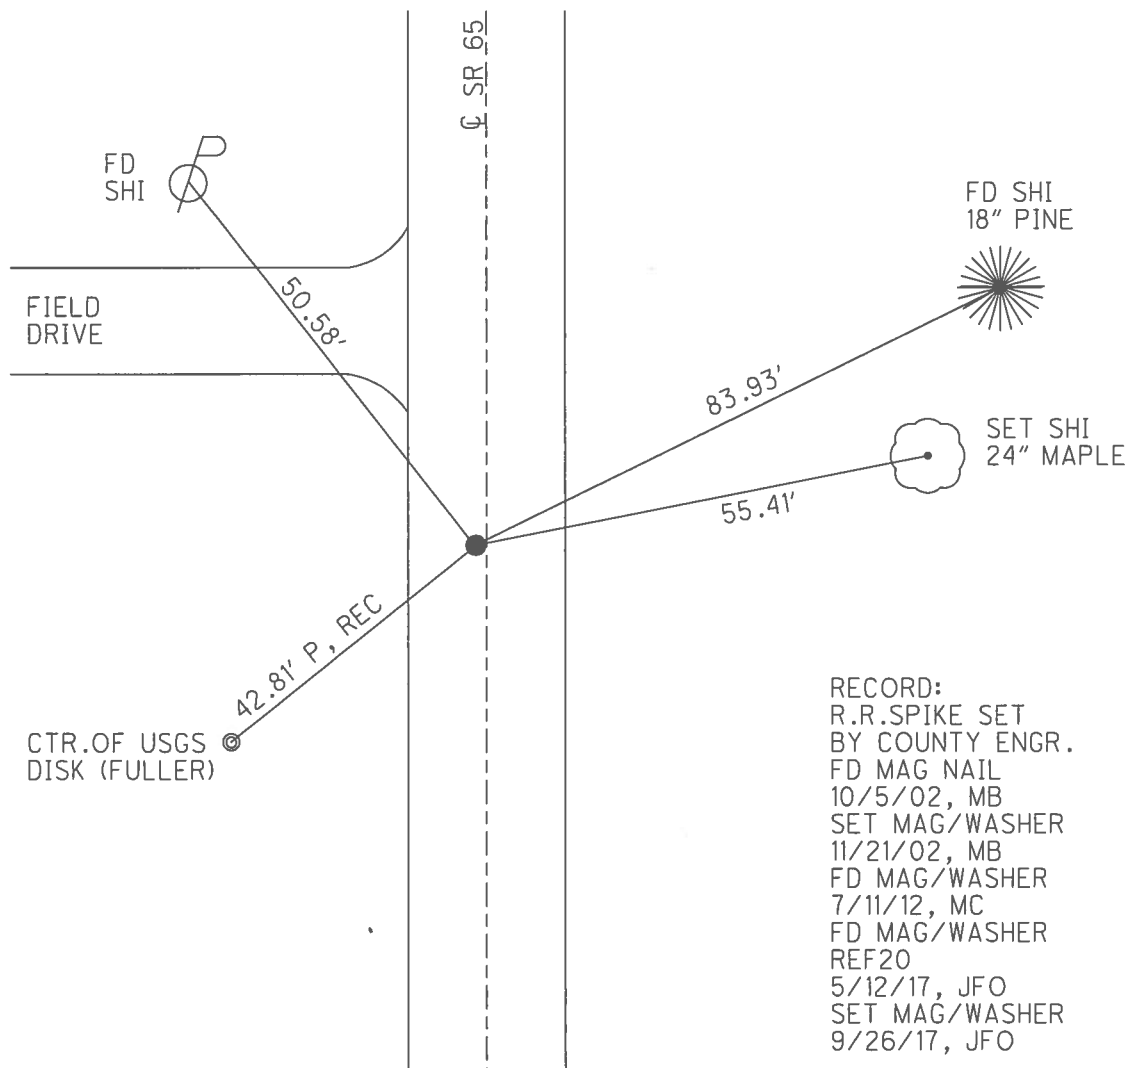


O.D.O.T. DISTRICT 2 SURVEY OFFICE (USE ONLY)

PERSONNEL _____ REFERENCE NO. 20 SHEET 23 OF 42
NOTES _____ DATE 5/9/17 ROUTE SR 65
H.C. RHOADES WEATHER SUNNY COUNTY HENRY
R.C. RHOADES TEMP. 47° TOWNSHIP RICHFIELD
SECTION 16
T 4 N R 8 E

TYPE MONUMENT MAG/WASHER
~~ON SURFACE~~ - BELOW ON
LEFT - C PAV'T - ~~RIGHT~~ 0.5'
9.3' TO LT EDGE PAVEMENT
S.L.M. 503+05

GRID: NORTHING: 600395.657 EASTING: 1572587.396

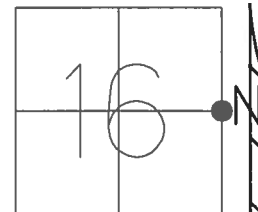

RECORD:
R.R.SPIKE SET
BY COUNTY ENGR.
FD MAG NAIL
10/5/02, MB
SET MAG/WASHER
11/21/02, MB
FD MAG/WASHER
7/11/12, MC
FD MAG/WASHER
REF20
5/12/17, JFO
SET MAG/WASHER
9/26/17, JFO

O.D.O.T. DISTRICT 2 SURVEY OFFICE (USE ONLY)

PERSONNEL

REFERENCE NO. 20

SHEET 23 OF 42

NOTES BARNHISEL

DATE 10/5/02

ROUTE SR 65

H.C. CANTERBURY

WEATHER SUNNY

COUNTY HENRY

R.C. BARNHISEL

TEMP. 75°

TOWNSHIP RICHFIELD

SECTION 16

T 4 N R 8 E

TYPE MONUMENT MAG / WASHER



~~ON SURFACE~~ - BELOW 3"

LEFT - Q PAV'T - ~~RIGHT~~ 0.5'

9.3' TO LT EDGE PAVEMENT

S.L.M. 503+05

Grid: Northing: 600395.688 Easting: 1572587.353

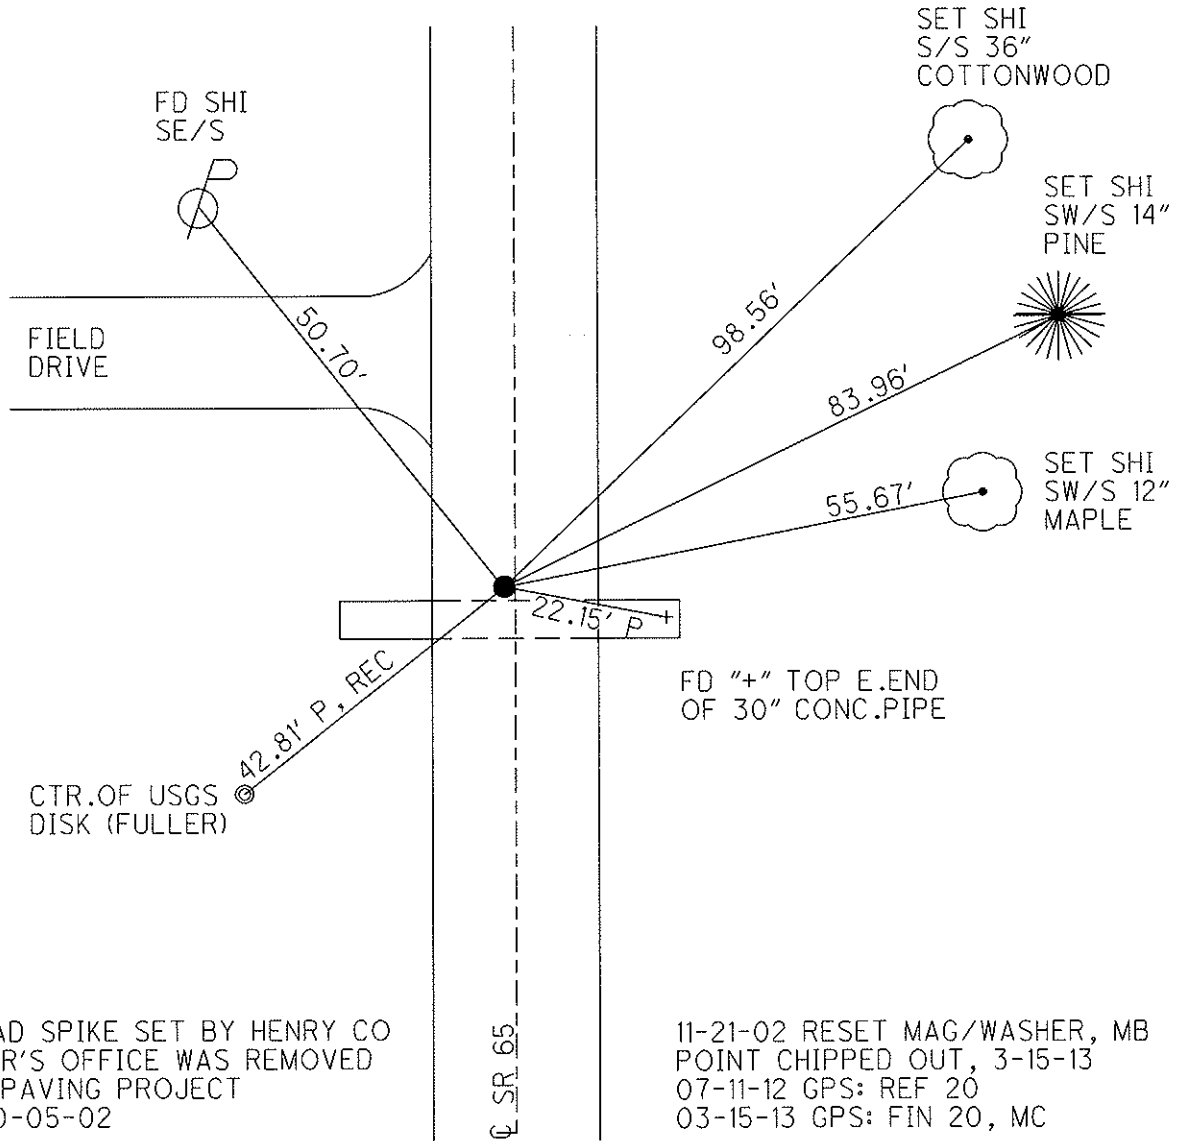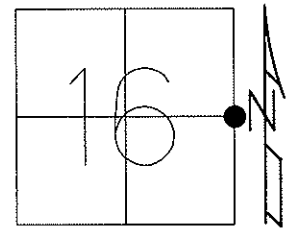

RAILROAD SPIKE SET BY HENRY CO
ENGINEER'S OFFICE WAS REMOVED
DURING PAVING PROJECT
DATE: 10-05-02

11-21-02 RESET MAG/WASHER, MB
POINT CHIPPED OUT, 3-15-13
07-11-12 GPS: REF 20
03-15-13 GPS: FIN 20, MC

O.D.O.T. DISTRICT 2 SURVEY OFFICE

PERSONNEL

REFERENCE NO. 20

SHEET 21 OF 29

NOTES BARNHISEL RC

H.C. CANTERBURY

R.C. _____

DATE 10-05-02

WEATHER SUNNY

TEMP. +75°

ROUTE 65

COUNTY HENRY

TOWNSHIP RICHFIELD

SECTION 16

T 4 N R 8 E

TYPE MONUMENT Cg RR Spk

ON SURFACE - BELOW 3"


LEFT-~~C~~ PAU'T. - RIGHT 0.5'

9.3' TO LT. EDGE PAVEMENT

S.L.M. 503+05

Mag Nail Removed,
Railroad Spike Reset


Date _____

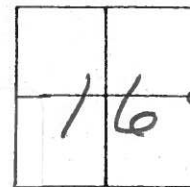

Reset Mag Nail & Washer

11-21-02

MB

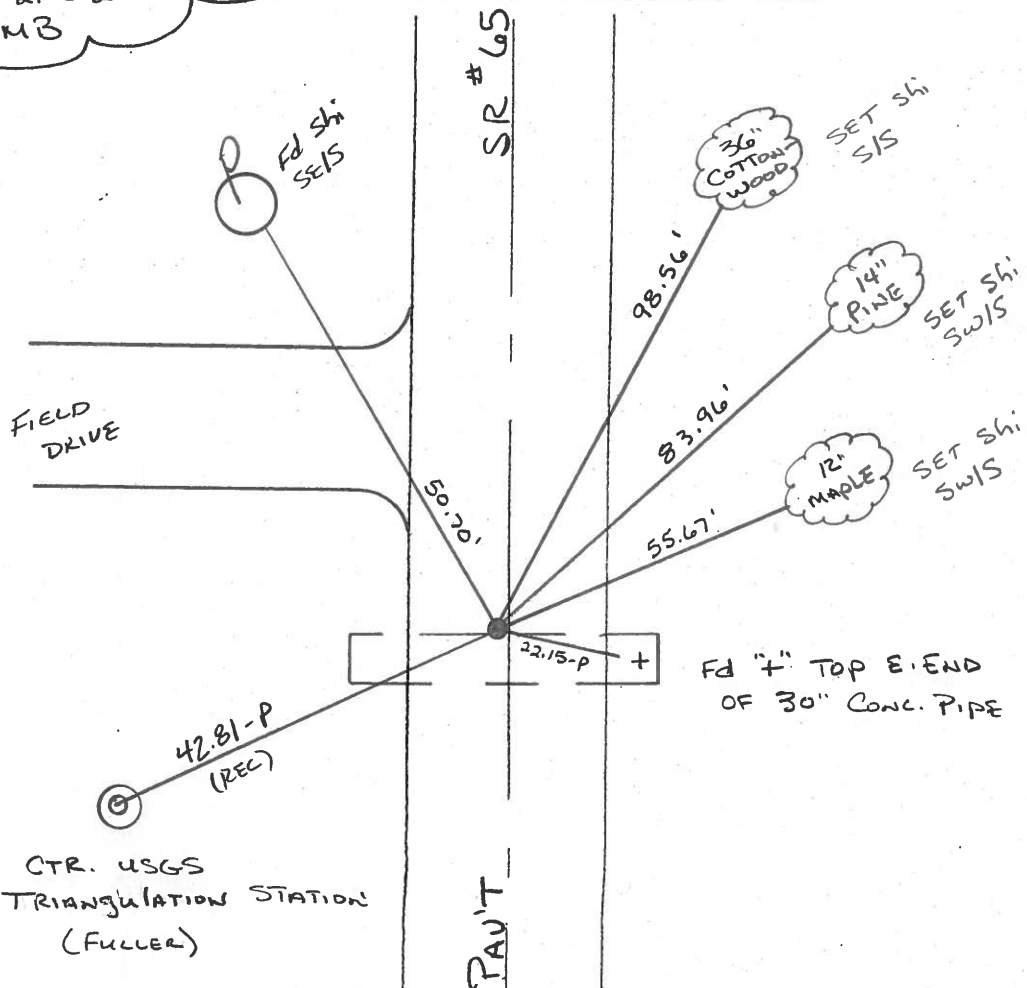

PAU'T

Railroad Spike Set by Henry Co.
Engineer's Office was Removed
During Paving Project
Date 10-05-02

O.D.O.T. DISTRICT 2 SURVEY OFFICE

PERSONNEL

REFERENCE NO. 20

SHEET OF

NOTES BARNHISEL ✓

10-05-02

H.C. " " MC

DATE 4-11-90

ROUTE 65

R.C. HOFFMAN MB

WEATHER SUNNY ✓

COUNTY Henry

TEMP. +35° +95

TOWNSHIP Richfield

SECTION 16

T 4 N R 8 E


TYPE MONUMENT Lg RR SPT WITH punch hole Removed

ON SURFACE - BELOW 1/2" 3"

LEFT - & PAV'T. - RIGHT 0.5' 0.6'


9.3' 9.4 TO LT EDGE PAVEMENT

S.L.M. 503+76 496+50 503+05

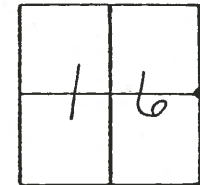

Set P.K. & Washer
5-15-90
MB

Reset Mag Nail/Washer
11-21-02
MB

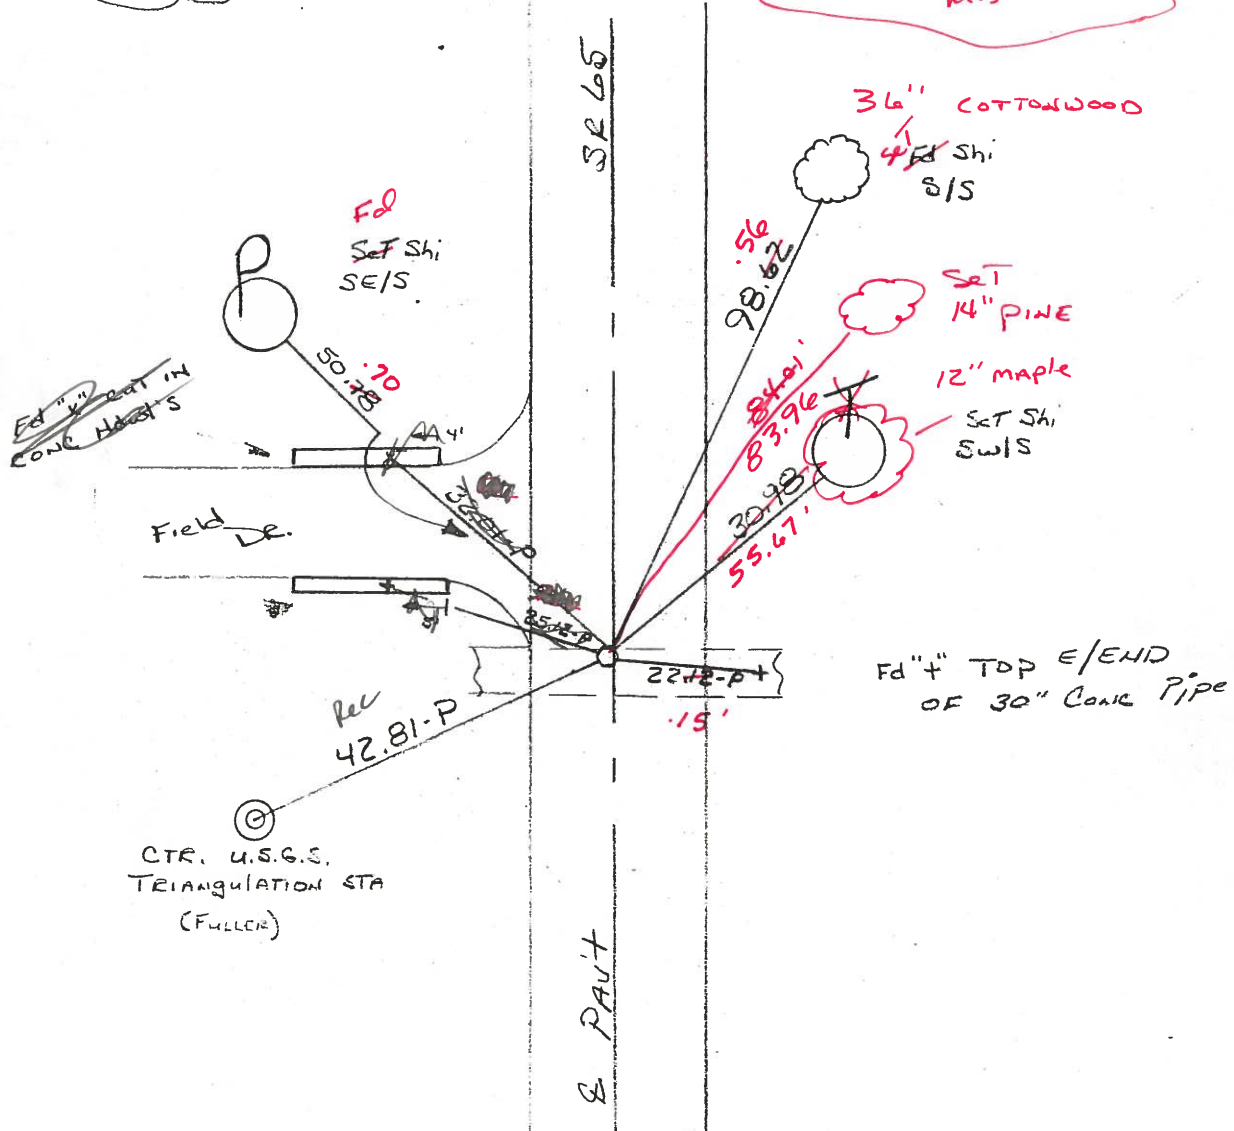

QD.O.T. DISTRICT 2 SURVEY OFFICE

SHEET _____ OF _____

County HENRY S.R. 65

Township RICHFIELD

Section 16

T4N, R8E

Personnel HOFFMAN

LOEHKE H.C.

HOUSEHOLDER R.C.


BARNHISEL

20

Date 1-27-84

Weather Cloudy

Temp. 30°

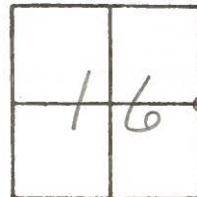

Fd R.R. SPK set by COUNTY

ON R PAUT

8.9' TO RT. EP.


9.3' TO LT. EP.


SLM 503 + 14

SET PK/WASHER

8-28-84

S.W.H.

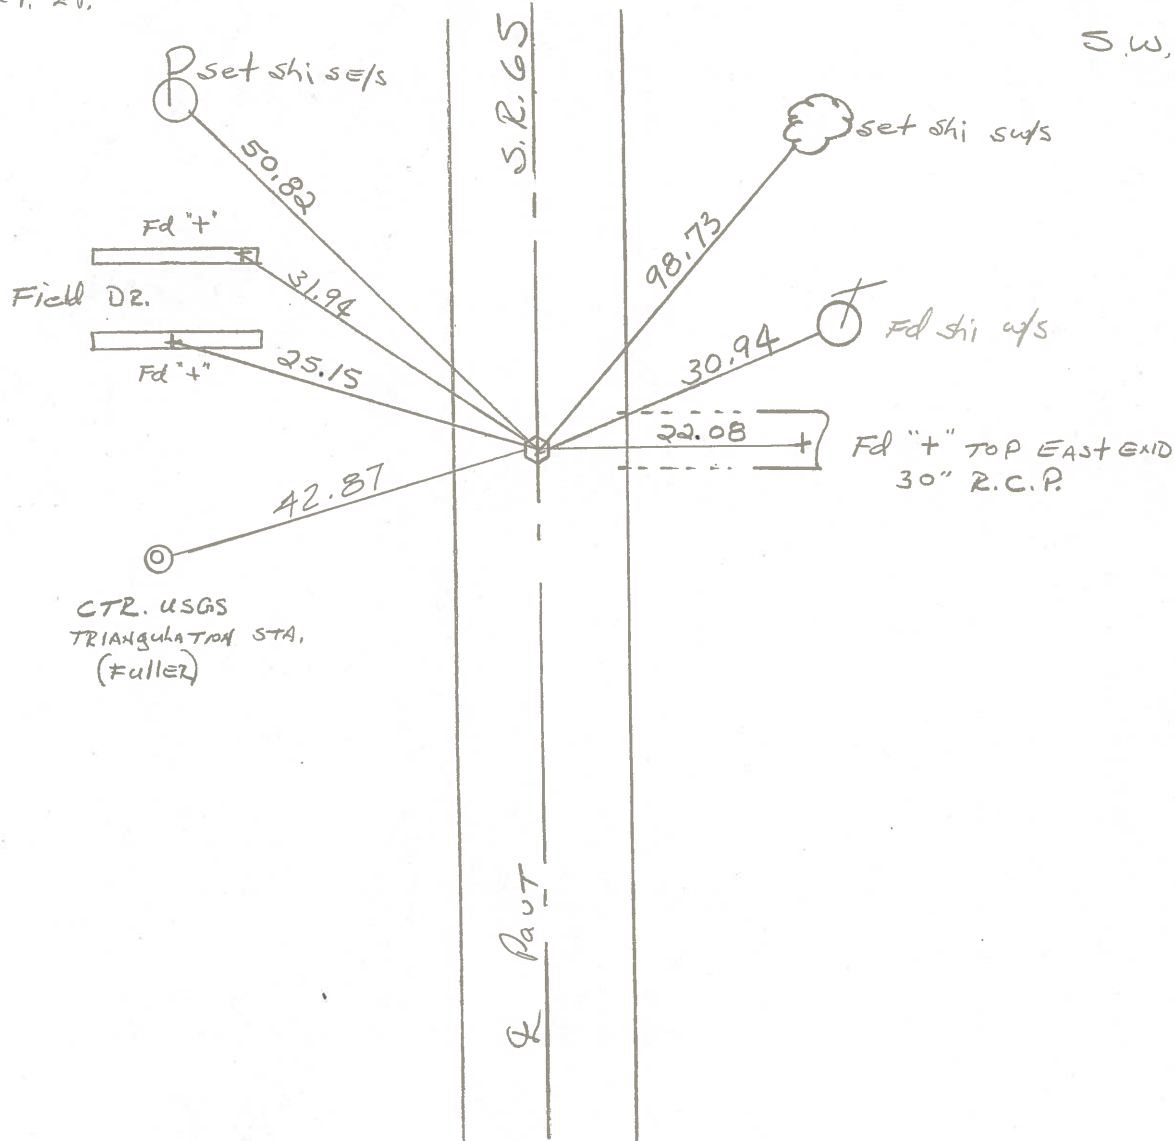

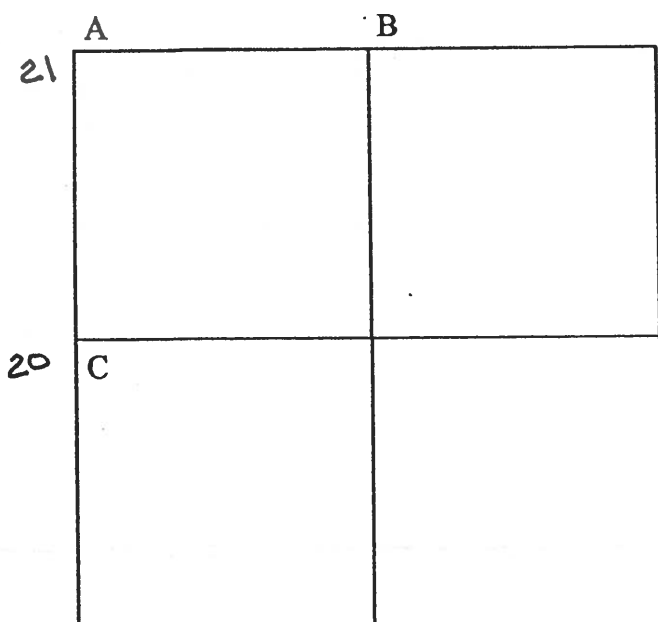

COUNTY: HENRY

TOWNSHIP: RICHFIELD

T- 4 -N R- 8 - E

SECTION: 15

20 7/31/79 R.W., J.J., G.M.
C - Found recorded RR spike 1.30' east and 0.05' north of top center of stone (8"x9"x10") 15" below road surface. Placed center punched RR spike on surface over to center of stone. Pk's 6' north and east. Stone is 9.2' east of west edge 18' pavement.

25.13' W. to "+" in conc. headwall. (P)
31.87' W.N.W. to "+" in conc. headwall. (P)
91.85' N.N.W. to shiner se/s power pole.
30.91' E.N.E. to shiner sw/s telephone pole.
78.20' S.S.W. to shiner ne/s power pole. GONE
42.82' W.S.W. to center USGS Sta. "FULLER". (P)
22.05' E.S.E. to "+" east end 30" RCP.

7/20/88 R.W., S.K., K.A.
25.13' W. to "+" in conc. headwall. (P)
32.00' N.W. to "+" in conc. headwall. (P)
50.83' N.W. to shiner se/s power pole. NEW
30.96' N.E. to shiner sw/s telephone pole.
22.07' E.S.E. to "+" east end conc. pipe. (P)
42.85' W.S.W. to center USGS Sta. "FULLER 1947". (P)

PERSONNEL	TITLE	PERSONNEL	TITLE
BURNSIDE			
SMITH			
BOWERS			
MEAD			


COUNTY HENRY DATE 11-26-74

S. R. 65 WEATHER CLEAR

SEC. E 1/4 Post SEC. 16 (RICHFIELD Twp.) TEMP. +35°

DESCRIPTION REF. TO SEC. CORNER JOB NO. _____

LEFT CENTER LINE RIGHT

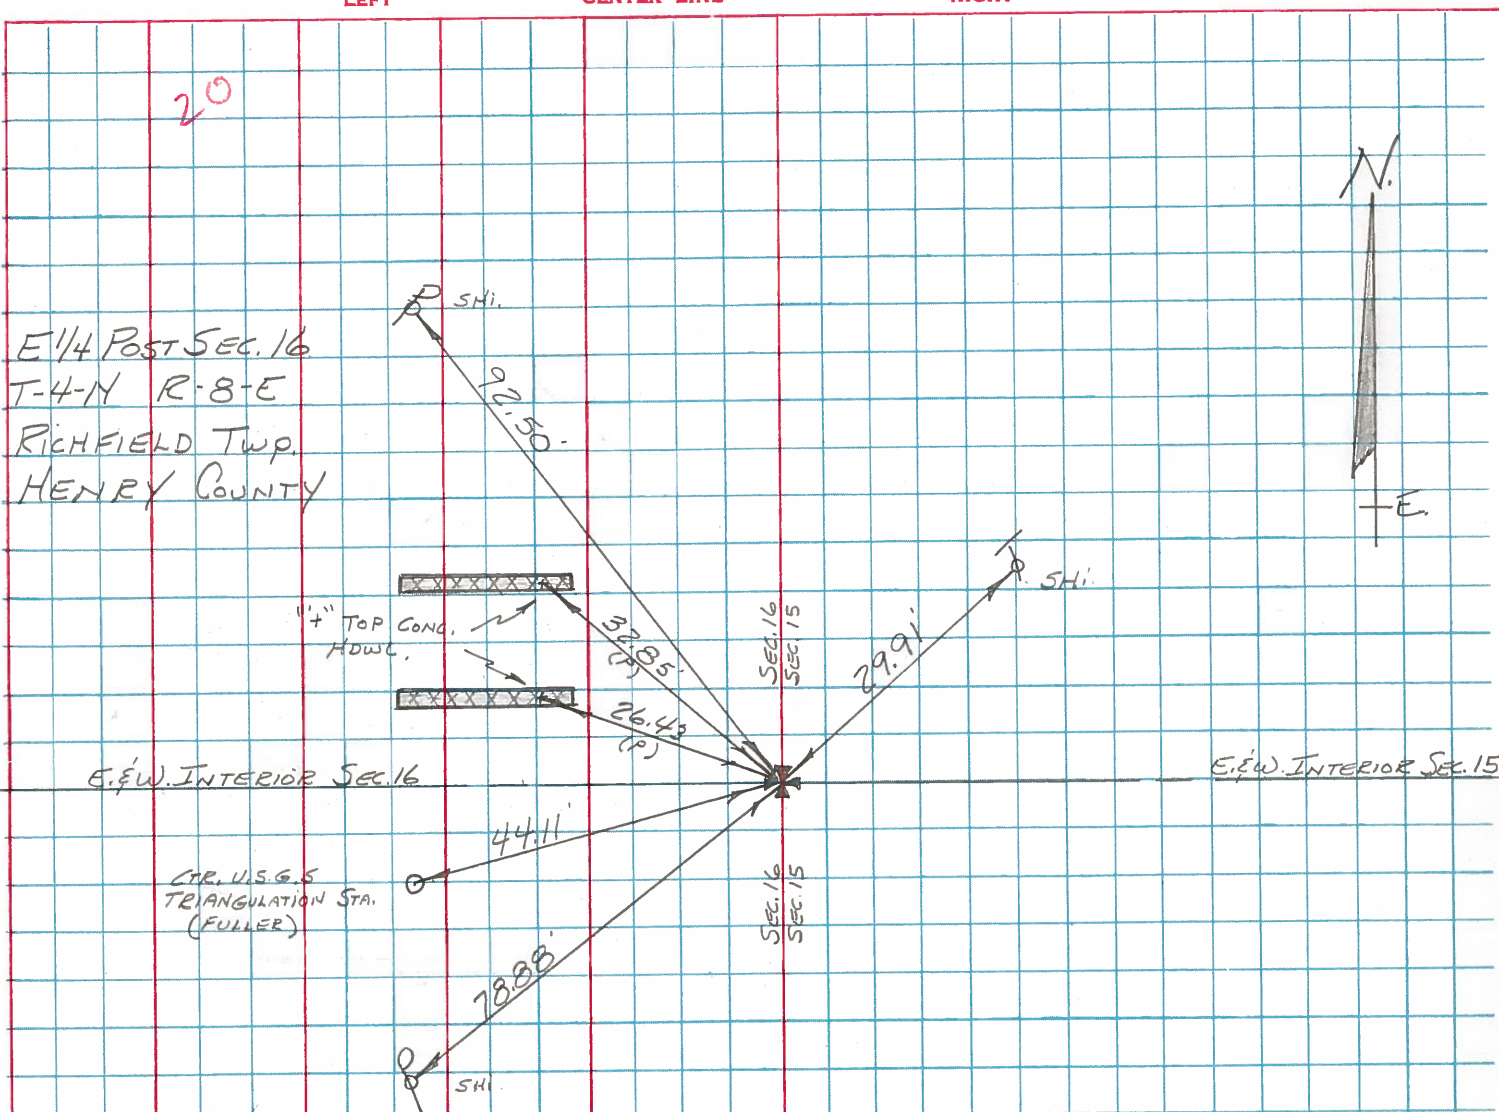


FOUND R.R. Spk @ SURFACE
E 1 1/2 E. OF CTR. PAV.
ORIGIN UNKNOWN BUT
SAID POINT WAS USED
BY R.C. JONES & H. BEHRMAN
IN PREVIOUS SURVEYS
NO RECORD OF STONE
EVER BEING SET.

PERSONNEL	TITLE	PERSONNEL	TITLE	COUNTY	DATE
Smith				Henry	4-16-1974
Bowers				S. R. 65	WEATHER Clear-Mild
Mead				SEC. Richfield Twp.	TEMP. 52°

DESCRIPTION	LEFT	CENTER LINE	RIGHT	JOB NO.
-------------	------	-------------	-------	---------

SE Corner Sec. 9
Richfield Twp.
Ed. R.R. Spike @ Surface
± SR 65

21

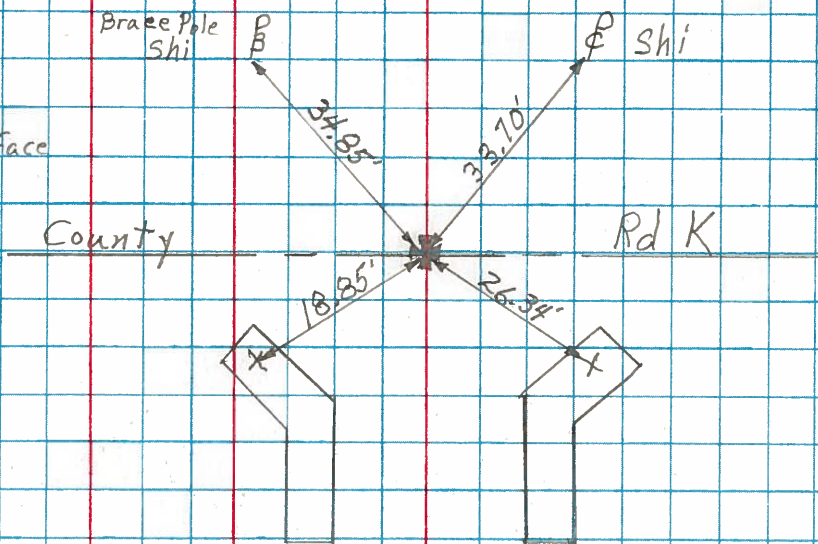

20

E 1/4 Corner Sec. 16
Richfield Twp.
Ed. R.R. Spike @ Surface
± SR 65

