

O.D.O.T. DISTRICT 2 SURVEY OFFICE (USE ONLY)

PERSONNEL

REFERENCE NO.

25 A

SHEET

30 OF

42

NOTES

BARNHISEL

DATE

10/7/02

ROUTE

SR 65

H.C.

CANTERBURY

WEATHER

SUNNY

COUNTY

HENRY

R.C.

BARNHISEL

TEMP.

59°

TOWNSHIP

RICHFIELD

SECTION

4

T 4 N R 8 E

TYPE MONUMENT

MONBOX

ON SURFACE - ~~BELOW~~

ON

LEFT - ~~C~~ PAV'T - ~~RIGHT~~ 21.9'


10.2' W TO LT EDGE PAVEMENT

S.L.M.

636+41

GRID: NORTHING: 613728.643

EASTING: 1572693.613

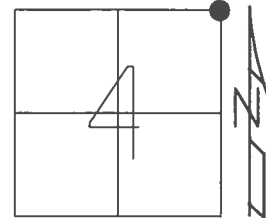

RECORD:

FD STONE W/CROSS CUT

24" DOWN

11/25/91, VANDUSEN

BOX WAS RAISED

DURING CONST.

11/20/02, MB

REF A25

7/11/12, MC


FD MONBOX

5/12/17, JFO

FD ASPHALT

COVERED MONBOX

9/26/17, JFO

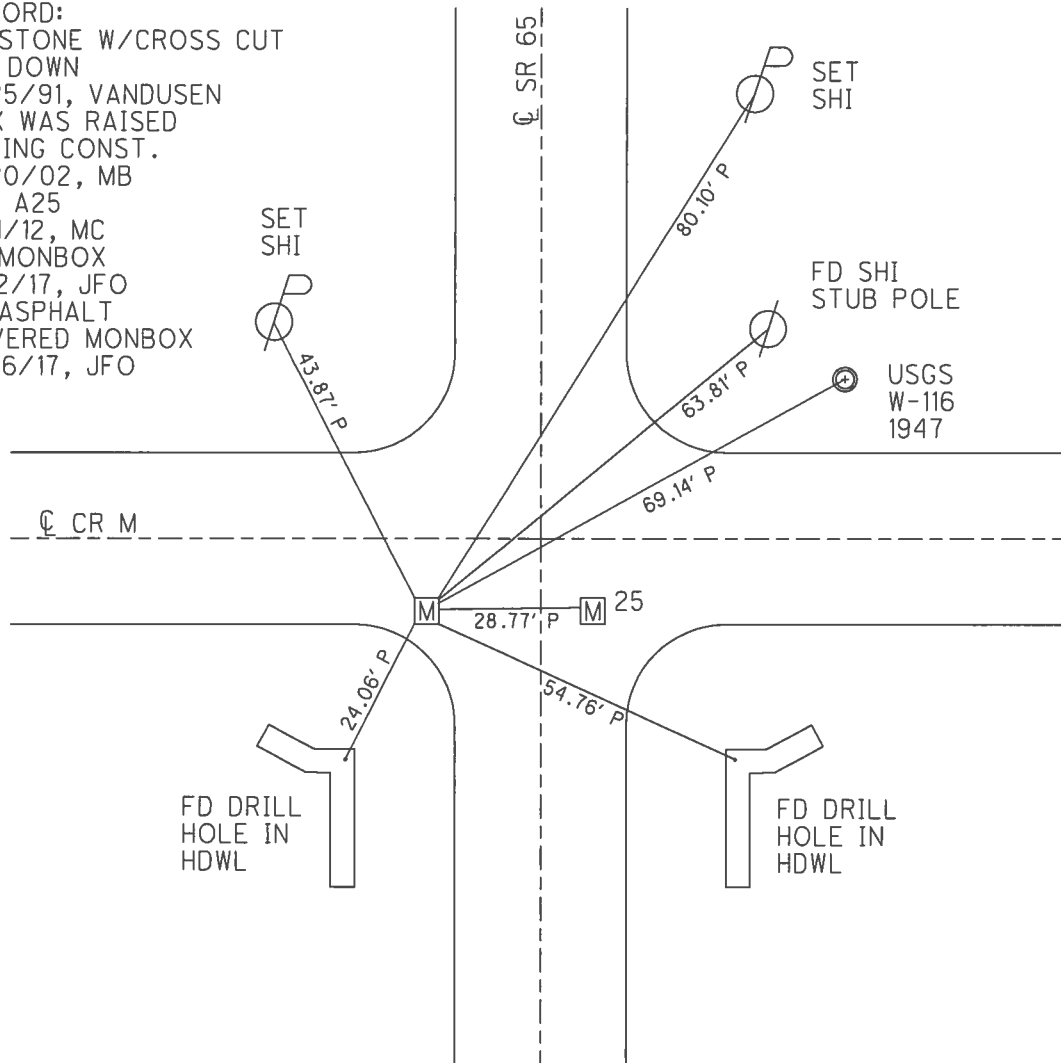

O.D.O.T. DISTRICT 2 SURVEY OFFICE (USE ONLY)

PERSONNEL

REFERENCE NO. 25 A

SHEET 30 OF 42

NOTES BARNHISEL

DATE 10/7/02

ROUTE SR 65

H.C. CANTERBURY

WEATHER SUNNY

COUNTY HENRY

R.C. BARNHISEL

TEMP. 59°

TOWNSHIP RICHFIELD

SECTION 4

T 4 N R 8 E

TYPE MONUMENT MONBOX


ON SURFACE - ~~BELOW~~ ON

LEFT - Q PAV'T - ~~RIGHT~~ 21.9'

- TO - EDGE PAVEMENT (10.2' W. OF W. EDGE)

S.L.M. 636+41


Grid: Northing: 613728.643 Easting: 1572693.613

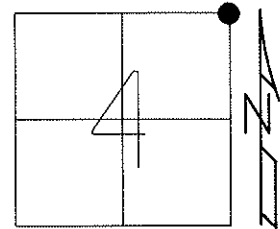

BOX WAS RAISED DURING CONST.
11/20/02, MB

RECORD:
FD STONE W/CROSS CUT
24" DOWN
11/25/91, VANDUSEN

GPS, REF A25
7/11/12
FIN A25, 3/15/13
MC

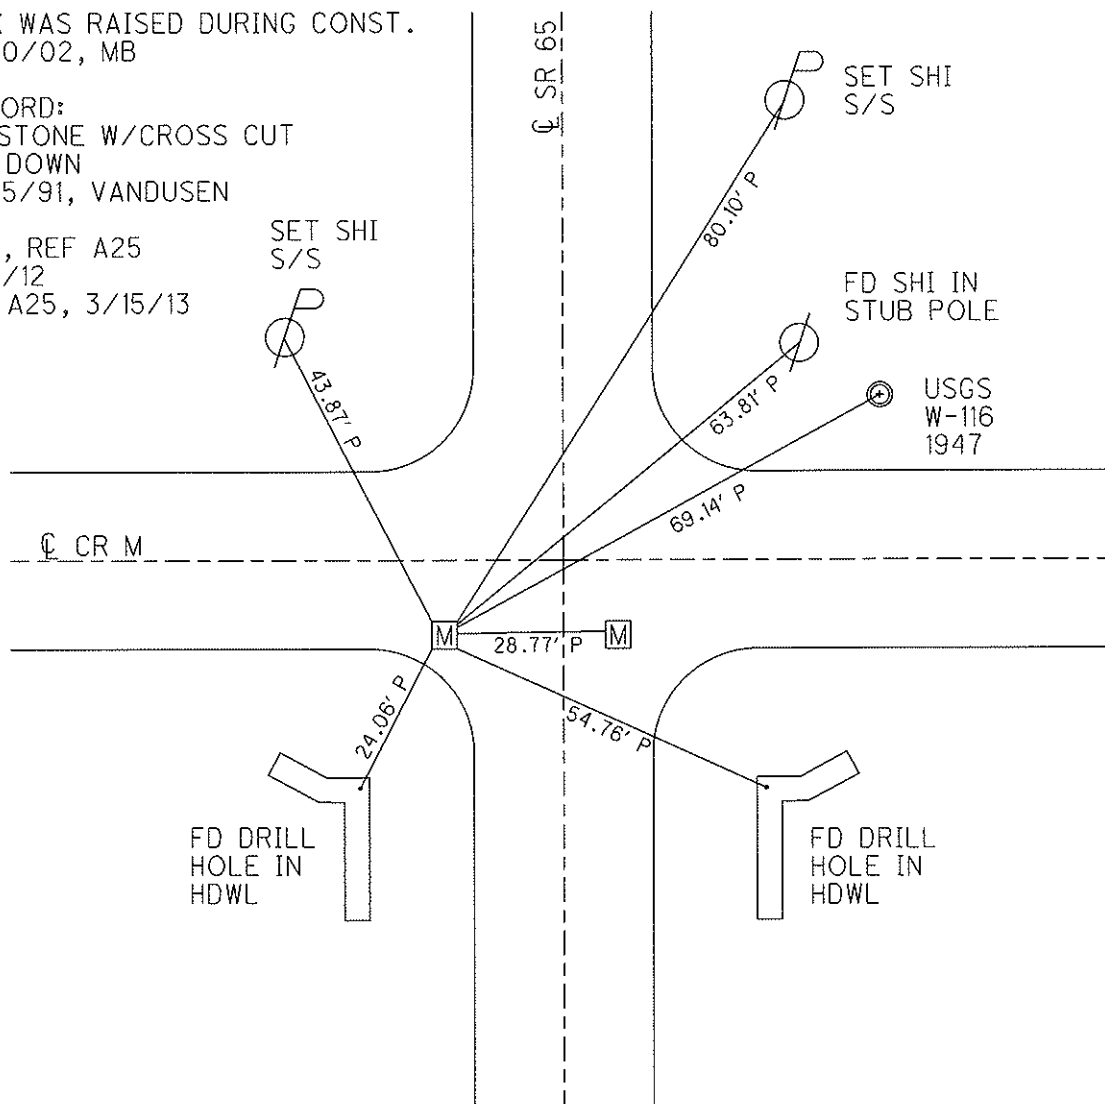

O.D.O.T. DISTRICT 2 SURVEY OFFICE

PERSONNEL

NOTES BARNHISEL RC

H.C. CANTERBURY

R.C. _____

REFERENCE NO. 25

DATE 10-07-02

WEATHER SUNNY

TEMP. +59°

SHEET 27 OF 29

ROUTE 65

COUNTY HENRY


TOWNSHIP RICHFIELD/DAMACUS

SECTION 4

T 4 N R 8 E

DAMACUS TWP

RICHFIELD TWP

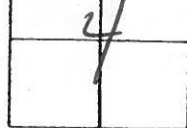

TYPE MONUMENT I. PIN IN MON. BOXES

ON SURFACE - BELOW YES

LEFT - E PAV'T. - RIGHT PT "A" 10.2' W. OF W. Edge

- TO - EDGE PAVEMENT PT "B" 5.0' W. OF E. Edge

S.L.M. 636+41 PT "A" 21.9' LT OF E PT "B" 7.5' RT OF E

Boxes were RAISED during CONST.

11-20-02

MB

RECORD:

PT "A", Fd STONE
W/CROSS CUT 24" DOWN

PT "B" Fd STONE
18" DOWN, USED
HIGH POINT

VAN DUSEN
11-25-91

SET SHI
S/S


SET SHI
S/S

Fd SHI
IN STUB POLE

USGS
"W-116" 1947

E PAV'T.

Co. Rd. "M"

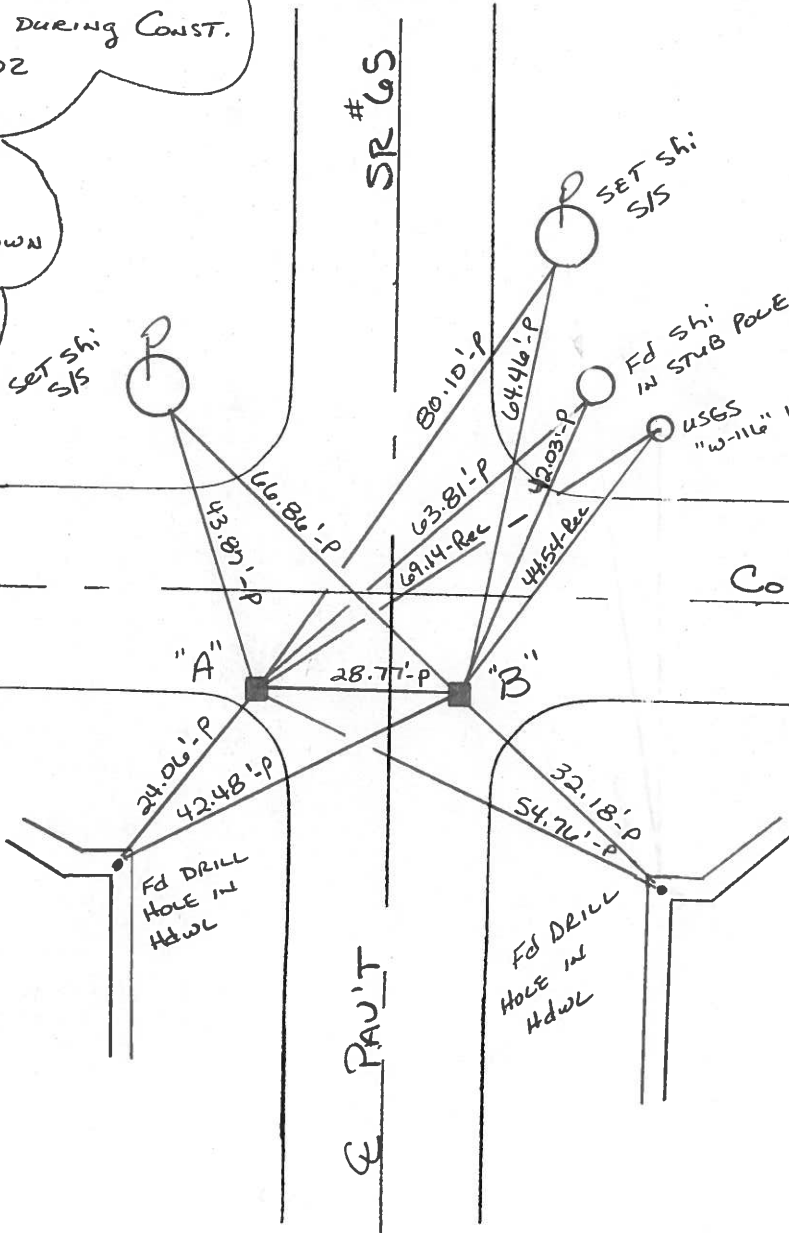

O.D.O.T. DISTRICT 2 SURVEY OFFICE

PERSONNEL

REFERENCE NO. 25

SHEET OF

NOTES VAN DUSEN

H.C. VAN DUSEN

R.C. BARNHISEL

LONG

DATE 11-25-91

WEATHER CLEAR

TEMP. +28° F

ROUTE 65

COUNTY HENRY

TOWNSHIP RICHFIELD/DAMACUS

SECTION

T 5 R 8 E

LOOSE PT A I. PINS in Mon. Boxes

TYPE MONUMENT STONE STONE

ON SURFACE - BELOW yes yes

LEFT- & PAV'T. - RIGHT 21.9'S. 7.5'S.

TO EDGE PAVEMENT PTA 10.2' W. of W. Edge

S.L.M. 636+52 PTB 50' W. of E. Edge RICHFIELD 4 3 629+88


DAMACUS	33	34
RICHFIELD	4	3



NOTE: CONTRACTOR IS INSTALLING
MON. BOXES OVER STONES ON ABOVE DATE
IRON PINS TO BE CUT & SET IN CONC OVER STONES

636+41

A" 0.35' Down
B" 0.37' Down

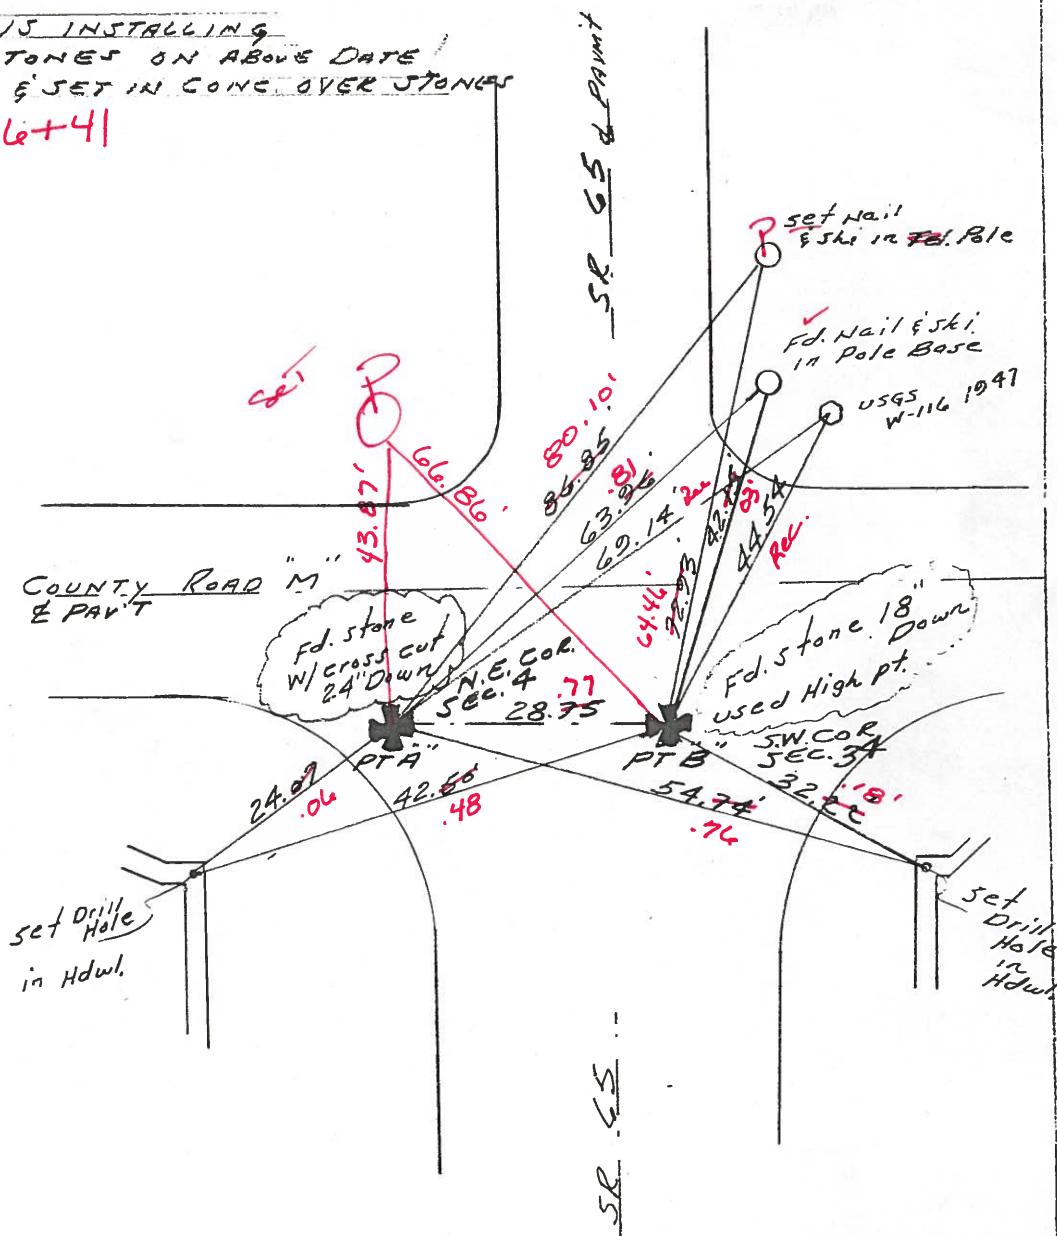

O.D.O.T. DISTRICT 2 SURVEY OFFICE

PERSONNEL

REFERENCE NO. 25

SHEET OF

NOTES BARNHISEL

H.C. " "

R.C. HOFFMAN

DATE 4-11-90

WEATHER cloudy

TEMP. +40°

ROUTE 65

COUNTY HENRY

TOWNSHIP RICHFIELD/DAMACUS

SECTION

T 5/4 N R 8 E

TYPE MONUMENT P.K.'s & Washers

ON SURFACE - BELOW YES YES

LEFT- & PAV'T. - RIGHT 16.8 12.0

- TO - EDGE PAVEMENT

S.L.M. 636+52

DAMACUS -

33	34
4	3


Twp

Twp



PT "A" - 9.2 S. OF & WEST RICHFIELD -
PT "B" - 9.9, 8.0 OF & EAST

Set P.K. & Washer
5-15-90
MB

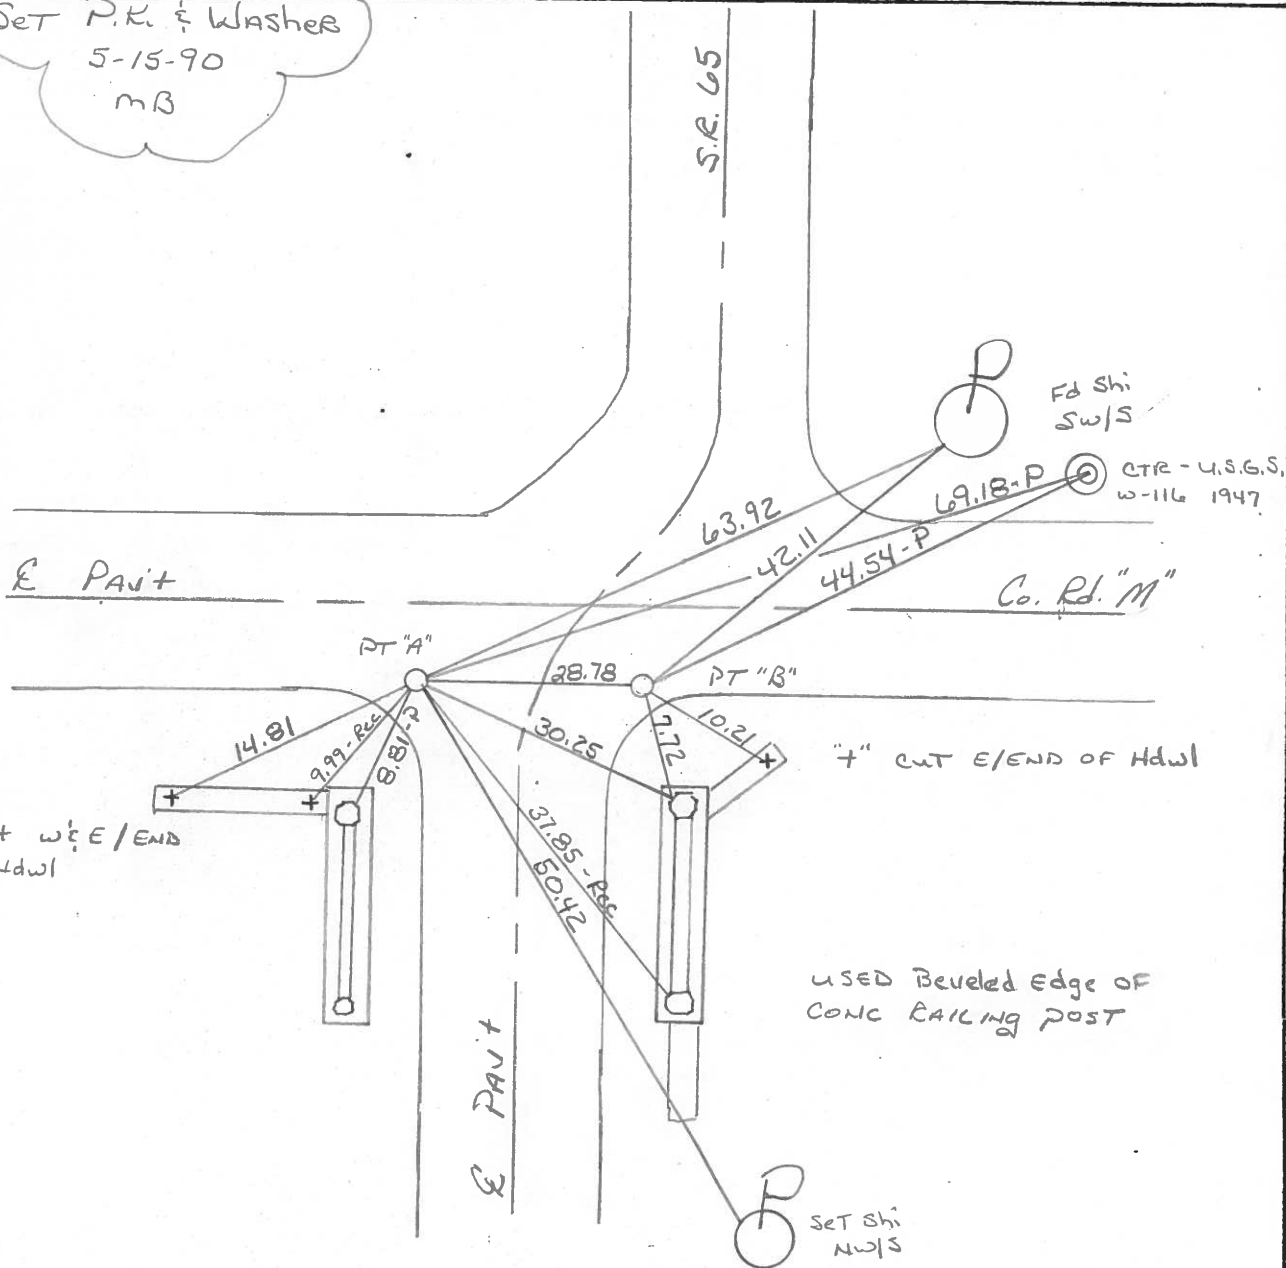

Q.D.O.T. DISTRICT 2 SURVEY OFFICE

SHEET _____ OF _____

County HENRY S.R. 65

Township RICHFIELD / DAMASCUS

Section _____

T4N, R8E

Personnel HOFFMAN

LOEHRLER H.C.

HOUSEHOLDER R.C.

BARNHISEL

25

Date 1-27-84

Weather cloudy

Temp. 30°

DAMASCUS	33	34	TWP.
RICHFIELD	4	3	TWP




"A" = Fd CTR. PUNCHED R.R. SPK set BY COUNTY
@ SURFACE

17.8' LT. of & SR 65 PAUT
9.0' S. of & Co. Rd. "m" PAUT

N.E. CORNER Section 4
RICHFIELD TWP.

S 2 M = 636 + 50

SET PK/WASHER @
BOTH POINTS 8-28-84
S.W.H.

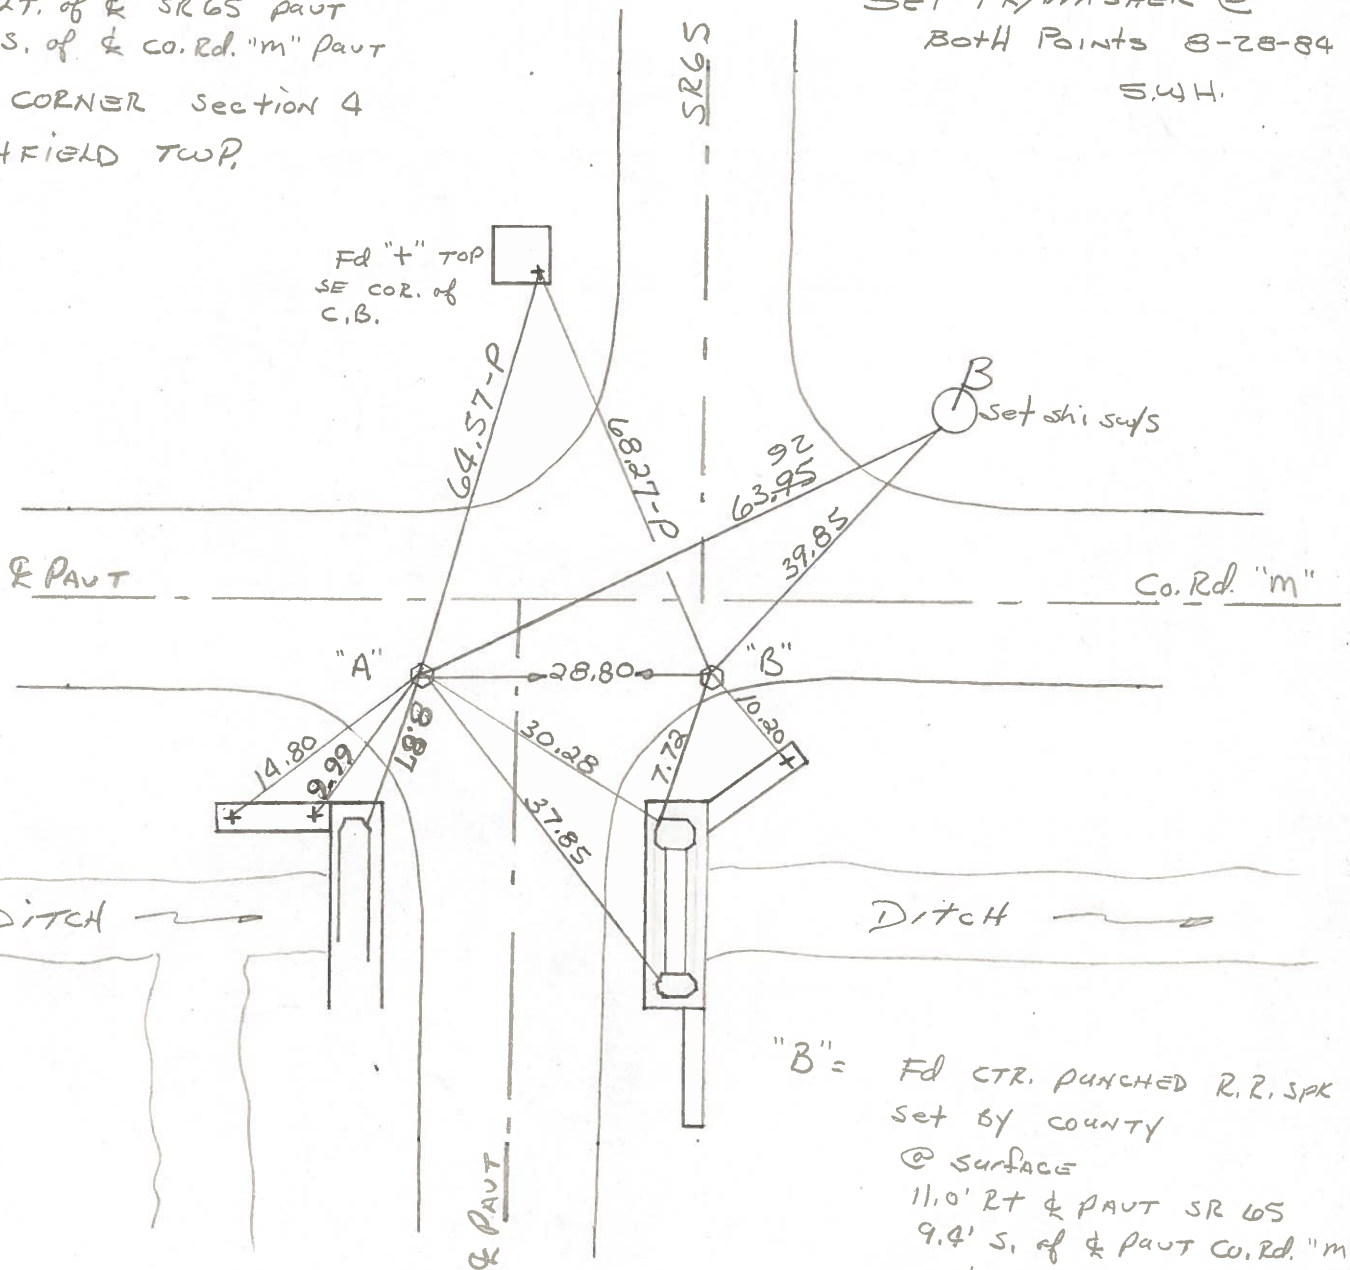


"B" = Fd CTR. PUNCHED R.R. SPK
set BY COUNTY
@ SURFACE
11.0' RT of PAUT SR 65
9.4' S. of PAUT Co. Rd. "m"
S.W. CORNER SECTION 34
DAMASCUS TWP.

SHEET _____ OF _____

"B" = Fd CTR. punched R.R. spike
Set by county
@ surface
11.0' RT & PAUT SR 605
9.4' S. of & PAUT Co. Rd "m"
S.W. CORNER SECTION 34
DAMASCUS TWP

25-A

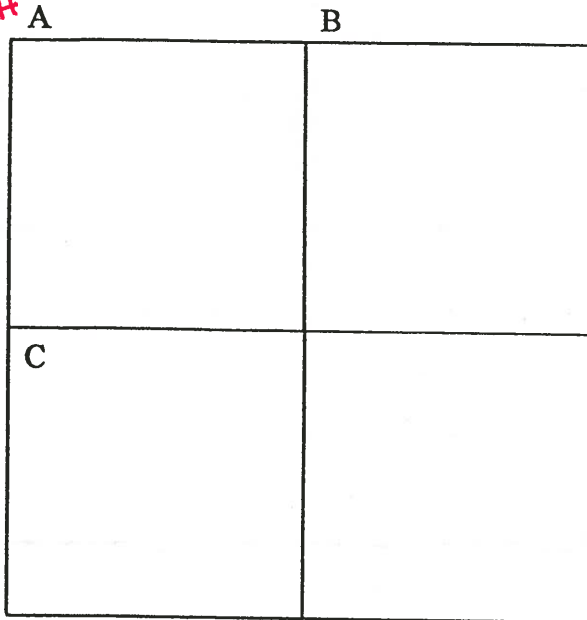

COUNTY: HENRY

TOWNSHIP: RICHFIELD

T- 4 -N R- 8 - E

SECTION: 3

25-A

8/1/79 R.W., J.J., G.M.

A - Found recorded RR spike in iron pipe over iron pin on n/s of top stone. Top stone was 0.25' north and 0.42' west of top center of true stone (6"x6"x20") 22" below road surface. Removed RR spike, iron pipe, iron pin, and top stone. Placed center punched RR spike on surface over top center of stone. Pk's 6' north and east. Stone is 8.2' west of west edge pavement.

64.52' N. to "+" SE corner catch basin. (P)

69.15' E.N.E. to center USGS bench mark "W-116 1947". (P)

38.74' S.E. to SW corner bridge rail.

9.94' S.S.W. to "+" in conc. wingwall. (P)

14.78' S.W. to "+" in west end conc. wingwall.

28.79' E. to SW Corner, Sec. 34: Damascus Twp.

7/13/88 R.W., S.K., K.A.

Found nail/shiner and Pk's north and east.

64.52' N. to "+" SE corner catch basin. (P)

69.14' E.N.E. to center USGS bench mark "W-116 1947". (P)


37.98' E.S.E. to "+" north end NE wingwall. (P)

9.93' S.S.W. to "+" in top of conc. wingwall. (P)

14.80' S.W. to "+" west end conc. wingwall. (P)

PERSONNEL	TITLE	PERSONNEL	TITLE	COUNTY	DATE	WEATHER	TEMP.
BURNSIDE				HENRY	5-13-75	CLEAR	+63°
SMITH				S. R. 65			
BOWERS				SEC. TOWNSHIP LINE			
MEAD							

DESCRIPTION REF. TO SEC. CORNERS (RICHFIELD & DAMASCUS TWP) JOB NO.

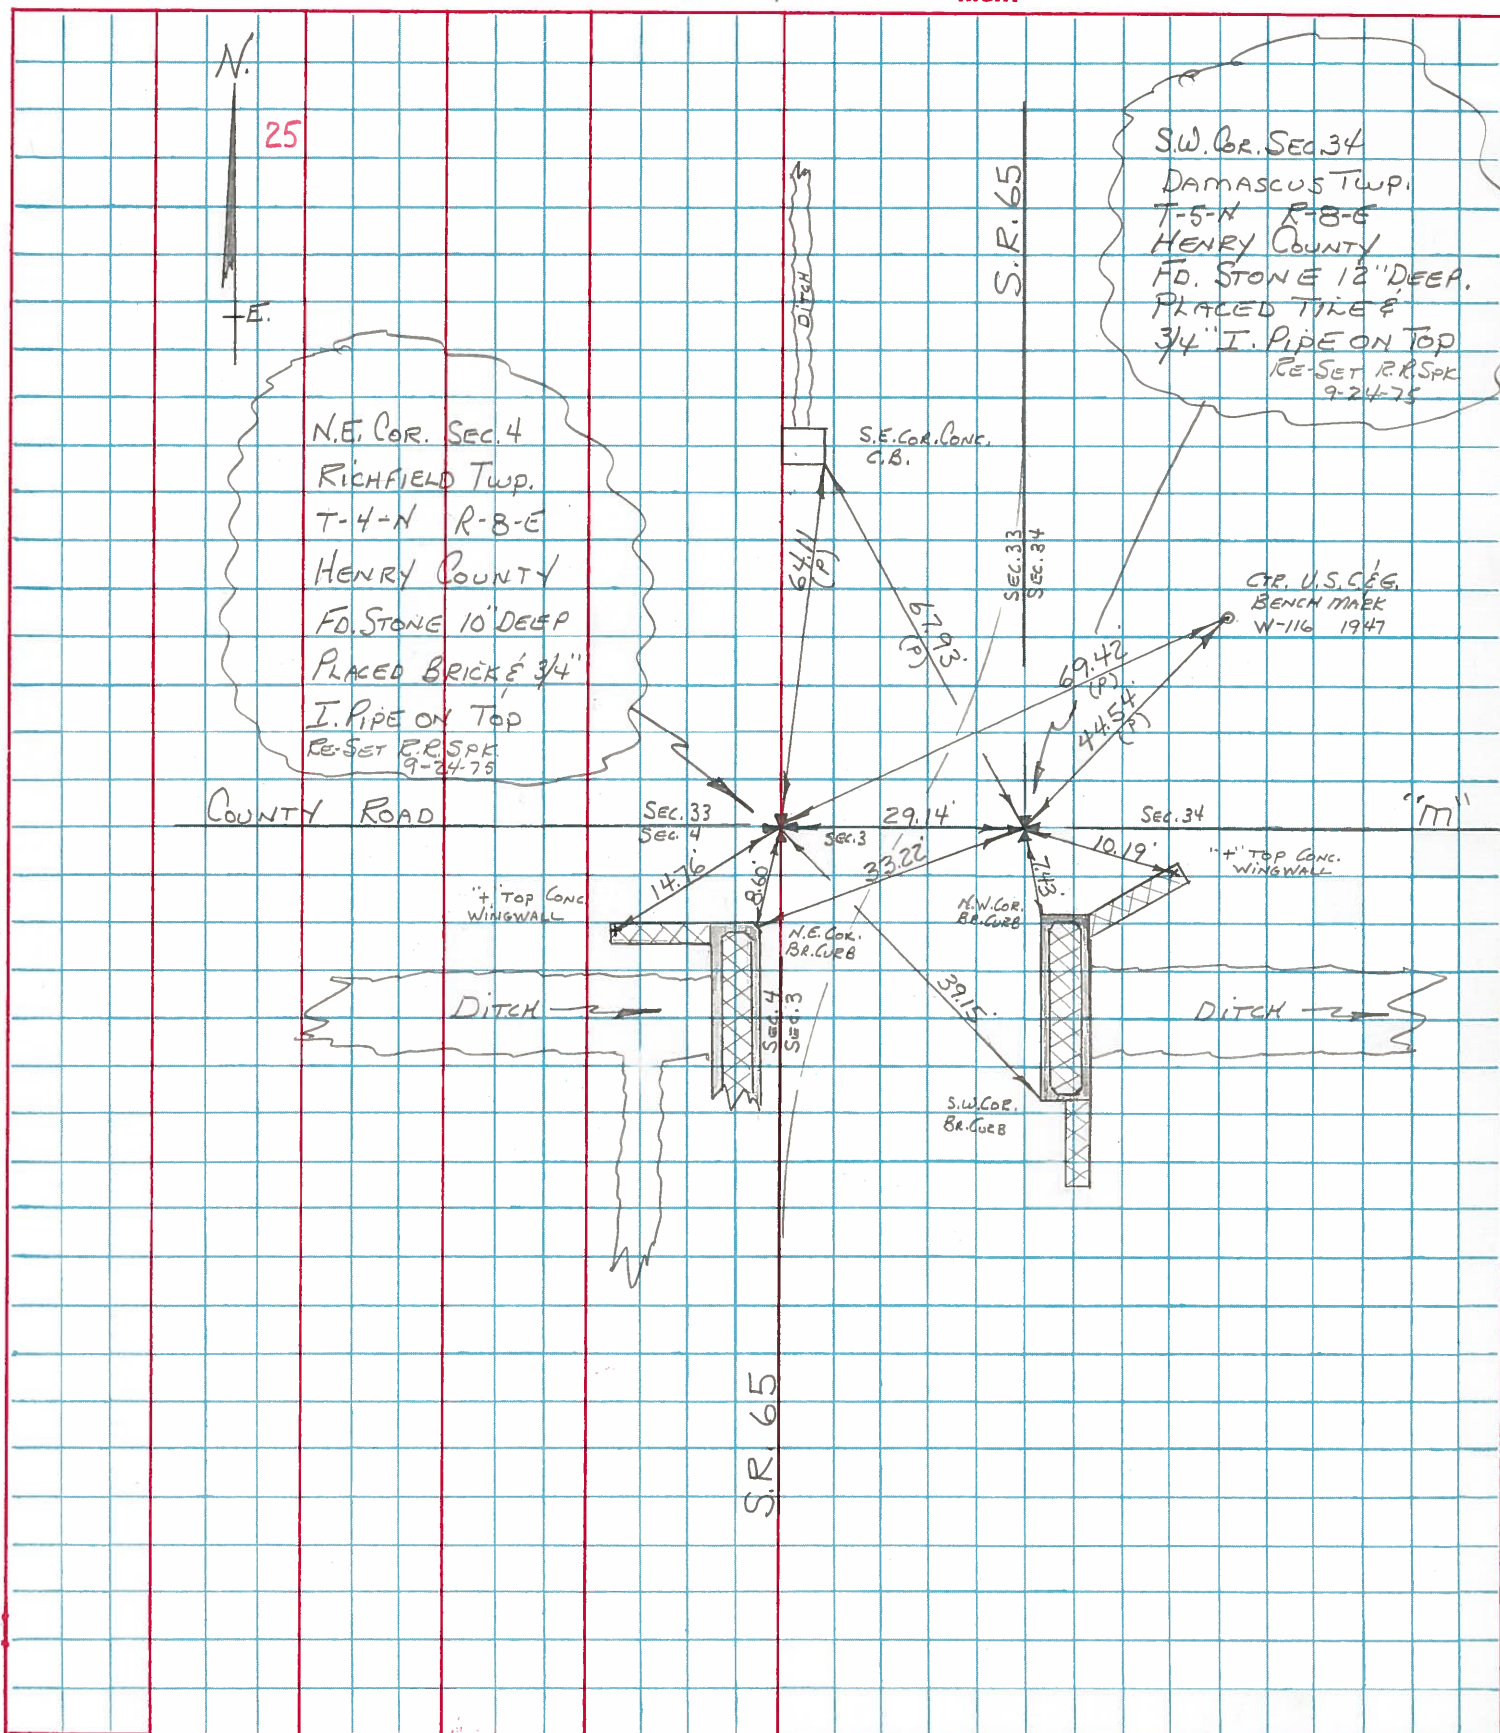

PERSONNEL	TITLE	PERSONNEL	TITLE	COUNTY	DATE	S. R.	WEATHER	SEC.	TEMP.
Smith				Henry	4-16-1974	65	Clear-Mild	Damascus & Richfield Twp.	52°
Bowers									
Mead									

DESCRIPTION ± Control Ties LEFT CENTER LINE RIGHT JOB NO. _____

