

O.D.O.T. DISTRICT 2 SURVEY OFFICE (USE ONLY)

PERSONNEL

REFERENCE NO. 1

SHEET 1 OF 21

NOTES GARRETT

DATE 7/6/20

ROUTE SR 108

H.C. LEU

WEATHER PTLY CLOUDY

COUNTY HENRY

R.C. MAHLER

TEMP. 93°

TOWNSHIP PLEASANT

AUBLE

SECTION 35

DWG BY NIESE

PID 95739

T 3 N R 6 E

TYPE MONUMENT MAG/WASHER

ON SURFACE - ~~BELOW~~ ON

OFFSET Q PAVEMENT ON LT : RT

10.1' TO LT EDGE PAVEMENT


STATION: 0+00

HORIZ.DATUM: NAD83 (2011)

GEOID: NAVD88 2012A


GRID: NORTHING: 550587.432

EASTING: 1519269.750

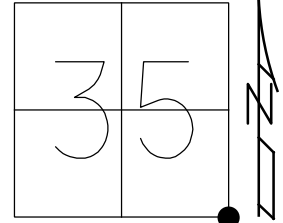

RECORD:
FD SMALL R.R. SPIKE
4/29/03, MB
SET MAG/WASHER
10/30/03, MB
FD MAG/WASHER
REF1
2/14/19, JLL
SET MAG/WASHER
12/14/20, DSA

DIST. 1-1AA= 29.45'

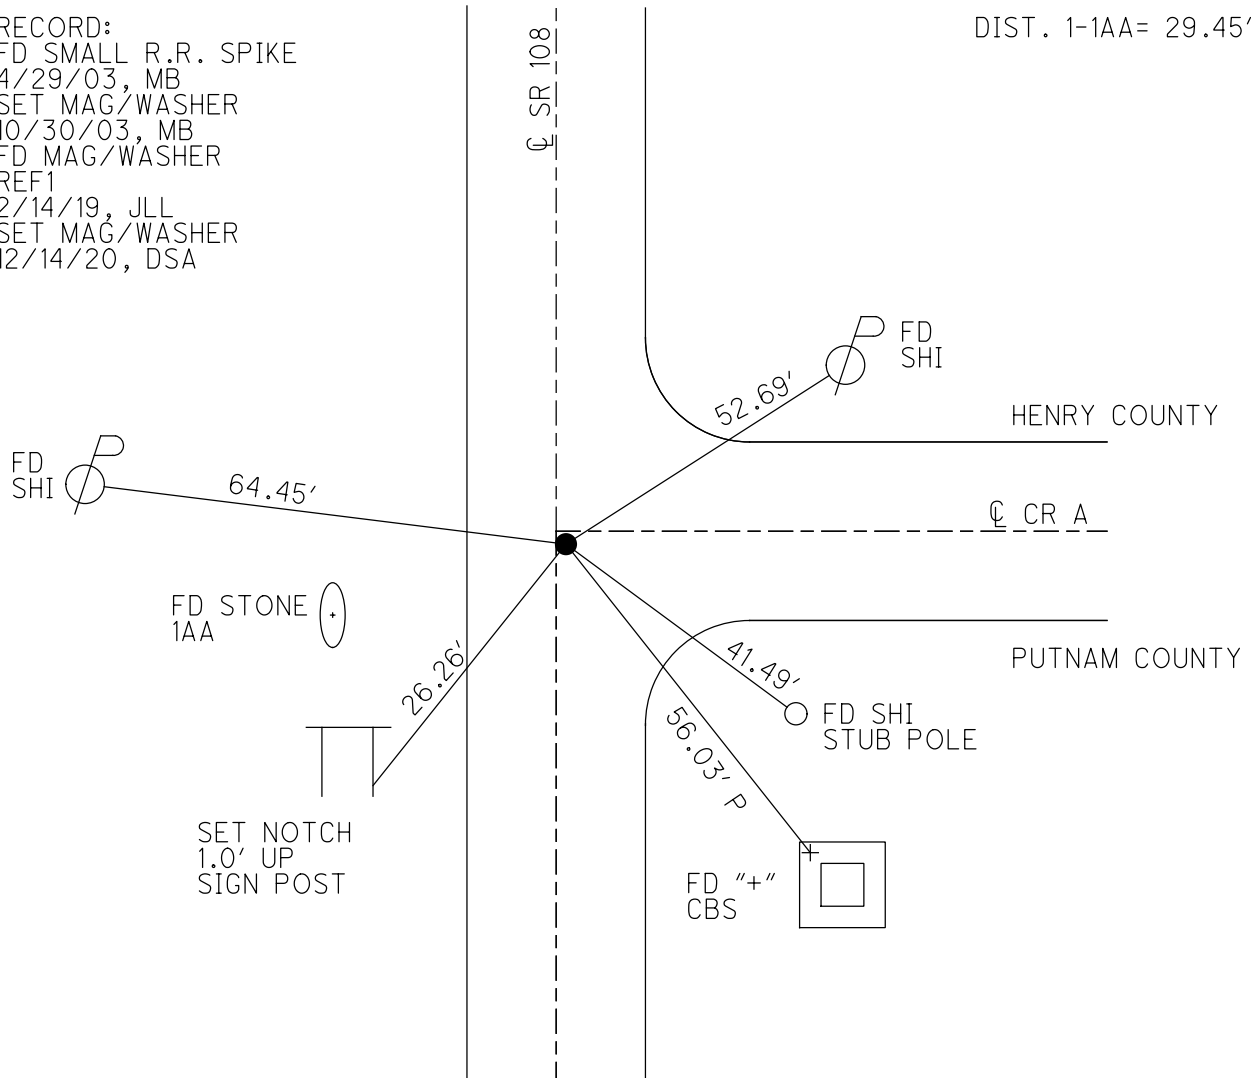

O.D.O.T. DISTRICT 2 SURVEY OFFICE (USE ONLY)

PERSONNEL

REFERENCE NO. 1 AA

SHEET 2 OF 21

NOTES GARRETT

DATE 7/6/20

ROUTE SR 108

H.C. LEU

WEATHER PTLY CLOUDY

COUNTY HENRY

R.C. MAHLER

TEMP. 93°

TOWNSHIP PLEASANT

AUBLE

SECTION 36

DWG BY NIESE PID 95739

T 3 N R 6 E

TYPE MONUMENT STONE W/ X

ON SURFACE - ~~BELOW~~ ON

OFFSET Q PAVEMENT - LT : RT

16'± TO LT EDGE PAVEMENT


STATION: 0+00

HORIZ.DATUM: NAD83 (2011)

GEOID: NAVD88 2012A


GRID: NORTHING: 550587.779

EASTING: 1519240.327

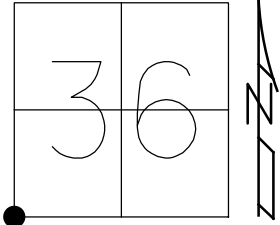

RECORD:
FD "+" ATOP
STONE
IN DITCH BANK
REFAA1
N: 550587.780
E: 1519240.327
7/5/20, JLL

DIST. 1-1AA= 29.45'

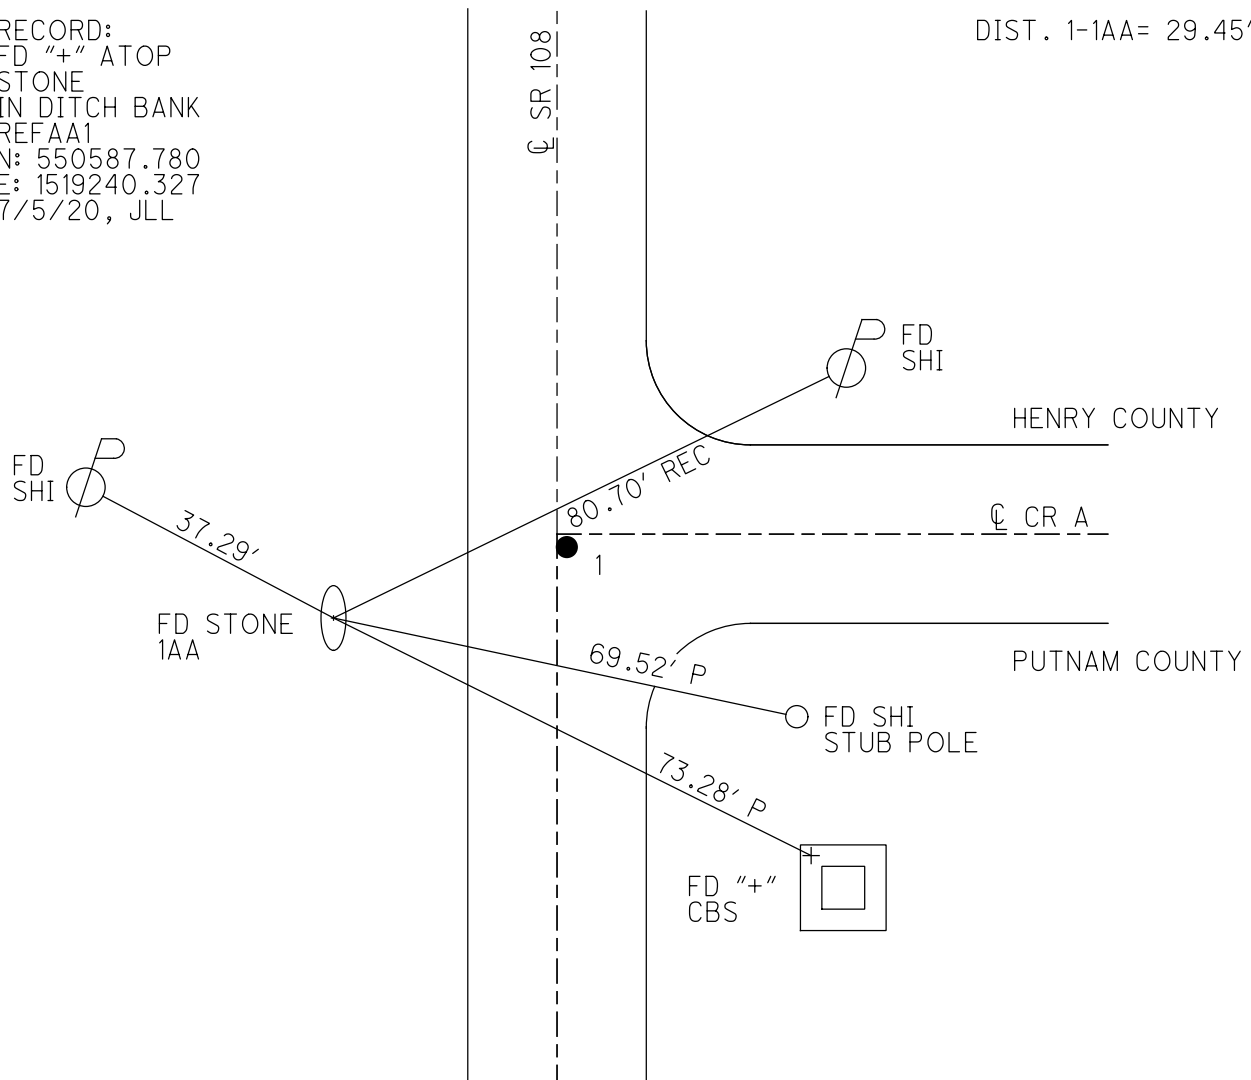

O.D.O.T. DISTRICT 2 SURVEY OFFICE (USE ONLY)

PERSONNEL

REFERENCE NO. 1 A

SHEET 3 OF 21

NOTES GARRETT

DATE 7/6/20

ROUTE SR 108

H.C. LEU

WEATHER CLEAR

COUNTY HENRY

R.C. MAHLER

TEMP. 81°

TOWNSHIP PLEASANT

AUBLE

SECTION 35

DWG BY NIESE

PID 95739

T 3 N R 6 E

TYPE MONUMENT 1/2" IPIPE

~~ON SURFACE~~ - BELOW 6.5'

OFFSET Q PAVEMENT 8.8' LT : ~~RT~~

1.7' TO LT EDGE PAVEMENT


STATION: 26+42.28

HORIZ.DATUM: NAD83 (2011)

GEOID: NAVD88 2012A

GRID: NORTHING: 553229.869

EASTING: 1519278.304

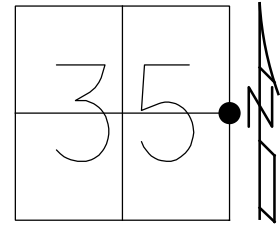

RECORD:
FD 1/2" IPIPE
OVER STONE
FD P.K./WASHER
3" DOWN
4/29/03, MB
SET MAG/WASHER
10/30/03, MB
FD MAG NAIL
2/14/19, JLL
FD MAG NAIL
ON SURFACE
FD SM R.R.SPIKE
5" DOWN
REFA1
FD 1/2" IPIPE
6.5" DOWN
REFA1P
HIT CLAY
15" DOWN
7/6/20, JLL
SET MAG/WASHER
12/14/20, DSA

FD
SHI



41.77'

Q SR 108

37.25'

37.47'

40.80'

FD
SHI



SET NOTCH
2' UP
STOP SIGN

Q CR A-2



CNTR OF MOST
WESTERNLY
METAL PIPE IN
CONCRETE PAD

O.D.O.T. DISTRICT 2 SURVEY OFFICE (USE ONLY)

PERSONNEL

REFERENCE NO. 2

SHEET 4 OF 21

NOTES GARRETT

DATE 7/7/20

ROUTE SR 108

H.C. AUBLE

WEATHER SUNNY

COUNTY HENRY

R.C. MAHLER

TEMP. 79°

TOWNSHIP PLEASANT

SECTION 35

DWG BY NIESE

PID 95739

T 3 N R 6 E

TYPE MONUMENT SM R.R. SPIKE

~~ON SURFACE~~ - BELOW 3"

OFFSET Q PAVEMENT 8.4' LT : ~~RT~~

1.0' TO LT EDGE PAVEMENT


STATION: 52+85.76

HORZ. DATUM: NAD83 (2011)


GEOID: NAVD88 2012A

GRID: NORTHING: 555873.073

EASTING: 1519310.038

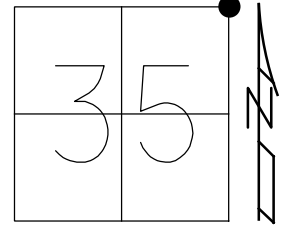

RECORD:
FD P.K./WASHER
4/29/03, MB
SET MAG/WASHER
10/30/03, MB
FD MAG SHANK
REF2
2/14/19, JLL
10/4/19, JFO
FD SM.R.R. SPIKE
3" DOWN
7/7/20, DSA
SET MAG/WASHER
12/14/20, DSA

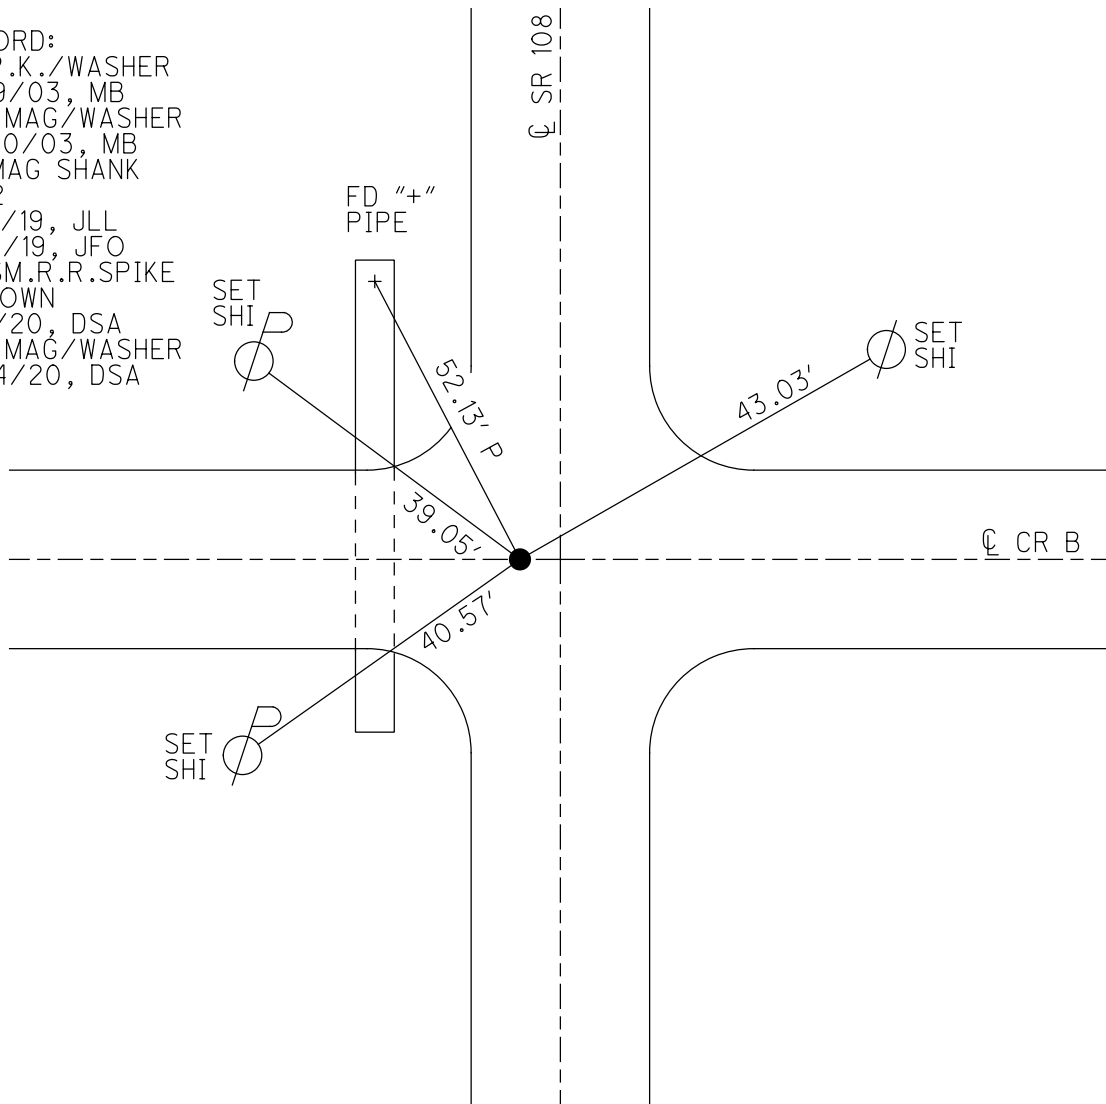

O.D.O.T. DISTRICT 2 SURVEY OFFICE (USE ONLY)

PERSONNEL

REFERENCE NO. 2 A

SHEET 5 OF 21

NOTES GARRETT

DATE 7/7/20

ROUTE SR 108

H.C. AUBLE

WEATHER SUNNY

COUNTY HENRY

R.C. MAHLER

TEMP. 79°

TOWNSHIP PLEASANT

SECTION 26

DWG BY NIESE

PID 95739

T 3 N R 6 E

TYPE MONUMENT R.R.SPIKE

~~ON SURFACE~~ - BELOW 2.5"

OFFSET Q PAVEMENT 9.3' ~~LT~~ : RT

- TO - EDGE PAVEMENT



STATION: 91+67.42

HORZ.DATUM: NAD83 (2011)

GEOID: NAVD88 2012A

GRID: NORTHING: 559754.419

EASTING: 1519358.887

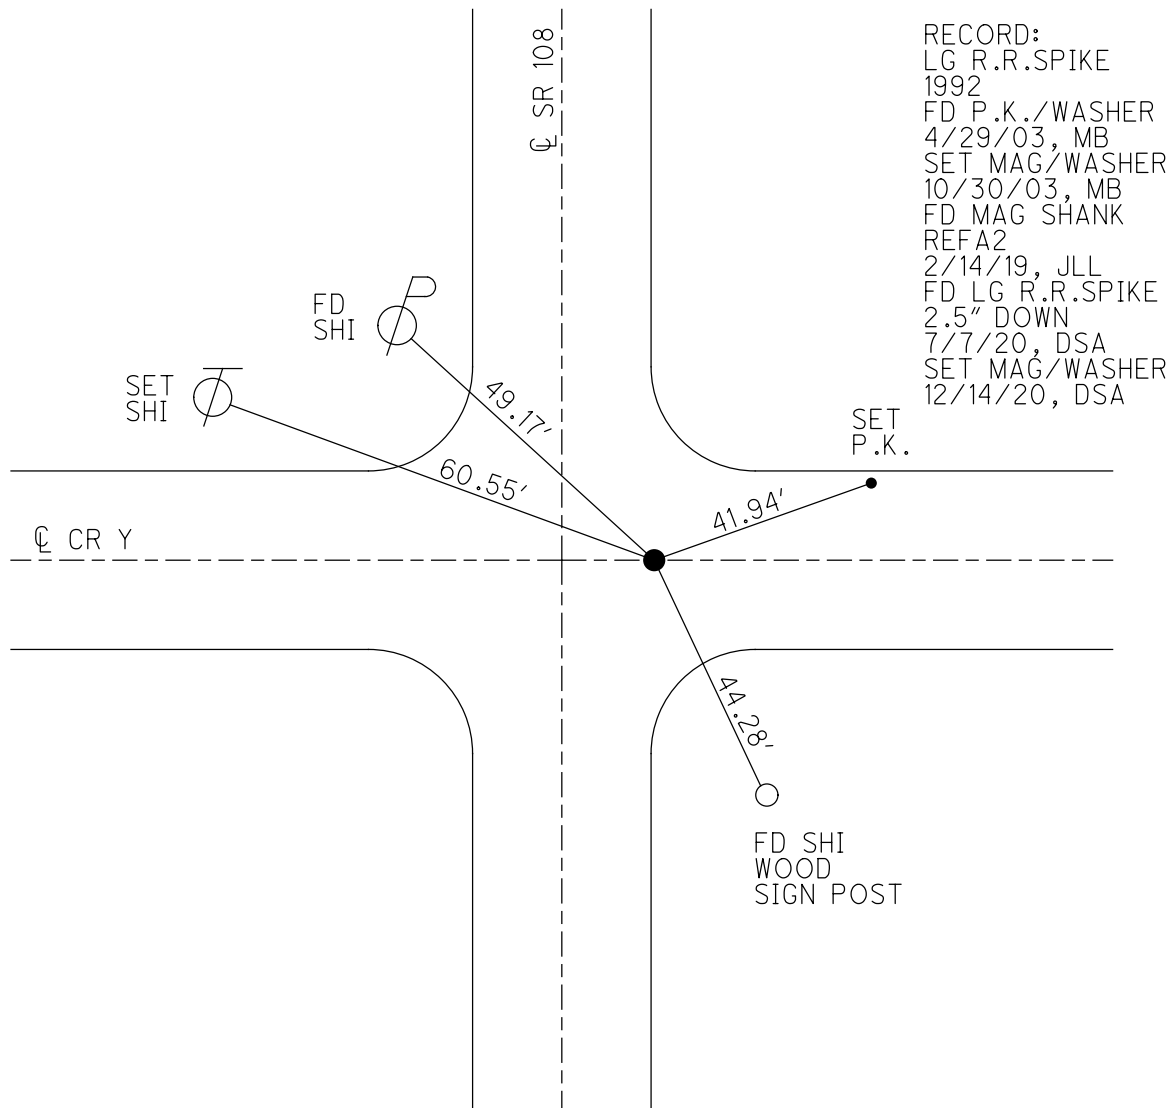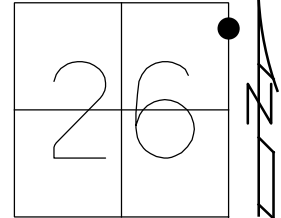

O.D.O.T. DISTRICT 2 SURVEY OFFICE (USE ONLY)

PERSONNEL

REFERENCE NO. 3

SHEET 6 OF 21

NOTES GARRETT

DATE 7/7/20

ROUTE SR 108

H.C. AUBLE

WEATHER SUNNY

COUNTY HENRY

R.C. MAHLER

TEMP. 79°

TOWNSHIP PLEASANT

SECTION 26

DWG BY NIESE

PID 95739

T 3 N R 6 E

TYPE MONUMENT MAG/WASHER

ON SURFACE - ~~BELOW~~ ON

OFFSET CL PAVEMENT 0.8' LT : RT

10.8' TO LT EDGE PAVEMENT


STATION: 105+96.53

HORZ.DATUM: NAD83 (2011)


GEOID: NAVD88 2012A

GRID: NORTHING: 561183.421

EASTING: 1519376.840

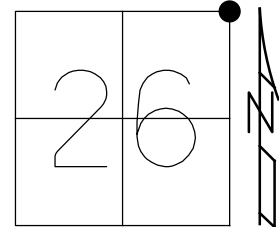

RECORD:
FD P.K./WASHER
4/29/03, MB
SET MAG/WASHER
10/30/03, MB
FD MAG/WASHER
REF3
2/14/19, JLL
10/4/19, JFO
7/7/20, DSA
SET MAG/WASHER
12/14/20, DSA

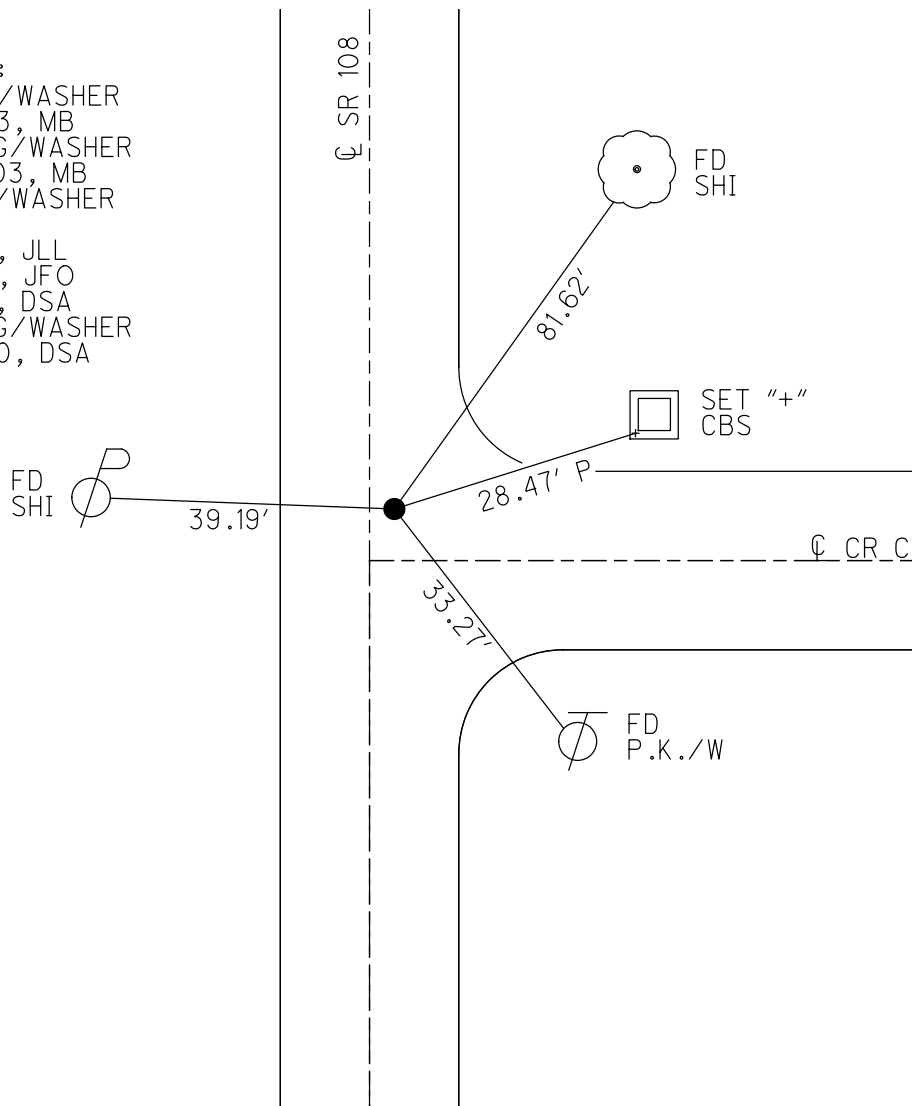

O.D.O.T. DISTRICT 2 SURVEY OFFICE (USE ONLY)

PERSONNEL

REFERENCE NO. 4

SHEET 7 OF 21

NOTES GARRETT

DATE 7/7/20

ROUTE SR 108

H.C. AUBLE

WEATHER CLEAR

COUNTY HENRY

R.C. MAHLER

TEMP. 82°

TOWNSHIP PLEASANT

SECTION 23

DWG BY NIESE

PID 95739

T 3 N R 6 E

TYPE MONUMENT MAG/WASHER

ON SURFACE - ~~BELOW~~ ON

OFFSET CL PAVEMENT 6.0' LT : ~~RT~~

- TO - EDGE PAVEMENT


STATION: 132+50.40

HORZ.DATUM: NAD83 (2011)


GEOID: NAVD88 2012A

GRID: NORTHING: 563837.068

EASTING: 1519411.947

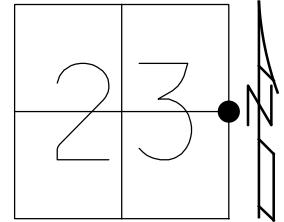

RECORD:
FD P.K.SHANK
4/29/03, MB
SET MAG/WASHER
10/30/03, MB
FD MAG/WASHER
REF4
2/14/19, JLL
10/4/19, JFO
7/7/20, DSA
SET MAG/WASHER
12/14/20, DSA

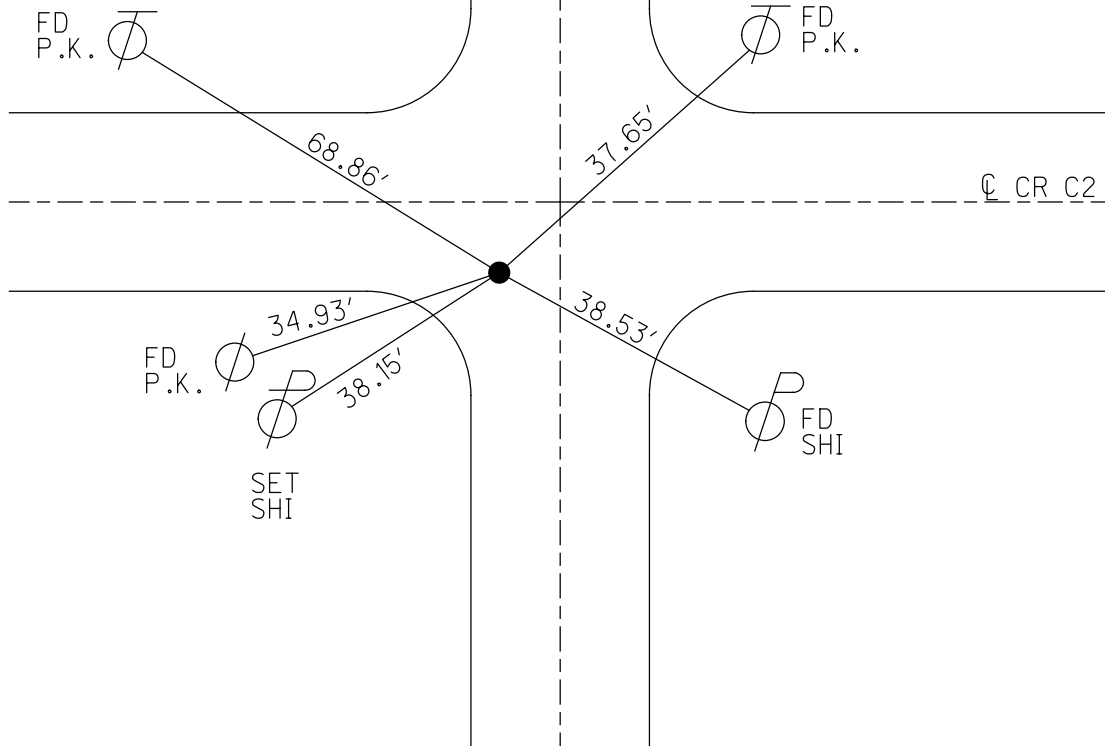

O.D.O.T. DISTRICT 2 SURVEY OFFICE (USE ONLY)

PERSONNEL

REFERENCE NO. 5

SHEET 8 OF 21

NOTES GARRETT

DATE 7/7/20

ROUTE SR 108

H.C. AUBLE

WEATHER CLEAR

COUNTY HENRY

R.C. MAHLER

TEMP. 87°

TOWNSHIP PLEASANT

SECTION 23

DWG BY NIESE

PID 95739

T 3 N R 6 E

TYPE MONUMENT MAG/WASHER

ON SURFACE - ~~BELOW~~ ON

OFFSET Q PAVEMENT 6.7' LT : RT

4.0' TO LT EDGE PAVEMENT


STATION: 158+86.49

HORZ.DATUM: NAD83 (2011)


GEOID: NAVD88 2012A

GRID: NORTHING: 566472.981

EASTING: 1519442.201

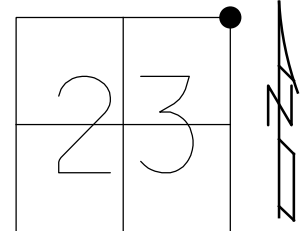

RECORD:
FD P.K./WASHER
4/30/03, MB
SET MAG/WASHER
10/30/03, MB
FD MAG/WASHER
REF5
2/10/16, JLL
FD MAG/WASHER
2/14/19, JLL
10/4/19, JFO
7/7/20, DSA
SET MAG/WASHER
12/14/20, DSA

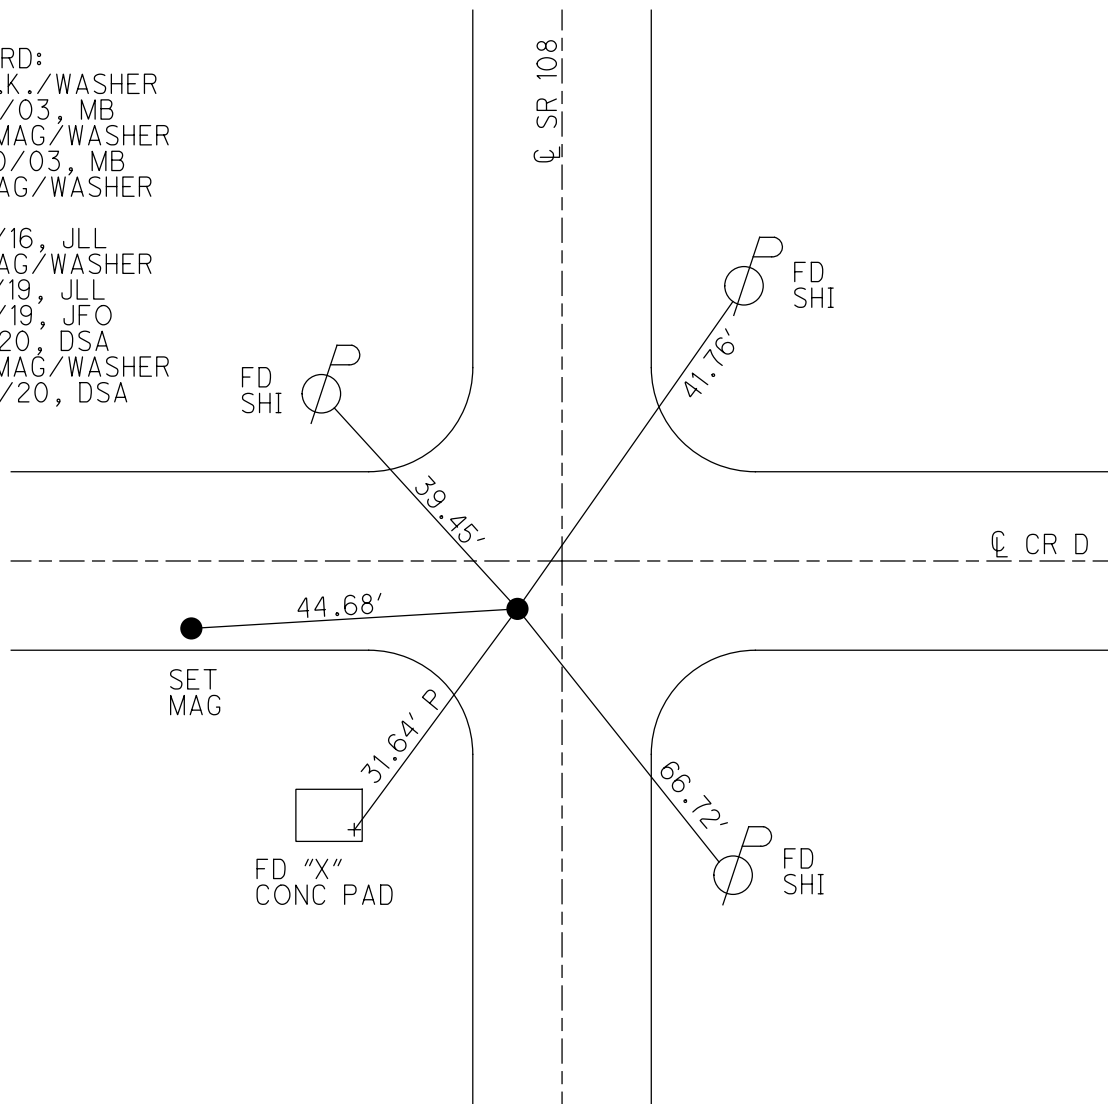

O.D.O.T. DISTRICT 2 SURVEY OFFICE (USE ONLY)

PERSONNEL

REFERENCE NO. 5 A

SHEET 9 OF 21

NOTES GARRETT

DATE 7/7/20

ROUTE SR 108

H.C. AUBLE

WEATHER SUNNY

COUNTY HENRY

R.C. MAHLER

TEMP. 88°

TOWNSHIP PLEASANT

SECTION 14

DWG BY NIESE

PID 95739

T 3 N R 6 E

TYPE MONUMENT MAG/WASHER

ON SURFACE - ~~BELOW~~ ON

OFFSET CL PAVEMENT 3' LT : ~~RT~~

7.3' TO LT EDGE PAVEMENT


STATION: 185+45.16

HORIZ.DATUM: NAD83 (2011)

GEOID: NAVD88 2012A

GRID: NORTHING: 569131.476

EASTING: 1519472.369

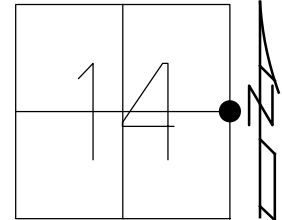

SET MAG
ASPHALT DR

SET
SHI

43.99'

48.46'

36.57'

FD
SHI

CL SR 108

RECORD:
FD P.K./WASHER
4/30/03, MB
SET MAG/WASHER
10/30/03, MB
FD MAG/WASHER
REF6
2/10/16, JLL
FD MAG/WASHER
REF6
2/14/19, JLL
10/4/19, JFO
7/7/20, DSA
SET MAG/WASHER
12/14/20, DSA

O.D.O.T. DISTRICT 2 SURVEY OFFICE (USE ONLY)

PERSONNEL

REFERENCE NO. 6

SHEET 10 OF 24

NOTES BRUMBAUGH

DATE 4/30/03

ROUTE SR 108

H.C. BARNHISEL

WEATHER PTLY.CLOUDY

COUNTY HENRY

R.C. RYALL

TEMP. 55°

TOWNSHIP PLEASANT

CANTERBURY

SECTION 14

DWG BY RHOADES

PID _____

T 3 N R 6 E

TYPE MONUMENT P.K.SHANK

ON SURFACE - ~~BELOW~~ ON _____

OFFSET Q PAVEMENT 1.3' LT : ~~RT~~

8.5' TO LT EDGE PAVEMENT


STATION: 205+46

HORZ.DATUM: _____

GEOID: _____

GRID: NORTHING: _____

EASTING: _____

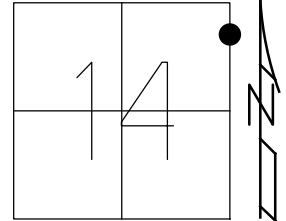

RECORD:
FD P.K.SHANK
4/30/03, MB
SET MAG/WASHER
10/30/03, MB

OCCL -----

SET 5/8"
IPIDS

STONE FIELD
DRIVE


45.21' P

41.24' P

33.90'

SHI

Q SR 108

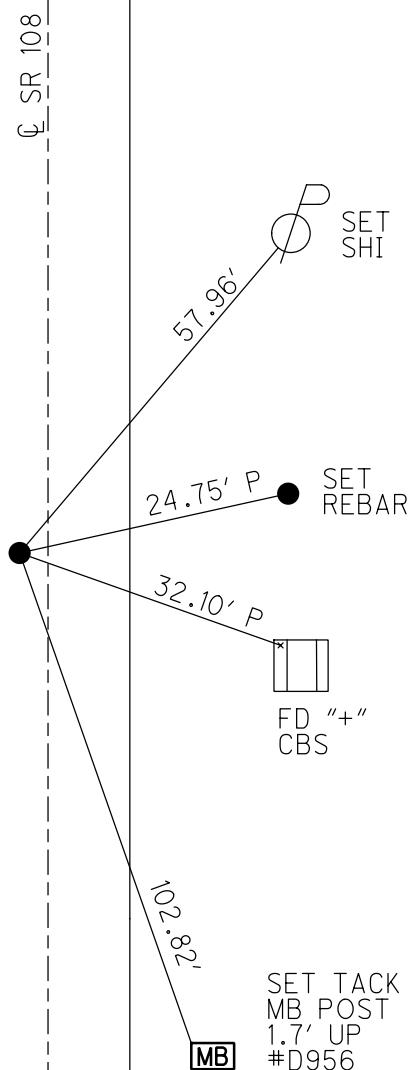

O.D.O.T. DISTRICT 2 SURVEY OFFICE (USE ONLY)

PERSONNEL

REFERENCE NO. 7 A

SHEET 12 OF 24

NOTES HOFFMAN

DATE 1/22/82

ROUTE SR 108

H.C. HOUSEHOLDER

WEATHER SNOW, WINDY

COUNTY HENRY

R.C. LOEHRKE

TEMP. 14°

TOWNSHIP PLEASANT

GRIFFITH

SECTION 11

DWG BY RHOADES

PID _____

T 3 N R 6 E

TYPE MONUMENT P.K.NAIL

ON SURFACE - ~~BELOW~~ ON

OFFSET Q PAVEMENT 4.1' LT : ~~RT~~

5.8' TO LT EDGE PAVEMENT


STATION: 214+14.20

HORIZ.DATUM: _____

GEOID: _____


GRID: NORTHING: _____

EASTING: _____

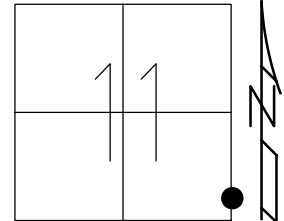

RECORD:
SET P.K.NAIL
F/C BRIDGE CONTROL
1/22/82, CL
D.N.RESET
9/92, CL

Q SR 108

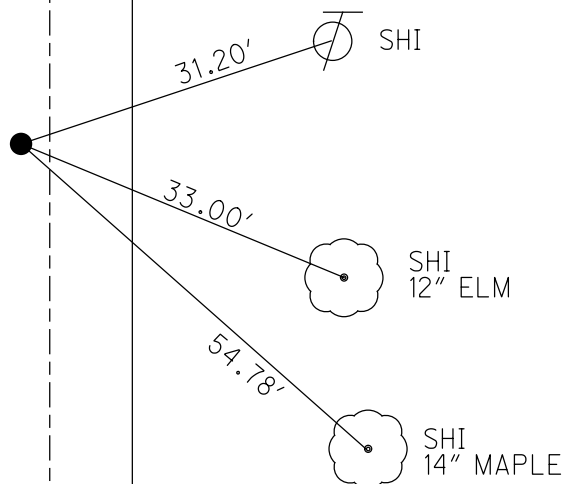

O.D.O.T. DISTRICT 2 SURVEY OFFICE (USE ONLY)

PERSONNEL

REFERENCE NO. 7 B

SHEET 13 OF 24

NOTES HOFFMAN

DATE 1/22/82

ROUTE SR 108

H.C. HOUSEHOLDER

WEATHER SNOW, WINDY

COUNTY HENRY

R.C. LOEHRKE

TEMP. 14°

TOWNSHIP PLEASANT

GRIFFITH

SECTION 11

DWG BY RHOADES

PID _____

T 3 N R 6 E

TYPE MONUMENT P.K.NAIL

ON SURFACE - ~~BELOW~~ ON

OFFSET Q PAVEMENT 4.1' LT : ~~RT~~

5.8' TO LT EDGE PAVEMENT


STATION: 221+14.20

HORZ.DATUM: _____


GEOID: _____

GRID: NORTHING: _____

EASTING: _____

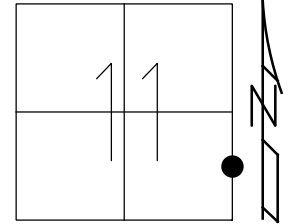

RECORD:
SET P.K.NAIL
F/Q BRIDGE CONTROL
1/22/82, CL
D.N.RESET
9/92, CL

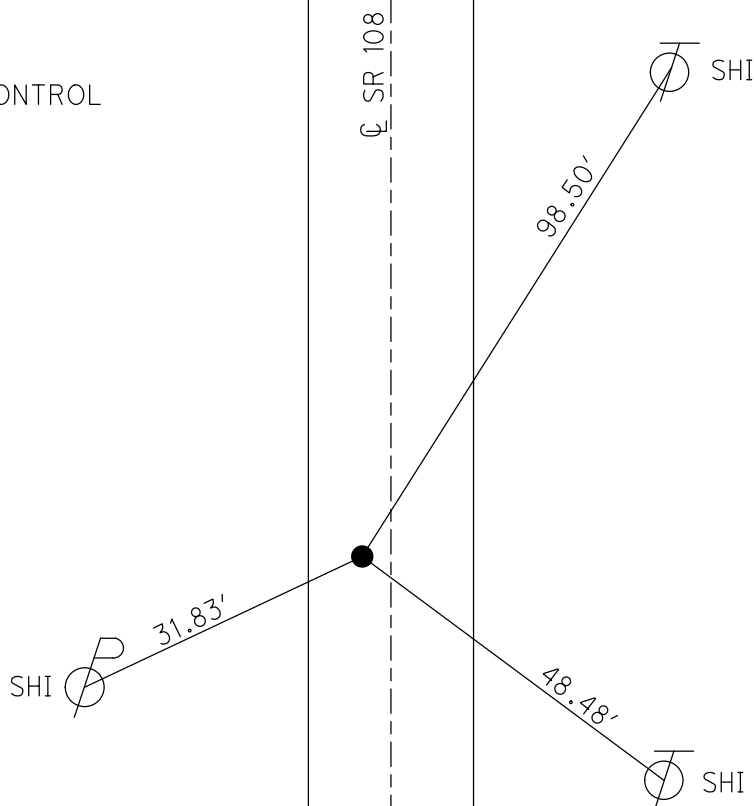

O.D.O.T. DISTRICT 2 SURVEY OFFICE (USE ONLY)

PERSONNEL

REFERENCE NO. 8

SHEET 11 OF 21

NOTES GARRETT

DATE 7/7/20

ROUTE SR 108

H.C. AUBLE

WEATHER SUNNY

COUNTY HENRY

R.C. MAHLER

TEMP. 90°

TOWNSHIP PLEASANT

DWG BY NIESE PID 95739

SECTION 11

T 3 N R 6 E

TYPE MONUMENT MAG/WASHER

ON SURFACE - ~~BELOW~~ ON

OFFSET Q PAVEMENT 2.0' LT : ~~RT~~

8.4' TO LT EDGE PAVEMENT



STATION: 238+48.31

HORZ.DATUM: NAD83 (2011)

GEOID: NAVD88 2012A

GRID: NORTHING: 574434.212

EASTING: 1519538.323

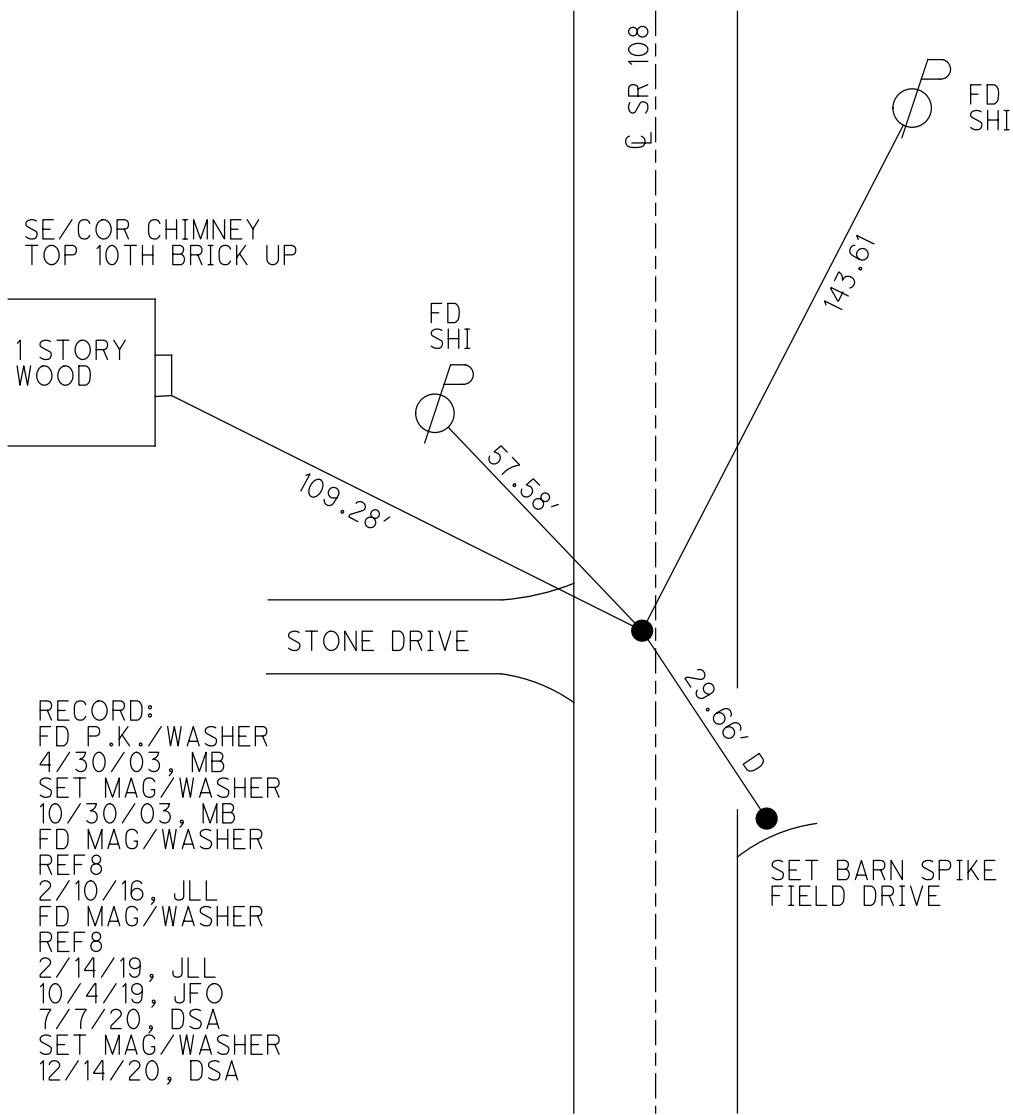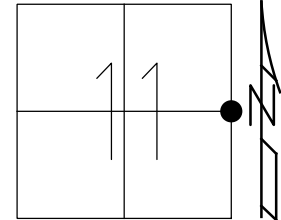

PERSONNEL

REFERENCE NO. 9

SHEET 12 OF 21

NOTES GARRETT

DATE 7/7/20

ROUTE SR 108

H.C. AUBLE

WEATHER SUNNY

COUNTY HENRY

R.C. MAHLER

TEMP. 90°

TOWNSHIP PLEASANT

SECTION 11

DWG BY NIESE

PID 95739

T₃N R₆E

TYPE MONUMENT LG R.R.SPIKE

ON SURFACE - ~~BELOW~~ ON

OFFSET @ PAVEMENT 39.05' LT : RT


3.9' TO S EDGE PAVEMENT

STATION: 264+88.26


HORZ.DATUM: NAD83 (2011)

GEOID: NAVD88 2012A

GRID: NORTHING: 577079.304

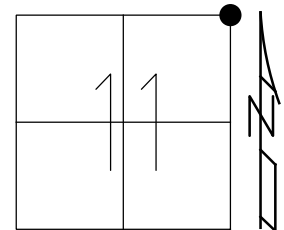EASTING: 1519550.917

RECORD:
FD R.R.SPIKE
3" DOWN
4/30/03, MB
FD R.R.SPIKE
10/30/03, MB
FD R.R.SPIKE
REF9
2/4/16, JLL
FD RR SPIKE
2/14/19, JLL
10/4/19, JFO
7/7/20, DSA
FD LG RR SPIKE
12/14/20, DSA

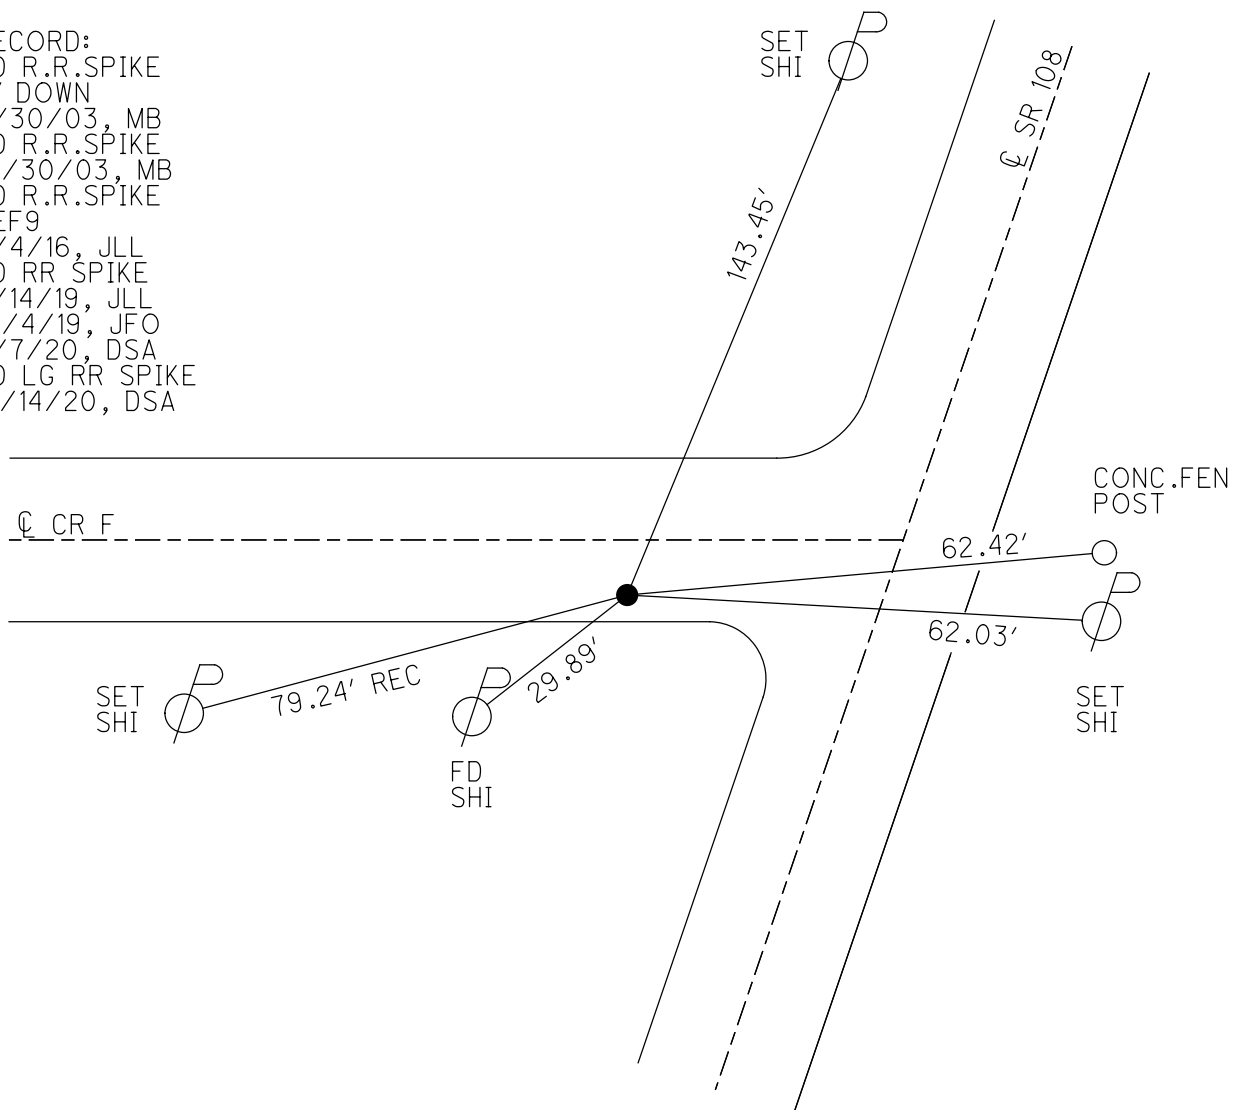

O.D.O.T. DISTRICT 2 SURVEY OFFICE (USE ONLY)

PERSONNEL

REFERENCE NO. 10

SHEET 13 OF 21

NOTES GARRETT

DATE 7/7/20

ROUTE SR 108

H.C. AUBLE

WEATHER SUNNY

COUNTY HENRY

R.C. MAHLER

TEMP. 91°

TOWNSHIP PLEASANT

SECTION 1

DWG BY NIESE

PID 95739

T 3 N R 6 E

TYPE MONUMENT MAG/WASHER

ON SURFACE - ~~BELOW~~ ON

OFFSET Q PAVEMENT ON LT : RT

- TO - EDGE PAVEMENT


STATION: 303+03.05

HORZ.DATUM: NAD83 (2011)


GEOID: NAVD88 2012A

GRID: NORTHING: 580760.405

EASTING: 1520552.513

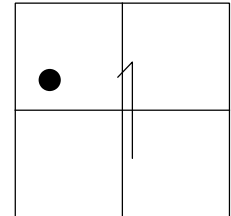

RECORD:
FD P.K./WASHER ATOP
SM.R.R.SPIKE
5/1/03, MB
SET MAG/WASHER
10/31/03, MB
FD MAG/WASHER
REF10
2/4/16, JLL
SET MAG/WASHER
8/4/17, JLL
FD MAG/WASHER
REF10
2/14/19, JLL

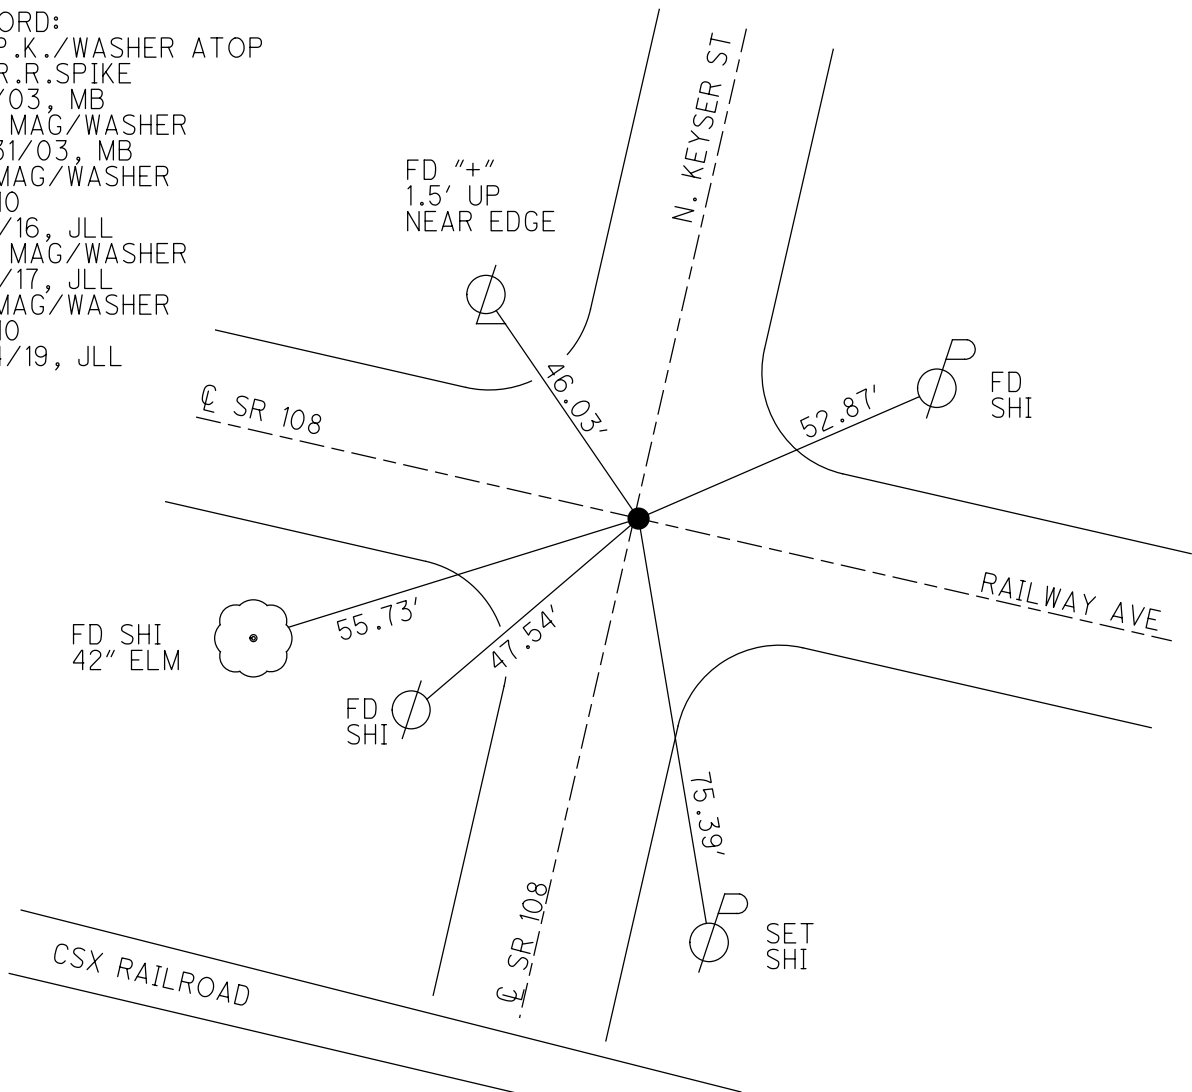

O.D.O.T. DISTRICT 2 SURVEY OFFICE (USE ONLY)

PERSONNEL

REFERENCE NO.

10 A

SHEET

7

OF 16

NOTES RHOADES

DATE

8/4/17

ROUTE SR 108

H.C. LEU

WEATHER

CLOUDY

COUNTY HENRY

R.C. CARSON

TEMP.

70°

TOWNSHIP PLEASANT

SECTION 1

T 3 N R 6 E

TYPE MONUMENT MAG/WASHER


ON SURFACE - ~~BELOW~~ ON

~~LEFT~~ - CL PAV'T - RIGHT 0.5'


- TO - EDGE PAVEMENT

S.L.M. 307+59.3

Grid: Northing: 580854.254 Easting: 1520206.320

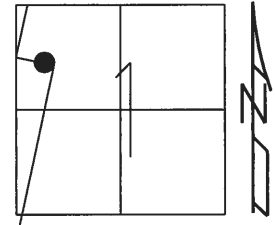

RECORD:
SET MAG/WASHER
10/31/03, MB
DNF MAG/WASHER
2/4/16, JLL
SET MAG/WASHER
W/TIES
8/4/17, JLL

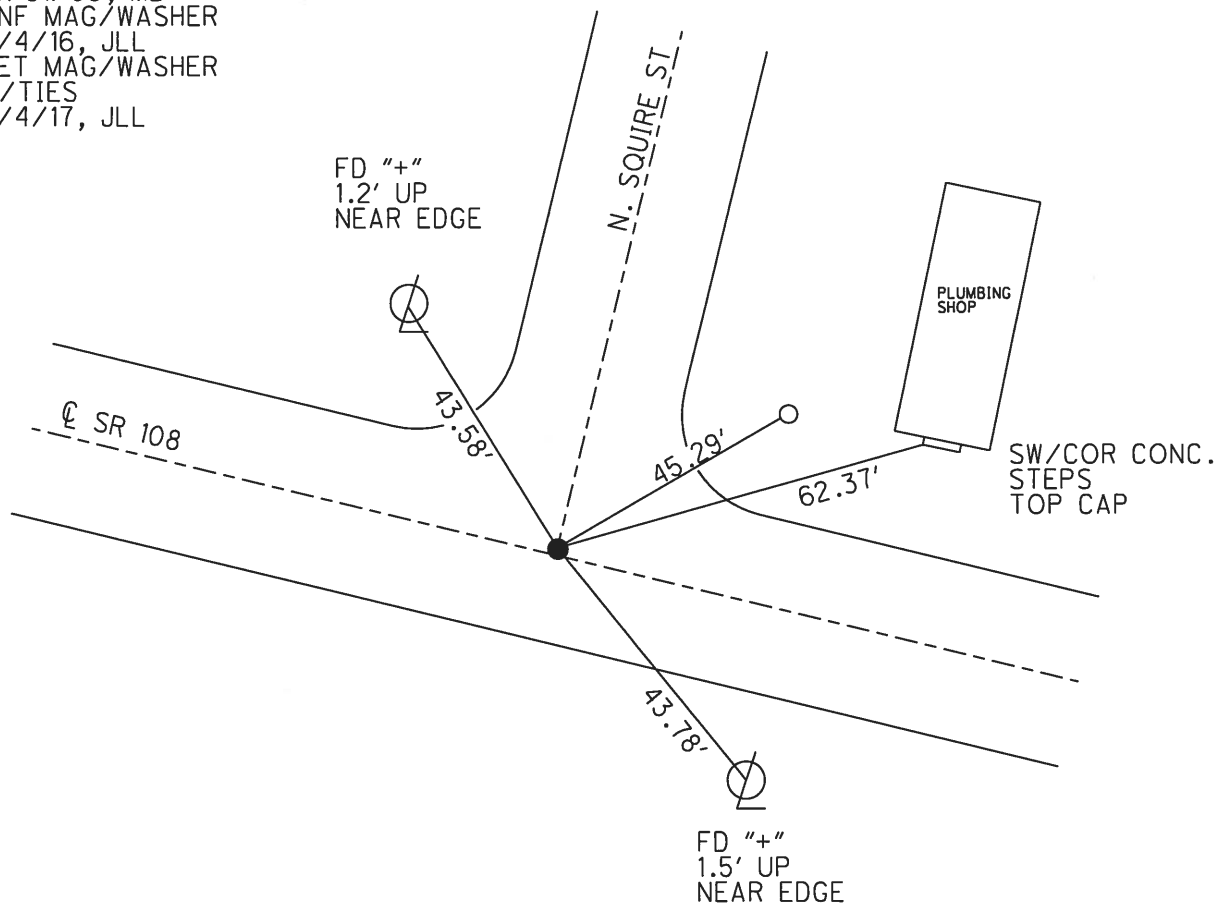

O.D.O.T. DISTRICT 2 SURVEY OFFICE (USE ONLY)

PERSONNEL

REFERENCE NO. 10 B

SHEET 8 OF 16

NOTES HELDMAN
H.C. LEU
R.C. HELDMAN

DATE 4/26/17
WEATHER PTLY CLOUDY
TEMP. 64°

ROUTE SR 108
COUNTY HENRY
TOWNSHIP PLEASANT
SECTION 1
T 3 N R 6 E

TYPE MONUMENT MAG/WASHER



ON SURFACE - ~~BELOW~~ ON

~~LEFT~~ - ℄ PAV'T - RIGHT 0.5', 0.5' W OF ℄ N

- TO - EDGE PAVEMENT

S.L.M. 311+02.6

Grid: Northing: 580943.787 Easting: 1519875.862

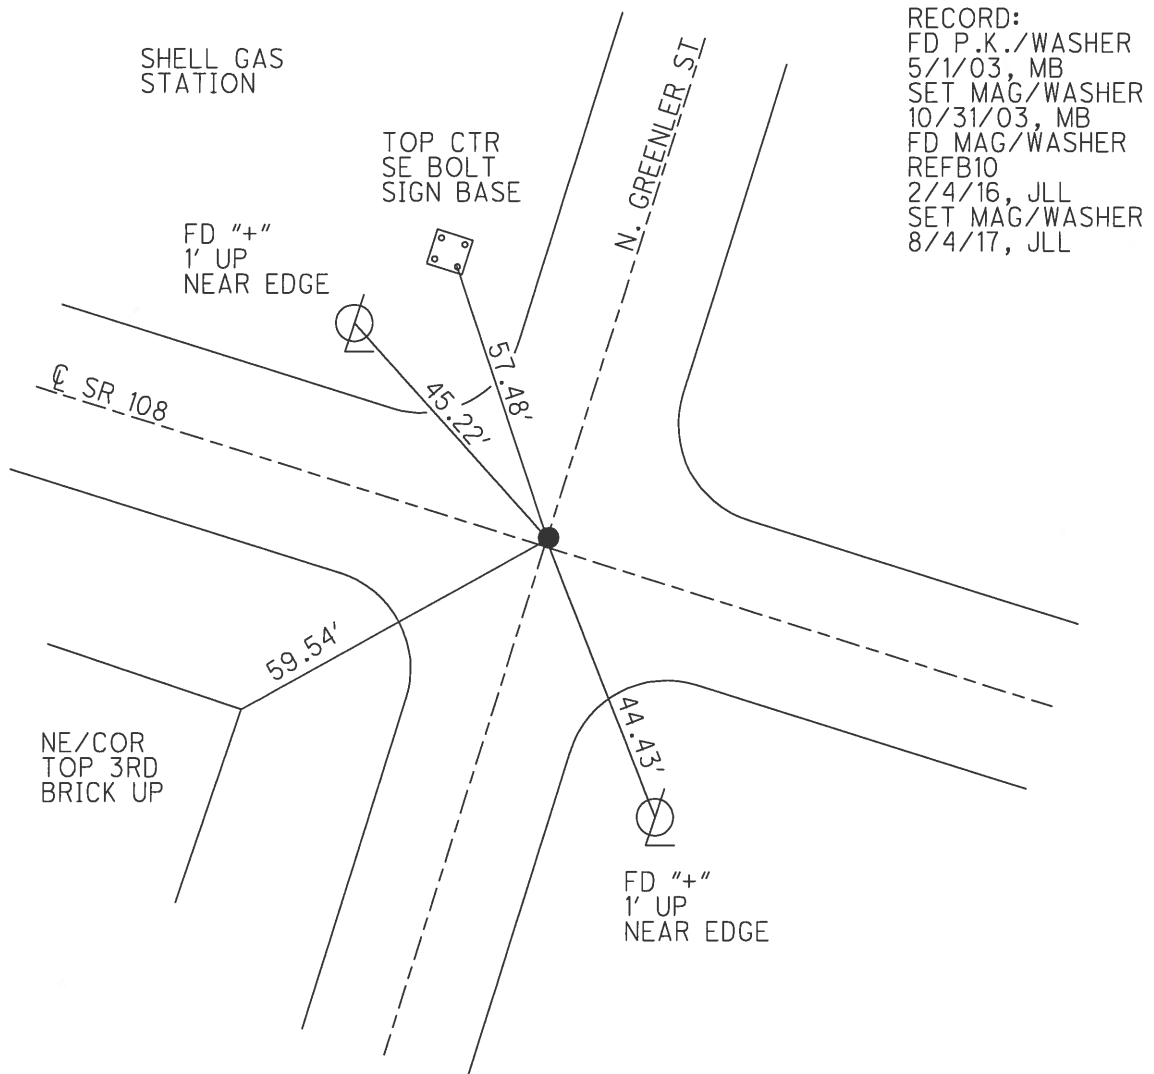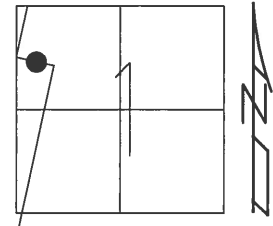


RECORD:
FD P.K./WASHER
5/1/03, MB
SET MAG/WASHER
10/31/03, MB
FD MAG/WASHER
REFB10
2/4/16, JLL
SET MAG/WASHER
8/4/17, JLL

O.D.O.T. DISTRICT 2 SURVEY OFFICE (USE ONLY)


PERSONNEL _____ REFERENCE NO. 11 SHEET 9 OF 16
 NOTES HELDMAN DATE 4/16/17 ROUTE SR 108
 H.C. LEU WEATHER PTLY CLOUDY COUNTY HENRY
 R.C. HELDMAN TEMP. 64° TOWNSHIP PLEASANT
 SECTION 1
 T 3 N R 6 E

TYPE MONUMENT MAG/WASHER
 ON SURFACE - ~~BELOW~~ ON
~~LEFT~~ - CL PAV'T - RIGHT 0.5' OF CL N
22.8' TO LT EDGE PAVEMENT
 S.L.M. 314+45.02

Grid: Northing: 581033.287 Easting: 1519545.354

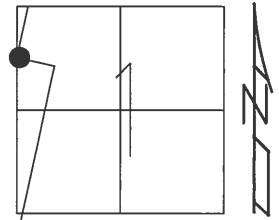

RECORD:
 FD 3/4" IRON BOLT
 4" DOWN
 6/27/84
 FD P.K./WASHER ATOP
 SM.R.R.SPIKE
 5/1/03, MB
 SET MAG/WASHER
 10/31/03, MB
 FD MAG/WASHER
 REF11
 2/4/16, JLL
 SET MAG/WASHER
 8/4/17, JLL

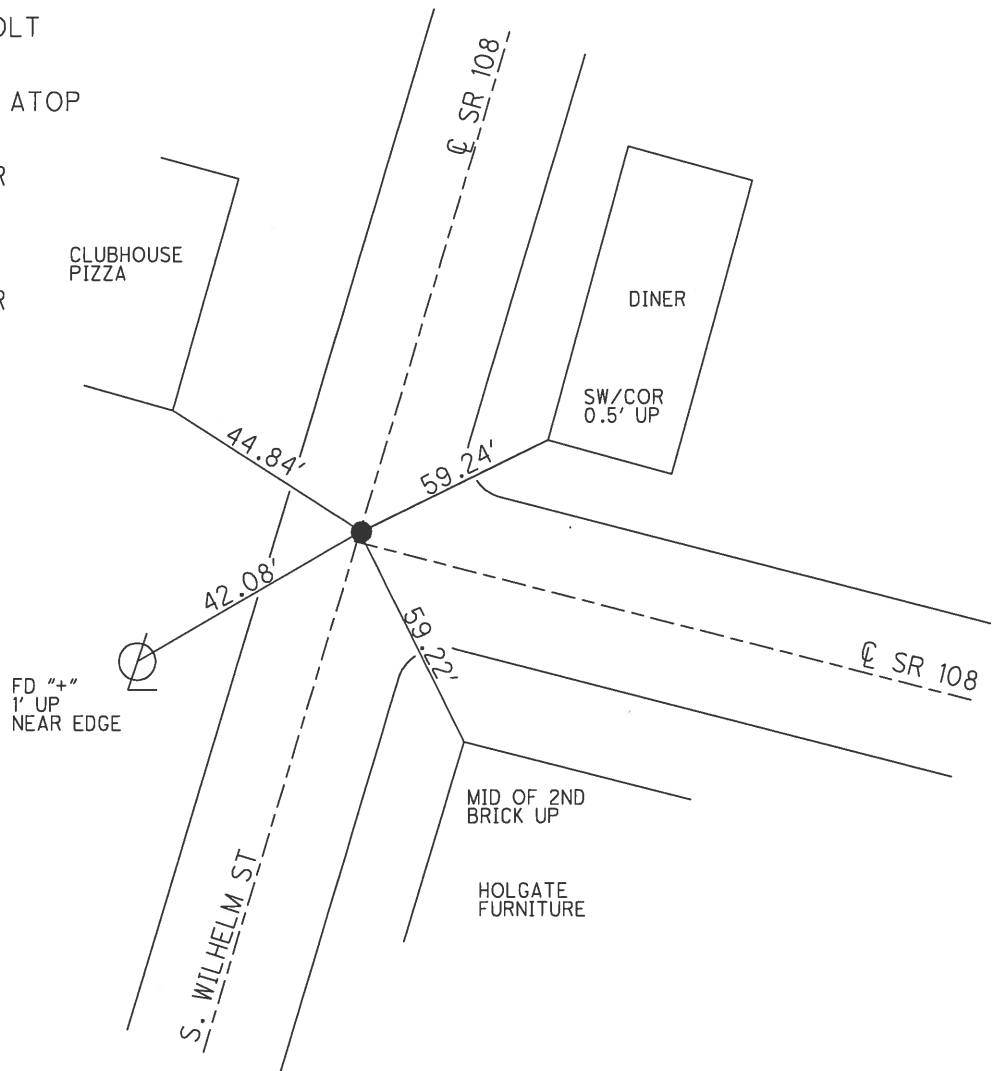

O.D.O.T. DISTRICT 2 SURVEY OFFICE (USE ONLY)

PERSONNEL

REFERENCE NO. 11 A

SHEET 10 OF 16

NOTES HELDMAN

DATE 4/26/17

ROUTE SR 108

H.C. LEU

WEATHER PTLY CLOUDY

COUNTY HENRY

R.C. HELDMAN

TEMP. 65°

TOWNSHIP PLEASANT

SECTION 1

T 3 N R 6 E

TYPE MONUMENT MAG/WASHER


ON SURFACE - ~~BELOW~~ ON

~~LEFT~~ - CL PAV'T - RIGHT 0.5', 1" N OF CL W


22.7' TO RT EDGE PAVEMENT

S.L.M. 317+03.4

Grid: Northing: 581282.836 Easting: 1519612.424

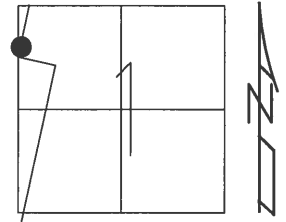

RECORD:
DNF P.K./WASHER
5/1/03, MB
SET MAG/WASHER
W/TIES
10/31/03, MB
FD MAG/WASHER
REF A11
2/4/16, JLL
SET MAG/WASHER
8/4/17, JLL

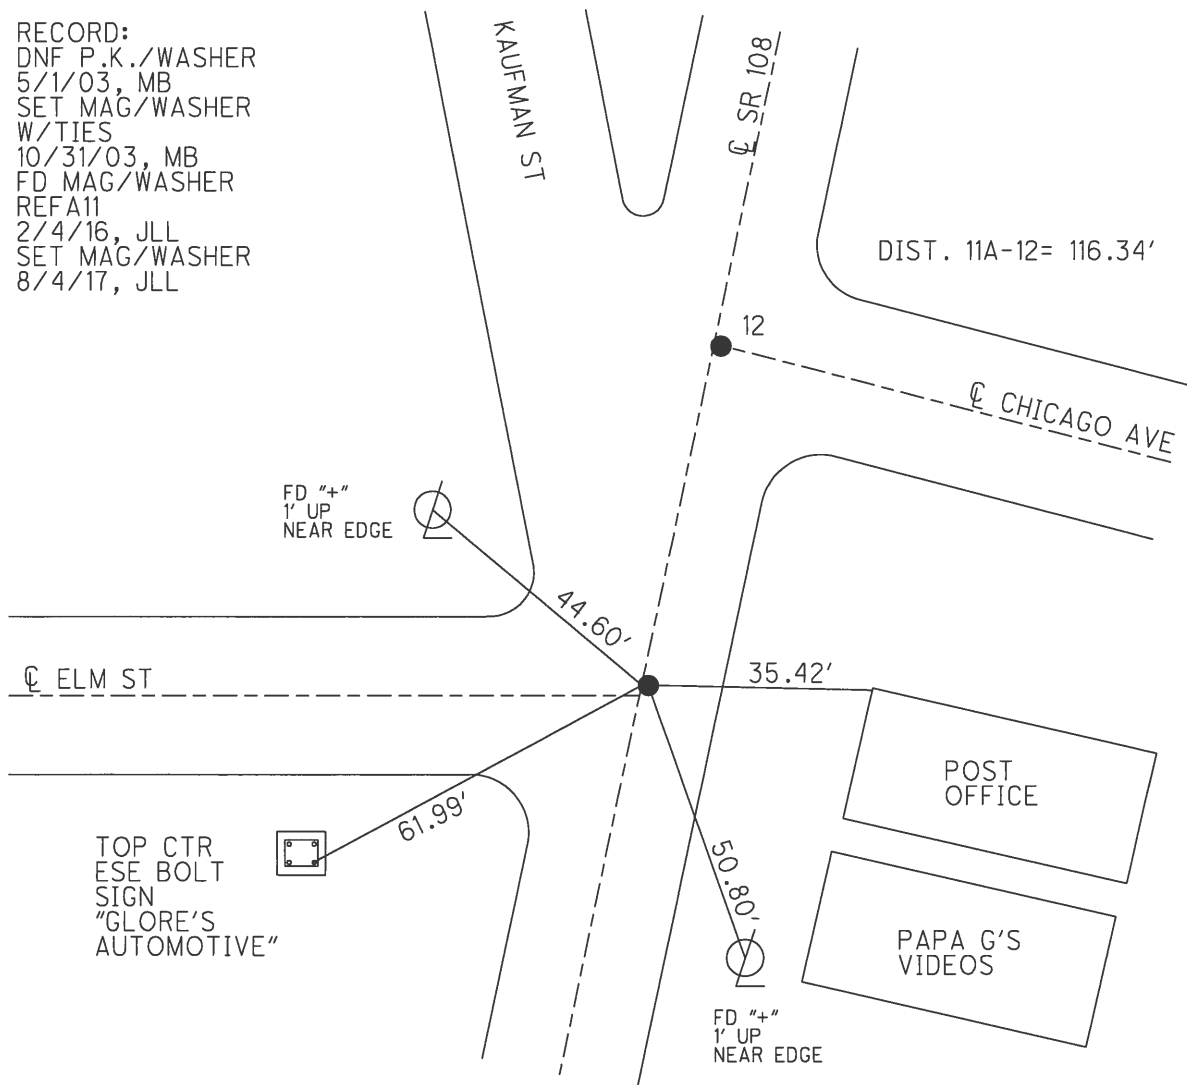


O.D.O.T. DISTRICT 2 SURVEY OFFICE (USE ONLY)


PERSONNEL	REFERENCE NO. <u>12</u>	SHEET <u>11</u> OF <u>16</u>
NOTES <u>HELDMAN</u>	DATE <u>4/26/17</u>	ROUTE <u>SR 108</u>
H.C. <u>LEU</u>	WEATHER <u>PTLY CLOUDY</u>	COUNTY <u>HENRY</u>
R.C. <u>HELDMAN</u>	TEMP. <u>65°</u>	TOWNSHIP <u>PLEASANT</u>
		SECTION <u>1</u>
		T <u>3</u> N R <u>6</u> E

TYPE MONUMENT MAG/WASHER
 ON SURFACE - BELOW ON
 LEFT - Q PAV'T - RIGHT 0.5'
 - TO - EDGE PAVEMENT
 S.L.M. 318+19.8

Grid: Northing: 581395.223 Easting: 1519642.498

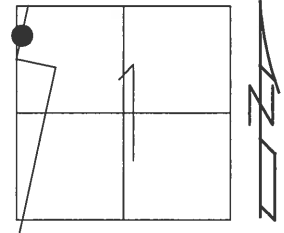

RECORD:
 FD P.K./WASHER
 5/1/03, MB
 SET MAG/WASHER
 10/31/03, MB
 FD MAG/WASHER
 REF12
 2/4/16, JLL
 SET MAG/WASHER
 8/4/17, JLL

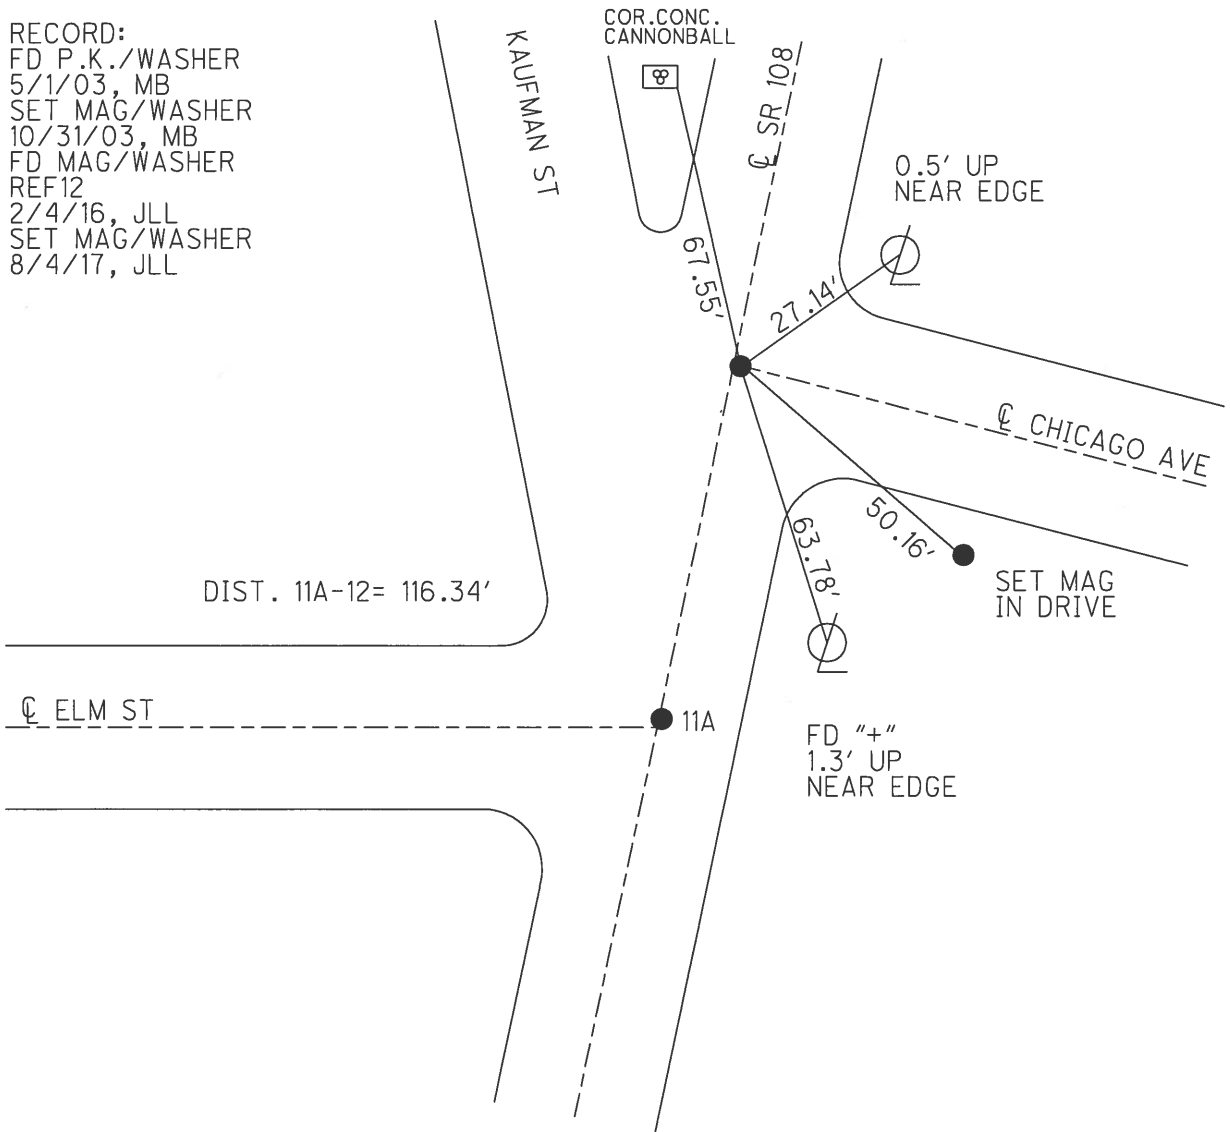

O.D.O.T. DISTRICT 2 SURVEY OFFICE (USE ONLY)

PERSONNEL _____ REFERENCE NO. 13 SHEET 12 OF 16

NOTES LEU DATE 2/4/16 ROUTE SR 108
H.C. LEU WEATHER CLOUDY COUNTY HENRY
R.C. FARKAS TEMP. 30° TOWNSHIP PLEASANT
SECTION 1
T 3 N R 6 E

TYPE MONUMENT MAG/WASHER



ON SURFACE - ~~BELOW~~ ON

LEFT - Q PAV'T - RIGHT ON

10.5' TO RT EDGE PAVEMENT

S.L.M. 326+54.23

Grid: Northing: 582201.228 Easting: 1519859.982

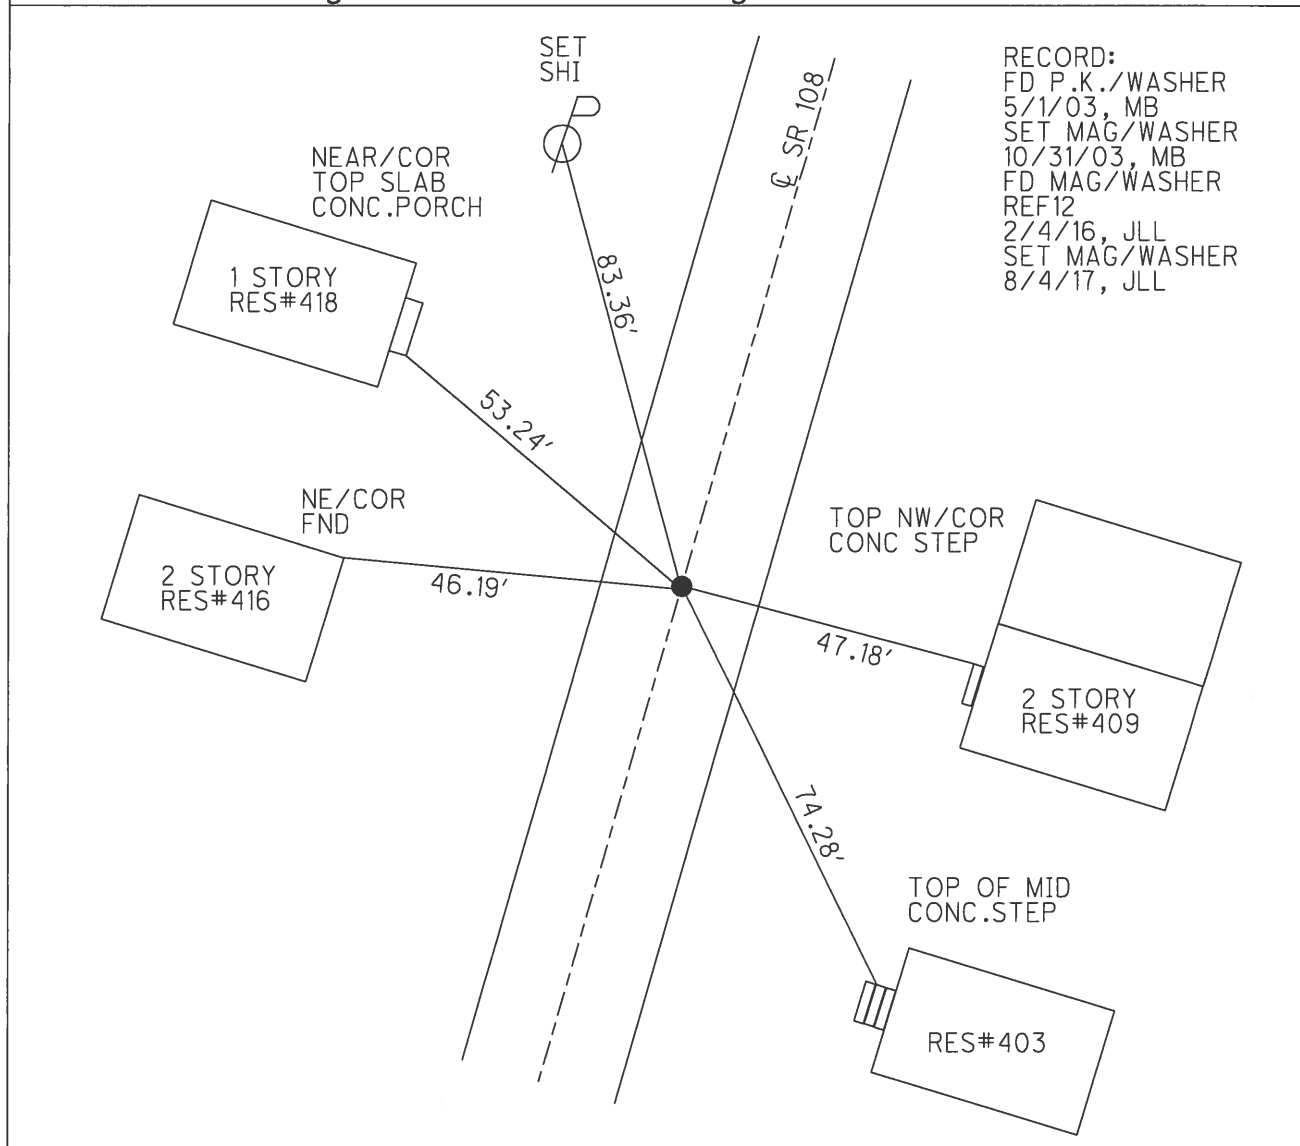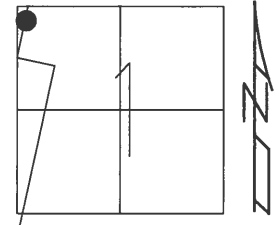


O.D.O.T. DISTRICT 2 SURVEY OFFICE (USE ONLY)

PERSONNEL _____ REFERENCE NO. 14 SHEET 13 OF 16
NOTES HELDMAN DATE 4/26/17 ROUTE SR 108
H.C. LEU WEATHER PTLY CLOUDY COUNTY HENRY
R.C. HELDMAN TEMP. 65° TOWNSHIP FLATROCK
SECTION 1
T 3 N R 6 E


TYPE MONUMENT MAG NAIL
ON SURFACE - ~~BELOW~~ ON
LEFT - ℄ PAV'T - ~~RIGHT~~ 4.4', 2.2' S OF ℄ W
TO EDGE PAVEMENT
S.L.M. 328+30.89

Grid: Northing: 582369.208 Easting: 1519904.016

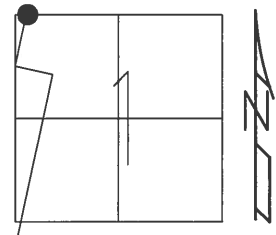

RECORD:
FD P.K./WASHER
5/1/03, MB
SET MAG/WASHER
10/31/03, MB
FD MAG/WASHER
REF12
2/4/16, JLL
SET MAG/WASHER
8/4/17, JLL

NOTE: REF 11B ON SR 18

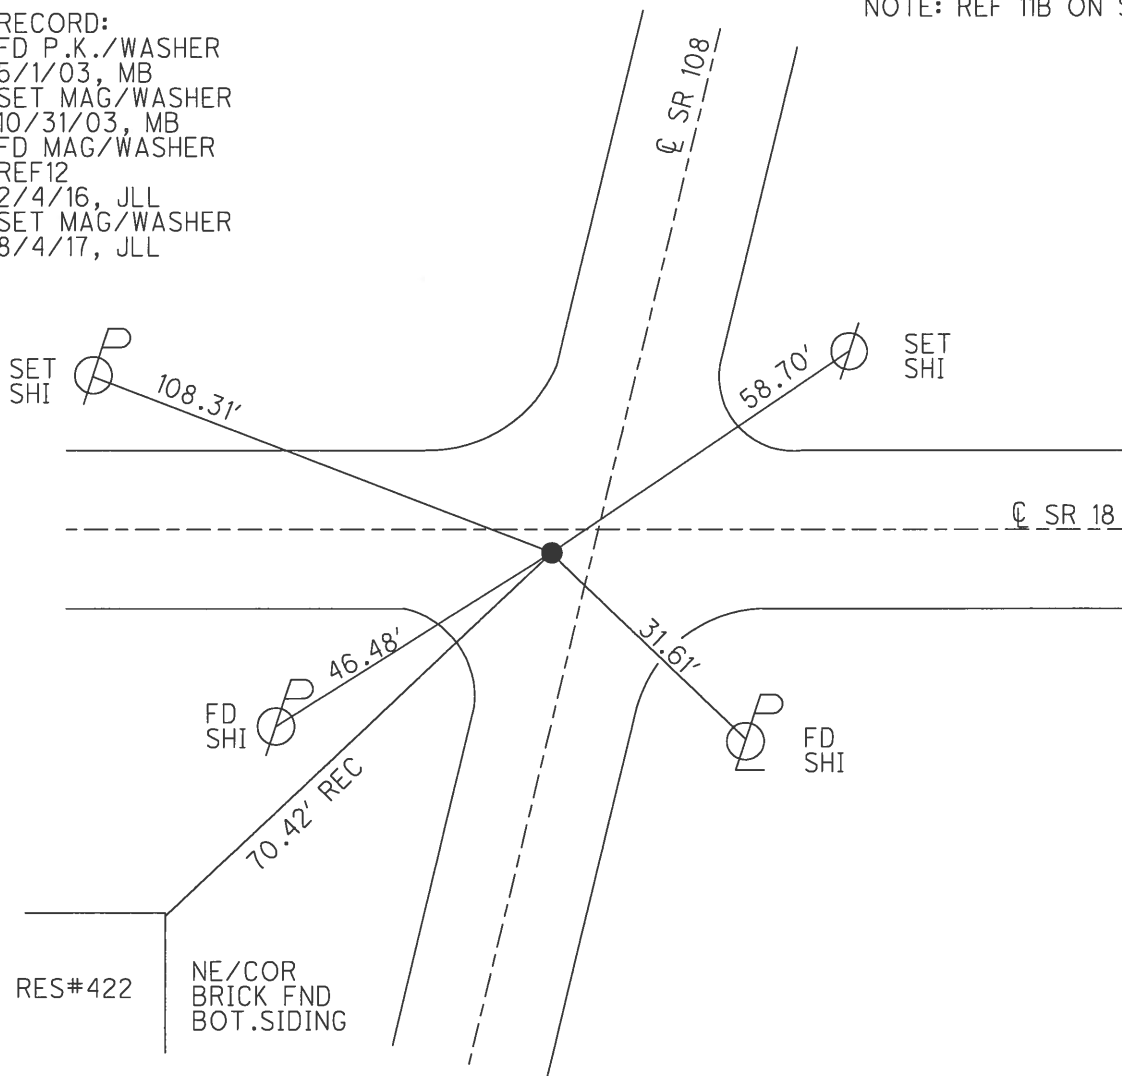

O.D.O.T. DISTRICT 2 SURVEY OFFICE (USE ONLY)

PERSONNEL	REFERENCE NO.	15	SHEET	14	OF	16
NOTES	LOEHRKE	DATE	8/18/92	ROUTE	SR 108	
H.C.	CURTIS	WEATHER	CLEAR	COUNTY	HENRY	
R.C.	ROMETO	TEMP.	75°	TOWNSHIP	FLATROCK	
	FALKOWSKI			SECTION	36	
				T	4	N
				R	6	E

TYPE MONUMENT 1" IPIPE


~~ON SURFACE~~ - BELOW 1.5'

LEFT - ℄ PAV'T - ~~RIGHT~~ 61.5'


49' LT TO LT EDGE PAVEMENT

S.L.M. 331+71.22

Grid: Northing: 582700.186 Easting: 1519993.939

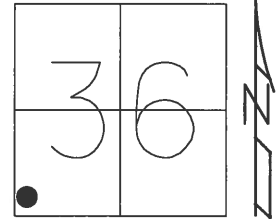

RECORD: P.I.
 $\Delta = 32^\circ 26' 19''$
 FD 1" IPIPE
 1 1/2' DOWN
 6/27/84, CL
 D.N.F. IPIPE
 2/17/16, JLL
 CALC3
 2/26/16, DCH

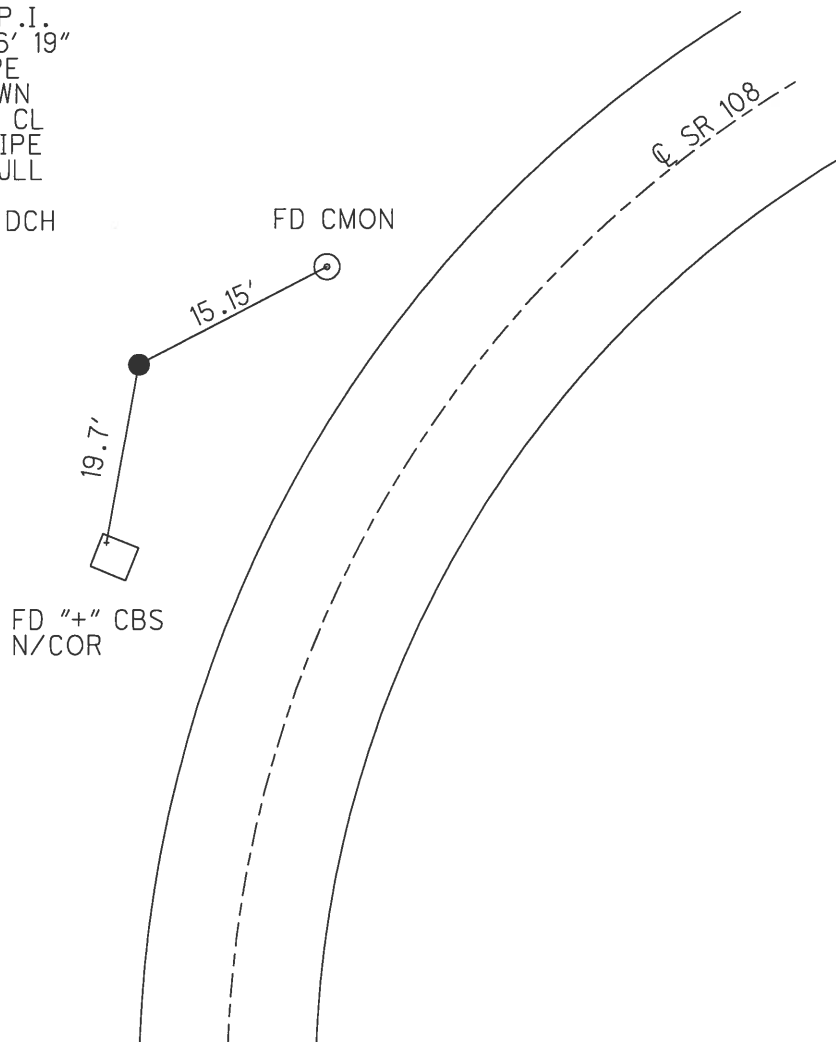

O.D.O.T. DISTRICT 2 SURVEY OFFICE (USE ONLY)

PERSONNEL

REFERENCE NO. 16

SHEET 1 OF 48

NOTES ELKHECHEN

DATE 10/25/18

ROUTE SR 108

H.C. LEU

WEATHER CLEAR

COUNTY HENRY

R.C. MILLER

TEMP. 35°

TOWNSHIP FLATROCK

RHOADES

SECTION 36

DWG BY MILLER PID 94319

T 4 N R 6 E

TYPE MONUMENT P.K.SHANK

~~ON SURFACE~~ - BELOW 3"

OFFSET CL PAVEMENT 0.3' ~~LT~~ : RT

12.2' TO RT EDGE PAVEMENT


STATION: 337+92.85

HORZ.DATUM: NAD83 (2011)


GEOID: 2012A

GRID: NORTHING: 583136.067

EASTING: 1520469.571

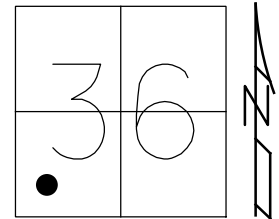

RECORD:
FD P.K./WASHER
8/18/92, CL
SET P.K./WASHER
9-29-92, CL
FD P.K.SHANK
3" DOWN
REF16
10-25-18, JLL
SET MAG/WASHER
10-20-20, DSA

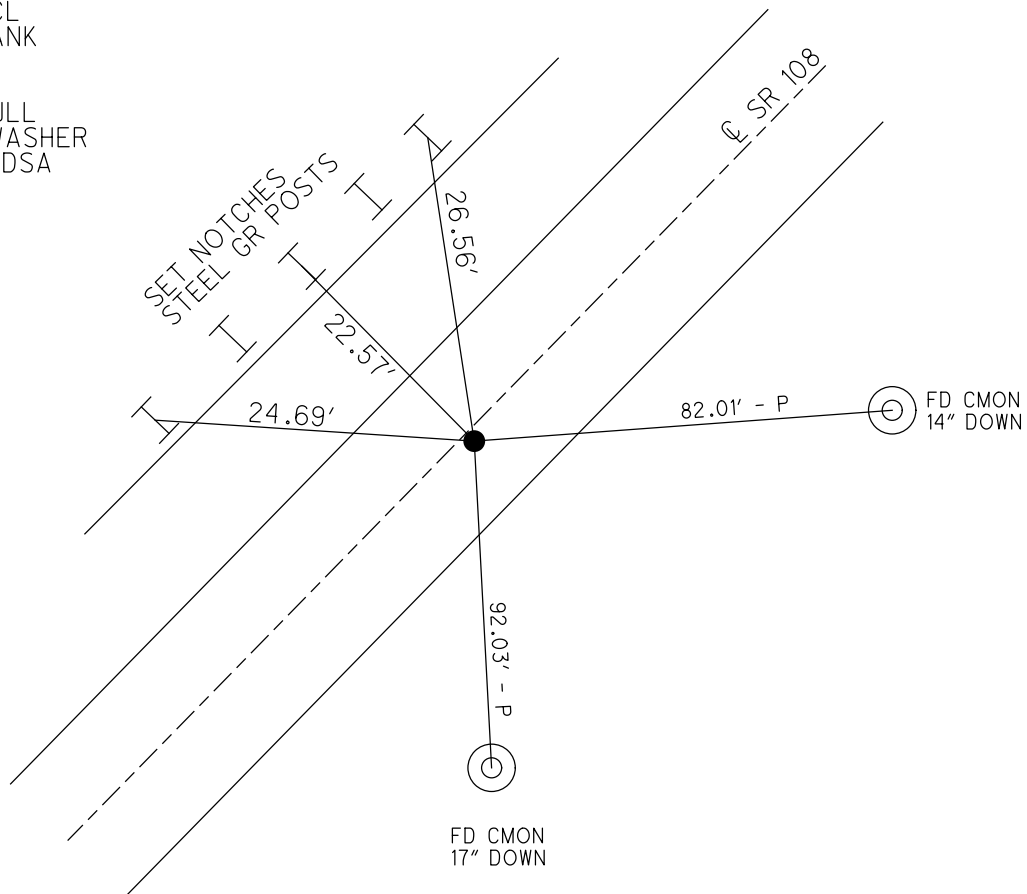

O.D.O.T. DISTRICT 2 SURVEY OFFICE (USE ONLY)

PERSONNEL

REFERENCE NO. 17

SHEET 2 OF 48

NOTES LOEHRKE

DATE 8/18/92

ROUTE SR 108

H.C. CURTIS

WEATHER PTLY CLOUDY

COUNTY HENRY

R.C. ROMETO

TEMP. 76°

TOWNSHIP FLATROCK

FALKOWSKI

SECTION 36

DWG BY MILLER PID 94319

T 4 N R 6 E

TYPE MONUMENT 3/4" IPIN

~~ON SURFACE~~ - BELOW 1.5'

OFFSET CL PAVEMENT 68' ~~LT~~ : RT

- TO - EDGE PAVEMENT


STATION: 344+07.06

HORZ.DATUM: NAD83 (2011)


GEOID: 2012A

GRID: NORTHING: 583558.478

EASTING: 1520930.630

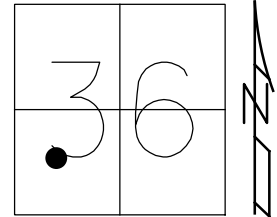

RECORD: P.I.
STA. 344+18.91
 $\Delta = 33^\circ 00' 00''$
FD 3/4" IPIN
1' DOWN
8/18/92, CL
FD 3/4" IPIN
1.5' DOWN
REF17
2-17-16
10-25-18, JLL

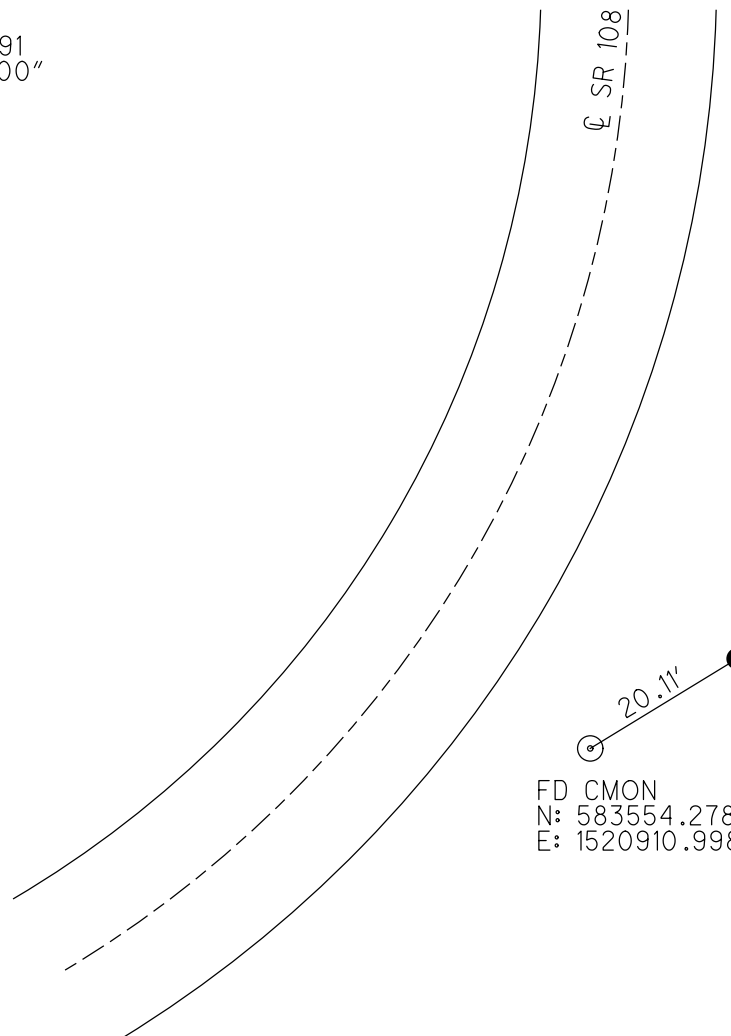

O.D.O.T. DISTRICT 2 SURVEY OFFICE (USE ONLY)

PERSONNEL

REFERENCE NO. 18

SHEET 3 OF 48

NOTES LEU

DATE 3/09/20

ROUTE SR 108

H.C. LEU

WEATHER CLOUDY/WINDY

COUNTY HENRY

R.C. BALBAUGH

TEMP. 60°

TOWNSHIP FLATROCK

SECTION 36

DWG BY BALBAUGH

PID 94319

T 4 N R 6 E

TYPE MONUMENT P.K. NAIL

~~ON SURFACE~~ - BELOW 3"

OFFSET Q PAVEMENT 0.9' LT : ~~RT~~

11.9' TO LT EDGE PAVEMENT


STATION: 350+18.32

HORIZ.DATUM: NAD83 (2011)

GEOID: 2012A


GRID: NORTHING: 584163.878

EASTING: 1521087.060

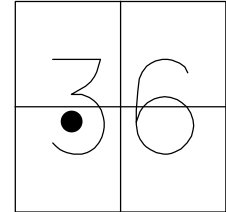

RECORD: S.T.
STA 350+18.37
FD P.K./WASHER
8/18/92, CL
SET P.K./WASHER
9-29-92
FD P.K.NAIL
3" DOWN
REF18
10-25-18, JLL
SET MAG/WASHER
10-20-20, DSA

SET 5/8" IPINS
W/CAP
"ODOT D2 REF TIE"

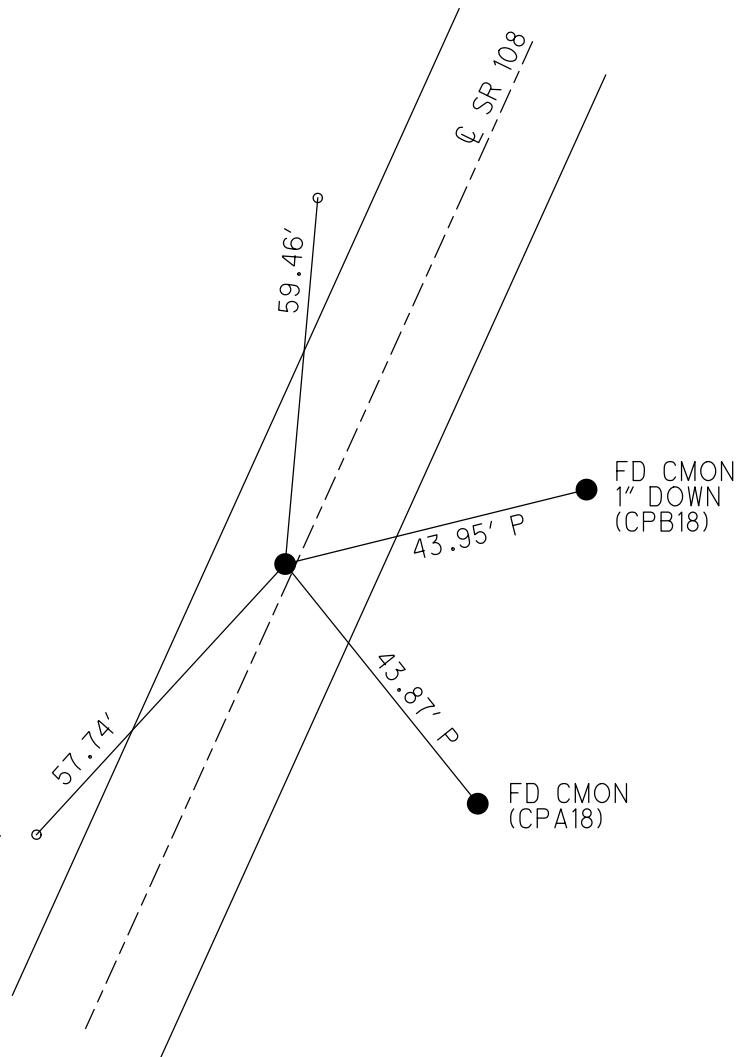

O.D.O.T. DISTRICT 2 SURVEY OFFICE (USE ONLY)

PERSONNEL

REFERENCE NO. 19

SHEET 4 OF 48

NOTES ELKHECHEN

DATE 10/25/18

ROUTE SR 108

H.C. LEU

WEATHER CLOUDY

COUNTY HENRY

R.C. MILLER
RHOADES

TEMP. 40°

TOWNSHIP FLATROCK

DWG BY MILLER

PID 94319

SECTION 36

T 4 N R 6 E

TYPE MONUMENT P.K.SHANK

~~ON SURFACE~~ - BELOW 3"

OFFSET Q PAVEMENT 0.4' ~~LT~~ : RT

12.3' TO LT EDGE PAVEMENT


STATION: 354+04.63

HORIZ.DATUM: NAD83 (2011)


GEOID: 2012A

GRID: NORTHING: 584538.619

EASTING: 1521183.835

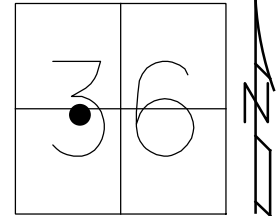

RECORD: T.S.
STA 353+92.64
FD P.K./WASHER
8/18/92, CL
SET P.K./WASHER
9-29-92, CL
FD P.K.SHANK
3" DOWN
REF19
10/25/18, JLL
SET MAG/WASHER
10-20-20, DSA

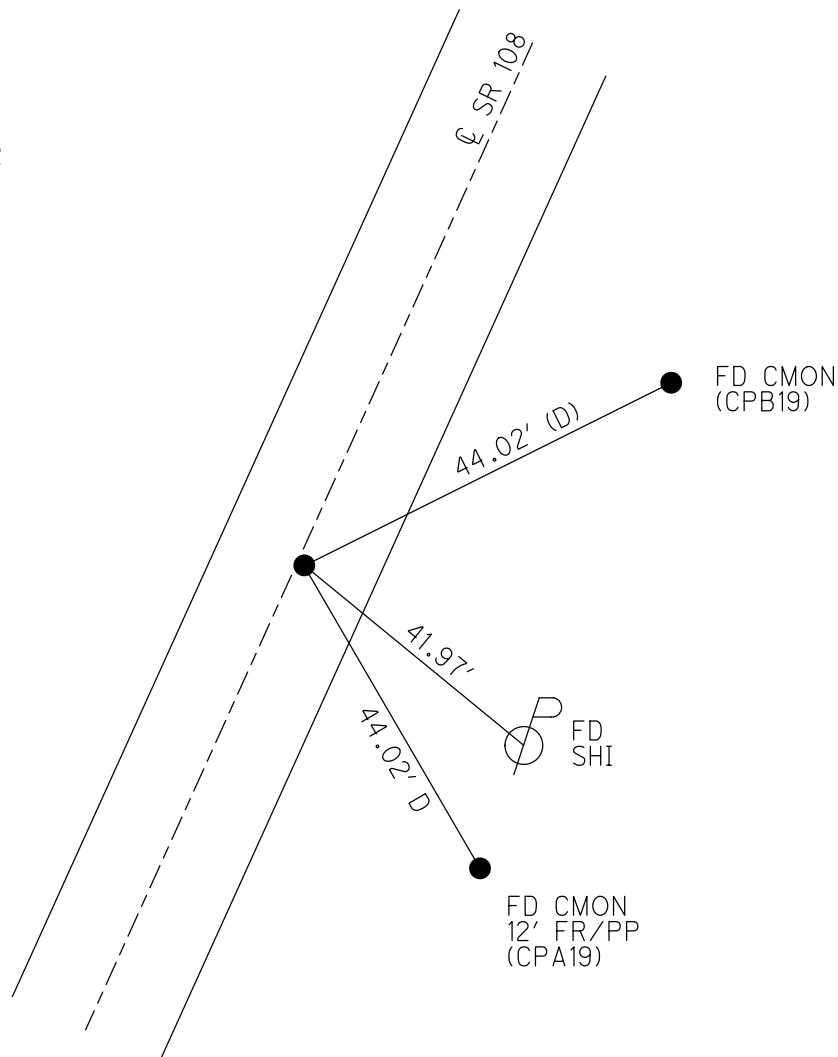

O.D.O.T. DISTRICT 2 SURVEY OFFICE (USE ONLY)

PERSONNEL

REFERENCE NO. 20

SHEET 5 OF 48

NOTES BALBAUGH

DATE 3/16/20

ROUTE SR 108

H.C. LEU

WEATHER PT CLOUDY

COUNTY HENRY

R.C. BALBAUGH

TEMP. 36°

TOWNSHIP FLATROCK

SECTION 36

DWG BY MILLER

PID 94319

T 4 N R 6 E

TYPE MONUMENT MONBOX W/1" IPIN

ON SURFACE - ~~BELOW~~ ON

OFFSET Q PAVEMENT 33' LT : ~~RT~~

- TO - EDGE PAVEMENT


STATION: 358+83.69

HORIZ.DATUM: NAD83 (2011)


GEOID: 2012A

GRID: NORTHING: 585006.416

EASTING: 1521304.617

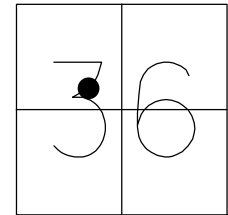

RECORD: P.I.
STA 358+75.97
 $\Delta=22^{\circ}19'00''$
FD MONBOX
8/18/92, CL
FD MONBOX
W/ 3/4" IPIN
REF20
10-25-18, JLL

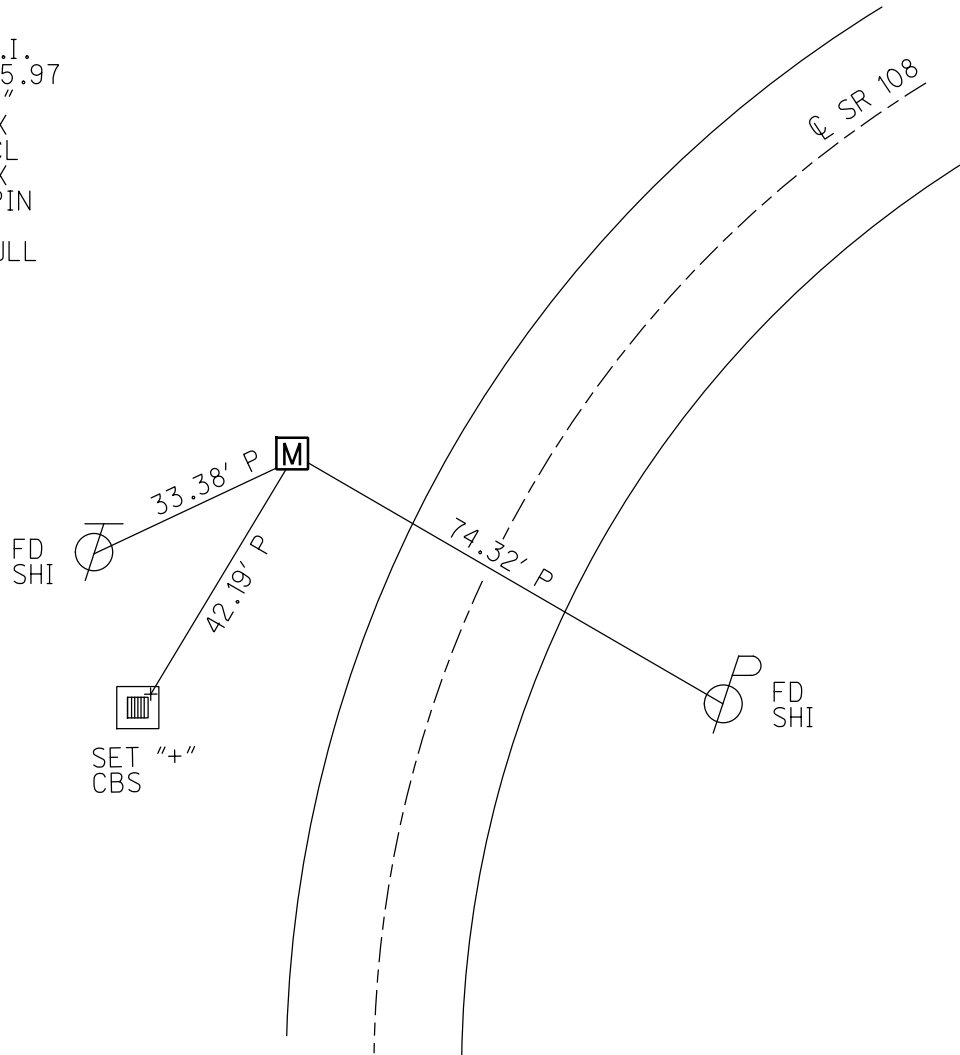

O.D.O.T. DISTRICT 2 SURVEY OFFICE (USE ONLY)

PERSONNEL

REFERENCE NO. 21

SHEET 6 OF 48

NOTES LEU

DATE 3/09/20

ROUTE SR 108

H.C. LEU

WEATHER CLOUDY/WINDY

COUNTY HENRY

R.C. BALBAUGH

TEMP. 60°

TOWNSHIP FLATROCK

DWG BY BALBAUGH

PID 94319

SECTION 36

T 4 N R 6 E

TYPE MONUMENT P.K. NAIL

~~ON SURFACE~~ - BELOW 3"

OFFSET Q PAVEMENT 0.5' LT : ~~RT~~

12.1' TO LT EDGE PAVEMENT


STATION: 363+62.59

HORZ.DATUM: NAD83 (2011)


GEOID: 2012A

GRID: NORTHING: 585393.316

EASTING: 1521594.269

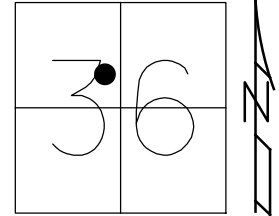

RECORD: S.T.
STA 363+50.56 BACK
STA 363+56.43 AHEAD
FD P.K./WASHER
8/18/92, CL
SET P.K./WASHER
9-29-92, CL
FD P.K.NAIL
3" DOWN
REF21
10-25-18, JLL
SET MAG/WASHER
10-20-20, DSA

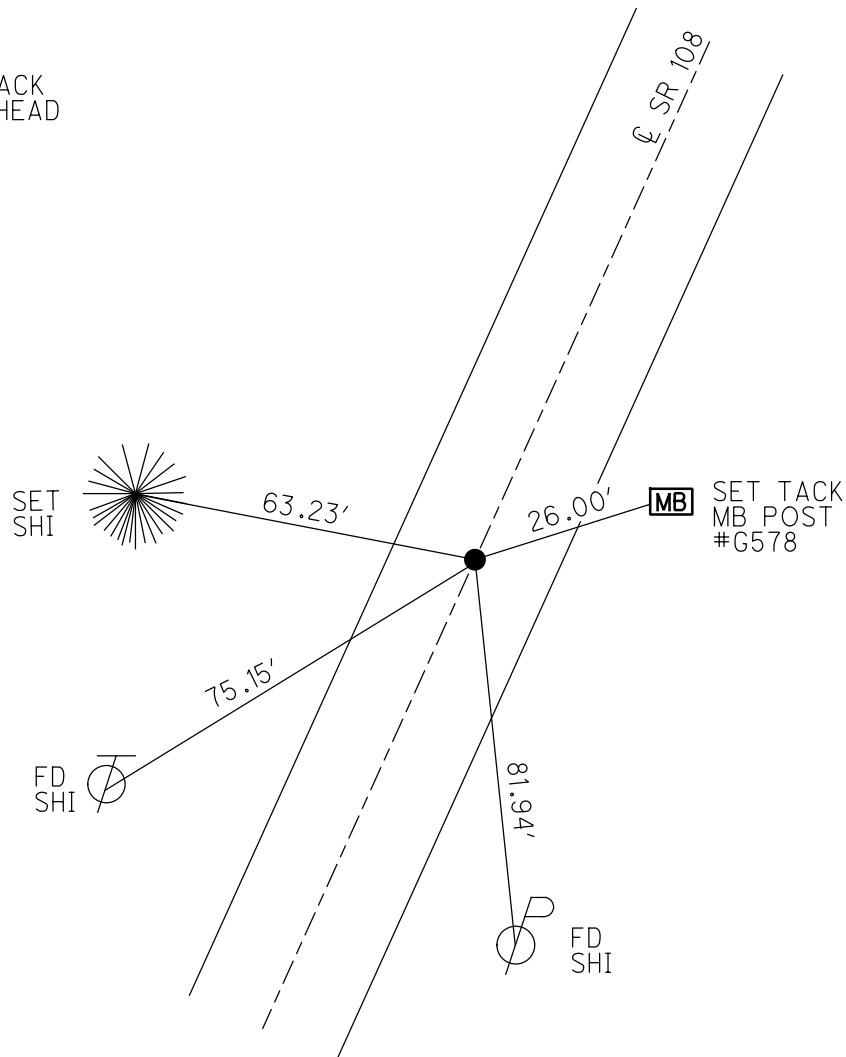

O.D.O.T. DISTRICT 2 SURVEY OFFICE (USE ONLY)

PERSONNEL

REFERENCE NO. 22

SHEET 7 OF 48

NOTES RHOADES

DATE 10-20-2020

ROUTE SR 108

H.C. AUBLE

WEATHER CLOUDY

COUNTY HENRY

R.C. O'DONNELL

TEMP. 45°

TOWNSHIP FLATROCK

SECTION 36

DWG BY MILLER PID 94319

T 4 N R 6 E

TYPE MONUMENT MAG/WASHER

ON SURFACE - ~~BELOW~~ ON

OFFSET Q PAVEMENT ON LT : RT

13.2 TO RT EDGE PAVEMENT


STATION: 369+05.74

HORZ.DATUM: NAD83 (2011)


GEOID: 2012A

GRID: NORTHING: 585828.315

EASTING: 1521919.546

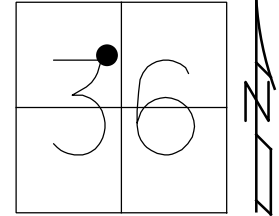

RECORD: P.O.T.
STA 369+00
FD P.K./WASHER
8/18/92, MB
SET P.K./WASHER
9-17-92, MB
DNF
11-5-18, JLL
SET MAG/WASHER
NEWREF22
10-20-20, DSA

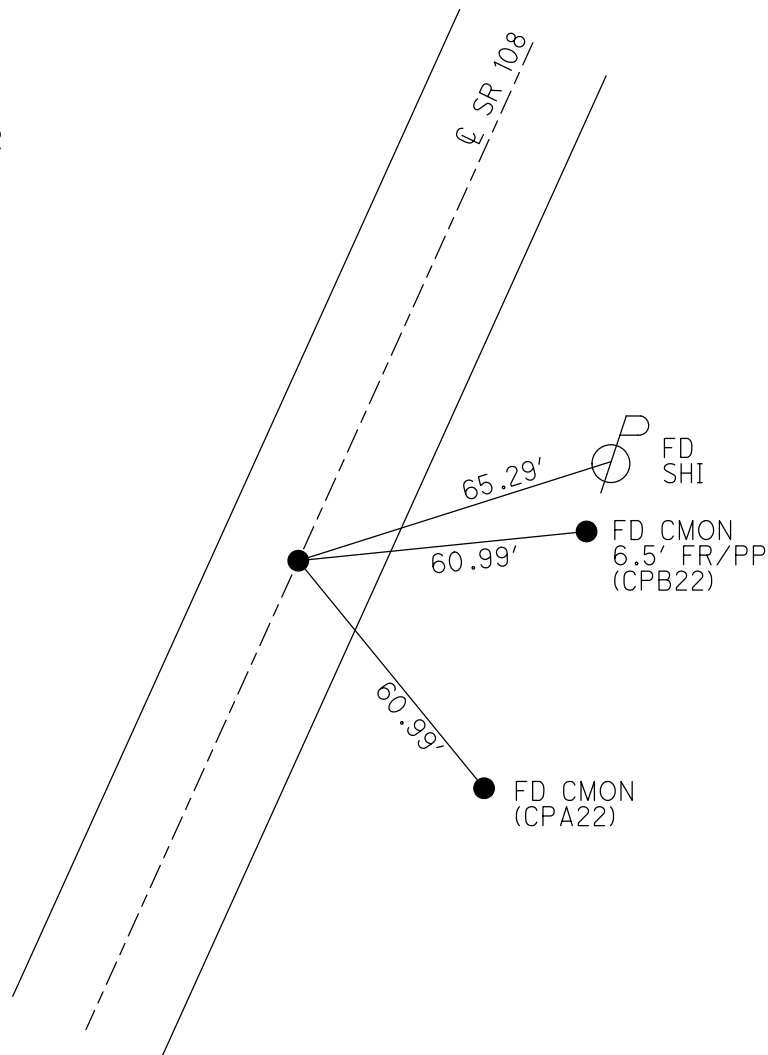

O.D.O.T. DISTRICT 2 SURVEY OFFICE (USE ONLY)

PERSONNEL

REFERENCE NO. 23

SHEET 8 OF 48

NOTES ELKHECHEN

DATE 11/5/18

ROUTE SR 108

H.C. LEU

WEATHER SUNNY

COUNTY HENRY

R.C. MILLER

TEMP. 51°

TOWNSHIP FLATROCK

SECTION 36

DWG BY MILLER

PID 94319

T 4 N R 6 E

TYPE MONUMENT P.K.SHANK

~~ON SURFACE~~ - BELOW 3"

OFFSET Q PAVEMENT ON LT : RT

13.6' TO RT EDGE PAVEMENT


STATION: 374+85.81

HORIZ.DATUM: NAD83 (2011)


GEOID: 2012A

GRID: NORTHING: 586292.672

EASTING: 1522266.952

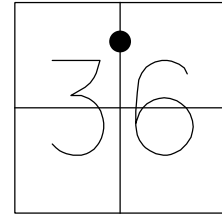

RECORD: T.S.
STA 374+79.97
FD P.K./WASHER
8/18/92, MB
SET P.K./WASHER
9-17-92, MDB
FD P.K.SHANK
3" DOWN
REF23
11-5-18, JLL
SET MAG/WASHER
10-20-20, DSA

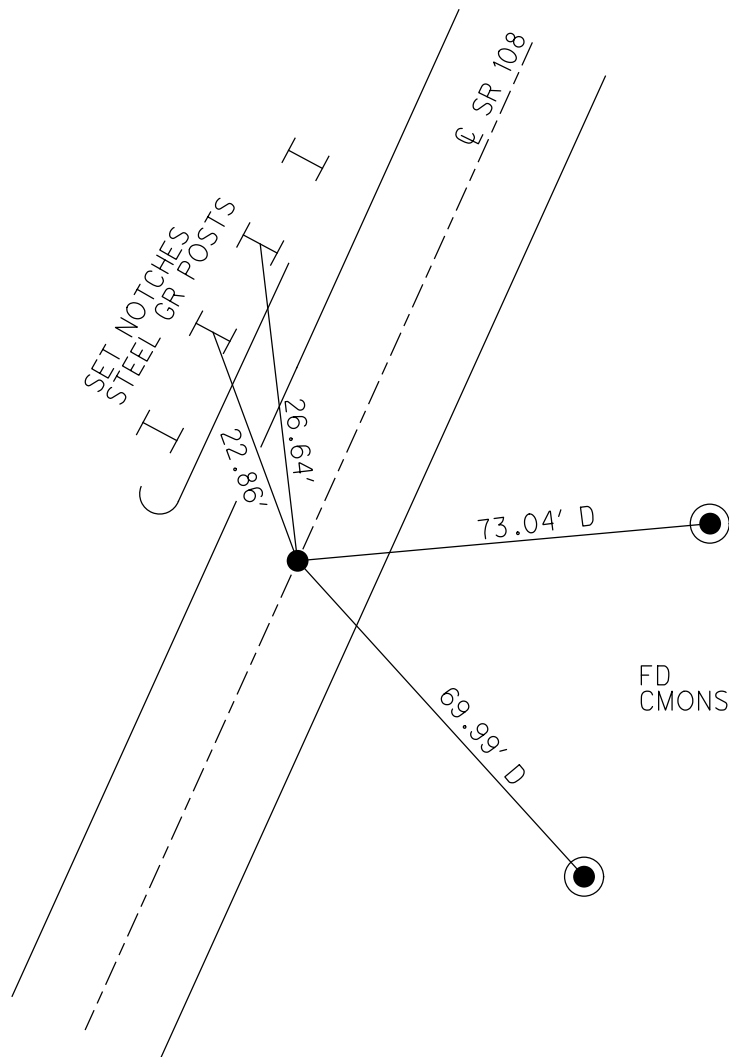

O.D.O.T. DISTRICT 2 SURVEY OFFICE (USE ONLY)

PERSONNEL

REFERENCE NO. 24

SHEET 9 OF 48

NOTES ELKHECHEN

DATE 11/5/18

ROUTE SR 108

H.C. LEU

WEATHER CLEAR

COUNTY HENRY

R.C. MILLER

TEMP. 51°

TOWNSHIP FLATROCK

DWG BY MILLER

PID 94319

SECTION 36

T 4 N R 6 E

TYPE MONUMENT 1" IPIN

~~ON SURFACE~~ - BELOW 8"

OFFSET Q PAVEMENT 53' ~~LT~~ : RT

- TO - EDGE PAVEMENT


STATION: 380+49.66

HORZ.DATUM: NAD83 (2011)


GEOID: 2012A

GRID: NORTHING: 586751.007

EASTING: 1522609.783

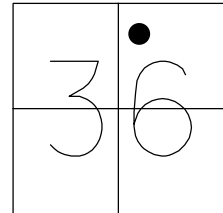

RECORD: P.I.
STA 380+52.60
 $\Delta = 29^{\circ} 05' 00''$
FD 1" IPIN
8" DOWN
8/18/92, MB
FD 1" IPIN
REF24
11-5-18, JLL

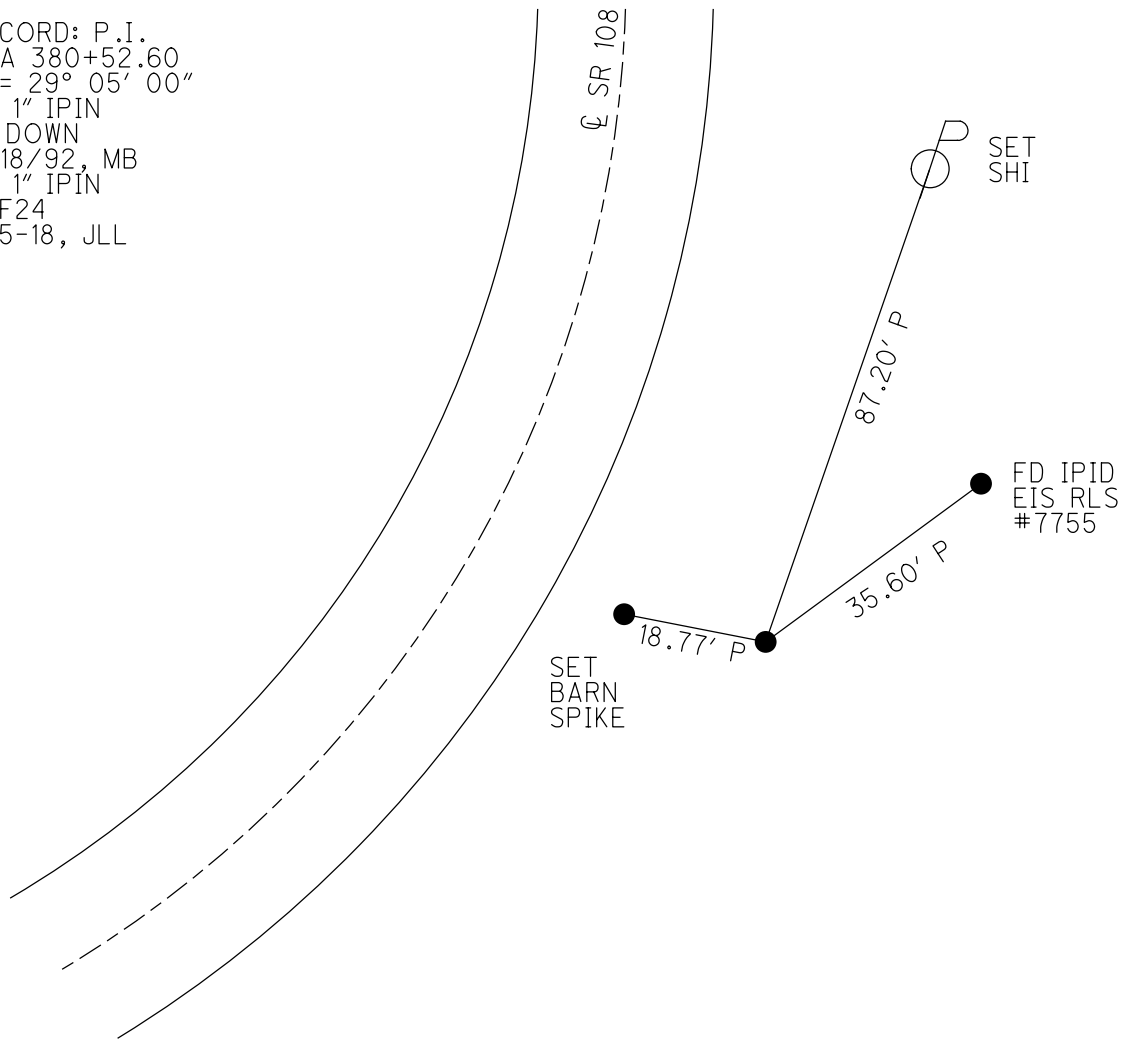

O.D.O.T. DISTRICT 2 SURVEY OFFICE (USE ONLY)

PERSONNEL

REFERENCE NO. 25

SHEET 10 OF 48

NOTES BALBAUGH

DATE 3/16/20

ROUTE SR 108

H.C. LEU

WEATHER PARTLY CLOUDY

COUNTY HENRY

R.C. BALBAUGH

TEMP. 36°

TOWNSHIP FLATROCK

SECTION 36

DWG BY BALBAUGH

PID 94319

T 4 N R 6 E

TYPE MONUMENT P.K.NAIL

~~ON SURFACE~~ - BELOW 3.5"

OFFSET ℄ PAVEMENT ON LT : RT

12.3' TO LT EDGE PAVEMENT


STATION: 386+12.10

HORIZ.DATUM: NAD83 (2011)

GEOID: 2012A


GRID: NORTHING: 587318.145

EASTING: 1522686.931

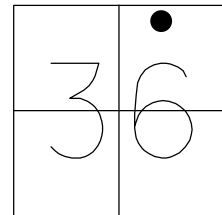

RECORD: S.T.
STA 386+01
FD P.K./WASHER
8/18/92, MB
SET P.K./WASHER
9-17-92, MB
FD P.K. NAIL
3.5" DOWN
REF25
11-5-18, JLL
SET MAG/WASHER
10-20-20, DSA

℄ SR 108

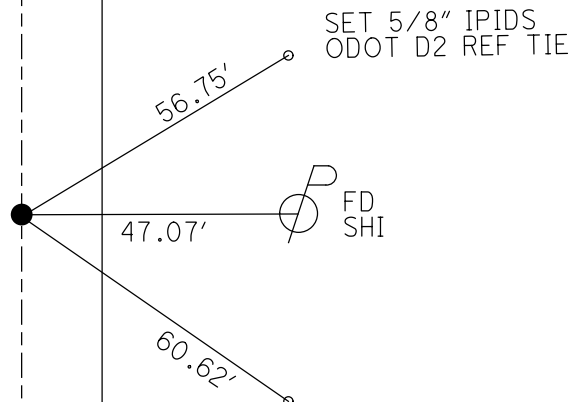

O.D.O.T. DISTRICT 2 SURVEY OFFICE (USE ONLY)

PERSONNEL

REFERENCE NO. 25A

SHEET 11 OF 48

NOTES ELKHECHEN

DATE 11/5/18

ROUTE SR 108

H.C. LEU

WEATHER CLOUDY

COUNTY HENRY

R.C. MILLER

TEMP. 51°

TOWNSHIP FLATROCK

SECTION 36

DWG BY MILLER

PID 94319

T 4 N R 6 E

TYPE MONUMENT P.K./WASHER

~~ON SURFACE~~ - BELOW 1 3/4"

OFFSET Q PAVEMENT 2.0 LT : ~~RT~~

- TO - EDGE PAVEMENT



STATION: 389+16.75

HORIZ.DATUM: NAD83 (2011)

GEOID: 2012A

GRID: NORTHING: 587619.932

EASTING: 1522727.916

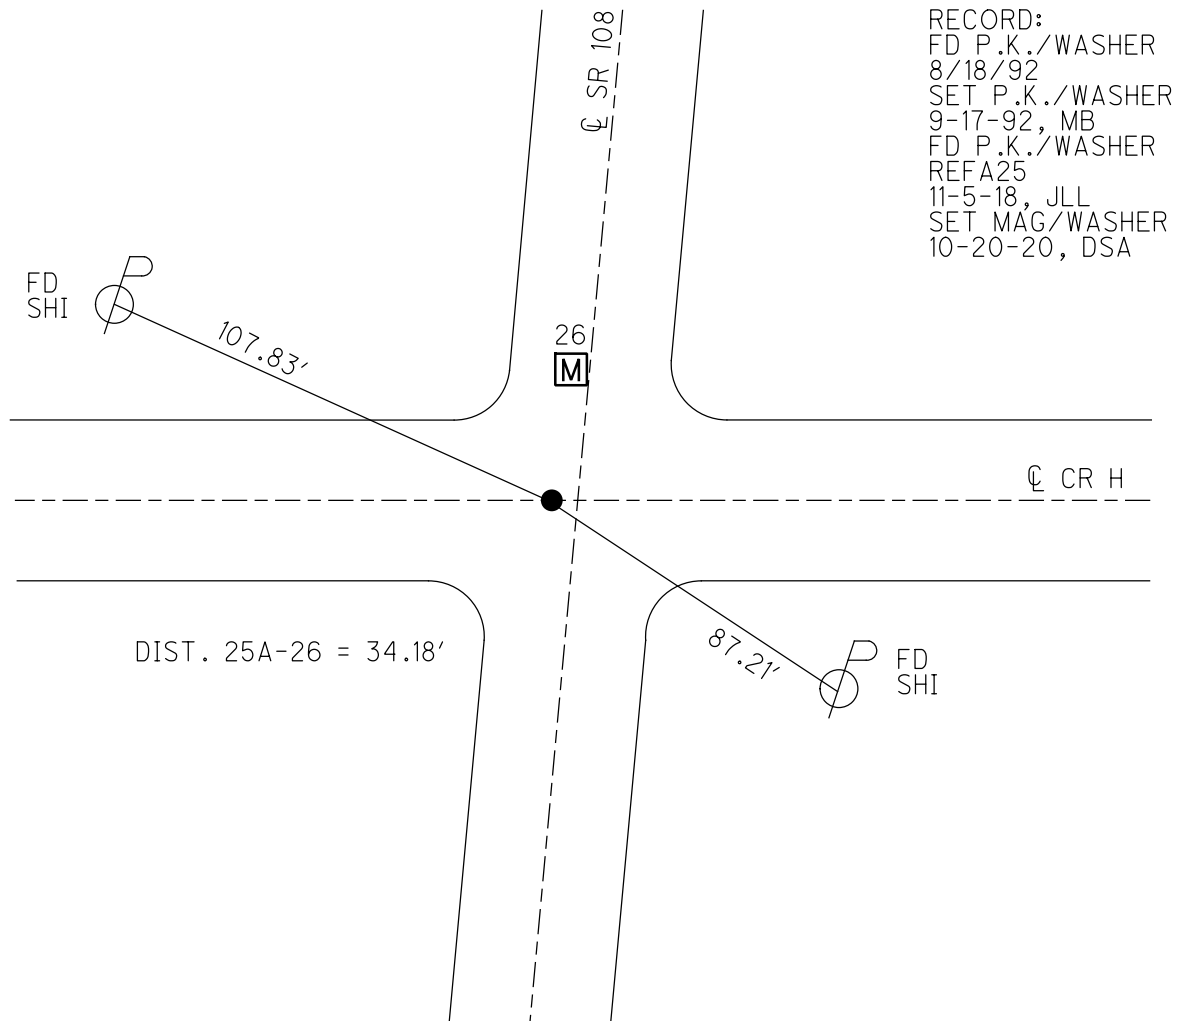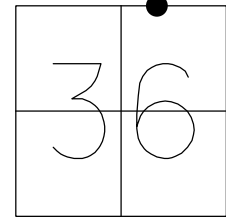

O.D.O.T. DISTRICT 2 SURVEY OFFICE (USE ONLY)

PERSONNEL

REFERENCE NO. 26

SHEET 12 OF 48

NOTES ELKHECHEN

DATE 11/5/18

ROUTE SR 108

H.C. LUE

WEATHER CLOUDY

COUNTY HENRY

R.C. MILLER

TEMP. 51°

TOWNSHIP FLATROCK

DWG BY MILLER

PID 94319

SECTION 36

T 4 N R 6 E

TYPE MONUMENT MONBOX

ON SURFACE - ~~BELOW~~ ON

OFFSET CL PAVEMENT 3.0' LT : ~~RT~~

8.7' TO LT EDGE PAVEMENT



STATION: 389+51.06

HORZ.DATUM: NAD83 (2011)

GEOID: 2012A

GRID: NORTHING: 587653.840

EASTING: 1522732.555

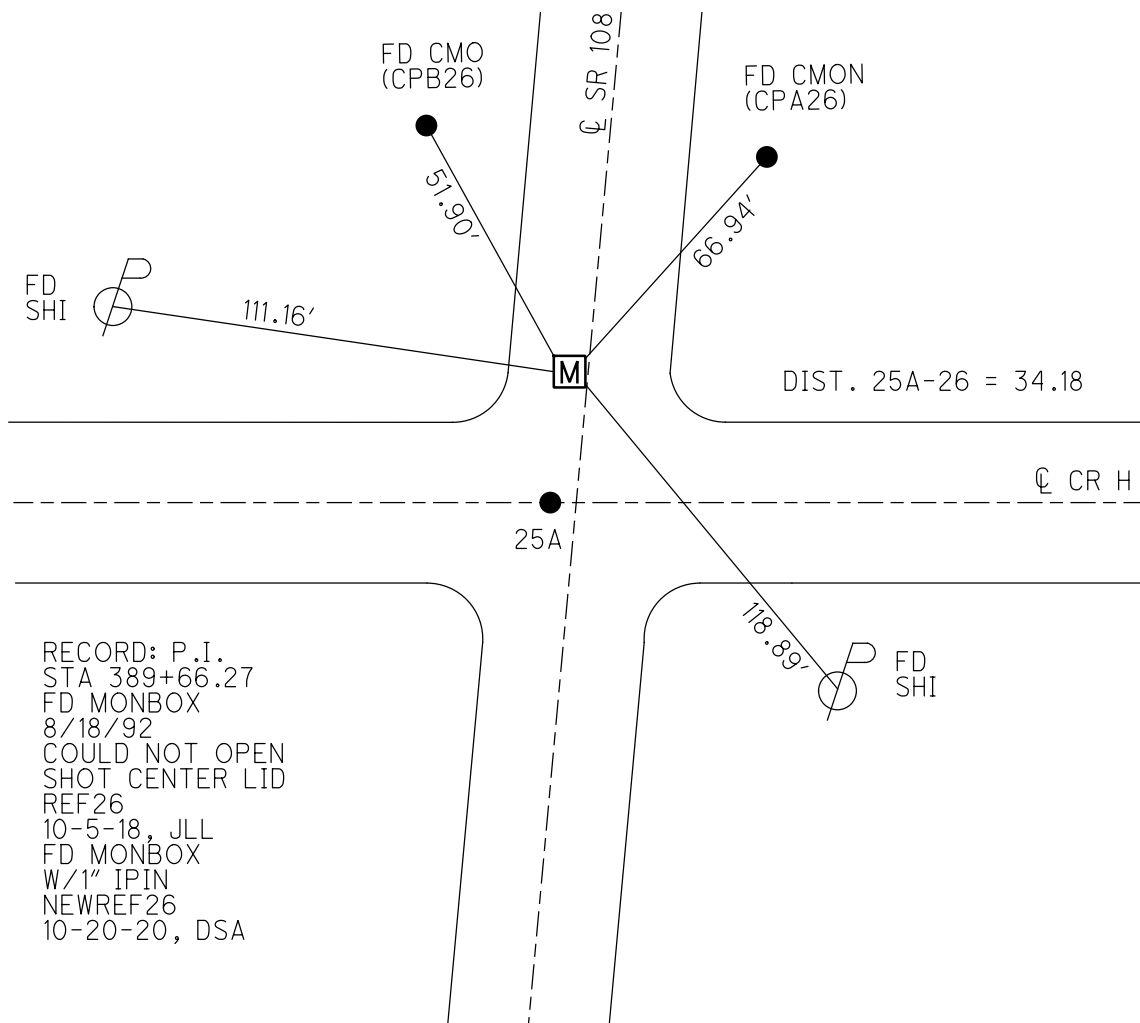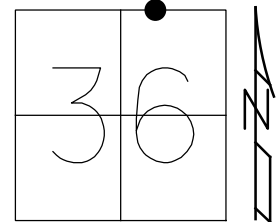

O.D.O.T. DISTRICT 2 SURVEY OFFICE (USE ONLY)

PERSONNEL

REFERENCE NO. 27

SHEET 13 OF 48

NOTES BALBAUGH

DATE 3/17/20

ROUTE SR 108

H.C. LEU

WEATHER CLOUDY

COUNTY HENRY

R.C. BALBAUGH

TEMP. 39°

TOWNSHIP FLATROCK

SECTION 25

DWG BY BALBAUGH PID 94319

T 4 N R 6 E

TYPE MONUMENT MONBOX W/ 1" IPIN

ON SURFACE - ~~BELOW~~ ON

OFFSET Q PAVEMENT 2.5' LT : ~~RT~~

9.9' TO LT EDGE PAVEMENT


STATION: 396+68.71

HORZ.DATUM: NAD83 (2011)


GEOID: 2012A

GRID: NORTHING: 588356.556

EASTING: 1522879.044

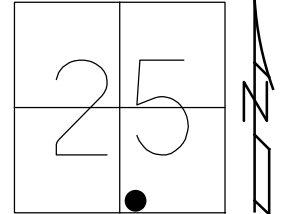

RECORD: P.I.
STA 396+84.19
FD MONBOX
DID NOT OPEN
8/18/92, MB
FD MONBOX
W/ 1" IPIN
REF27
11-5-18, JLL
FD MONBOX
W/1" IPIN
NEWREF27
10-20-20, DSA

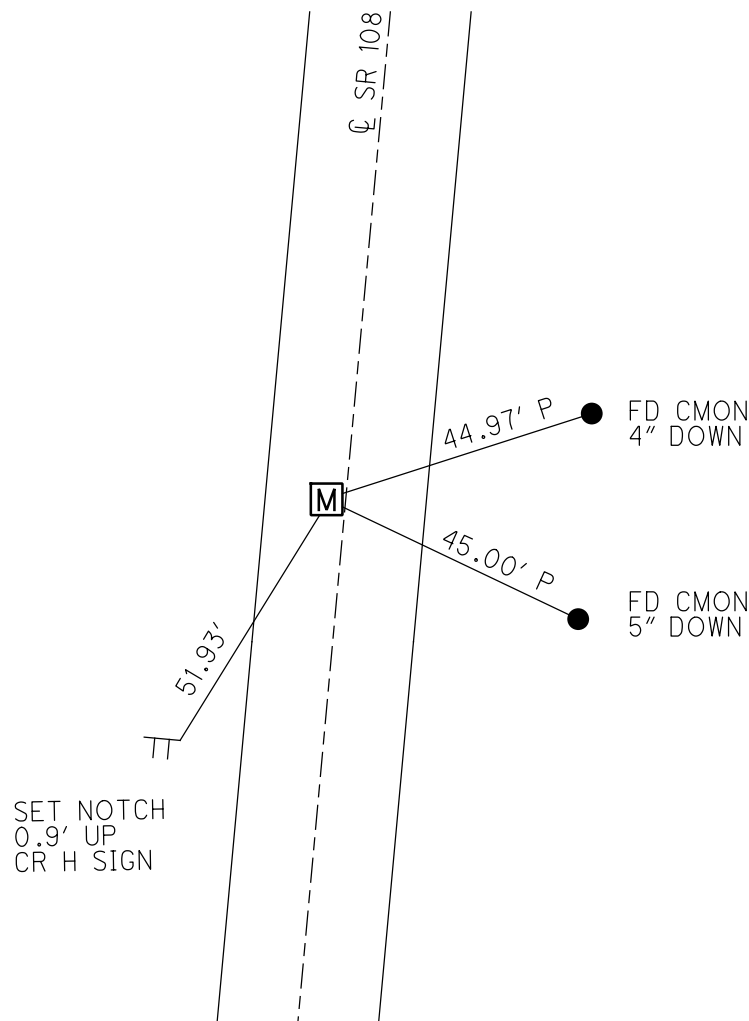

O.D.O.T. DISTRICT 2 SURVEY OFFICE (USE ONLY)

PERSONNEL

REFERENCE NO. 28

SHEET 14 OF 48

NOTES BALBAUGH

DATE 3/17/20

ROUTE SR 108

H.C. LEU

WEATHER CLOUDY

COUNTY HENRY

R.C. BALBAUGH

TEMP. 36°

TOWNSHIP FLATROCK

SECTION 25

DWG BY BALBAUGH

PID 94319

T 4 N R 6 E

TYPE MONUMENT MONBOX W/ 1" IPIN

ON SURFACE - ~~BELOW~~ ON

OFFSET Q PAVEMENT 4.4' ~~LT~~ : RT

8.5' TO RT EDGE PAVEMENT


STATION: 402+68.71

HORZ.DATUM: NAD83 (2011)


GEOID: 2012A

GRID: NORTHING: 588940.134

EASTING: 1523018.473

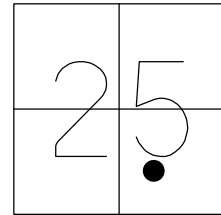

RECORD: P.I.
STA 402+84.49
 $\Delta = 19^{\circ} 52' 30''$
FD MONBOX
DID NOT OPEN
8/18/92, MB
FD MONBOX
W/ 1" IPIN
REF28
11-5-18, JLL
FD MONBOX
W/ 1" IPIN
NEWREF28
10-20-20, DSA

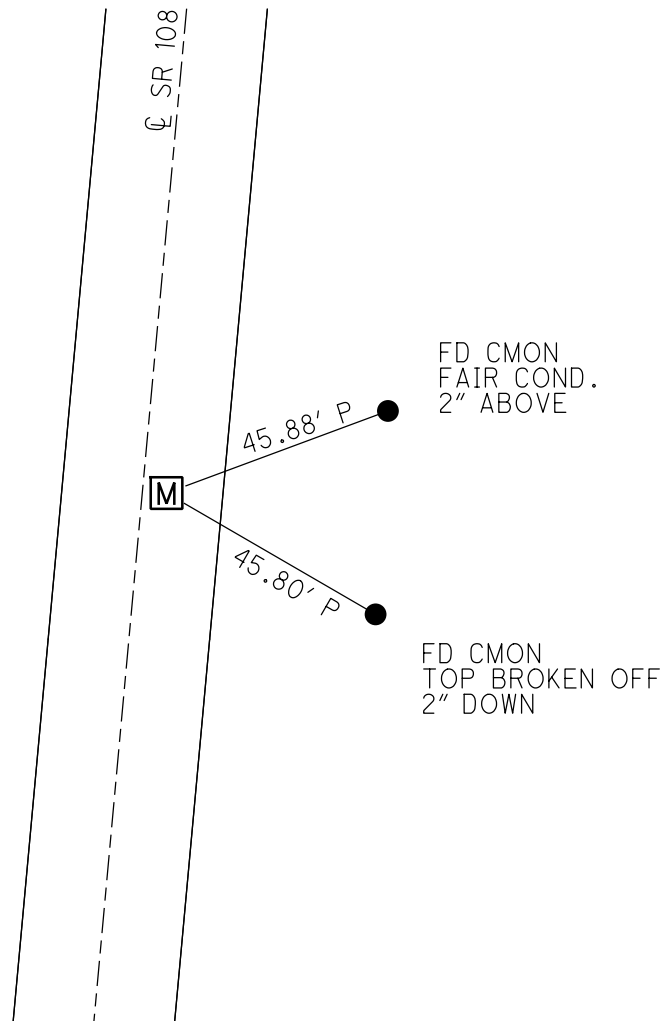

O.D.O.T. DISTRICT 2 SURVEY OFFICE (USE ONLY)

PERSONNEL

REFERENCE NO. 30

SHEET 15 OF 48

NOTES VAN DUSEN

DATE 8/18/92

ROUTE SR 108

H.C. KUSZ

WEATHER CLEAR

COUNTY HENRY

R.C. BARNHISEL

TEMP. 75°

TOWNSHIP FLATROCK

SECTION 25

DWG BY MILLER

PID 94319

T 4 N R 6 E

TYPE MONUMENT P.K./WASHER

ON SURFACE - ~~BELOW~~ ON

OFFSET Q PAVEMENT 0.7' LT : ~~RT~~

11.6' TO LT EDGE PAVEMENT


STATION: 410+60.14

HORZ.DATUM: _____

GEOID: _____

GRID: NORTHING: _____

EASTING: _____

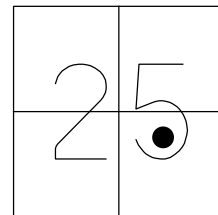

RECORD: T.S.
STA 410+76.78
FD P.K./WASHER
8/18/92, MB
SET P.K./WASHER
9-17-92, MB
D.N.F.
11-5-18, JLL

FD
SHI

74.69' REC

Q SR 108

SET SHI
MB POST

MB

30.08'

53.03' P

CMON

53.05' P

CMON

O.D.O.T. DISTRICT 2 SURVEY OFFICE (USE ONLY)

PERSONNEL

REFERENCE NO. 31

SHEET 16 OF 48

NOTES BALBAUGH

DATE 3/17/20

ROUTE SR 108

H.C. LEU

WEATHER CLOUDY

COUNTY HENRY

R.C. BALBAUGH

TEMP. 36°

TOWNSHIP FLATROCK

SECTION 25

DWG BY BALBAUGH

PID 94319

T 4 N R 6 E

TYPE MONUMENT MONBOX W/ 1" IPIN

ON SURFACE - ~~BELOW~~ ON

OFFSET Q PAVEMENT 37.5' LT : ~~RT~~

- TO - EDGE PAVEMENT


STATION: 416+15.66

HORZ.DATUM: NAD83 (2011)


GEOID: 2012A

GRID: NORTHING: 590270.675

EASTING: 1523242.371

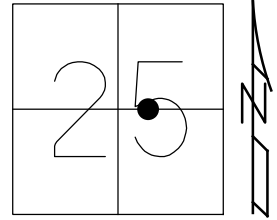

RECORD: P.I.
STA 416+33.82
 $\Delta = 18^{\circ} 07' 30''$
FD MONBOX
DID NOT OPEN
8/18/92, MB
FD MONBOX
W/1" IPIN
REF31
11-5-18, JLL

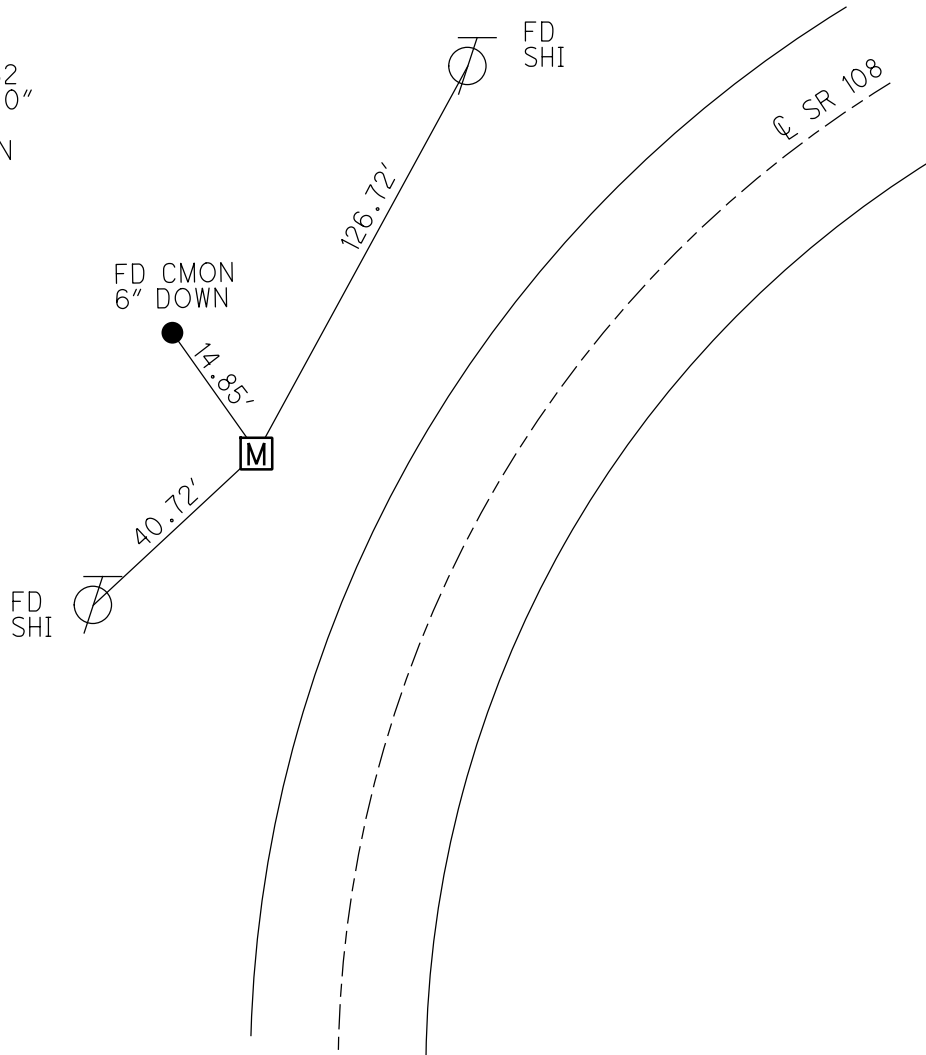

O.D.O.T. DISTRICT 2 SURVEY OFFICE (USE ONLY)

PERSONNEL

REFERENCE NO. 32

SHEET 17 OF 48

NOTES VAN DEUSEN

DATE 8/18/92

ROUTE SR 108

H.C. KUSZ

WEATHER CLEAR

COUNTY HENRY

R.C. BARNHISEL

TEMP. 75°

TOWNSHIP FLATROCK

SECTION 25

DWG BY MILLER

PID 94319

T 4 N R 6 E

TYPE MONUMENT P.K./WASHER

ON SURFACE - ~~BELOW~~ ON

OFFSET Q PAVEMENT ON LT : RT

12.5' TO RT EDGE PAVEMENT


STATION: 421+67.57

HORZ.DATUM: NAD83 (2011)


GEOID: 2012A

GRID: NORTHING: 590764.393

EASTING: 1523501.595

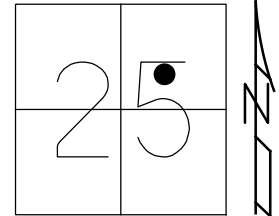

RECORD:
STA 421+83.03 BACK
STA 421+80.92 AHEAD
FD P.K./WASHER
8/18/92, MB
SET P.K./WASHER
9-17-92, MB
DNF
11-5-18, JLL

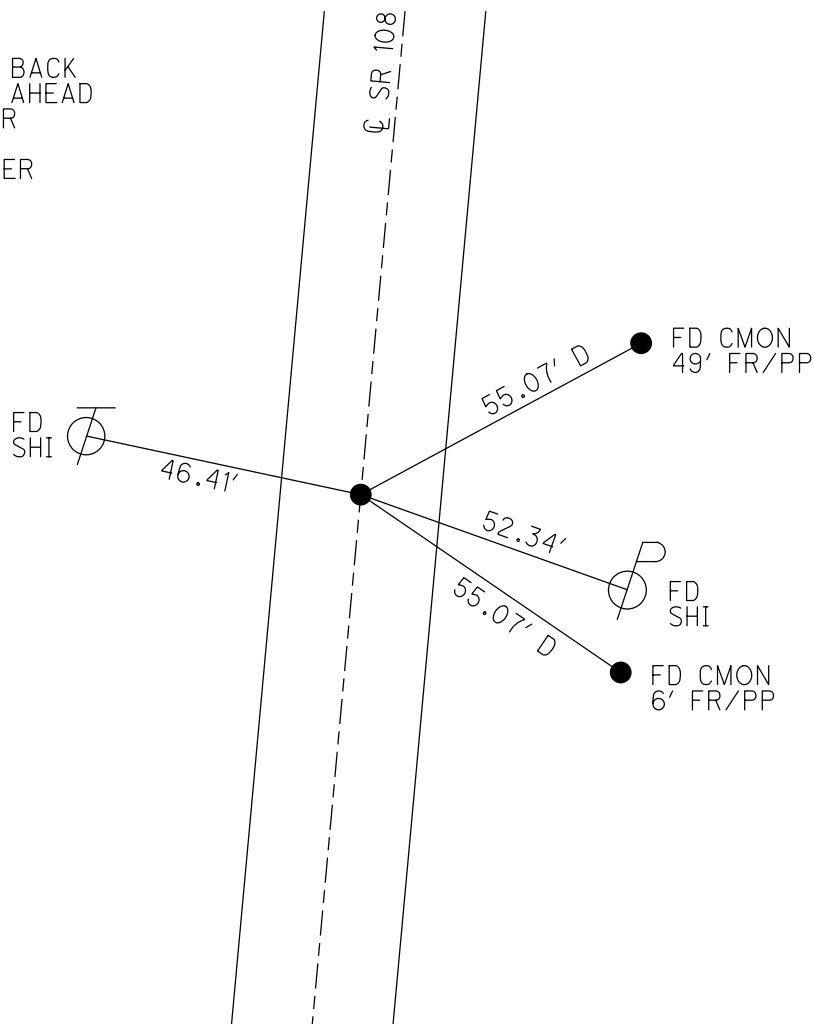

O.D.O.T. DISTRICT 2 SURVEY OFFICE (USE ONLY)

PERSONNEL

REFERENCE NO. 33

SHEET 18 OF 48

NOTES LEU

DATE 3/17/20

ROUTE SR 108

H.C. LEU

WEATHER CLOUDY

COUNTY HENRY

R.C. BALBAUGH

TEMP. 41°

TOWNSHIP FLATROCK

SECTION 25

DWG BY BALBAUGH

PID 94319

T 4 N R 6 E

TYPE MONUMENT MONBOX W/ 1" IPIN

ON SURFACE - ~~BELOW~~ ON

OFFSET Q PAVEMENT 7.5' ~~LT~~ : RT

4.7' TO RT EDGE PAVEMENT


STATION: 431+03.76

HORIZ.DATUM: NAD83 (2011)


GEOID: 2012A

GRID: NORTHING: 591593.286

EASTING: 1523936.829

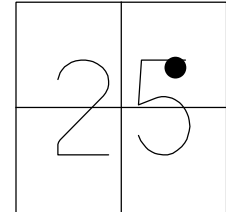

RECORD: P.I.
STA 431+18.13
 $\Delta=08^{\circ}52'$ LT
FD MONBOX
DID NOT OPEN
PK @ SURFACE
8-18-92, MB
FD MON BOX
W/ 1" IPIN
REF33
11-5-18, JLL
FD MONBOX
W/1" IPIN
NEWREF33
10-20-20, DSA

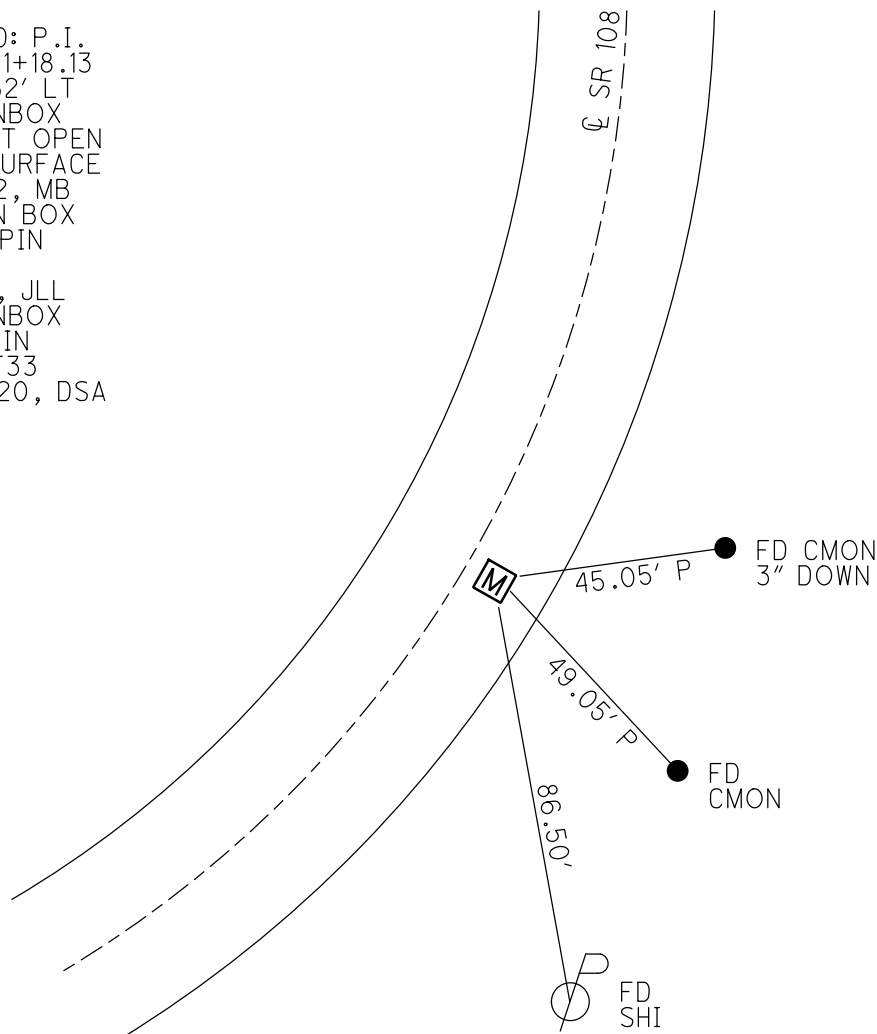

O.D.O.T. DISTRICT 2 SURVEY OFFICE (USE ONLY)

PERSONNEL

REFERENCE NO. 34

SHEET 19 OF 48

NOTES LEU

DATE 3/17/20

ROUTE SR 108

H.C. LEU

WEATHER CLOUDY

COUNTY HENRY

R.C. BALBAUGH

TEMP. 41°

TOWNSHIP FLATROCK

SECTION 25

DWG BY BALBAUGH

PID 94319

T 4 N R 6 E

TYPE MONUMENT LG.R.R.SPIKE

~~ON SURFACE~~ - BELOW 6.75"

OFFSET Q PAVEMENT 15.7' ~~LT~~ : RT

- TO - EDGE PAVEMENT


STATION: 435+25.57

HORIZ.DATUM: NAD83 (2011)

GEOID: 2012A

GRID: NORTHING: 591993.211


EASTING: 1524073.108

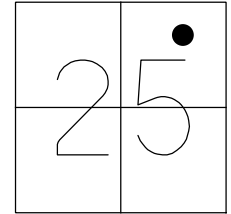

RECORD: P.I.
STA 435+39.96
FD LG.R.R.SPIKE
4" DOWN
8/18/92, MB
FD LG.R.R.SPIKE
6 3/4" DOWN
REF 34
11-6-18, JLL
SET MAG/WASHER
10-20-20, DSA

FD "+"
TOP OF BOLT
ON ANCHOR
ASSEMBLY

FD LG.R.R.SPIKE
18" COTONWOOD

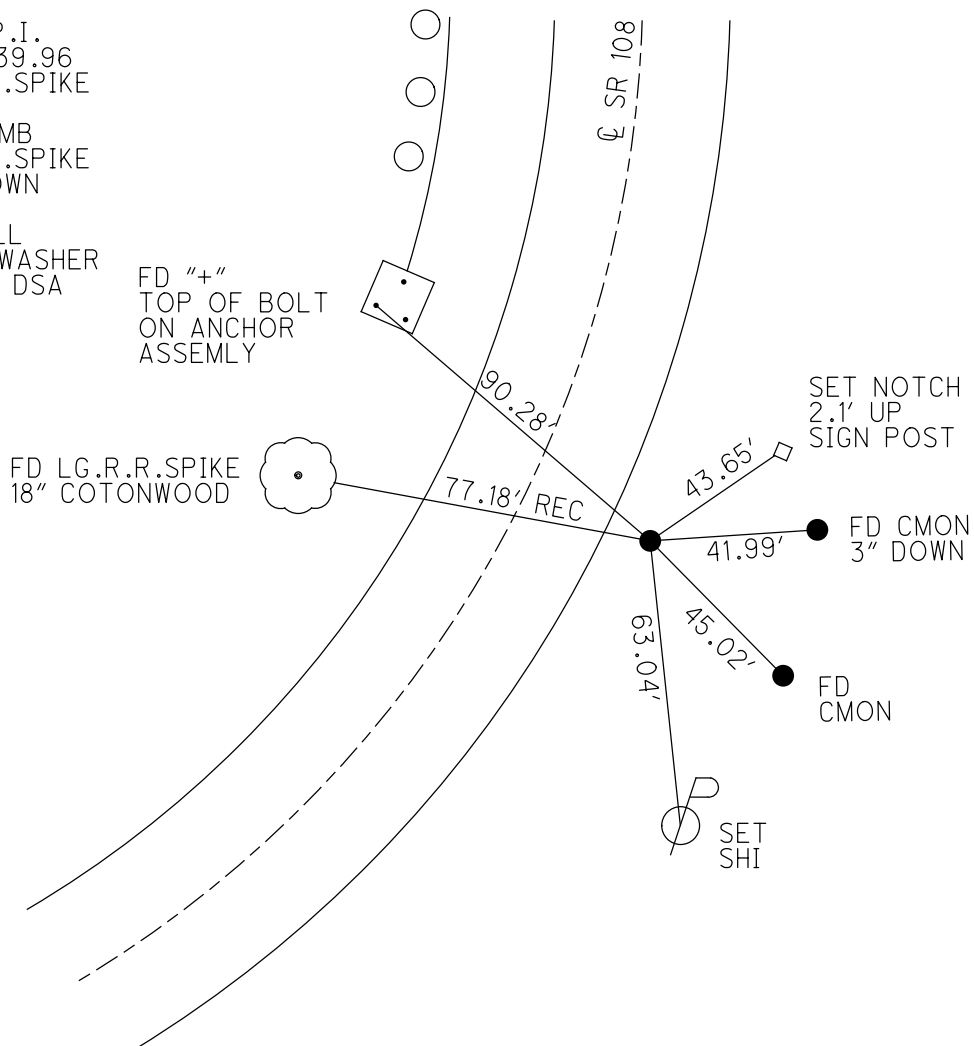

O.D.O.T. DISTRICT 2 SURVEY OFFICE (USE ONLY)

PERSONNEL

REFERENCE NO. 35

SHEET 20 OF 48

NOTES BALBAUGH

DATE 3/17/20

ROUTE SR 108

H.C. LEU

WEATHER CLOUDY

COUNTY HENRY

R.C. BALBAUGH

TEMP. 41°

TOWNSHIP FLATROCK

SECTION 25

DWG BY BALBAUGH

PID 94319

T 4 N R 6 E

TYPE MONUMENT MONBOX W/ 1" IPIN

ON SURFACE - ~~BELOW~~ ON

OFFSET Q PAVEMENT 10.2' ~~LT~~ : RT

1.8' TO RT EDGE PAVEMENT


STATION: 438+41.92

HORIZ.DATUM: NAD83 (2011)

GEOID: 2012A


GRID: NORTHING: 592311.609

EASTING: 1524083.336

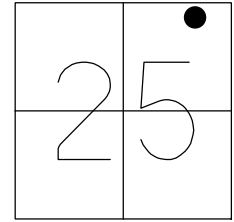

RECORD: P.I.
STA 438+55.67 LT
 $\Delta = 14^\circ 24'$
FD MONBOX
DID NOT OPEN
8-18-92, MB
FD MONBOX
W/ 1" IPIN
REF 35
11-6-18, JLL
FD MONBOX
COVERED W/ ASPHALT
10-22-20, DSA
SET MAG/W
12-14-20, DSA

SET NOTCH
2.5' UP
SIGN

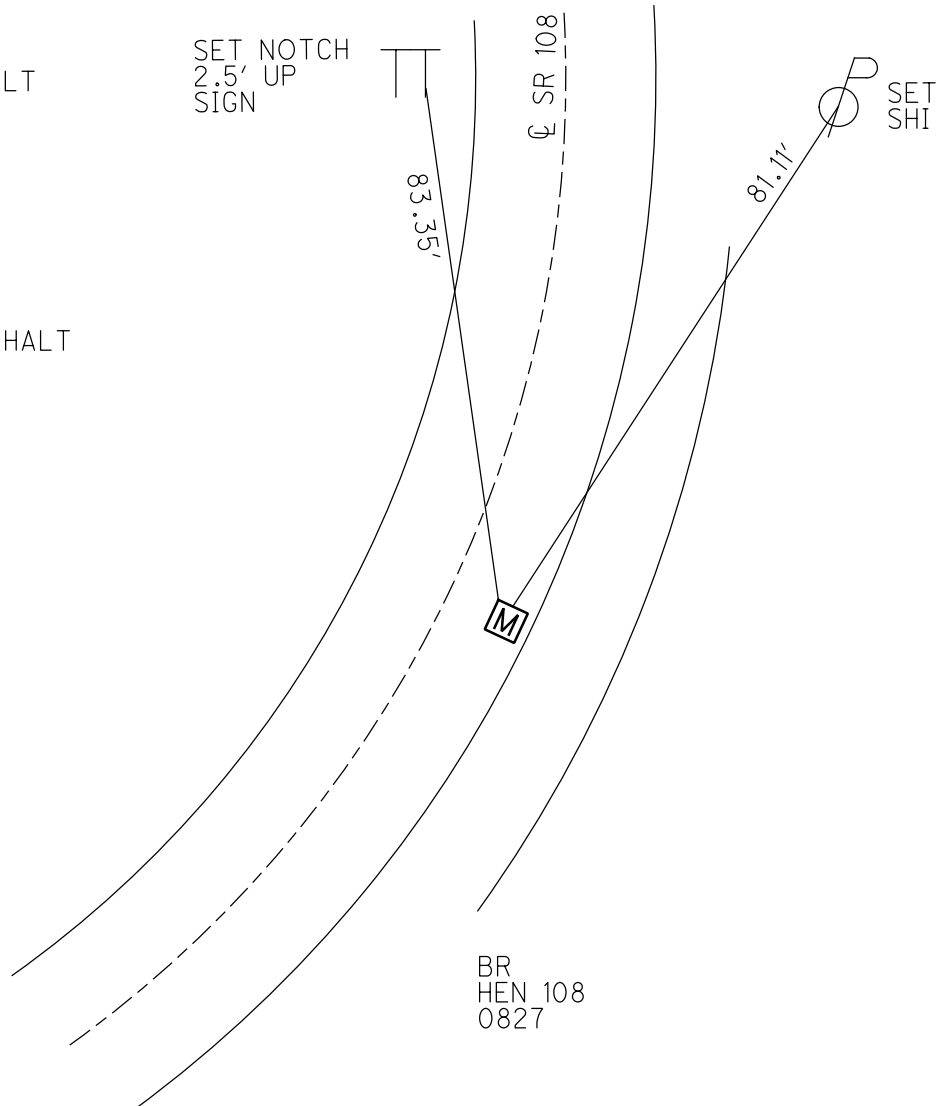

O.D.O.T. DISTRICT 2 SURVEY OFFICE (USE ONLY)

PERSONNEL

REFERENCE NO. 35 A

SHEET 21 OF 48

NOTES LEU

DATE 3/19/20

ROUTE SR 108

H.C. LEU

WEATHER FOG

COUNTY HENRY

R.C. BALBAUGH

TEMP. 40°

TOWNSHIP FLATROCK

SECTION 25

DWG BY BALBAUGH

PID 94319

T 4 N R 6 E

TYPE MONUMENT MAG/WASHER

ON SURFACE - ~~BELOW~~ ON

OFFSET Q PAVEMENT 15.4' LT : ~~RT~~

- TO - EDGE PAVEMENT


STATION: 444+53.34

HORZ.DATUM: NAD83 (2011)

GEOID: 2012A


GRID: NORTHING: 592911.473

EASTING: 1523949.701

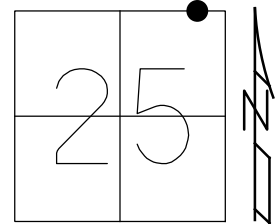

RECORD: P.I.
STA 444+96.06
SET P.K./WASHER
9-17-92, MDB
FD P.K./WASHER
5-19-98, MC
SET MAG/WASHER
REFA35
11/6/18, JLL
SET MAG/WASHER
10-20-20, DSA

NOTE: REF 12A SR 281

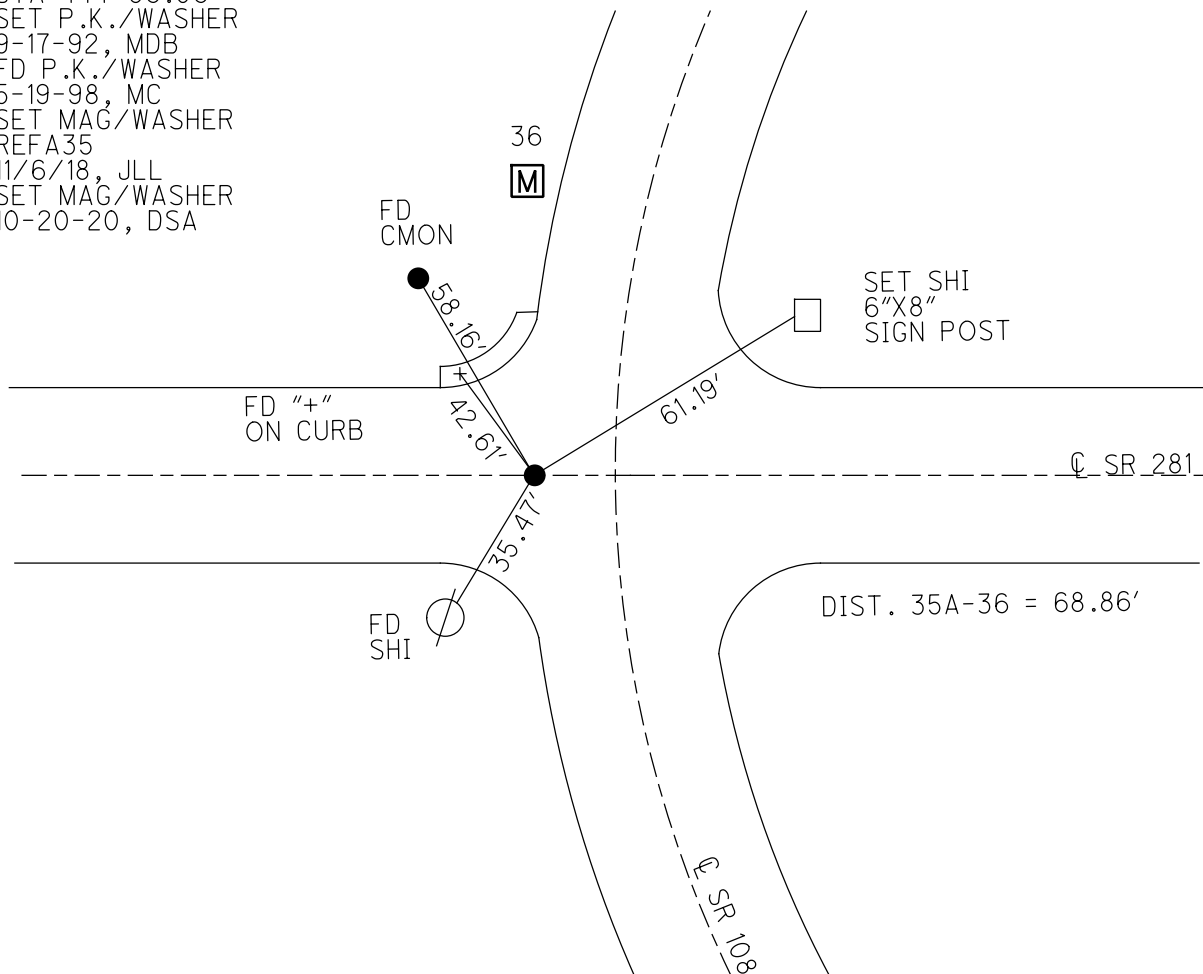

O.D.O.T. DISTRICT 2 SURVEY OFFICE (USE ONLY)

PERSONNEL

REFERENCE NO. 36

SHEET 22 OF 48

NOTES LEU

DATE 3/19/20

ROUTE SR 108

H.C. LEU

WEATHER FOG

COUNTY HENRY

R.C. BALBAUGH

TEMP. 40°

TOWNSHIP FLATROCK

DWG BY BALBAUGH

PID 94319

SECTION 25

T 4 N R 6 E

TYPE MONUMENT MONBOX W/ 1" IPIN

ON SURFACE - ~~BELOW~~ ON

OFFSET Q PAVEMENT 15.4' LT : ~~RT~~

- TO - EDGE PAVEMENT


STATION: 445+20.67

HORIZ.DATUM: NAD83 (2011)


GEOID: 2012A

GRID: NORTHING: 592978.650

EASTING: 1523934.669

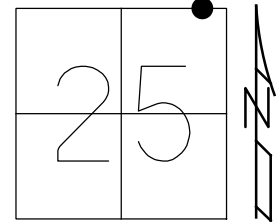

NOTE: REF 12B SR 281

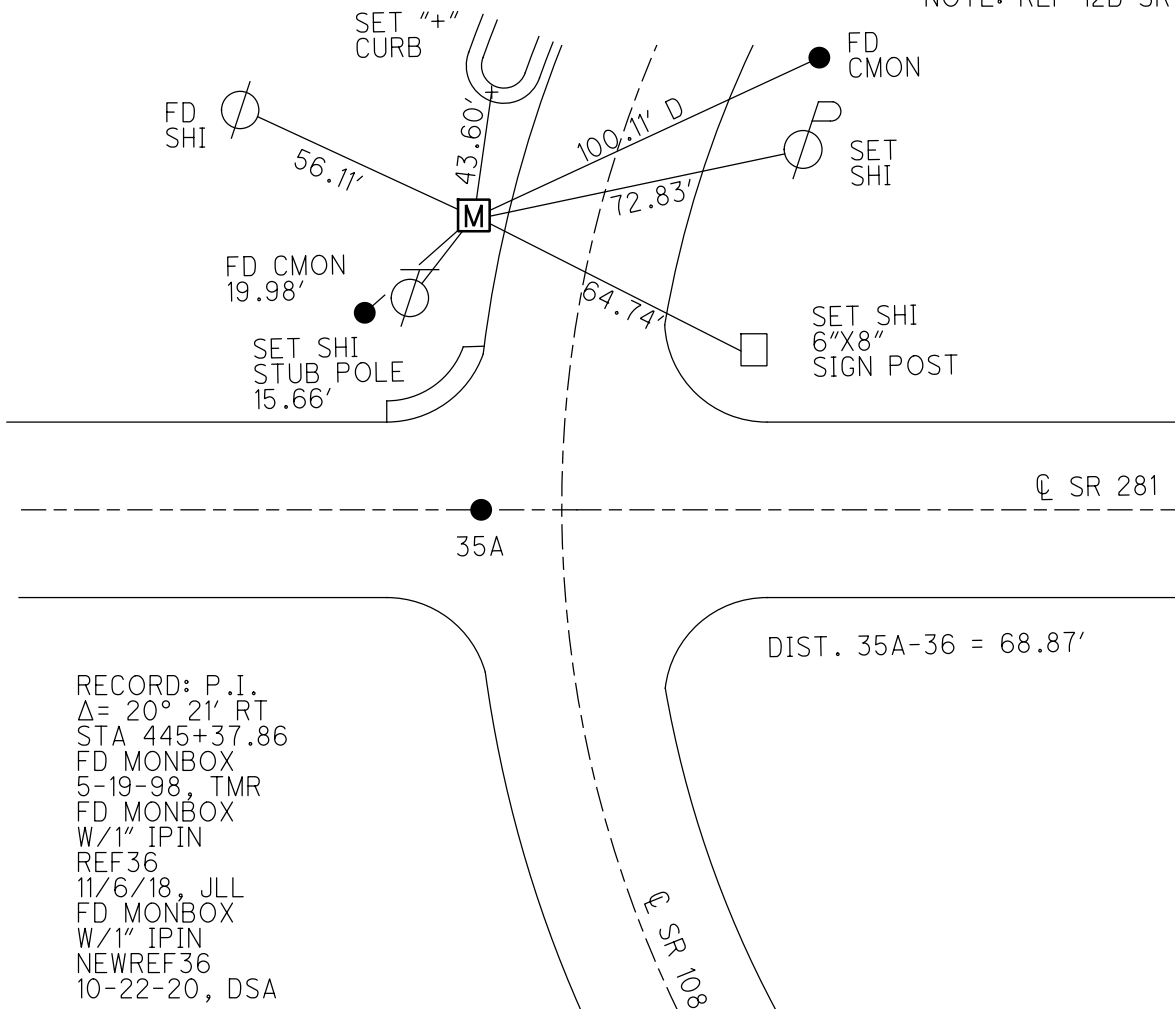

RECORD: P.I.
 $\Delta = 20^\circ 21' \text{ RT}$
STA 445+37.86
FD MONBOX
5-19-98, TMR
FD MONBOX
W/1" IPIN
REF36
11/6/18, JLL
FD MONBOX
W/1" IPIN
NEWREF36
10-22-20, DSA

O.D.O.T. DISTRICT 2 SURVEY OFFICE (USE ONLY)

PERSONNEL

REFERENCE NO. 37

SHEET 23 OF 48

NOTES VAN DUSEN

DATE 8/18/92

ROUTE SR 108

H.C. KUSZ

WEATHER CLEAR

COUNTY HENRY

R.C. BARNHISEL

TEMP. 75°

TOWNSHIP FLATROCK

SECTION 24

DWG BY MILLER

PID 94319

T 4 N R 6 E

TYPE MONUMENT P.K./WASHER

ON SURFACE - ~~BELOW~~ ON

OFFSET Q PAVEMENT 0.5' ~~LT~~ : RT

12.3' TO LT EDGE PAVEMENT


STATION: 449+25.12

HORIZ.DATUM: NAD83 (2011)


GEOID: 2012A

GRID: NORTHING: 593442.670

EASTING: 1523998.396

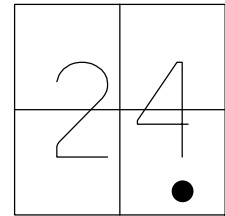

RECORD: P.O.T.
STA 450+00
FD P.K./WASHER
8/18/92, MB
SET P.K./WASHER
9-17-92, MB
SHOT TIE XING
REF37
11-6-18, JLL
DID NOT SET
10-22-20, DSA

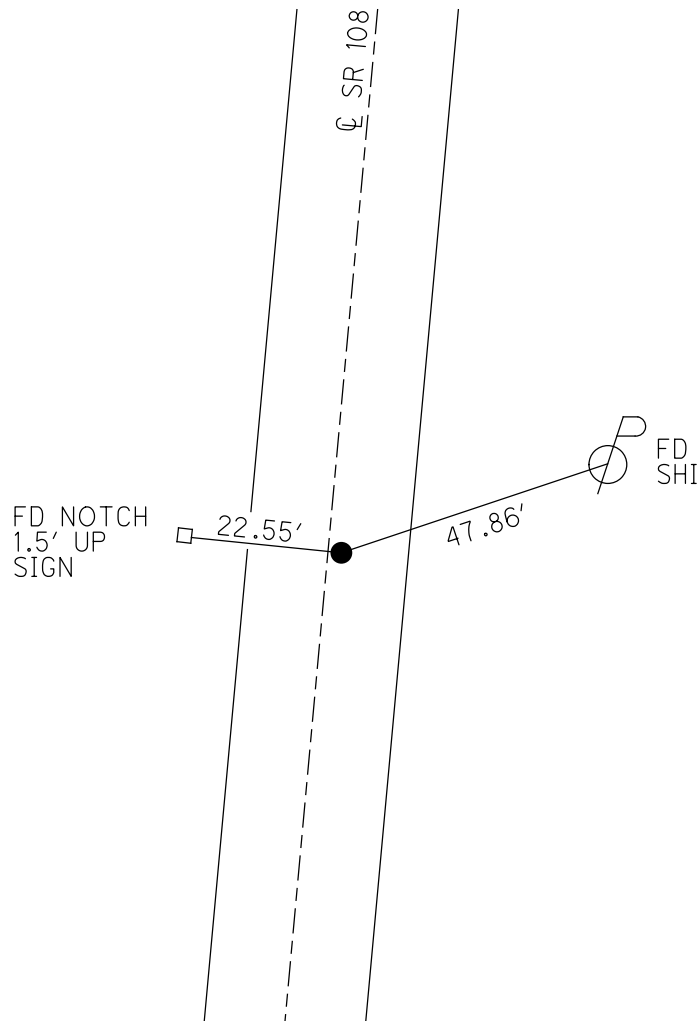

O.D.O.T. DISTRICT 2 SURVEY OFFICE (USE ONLY)

PERSONNEL

REFERENCE NO. 38

SHEET 24 OF 48

NOTES VAN DUSEN

DATE 8/18/92

ROUTE SR 108

H.C. KUSZ

WEATHER CLOUDY

COUNTY HENRY

R.C. BARNHISEL

TEMP. 75°

TOWNSHIP FLATROCK

SECTION 24

DWG BY MILLER

PID 94319

T 4 N R 6 E

TYPE MONUMENT P.K./WASHER

ON SURFACE - ~~BELOW~~ ON

OFFSET Q PAVEMENT 0.7' ~~LT~~ : RT

12.2' TO RT EDGE PAVEMENT


STATION: 454+96.81

HORZ.DATUM: NAD83 (2011)


GEOID: 2012A

GRID: NORTHING: 593949.485

EASTING: 1524068.022

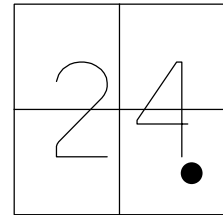

RECORD: P.C.
STA 455+11.47
FD P.K./WASHER
8/18/92, MB
SET P.K./WASHER
9-17-92, MB
SHOT TIE XING
REF38
11-6-18, JLL
DID NOT SET
10-22-20, DSA

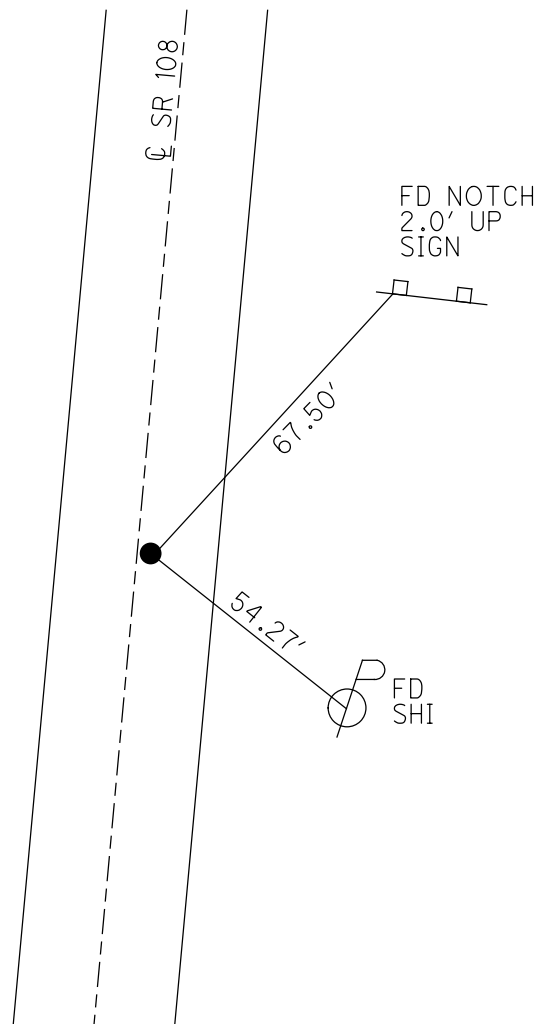

O.D.O.T. DISTRICT 2 SURVEY OFFICE (USE ONLY)

PERSONNEL

REFERENCE NO. 39

SHEET 25 OF 48

NOTES LEU

DATE 3/19/20

ROUTE SR 108

H.C. LEU

WEATHER CLOUDY

COUNTY HENRY

R.C. BALBAUGH

TEMP. 41°

TOWNSHIP FLATROCK

SECTION 24

DWG BY BALBAUGH PID 94319

T 4 N R 6 E

TYPE MONUMENT MONBOX W/ 1" IPIN

ON SURFACE - ~~BELOW~~ ON

OFFSET C PAVEMENT 11.7' ~~LT~~ : RT

0.8' TO RT EDGE PAVEMENT


STATION: 458+10.06

HORZ.DATUM: NAD83 (2011)


GEOID: 2012A

GRID: NORTHING: 594259.372

EASTING: 1524110.330

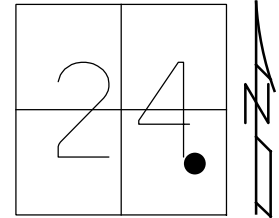

RECORD: P.I.
STA 458+24.52 LT
 $\Delta = 08^{\circ} 20'$
FD MONBOX
8/17/92
FD MONBOX
W/ 1" IPIN
REF39
11-6-18, JLL
FD MONBOX
W/1" IPIN
NEWREF39
10-22-20, DSA

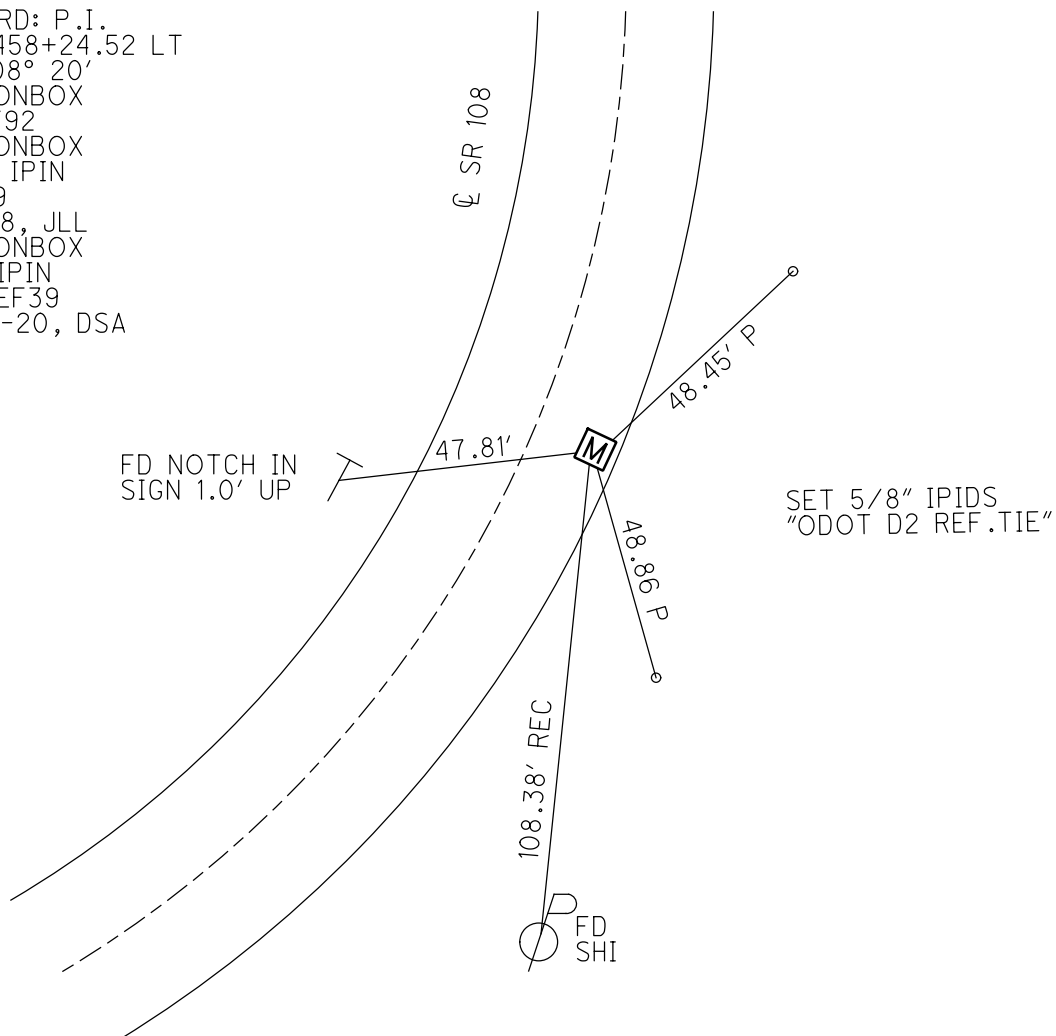

O.D.O.T. DISTRICT 2 SURVEY OFFICE (USE ONLY)

PERSONNEL

REFERENCE NO. 40

SHEET 26 OF 48

NOTES VAN DUSEN

DATE 8/17/92

ROUTE SR 108

H.C. KUSZ

WEATHER CLOUDY

COUNTY HENRY

R.C. BARNHISEL

TEMP. 75°

TOWNSHIP FLATROCK

SECTION 24

DWG BY MILLER

PID 94319

T 4 N R 6 E

TYPE MONUMENT P.K./WASHER

ON SURFACE - ~~BELOW~~ ON

OFFSET Q PAVEMENT 0.5' LT : RT

13.2' TO LT EDGE PAVEMENT


STATION: 461+22.21

HORZ.DATUM: _____

GEOID: _____

GRID: NORTHING: _____

EASTING: _____

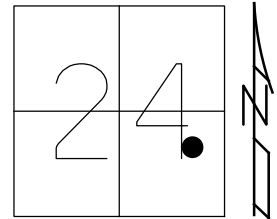

RECORD:

STA 461+36.47 BACK

STA 461+36.93 AHEAD

FD P.K./WASHER

8/17/92, MB

SET P.K./WASHER


9-17-92, MB

DNF

11-6-18, JLL

DID NOT SET

10-22-20, DSA

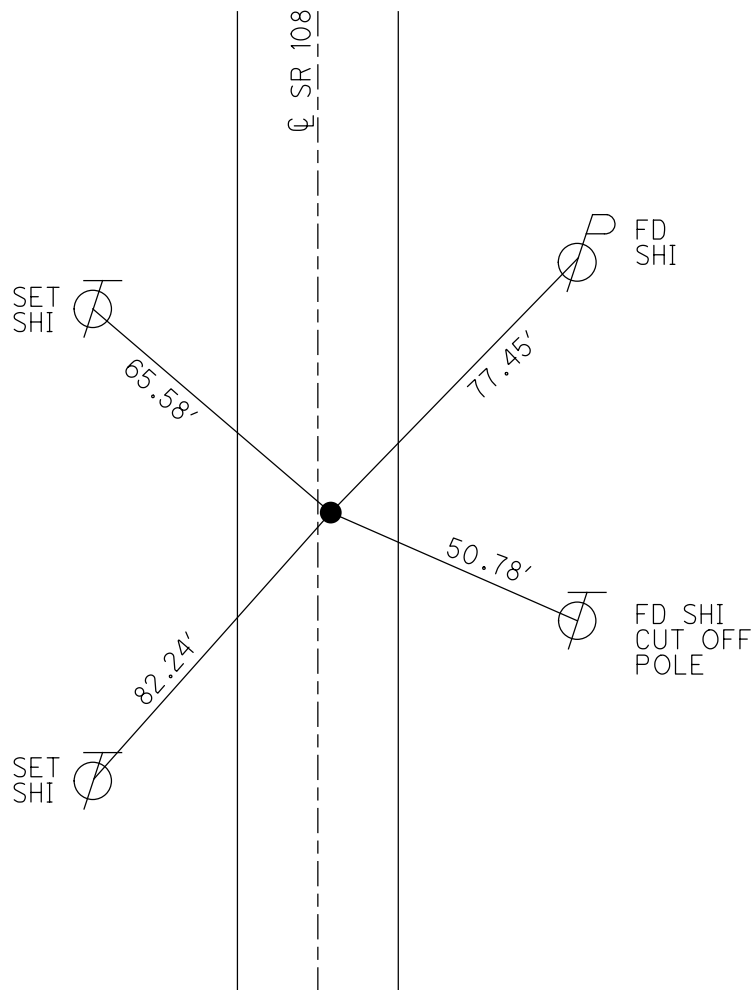

O.D.O.T. DISTRICT 2 SURVEY OFFICE (USE ONLY)

PERSONNEL	REFERENCE NO. <u>41</u>	SHEET <u>27</u> OF <u>48</u>
NOTES <u>LEU</u>	DATE <u>3/19/20</u>	ROUTE <u>SR 108</u>
H.C. <u>LEU</u>	WEATHER <u>CLOUDY</u>	COUNTY <u>HENRY</u>
R.C. <u>BALBAUGH</u>	TEMP. <u>41°</u>	TOWNSHIP <u>FLATROCK</u>
		SECTION <u>24</u>
DWG BY <u>BALBAUGH</u>	PID <u>94319</u>	T <u>4</u> N R <u>6</u> E

TYPE MONUMENT MONBOX W/ 1" IPIN

ON SURFACE - ~~BELOW~~ ON

OFFSET Q PAVEMENT ON LT : RT
13.0' TO LT EDGE PAVEMENT


STATION: 471+08.43

HORIZ.DATUM: NAD83 (2011)


GEOID: 2012A

GRID: NORTHING: 595558.789

EASTING: 1524098.248

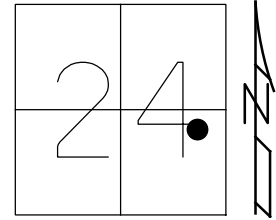

RECORD: P.I.
STA 471+23.79
 $\Delta = 00^\circ 04'$
FD MONBOX
8/17/92, MB
FD MONBOX
W/ 1" IPIN
REF41
11-6-18, JLL
FD MONBOX
W/1" IPIN
NEWREF41
10-22-20, DSA

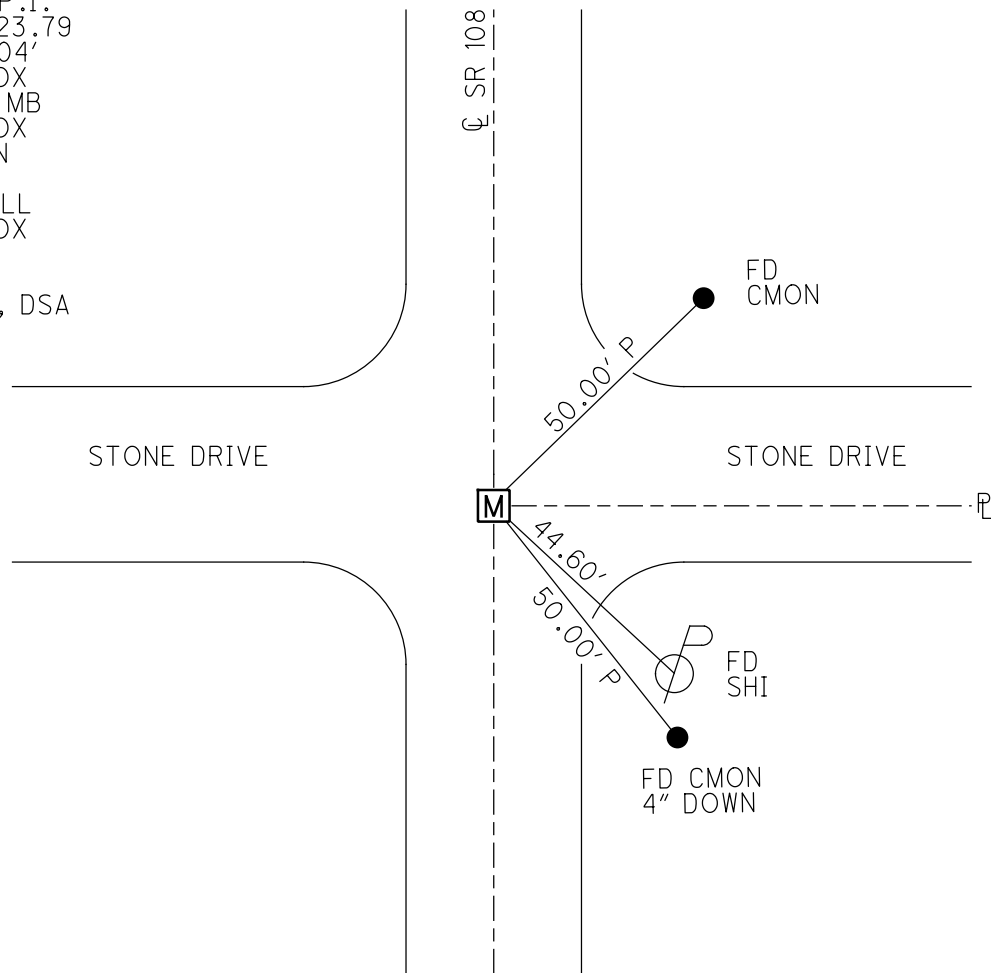

O.D.O.T. DISTRICT 2 SURVEY OFFICE (USE ONLY)

PERSONNEL

REFERENCE NO. 42

SHEET 28 OF 48

NOTES BALBAUGH

DATE 3/19/20

ROUTE SR 108

H.C. LEU

WEATHER CLOUDY

COUNTY HENRY

R.C. BALBAUGH

TEMP. 46°

TOWNSHIP FLATROCK

SECTION 24

DWG BY BALBAUGH

PID 94319

T 4 N R 6 E

TYPE MONUMENT MONBOX W/ 1" IPIN

ON SURFACE - ~~BELOW~~ ON

OFFSET Q PAVEMENT ON LT : RT

- TO - EDGE PAVEMENT


STATION: 497+62.64

HORZ.DATUM: NAD83 (2011)

GEOID: 2012A

GRID: NORTHING: 598212.878

EASTING: 1524075.969

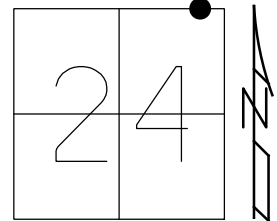

RECORD:

STA 497+78.69

$\Delta = 00^\circ 03' \text{ RT}$

FD MONBOX

8/19/92, MB

FD MONBOX

W/ 1" IPIN

REF42


11-6-18, JLL

FD MONBOX

W/1" IPIN

NEWREF42

10-22-20, DSA

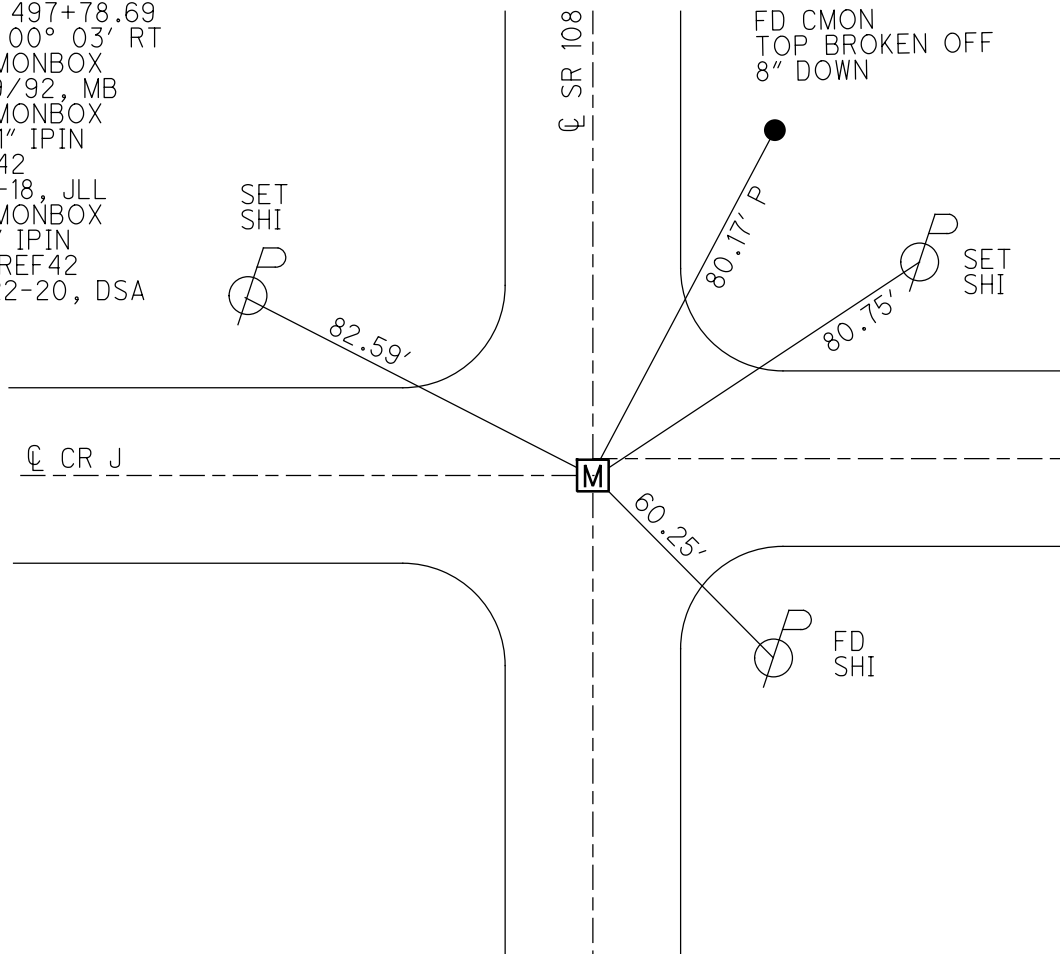

O.D.O.T. DISTRICT 2 SURVEY OFFICE (USE ONLY)

PERSONNEL

REFERENCE NO. 43

SHEET 29 OF 48

NOTES VAN DUSEN

DATE 8/17/92

ROUTE SR 108

H.C. KUSZ

WEATHER CLOUDY

COUNTY HENRY

R.C. BARNHISEL

TEMP. 75°

TOWNSHIP FLATROCK

DWG BY MILLER

PID 94319

SECTION 13

T 4 N R 6 E

TYPE MONUMENT P.K./WASHER

ON SURFACE - ~~BELOW~~ ON

OFFSET Q PAVEMENT ON LT : RT

12.4' TO RT EDGE PAVEMENT


STATION: 511+82

HORIZ.DATUM: _____


GEOID: _____

GRID: NORTHING: _____

EASTING: _____

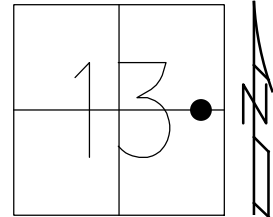

RECORD: P.O.T
STA 512+00
FD P.K./WASHER
8/17/92, MB
SET P.K./WASHER
9-17-92, MD
DNF
11-6-18, JLL
DID NOT SET
10-22-20, DSA

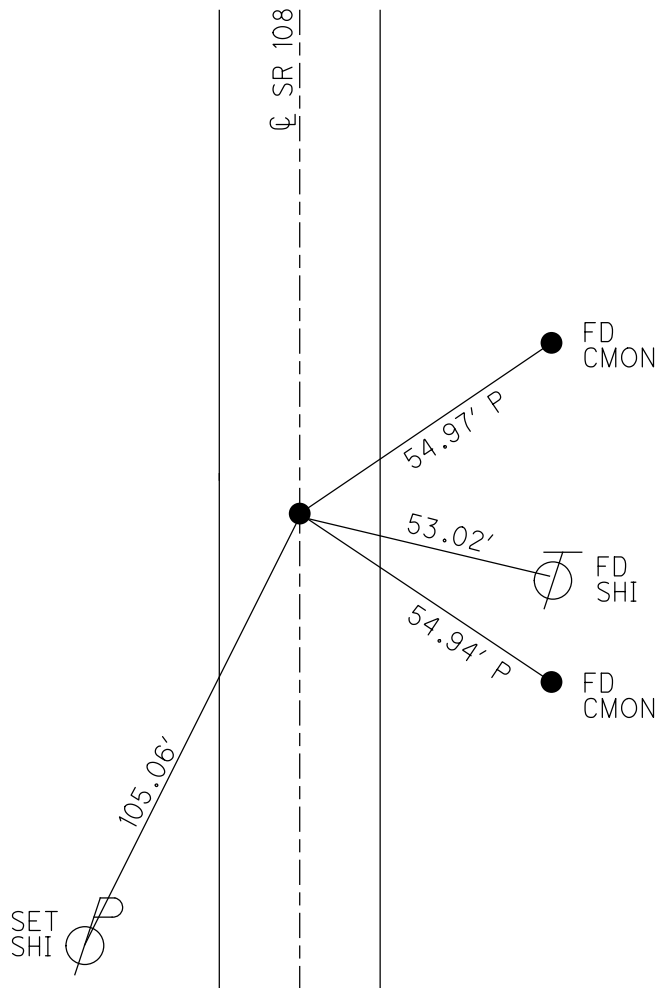

O.D.O.T. DISTRICT 2 SURVEY OFFICE (USE ONLY)

PERSONNEL

REFERENCE NO. 44

SHEET 30 OF 48

NOTES VAN DUSEN

DATE 8/17/92

ROUTE SR 108

H.C. KUSZ

WEATHER CLEAR

COUNTY HENRY

R.C. BARNHISEL

TEMP. 75°

TOWNSHIP FLATROCK

SECTION 13

DWG BY MILLER

PID 94319

T 4 N R 6 E

TYPE MONUMENT P.K./WASHER

ON SURFACE - ~~BELOW~~ ON

OFFSET Q PAVEMENT ON LT : RT

12.4' TO RT EDGE PAVEMENT


STATION: 517+83

HORZ.DATUM: _____


GEOID: _____

GRID: NORTHING: _____

EASTING: _____

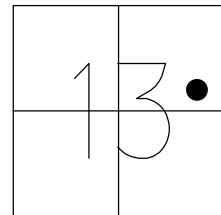

RECORD: P.O.T.
STA 518+00
FD P.K./WASHER
8/17/92, MB
SET P.K./WASHER
9-17-92, MB
DNF
11-6-18, JLL
DID NOT SET
10-22-20, DSA

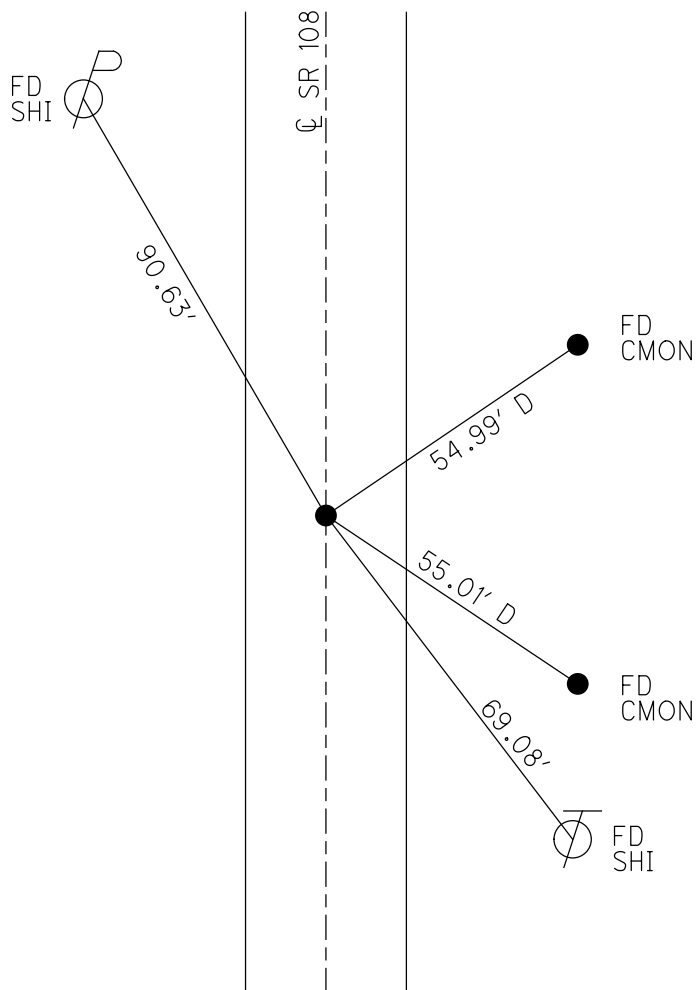

O.D.O.T. DISTRICT 2 SURVEY OFFICE (USE ONLY)

PERSONNEL

REFERENCE NO. 45

SHEET 31 OF 48

NOTES BALBAUGH

DATE 3/18/20

ROUTE SR 108

H.C. LEU

WEATHER CLOUDY

COUNTY HENRY

R.C. BALBAUGH

TEMP. 38°

TOWNSHIP FLATROCK

SECTION 13

DWG BY BALBAUGH PID 94319

T 4 N R 6 E

TYPE MONUMENT MONBOX W/ 1" IPIN

ON SURFACE - ~~BELOW~~ ON

OFFSET Q PAVEMENT 0.5' LT : ~~RT~~

12.8' TO RT EDGE PAVEMENT


STATION: 524+14.23

HORZ.DATUM: NAD83 (2011)


GEOID: 2012A

GRID: NORTHING: 600864.431

EASTING: 1524056.142

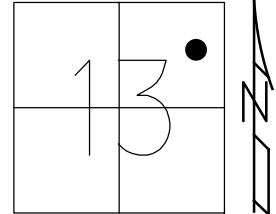

RECORD: P.I.
STA 524+39.05
 $\Delta = 00^\circ 28'$
FD MONBOX
8/17/92, MB
FD MONBOX
W/ 1" IPIN
REF45
11-6-18, JLL
FD MONBOX
W/1" IPIN
NEWREF45
10-22-20, DSA

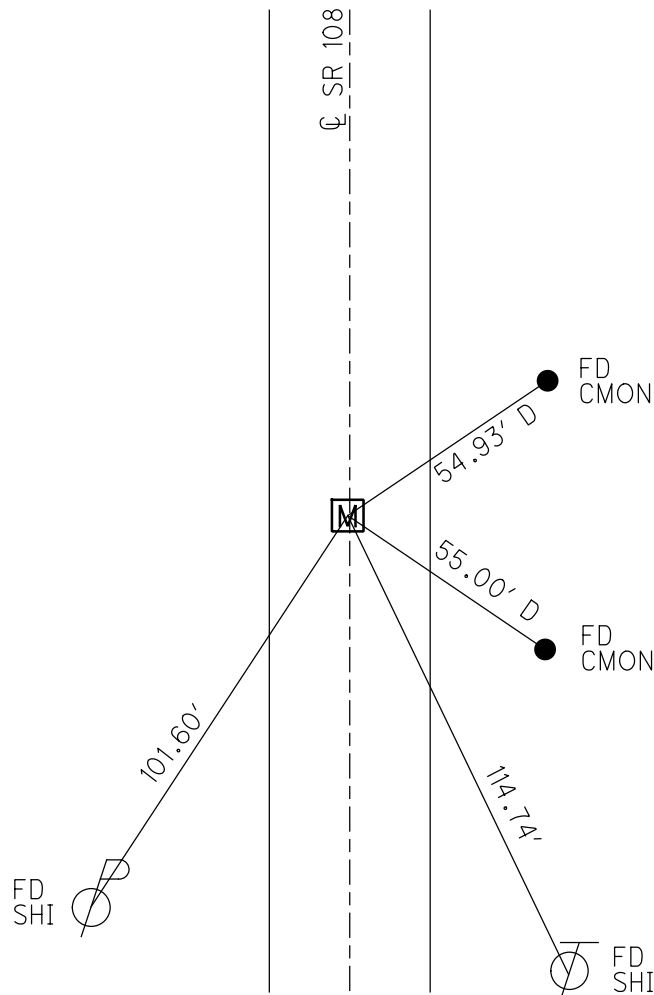

O.D.O.T. DISTRICT 2 SURVEY OFFICE (USE ONLY)

PERSONNEL

REFERENCE NO. 46

SHEET 32 OF 48

NOTES VAN DUSEN

DATE 8/17/92

ROUTE SR 108

H.C. KUSZ

WEATHER CLEAR

COUNTY HENRY

R.C. BARNHISEL

TEMP. 75°

TOWNSHIP FLATROCK

SECTION 13

DWG BY MILLER

PID 94319

T 4 N R 6 E

TYPE MONUMENT P.K./WASHER

ON SURFACE - ~~BELOW~~ ON

OFFSET CL PAVEMENT ON LT : RT

12.9' TO RT EDGE PAVEMENT


STATION: 542+21.56

HORZ.DATUM: NAD83 (2011)


GEOID: 2012A

GRID: NORTHING: 602671.535

EASTING: 1524027.975

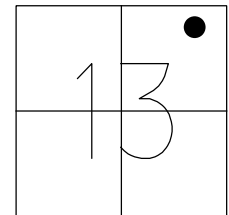

RECORD: P.I.
STA 542+39.05
 $\Delta = 00^\circ 31' \text{ RT}$
FD P.K./WASHER
8/17/92, MB
SET P.K./WASHER
9-17-92, MB
FD LG.R.R.SPIKE
2" BELOW
REF45
11-6-18, JLL
SET MAG NAIL
IN CONC. APPROACH
10-22-20, DSA

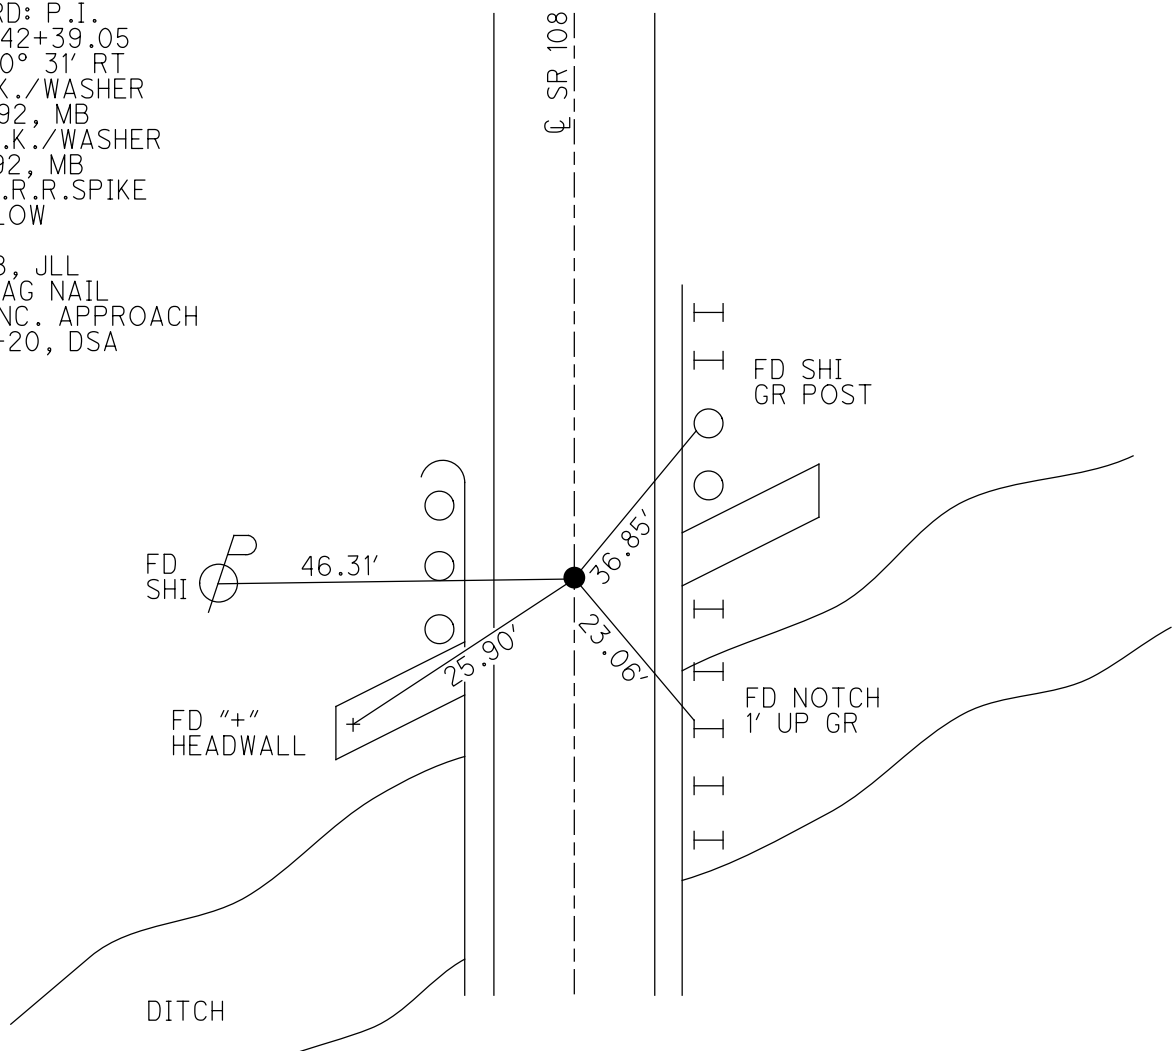

O.D.O.T. DISTRICT 2 SURVEY OFFICE (USE ONLY)

PERSONNEL

REFERENCE NO. 47

SHEET 33 OF 48

NOTES BALBAUGH

DATE 3/18/20

ROUTE SR 108

H.C. LEU

WEATHER CLOUDY

COUNTY HENRY

R.C. BALBAUGH

TEMP. 34°

TOWNSHIP FLATROCK

SECTION 13

DWG BY BALBAUGH

PID 94319

T 4 N R 6 E

TYPE MONUMENT MONBOX W/ 3/4" IPIN

ON SURFACE - ~~BELOW~~ ON

OFFSET Q PAVEMENT ON LT : RT

12' TO RT EDGE PAVEMENT


STATION: 550+48.75

HORIZ.DATUM: NAD83 (2011)


GEOID: 2012A

GRID: NORTHING: 603498.707

EASTING: 1524022.918

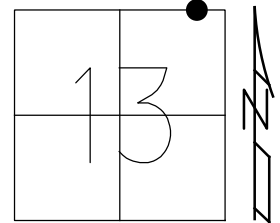

RECORD: P.I.
STA 550+66.77
 $\Delta = 00^\circ 13' \text{ LT}$
FD MONBOX
8/17/92, MB
FD MONBOX
W/ 1" IPIN
REF47
11-6-18, JLL
FD MONBOX
W/1" IPIN
NEWREF47
10-22-20, DSA

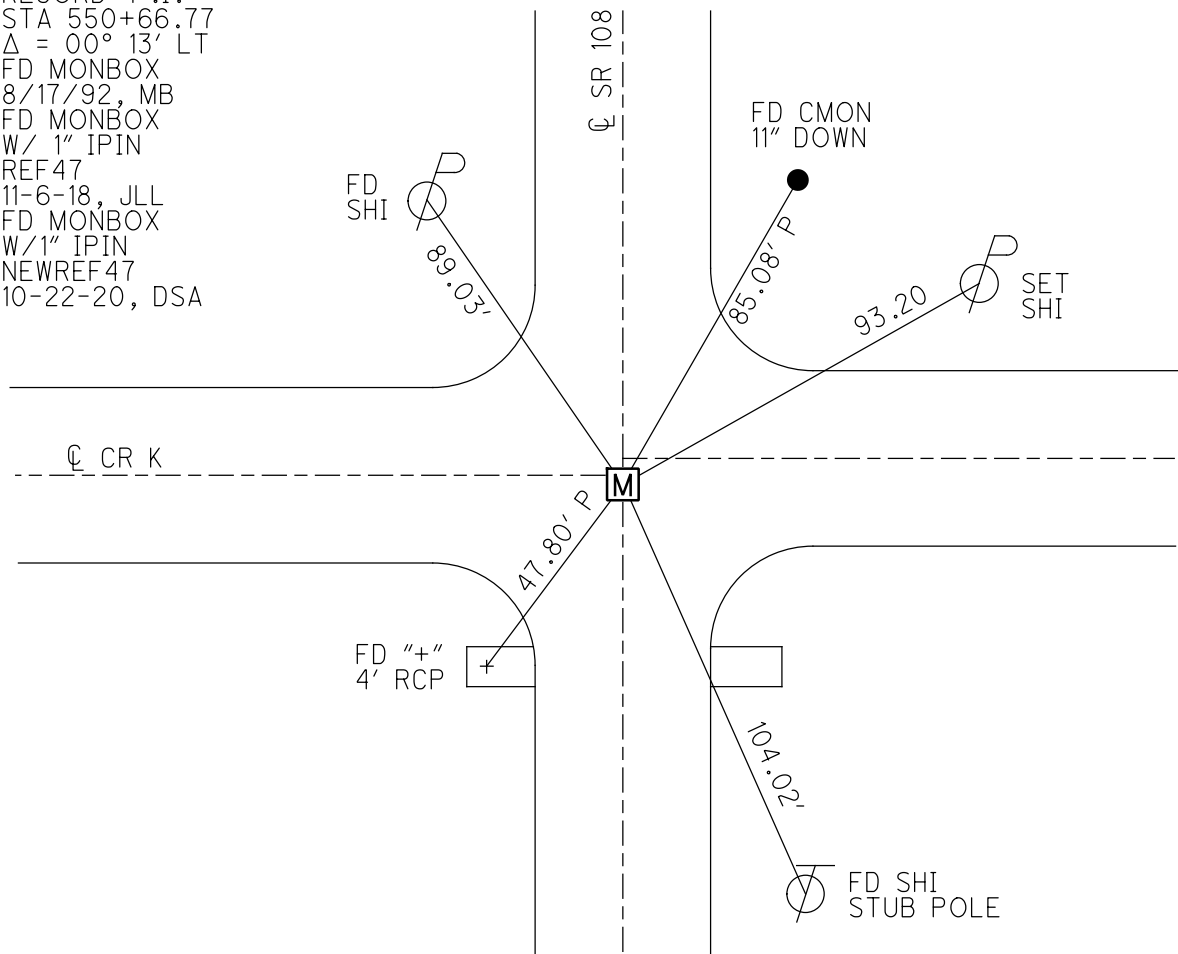

O.D.O.T. DISTRICT 2 SURVEY OFFICE (USE ONLY)

PERSONNEL

REFERENCE NO. 48

SHEET 34 OF 48

NOTES VAN DUSEN

DATE 8/14/92

ROUTE SR 108

H.C. McCORMICK

WEATHER CLEAR

COUNTY HENRY

R.C. KUSZ

TEMP. 75°

TOWNSHIP FLATROCK

BARNHISEL

SECTION 12

DWG BY MILLER

PID 94319

T 4 N R 6 E

TYPE MONUMENT P.K./WASHER

ON SURFACE - ~~BELOW~~ ON

OFFSET ℄ PAVEMENT 0.5' LT : ~~RT~~

12.3' TO LT EDGE PAVEMENT


STATION: 557+80

HORZ.DATUM: _____


GEOID: _____

GRID: NORTHING: _____

EASTING: _____

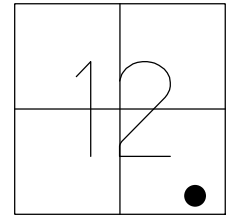

RECORD: P.O.T.
STA 558+00
FD P.K./WASHER
8/14/92, BVD
SET P.K./WASHER
9-17-92, MB
DNF
11-6-18, JLL
DID NOT SET
10-22-20, DSA

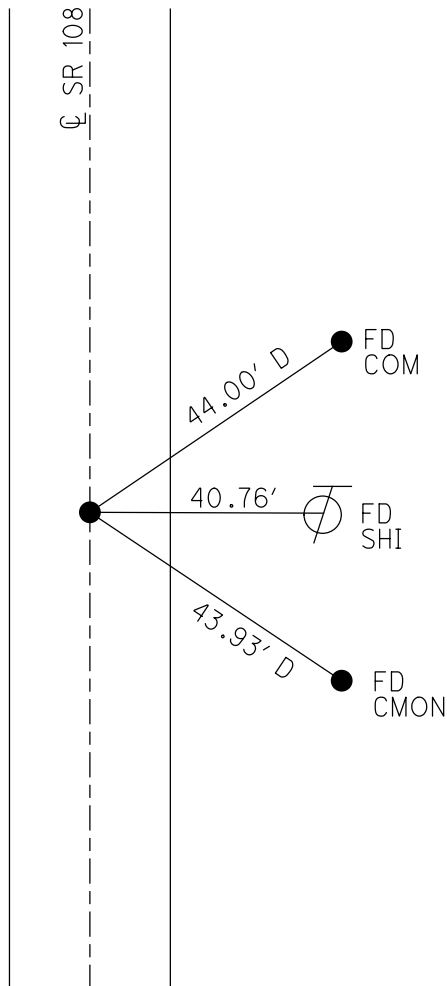

O.D.O.T. DISTRICT 2 SURVEY OFFICE (USE ONLY)

PERSONNEL

REFERENCE NO. 49

SHEET 35 OF 48

NOTES BALBAUGH

DATE 3/18/20

ROUTE SR 108

H.C. LEU

WEATHER CLOUDY

COUNTY HENRY

R.C. BALBAUGH

TEMP. 34°

TOWNSHIP FLATROCK

SECTION 12

DWG BY BALBAUGH PID 94319

T 4 N R 6 E

TYPE MONUMENT MONBOX W/ 1" IPIN

ON SURFACE - ~~BELOW~~ ON

OFFSET Q PAVEMENT ON LT : RT

12.4' TO RT EDGE PAVEMENT


STATION: 576+98.5

HORZ.DATUM: NAD83 (2011)


GEOID: 2012A

GRID: NORTHING: 606148.294

EASTING: 1523995.373

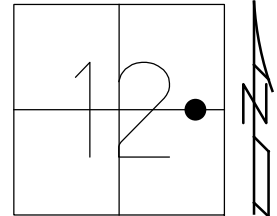

RECORD: P.I.
STA 577+17.35
 $\Delta = 00^\circ 09'$
FD MONBOX
8/14/92, BVD
FD MON BOX
W/ 1" IPIN
REF49
11-6-18, JLL
FD MONBOX
W/1" IPIN
NEWREF49
10-22-20, DSA

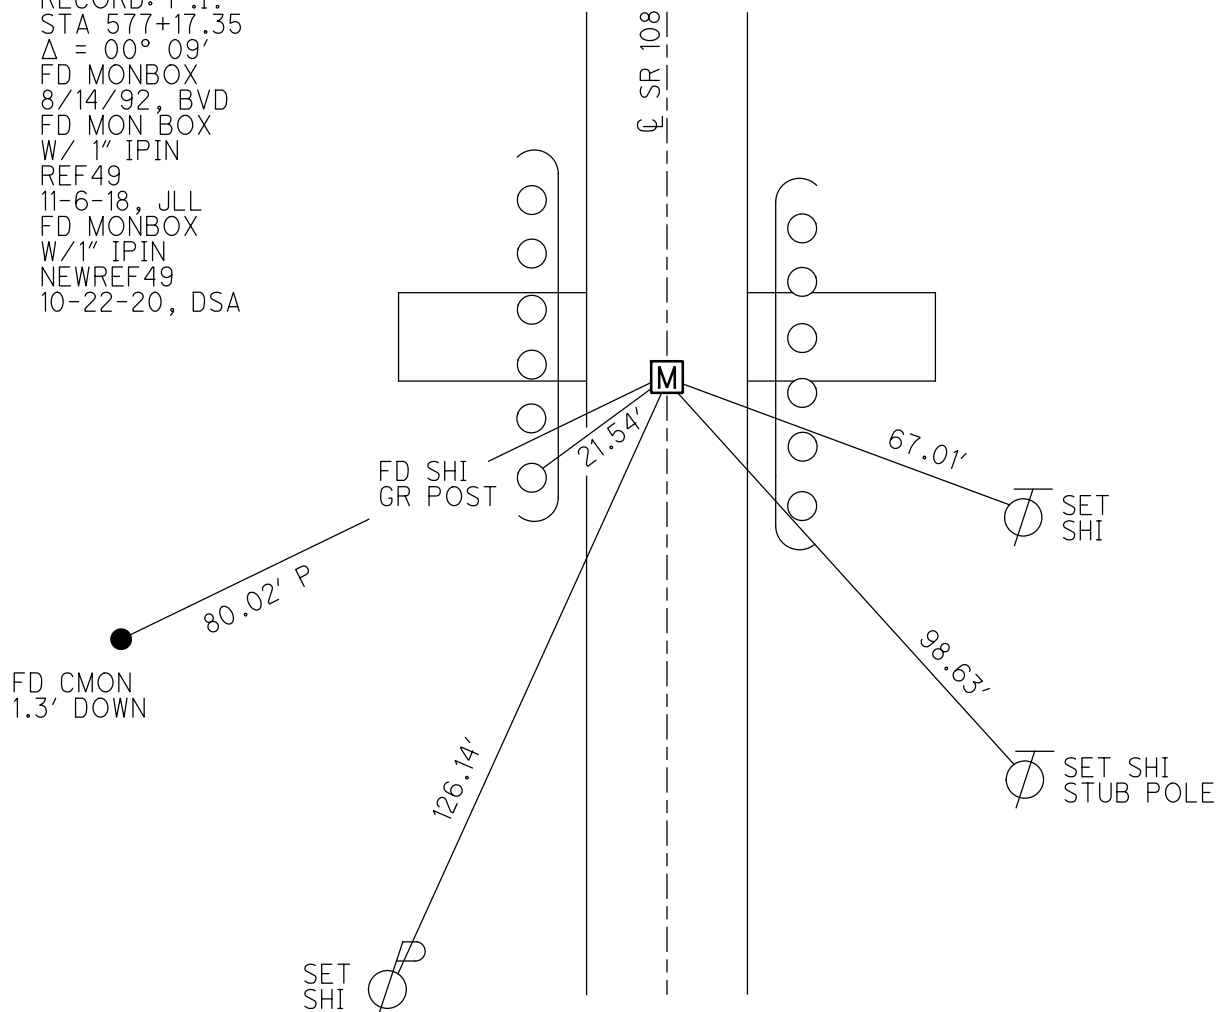

O.D.O.T. DISTRICT 2 SURVEY OFFICE (USE ONLY)

PERSONNEL

REFERENCE NO. 50

SHEET 36 OF 48

NOTES BALBAUGH

DATE 3/12/20

ROUTE SR 108

H.C. LEU

WEATHER OVERCAST

COUNTY HENRY

R.C. BALBAUGH

TEMP. 42°

TOWNSHIP FLATROCK

SECTION 12

DWG BY GARRETT

PID 94319

T 4 N R 6 E

TYPE MONUMENT LG.R.R.SPIKE

~~ON SURFACE~~ - BELOW 2"

OFFSET Q PAVEMENT ON LT : RT

- TO - EDGE PAVEMENT


STATION: 603+52.86

HORIZ.DATUM: NAD83 (2011)


GEOID: 2012A

GRID: NORTHING: 608802.587

EASTING: 1523974.299

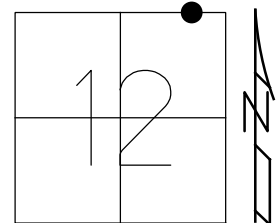

RECORD:
 $\Delta = 00^\circ 19' \text{ LT}$
FD LG.R.R.SPIKE
ATOP P.K./WASHER
10/25/01, MB
SET P.K./WASHER
11-13-01, MB
FD LG.R.R.SPIKE
2" DOWN
REF50
11-7-18, JLL
SET MAG/WASHER
10-22-20, DSA

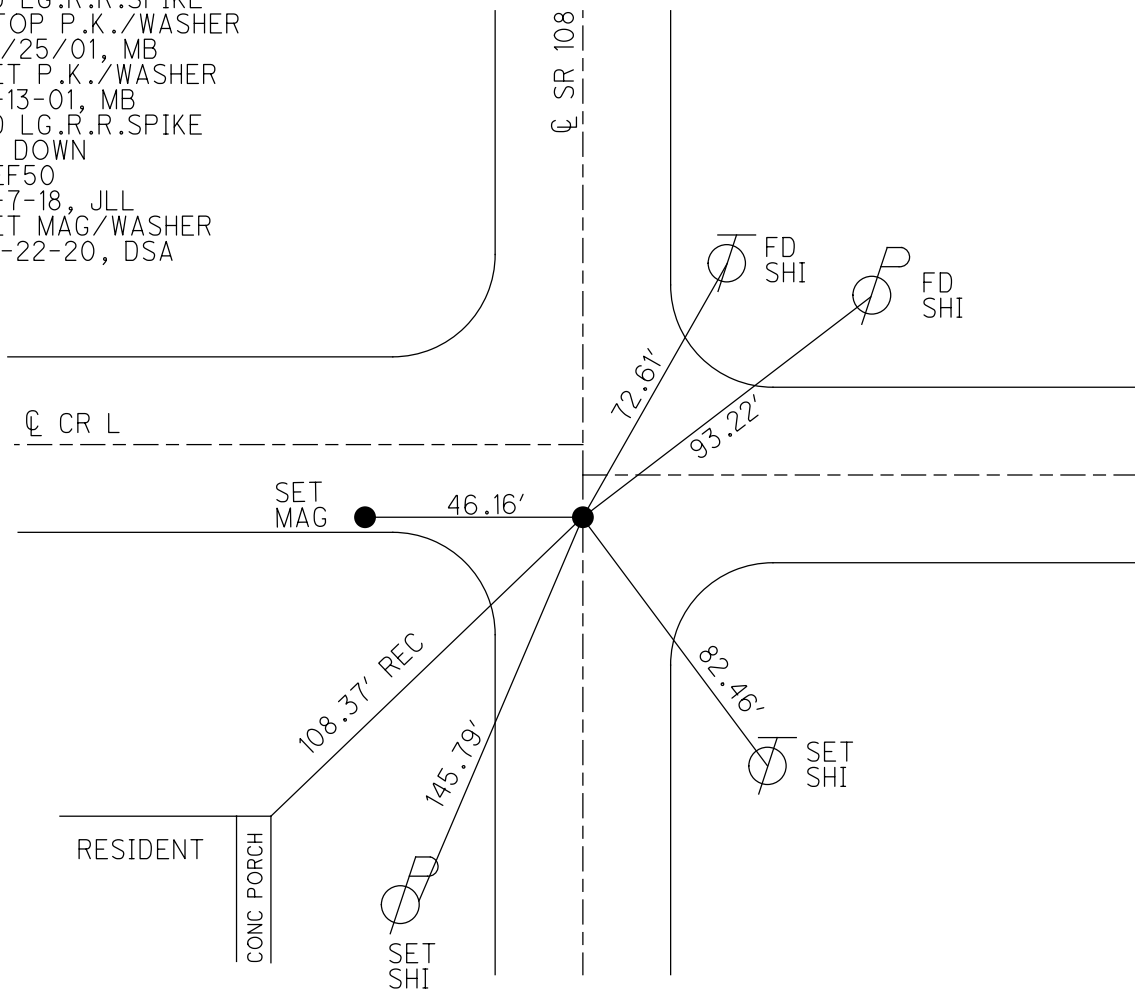

O.D.O.T. DISTRICT 2 SURVEY OFFICE (USE ONLY)

PERSONNEL

REFERENCE NO. 51

SHEET 37 OF 48

NOTES BALBAUGH

DATE 3/12/20

ROUTE SR 108

H.C. LEU

WEATHER OVERCAST

COUNTY HENRY

R.C. BALBAUGH

TEMP. 42°

TOWNSHIP FLATROCK

SECTION 1

DWG BY GARRETT

PID 94319

T 4 N R 6 E

TYPE MONUMENT SM.R.R.SPIKE

~~ON SURFACE~~ - BELOW 5"

OFFSET Q PAVEMENT ON LT : RT

12.4' TO RT EDGE PAVEMENT


STATION: 630+13.48

HORZ.DATUM: NAD83 (2011)

GEOID: 2012A

GRID: NORTHING: 611462.963

EASTING: 1523938.035

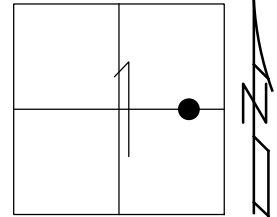

RECORD:

STA 630+34.14

$\Delta = 0^{\circ} 07' \text{ LT}$

FD SM.R.R.SPIKE

8/9/01, MB

SET PK/WASHER

11-13-01, MC

FD LG.R.R.SPIKE


5" DOWN

REF51

11-7-18, JLL

SET MAG/WASHER

10-22-20, DSA

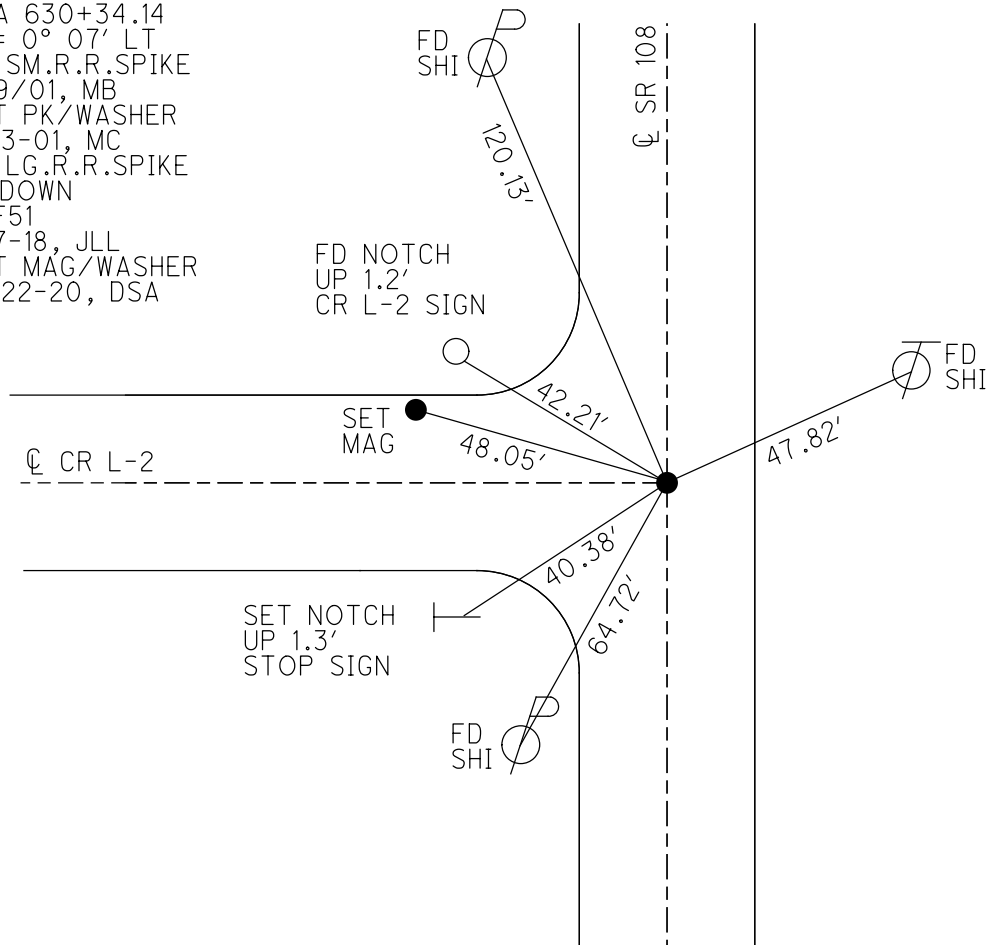

O.D.O.T. DISTRICT 2 SURVEY OFFICE (USE ONLY)

PERSONNEL

REFERENCE NO. 52

SHEET 38 OF 48

NOTES BALBAUGH

DATE 8/9/01

ROUTE SR 108

H.C. LEU

WEATHER OVERCAST

COUNTY HENRY

R.C. BALBAUGH

TEMP. 85°

TOWNSHIP FLATROCK

SECTION 1

DWG BY GARRETT

PID 94319

T 4 N R 6 E

TYPE MONUMENT SM.R.R.SPIKE SHANK

~~ON SURFACE~~ - BELOW 3"

OFFSET Q PAVEMENT ON LT : RT

- TO - EDGE PAVEMENT


STATION: 658+11.0

HORZ.DATUM: NAD83 (2011)


GEOID: 2012A

GRID: NORTHING: 614260.213

EASTING: 1523899.092

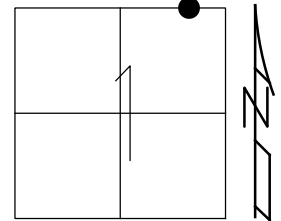

RECORD:
STA 658+32.25
 $\Delta = 00^{\circ} 10' \text{ LT}$
FD SM.R.R.SPIKE
8/9/01, MB
SET PK/WASHER
10-13-01, MRC
FD SM.R.R.SPIKE
3" DOWN
REF52
11-7-18, JLL
SET MAG/WASHER
10-22-20, DSA

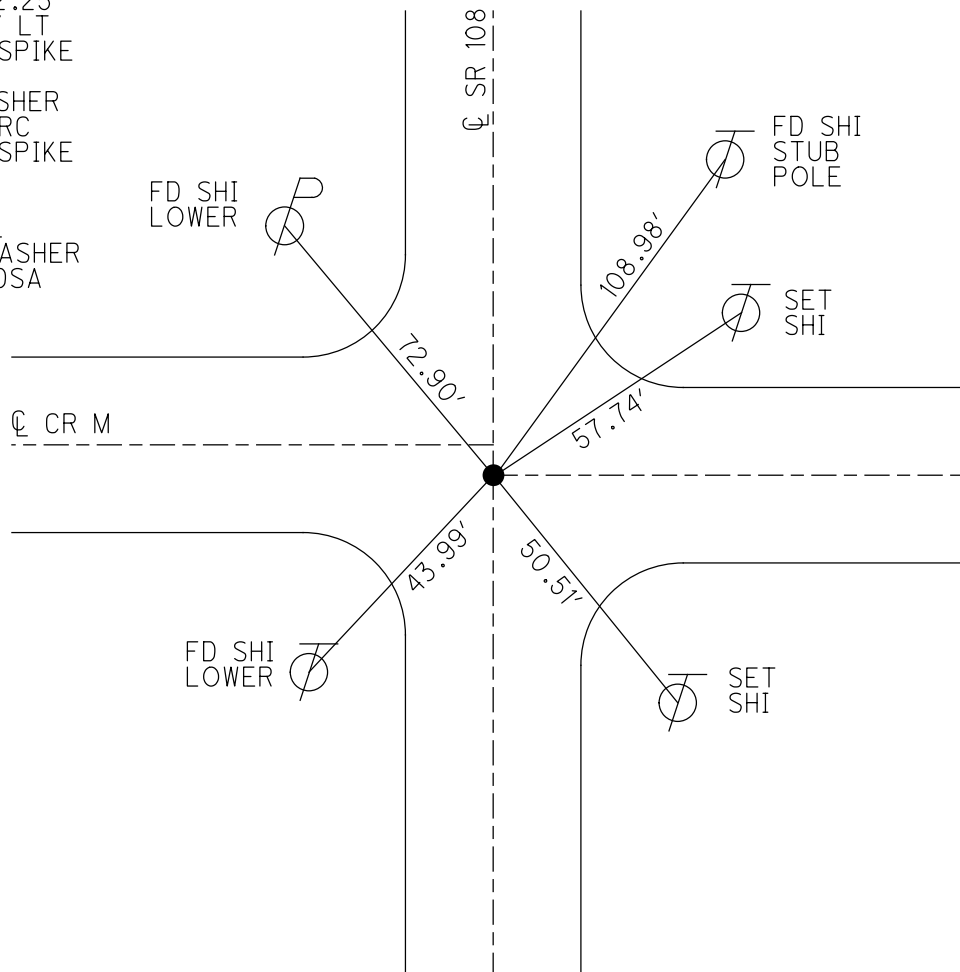

O.D.O.T. DISTRICT 2 SURVEY OFFICE (USE ONLY)

PERSONNEL

REFERENCE NO. 53

SHEET 39 OF 48

NOTES BALBAUGH

DATE 3/12/20

ROUTE SR 108

H.C. LEU

WEATHER OVERCAST

COUNTY HENRY

R.C. BALBAUGH

TEMP. 42°

TOWNSHIP NAPOLEON

SECTION 36

DWG BY GARRETT

PID 94319

T 5 N R 6 E

TYPE MONUMENT P.K./WASHER

ON SURFACE - ~~BELOW~~ ON

OFFSET CL PAVEMENT 1.0' LT : ~~RT~~

11.4' TO LT EDGE PAVEMENT


STATION: 684+67.07

HORZ.DATUM: NAD83 (2011)


GEOID: 2012A

GRID: NORTHING: 616915.897

EASTING: 1523854.116

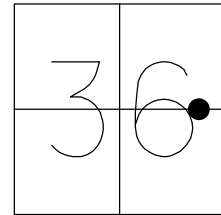

RECORD: P.I.
STA 684+89.07
 $\Delta = 00^\circ 26' RT$
FD SM.R.R.SPIKE
8/9/01, MB
SET P.K./WASHER
11-15-01, MRC
FD P.K./WASHER
REF53
11-7-18, JLL
SET MAG/WASHER
10-22-20, DSA

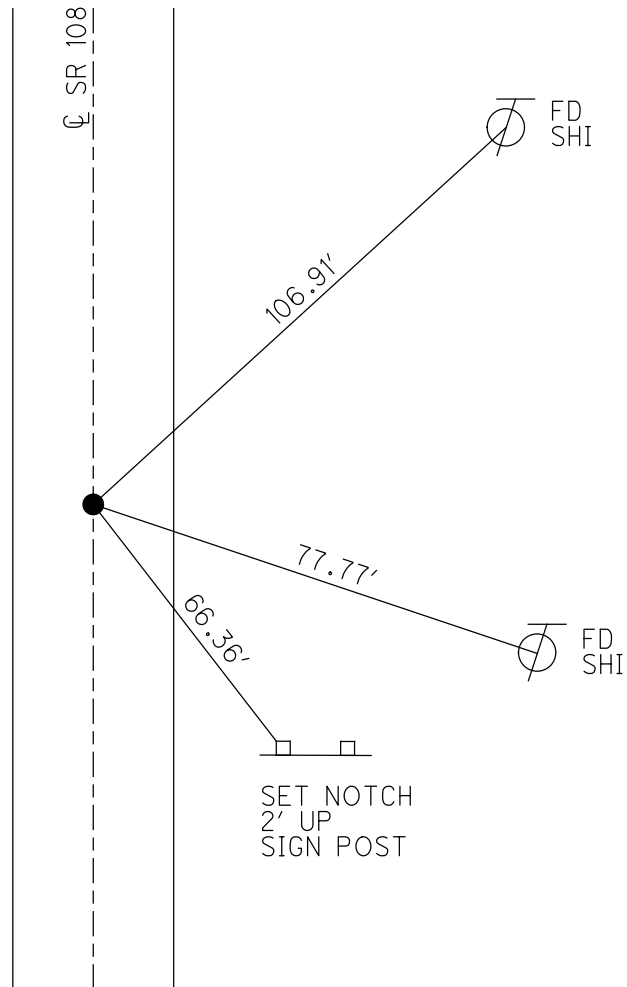

O.D.O.T. DISTRICT 2 SURVEY OFFICE (USE ONLY)

PERSONNEL

REFERENCE NO. 54

SHEET 40 OF 48

NOTES BALBAUGH

DATE 3/12/20

ROUTE SR 108

H.C. LEU

WEATHER OVERCAST

COUNTY HENRY

R.C. BALBAUGH

TEMP. 42°

TOWNSHIP NAPOLEON

DWG BY MILLER

PID 94319

SECTION 36

T 5 N R 6 E

TYPE MONUMENT P.K./WASHER

ON SURFACE - ~~BELOW~~ ON

OFFSET Q PAVEMENT ON LT : RT

- TO - EDGE PAVEMENT


STATION: 711+16.63

HORZ.DATUM: NAD83 (2011)

GEOID: 2012A

GRID: NORTHING: 619565.345

EASTING: 1523829.367

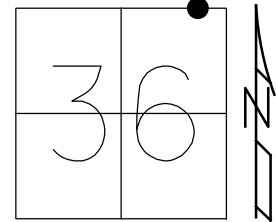

RECORD:

STA 711+39.37

$\Delta = 00^{\circ} 00' 80''$ LT

FD SM.R.R.SPIKE

8/9/01, MB

SET P.K./WASHER

11-13-01, MRC


FD P.K./WASHER

REF54

11-7-18, JLL

SET MAG/WASHER

10-22-20, DSA

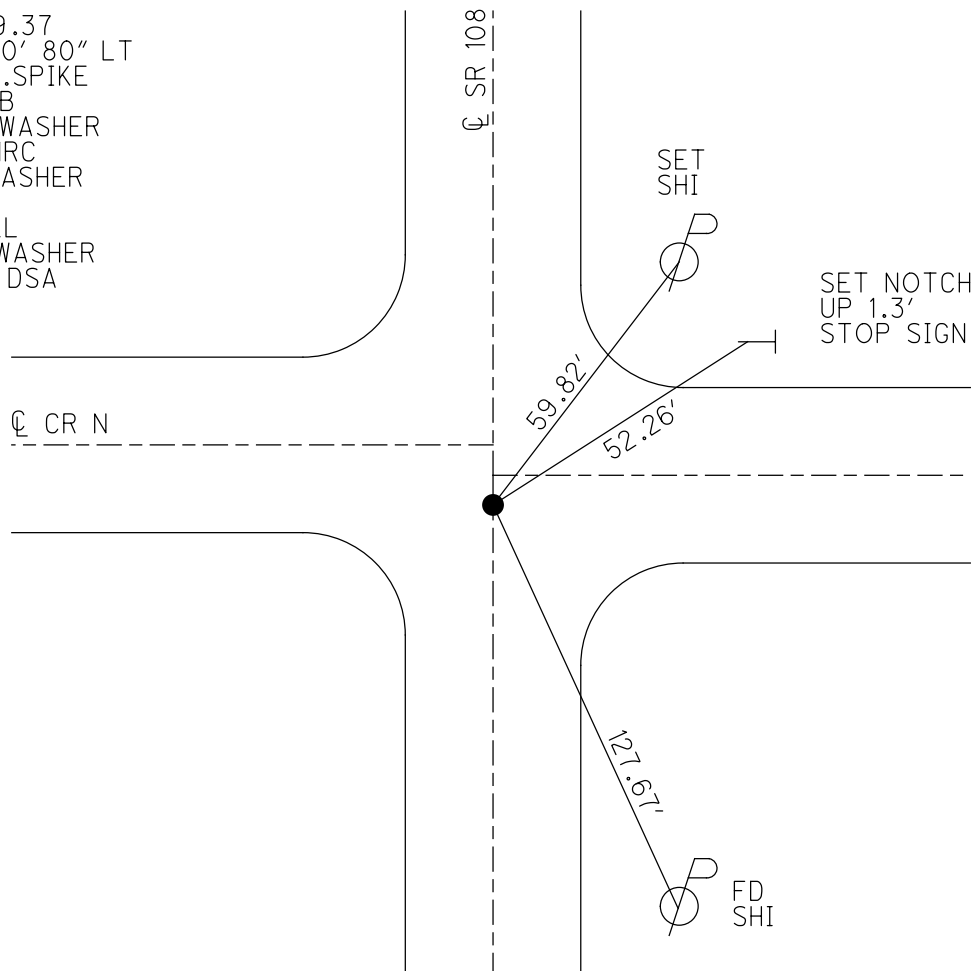

O.D.O.T. DISTRICT 2 SURVEY OFFICE (USE ONLY)

PERSONNEL

REFERENCE NO. 55

SHEET 41 OF 48

NOTES BALBAUGH

DATE 3/12/20

ROUTE SR 108

H.C. LEU

WEATHER OVERCAST

COUNTY HENRY

R.C. BALBAUGH

TEMP. 42°

TOWNSHIP NAPOLEON

DWG BY GARRETT

PID 94319

SECTION 25

T 5 N R 6 E

TYPE MONUMENT SM.R.R.SPIKE

~~ON SURFACE~~ - BELOW 3.5"

OFFSET Q PAVEMENT 0.5' LT : ~~RT~~

12.4' TO LT EDGE PAVEMENT


STATION: 737+63.61

HORZ.DATUM: NAD83 (2011)

GEOID: 2012A

GRID: NORTHING: 622212.193

EASTING: 1523804.330

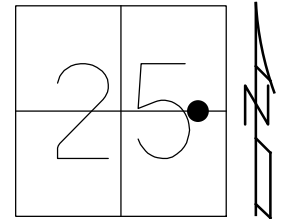

RECORD:

STA 737+87.09

$\Delta = 00^{\circ} 09' RT$

FD SM.R.R.SPIKE

8/9/01, MB

SET P.K./WASHER

11-13-01, MRC

FD P.K.NAIL

11-7-18, JLL

SET MAG/WASHER

10-23-20, DSA

SE COR
RED ROOF
ATOP
12" STUMP



54.12'



43.98'

30.64' P

SET "+"
M.H. RIM



61.65'



FD
SHI

43.88' P

FD "+"
RCP



121.19'



FD
SHI

O.D.O.T. DISTRICT 2 SURVEY OFFICE (USE ONLY)

PERSONNEL

REFERENCE NO. 56

SHEET 42 OF 48

NOTES BALBAUGH

DATE 3/19/20

ROUTE SR 108

H.C. LEU

WEATHER OVERCAST

COUNTY HENRY

R.C. BALBAUGH

TEMP. 46°

TOWNSHIP NAPOLEON

SECTION 25

DWG BY GARRETT

PID 94319

T 5 N R 6 E

TYPE MONUMENT SM.R.R.SPIKE

~~ON SURFACE~~ - BELOW 3"

OFFSET Q PAVEMENT ON LT : RT

12.5' TO LT EDGE PAVEMENT


STATION: 764+20.87

HORZ.DATUM: NAD83 (2011)

GEOID: 2012A


GRID: NORTHING: 624869.407

EASTING: 1523785.920

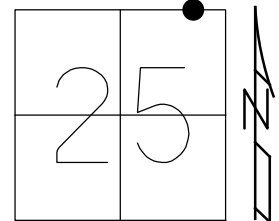

RECORD:
STA 764+44.30'
 $\Delta=00^{\circ}-03'$ RT
RESET PK/WASHER
11-13-01, MRC
FD LG R.R. SPIKE
3" BELOW
REF56
 $\Delta=00^{\circ}03'35''$ RT
11-7-18, JLL
SET MAG/WASHER
10-23-20, DSA

FD NOTCH
IRON LEG
SECOND SIGN

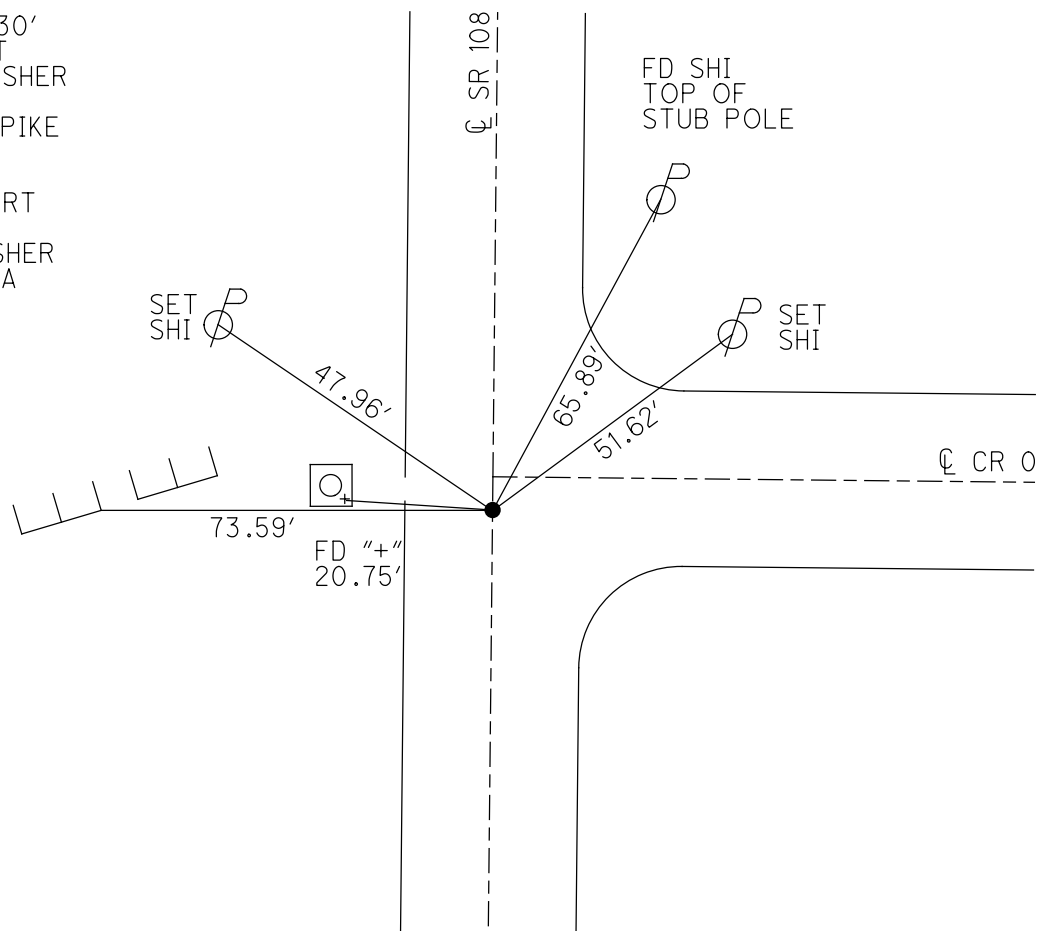

O.D.O.T. DISTRICT 2 SURVEY OFFICE (USE ONLY)

PERSONNEL

REFERENCE NO. 57

SHEET 43 OF 48

NOTES BALBAUGH

DATE 3/19/30

ROUTE SR 108

H.C. LEU

WEATHER OVERCAST

COUNTY HENRY

R.C. BALBAUGH

TEMP. 46°

TOWNSHIP NAPOLEON

SECTION 24

DWG BY GARRETT

PID 94319

T 5 N R 6 E

TYPE MONUMENT SM.R.R.SPIKE SHANK

~~ON SURFACE~~ - BELOW 3"

OFFSET Q PAVEMENT 0.4' LT : ~~RT~~

13.2' TO RT EDGE PAVEMENT



STATION: 790+70.35

HORZ.DATUM: NAD83 (2011)

GEOID: 2012A

GRID: NORTHING: 627518.836

EASTING: 1523770.359

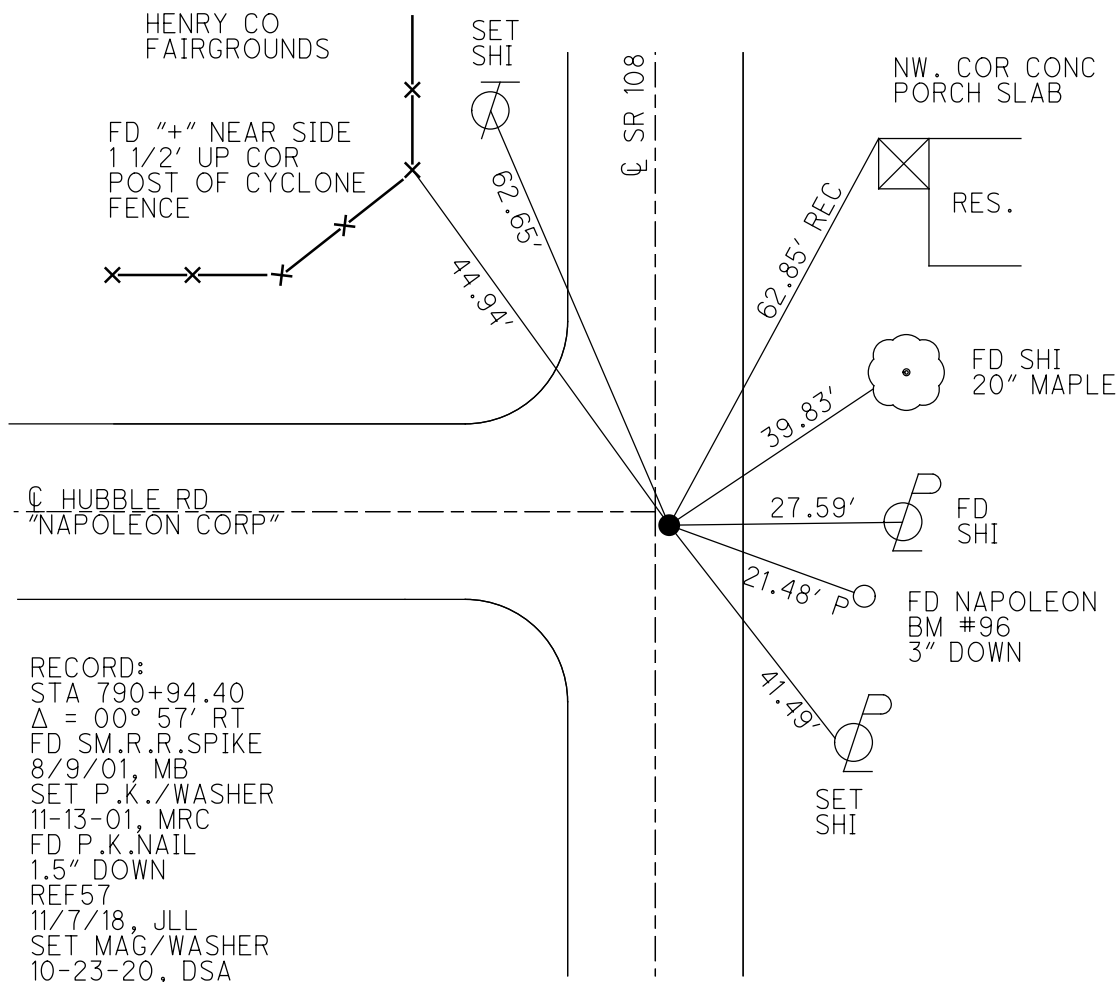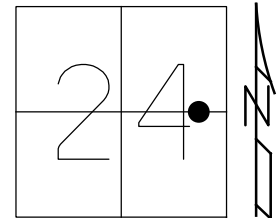

O.D.O.T. DISTRICT 2 SURVEY OFFICE (USE ONLY)

PERSONNEL

REFERENCE NO. 58

SHEET 44 OF 48

NOTES BALBAUGH

DATE 4/6/20

ROUTE SR 108

H.C. LEU

WEATHER SUNNY

COUNTY HENRY

R.C. O'DONNELL

TEMP. 57°

TOWNSHIP NAPOLEON

SECTION 24

DWG BY MILLER

PID 94319

T 5 N R 6 E

TYPE MONUMENT SM.R.R.SPIKE

ON SURFACE - ~~BELOW~~ ON

OFFSET CL PAVEMENT 5.0' LT : RT

- TO - EDGE PAVEMENT


STATION: 817+15.72

HORZ.DATUM: NAD83 (2011)


GEOID: 2012A

GRID: NORTHING: 630164.054

EASTING: 1523798.955

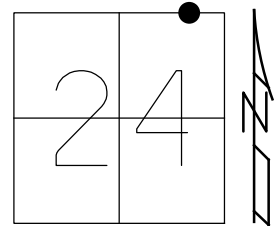

RECORD:
FD STAPLE
IN CONC. PVMT
1958, BEACH
SET SM.R.R.SPIKE
1960
1974, TOMSICK
1977, BURNSIDE
FD P.K.NAIL
SET SM.R.R.SPIKE
1988, HOFFMAN
FD SM.R.R.SPIKE
2001, MB
REF58
4/6/20, JLL
SET MAG/WASHER
10-23-20, DSA

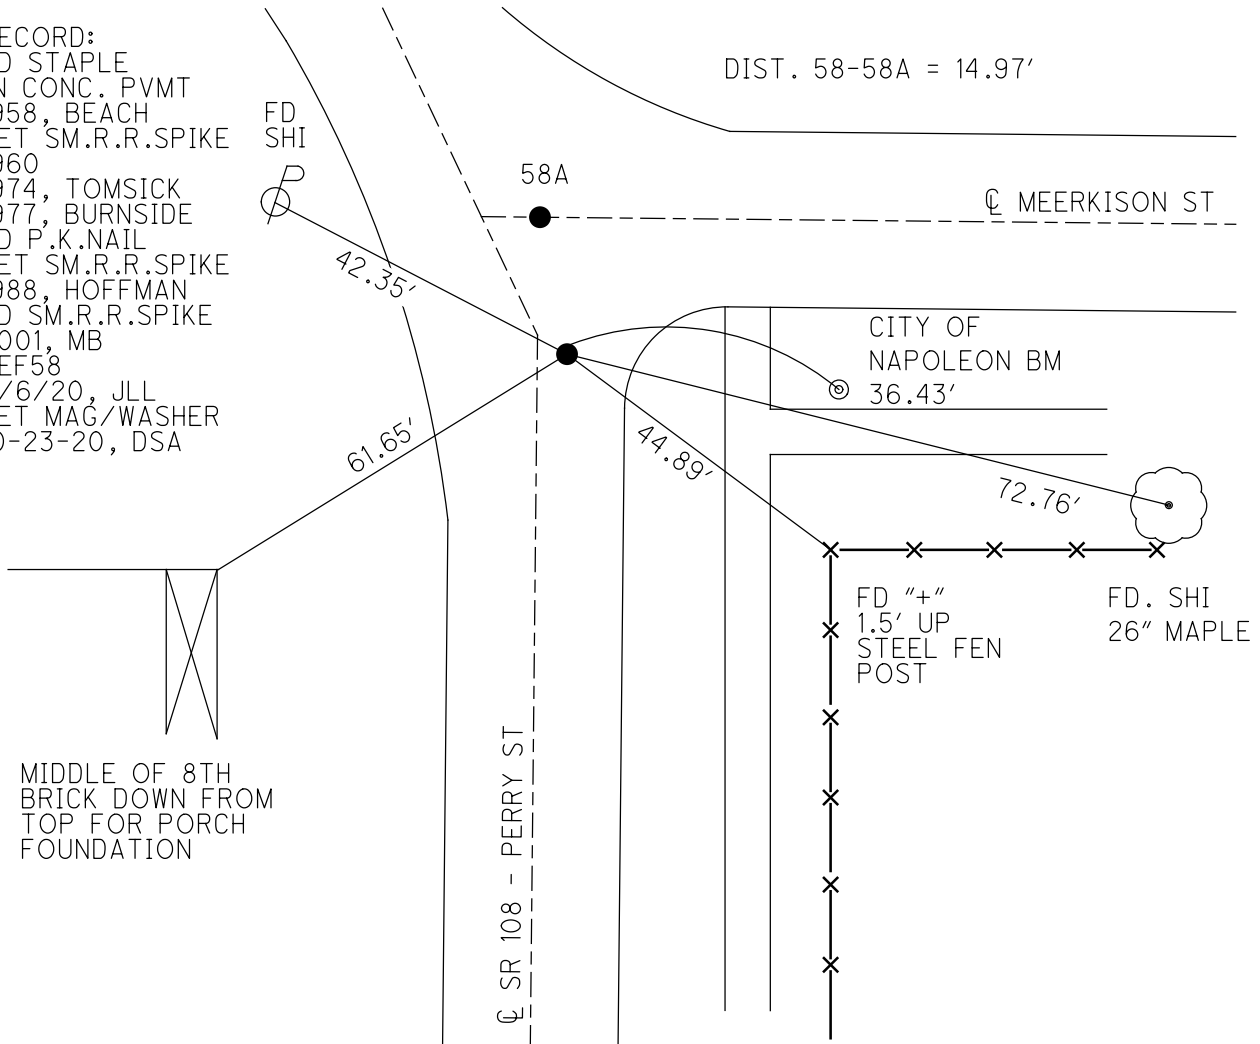

O.D.O.T. DISTRICT 2 SURVEY OFFICE (USE ONLY)

PERSONNEL

REFERENCE NO. 58 A

SHEET 45 OF 48

NOTES BALBAUGH

DATE 4/6/20

ROUTE SR 108

H.C. LEU

WEATHER SUNNY

COUNTY HENRY

R.C. O'DONNELL

TEMP. 57°

TOWNSHIP NAPOLEON

SECTION 24

DWG BY LEU PID 94319

T 5 N R 6 E

TYPE MONUMENT MAG NAIL

ON SURFACE - ~~BELOW~~ ON

OFFSET CL PAVEMENT - ~~LT~~ : RT

 - TO - EDGE PAVEMENT


STATION: 817+30.69

HORZ.DATUM: NAD83 (2011)

GEOID: 2012A


GRID: NORTHING: 630177.925

EASTING: 1523793.417

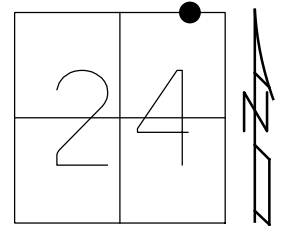

RECORD:
FD MAG NAIL
4/6/20, JLL
SET MAG/WASHER
NEWREFA58
10-23-20, DSA

MIDDLE OF 8TH
BRICK DOWN FROM
TOP FOR PORCH
FOUNDATION

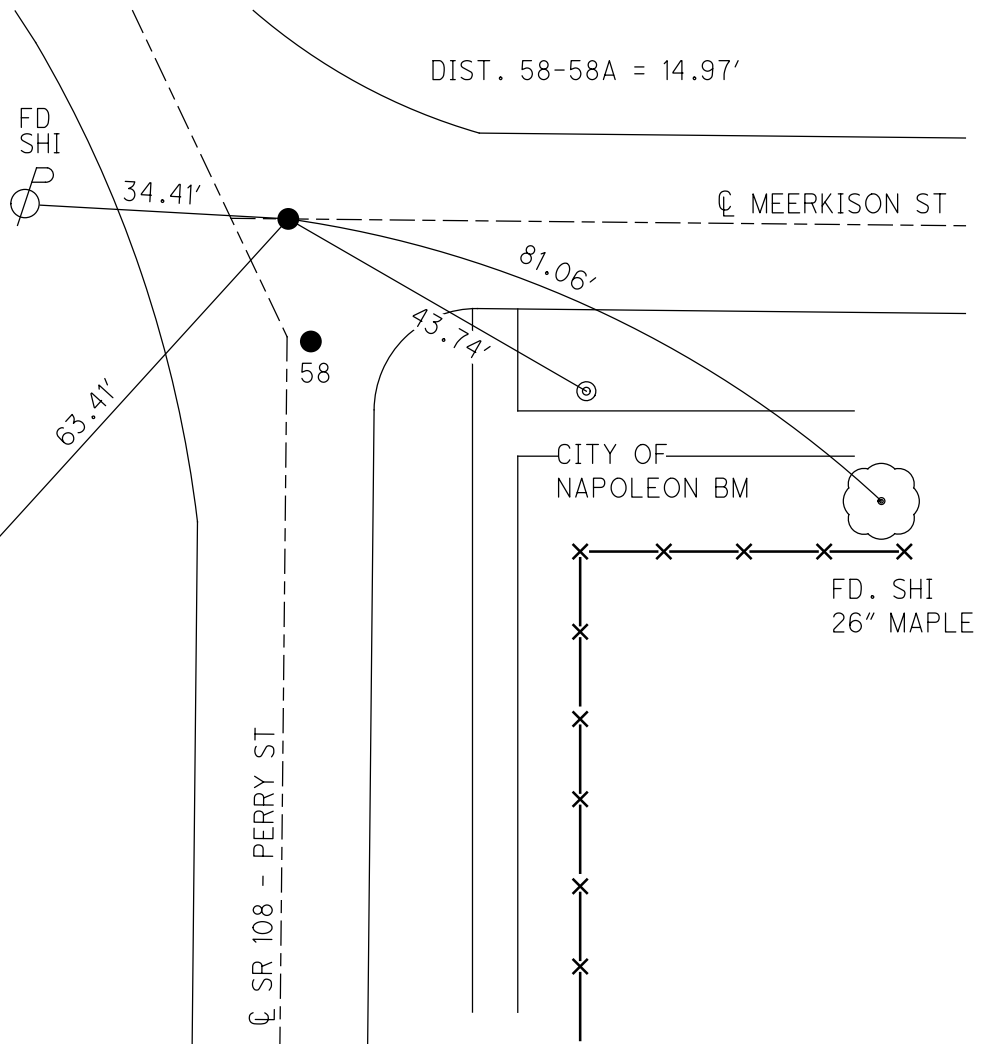

O.D.O.T. DISTRICT 2 SURVEY OFFICE (USE ONLY)

PERSONNEL

REFERENCE NO. 59

SHEET 46 OF 48

NOTES CURTIS

DATE 4/18/94

ROUTE SR 108

H.C. CANTERBURY

WEATHER CLOUDY

COUNTY HENRY

R.C. CORDES

TEMP. 60°

TOWNSHIP NAPOLEON

HERMILLER

SECTION 13

DWG BY MILLER PID 94319

T 5 N R 6 E

TYPE MONUMENT SM.R.R.SPIKE

ON SURFACE - ~~BELOW~~ ON

OFFSET Q PAVEMENT ON LT : RT

- TO - EDGE PAVEMENT


STATION: 821+02

HORZ.DATUM: NAD83 (2011)


GEOID: 2012A

GRID: NORTHING: 630535.809

EASTING: 1523618.861

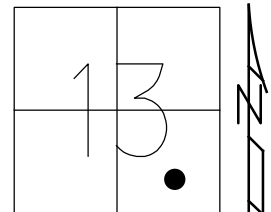

RECORD:
FD SM.R.R.SPIKE
4-18-94
FD P.K.NAIL
8-2-94
FD MONBOX
W/ 1" IPIN
REF59
11-7-18, JLL
FD MONBOX
W/1" IPIN
NEWREF59
10-23-20, DSA

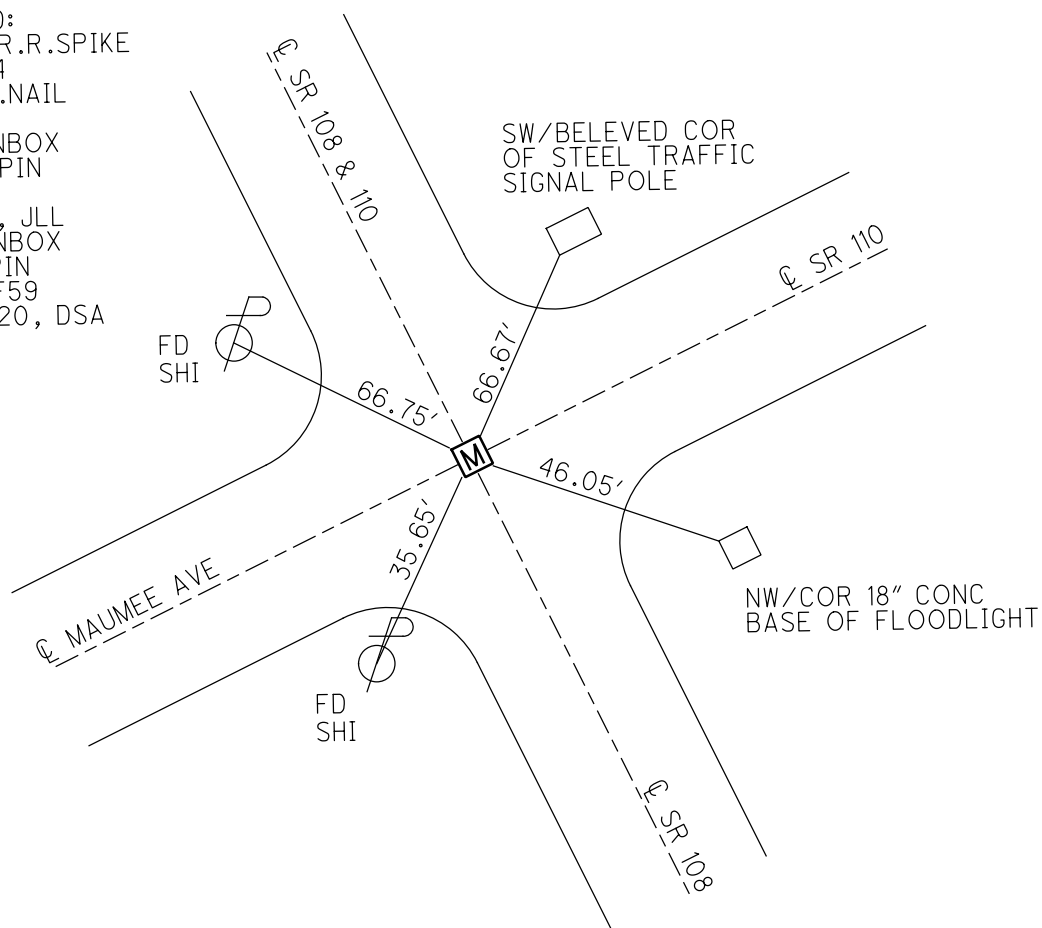

O.D.O.T. DISTRICT 2 SURVEY OFFICE (USE ONLY)

PERSONNEL

REFERENCE NO. 59 A

SHEET 47 OF 48

NOTES LEU

DATE 11/7/18

ROUTE SR 108

H.C.

WEATHER

COUNTY HENRY

R.C.

TEMP.

TOWNSHIP NAPOLEON

SECTION 13

DWG BY MILLER

PID 94319

T 5 N R 6 E

TYPE MONUMENT MONBOX W/1" IPIN

ON SURFACE - ~~BELOW~~ ON

OFFSET CL PAVEMENT ON LT : RT

- TO - EDGE PAVEMENT


STATION: 833+17

HORZ.DATUM: NAD83 (2011)


GEOID: 2012A

GRID: NORTHING: 631624.184

EASTING: 1523090.659

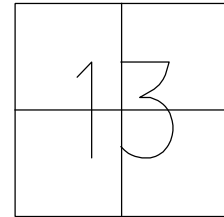

RECORD:
ORIGIN UNKNOWN
FD NAIL
2" DOWN
3-25-88
LG NAIL
3" DOWN
4-18-94, CL
FD MONBOX
W/ 1" IPIN
REFA59
11-7-18, JLL

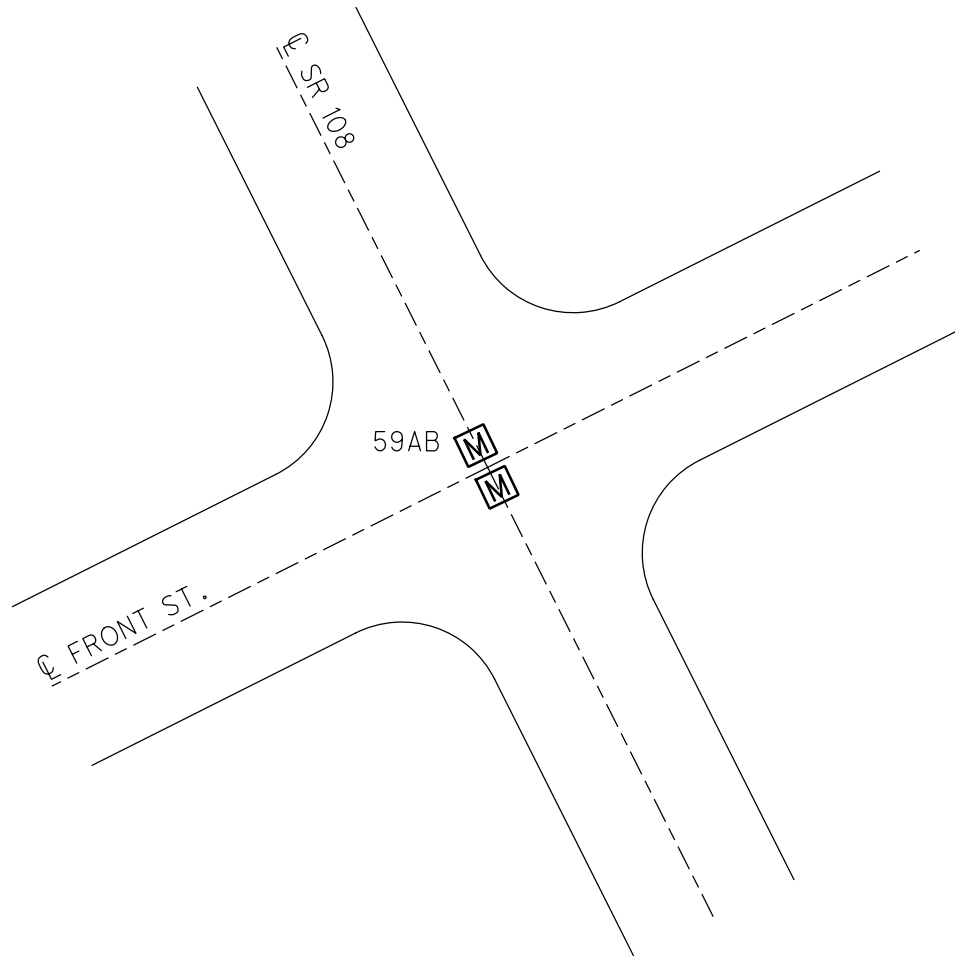

O.D.O.T. DISTRICT 2 SURVEY OFFICE (USE ONLY)

PERSONNEL

REFERENCE NO. 59 AB

SHEET 48 OF 48

NOTES LEU

DATE 11/7/18

ROUTE SR 108

H.C.

WEATHER

COUNTY HENRY

R.C.

TEMP.

TOWNSHIP NAPOLEON

SECTION 13

DWG BY MILLER

PID 94319

T 5 N R 6 E

TYPE MONUMENT MONBOX W/1" IPIN

ON SURFACE - ~~BELOW~~ ON

OFFSET Q PAVEMENT LT : RT

 TO EDGE PAVEMENT


STATION: 833+17

HORZ.DATUM: NAD83 (2011)


GEOID: 2012A

GRID: NORTHING: 631628.690

EASTING: 1523088.522

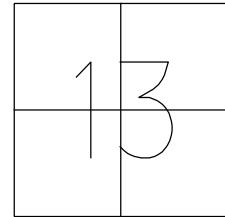

RECORD:
FD MON BOX
W/ 1" IPIN
REFB59
11-7-18, JLL

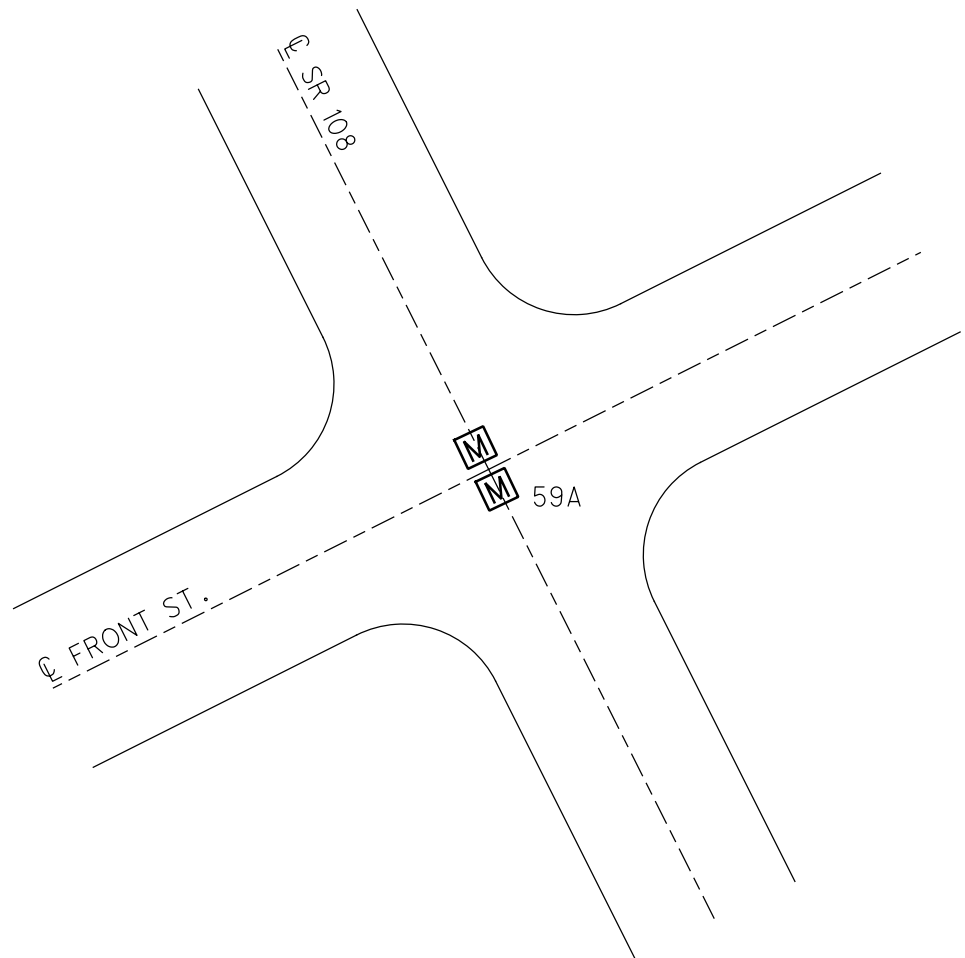

O.D.O.T. DISTRICT 2 SURVEY OFFICE (USE ONLY)

PERSONNEL

REFERENCE NO. 59 B

SHEET 1 OF 14

NOTES CURTIS

DATE 4/18/94

ROUTE SR 108

H.C. LOEHRKE

WEATHER CLOUDY

COUNTY HENRY

R.C. _____

TEMP. 60°

TOWNSHIP NAPOLEON

DWG BY NIESE PID _____

SECTION 13

T 5 N R 6 E

TYPE MONUMENT LG R.R. SPIKE

~~ON SURFACE~~ - BELOW 7 1/2"

OFFSET Q PAVEMENT ON LT : RT

- TO - EDGE PAVEMENT


STATION: 836+50

HORIZ.DATUM: _____

GEOID: _____


GRID: NORTHING: _____

EASTING: _____

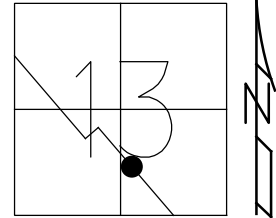

RECORD:
FD LG R.R.SPIKE
7 1/2" DOWN
4/18/94, CL
D.N.F.
8/2/94, CL

SE BEVELED COR
CONC BASE TRAFFIC
SIGNAL CONTROL BOX

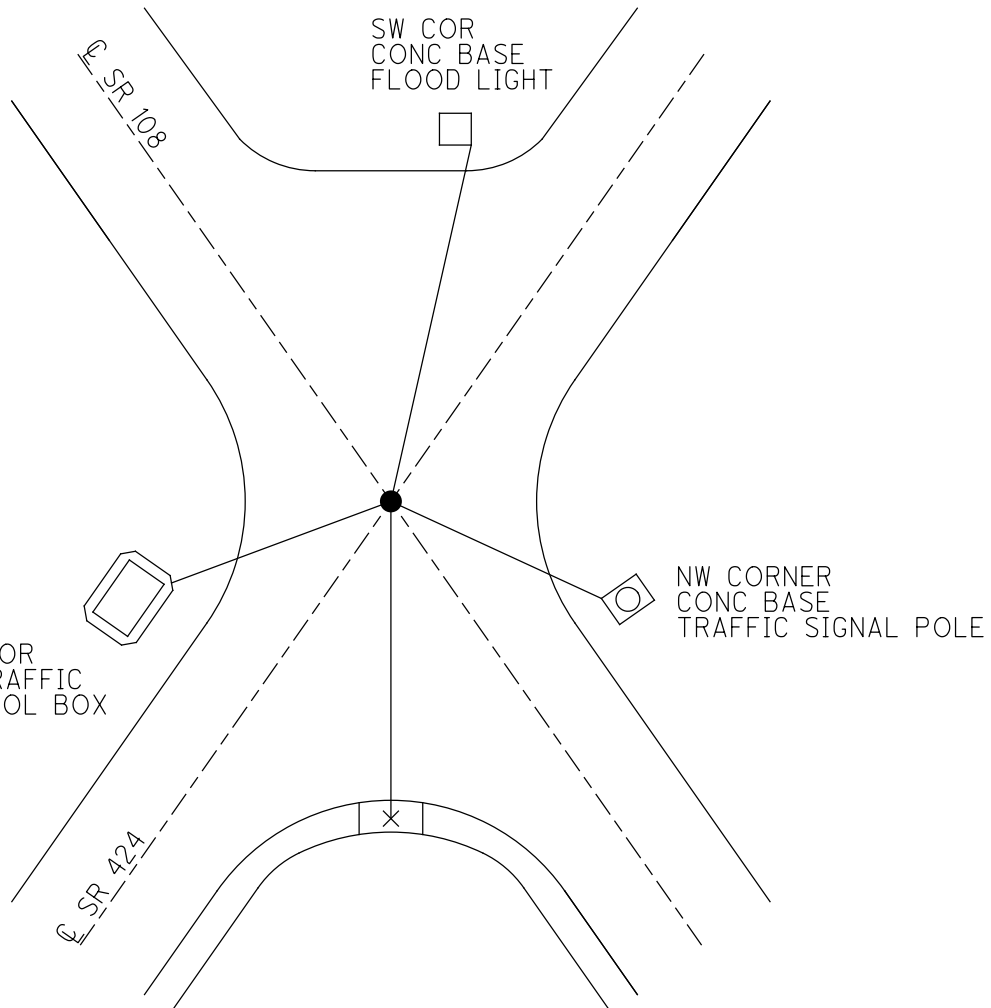

O.D.O.T. DISTRICT 2 SURVEY OFFICE (USE ONLY)

PERSONNEL

REFERENCE NO. 59 C

SHEET 2 OF 14

NOTES CURTIS

DATE 4/18/94

ROUTE SR 108

H.C. CANTERBURY

WEATHER CLOUDY

COUNTY HENRY

R.C. CORDES

TEMP. 60°

TOWNSHIP NAPOLEON

HERMILLER, VOGEL

SECTION 13

DWG BY NIESE PID

T 5 N R 6 E

TYPE MONUMENT LG R.R. SPIKE

ON SURFACE - ~~BELOW~~ ON


OFFSET CL PAVEMENT ON LT : RT

- TO - EDGE PAVEMENT

STATION: 838+08

HORIZ.DATUM: GEOID:

GRID: NORTHING: EASTING:

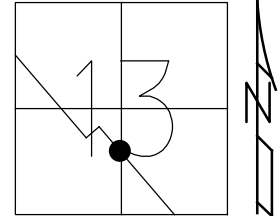


RECORD:
FD LG R.R. SPIKE
4/18/94, MC
SET P.K./WAHER
8/2/94, CL

COR. BRICK BUILDING
AT BOTTOM

COR. BRICK BUILDING
AT BOTTOM
BELOW SLAB

CENTER OF NW BOLT
LIGHT POLE BASE

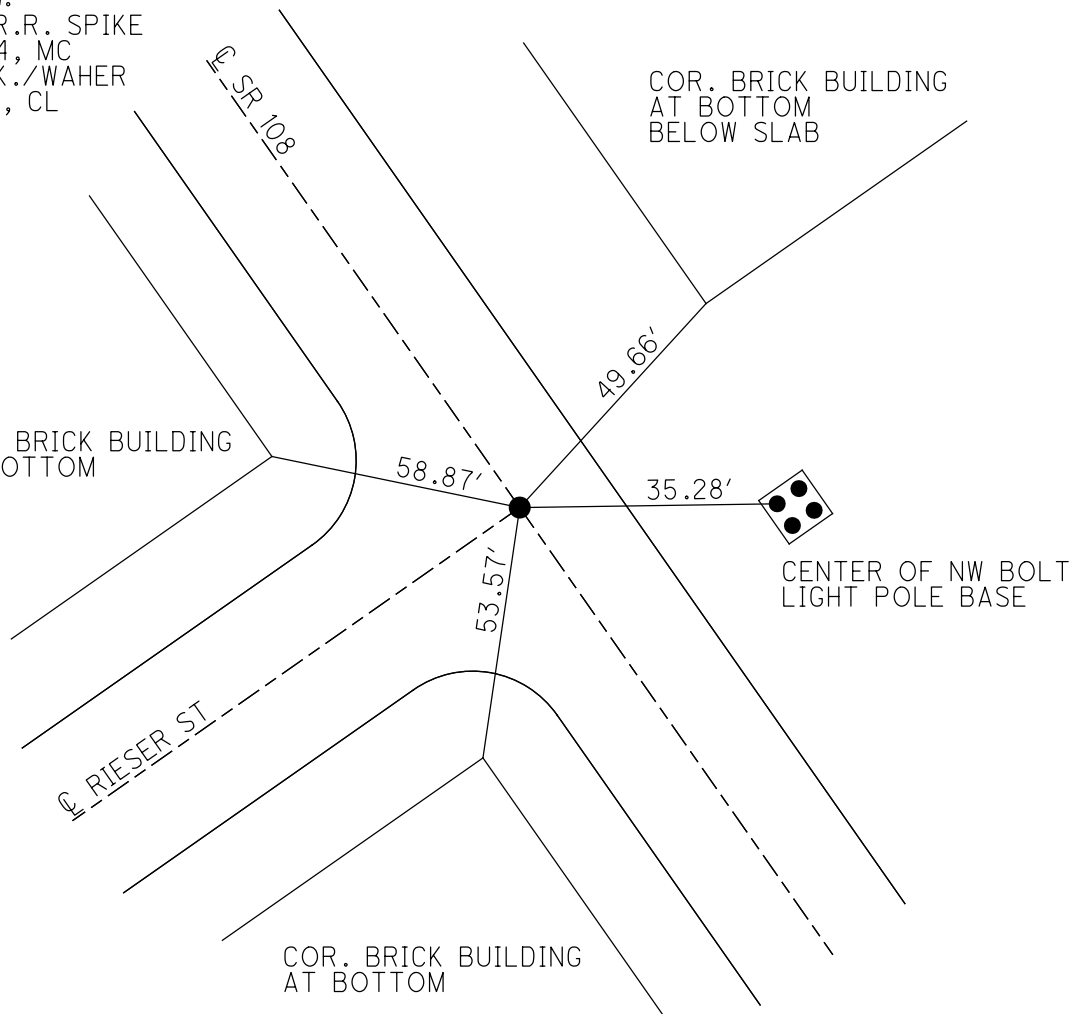

O.D.O.T. DISTRICT 2 SURVEY OFFICE (USE ONLY)

PERSONNEL

REFERENCE NO. 59 D

SHEET 3 OF 14

NOTES CURTIS
H.C. CANTERBURY
R.C. HERMILLER
CORDES, VOGEL

DATE 4/18/94
WEATHER CLOUDY
TEMP. 60°

ROUTE SR 108
COUNTY HENRY
TOWNSHIP NAPOLEON
SECTION 13

DWG BY NIESE PID

T 5 N R 6 E

TYPE MONUMENT P.K. NAIL

ON SURFACE - ~~BELOW~~ ON


OFFSET Q PAVEMENT ON LT : RT

- TO - EDGE PAVEMENT


STATION: 846+04

HORZ.DATUM: GEOID:

GRID: NORTHING: EASTING:

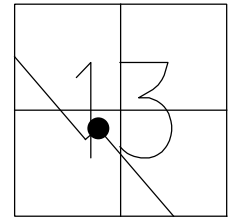

RECORD:
FD P.K. NAIL
4/18/94, MC
SET P.K./WASHER
8/2/94, CL

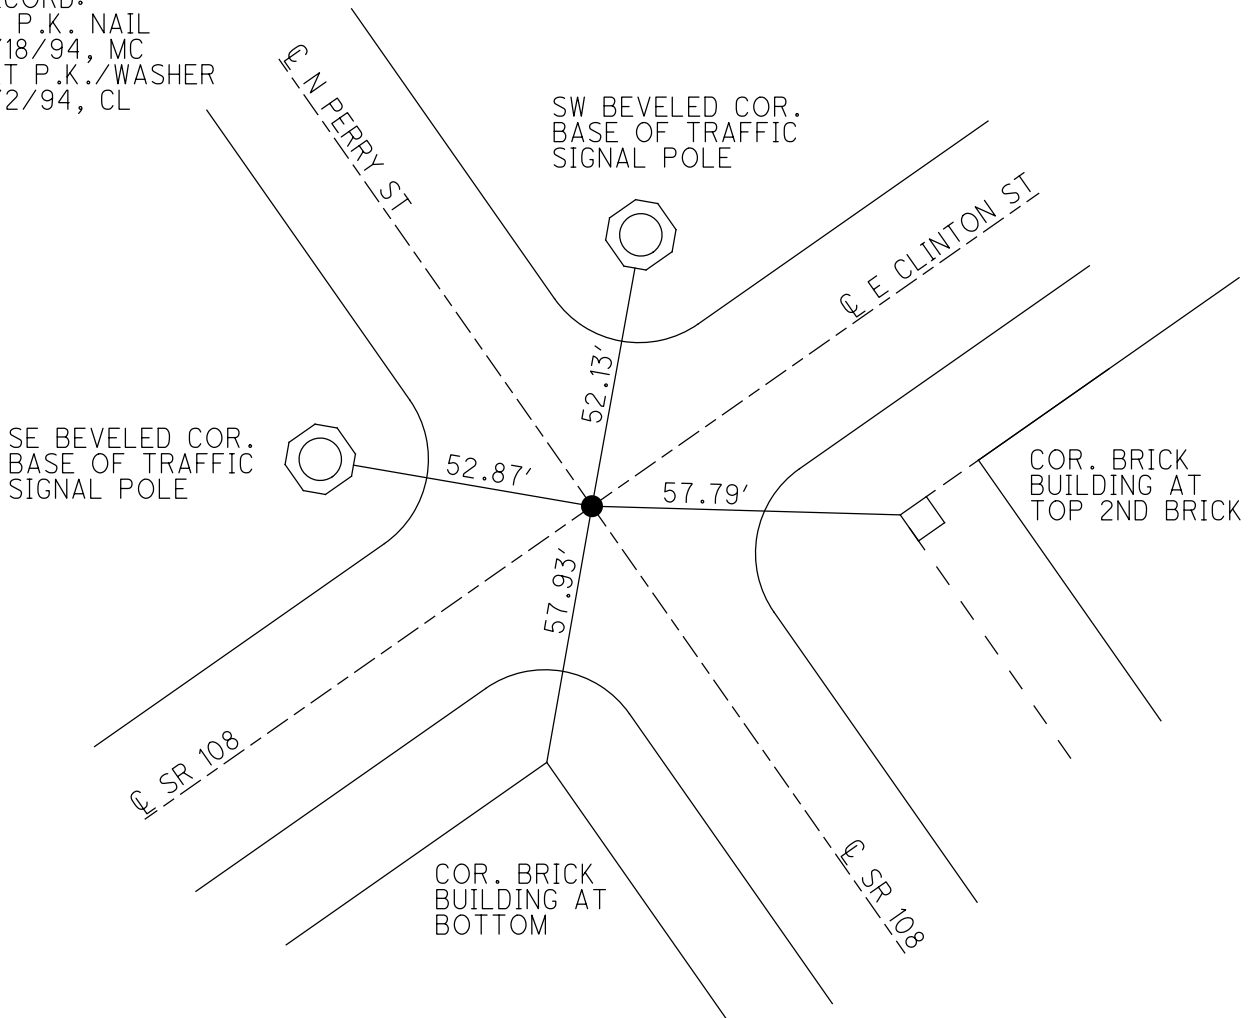

O.D.O.T. DISTRICT 2 SURVEY OFFICE (USE ONLY)

PERSONNEL

REFERENCE NO. 60

SHEET 4 OF 14

NOTES CURTIS

DATE 4/18/94

ROUTE SR 108

H.C. CANTERBURY

WEATHER RAIN

COUNTY HENRY

R.C. HERMILLER

TEMP. 60°

TOWNSHIP NAPOLEON

CORDES, VOGEL

SECTION 13

DWG BY NIESE PID

T 5 N R 6 E

TYPE MONUMENT BOAT SPIKE

~~ON SURFACE~~ - BELOW 2"


OFFSET CL PAVEMENT 2.7' LT : ~~RT~~

18.0' TO LT EDGE PAVEMENT

STATION: 850+62

HORIZ.DATUM: GEOID:


GRID: NORTHING: EASTING:

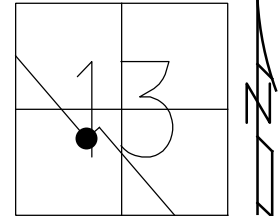

RECORD:
FD BOAT SPIKE
4/18/94, MC
SET P.K./WASHER
8/2/94, CL

DIST.60-60A= 51.90'

"+" CUT SW
COR. CONC BASE
TRAFFIC SIGNAL

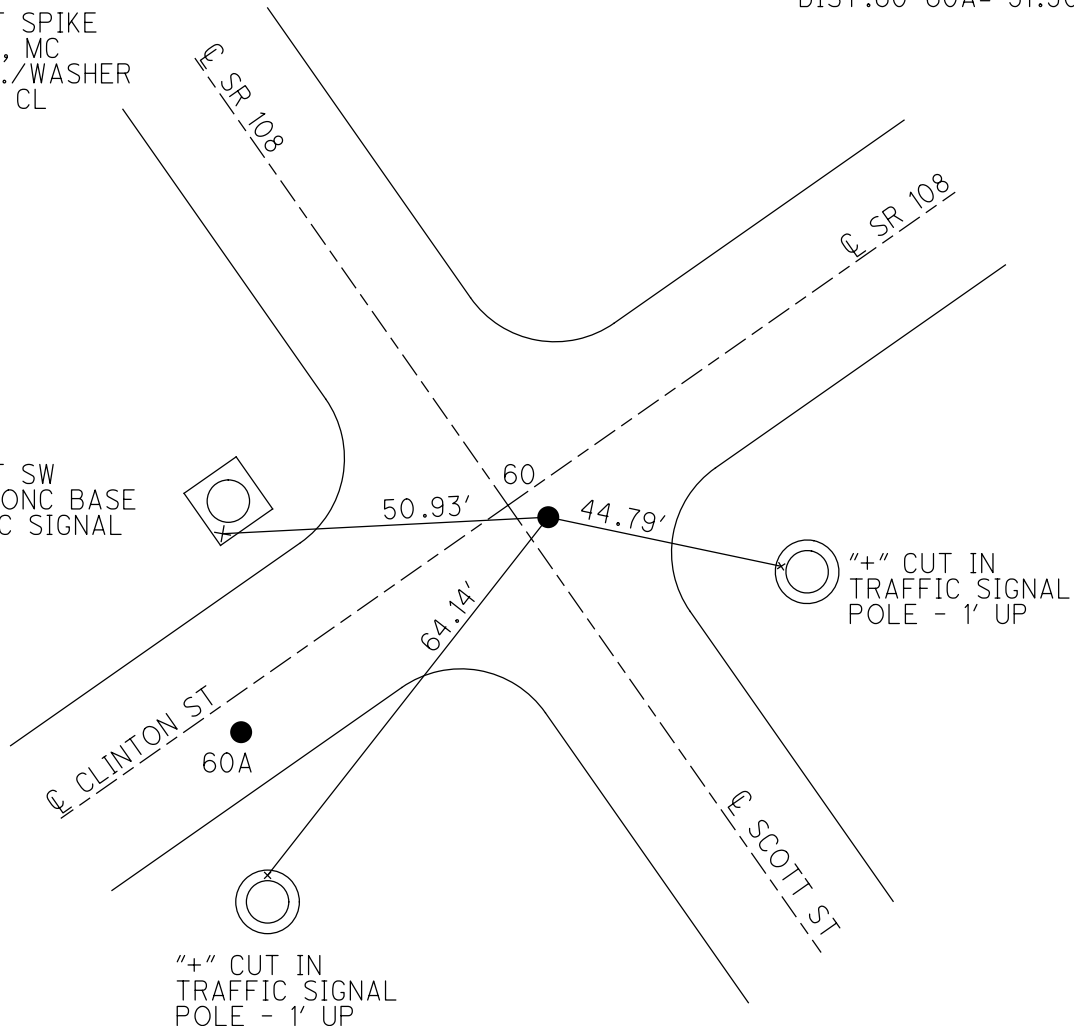

O.D.O.T. DISTRICT 2 SURVEY OFFICE (USE ONLY)

PERSONNEL

REFERENCE NO. 60 A

SHEET 5 OF 14

NOTES CURTIS

DATE 4/18/94

ROUTE SR 108

H.C. CANTERBURY

WEATHER RAIN

COUNTY HENRY

R.C. HERMILLER
CORDES, VOGEL

TEMP. 60°

TOWNSHIP NAPOLEON

DWG BY NIESE PID

SECTION 13

T 5 N R 6 E

TYPE MONUMENT BOAT SPIKE

~~ON SURFACE~~ - BELOW 2"

OFFSET CL PAVEMENT 2.7' LT : ~~RT~~

18.0' TO LT EDGE PAVEMENT


STATION: 851+13

HORZ.DATUM:

GEOID:


GRID: NORTHING:

EASTING:

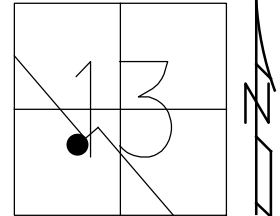

RECORD:
FD BOAT SPIKE
4/18/94, MC
SET P.K./WASHER
8/2/94, CL

DIST.60-60A= 51.90'

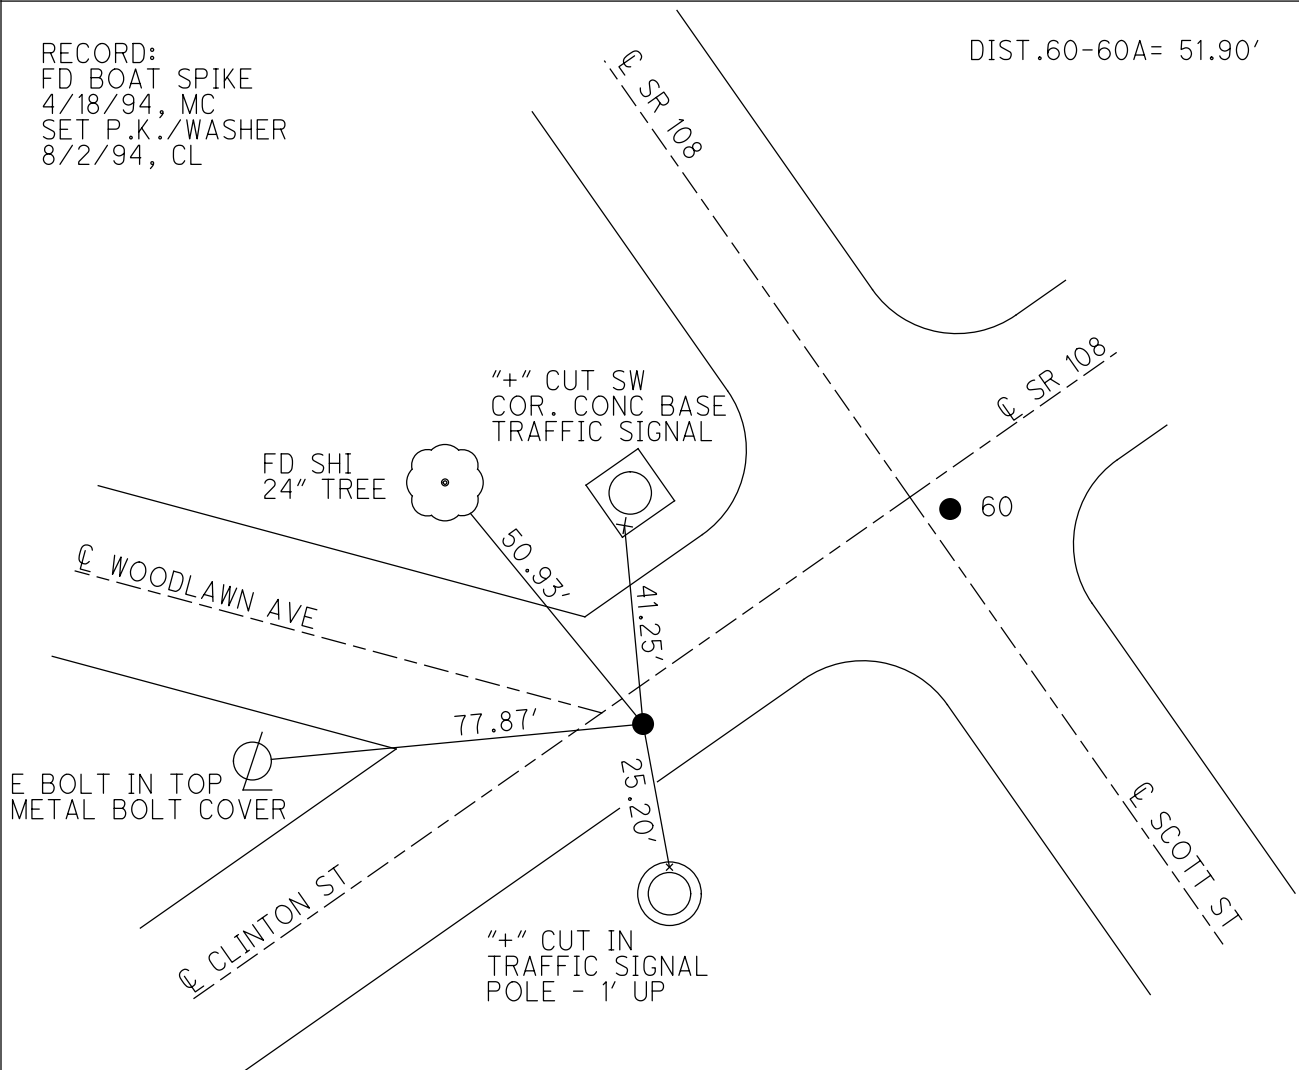

O.D.O.T. DISTRICT 2 SURVEY OFFICE (USE ONLY)

PERSONNEL

REFERENCE NO. 61

SHEET 6 OF 14

NOTES MOSER

DATE 8/2/01

ROUTE SR 108

H.C. CANTERBURY

WEATHER CLEAR

COUNTY HENRY

R.C. MOSER

TEMP. 75°

TOWNSHIP NAPOLEON

SECTION 13

DWG BY NIESE PID

T 5 N R 6 E

TYPE MONUMENT LG. SPIKE

ON SURFACE - ~~BELOW~~ ON


OFFSET ϕ PAVEMENT 2.6' ~~LT~~ : RT

21.4' TO RT EDGE PAVEMENT


STATION: 851+95

HORZ.DATUM: GEOID:

GRID: NORTHING: EASTING:

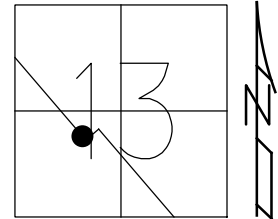

RECORD: P.I.
STA 850+55.03
FD LG SPIKE
8/2/01, MRC
SET P.K./WASHER
11/15/01, MRC

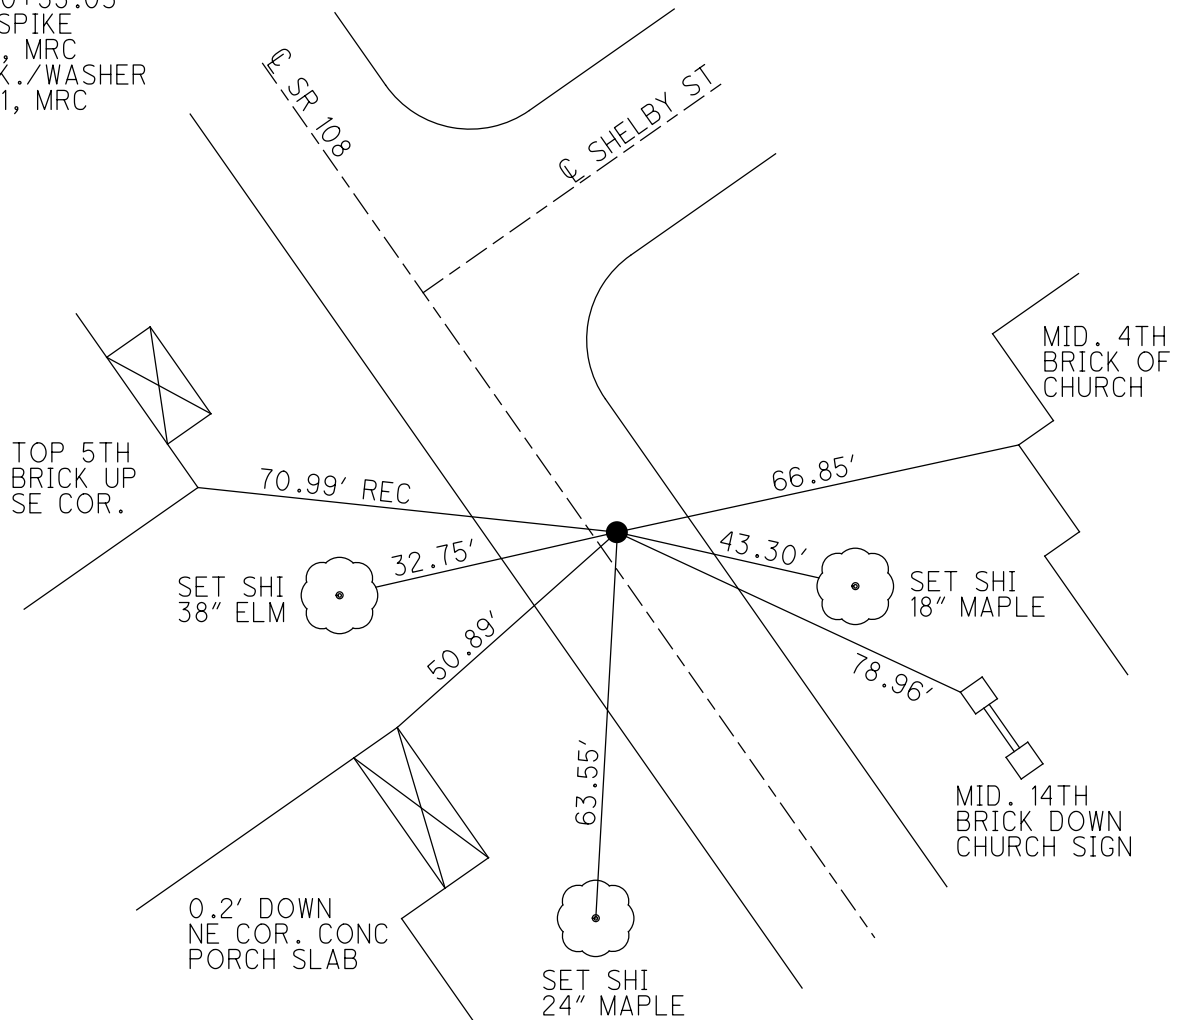

O.D.O.T. DISTRICT 2 SURVEY OFFICE (USE ONLY)

PERSONNEL

REFERENCE NO. 62

SHEET 7 OF 14

NOTES MOSER

DATE 8/2/01

ROUTE SR 108

H.C. CANTERBURY

WEATHER CLEAR

COUNTY HENRY

R.C. MOSER

TEMP. 75°

TOWNSHIP NAPOLEONDWG BY NIESE

PID _____

T_5_N R_6_E

TYPE MONUMENT SM. SPIKE

ON SURFACE - ~~BELOW~~ ON

OFFSET @ PAVEMENT _____ ON _____ LT : RT

14.5' TO LT EDGE PAVEMENT


STATION: 859+93

HORZ.DATUM: _____


GEOID: _____

GRID: NORTHING: _____

EASTING: _____

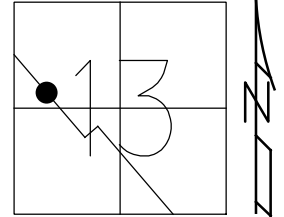

RECORD: P.I.
STA 860+56.78
FD SM SPIKE
8/2/01, MRC
SET P.K./WASHER
11/15/01, MRC

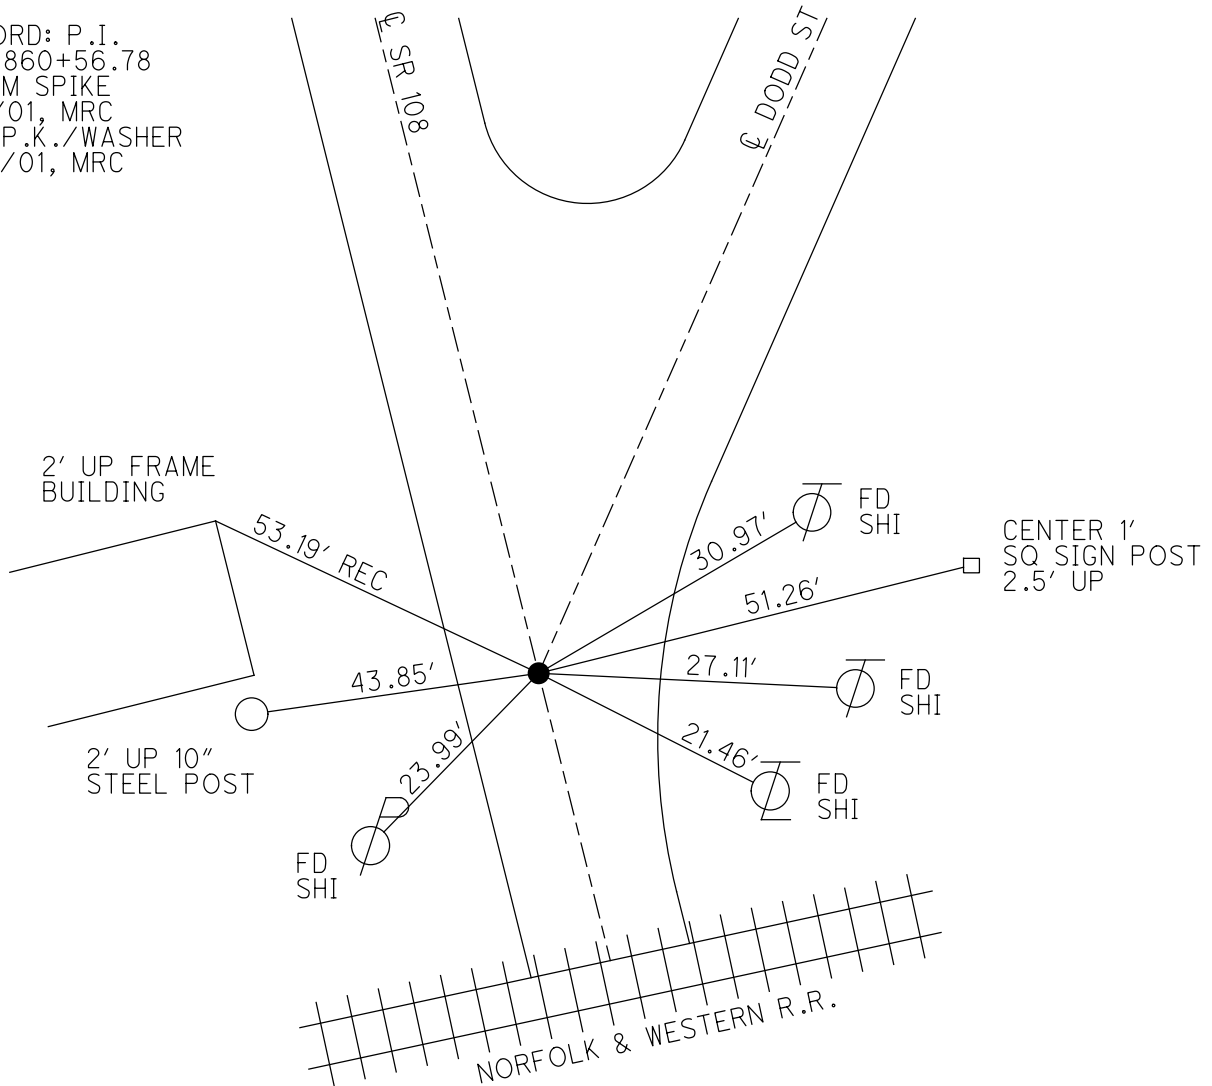

O.D.O.T. DISTRICT 2 SURVEY OFFICE (USE ONLY)

PERSONNEL

REFERENCE NO. 63

SHEET 8 OF 14

NOTES MOSER

DATE 8/2/01

ROUTE SR 108

H.C. CANTERBURY

WEATHER CLEAR

COUNTY HENRY

R.C. MOSER

TEMP. 80°

TOWNSHIP NAPOLEON

SECTION 13

DWG BY NIESE PID

T 5 N R 6 E

TYPE MONUMENT P.K./WASHER


ON SURFACE - ~~BELOW~~ ON

OFFSET 12.6' TO RT EDGE PAVEMENT


STATION: 861+62

HORZ.DATUM: GEOID:

GRID: NORTHING: EASTING:

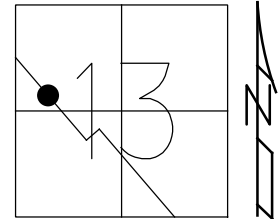

RECORD:
FD NAIL
ORIGIN UNKNOWN
4/8/88
FD P.K./WASHER
8/2/01, MRC
SET P.K./WASHER
11/15/01, MRC

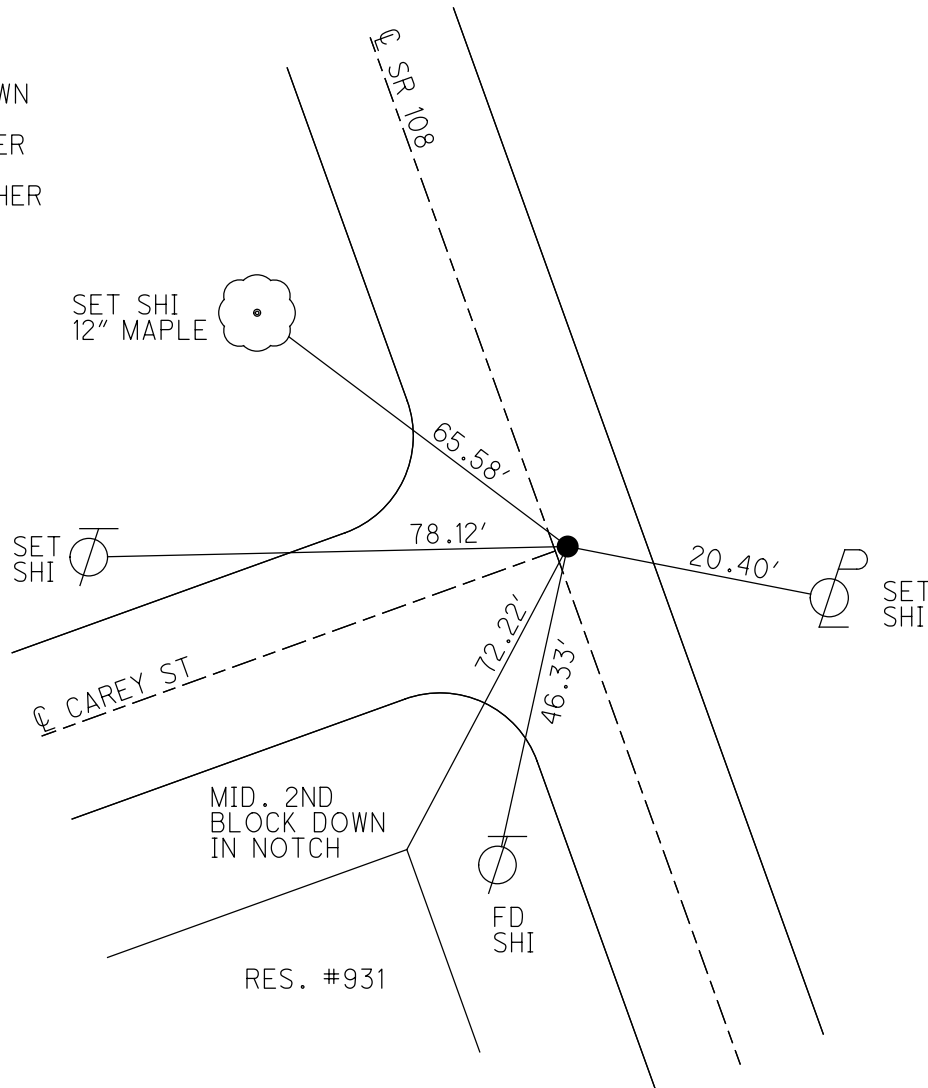

O.D.O.T. DISTRICT 2 SURVEY OFFICE (USE ONLY)

PERSONNEL

REFERENCE NO. 64

SHEET 9 OF 14

NOTES MOSER

DATE 8/2/01

ROUTE SR 108

H.C. CANTERBURY

WEATHER CLEAR

COUNTY HENRY

R.C. MOSER

TEMP. 85°

TOWNSHIP NAPOLEON

SECTION 13

DWG BY NIESE PID

T 5 N R 6 E

TYPE MONUMENT SM. P.K.

ON SURFACE - ~~BELOW~~ ON


OFFSET CL PAVEMENT ON LT : RT

17.0' TO RT EDGE PAVEMENT


STATION: 871+08

HORZ.DATUM: GEOID:

GRID: NORTHING: EASTING:

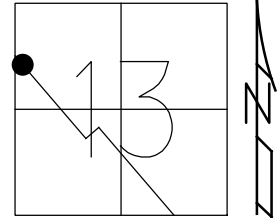

RECORD:
STA 871+68.53
FD SM. P.K.
8/2/01, MRC
SET P.K./WASHER
11/15/01, MRC

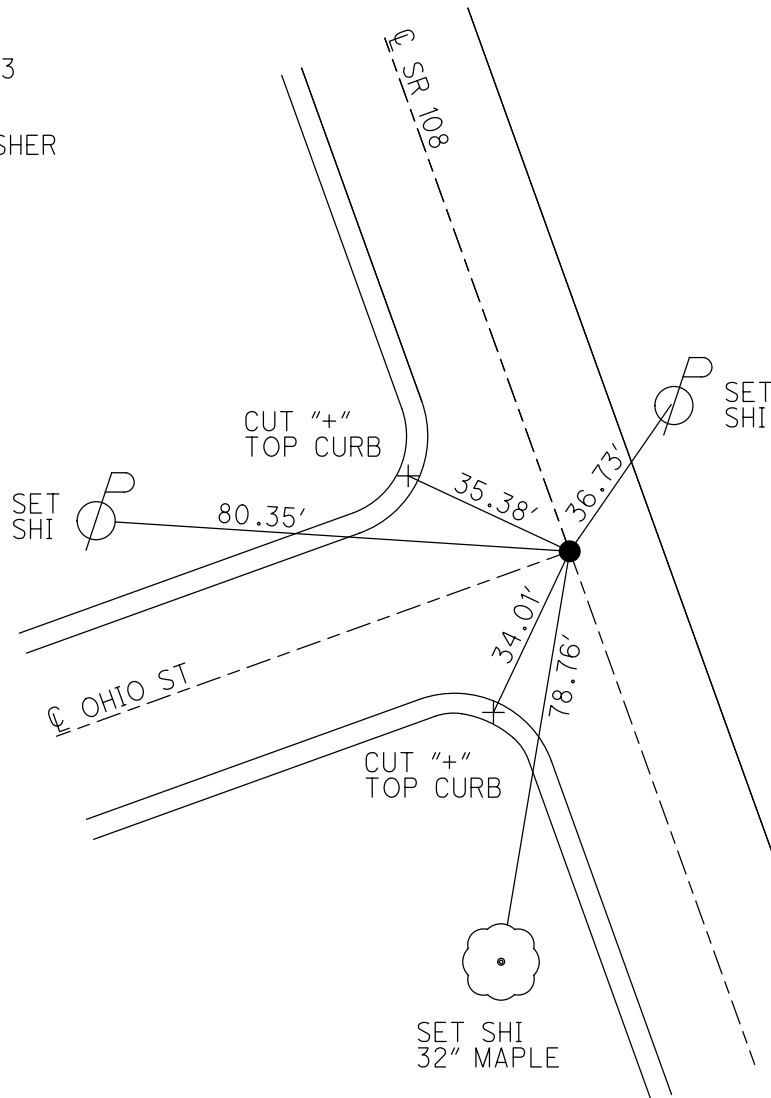

O.D.O.T. DISTRICT 2 SURVEY OFFICE (USE ONLY)

PERSONNEL

REFERENCE NO. 65

SHEET 10 OF 14

NOTES MOSER

DATE 8/2/01

ROUTE SR 108

H.C. CANTERBURY

WEATHER CLEAR

COUNTY HENRY

R.C. MOSER

TEMP. 85°

TOWNSHIP NAPOLEON

SECTION 13

DWG BY NIESE PID

T 5 N R 6 E

TYPE MONUMENT MONBOX W/ 1" IPIN

ON SURFACE - ~~BELOW~~ ON

OFFSET CL PAVEMENT 19.0' LT : ~~RT~~

- TO - EDGE PAVEMENT


STATION: 873+62

HORIZ.DATUM:


GEOID:

GRID: NORTHING:

EASTING:

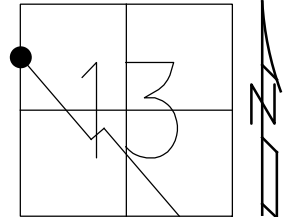

RECORD:
P.I. STA 874+28.78
FD MONBOX
W/ 1" IPIN
8/2/01, MRC

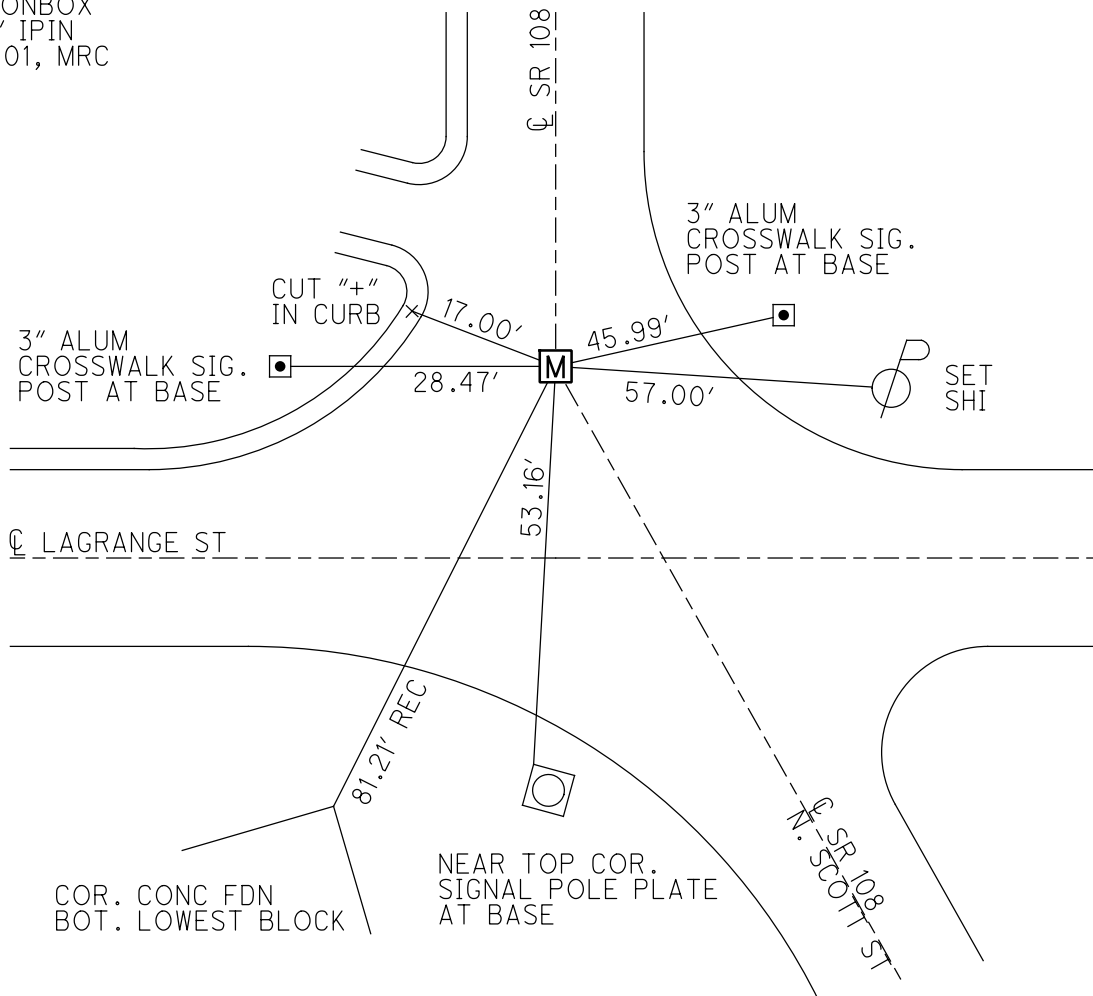

O.D.O.T. DISTRICT 2 SURVEY OFFICE (USE ONLY)

PERSONNEL

REFERENCE NO. 66

SHEET OF

NOTES NIESE

DATE 8/21/23

ROUTE SR 108

H.C. NIESE

WEATHER

COUNTY HENRY

R.C.

TEMP.

TOWNSHIP NAPOLEON

SECTION 13

DWG BY BARRIERE

PID 110867

T 5 N R 16 E

TYPE MONUMENT MONBOX W/ 1" IPIN

ON SURFACE - BELOW ON

OFFSET $\mathcal{C}$ PAVEMENT ON LT : RT

 TO EDGE PAVEMENT

STATION: 882+82

HORIZ.DATUM: NAD83(2011)/HEN LDP


GEOID: 18

GRID: NORTHING: 635425.073

EASTING: 1520773.500


LDP: NORTHING: 491598.434

EASTING: 155246.710

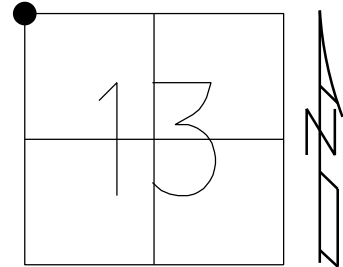

RECORD: P.I.

STA 883+50.96
FD MONBOX
W/ IPIN
8/2/01, MRC
FD MONBOX
W/ 1" IPIN
REF66
8/21/23, TDN

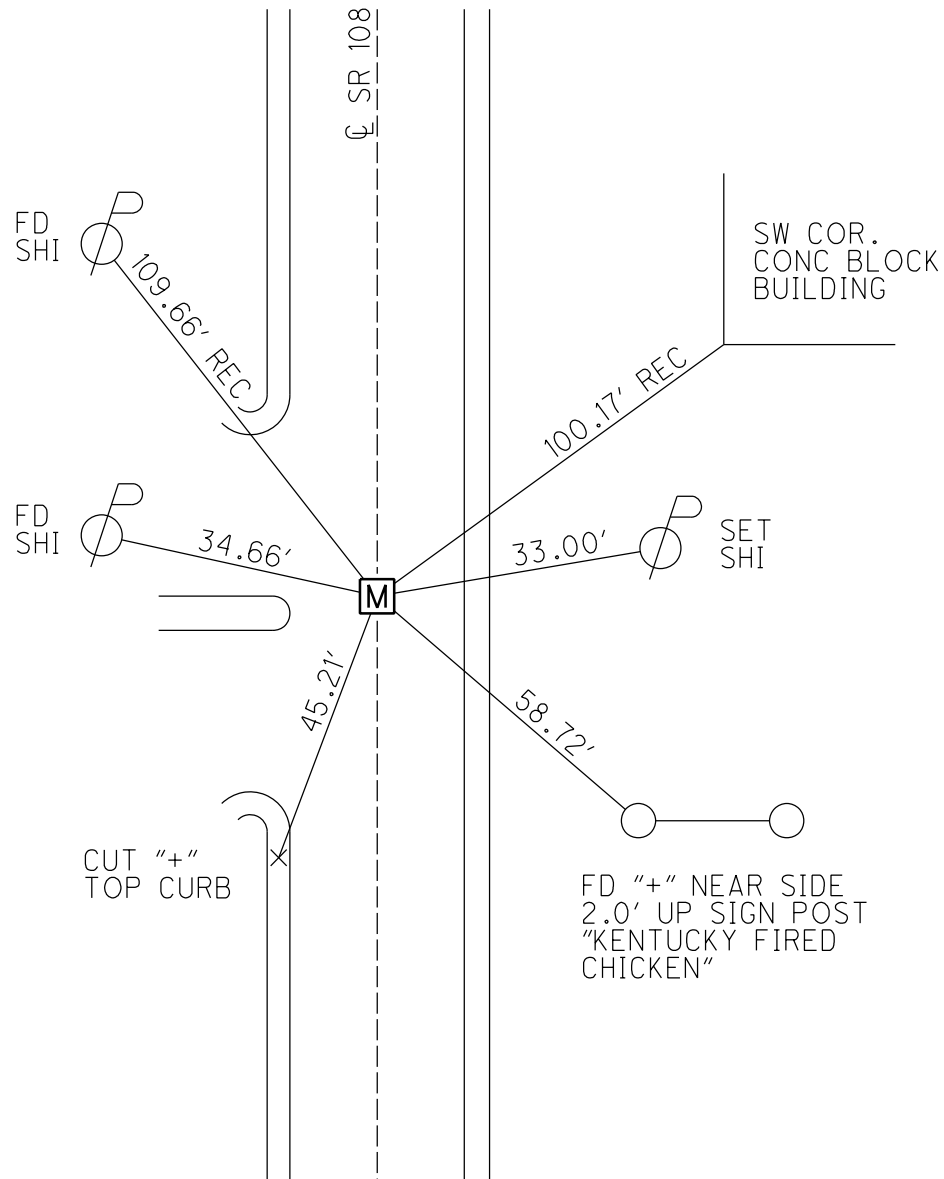

O.D.O.T. DISTRICT 2 SURVEY OFFICE (USE ONLY)

PERSONNEL

REFERENCE NO. 66A

SHEET OF

NOTES NIESE

DATE 8/21/23

ROUTE SR 108

H.C. NIESE

WEATHER

COUNTY HENRY

R.C.

TEMP.

TOWNSHIP NAPOLEON

DWG BY BARRIERE

PID 110867

SECTION 12

T 5 N R 6 E


TYPE MONUMENT MONBOX W/ 1" IPIN

ON SURFACE - BELOW ON

OFFSET CL PAVEMENT ON LT : RT

 TO EDGE PAVEMENT

STATION: 904+07

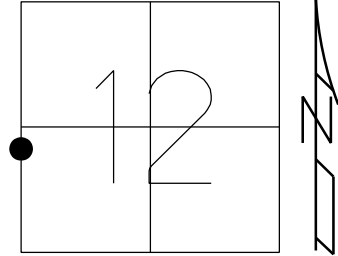


HORIZ.DATUM: NAD83(2011)/HEN LDP GEOID: 18

GRID: NORTHING: 637548.723 EASTING: 1520821.478

LDP: NORTHING: 493722.757 EASTING: 155255.728

RECORD: P.I.
STA 904+75.14

FD MONBOX
W/ IPIN
8/2/01, MRC
FD MONBOX
W/ 1" IPIN
REF66A
8/21/23, TDN

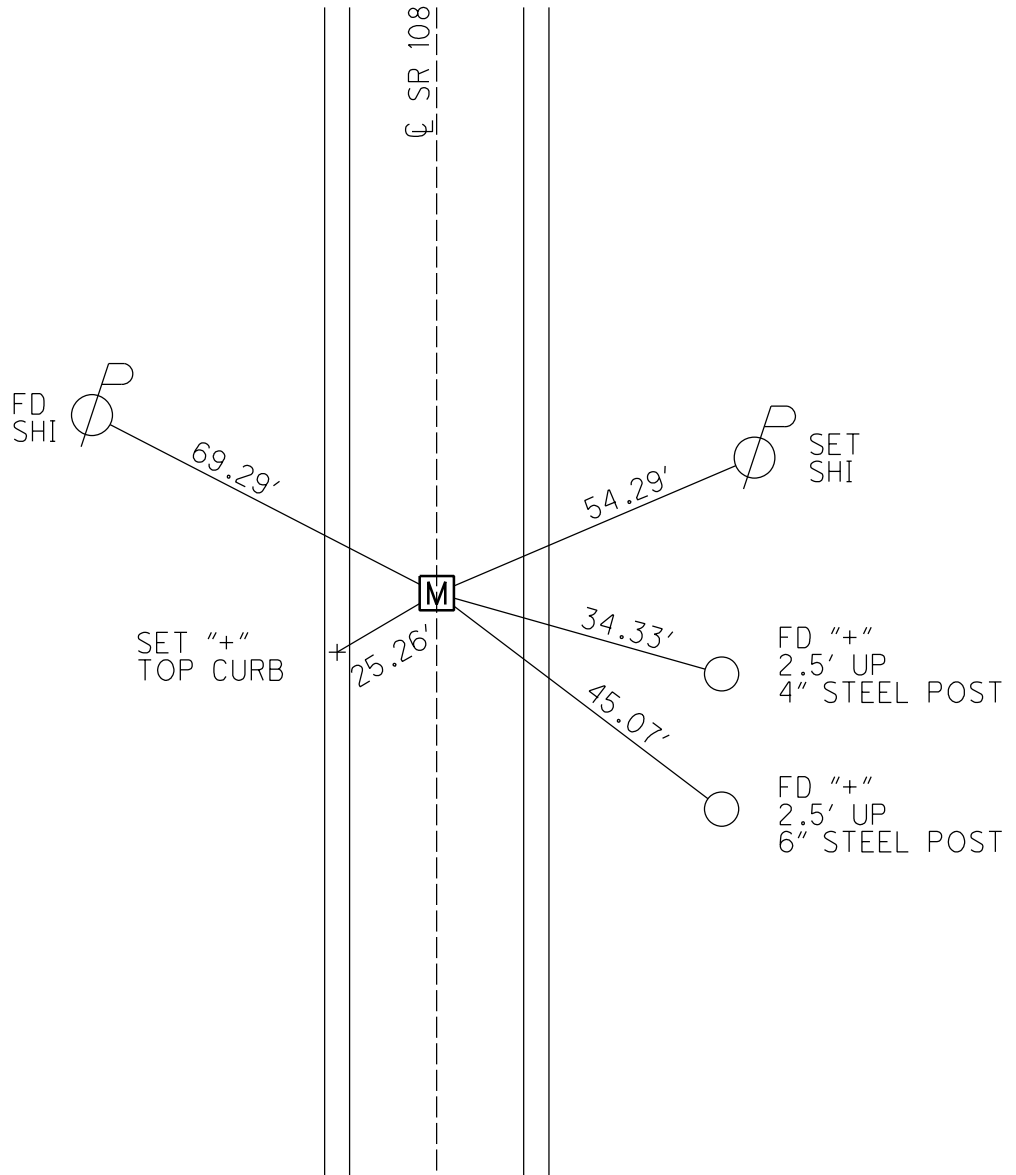

O.D.O.T. DISTRICT 2 SURVEY OFFICE (USE ONLY)

PERSONNEL

REFERENCE NO. 67

SHEET OF

NOTES NIESE

DATE 8/21/23

ROUTE SR 108

H.C. NIESE

WEATHER

COUNTY HENRY

R.C.

TEMP.

TOWNSHIP NAPOLEON

DWG BY BARRIERE

PID 110867

SECTION 12

T 5 N R 6 E

TYPE MONUMENT MONBOX W/ STONE

ON SURFACE - BELOW ON

OFFSET Q PAVEMENT ON LT : RT


 TO EDGE PAVEMENT

STATION: 909+06

HORIZ.DATUM: NAD83(2011)/HEN LDP GEOID: 18

GRID: NORTHING: 638047.769 EASTING: 1520832.654


LDP: NORTHING: 494221.959 EASTING: 155257.749

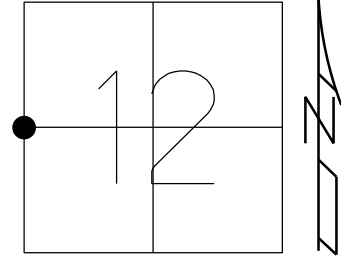

RECORD: P.I.
STA 909+74.40
 $\Delta=00^{\circ}06'$ LT
HEN-108-17.50-1966 PLAN

FD MONBOX
8/2/01, MRC
FD MONBOX
W/ STONE 2.4' DOWN
REF67
8/22/23, TDN
FD MONBOX
W/ STONE
12/21/23, TDN

****NOTE****
TIES ARE TO CENTER OF
BOX IN 2001, NOT TO STONE

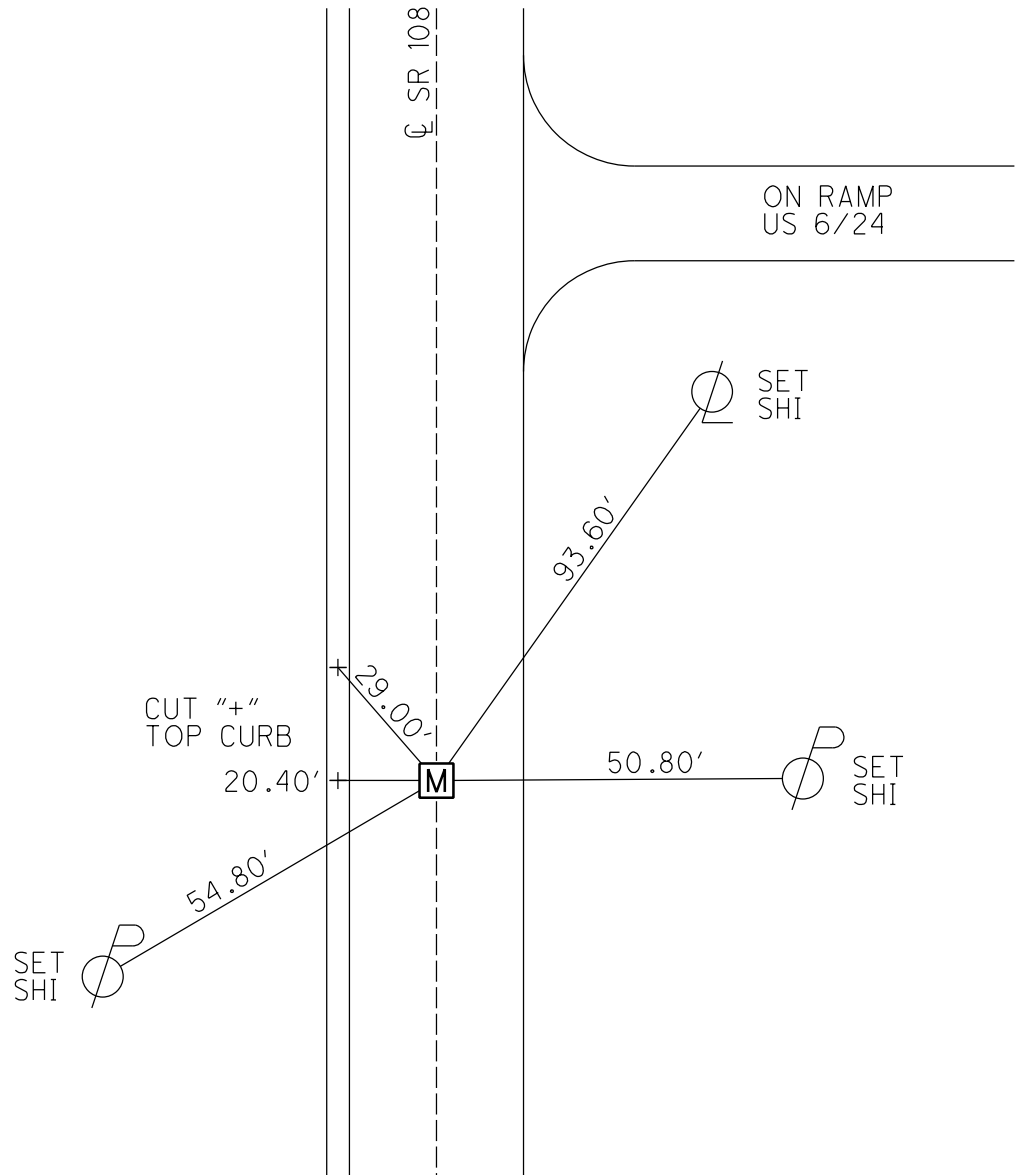

O.D.O.T. DISTRICT 2 SURVEY OFFICE (USE ONLY)

PERSONNEL

REFERENCE NO. 67A

SHEET OF

NOTES ASTON

DATE 8/21/23

ROUTE SR 108

H.C. NIESE

WEATHER CLEAR

COUNTY HENRY

R.C. ASTON

TEMP. 90°

TOWNSHIP NAPOLEON

SECTION 12

DWG BY BARRIERE

PID 110867

T 5 N R 6 E

TYPE MONUMENT MONBOX W/ 1.5" IPIN

ON SURFACE - BELOW ON

OFFSET $\varnothing$ PAVEMENT ON LT : RT


 TO EDGE PAVEMENT

STATION: 910+52

HORIZ.DATUM: NAD83(2011)/HEN LDP GEOID: 18


GRID: NORTHING: 638194.324 EASTING: 1520835.635

LDP: NORTHING: 494368.555 EASTING: 155258.042

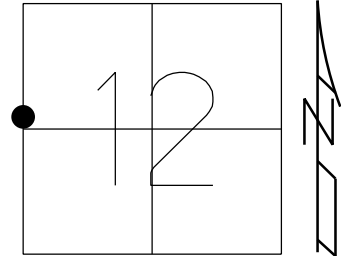

RECORD:
1965 PLAN
STA 911+21.05

FD MONBOX
8/2/01, MRC
FD MONBOX
W/ 1.5" IPIN
REF67A
8/21/23, TDN

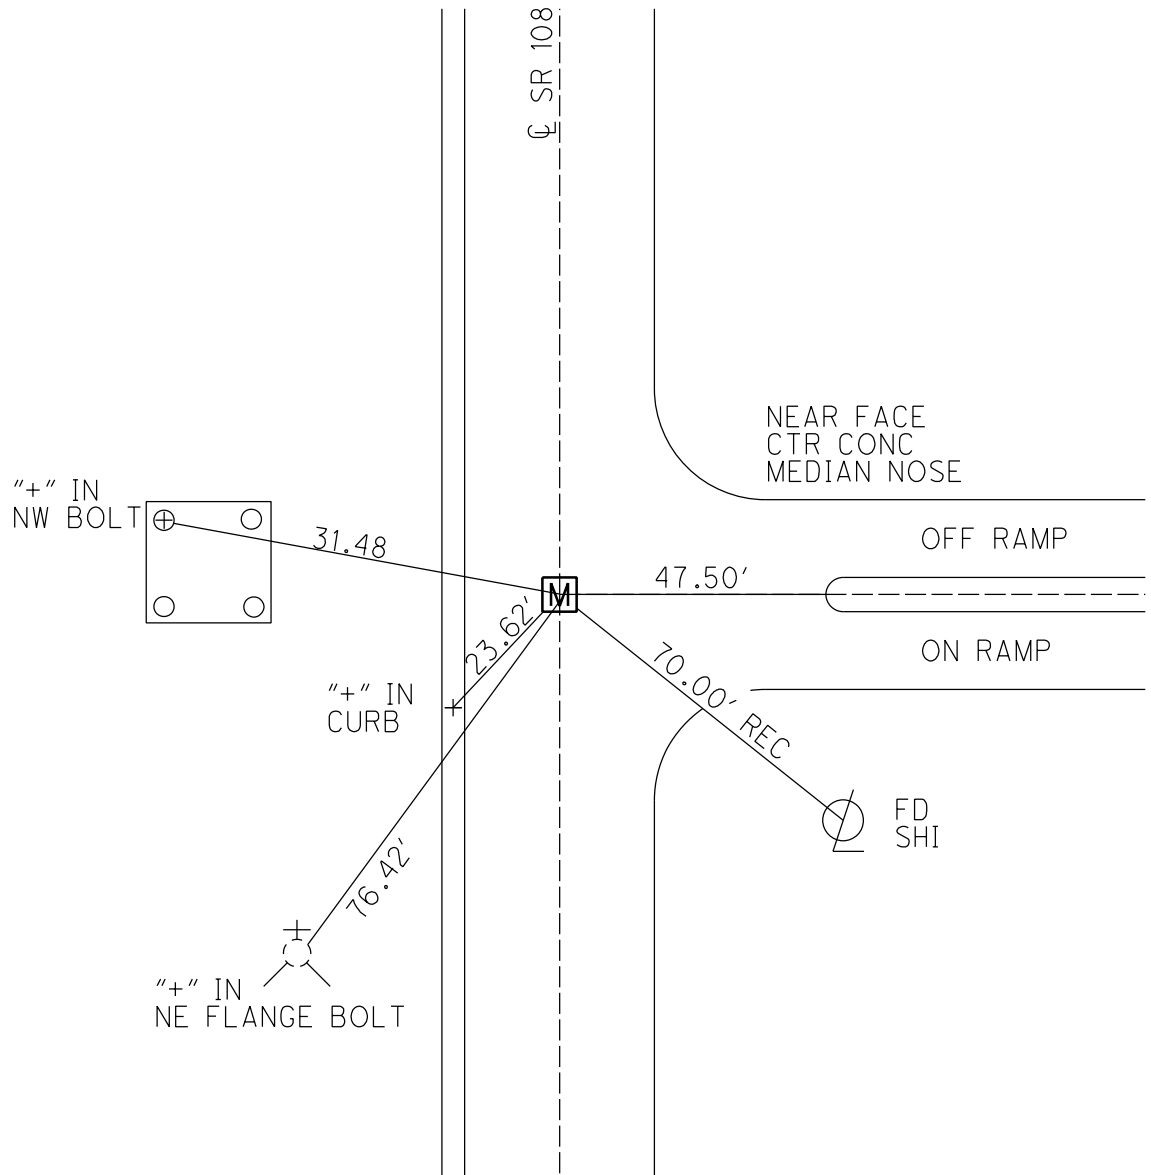

O.D.O.T. DISTRICT 2 SURVEY OFFICE (USE ONLY)

PERSONNEL

REFERENCE NO. 67B

SHEET OF

NOTES ASTON
H.C. NIESE
R.C. ASTON

DATE 8/21/23
WEATHER CLEAR
TEMP. 90°

ROUTE SR 108
COUNTY HENRY
TOWNSHIP NAPOLEON
SECTION 11

DWG BY BARRIERE PID 110867

T 5 N R 6 E

TYPE MONUMENT MONBOX W/ 1.5" IPIN

ON SURFACE - BELOW ON

OFFSET $\varnothing$ PAVEMENT ON LT : RT


 TO EDGE PAVEMENT

STATION: 910+52

HORZ.DATUM: NAD83(2011)/HEN LDP GEOID: 18


GRID: NORTHING: 638194.324 EASTING: 1520835.635

LDP: NORTHING: 494368.555 EASTING: 155258.042

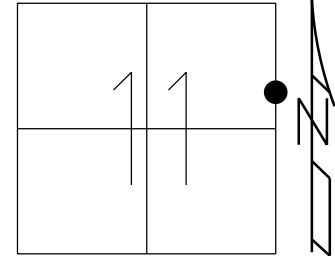

RECORD:
1965 PLAN= 920+00

FD MON.BOX
SHOT IPIN
REFB67
8/2/01, KPM
FD CMON SET BY
BOCKRATH & ASSOC.
"ODOT & PS 8306
C/L
BOCKRATH & ASSOC."
SET ON 2/7/24
NEWREF67B
2/9/24, TDN

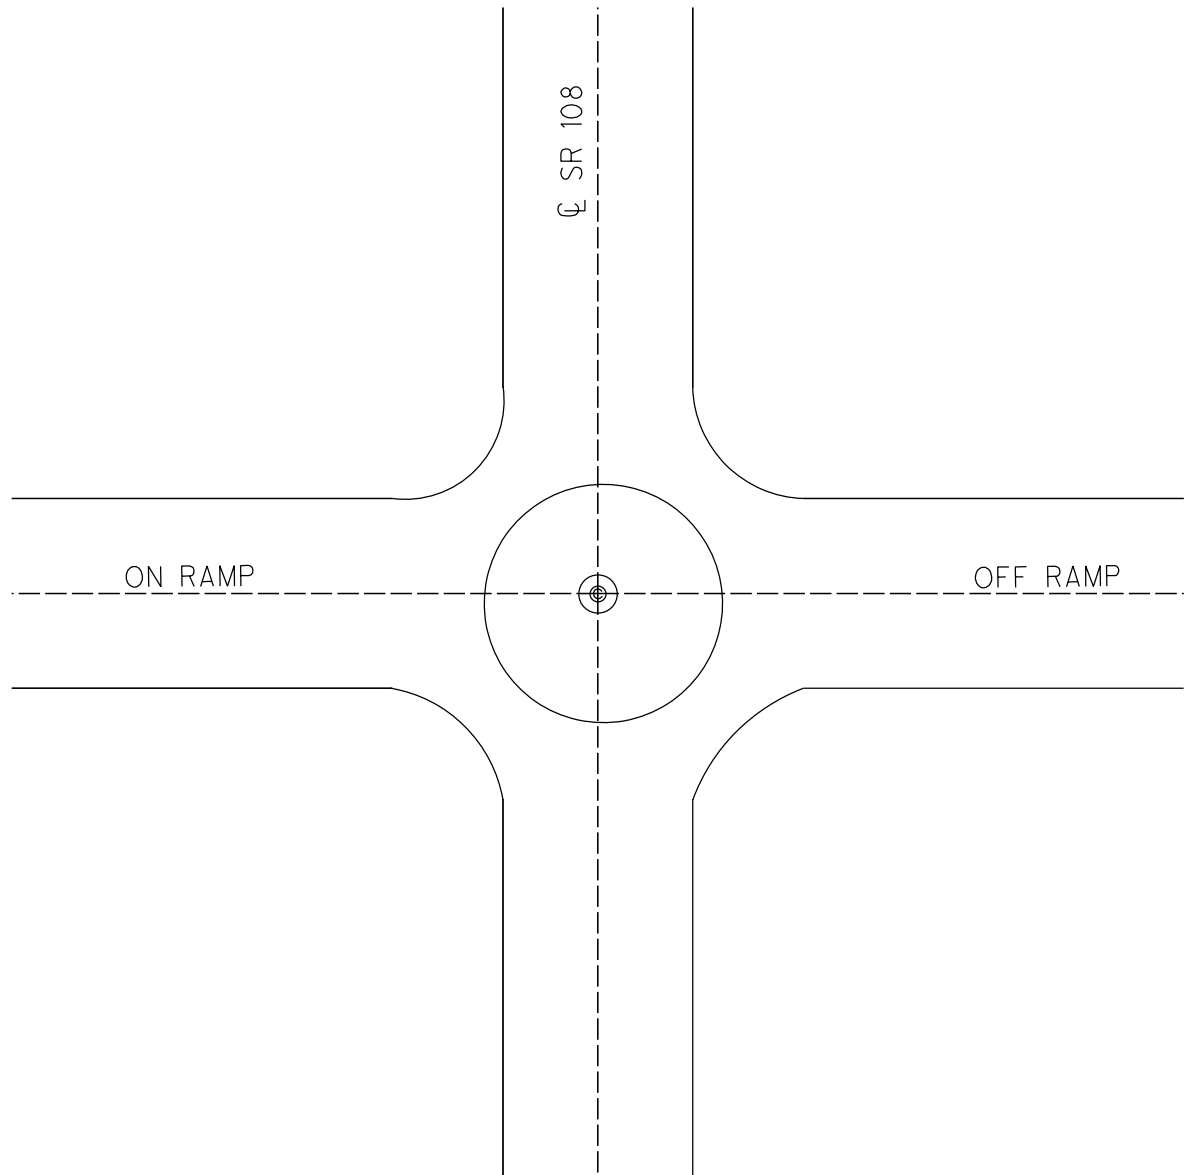

O.D.O.T. DISTRICT 2 SURVEY OFFICE (USE ONLY)

PERSONNEL

REFERENCE NO. 68

SHEET OF

NOTES ASTON
H.C. NIESE
R.C. ASTON

DATE 8/21/23
WEATHER CLEAR
TEMP. 90°

ROUTE SR 108
COUNTY HENRY
TOWNSHIP NAPOLEON
SECTION 11

DWG BY BARRIERE PID 110867

T 5 N R 6 E

TYPE MONUMENT MONBOX W/ 1" IPIN

ON SURFACE - BELOW ON

OFFSET Q PAVEMENT 1' RT LT : RT


 TO EDGE PAVEMENT

STATION: 935+97.36

HORIZ.DATUM: NAD83(2011)/HEN LDP GEOID: 18


GRID: NORTHING: 640670.031 EASTING: 1520887.395

LDP: NORTHING: 496844.968 EASTING: 155264.383

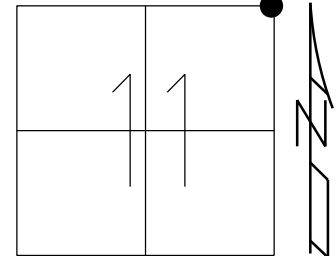

RECORD:
1966 PLAN
STA. 935+97.36

FD MONBOX
W/ IPIN
REF68
8/2/01, KPM
FD MONBOX
W/ 1" IPIN
REF68
9/17/19, JLL
FD MONBOX
W/ 1" IPIN
REF68
8/21/23, TDN

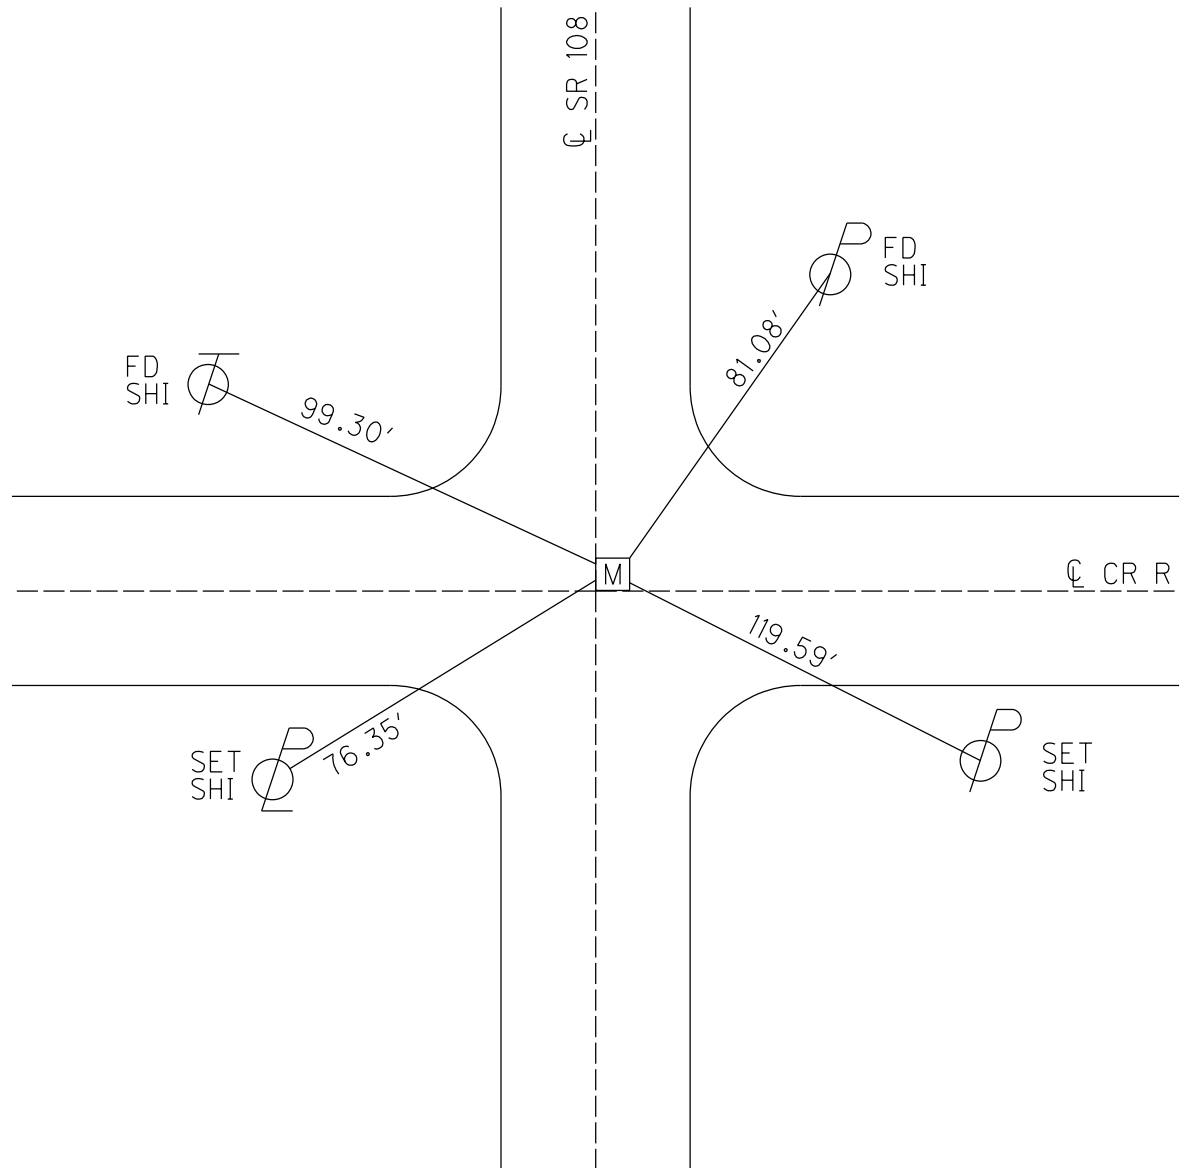

O.D.O.T. DISTRICT 2 SURVEY OFFICE (USE ONLY)

PERSONNEL

REFERENCE NO. 69

SHEET 3 OF 21

NOTES AUBLE

DATE 4/20/18

ROUTE SR 108

H.C. LEU

WEATHER CLOUDY

COUNTY HENRY

R.C. AUBLE

TEMP. 40°F

TOWNSHIP NAPOLEON

SECTION 2

DWG BY NIESE

PID 101211

T 5 N R 6 E

TYPE MONUMENT MONBOX W/1" IPIN

ON SURFACE - ~~BELOW~~ ON

OFFSET ℄ PAVEMENT ON LT : RT

12.2' TO RT EDGE PAVEMENT


STATION: 962+26.75

HORIZ.DATUM: NAD83(2011)


GEOID: 2012A

GRID: NORTHING: 643298.920

EASTING: 1520942.295

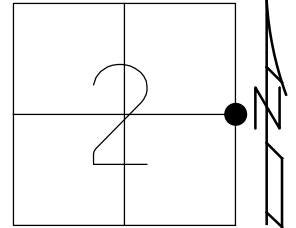

RECORD:
1966 PLAN
STA. 962+27.07
FD SET MONBOX
W/IPIN
REF69
8/6/01, KPM
FD MONBOX
REF69
9/17/19, JLL

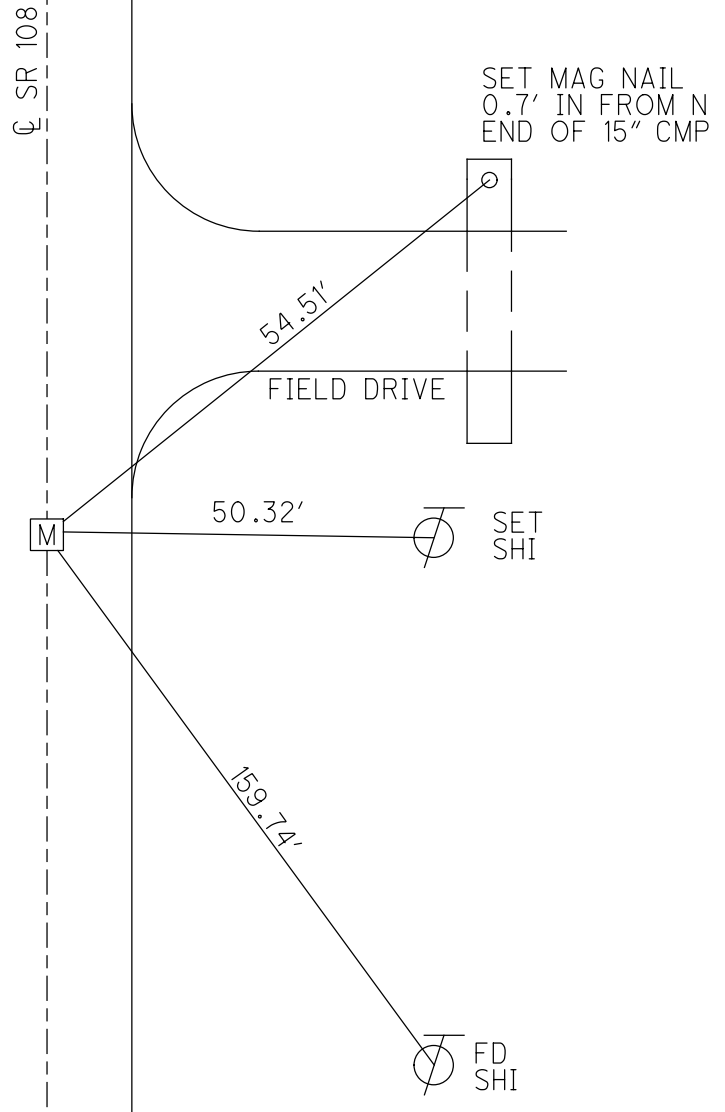

O.D.O.T. DISTRICT 2 SURVEY OFFICE (USE ONLY)

PERSONNEL

REFERENCE NO. 69 A

SHEET 4 OF 21

NOTES HUSS

DATE 4/15/09

ROUTE SR 108

H.C. CORDES

WEATHER CLOUDY

COUNTY HENRY

R.C. CORY

TEMP. 45°

TOWNSHIP NAPOLEON

DWG BY NIESE PID 101211

SECTION 2

T 5 N R 6 E

TYPE MONUMENT MONBOX W/1" IPIN

ON SURFACE - ~~BELOW~~ ON

OFFSET Q PAVEMENT ON LT : RT

12.1' TO RT EDGE PAVEMENT


STATION: 967+42.85

HORZ.DATUM: NAD83(2011)


GEOID: 2012A

GRID: NORTHING: 643814.968

EASTING: 1520952.985

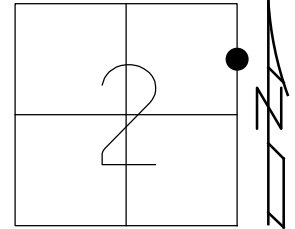

RECORD:
1966 PLAN
STA 967+43.00
FD MONBOX
W/IPIN
REFA69
8/6/01, KPM
FD MONBOX
REFA69
4/4/18, JLL

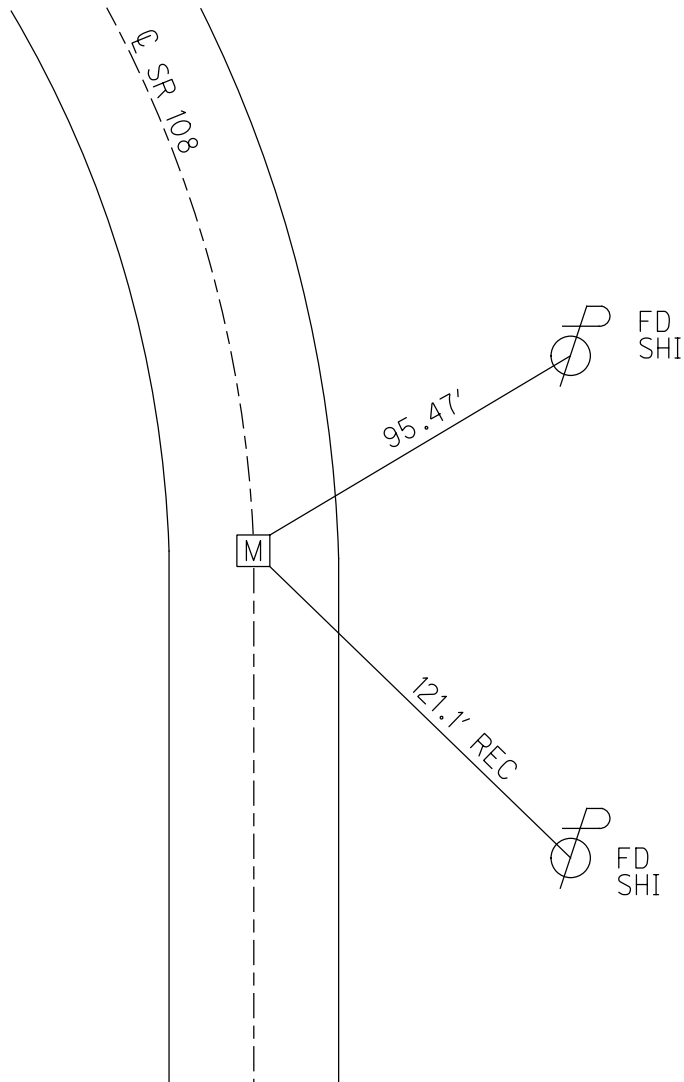

O.D.O.T. DISTRICT 2 SURVEY OFFICE (USE ONLY)

PERSONNEL

REFERENCE NO. 69 B

SHEET 5 OF 21

NOTES HUSS

DATE 4/15/09

ROUTE SR 108

H.C. CORDES

WEATHER CLOUDY

COUNTY HENRY

R.C. CORY

TEMP. 47°

TOWNSHIP NAPOLEON

DWG BY NIESE

PID 101211

SECTION 2

T 5 N R 6 E

TYPE MONUMENT MONBOX W/1" IPIN

ON SURFACE - ~~BELOW~~ ON

OFFSET 11.2' TO RT ~~LT~~ : RT

11.2' TO RT EDGE PAVEMENT


STATION: 971+42.60

HORIZ.DATUM: NAD83(2011)


GEOID: 2012A

GRID: NORTHING: 644214.535

EASTING: 1520944.977

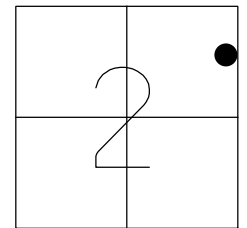

RECORD:
1966 PLAN
SLM. 971+43.00
FD MONBOX
W/IPIN
REFB69
8/6/01, KPM
FD MONBOX
REFB69
4/4/18, JLL
FD MONBOX
9/17/19, JLL

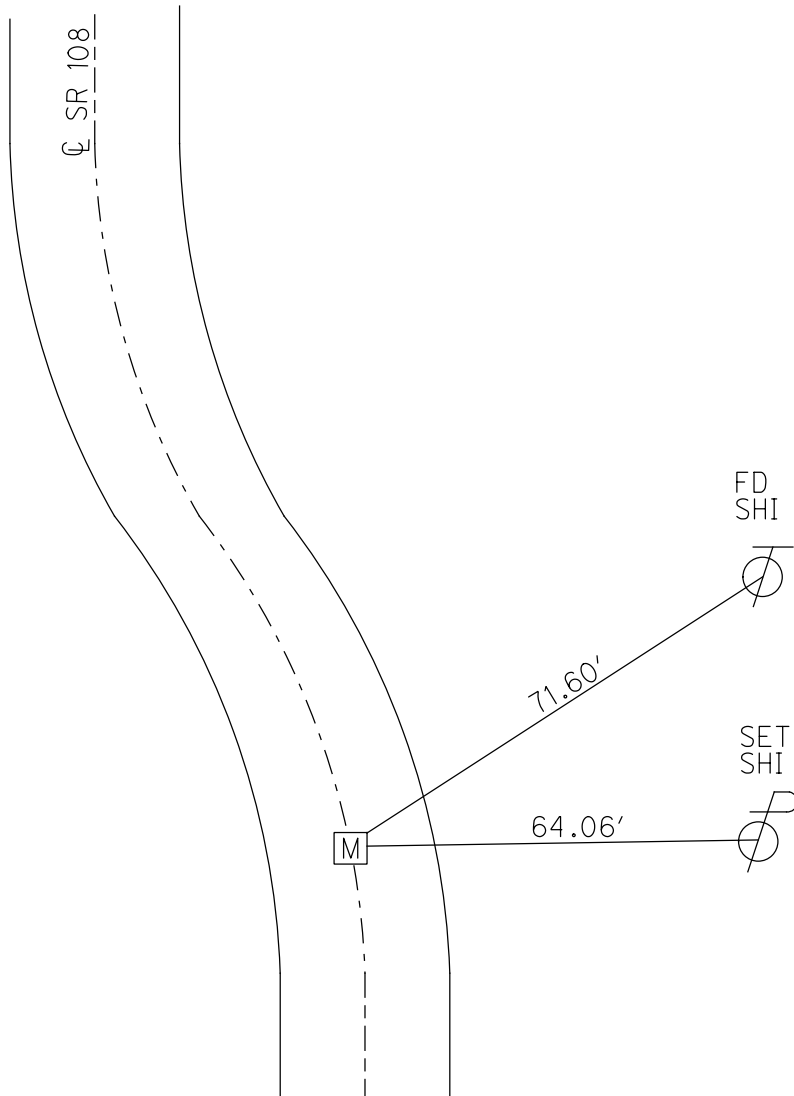

O.D.O.T. DISTRICT 2 SURVEY OFFICE (USE ONLY)

PERSONNEL

REFERENCE NO. 69 C

SHEET 6 OF 21

NOTES HUSS

DATE 4/15/09

ROUTE SR 108

H.C. CORDES

WEATHER CLOUDY

COUNTY HENRY

R.C. CORY

TEMP. 47°

TOWNSHIP NAPOLEON

SECTION 2

DWG BY NIESE PID 101211

T 5 N R 6 E

TYPE MONUMENT MONBOX W/1" IPIN

ON SURFACE - ~~BELOW~~ ON

OFFSET Q PAVEMENT ON ~~LT~~ : RT

12.1' TO RT EDGE PAVEMENT


STATION: 975+41.26

HORZ.DATUM: NAD83(2011)


GEOID: 2012A

GRID: NORTHING: 644603.364

EASTING: 1520856.652

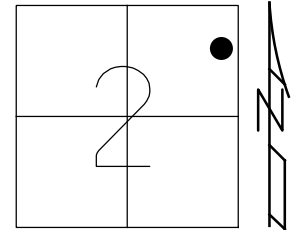

RECORD:
1966 PLAN
STA. 975+42.76
FD MONBOX
W/IPIN
REFC69
8/6/01, KPM
FD MONBOX
REFC69
4/4/18, JLL
FD MONBOX
9/17/19, JLL

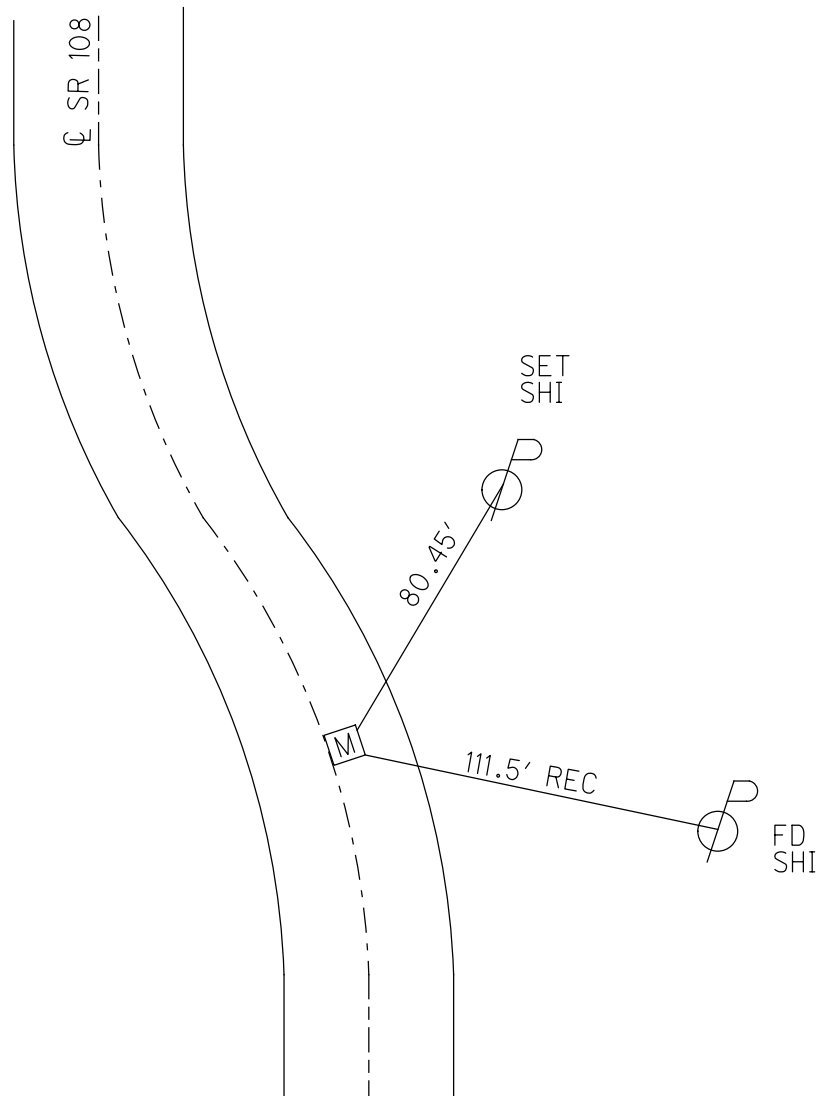

O.D.O.T. DISTRICT 2 SURVEY OFFICE (USE ONLY)

PERSONNEL

REFERENCE NO. 69 D

SHEET 7 OF 21

NOTES HUSS

DATE 4/15/09

ROUTE SR 108

H.C. CORDES

WEATHER CLOUDY

COUNTY HENRY

R.C. CORY

TEMP. 47°

TOWNSHIP NAPOLEON

DWG BY NIESE PID 101211

SECTION 2

T 5 N R 6 E

TYPE MONUMENT MONBOX W/1" IPIN

ON SURFACE - ~~BELOW~~ ON

OFFSET Q PAVEMENT ON LT : RT

12.6' TO RT EDGE PAVEMENT


STATION: 979+40.978

HORIZ.DATUM: NAD83(2011)


GEOID: 2012A

GRID: NORTHING: 644967.177

EASTING: 1520691.141

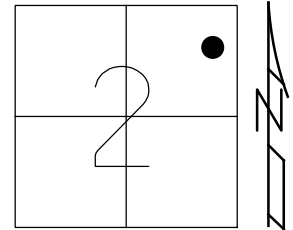

RECORD:
1966 PLAN
STA. 979+42.76
FD MONBOX
W/IPIN
REFD69
8/2/01, KPM
FD MONBOX
REFD69
4/4/18, JLL
FD MONBOX
9/17/19, JLL

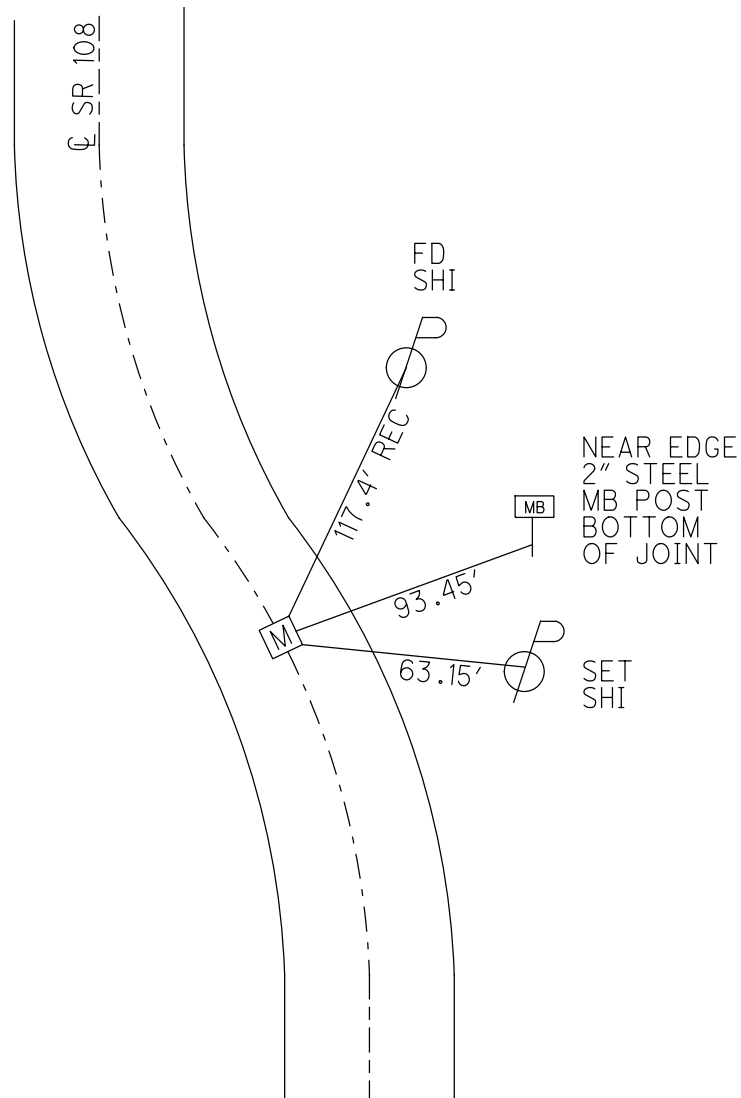

O.D.O.T. DISTRICT 2 SURVEY OFFICE (USE ONLY)

PERSONNEL

REFERENCE NO. 69 E

SHEET 8 OF 21

NOTES HUSS

DATE 4/15/09

ROUTE SR 108

H.C. CORDES

WEATHER CLOUDY

COUNTY HENRY

R.C. CORY

TEMP. 47°

TOWNSHIP NAPOLEON

DWG BY NIESE PID 101211

SECTION 2

T 5 N R 6 E

TYPE MONUMENT MONBOX W/1" IPIN

ON SURFACE - ~~BELOW~~ ON

OFFSET CL PAVEMENT ON LT : RT

13.0' TO RT EDGE PAVEMENT



STATION: 980+90.91

HORIZ.DATUM: NAD83(2011)

GEOID: 2012A

GRID: NORTHING: 645100.964

EASTING: 1520623.579

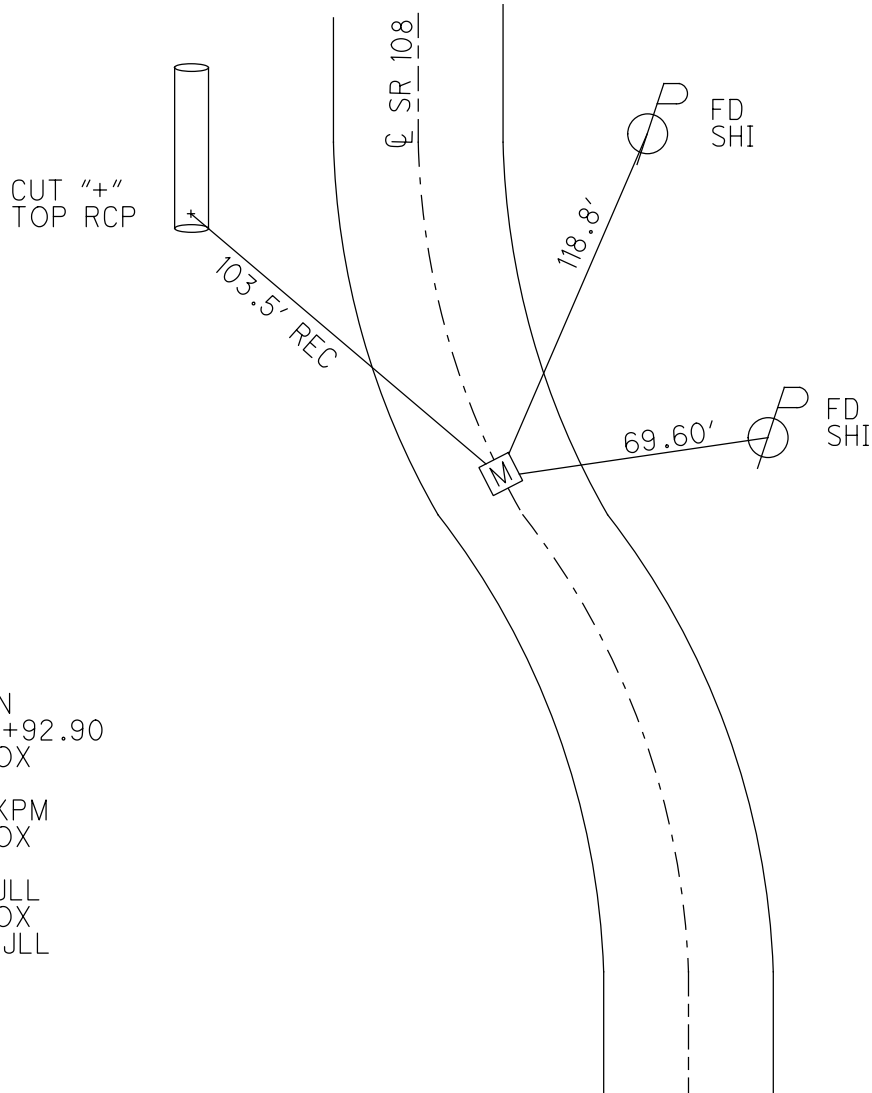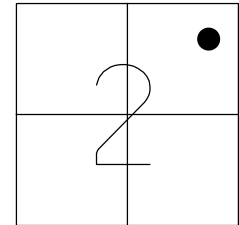

RECORD:
1966 PLAN
STA. 980+92.90
FD MONBOX
REFE69
8/2/01, KPM
FD MONBOX
REFE69
4/4/18, JLL
FD MONBOX
9/17/19, JLL

O.D.O.T. DISTRICT 2 SURVEY OFFICE (USE ONLY)

PERSONNEL

REFERENCE NO. 69 F

SHEET 9 OF 21

NOTES HUSS

DATE 4/15/09

ROUTE SR 108

H.C. CORDES

WEATHER CLOUDY

COUNTY HENRY

R.C. CORY

TEMP. 47°

TOWNSHIP NAPOLEON

SECTION 2

DWG BY NIESE PID 101211

T 5 N R 6 E

TYPE MONUMENT MONBOX W/1" IPIN

ON SURFACE - ~~BELOW~~ ON

OFFSET Q PAVEMENT 0.5' LT : ~~RT~~

12.3' TO LT EDGE PAVEMENT


STATION: 984+90.63

HORZ.DATUM: NAD83(2011)


GEOID: 2012A

GRID: NORTHING: 645464.818

EASTING: 1520458.025

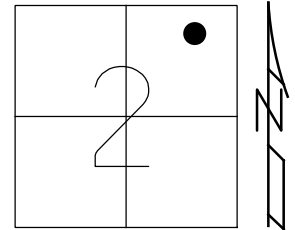

RECORD:
1966 PLAN
STA.984+92.90
FD MONBOX
REFF69
8/2/01, KPM
FD MONBOX
REFF69
4/4/18, JLL
FD MONBOX
9/17/19, JLL

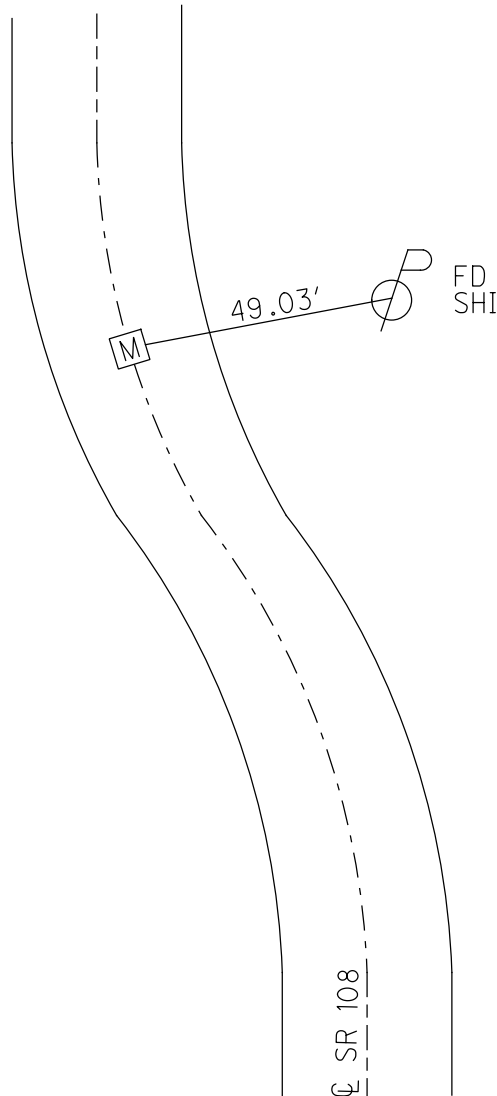

O.D.O.T. DISTRICT 2 SURVEY OFFICE (USE ONLY)

PERSONNEL

REFERENCE NO. 69 G

SHEET 10 OF 21

NOTES HUSS
H.C. CORDES
R.C. CORY

DATE 4/15/09
WEATHER CLOUDY
TEMP. 47°

ROUTE SR 108
COUNTY HENRY
TOWNSHIP NAPOLEON
SECTION 2
T 5 N R 6 E

DWG BY NIESE PID 101211

TYPE MONUMENT MONBOX W/1" IPIN

ON SURFACE - ~~BELOW~~ ON

OFFSET CL PAVEMENT ON LT : RT
12.3' TO RT EDGE PAVEMENT


STATION: 988+93.79

HORZ.DATUM: NAD83(2011)


GEOID: 2012A

GRID: NORTHING: 645858.088

EASTING: 1520369.242

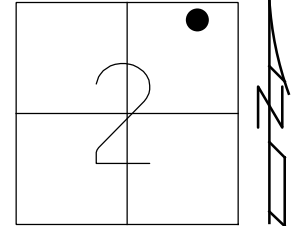

RECORD:
1966 PLAN
STA.988+97.19
FD MONBOX
REFG69
8/2/01, KPM
FD MONBOX
REFG69
4/4/18, JLL
FD MON BOX
9/17/19, JLL

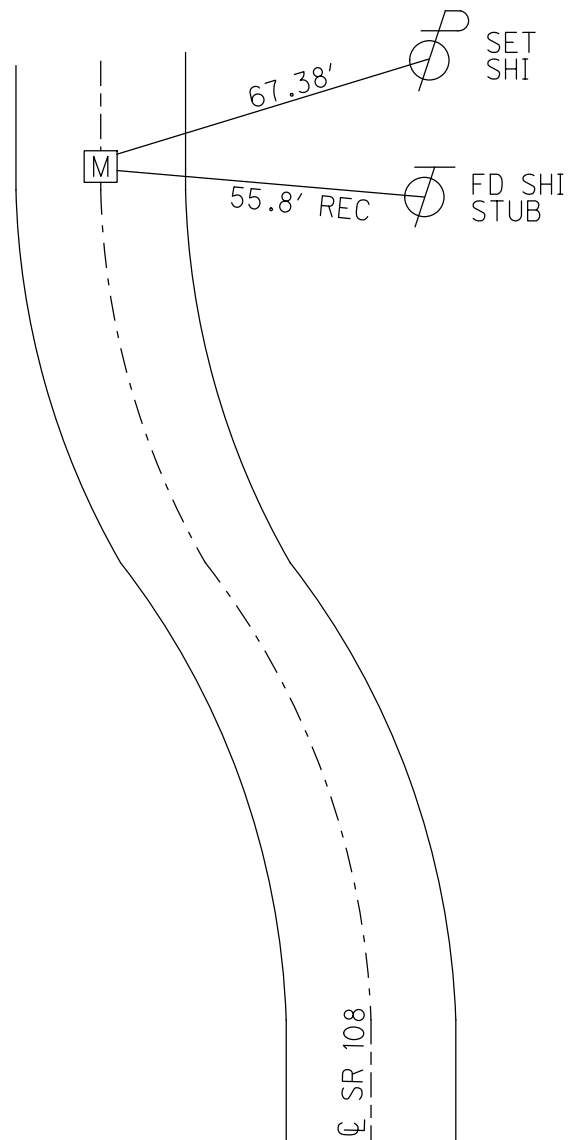

O.D.O.T. DISTRICT 2 SURVEY OFFICE (USE ONLY)

PERSONNEL

REFERENCE NO. 70

SHEET 11 OF 21

NOTES HUSS
H.C. CORDES
R.C. CORY

DATE 4/15/09
WEATHER CLOUDY
TEMP. 47°

ROUTE SR 108
COUNTY HENRY
TOWNSHIP FREEDOM
SECTION 35
T 6 N R 6 E

DWG BY NIESE PID 101211

TYPE MONUMENT MONBOX W/1" IPIN

ON SURFACE - ~~BELOW~~ ON

OFFSET $\perp$ PAVEMENT 11.5' LT : ~~RT~~
ON TO LT EDGE PAVEMENT


STATION: 989+64.99

HORZ.DATUM: NAD83(2011)

GEOID: 2012A


GRID: NORTHING: 645927.071

EASTING: 1520351.515

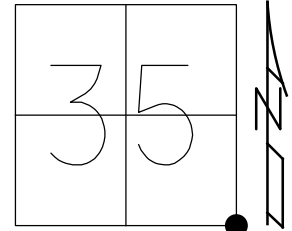

RECORD:
1966 PLAN
STA.989+66.2
FD MONBOX
2/6/08
FD MONBOX
REF70
4/4/18, JLL
FD MONBOX
9/17/19, JLL

RECORD:
FD R.R.SPIKE
@ SURFACE

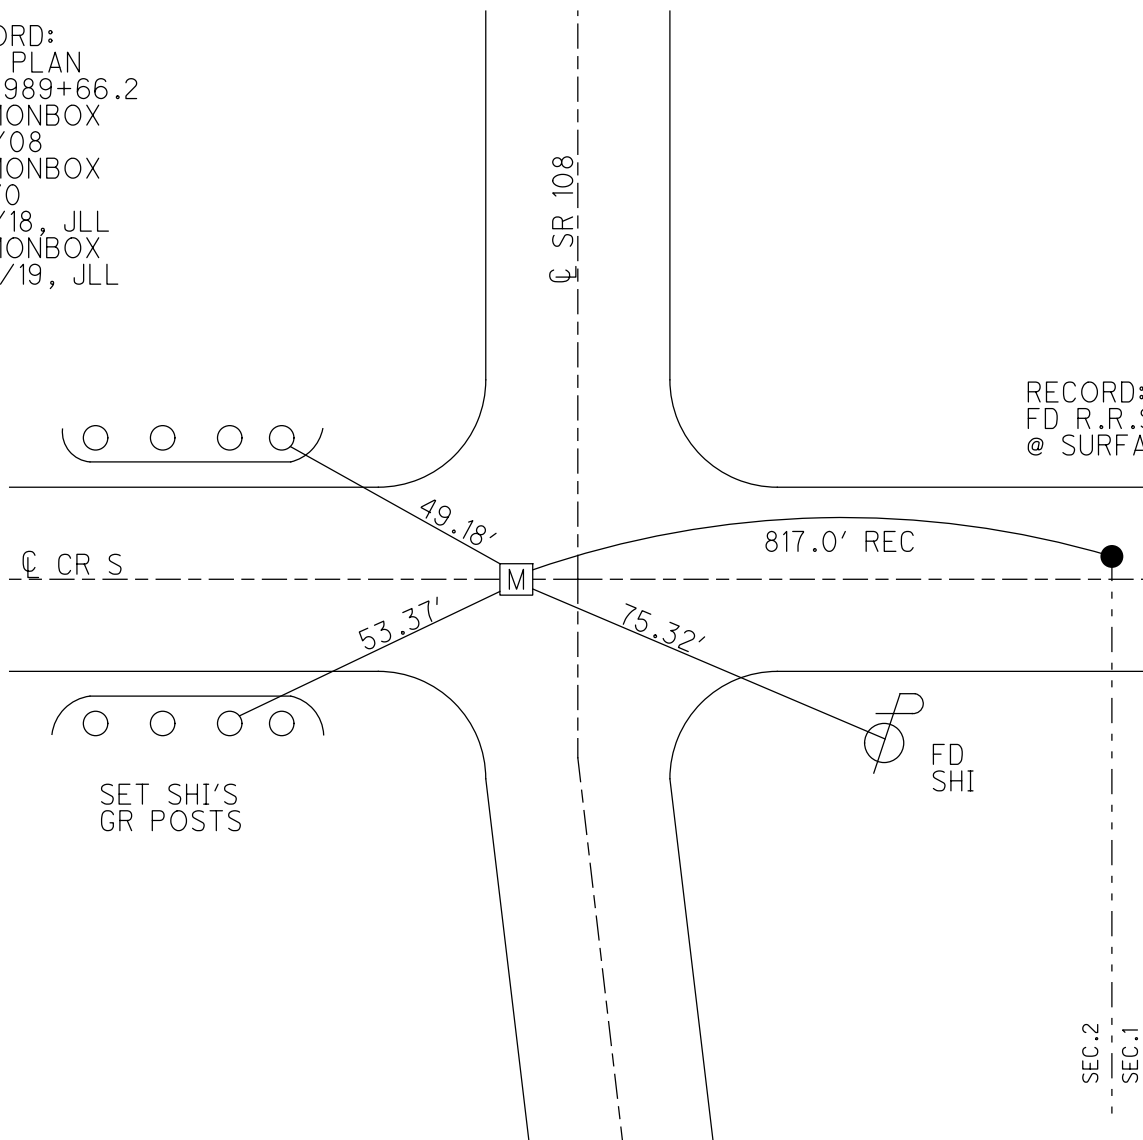

O.D.O.T. DISTRICT 2 SURVEY OFFICE (USE ONLY)

PERSONNEL

REFERENCE NO. 70 A

SHEET 12 OF 21

NOTES HUSS
H.C. CORDES
R.C. CORY

DATE 4/15/09
WEATHER CLOUDY
TEMP. 47°

ROUTE SR 108
COUNTY HENRY
TOWNSHIP FREEDON
SECTION 35
T 6 N R 6 E

DWG BY NIESE PID 101211

TYPE MONUMENT MONBOX W/1" IPIN

ON SURFACE - ~~BELOW~~ ON

OFFSET Q PAVEMENT ON LT : RT

11.9' TO RT EDGE PAVEMENT


STATION: 992+95.77

HORZ.DATUM: NAD83(2011)

GEOID: 2012A

GRID: NORTHING: 646257.755

EASTING: 1520362.254

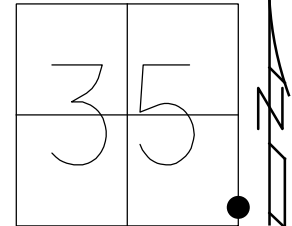

RECORD:
1966 PLAN
STA.992+97.19
FD MONBOX
2/6/08
FD MONBOX
REFA70
4/4/18, JLL
FD MONBOX
9/17/19, JLL

Q SR 108

M

118.8' REC

71.66'



FD
SHI



FD
SHI

O.D.O.T. DISTRICT 2 SURVEY OFFICE (USE ONLY)

PERSONNEL

REFERENCE NO. 71

SHEET 13 OF 21

NOTES AUBLE

DATE 3/28/18

ROUTE SR 108

H.C. LEU

WEATHER CLOUDY

COUNTY HENRY

R.C. AUBLE

TEMP. 43°F

TOWNSHIP FREEDOM

DWG BY NIESE PID 101211

SECTION 35

T 6 N R 6 E

TYPE MONUMENT MAG/WASHER

ON SURFACE - ~~BELOW~~ ON

OFFSET CL PAVEMENT 1.0' LT : ~~RT~~

10.4' TO LT EDGE PAVEMENT


STATION: 1016+08.09

HORZ.DATUM: NAD(83)2011


GEOID: 2012A

GRID: NORTHING: 648569.702

EASTING: 1520413.310

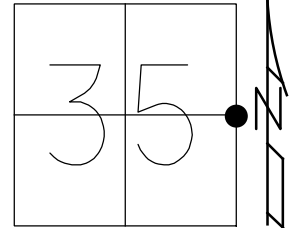

RECORD:
FD 1" IPIPE
3" DEEP
10/18/84, IRS
FD SQ.HEADED SPIKE
8/9/94, VD
SET P.K./WASHER
8/25/94, MB
FD P.K./WASHER
2/6/08
SET MAG/WASHER
9/4/09, SAH
FD MAG/WASHER
REF71
4/4/18, JLL
FD MAG/WASHER
9/17/19, JLL

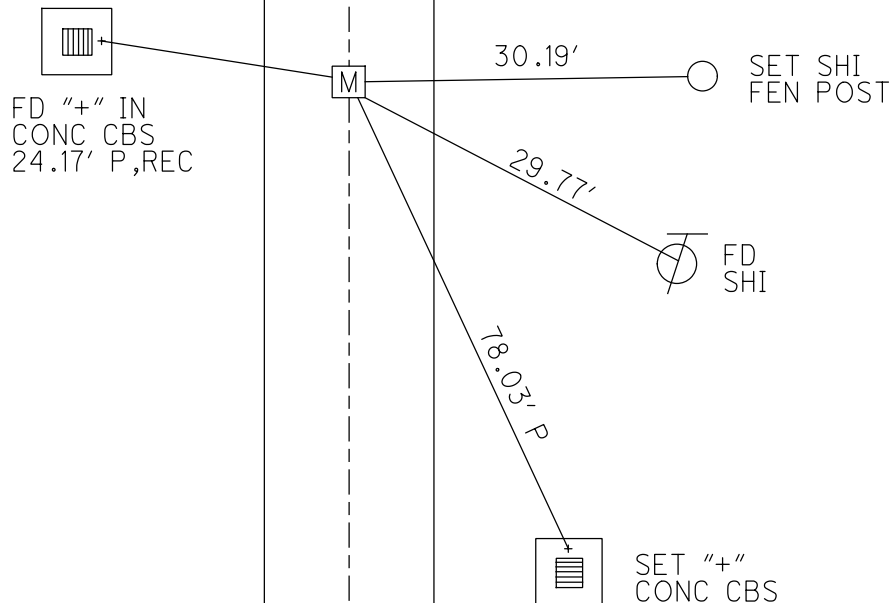

O.D.O.T. DISTRICT 2 SURVEY OFFICE (USE ONLY)

PERSONNEL

REFERENCE NO. 71 A

SHEET 14 OF 21

NOTES AUBLE

DATE 3/28/18

ROUTE SR 108

H.C. LEU

WEATHER CLOUDY

COUNTY HENRY

R.C. AUBLE

TEMP. 43°F

TOWNSHIP FREEDOM

DWG BY NIESE

PID 101211

SECTION 35

T 6 N R 6 E

TYPE MONUMENT MAG/WASHER

ON SURFACE - ~~BELOW~~ ON

OFFSET Q PAVEMENT 0.5' LT : ~~RT~~

11.0' TO LT EDGE PAVEMENT


STATION: 1029+20.69

HORIZ.DATUM: NAD83(2011)


GEOID: 2012A

GRID: NORTHING: 649881.634

EASTING: 1520443.966

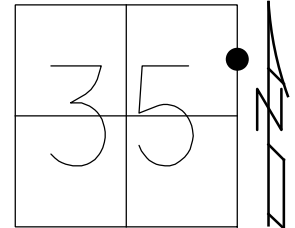

RECORD:
FD 3/4" IPIPE
3" DOWN
5/22/84, IRS
FD SQ.HEADED SPIKE
8/9/94, VD
SET P.K./WASHER
8/25/94, MB
FD P.K./WASHER
2/14/08
SET MAG/WASHER
9/4/09, SAH
FD MAG/WASHER
REFA71
4/4/18, JLL
FD MAG/WASHER
9/17/19, JLL

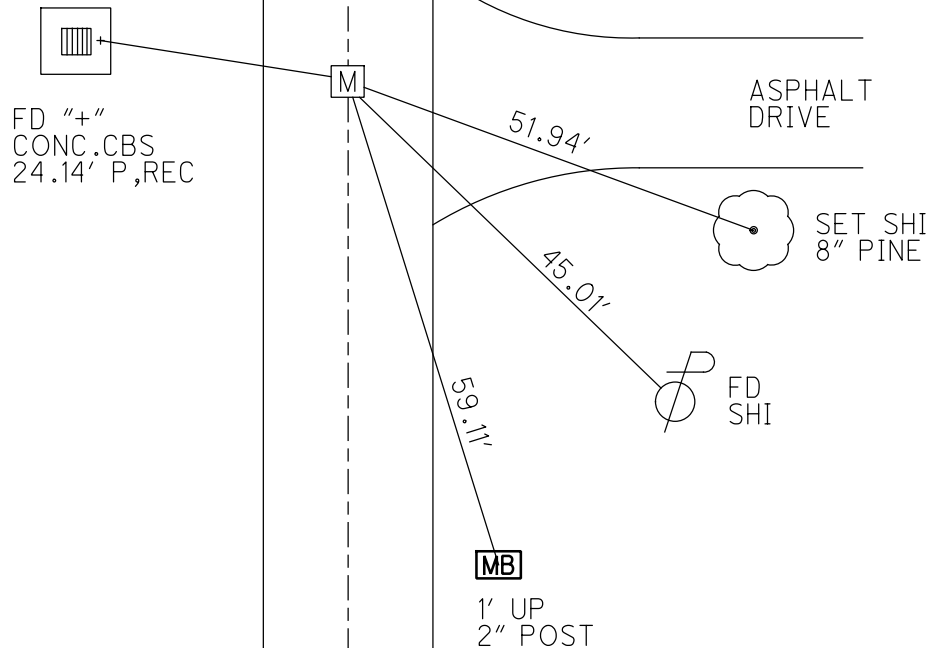

O.D.O.T. DISTRICT 2 SURVEY OFFICE (USE ONLY)

PERSONNEL

REFERENCE NO. 72

SHEET 15 OF 21

NOTES AUBLE

DATE 3/28/18

ROUTE SR 108

H.C. LEU

WEATHER CLDY-BREEZY

COUNTY HENRY

R.C. AUBLE

TEMP. 43°F

TOWNSHIP FREEDOM

DWG BY NIESE

PID 101211

SECTION 35

T 6 N R 6 E

TYPE MONUMENT MAG/WASHER

ON SURFACE - ~~BELOW~~ ON

OFFSET CL PAVEMENT 2.9' LT : ~~RT~~

8.7' TO LT EDGE PAVEMENT



STATION: 1042+32.09

HORZ.DATUM: NAD83(2011)

GEOID: 2012A

GRID: NORTHING: 651192.813

EASTING: 1520474.637

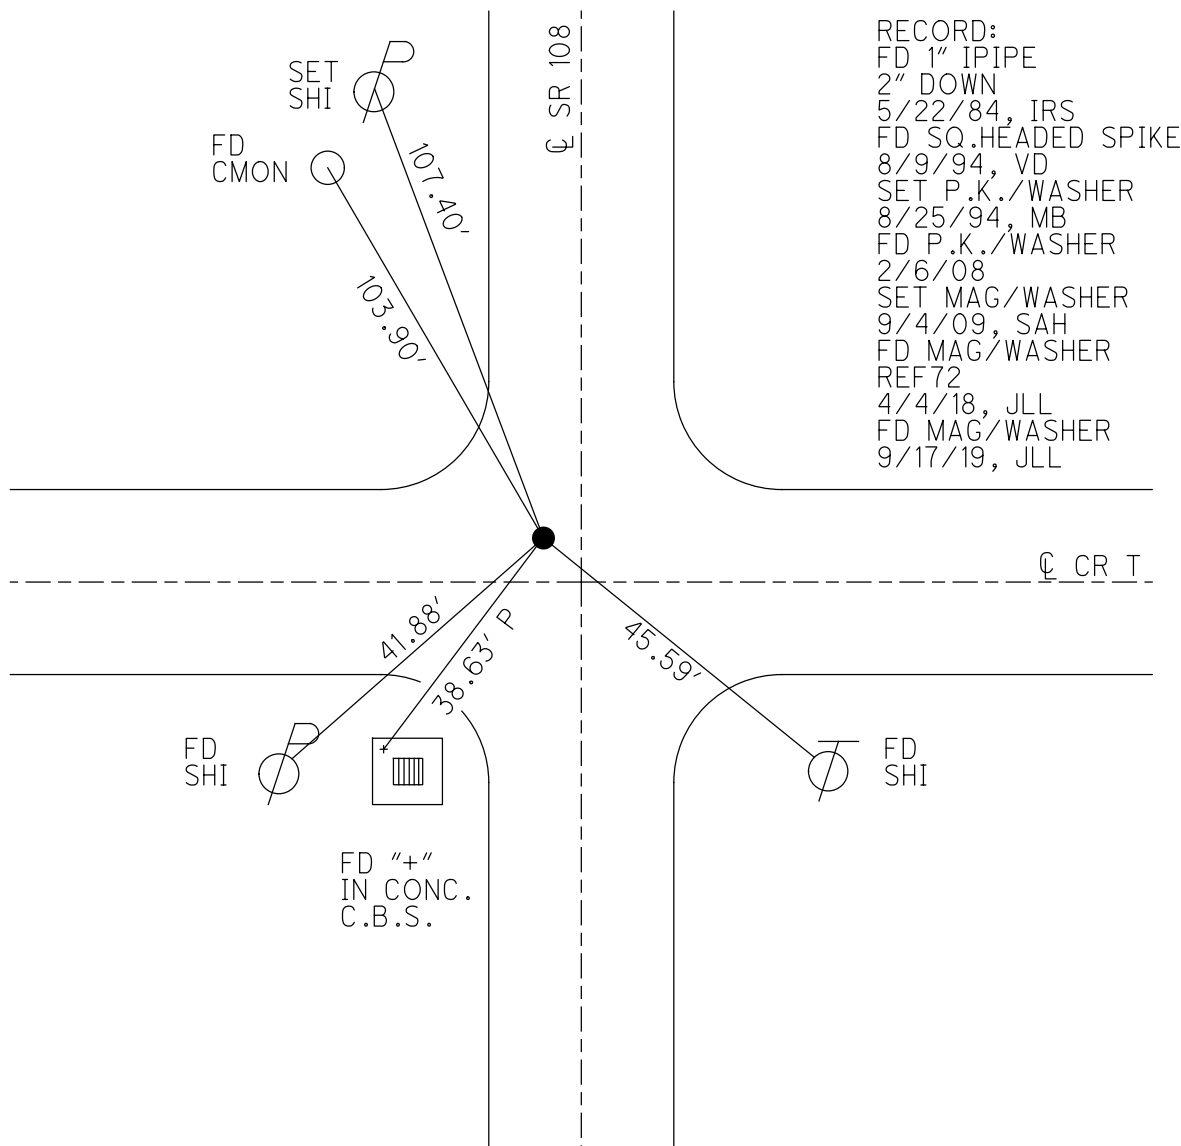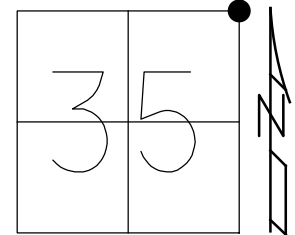

O.D.O.T. DISTRICT 2 SURVEY OFFICE (USE ONLY)

PERSONNEL

REFERENCE NO. 73

SHEET 16 OF 21

NOTES AUBLE

DATE 3/28/18

ROUTE SR 108

H.C. LEU

WEATHER CLOUDY

COUNTY HENRY

R.C. AUBLE

TEMP. 42°F

TOWNSHIP FREEDOM

DWG BY NIESE

PID 101211

SECTION 26

T 6 N R 6 E

TYPE MONUMENT MAG/WASHER

ON SURFACE - ~~BELOW~~ ON

OFFSET CL PAVEMENT 1.0' LT : ~~RT~~

10.9' TO LT EDGE PAVEMENT


STATION: 1068+77.87

HORIZ.DATUM: NAD83(2011)


GEOID: 2012A

GRID: NORTHING: 653837.684

EASTING: 1520543.696

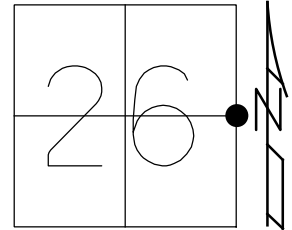

RECORD:
FD SM.SQ.HEADED SPIKE
8/9/94, VD
SET P.K./WASHER
8/25/94, MB
FD P.K./WASHER
2/6/08
SET MAG/WASHER
9/4/09, SAH
FD MAG/WASHER
REF73
4/4/18, JLL
FD MAG/WASHER
9/17/19, JLL

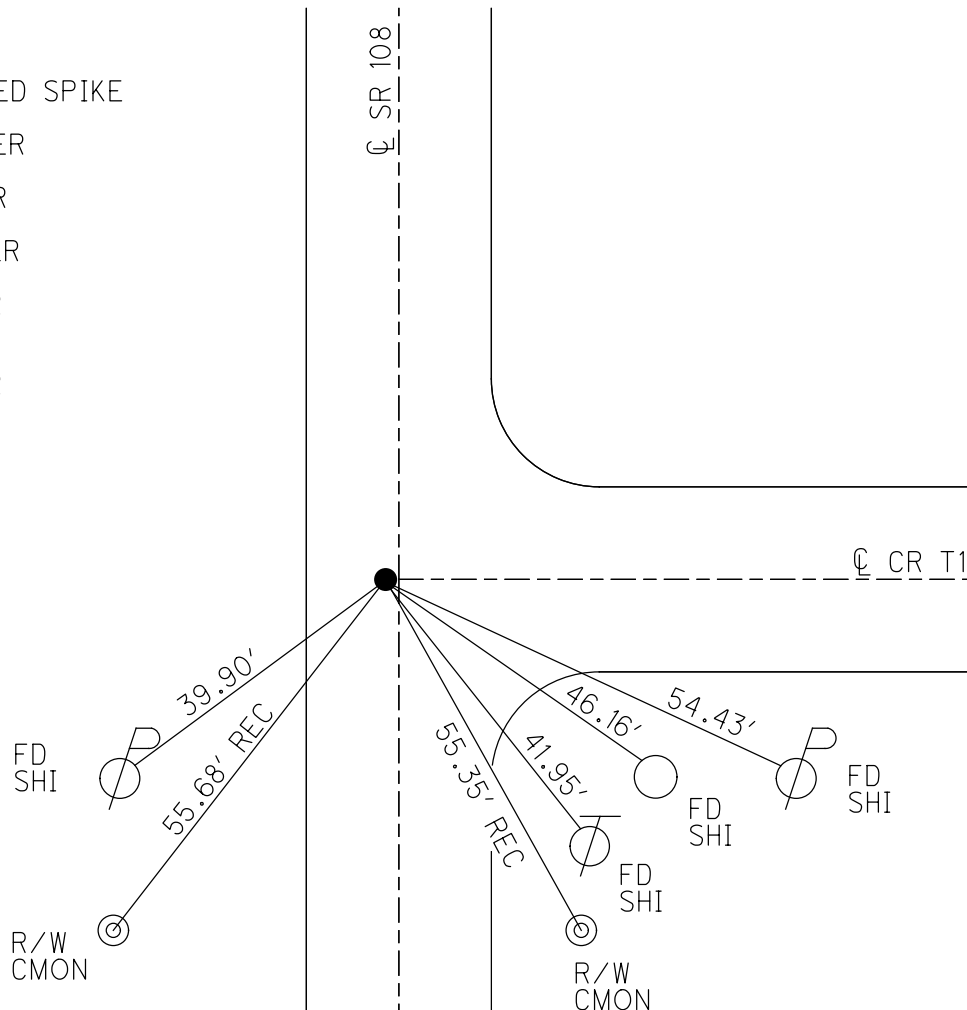

O.D.O.T. DISTRICT 2 SURVEY OFFICE (USE ONLY)

PERSONNEL

REFERENCE NO. 74

SHEET 17 OF 21

NOTES AUBLE

DATE 3/28/18

ROUTE SR 108

H.C. LEU

WEATHER CLOUDY

COUNTY HENRY

R.C. AUBLE

TEMP. 42°F

TOWNSHIP FREEDOM

DWG BY NIESE

PID 101211

SECTION 26

T 6 N R 6 E

TYPE MONUMENT MAG/WASHER

ON SURFACE - ~~BELOW~~ ON

OFFSET CL PAVEMENT 1.3' LT : ~~RT~~

10.0' TO LT EDGE PAVEMENT



STATION: 1095+25.9

HORZ.DATUM: NAD83(2011)

GEOID: 2012A

GRID: NORTHING: 656485.118

EASTING: 1520598.236

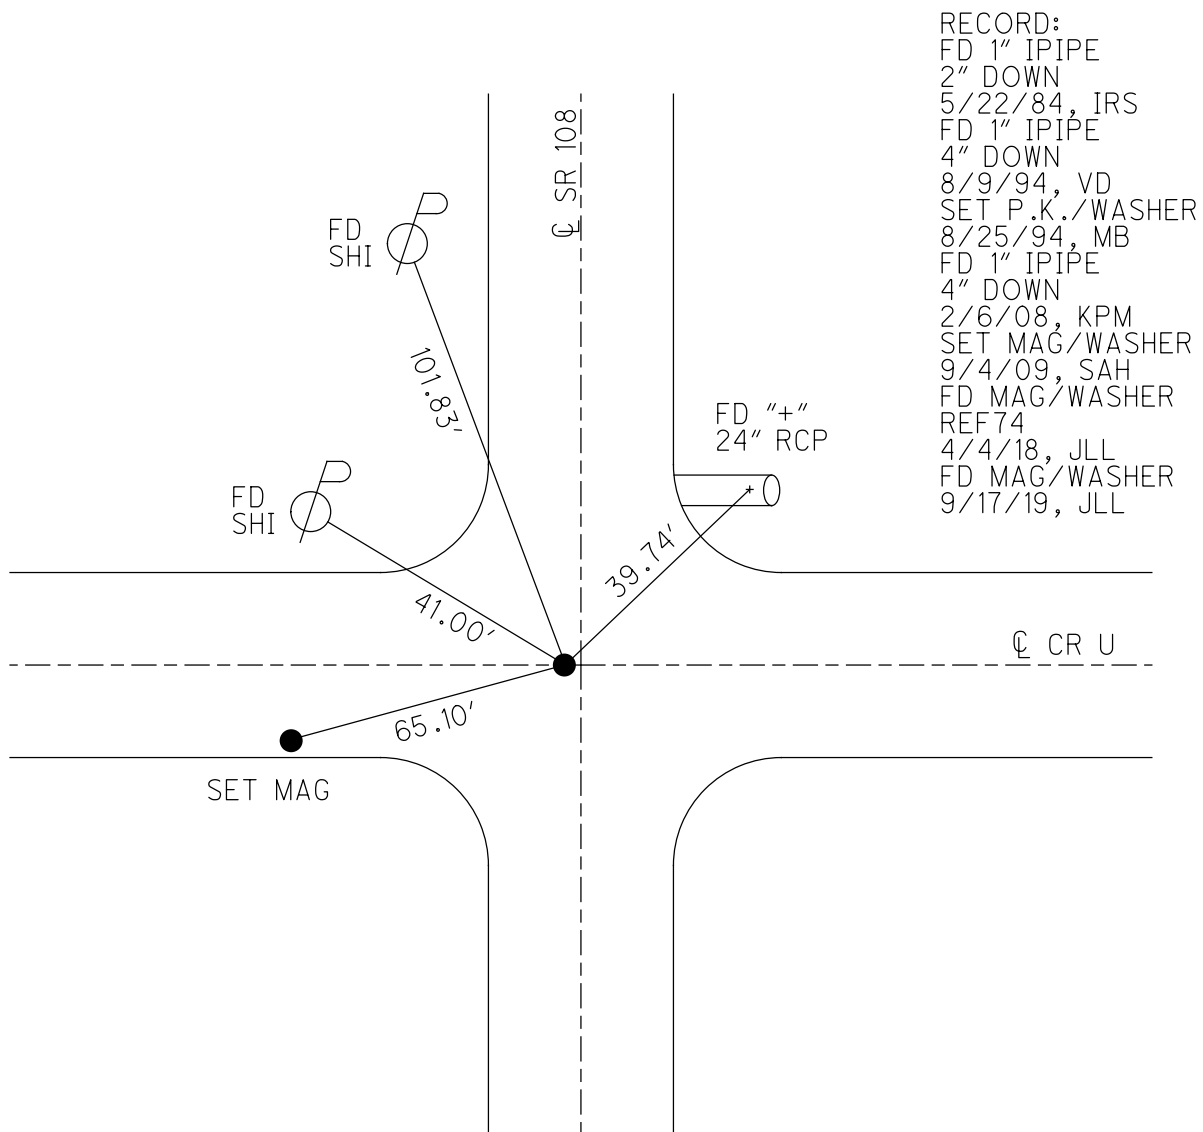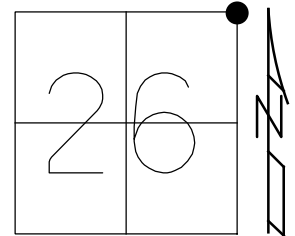

RECORD:
FD 1" IPIPE
2" DOWN
5/22/84, IRS
FD 1" IPIPE
4" DOWN
8/9/94, VD
SET P.K./WASHER
8/25/94, MB
FD 1" IPIPE
4" DOWN
2/6/08, KPM
SET MAG/WASHER
9/4/09, SAH
FD MAG/WASHER
REF74
4/4/18, JLL
FD MAG/WASHER
9/17/19, JLL

O.D.O.T. DISTRICT 2 SURVEY OFFICE (USE ONLY)

PERSONNEL

REFERENCE NO. 75

SHEET 18 OF 21

NOTES AUBLE

DATE 3/28/18

ROUTE SR 108

H.C. LEU

WEATHER CLOUDY

COUNTY HENRY

R.C. AUBLE

TEMP. 42°F

TOWNSHIP FREEDOM

DWG BY NIESE PID 101211

SECTION 23

T 6 N R 6 E

TYPE MONUMENT MAG NAIL

ON SURFACE - ~~BELOW~~ ON

OFFSET Q PAVEMENT ON LT : RT

11.5' TO LT EDGE PAVEMENT


STATION: 1121+72.05

HORZ.DATUM: NAD83(2011)


GEOID: 2012A

GRID: NORTHING: 659130.847

EASTING: 1520644.656

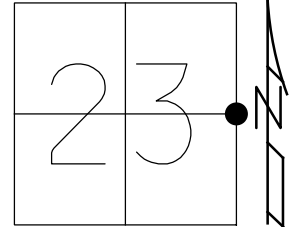

RECORD:
FD 1" IPIPE
5/22/84, IRS
FD SQ.HEADED SPIKE
8/9/94, VD
SET P.K./WASHER
8/25/94, MB
FD P.K./WASHER
2/6/08, KPM
SET MAG/WASHER
9/4/09, SAH
FD MAG NAIL
REF75
4/4/19, JLL
FD MAG/WASHER
9/17/19, JLL

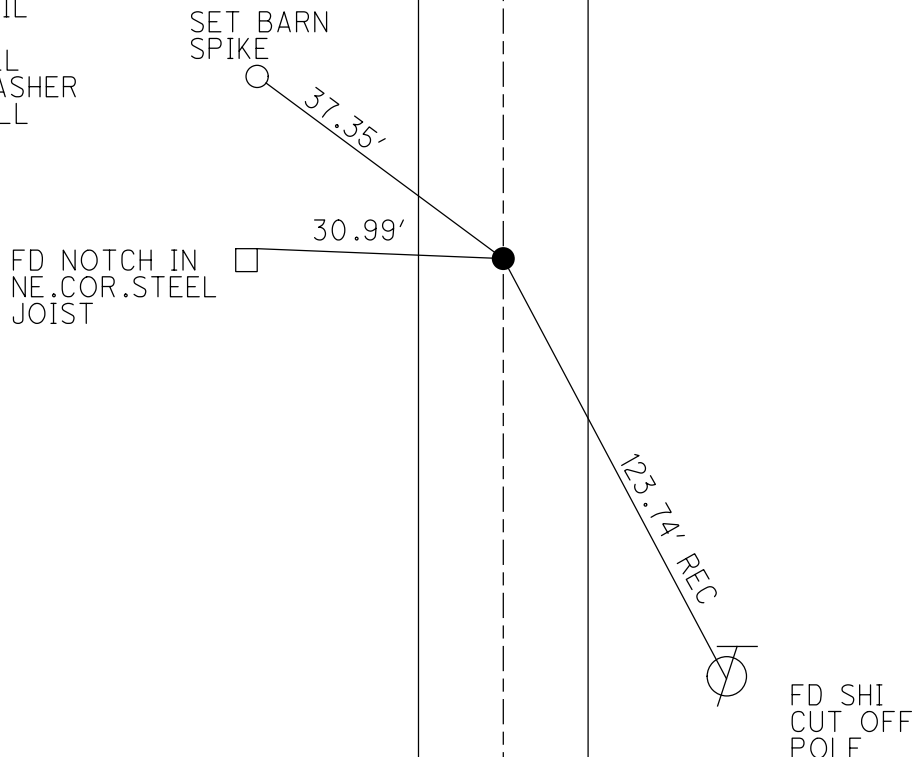

O.D.O.T. DISTRICT 2 SURVEY OFFICE (USE ONLY)

PERSONNEL

REFERENCE NO. 76

SHEET 19 OF 21

NOTES AUBLE

DATE 4/02/18

ROUTE SR 108

H.C. LEU

WEATHER CLEAR

COUNTY HENRY

R.C. AUBLE

TEMP. 34°F

TOWNSHIP FREEDOM

SECTION 23

DWG BY NIESE PID 101211

T 6 N R 6 E

TYPE MONUMENT MAG SHANK

ON SURFACE - ~~BELOW~~ ON

OFFSET 0.7' LT : ~~RT~~

10.7' TO LT EDGE PAVEMENT


STATION: 1148+14.31

HORZ.DATUM: NAD83(2011)


GEOID: 2012A

GRID: NORTHING: 661772.822

EASTING: 1520683.721

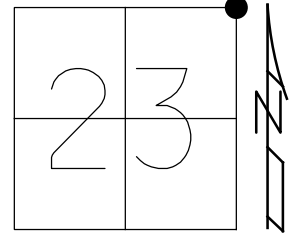

RECORD:
FD SQ.HEADED SPIKE
8/9/94, VD
SET P.K./WASHER
8/25/94, MB
FD P.K./WASHER
2" DOWN
2/15/08, KPM
SET MAG/WASHER
9/4/09, SAH
FD MAG SHANK
REF76
4/4/18, JLL
FD MAG SHANK
9/17/19, JLL

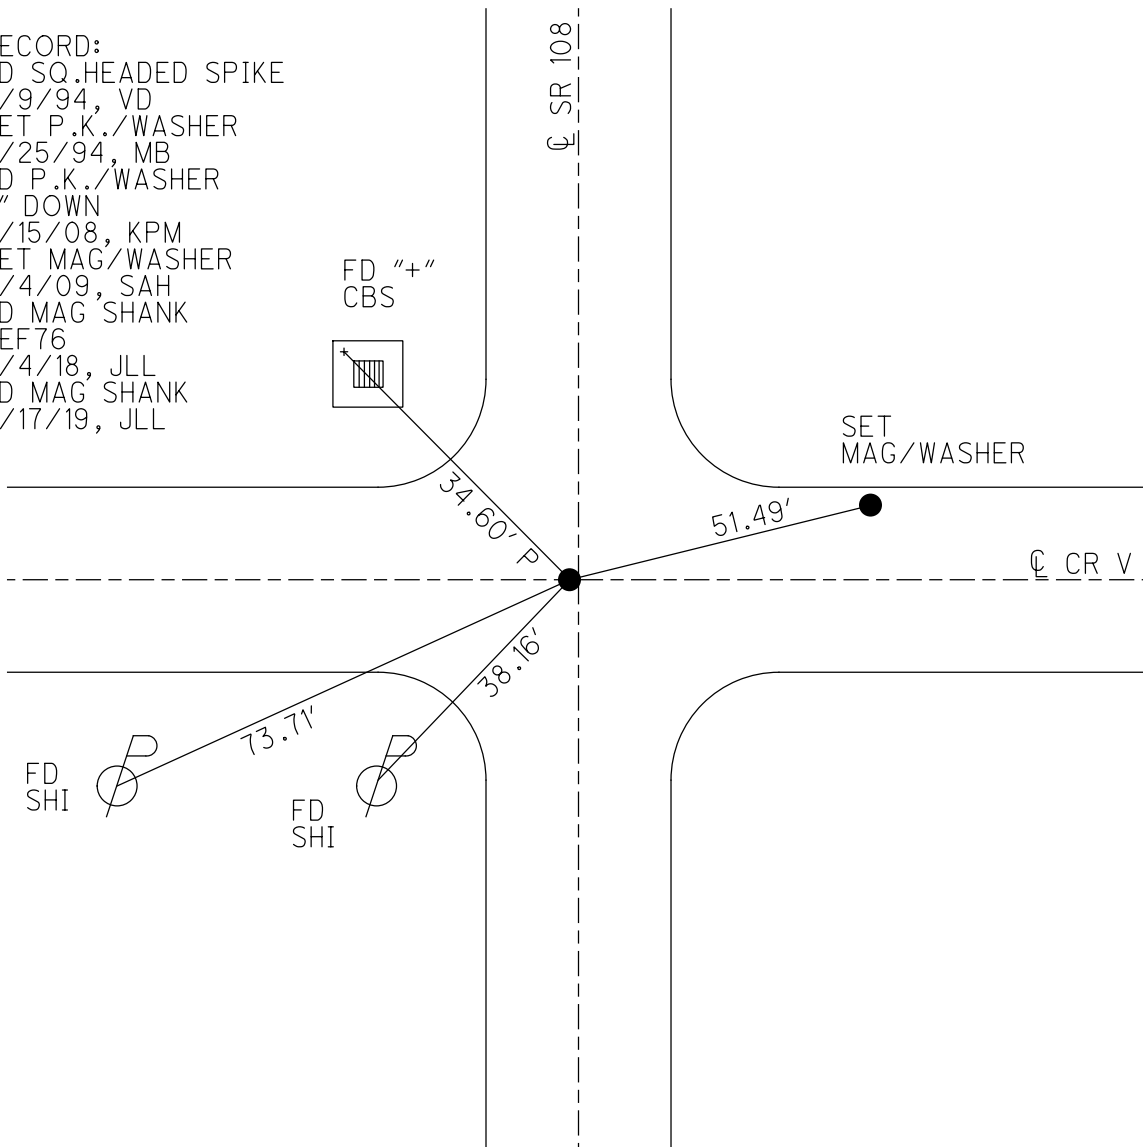

O.D.O.T. DISTRICT 2 SURVEY OFFICE (USE ONLY)

PERSONNEL

REFERENCE NO. 77

SHEET 20 OF 21

NOTES AUBLE

DATE 4/02/18

ROUTE SR 108

H.C. LEU

WEATHER CLEAR

COUNTY HENRY

R.C. AUBLE

TEMP. 34°F

TOWNSHIP FREEDOM

SECTION 14

DWG BY NIESE

PID 101211

T 6 N R 6 E

TYPE MONUMENT MAG/WASHER

ON SURFACE - ~~BELOW~~ ON

OFFSET Q PAVEMENT 2.5' LT : ~~RT~~

9.0' TO LT EDGE PAVEMENT


STATION: 1174+56.32

HORZ.DATUM: NAD83(2011)


GEOID: 2012A

GRID: NORTHING: 664414.703

EASTING: 1520719.676

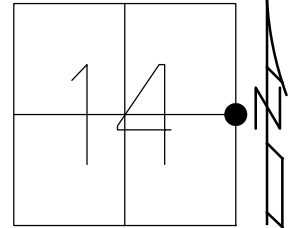

RECORD:
FD 1" IPIPE
2" DOWN
5/22/84, IRS
FD P.K.NAIL
8/9/94, VD
SET P.K./WASHER
8/25/94, MB
FD P.K./WASHER
2/6/08
SET MAG/WASHER
9/4/09, SAH
FD MAG/WASHER
REF77
4/4/18, JLL
FD MAG/WASHER
9/17/19, JLL

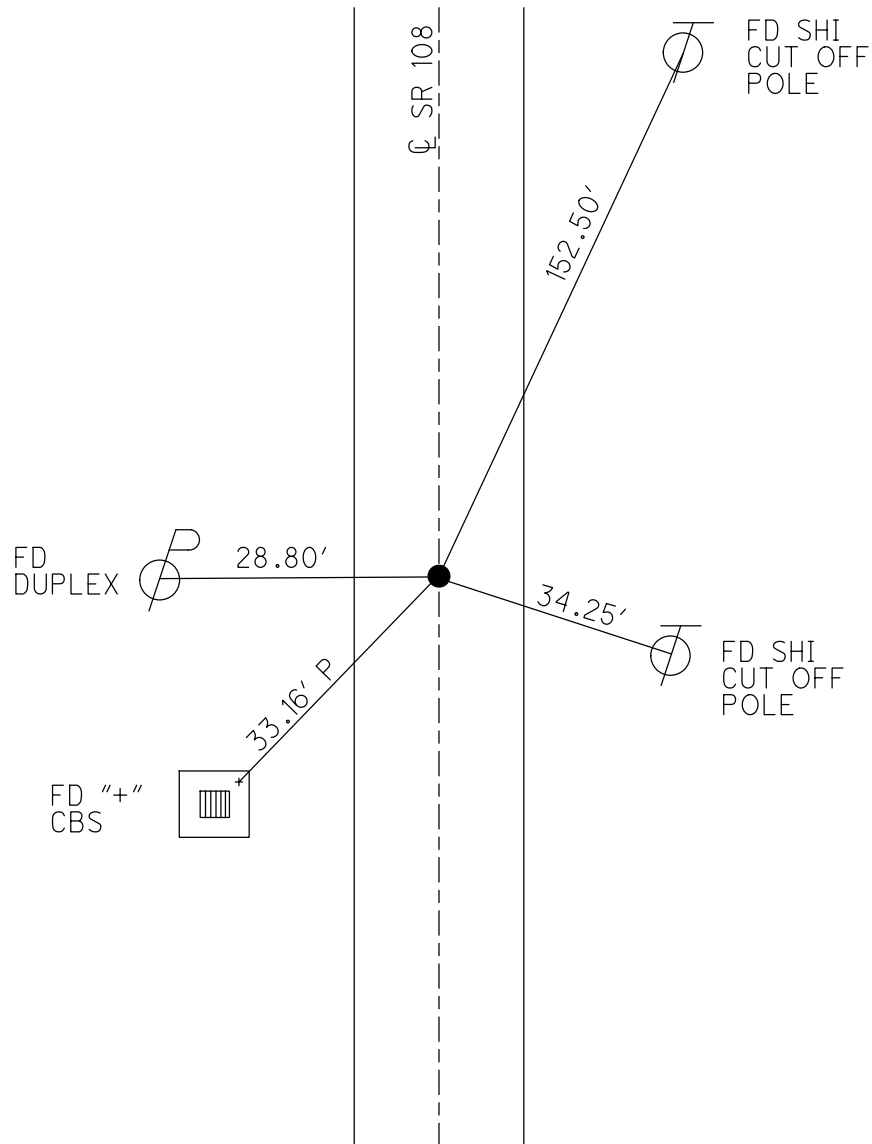

O.D.O.T. DISTRICT 2 SURVEY OFFICE (USE ONLY)

PERSONNEL

REFERENCE NO. 77 A

SHEET 21 OF 21

NOTES AUBLE

DATE 4/2/18

ROUTE SR 108

H.C. LEU

WEATHER CLEAR

COUNTY HENRY

R.C. AUBLE

TEMP. 34°F

TOWNSHIP FREEDOM

SECTION 14

DWG BY NIESE

PID 101211

T 6 N R 6 E

TYPE MONUMENT P.K./WASHER

ON SURFACE - ~~BELOW~~ ON

OFFSET Q PAVEMENT 4.7' LT : ~~RT~~

7.5' TO LT EDGE PAVEMENT



STATION: 1200+98.24

HORZ.DATUM: NAD83(2011)

GEOID: 012A

GRID: NORTHING: 667055.983

EASTING: 1520771.846

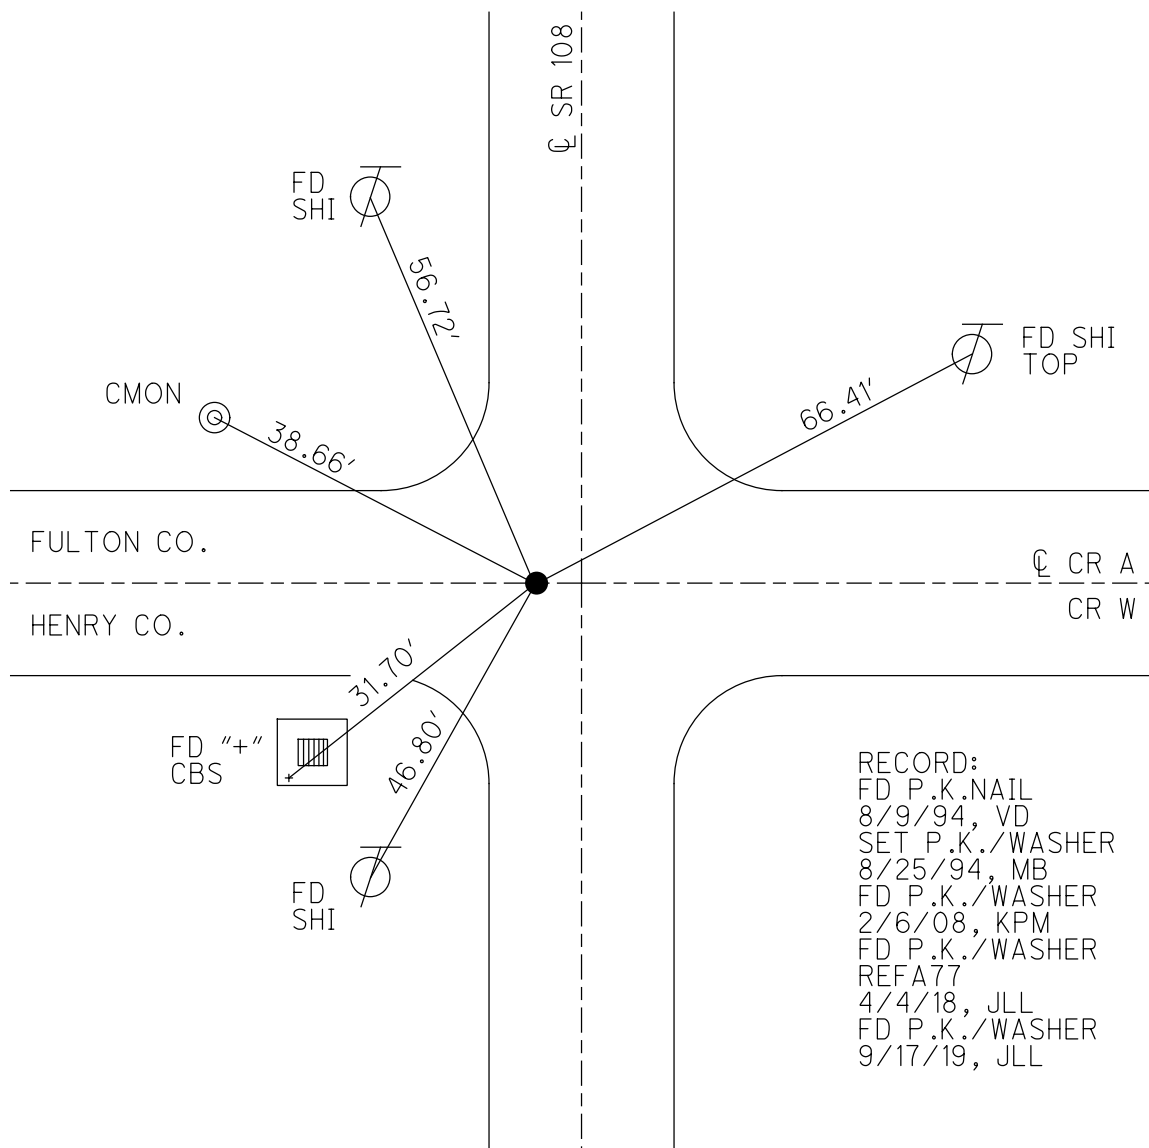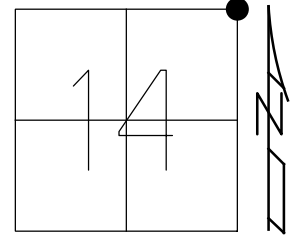

RECORD:
FD P.K.NAIL
8/9/94, VD
SET P.K./WASHER
8/25/94, MB
FD P.K./WASHER
2/6/08, KPM
FD P.K./WASHER
REFA77
4/4/18, JLL
FD P.K./WASHER
9/17/19, JLL