

O.D.O.T. DISTRICT 2 SURVEY OFFICE (USE ONLY)

PERSONNEL

REFERENCE NO.

9 C

SHEET

12

OF 25

NOTES

CANTERBURY

DATE

05-07-1998

ROUTE

SR 109

H.C.

CANTERBURY

WEATHER

CLOUDY

COUNTY

HENRY

R.C.

ROUSOS

TEMP.

65°

TOWNSHIP

MARION

SECTION

10

T 3 N R 7 E

TYPE MONUMENT PK


ON SURFACE - ~~BELOW~~ ON

~~LEFT - C~~ PAV'T - ~~RIGHT~~ ON


16.3 TO LT EDGE FACE OF CURB

S.L.M. 226+95

Grid: Northing: _____ Easting: _____

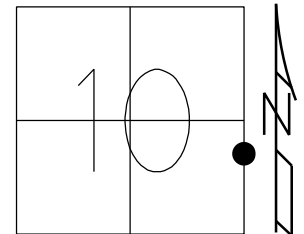

PK NAIL
RESET BY UNKNOWN
CHECKED - GOOD
09-23-1998
D.N.F.
DUG 10" DOWN
4/3/24-JAM

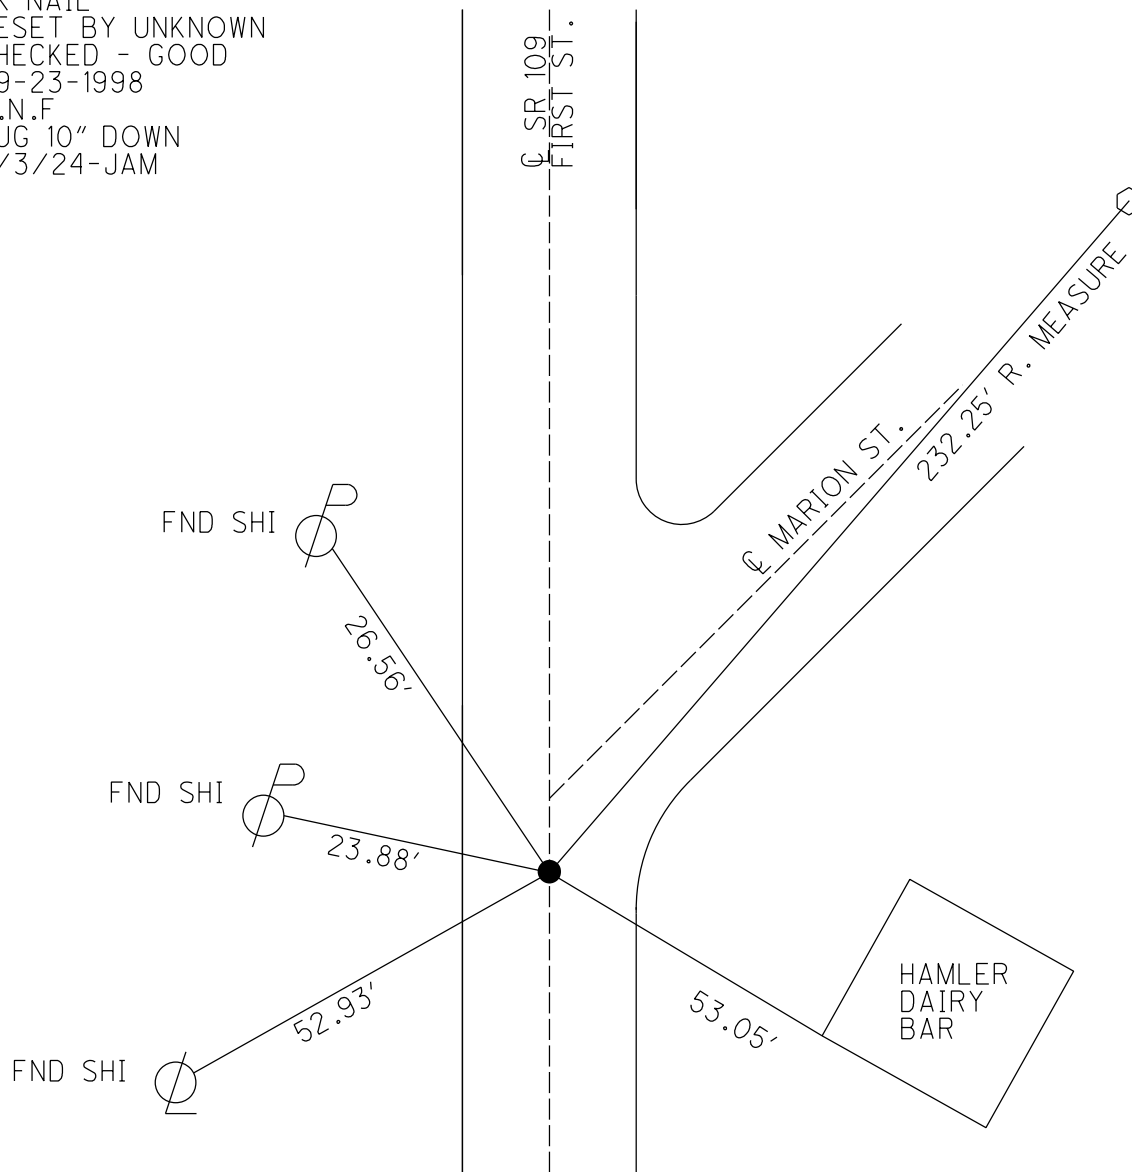

O.D.O.T. DISTRICT 2 SURVEY OFFICE (USE ONLY)

PERSONNEL

REFERENCE NO.

9 C

SHEET

12

OF 26

NOTES

CANTERBURY

DATE

05-07-1998

ROUTE

SR 109

H.C.

CANTERBURY

WEATHER

CLOUDY

COUNTY

HENRY

R.C.

ROUSOS

TEMP.

65°

TOWNSHIP

MARION

SECTION

10

T 3 N R 7 E

TYPE MONUMENT

PK

ON SURFACE - ~~BELOW~~

ON


~~LEFT~~ - C PAV'T - ~~RIGHT~~ ON

16.3 TO LT EDGE FACE OF CURB


S.L.M. 226+95

Grid: Northing:

Easting:

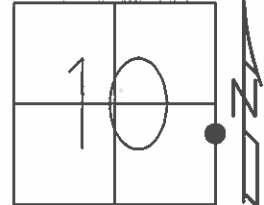

PK NAIL
RESET BY UNKNOWN
CHECKED - GOOD
09-23-1998

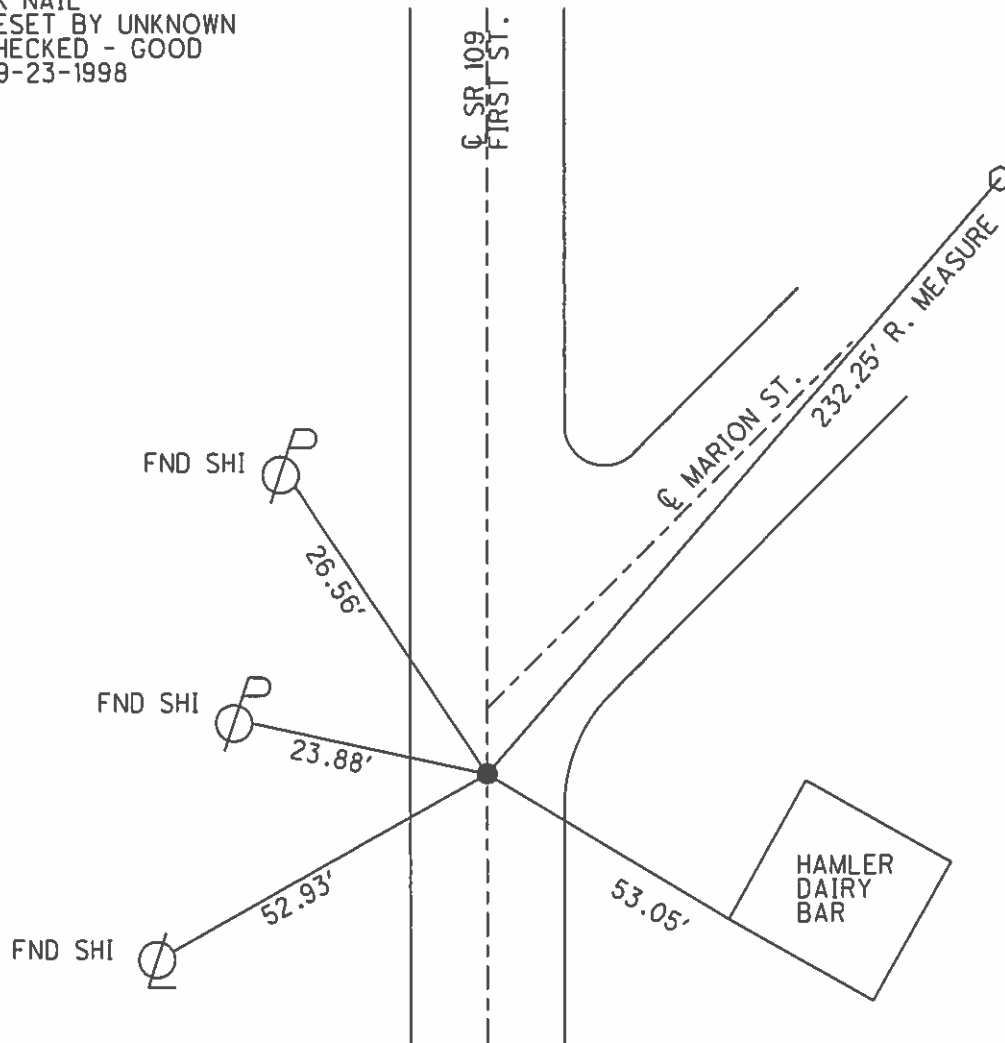

O.D.O.T. DISTRICT 2 SURVEY OFFICE

PERSONNEL

REFERENCE NO. 9-C

SHEET 11 OF 21

NOTES CANTERBURY

H.C. CANTERBURY

R.C. ROUSSEAU

DATE 5-7-98

WEATHER CLOUDY

TEMP. 65°

ROUTE 109

COUNTY HENRY

TOWNSHIP MARION

SECTION 10

T3 N R 7 E


TYPE MONUMENT P.K.

ON SURFACE - ~~BELOW~~ ON SURFACE

LEFT - CL PAV'T. - RIGHT

16.3 TO LT. EDGE PAVEMENT EDGE FACE OF CURB

S.L.M. 226.95 SLK (226+95 SLM)

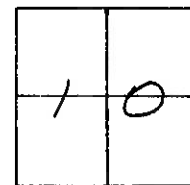

P.K. NAIL
RESET BY UNKNOWN
CHECKED - GOOD
9-23-98

SR 109
First St.

Point MARION ST.
232.25' R-MEAS.

FIND SHI E/S

26.56'

SET SHI E/S

23.88'

FIND '4' NE/S
1' UP STEEL POLE

52.93'

Point

HAMLER
DAIRY
BAR

DRAWN BY: TR

O.D.O.T. DISTRICT 2 SURVEY OFFICE

PERSONNEL

REFERENCE NO. 9-C

SHEET 11 OF

NOTES BARNHISEL

H.C.

R.C. HOFFMAN

DATE 3-29-89

WEATHER cloudy - windy

TEMP. +44°

ROUTE 109

COUNTY HENRY

TOWNSHIP MARION

SECTION 10

T 3 N R 1 E


TYPE MONUMENT P.K. & WASHER

ON SURFACE - BELOW YES

LEFT - Q PAV'T. - RIGHT E PAV'T OF S.R. 109 & MARION ST.

14.7 TO LT. EDGE PAVEMENT

S.L.M. 226+95

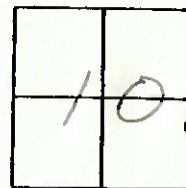

Set & Sm RE Spk
6-23-89
mdd

FO. SHI E/S 26.68

FO. SHI E/S 23.58

FO. "t" NE/S 1' UP
STEEL POLE 52.91

S.R. 109
FIRST ST.

Q PAV'T

Q PAV'T MARION ST.
- 232.25 RE MEAS.

Sm RE Spk
Belton

53.04

HAMLER
DAIRY
BAR

USE BOTTOM
OF 3RD BLOCK UP.

Q.D.O.T. DISTRICT 2 SURVEY OFFICE

SHEET _____ OF _____

County HENRY S.R. 109

Township MARION

Section 10 1st HAMLER

T3N, R7E

Personnel HOFFMAN

LOEHRKE


BARNHISEL

#9-C

Date April 19, 83

Weather CLEAR

Temp. +30°

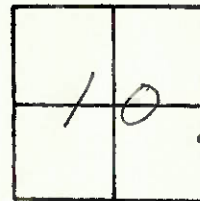

Fd PK Nail 1" below surface

Set By BURNSIDE 11-7-73


ON & PAUTS

14.8 TO W. EP, SR 109

SLM 226 + 52

SET P.K./WASHER

9-19-83 SWH

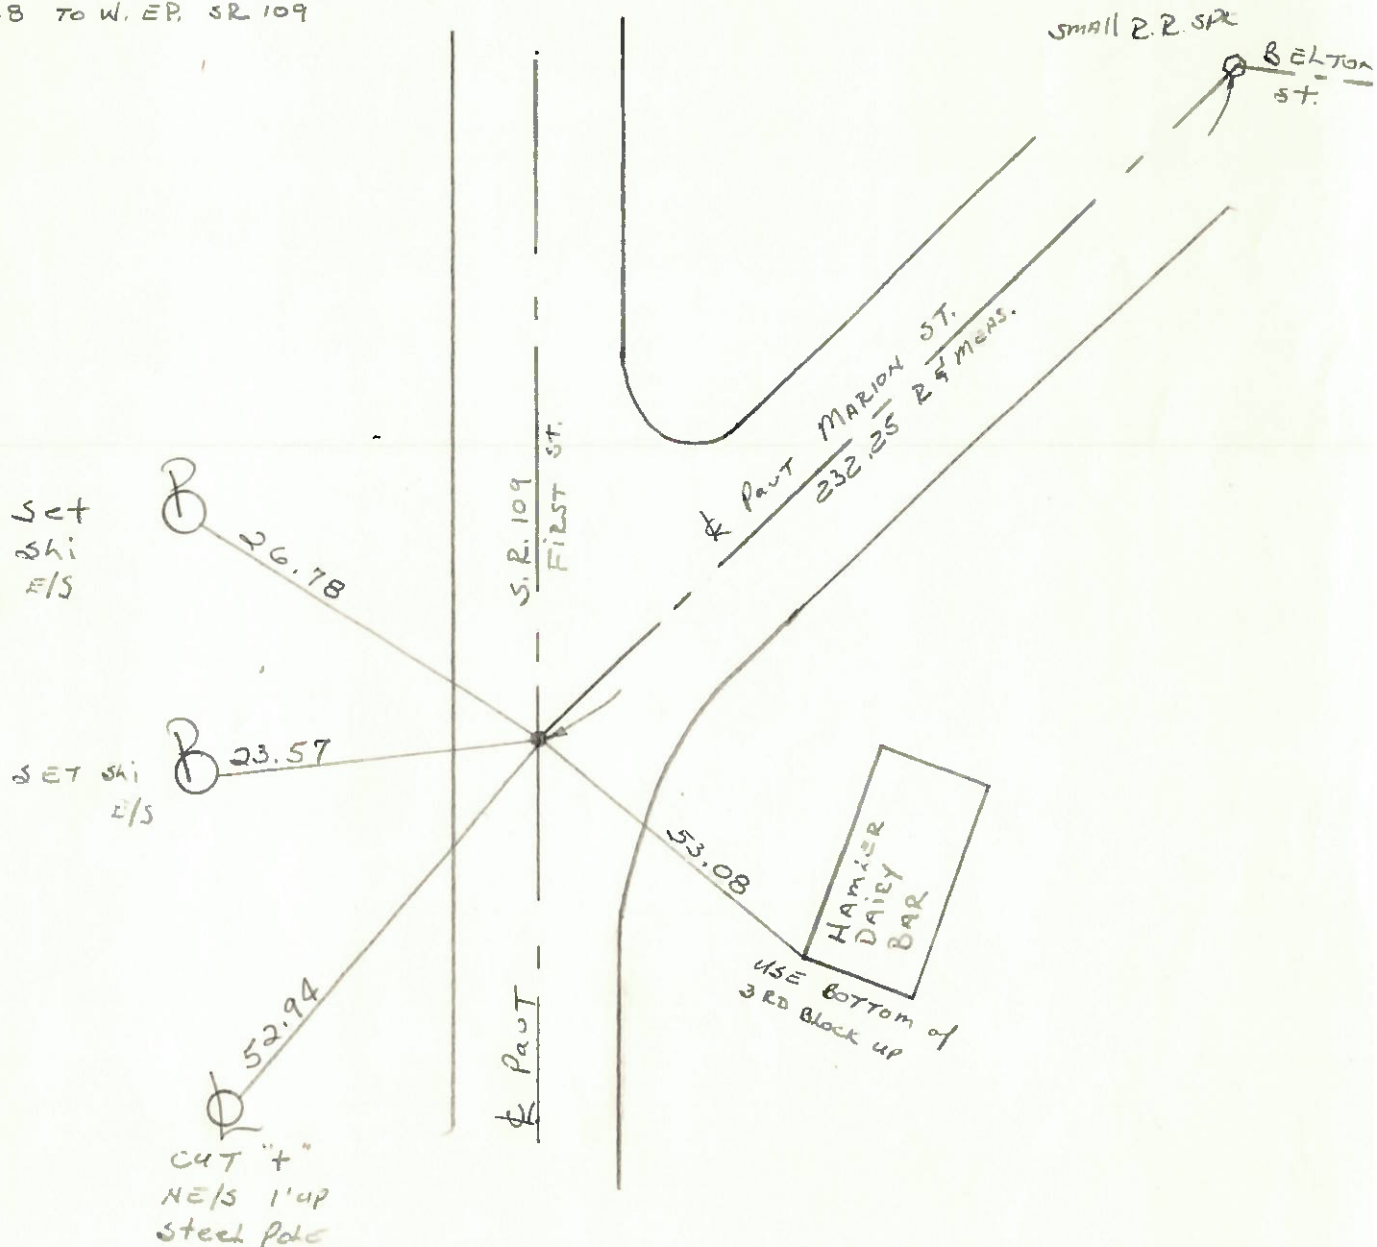

OD.O.T. DISTRICT 2 SURVEY OFFICE

Sht. 8 of 8

County HENRY

Township MARION

Section HAMLER, OHIO

T3N, R7E

Personnel BURNSIDE

SMITH

KNAPE

MEAD

Date 5-22-79

OK
4/19/83
S.W.H.

Weather CLEAR

Temp. +54°



NOTE: FBINTS FOUND ON MARION ST. PREVIOUS TO RESURFACING

SHI. IN
24" MAPLE

54.32'

53.68'

RANDOLPH ST.

"+" TOP STONE
CURB

FD. 1" IRON ROD
2" DEEP

(SMALL R.R. SPK @ SURFACE)

29.66'

35.69'

SHI. IN 18"
MAPLE

NEAR EDGE
6" STEEL LIGHT
POLE
(+" 1' UP)

MARION ST.

56.24'

NEAR EDGE
6" STEEL LIGHT
POLE
(+" 1' UP)

BELTON ST.

BOTTOM BRICK

33.72'

1" IRON ROD

35.60'

SHI. IN 28"
MAPLE

64.59'

FIRE
STATION

BOTTOM BRICK

FD. 1" IRON
ROD 2" DEEP

(FD. SMALL R.R. SPK
@ SURFACE)

DATE 11-7-73

TEMP. +42°

JOB NO. 028280

SEC

LEFT

CENTER LINE

RIGHT

