

O.D.O.T. DISTRICT 2 SURVEY OFFICE (USE ONLY)

PERSONNEL

REFERENCE NO.

9 D

SHEET

15

OF 25

NOTES CANTERBURY

DATE 05-05-1998

ROUTE SR 109

H.C. CANTERBURY

WEATHER CLOUDY

COUNTY HENRY

R.C. ROUSOS

TEMP. 65°

TOWNSHIP MARION

SECTION 10

T 3 N R 7 E

TYPE MONUMENT PK & WASHER


ON SURFACE - ~~BELOW~~ ON

~~LEFT - C PAV'T - RIGHT~~ ON C 109 - 20' S OF C BALTIMORE

15.2' TO LT EDGE PAVEMENT


S.L.M. 233+79

Grid: Northing: _____ Easting: _____

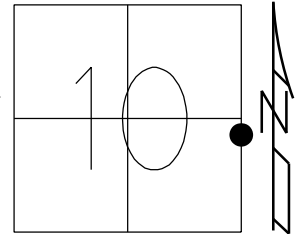

REC: P.O.T.
SLM 233+19.66

DID NOT FIND
05-08-1998
DNF
11/29/21 - DSA

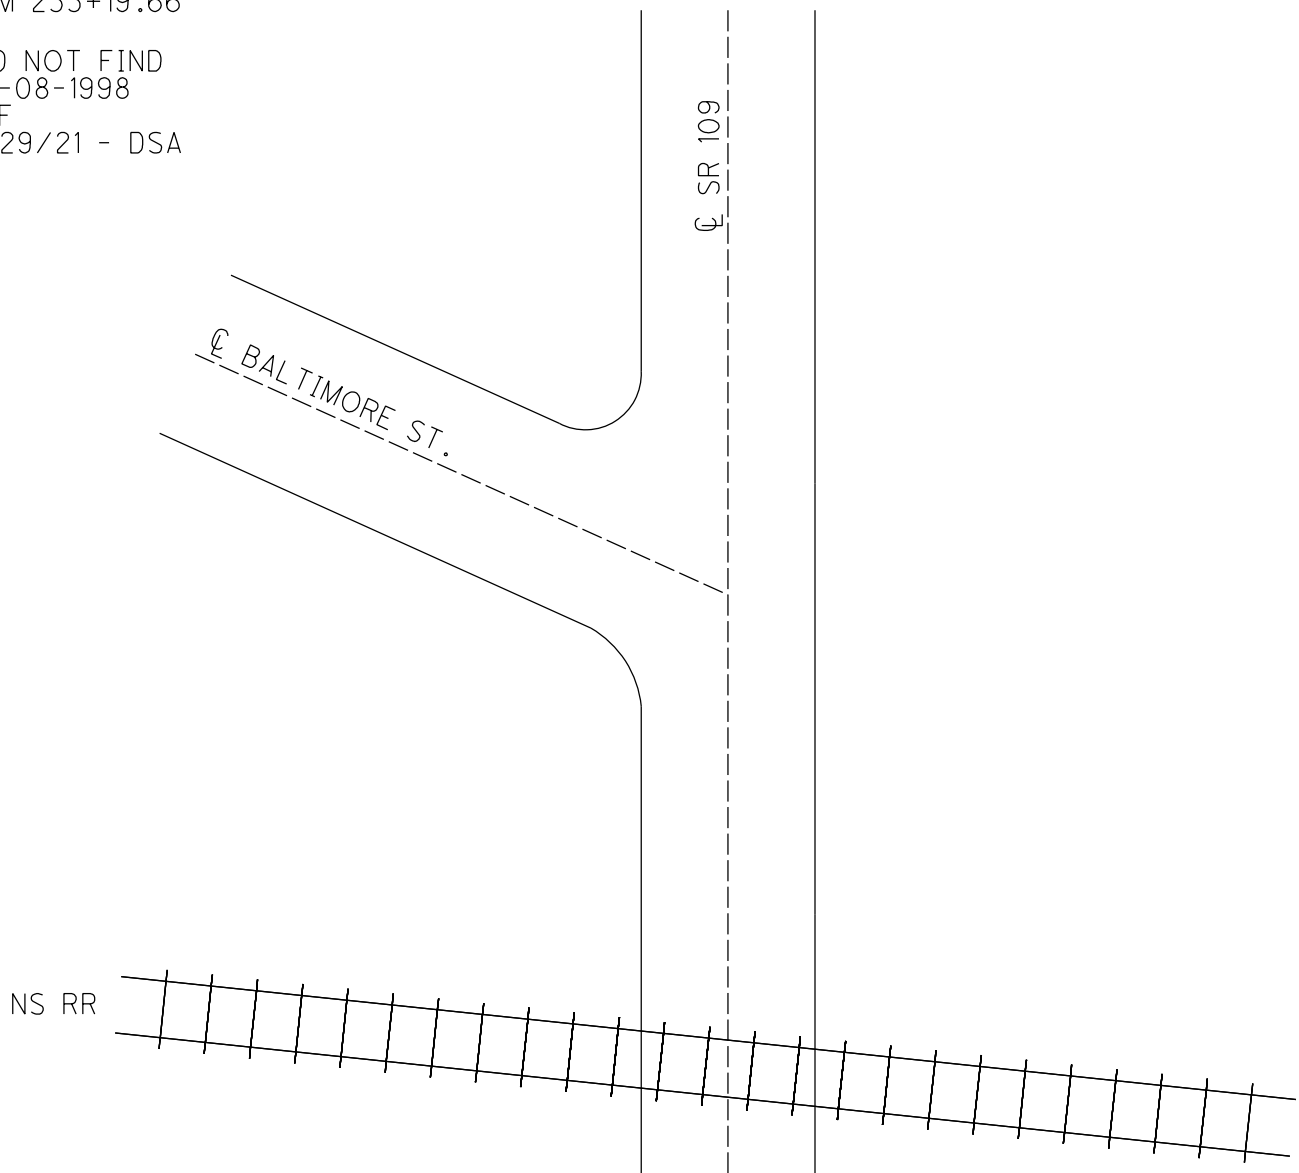

O.D.O.T. DISTRICT 2 SURVEY OFFICE (USE ONLY)

PERSONNEL

REFERENCE NO.

9 D

SHEET

15

OF 26

NOTES CANTERBURY

DATE 05-05-1998

ROUTE SR 109

H.C. CANTERBURY

WEATHER CLOUDY

COUNTY HENRY

R.C. ROUSOS

TEMP. 65°

TOWNSHIP MARION

SECTION 10

T 3 N R 7 E

TYPE MONUMENT PK & WASHER


ON SURFACE - ~~BELOW~~ ON

~~LEFT~~ - ℄ PAV'T - ~~RIGHT~~ ON ℄ 109 - 20' S OF ℄ BALTIMORE

15.2' TO LT EDGE PAVEMENT


S.L.M. 233+79

Grid: Northing: _____ Easting: _____

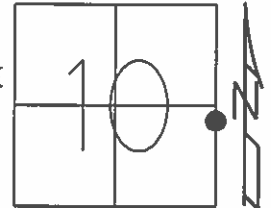

REC: P.O.T.
SLM 233+19.66

DID NOT FIND
05-08-1998

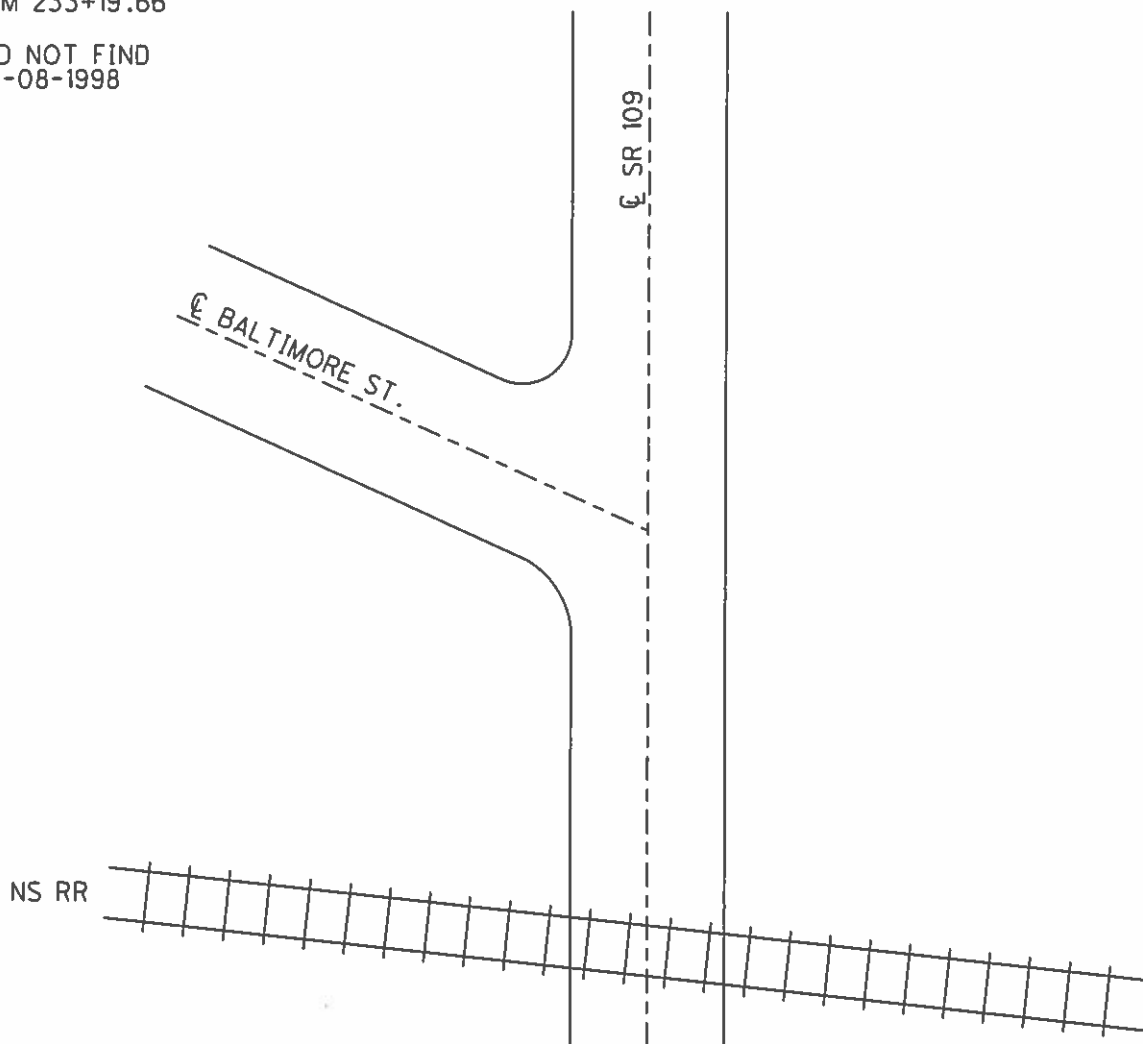

O.D.O.T. DISTRICT 2 SURVEY OFFICE

PERSONNEL

REFERENCE NO. 9-D

SHEET 12 OF 21

NOTES Canterbury

H.C. Canterbury

R.C. Roush

DATE 5-8-98

WEATHER cloudy

TEMP. 65'

ROUTE 109

COUNTY HENRY

TOWNSHIP MARION

SECTION 10


T3 N R 7 E

TYPE MONUMENT PK & WASHER

ON SURFACE - BELOW

LEFT - & PAU'T. - RIGHT ON & 109 20'S of & Part of
15.2 TO LT EDGE PAVEMENT OF PAVED PERM BALTIMORE ST.

S.L.M. 233+79

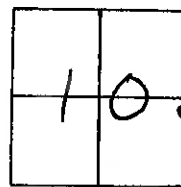

RECORD: P.O.T.

SLM 233+19.66

DID NOT FIND
5-8-98

S.R. 109

E PAU'T

BALTIMORE ST.

& PAU'T

NS RR

O.D.O.T. DISTRICT 2 SURVEY OFFICE

PERSONNEL

REFERENCE NO. 9-D

SHEET 12 OF

NOTES BRENTHISEL

H.C. _____

R.C. HOFFMAN

DATE 3-29-89

WEATHER cloudy-windy

TEMP. +44°

ROUTE 109

COUNTY HEWRY

TOWNSHIP MARIONSECTION 10



T 3 N R 7 E

TYPE MONUMENT P.H. WASHER

ON SURFACE - ~~BELOW~~ _____

LEFT - & PAV'T. - RIGHT ON E 109 20' 50" OF E PAVT OF
15.2 TO LT. EDGE PAVEMENT OF PAVED BERM BALTIMORE

S.L.M. 233+79

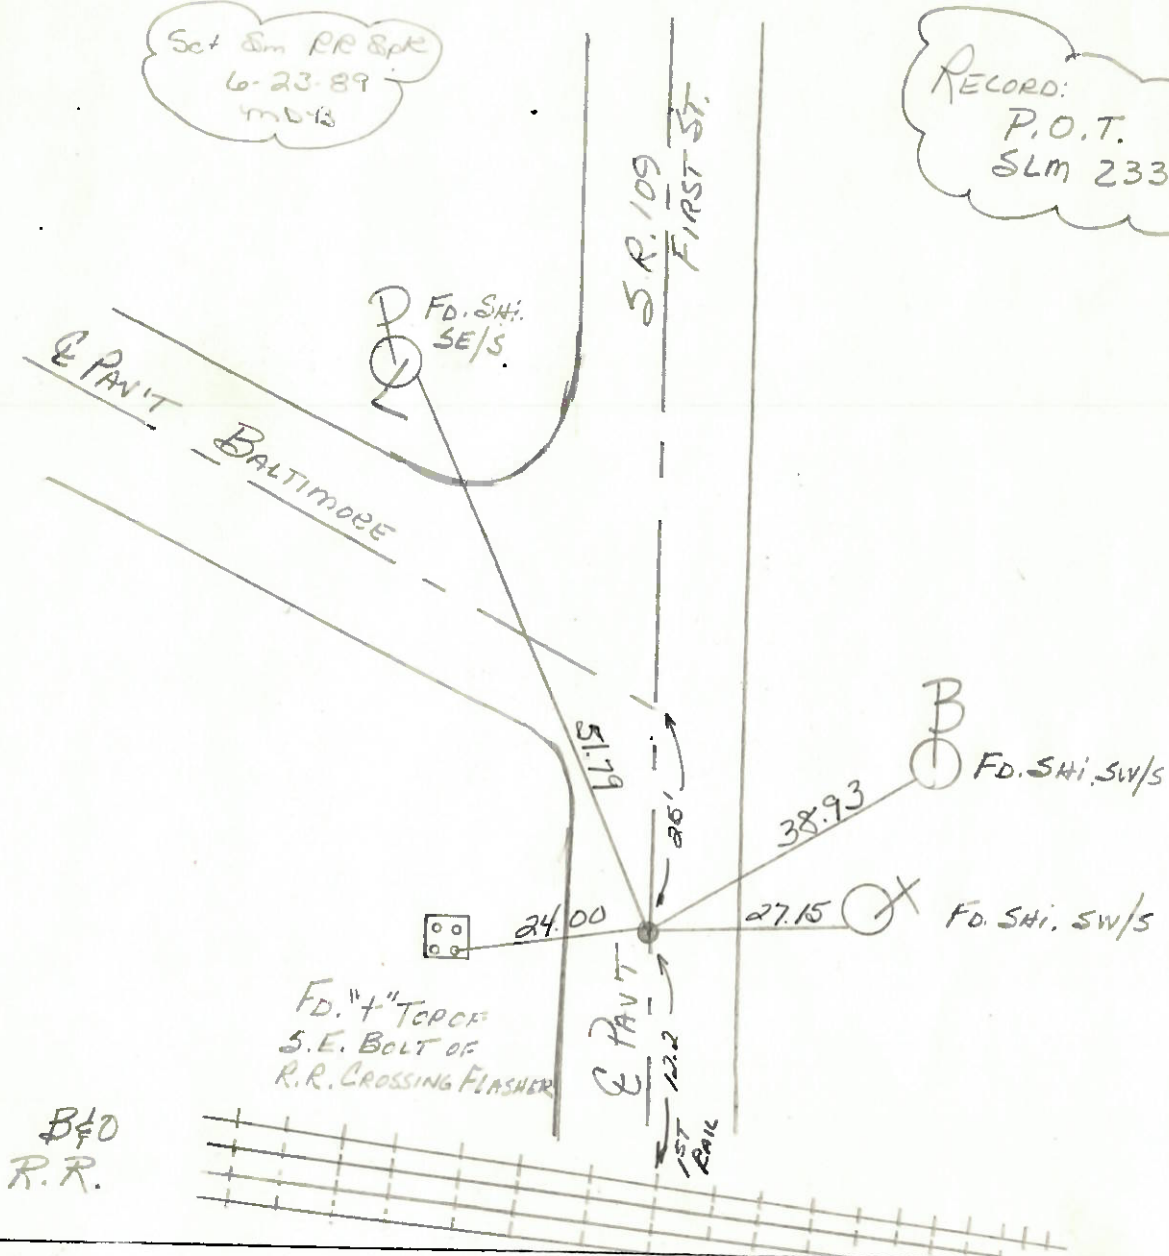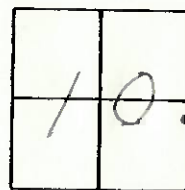

SHEET _____ OF _____

Date April 19, 83

Weather Clear

Temp. +34°

1	0
---	---

4

ЛОЕНРКЕ

BARNHISEL

BARNHISEL


Fig-D

S. L. M. 233 + 36

Record:

P. O. T.

SLM 233 + 19.66

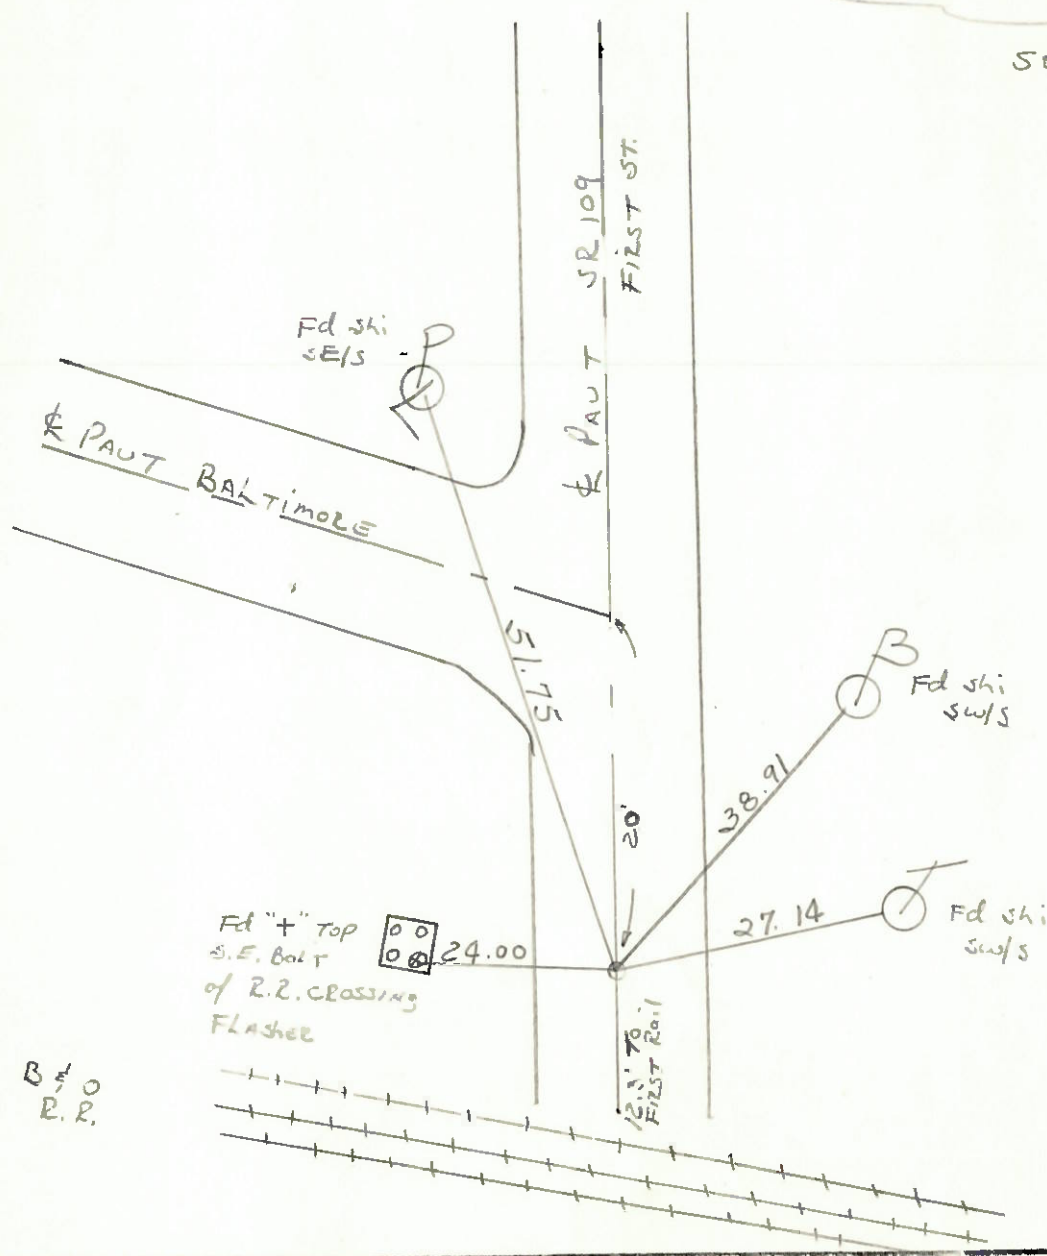

PERSONNEL	TITLE	PERSONNEL	TITLE
Tomsic			
Neuser			
Granata			
Vanya			

COUNTY HENRYDATE Oct. 31, 1973S. R. 109

WEATHER

SEC. MARION TWP.

TEMP

DESCRIPTION

LEFT

CENTER LINE

RIGHT

JOB NO.

Jct. S.R. 109

E. Co. Rd. "F"

S.E. Cor. Sec. 3

S.W. Cor. Sec. 2

MARION TWP.

MARION

Co.

Rd. "F"

Ed. R.R. spk @ surface

shiner 18" Maple

Jct. S.R. 109

S.R. 18 E.

MARION TWP.

shiner

27.51'

29.05'

shiner

S.R. 18 E.

Duplex S.F. 10" Walnut

Ed. 3/4" Iron Pipe

@ Baltimore St.

HAMMER OHIO

MARION TWP.

shiner

51.72'

S.R. 109

Ed. P.R. nail

S.E. bolt in base RR. X-ing sign

24.00'

27.11'

shiner

38.00'

shiner

