

O.D.O.T. DISTRICT 2 SURVEY OFFICE (USE ONLY)

PERSONNEL

REFERENCE NO. 12

SHEET 19 OF 25

NOTES CANTERBURY

DATE 8/18/98

ROUTE SR 109

H.C. ROUSOS

WEATHER PTLY CLOUDY

COUNTY HENRY

R.C. BARNHIESEL

TEMP. 80°

TOWNSHIP MARION

DWG BY GARRETT

PID PAVE TRAIN

SECTION 3

T 3 N R 7 E

TYPE MONUMENT STONE W/ DEPRESSION @ CTR

ON SURFACE - ~~BELOW~~ ON

OFFSET Q PAVEMENT 20.4' LT : ~~RT~~

10.25' TO LT EDGE PAVEMENT


STATION: 551+81

HORZ.DATUM: _____

GEOID: _____

GRID: NORTHING: _____


EASTING: _____

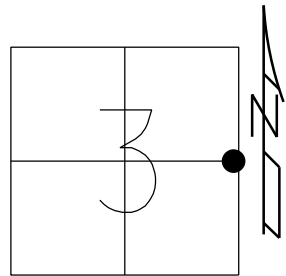

REC:
FND STONE/DEPRESSION @ CTR
@ SURFACE 10.25' W OF W E.P.
20.4' W OF Q PVMT. SR 18 & 109
SLM = HEM 18 - STA 551+80

NOTE:
FND STONE BUT UNABLE TO
DETERMINE WHAT WAS USED ON
STONE, OLD TIES DON'T HELP
WITH DEFINING A GOOD POINT

FD STONE W/ "+" CUT
REF12
3/14/22, DSA

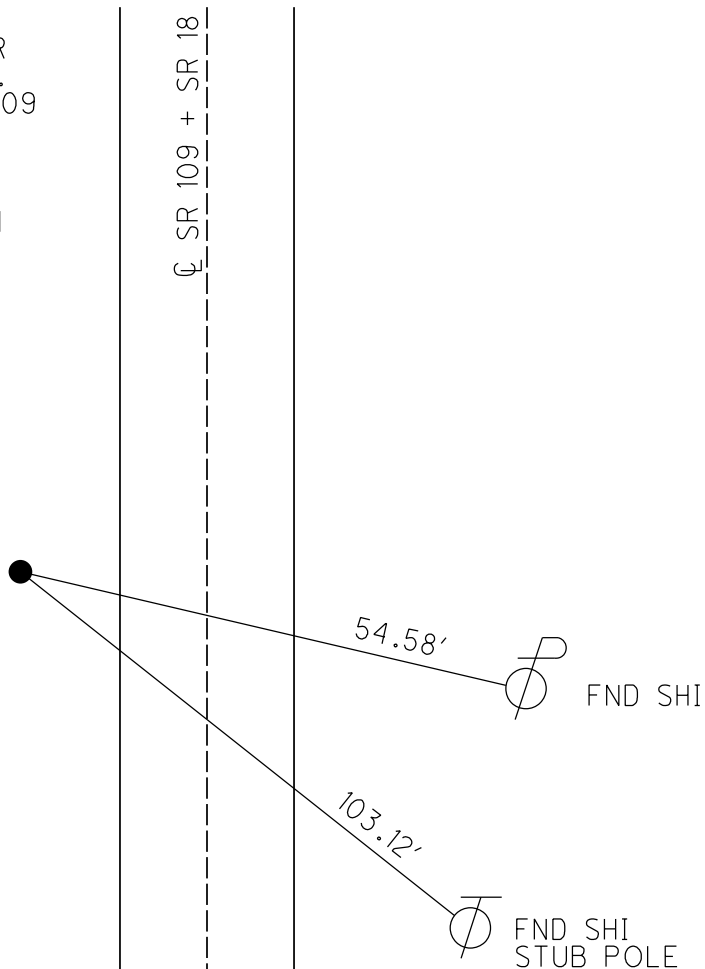

O.D.O.T. DISTRICT 2 SURVEY OFFICE (USE ONLY)

PERSONNEL

REFERENCE NO. 12

SHEET 19 OF 26

NOTES CANTERBURY

DATE 08-18-1998

ROUTE SR 109

H.C. ROUSOS

WEATHER PRTLY CLDY

COUNTY HENRY

R.C. BARNHISEL

TEMP. +80°F

TOWNSHIP MARION

SECTION 3

T 3 N R 7 E

TYPE MONUMENT STONE W/ DEPRESSION @ CTR


ON SURFACE - ~~BELOW~~ ON

LEFT - ~~C PAVT~~ - RIGHT 20.4'

10.25' TO LT EDGE PAVEMENT

S.L.M. 551+81

Grid: Northing: Easting:

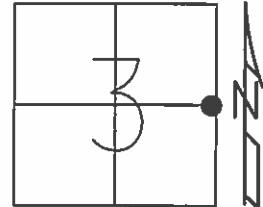


REC:

FND STONE/DEPRESSION @ CTR
@ SURFACE 10.25' W OF W E.P.
20.4' W OF C PVT. SR 18 & 109
SLM = HEM 18 - STA 551+80

NOTE:

FND STONE BUT UNABLE TO
DETERMINE WHAT WAS USED ON
STONE, OLD TIES DON'T HELP
WITH DEFINING A GOOD POINT

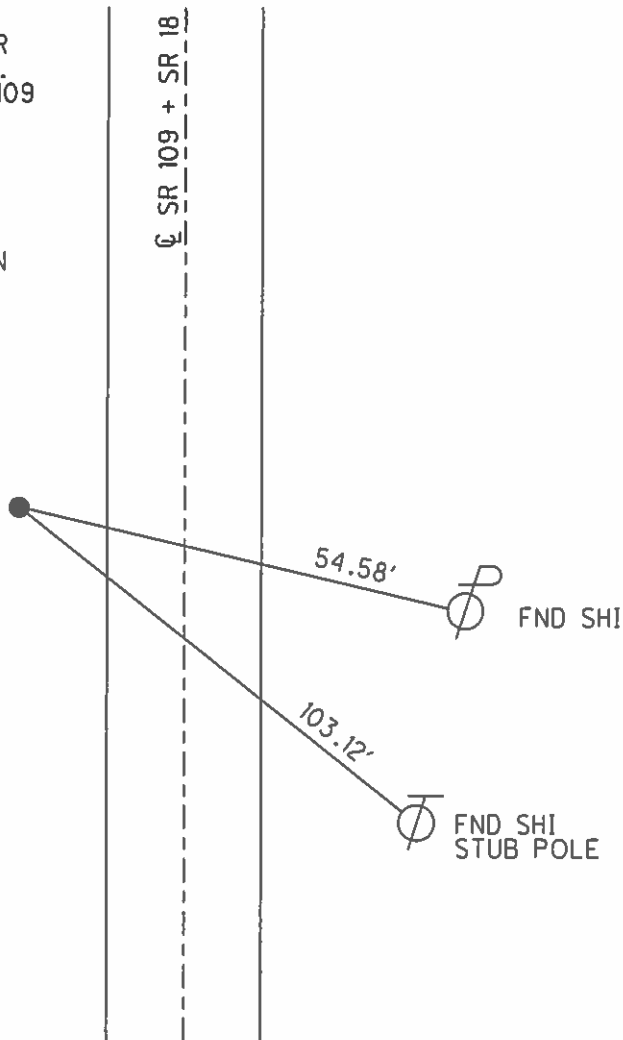

O.D.O.T. DISTRICT 2 SURVEY OFFICE

PERSONNEL

REFERENCE NO. 12

SHEET 15 OF 21

NOTES CANTERBURY

H.C. ROUSAR

R.C. BARNHISEL

DATE 8-18-98

WEATHER Partly Cldy.

TEMP. 80°F

ROUTE 109+18

COUNTY Henry

TOWNSHIP Marion

SECTION 3

T. 3 N. R. 7 E.


TYPE MONUMENT Stone w/ Depression @ ctr

ON SURFACE - ~~BELOW~~ SURFACE

LEFT - ~~Q~~ BAV.T. - RIGHT 204' L of E Pmt

10.25' L TO L EDGE PAVEMENT

S.L.M. 16+824.90 (MEASURED SS1+81)

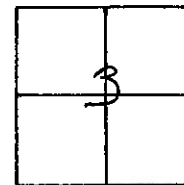

290+40/5.50


OFF PAVEMENT

RECORD:

FND Stone/DEPRESSION @ CTR
@ SURFACE 10.25' W. of W. & P.
20.9' W. of E Pmt. SR 184/09
SLM = HEX 18- STA 551+80

NOTE:

FOUND STONE BUT UNABLE TO
DETERMINE WHAT WAS USED ON
STONE, OLD TIES DON'T HELP WITH
DEFINING A GOOD POINT

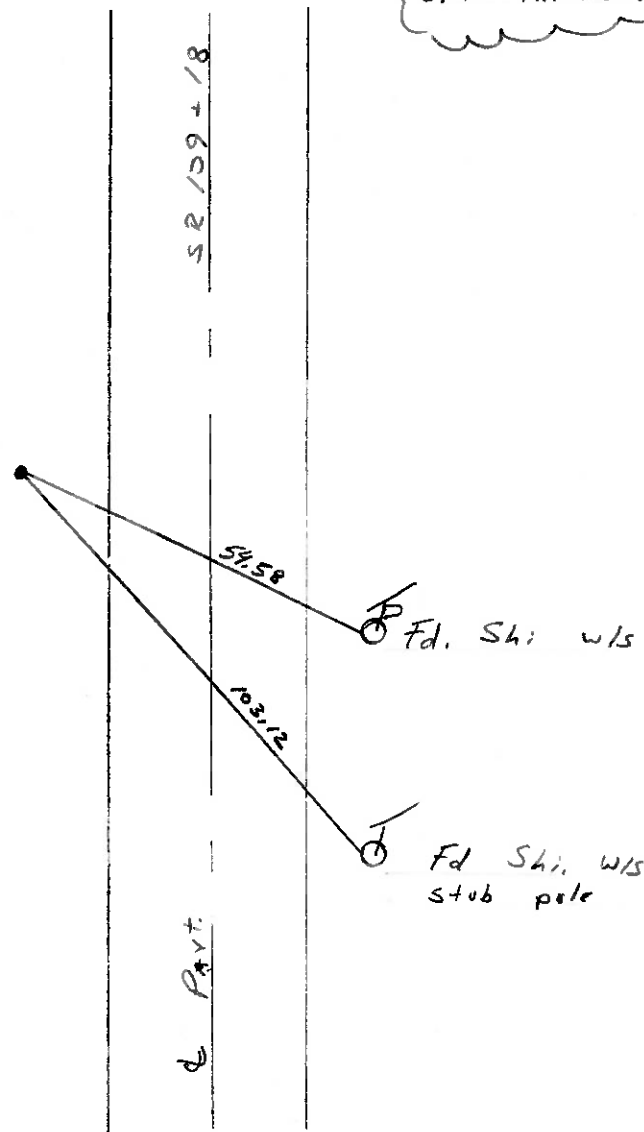

DRAWN BY-TR

Q.D.O.T. DISTRICT 2 SURVEY OFFICE

SHEET _____ OF _____

County HENRY S.R. 18 / 109

Township MARION

Section 3

T 3 N, R 7 E

Personnel HOFFMAN

LOEHRKE

HOUSEHOLDER


BARNHISEL

#12
S.R. 109

Date 4/25/83


Weather CLEAR

Temp. +60°

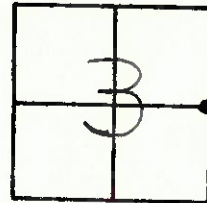

FD. STONE / DEPRESSION @ CTR.
@ SURFACE 10.25' WEST OF W.E.P.
20.4' W. OF & PAVE. S.R. 18 / 109
S.L.M. = HEN. 18 - STA 551+80

MEASURED
551+81

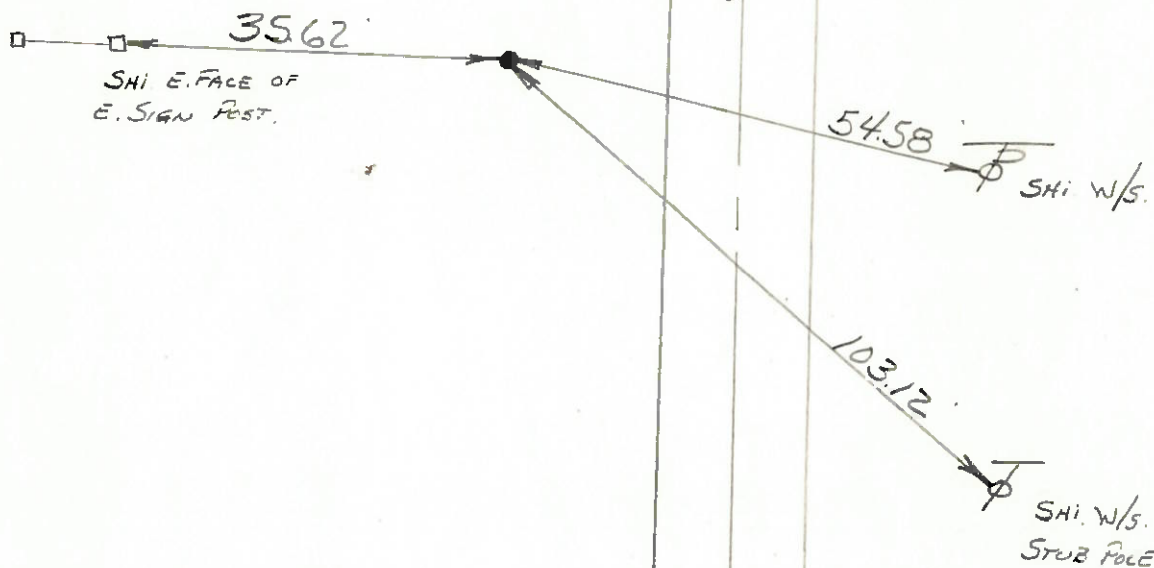

PERSONNEL TITLE PERSONNEL TITLE

Tomsic _____

Neuser _____

Granata _____


Vanya _____

COUNTY HENRY DATE Oct. 31, 1975

S. R. 109 WEATHER _____

SEC. 17.7 R 101 TEMP _____

DESCRIPTION _____ JOB NO. _____

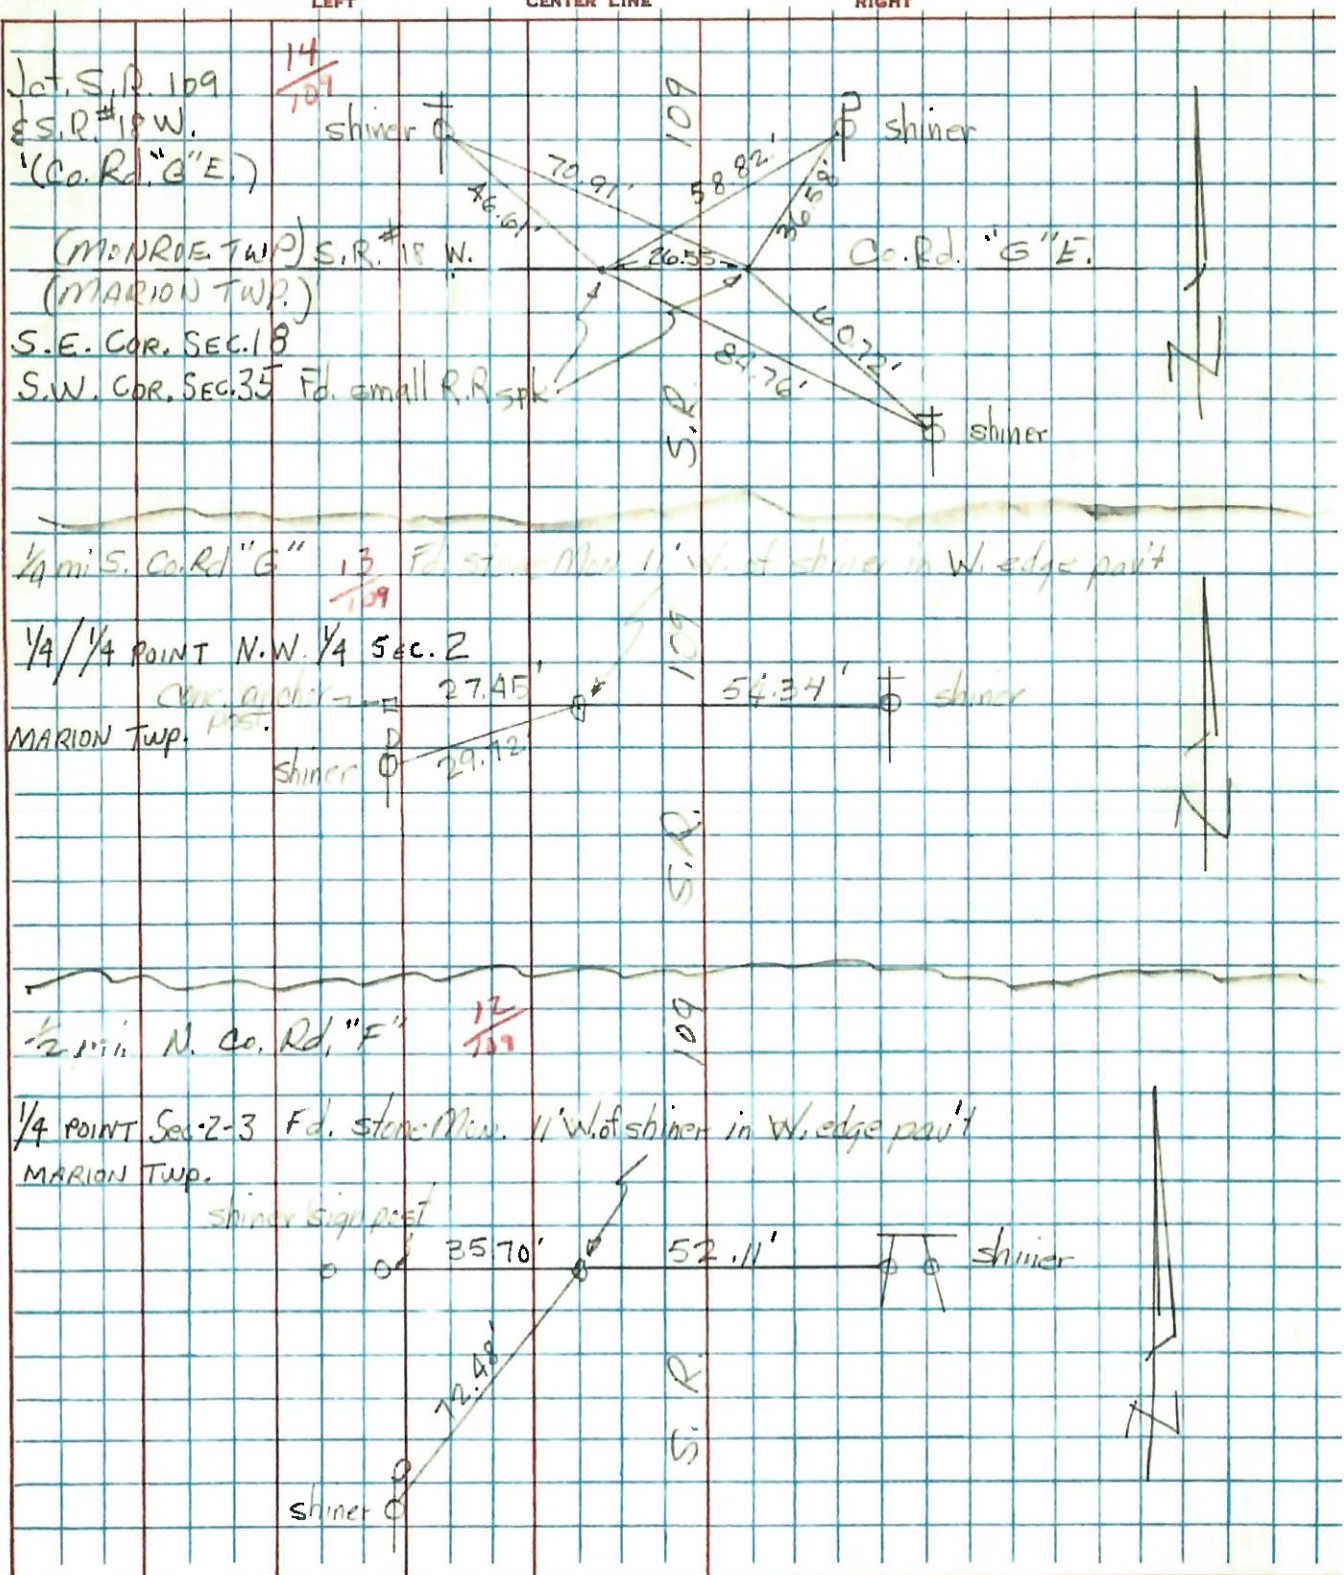

PERSONNEL TITLE PERSONNEL TITLE

BURNSIDECOUNTY HENRYDATE 5-11-72POWERSS. R. 13E109WEATHER CLEAR

SEC. _____


TEMP. +63°DESCRIPTION CONTROL POINTS N. OF HAMLER

JOB NO. _____

LEFT

CENTER LINE

RIGHT

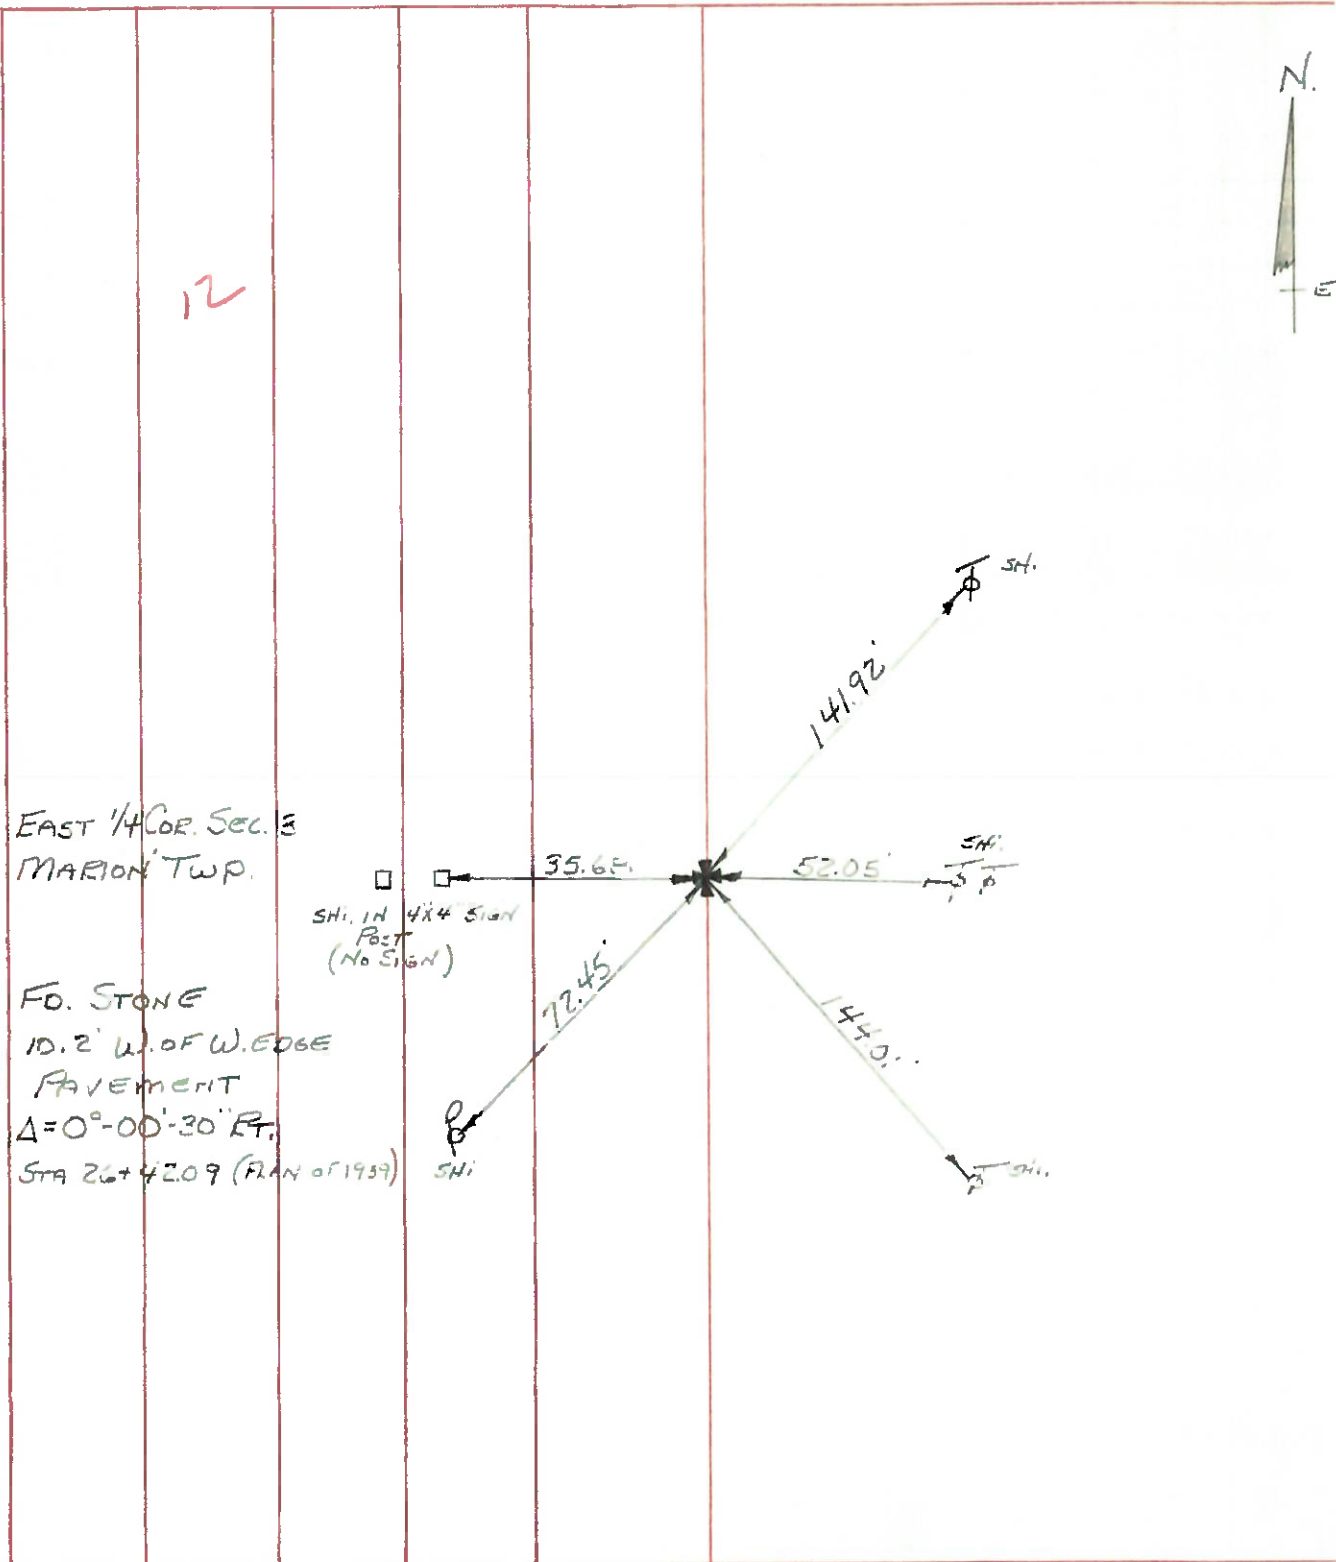


COUNTY HENRY S.R. 109

T-3-N, R-7-E

TOWNSHIP MISSION

SECTION 2

6-11-79
RW, 35, 6M

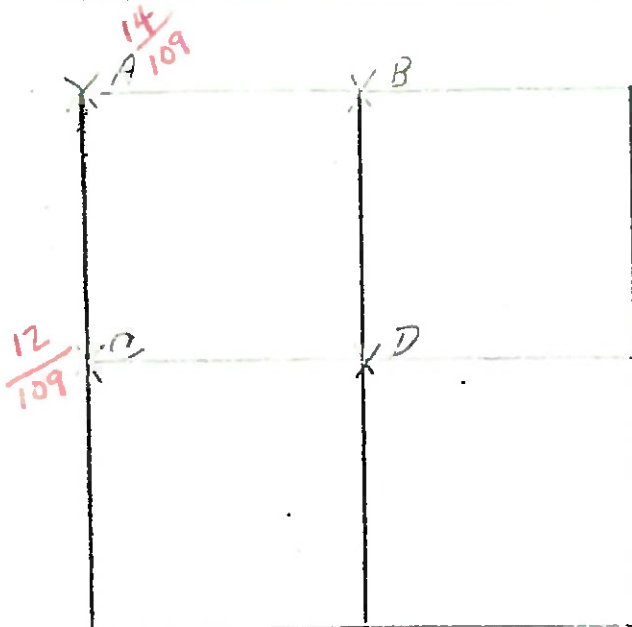

A - FOUND IRON BOLT 0.10' SOUTH AND 0.11' WEST OF HIGH POINT OF STONE (8"X14"X1/2") 14" BELOW ROAD SURFACE. FOUND WOOD STAKE ^N/₅ STONE. PLACED CENTER PUNCHED R.R. SPIRE ON SURFACE OVER HIGH POINT OF STONE. P.K.'S 6' NORTH AND WEST.

70.88' W.N.W. TO SHINER ^{SE}/₅ BRACE POLE
36.44' N.E. TO SHINER ^{SW}/₅ POWER POLE
60.65' E.S.E. TO SHINER ^{NW}/₅ TELEPHONE MARKER POLE
52.73' W.S.W. TO "4" N.E. CORNER CONC. BRIDGE WALL
26.60' W. TO S.W. CORNER SEC. 35, MONROE TWP.

6-11-79 RW, JT, 6M

B - FOUND IRON PIN ANGLED OVER TWO STONES. STONE #1 USED AS A BASE AND IS (10"X15"X5") 19" BELOW ROAD SURFACE. CORNER STONE SETS ON BASE STONE AND IS (5"X8"X11") 8" BELOW ROAD SURFACE. REMOVED IRON PIN AND PLACED CENTER PUNCHED R.R. SPIRE ON SURFACE 0.49' SOUTH OF HIGH POINT OF STONE ON SOUTH LINE OF SEC. 35; MONROE TWP. P.K.'S 16' N.E. W. STONE IS 8.9' S. OF N. EDGE OF 18' PAVEMENT
43.97' N.W. TO SPIRE ^S/₅ TELEPHONE POLE
39.25' S.S.E. TO DUPLEX ^W/₅ POWER POLE
45.35' S.W. TO IRON PIN ON SOUTH DITCH BACK
34.30' W. TO S ¹/₄ POST SEC. 35, MONROE TWP.

PERSONNEL	TITLE	PERSONNEL	TITLE	COUNTY	DATE
				Henry	
				S. R. #109	WEATHER
				SEC.	TEMP.
					JOB NO.

DESCRIPTION	LEFT	CENTER LINE	RIGHT
-------------	------	-------------	-------

12

#61 Stone on fence line
E 1/4 Sec. #3
Marion, Twp.

54.64 E. Bolt in stump
51.70 E. Spk. in Tele. Pole
28.84 W. Spk. in Cor. Post

13

#62 Stone on fence line
E 1/4 of N.E. 1/4
Sec. #3 Marion, Twp.

55.65 N.E. 1st Post N. Cor. As
55.20 E. Spk. Cor. Post
28.84 S.W. Spk. P. Pole

14

NE. Cor. Sec. #3 Marion, Twp.
#63 Iron bolt in Post
36.87 E. to Shiner Post
10.73 S.W. to Shiner Post
10.08 S.E. to Shiner Post
23.53 W. to Bolt in Cor. Post
21.80 S.W. to Shiner Post
27.27 N.E. to Shiner Post

57.46 N.W. to N.E. Cor. of N.
Bridge Rail.
52.40 S.W. to N.E. Cor. of S
Bridge Rail.
26.58 Distance between
Stones in Monroe Twp.
37.85 N.W. to S.E. cor. of
N. Bridge Rail
30.11 S.W. to N.E. cor. of
S. Bridge Rail.