

O.D.O.T. DISTRICT 2 SURVEY OFFICE (USE ONLY)

PERSONNEL

REFERENCE NO. 24

SHEET 21 OF 25

NOTES NIESE

DATE 10/7/24

ROUTE SR 109

H.C. MILLER

WEATHER SUNNY

COUNTY HENRY

R.C. PRESTON-COLVIN

TEMP. 60°

TOWNSHIP MONROE

SECTION 11

DWG BY BARRIERE PID 99587

T 4 N R 7 E

TYPE MONUMENT MAG NAIL/WASHER

ON SURFACE - BELOW ON

OFFSET $\varnothing$ PAVEMENT LT : RT

TO EDGE PAVEMENT

STATION: 578+49

HORIZ.DATUM: OHIO LDP (HENRY)


GEOID: 18

GRID: NORTHING: 640241.0807


EASTING: 1573133.7245

LDP: NORTHING: 465184.951

EASTING: 181136.045

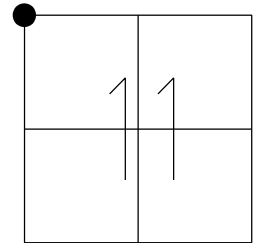

RECORD:
SET MAG/WASHER
10-28-04, MC
FD MAG/WASHER
GPS, REF24
9-2-15, JFO
FD MAG/W
REF24
12/7/21, DSA
SET MAG/WASHER
10/7/24, TDN

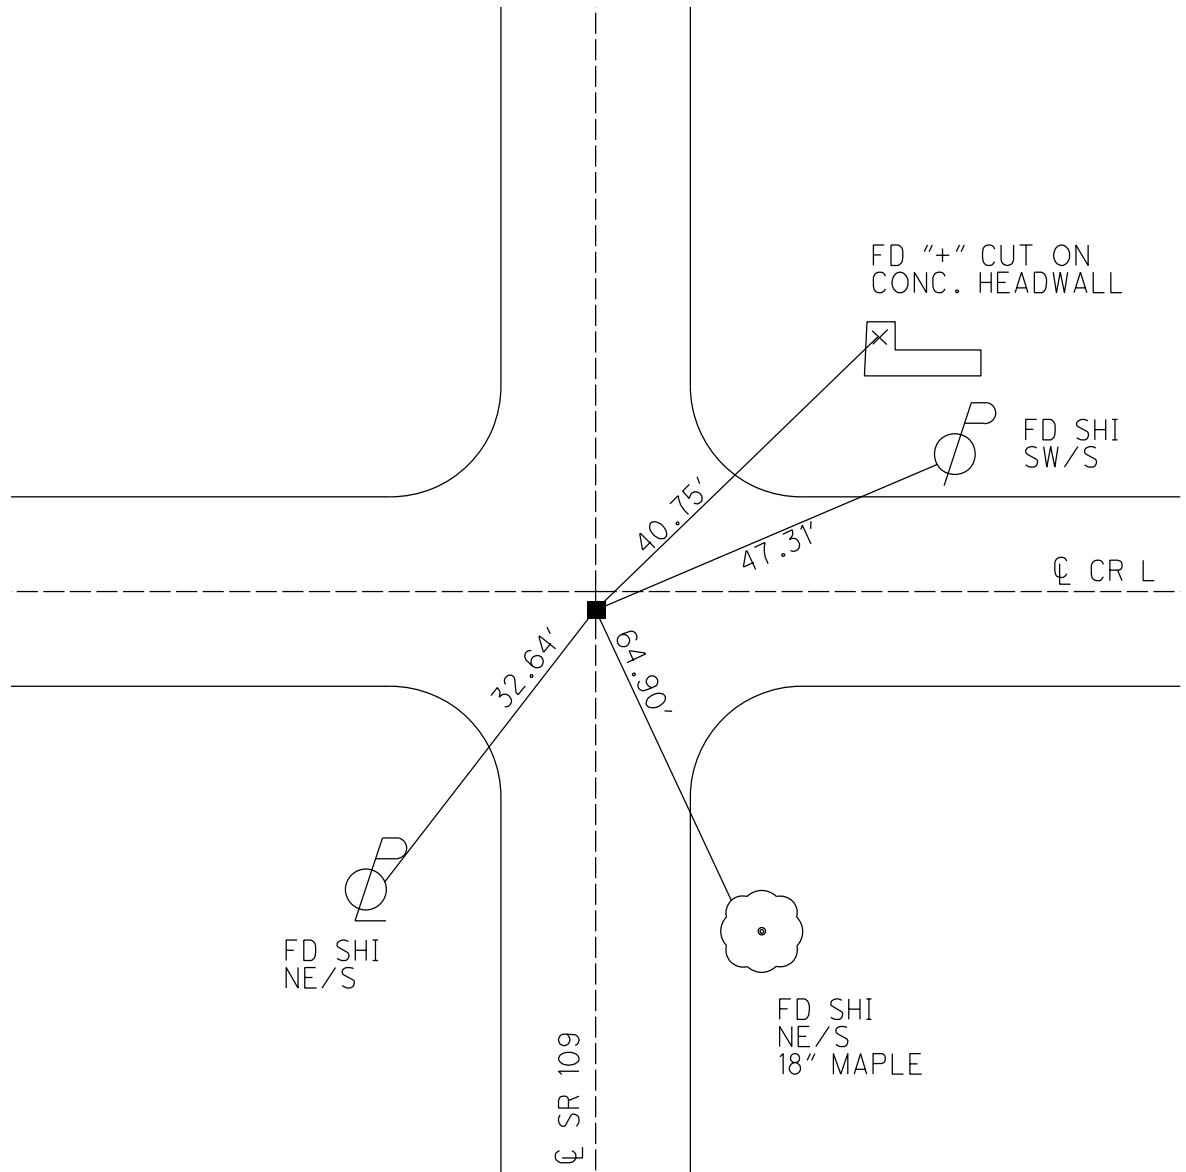


O.D.O.T. DISTRICT 2 SURVEY OFFICE (USE ONLY)

PERSONNEL REFERENCE NO. 24 SHEET 11 OF 38

NOTES	<u>RHOADES</u>	DATE	<u>9-3-15</u>	ROUTE	<u>SR 109</u>
H.C.	<u>O'DONNELL</u>	WEATHER	<u>CLEAR</u>	COUNTY	<u>HENRY</u>
R.C.	<u>RHOADES</u>	TEMP.	<u>88°F</u>	TOWNSHIP	<u>MONROE</u>
				SECTION	<u>11</u>
				T	<u>4</u> N R <u>7</u> E


TYPE MONUMENT MAG/WASHER
ON SURFACE - ~~BELOW~~ ON
~~LEFT~~ - CL PAV'T - RIGHT 0.5'
9.2' TO RT EDGE PAVEMENT
S.L.M. 583+69

Grid: Northing: 640241.0807 Easting: 1573133.7245

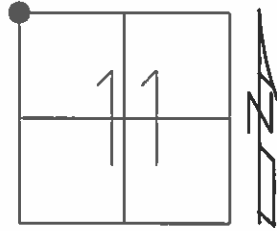

RECORD:
SET MAG/WASHER
10-28-04, MC

FD MAG/WASHER
GPS, REF24
9-2-15, JFO

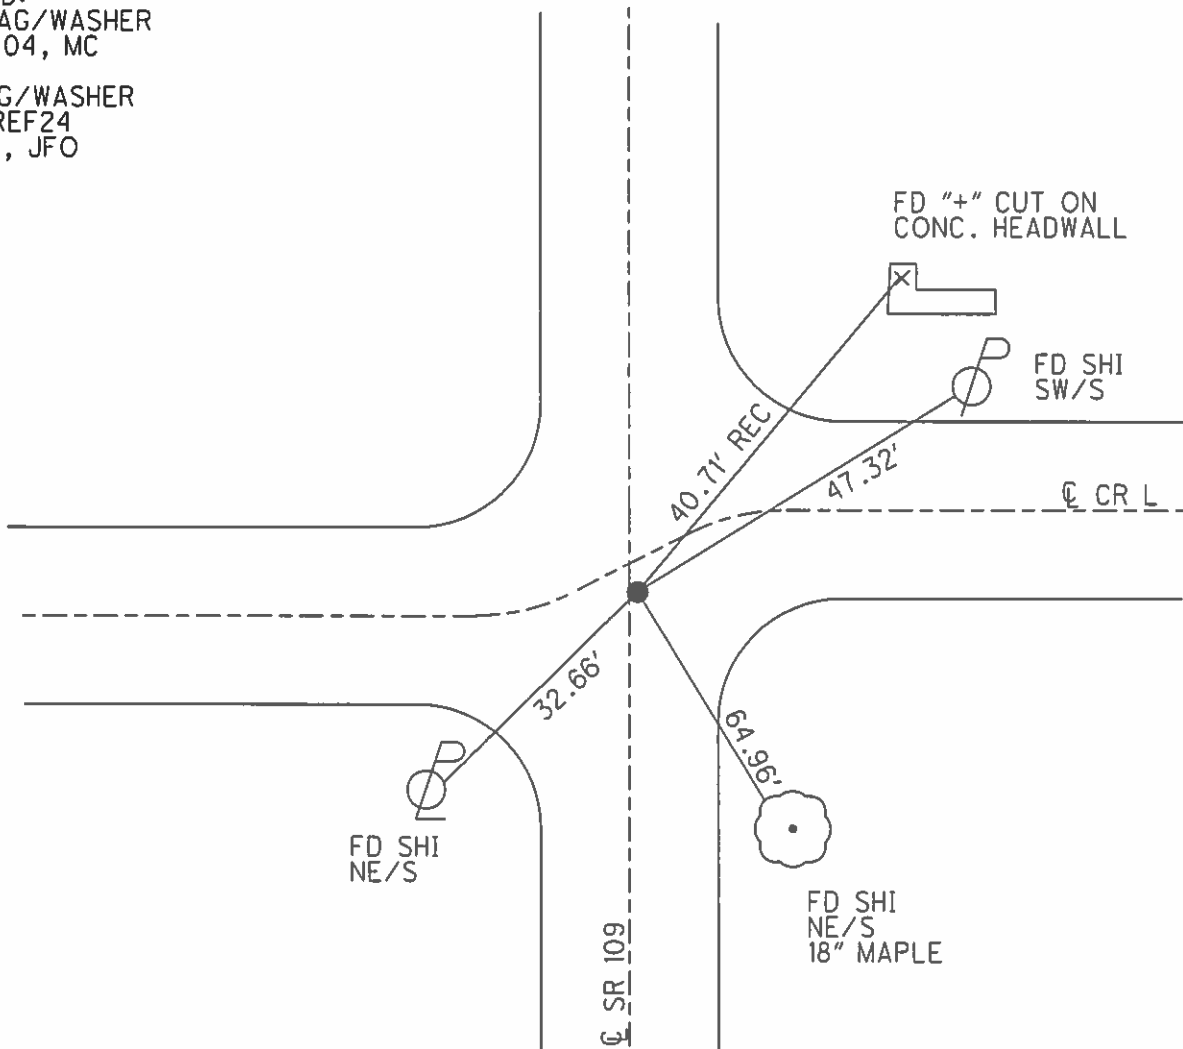

O.D.O.T. DISTRICT 2 SURVEY OFFICE

PERSONNEL

REFERENCE NO. 24

SHEET 10 OF 23

NOTES CANTERBURY

H.C. BARNHISEL

R.C. HOOKE

DATE 8/31/04

WEATHER SUN

TEMP. + 70 °

ROUTE 107

COUNTY HENRY

TOWNSHIP MONROESECTION 11

T4 NR 7 E



TYPE MONUMENT P.R. SHANK

ON SURFACE - ~~BELOW~~ SURFACE

~~LEFT~~ - ~~CL~~ PAV'T. - RIGHT 0.5' RT ~~CL~~

9.2' TO RT. EDGE PAVEMENT 3' S. OF & RD. "L" EAST

S.L.M. 583 + 69

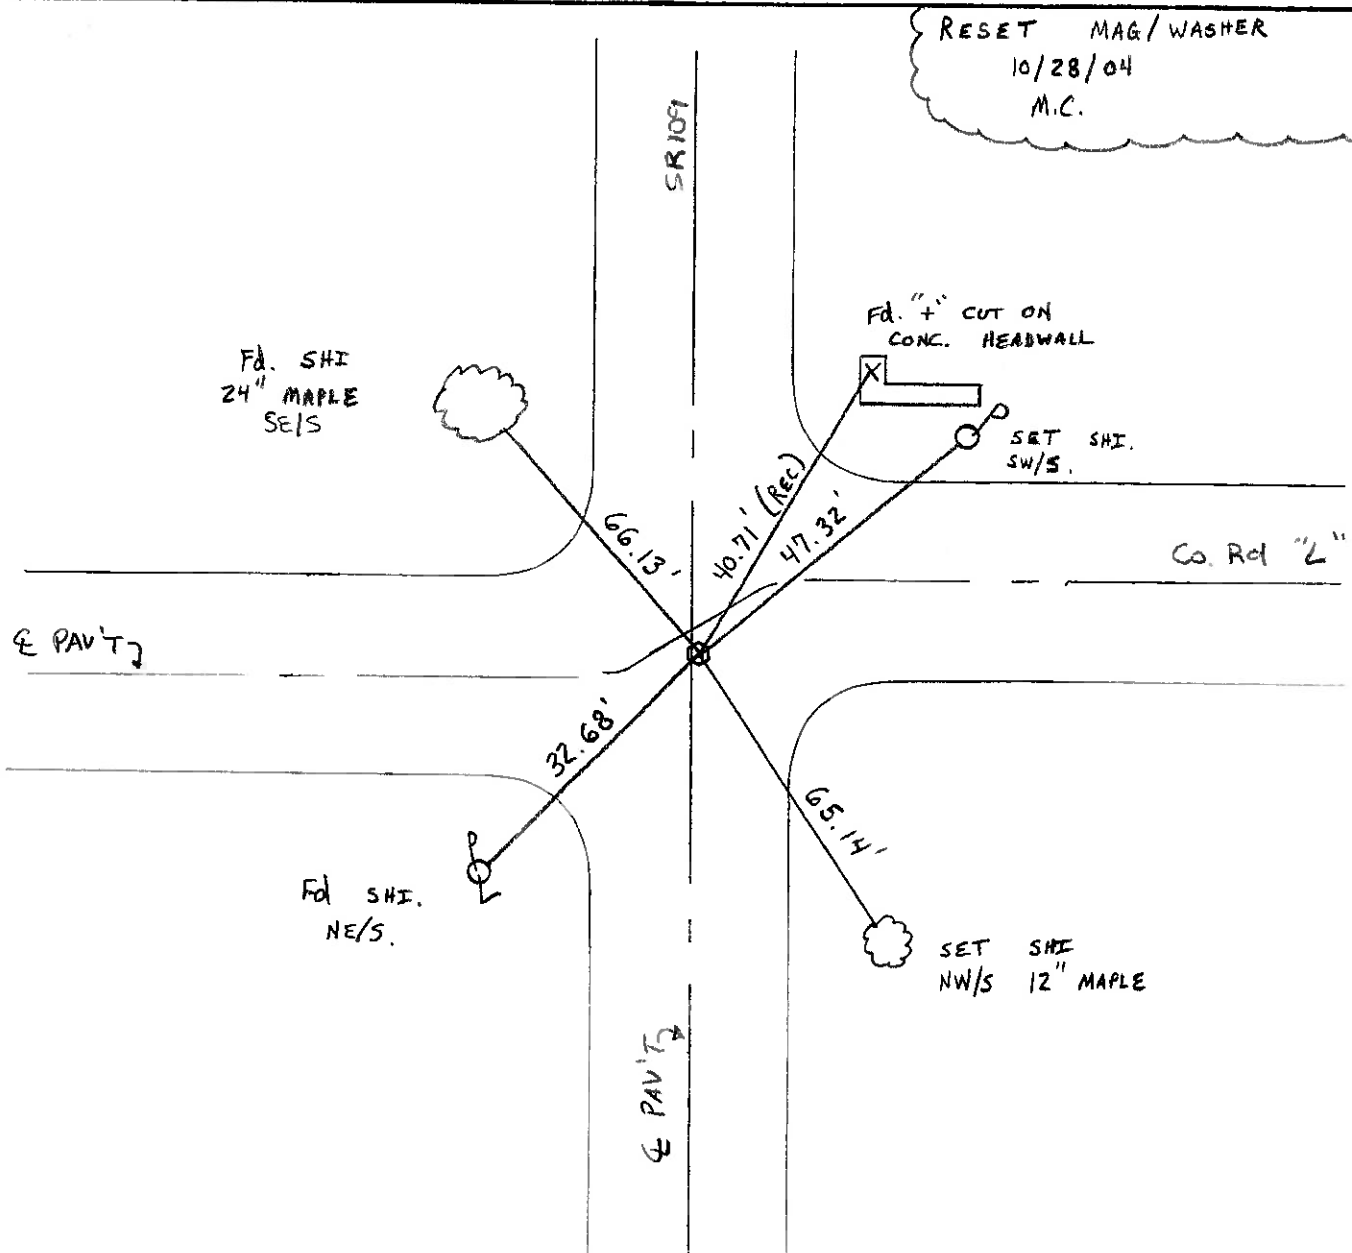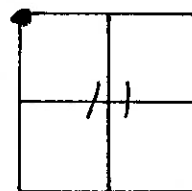

O.D.O.T. DISTRICT 2 SURVEY OFFICE

PERSONNEL

REFERENCE NO. 24

SHEET OF

NOTES BARNHISEL

H.C. VAN DUSEN

R.C. BARNHISEL

DATE 8-13-93

WEATHER JUNNY

TEMP. +80°F

ROUTE 109

COUNTY HENRY

TOWNSHIP MONROE

SECTION 11

T4 NR 7 E


TYPE MONUMENT LG. RR/SPK.

ON SURFACE - BELOW YES


~~LEFT~~ - & PAV'T. - RIGHT 1.0'

TO EDGE PAVEMENT 2'S. OF & RD. "L" EAST

S.L.M. 583+69

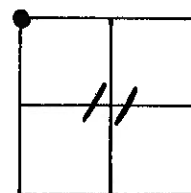

SET PK& WASHER
8-27-93
MB

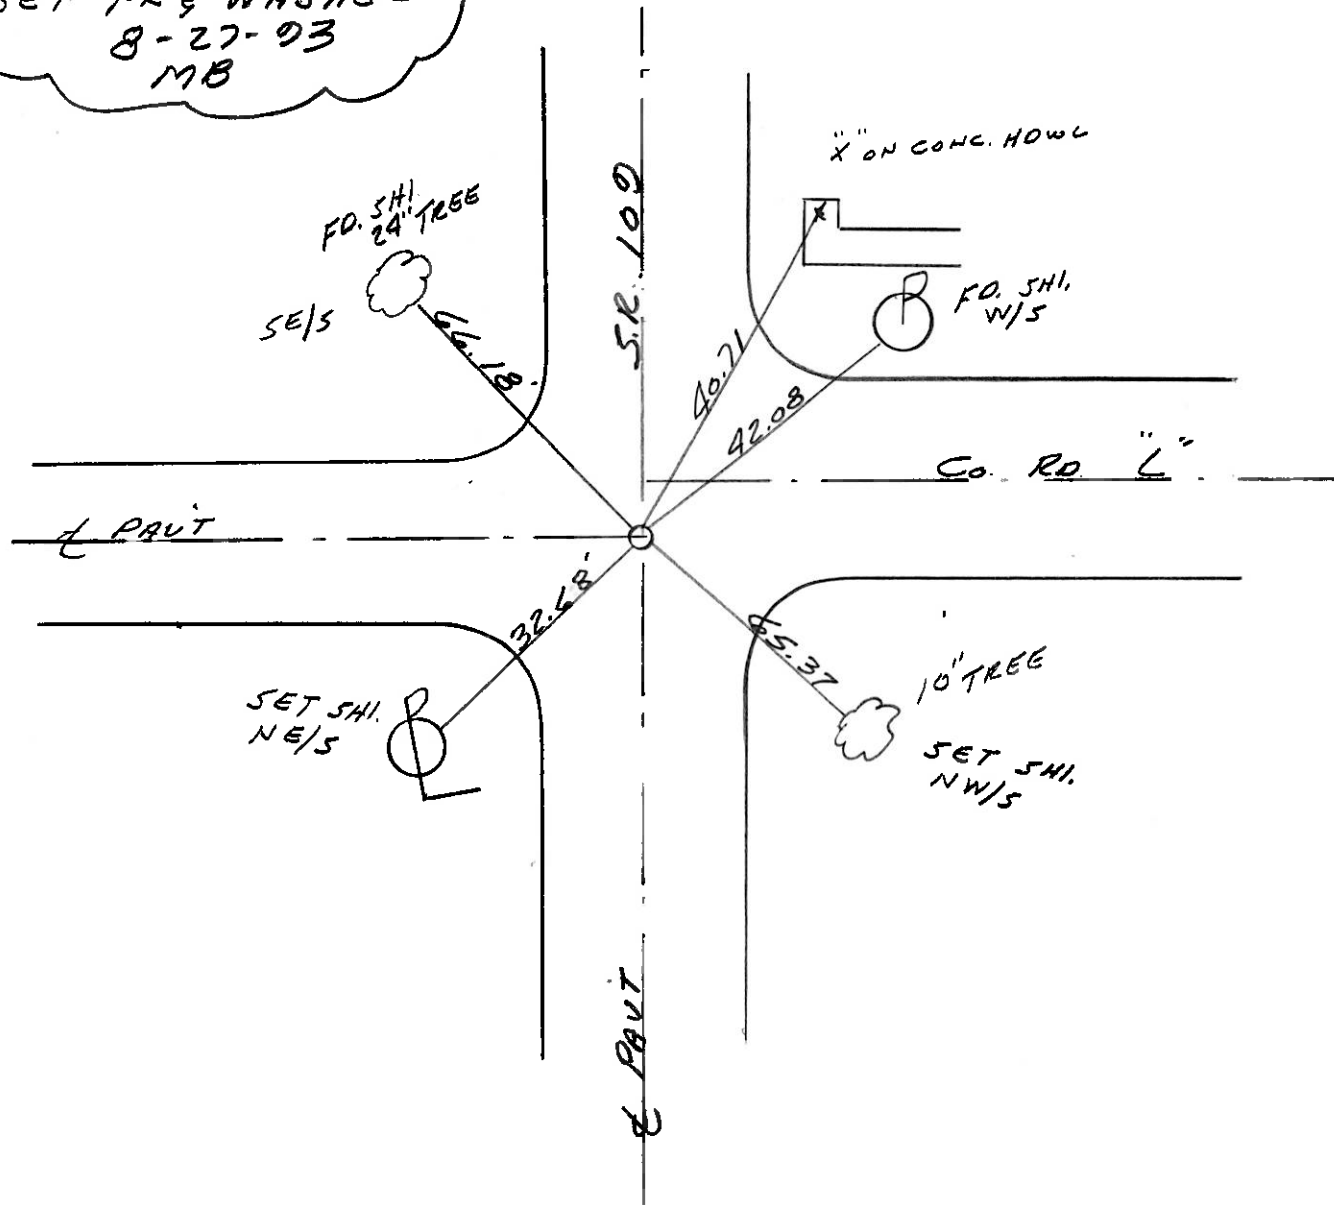

O.D.O.T. DISTRICT 2 SURVEY OFFICE

PERSONNEL

REFERENCE NO. 24

SHEET OF

NOTES Barnhisel

H.C. Hoffman

R.C. Loebcke

DATE 4-8-85

WEATHER cloudy

TEMP. +35°

ROUTE 109

COUNTY Henry

TOWNSHIP Monroe

SECTION 11

T 4 N R 7 E


TYPE MONUMENT Lg RR/S PK

ON SURFACE - BELOW ☒

LEFT - & PAV'T. - RIGHT 1.0

— TO — EDGE PAVEMENT 2' SOF & 20" L" EAST

S.L.M. 583+08

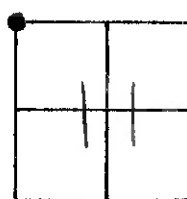

Set PK/Washer
5-24-85
MDB

24"
Set SHi
SE/S

SR 109

"X" on CONC HDWL

40.73
4209
FD SHi
W/S

Co Rd "L"

E PAV'T

28.38

FD SHi
NE/S


65.51

10"
Set SHi
NW/S

E PAV'T

COUNTY HENRY S.R. 109
TOWNSHIP MONROE
SECTION 11

T 1 N 1 R 17 E

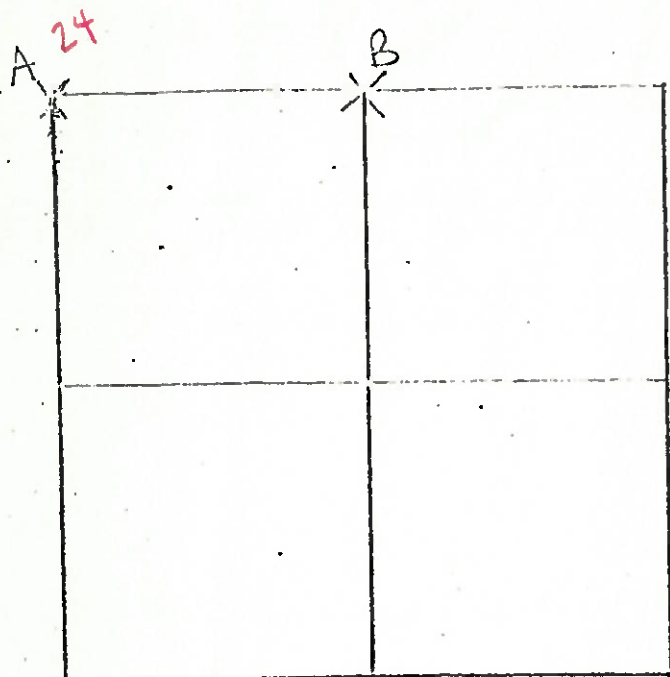

7-3-79 R.W. G.M. J.J.

A- FOUND ROAT SPIKE 0.63'
NORTH OF TOP CENTER OF STONE
19" x 11" x 11" 23" BELOW ROAD
SURFACE. REMOVED IRON SPIKE
AND PLACED CENTER PUNCHED
R.R. SPIKE ON SURFACE OVER
TOP CENTER OF STONE
P.K. 2 CUT 6' N. & E.

STONE IS LOCATED 9.2' WEST OF EAST EDGE OF
18' PAVEMENT

42.06' N.E. TO SHINER S.W/S P

57.74' S.E. TO DUPLEY S.W/S TREE

28.36' S.W. TO SHINER N.E/S LIGHT POLE P

67.17' N.N.W. TO DUPLEY E/S MAPLE TREE

7-6-79 R.W. J.J.

B- FOUND RECORDED IRON PIPE 2.75' NORTH AND 0.55' EAST
OF HIGH POINT OF STONE (8" x 16" x 11") 16" BELOW ROAD SURFACE.

ALSO FOUND SMALL SANDSTONE OVER HIGH POINT. REMOVED IRON
PIPE AND SMALL SANDSTONE. PLACED CENTER PUNCHED

RAILROAD SPIKE ON SURFACE OVER HIGH POINT OF STONE

P.K.'s 6' S. & W. STONE IS 8' NORTH OF SOUTH EDGE OF 18' PAVEMENT

75.35' E.N.E. TO DUPLEX S.W/S P

80.09' E.S.E. TO 30D SPIKE S.W/S P

27.33' S. TO DUPLEX N.E/S P

PERSONNEL TITLE PERSONNEL TITLE

COUNTY HenryDATE 2-6-58S. R. #109

WEATHER

SEC.

TEMP.

DESCRIPTION

Malinta

JOB NO.

LEFT

CENTER LINE

RIGHT

Control Points checked by Jameson 3-6-58

22 #72 Iron Pin

60.80

#1.07' N.W. To Shi. ^{T POLE} ~~P. Pole~~

✓ South Corp Line.

OK 2/6/58

39.20

21.65' S.W. To ~~SHINER~~ ^{SHINER} ~~How~~ P Pole

Sta 530+11.2

41.35

21.55' S.E. To ~~SHINER~~ ^{SHINER} T Pole

2?

51.60' NW TO CONC FOUNDATION 1' FROM GRND

43.0' NE TO SHINER IN MAPLE TREES

23 #73 IRON PIN. OK 2/6/58

Sta 556+44.15 Twp. Rd. K. 2

Angle 00°-17' H. E. Rd.

33.28' S.E. To ~~SHINER~~ ^{SHINER} N.W. Conc. S.W. Side,

38.30

T Pole ~~P. Pole~~

60.39' S.W. To N.E. Cor. Tile

Block Garage

24 #74 Iron Pipe

OK 2/6/58

North Corp Line Co. Rd. L

Sta 583+22.38

80.41' N.W. To S.E. Cor. Walk To

Porch

40.45' N.E. To X on Hd. W.

41.30' E.N.E. " " " "