

O.D.O.T. DISTRICT 2 SURVEY OFFICE (USE ONLY)

PERSONNEL

REFERENCE NO. 15 A

SHEET 13 OF 61

NOTES MILLER

DATE 12/19/23

ROUTE SR 110

H.C. AUBLE

WEATHER CLOUDY

COUNTY HENRY

R.C. RHOADES

TEMP. 27°

TOWNSHIP HARRISON

ASTON

SECTION 12

DWG BY RHOADES

PID 114846

T 5 N R 7 E

TYPE MONUMENT MAG/WASHER

ON SURFACE - ~~BELOW~~ ON

OFFSET CL PAVEMENT ON LT : RT

8.6' TO RT EDGE PAVEMENT



STATION: 368+97.72

HORZ.DATUM: NAD83 2011

GEOID: NAVD88 2018

GRID: NORTHING: 636587.995

EASTING: 1555934.937

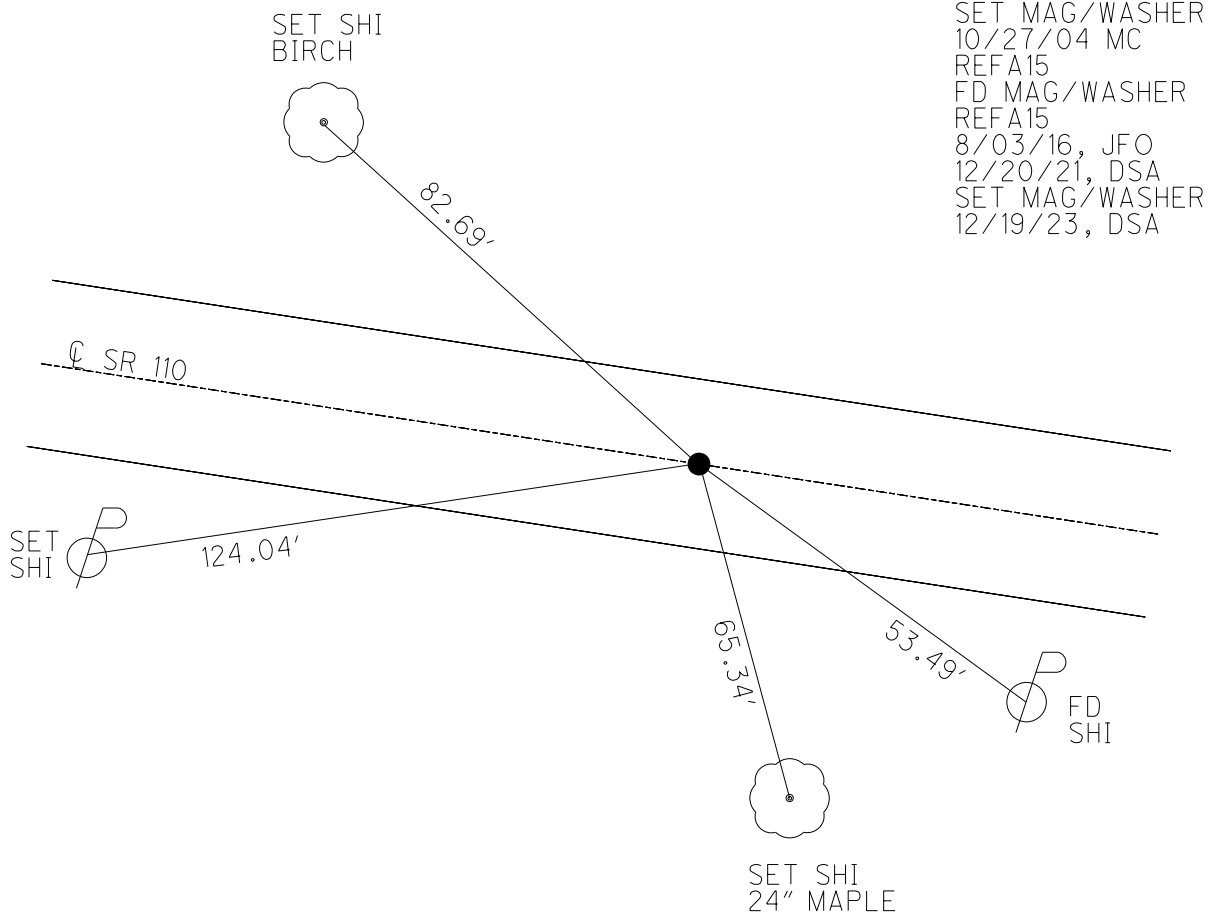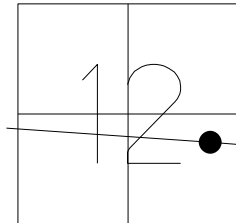

O.D.O.T. DISTRICT 2 SURVEY OFFICE (USE ONLY)

PERSONNEL

REFERENCE NO.

15-A

SHEET

14 OF 58

NOTES RHOADES

DATE

08/31/15

ROUTE

SR 110

H.C. O'DONNELL

WEATHER

FAIR

COUNTY

HENRY

R.C. RHOADES

TEMP.

85°

TOWNSHIP

HARRISON

SECTION

12

T 5 N R 7 E

TYPE MONUMENT

PK/WASHER

ON SURFACE - ~~BELOW~~

ON

~~LEFT~~ - Q PAV'T - ~~RIGHT~~


ON

8.6' TO RT EDGE PAVEMENT

S.L.M.

377+20

Grid: Northing: 636587.917 Easting: 1555934.978

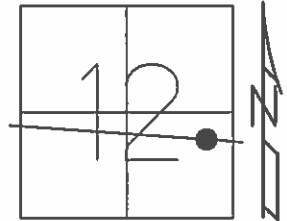

ORIGINAL POINT 1940 PLAN

RECORD:

PI STA: 375+95.2

DELTA= 0°-50' LT

NOTE: 384+87 IS THE BEGINNING

OF NEW PAV'T & NEW ALIGNMENT

OF SR 110

NOTE: THIS MON. BOX SET DURING

NEW CONST. IN 1988


RESET MAG NAIL & WASHER

10/27/04 MC

GPS, REFA15

UNCOVERED

08/03/16, JFO

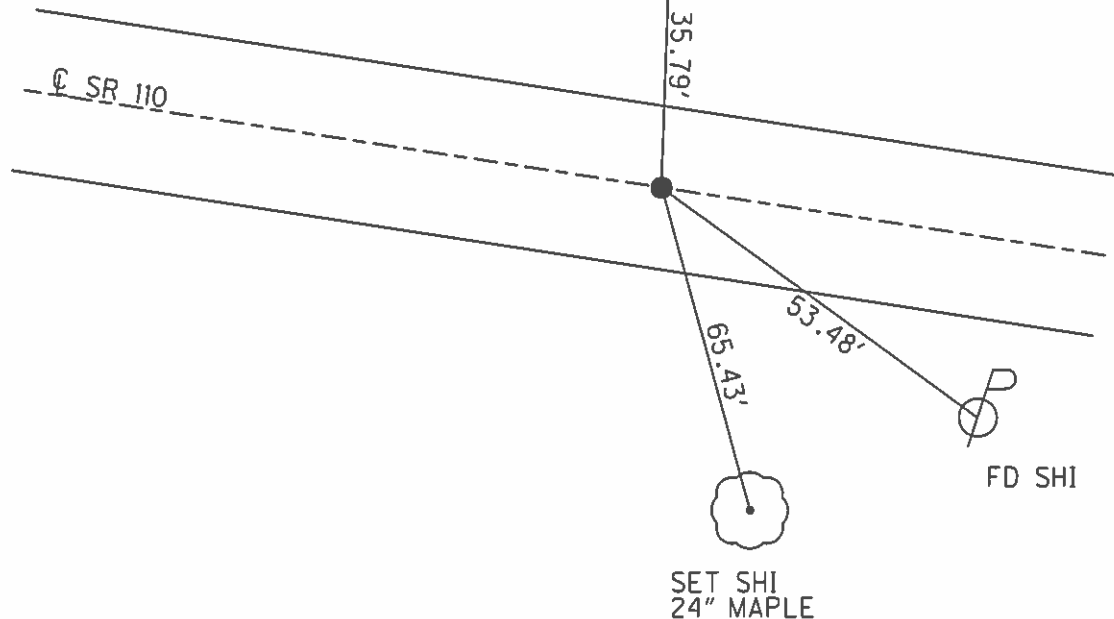

O.D.O.T. DISTRICT 2 SURVEY OFFICE

PERSONNEL

NOTES BARNHISEL
H.C. CANTERBURY
R.C. HOOKE


REFERENCE NO. ¹⁹⁸⁸ 154

DATE 04/13/04
WEATHER CLEAR
TEMP. +75°

SHEET 1 OF 37

ROUTE 110
COUNTY HENRY
TOWNSHIP HARRISON
SECTION 12
T 5 N R 7 E


TYPE MONUMENT PK & WASHER
ON SURFACE - ~~BELOW~~ YES
~~LEFT - C~~ PAV'T - ~~RIGHT~~ YES
8.6' TO RT EDGE PAVEMENT
S.L.M. 377+20

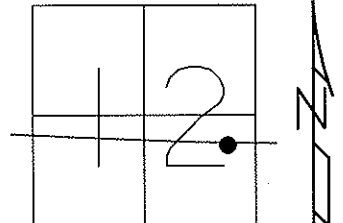

ORIGINAL POINT 1940 PLAN
RECORD:
PI STA: 375+95.2
DELTA = 0°-50' LT

RESET MAG NAIL & WASHER
10/27/04
MC

NOTE: 384+87 IS THE BEGINNING
OF NEW PAV'T & NEW ALIGNMENT
OF SR 110

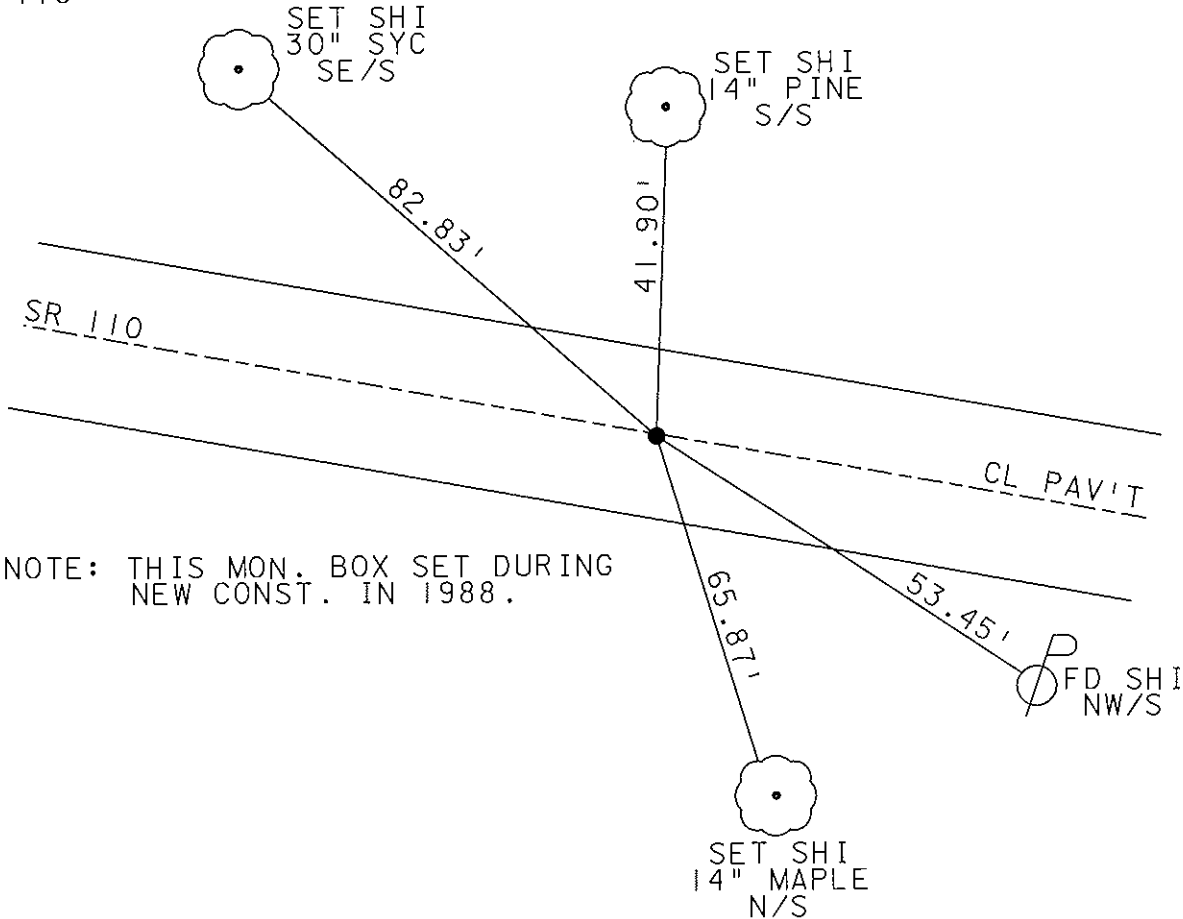

Resurfaced 2009

O.D.O.T. DISTRICT 2 SURVEY OFFICE

PERSONNEL

REFERENCE NO. 15A

SHEET _____ OF _____

NOTES BARNHISEL

H.C. " "

R.C. HOFFMAN

DATE 9-28-90

WEATHER Clear

TEMP. +65°

ROUTE 110

COUNTY HENRY

TOWNSHIP HARRISON

SECTION 12

T S N R 7 E

TYPE MONUMENT P.K. & Washer


ON SURFACE - BELOW yes

LEFT - & PAV'T. - RIGHT 0.8

8.6 TO Rt EDGE PAVEMENT 10.9 TO Lt Edge


S.L.M. 377+20

SET P.K. &
Washer
10-11-90
MB

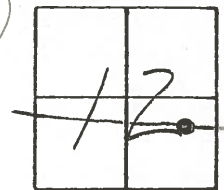

Recoed:
P.I. STA: 375+95.2
Set Sm RR Spk
A=0°-50' LT

NOTE: 384+87 IS THE
BEGINNING OF NEW PAUT
& NEW ALIGNMENT OF S.E. 110

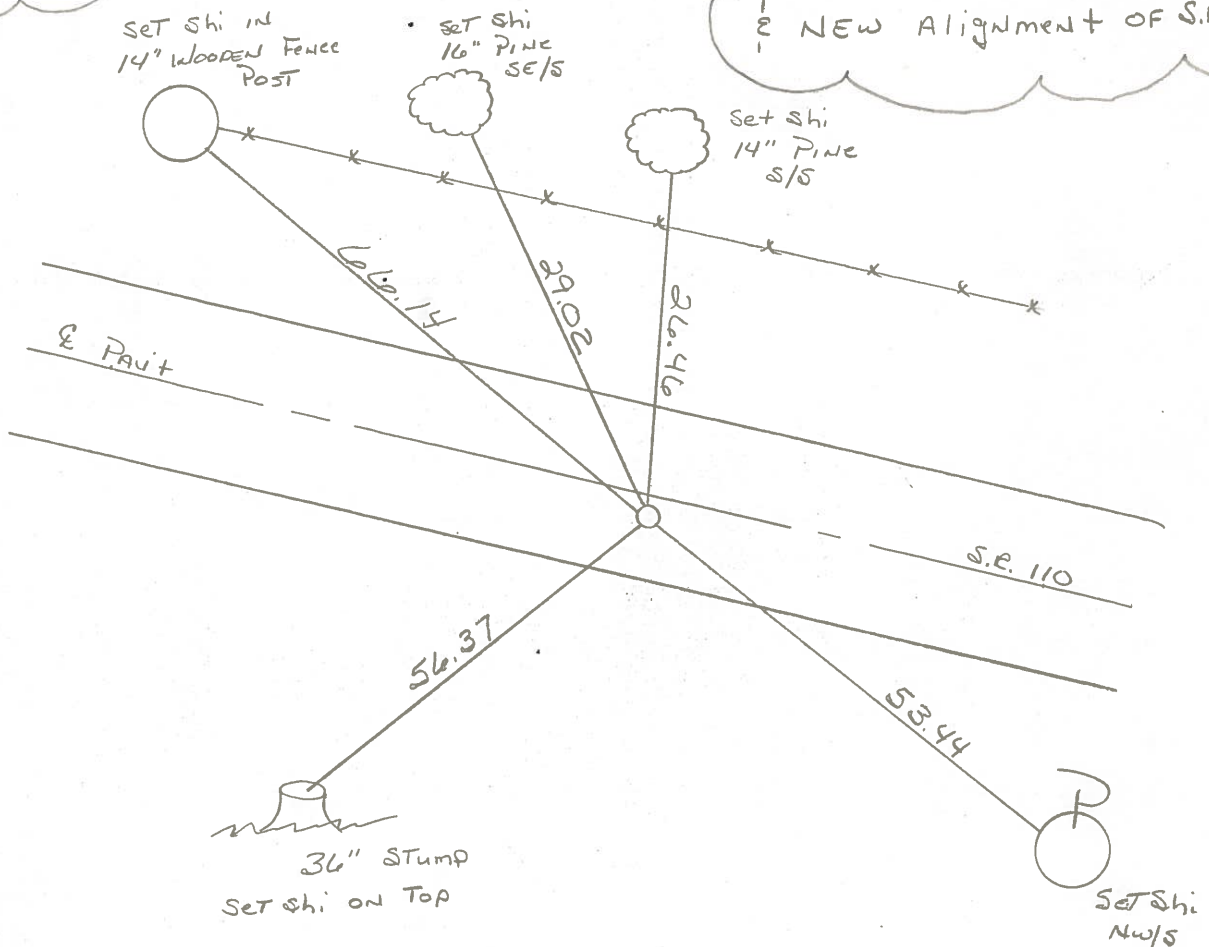

Q.D.O.T. DISTRICT 2 SURVEY OFFICE

SHEET 2 OF

County HENRY S.R. 110

Date 5-19-82

Township HARRISON

Weather

Section 12


Temp.

T5N, R7E

Personnel HOFFMAN

ROSHRKE


HOUSEHOLDER

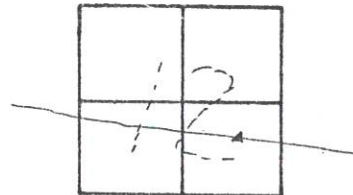

P.I. STA. 375+95.2
SET SMALL P.R. SPK.
 $\Delta = 0^\circ - 50' \text{ LT.}$

377+20
0.8 R+ &
8.6 R+ Edge
10.9 LT Edge
P.K. WASHER

SET P.K. & WASHER
5-19-82
S.W.M.

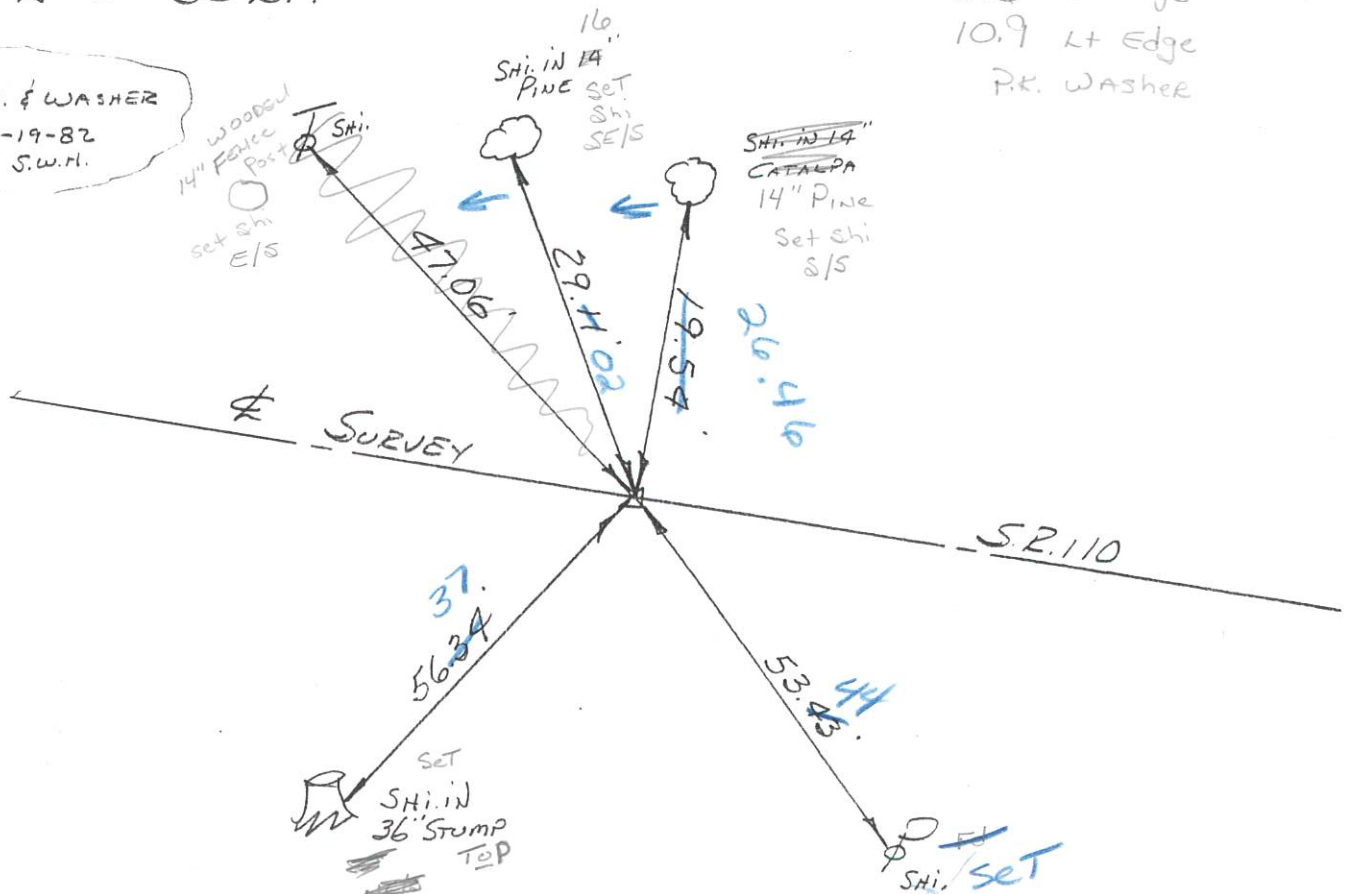

NOTE: 384+87

BEGINNING OF NEW PAVT
ON NEW ALIGNMENT OF SR 110

Q.D.O.T. DISTRICT 2 SURVEY OFFICE

SHEET 2 OF

County HENRY S.R. 110

Township HARRISON

Section 12

T5N, R2E

Personnel HOFFMAN

LOEHRKE

HOUSEHOLDER

15A

Date 5-19-82

Weather

Temp.



P.I. STA. 375+95.2
SET SMALL P.R. SPK.
 $\Delta = 0^\circ - 50' \text{ LT.}$

OLD ALIGNMENT S.R. 110

SET P.K. & WASHER
5-19-82
S.W.H.

