

O.D.O.T. DISTRICT 2 SURVEY OFFICE (USE ONLY)

PERSONNEL

REFERENCE NO. 1

SHEET 1 OF 20

NOTES RHOADES
H.C. O'DONNELL
R.C. TRENKA

DATE 6-7-18
WEATHER CLOUDY
TEMP. 65°

ROUTE SR 281
COUNTY HENRY
TOWNSHIP FLAT ROCK
SECTION 30

DWG BY JAMES PID 102763

T 4 N R 6 E

TYPE MONUMENT R.R.SPIKE

~~ON SURFACE~~ - BELOW 1"

OFFSET 6' (CR 19) LT : ~~RT~~

- TO - EDGE PAVEMENT


STATION: 0+00 (SR 108)

HORZ.DATUM: NAD83 2011

GEOID: NAVD88 2012A

GRID: NORTHING: 593226.279


EASTING: 1493773.003

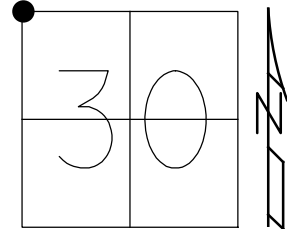

RECORD:
DNF
4-12-85
FD R.R.SPIKE
6-8-95, KPM
FD R.R.SPIKE
1" DOWN
REF1
11-2-16
6-7-18, JFO

SR 281

1A ●

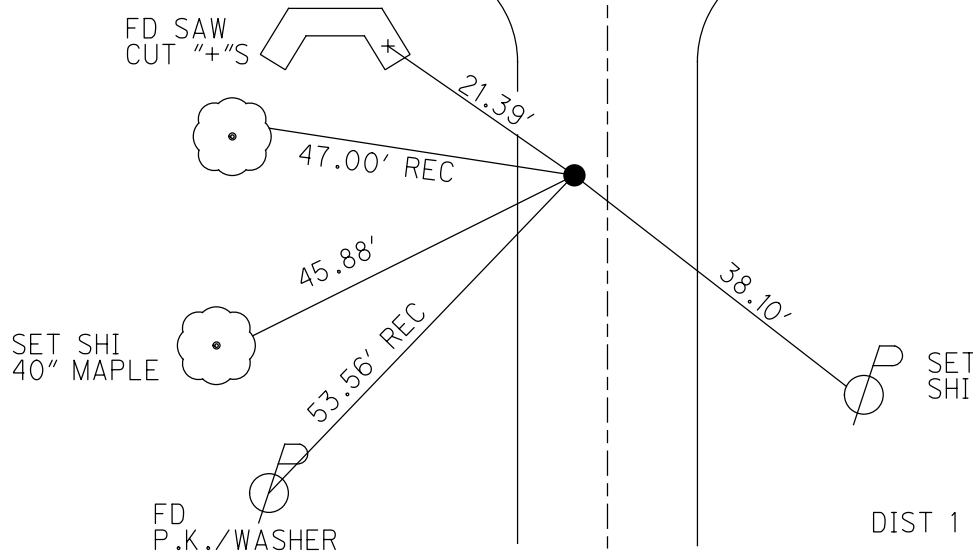

O.D.O.T. DISTRICT 2 SURVEY OFFICE (USE ONLY)

PERSONNEL

REFERENCE NO. 1 A

SHEET 2 OF 20

NOTES RHOADES
H.C. O'DONNELL
R.C. TRENKA

DATE 6-7-18
WEATHER CLOUDY
TEMP. 65°

ROUTE SR 281
COUNTY HENRY
TOWNSHIP FLAT ROCK
SECTION 30
T 4 N R 6 E

DWG BY JAMES PID 102763

TYPE MONUMENT R.R.SPIKE

~~ON SURFACE~~ - BELOW 6"

OFFSET Q PAVEMENT 1.5', 6' LT CR 19 LT : ~~RT~~
- TO - EDGE PAVEMENT



STATION: 0+00

HORZ.DATUM: NAD83 2011

GEOID: NAVD88 2012A

GRID: NORTHING: 593313.784

EASTING: 1493773.356

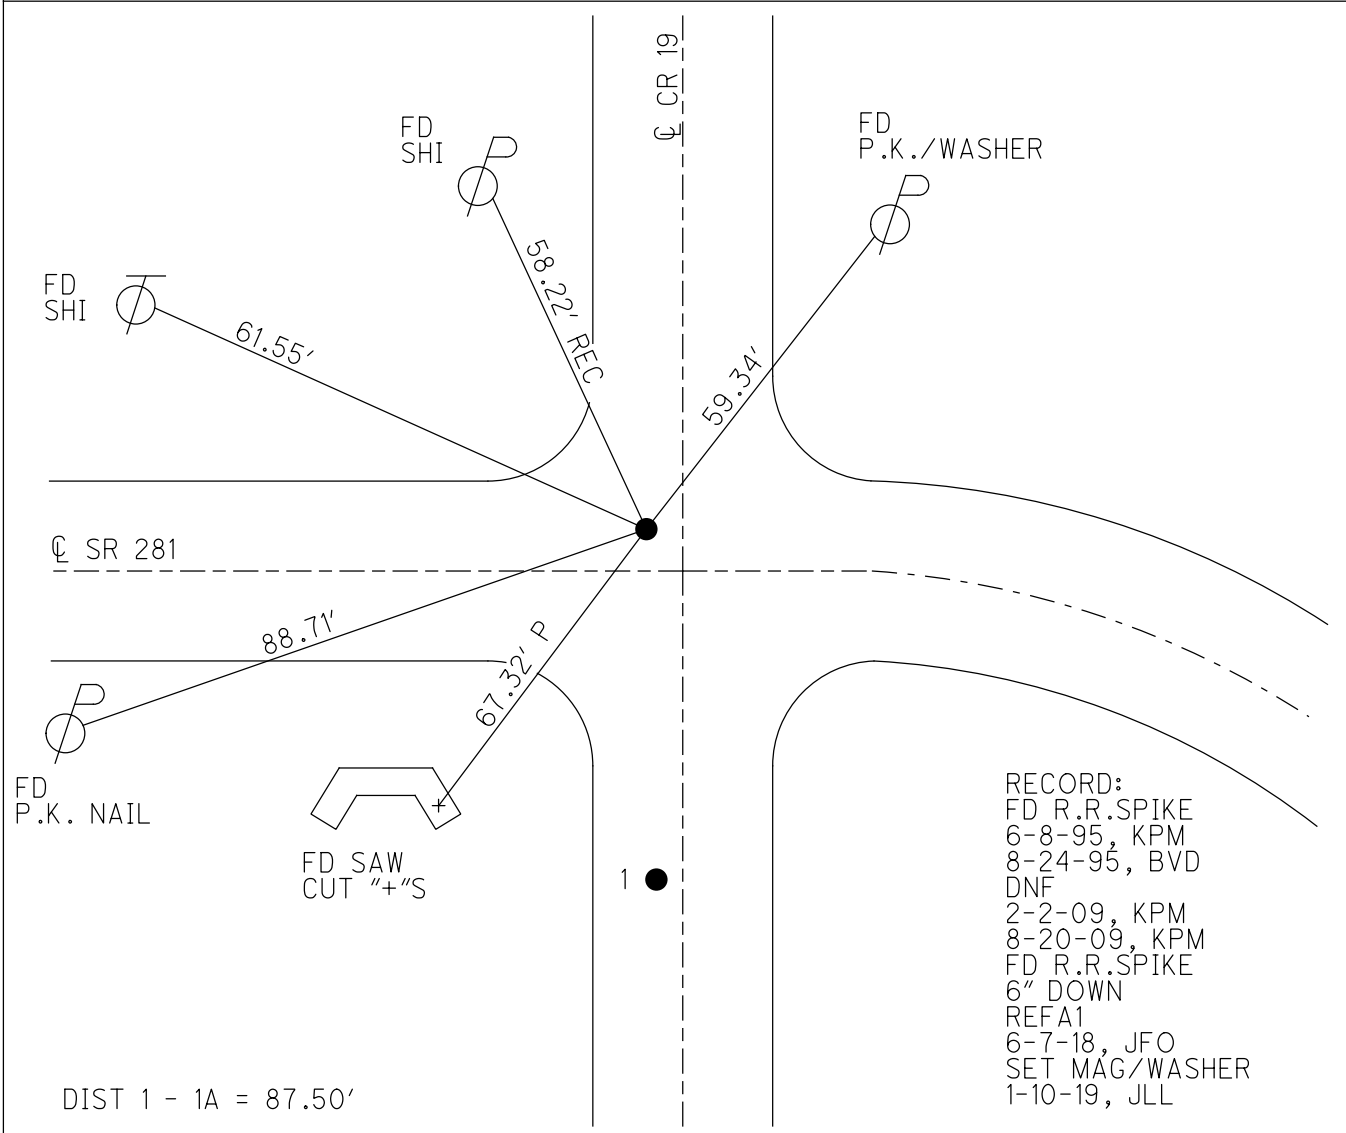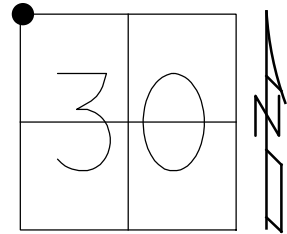

O.D.O.T. DISTRICT 2 SURVEY OFFICE (USE ONLY)

PERSONNEL

REFERENCE NO. 2

SHEET 3 OF 20

NOTES RHOADES

DATE 6-7-18

ROUTE SR 281

H.C. O'DONNELL

WEATHER CLOUDY

COUNTY HENRY

R.C. TRENKA

TEMP. 65°

TOWNSHIP FLAT ROCK

SECTION 30

DWG BY JAMES

PID 102763

T 4 N R 6 E

TYPE MONUMENT MAG/WASHER

ON SURFACE - ~~BELOW~~ ON

OFFSET CL PAVEMENT 2.0' ~~LT~~ : RT

7.1' TO RT EDGE PAVEMENT


STATION: 20+68.37

HORZ.DATUM: NAD83 2011

GEOID: NAVD88 2012A

GRID: NORTHING: 593196.8475

EASTING: 1495831.355

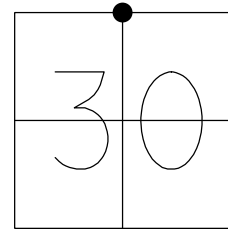

RECORD:

FD R.R.SPIKE

1 1/2" DOWN

1985

SET P.K./WASHER

8-24-95, KPM

FD P.K./WASHER

8-20-09, KPM

SET MAG/WASHER

10-19-09, KPM

FD MAG/WASHER

REF2

11-5-13, TMR

FD MAG/WASHER


REF2

11-2-16, JFO

6-7-18, JFO

SET MAG/WASHER

1-10-19, JLL

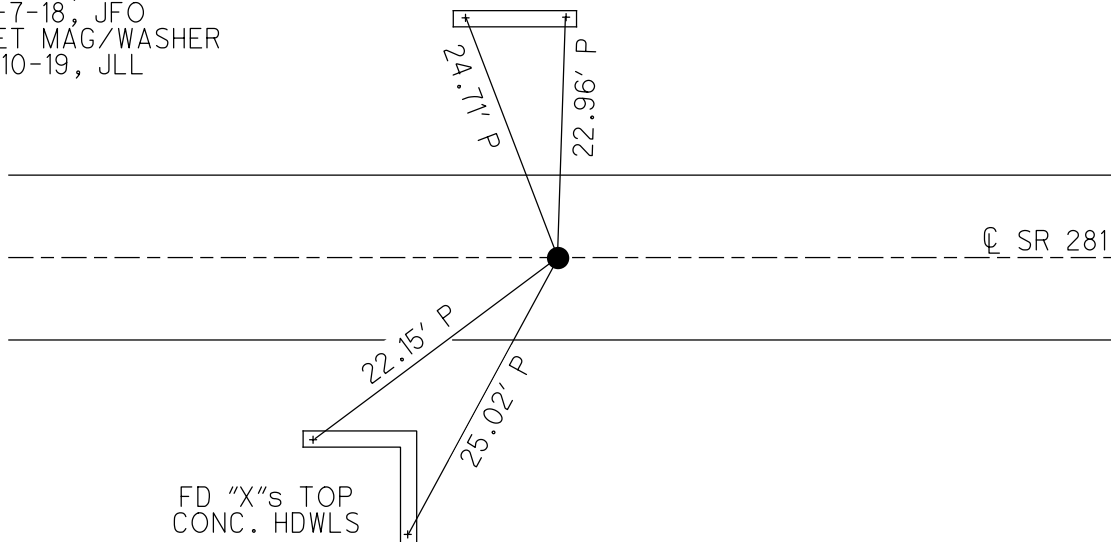

O.D.O.T. DISTRICT 2 SURVEY OFFICE (USE ONLY)

PERSONNEL

REFERENCE NO. 3

SHEET 4 OF 20

NOTES _____ RHOADES _____

DATE 6-7-18

ROUTE SR 281

H.C. O'DONNELL

WEATHER CLOUDY

COUNTY HENRY

R.C. TRENKA

TEMP. 65°

TOWNSHIP FLAT ROCK

DWG BY JAMES PID 102763

T 4 N R 6 F

TYPE MONUMENT SM R.R.SPIKE

ON SURFACE - ~~BELOW~~ ON _____

OFFSET ϕ PAVEMENT 1.8' ~~1.7'~~ : RT


____TO____EDGE PAVEMENT

STATION: 47+12.73


HORZ.DATUM: NAD83 2011

GEOID: NAVD88 2012A

GRID: NORTHING: 593158.721

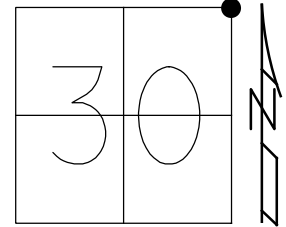EASTING: 1498475.442

RECORD:
FD P.K.NAIL
1985
SET P.K./WASHER
8-28-95, KPM
FD P.K./WASHER
8-20-09, KPM
SET MAG/WASHER
10-19-09, KPM
FD MAG/WASHER
REF3
11-5-13, TMR
FD SM R.R.SPIKE
REF3
8-26-16
11-2-16, JFO
SET MAG/WASHER
1-10-19, JLL

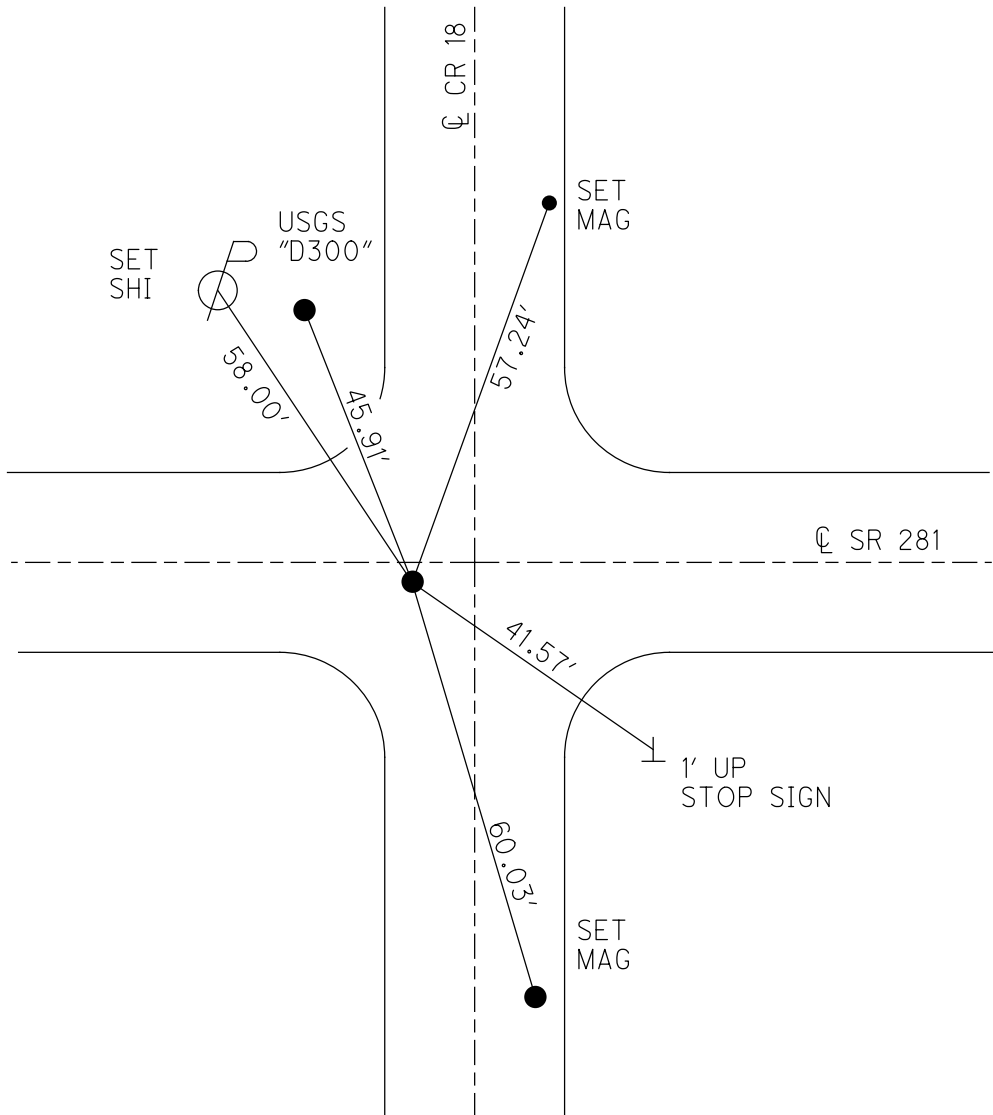


O.D.O.T. DISTRICT 2 SURVEY OFFICE (USE ONLY)


PERSONNEL _____ REFERENCE NO. 4 SHEET 5 OF 20
 NOTES JAMES DATE 1-10-19 ROUTE SR 281
 H.C. LEU WEATHER CLOUDY COUNTY HENRY
 R.C. MILLER TEMP. 24° TOWNSHIP FLAT ROCK
 DWG BY JAMES PID 102763 SECTION 29
 T 4 N R 6 E

TYPE MONUMENT MAG/WASHER
 ON SURFACE - ~~BELOW~~ ON
 OFFSET Q PAVEMENT ON LT : RT
9.8' TO LT EDGE PAVEMENT
 STATION: 73+88.25

HORZ.DATUM: NAD83 2011 GEOID: NAVD88 2012A
 GRID: NORTHING: 593134.559 EASTING: 1501150.850

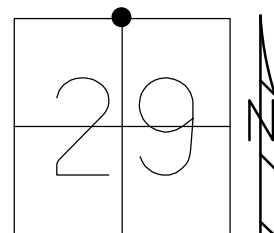

RECORD:
 FD R.R.SPIKE
 1985
 SET P.K./WASHER
 8-28-95, KPM
 FD P.K./WASHER
 8-20-09, KPM
 SET MAG/WASHER
 10-19-09, KPM
 FD MAG/WASHER
 REF4
 11-5-13, TMR
 11-2-16, JFO
 6-7-18, JFO
 SET MAG/WASHER
 1-10-19, JLL

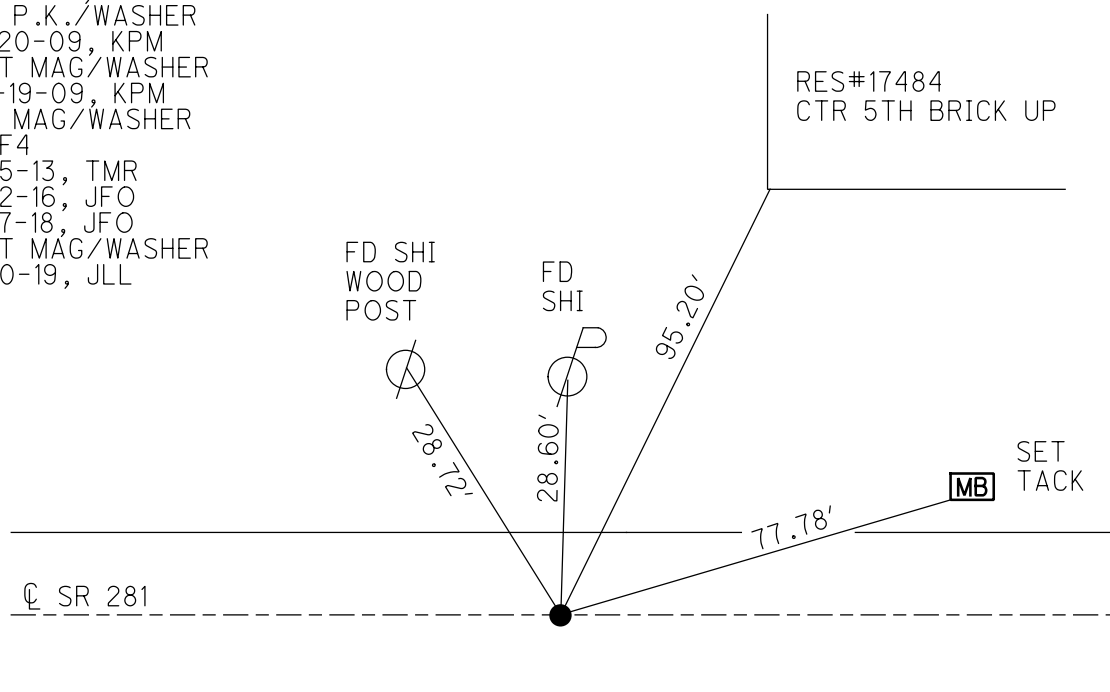

O.D.O.T. DISTRICT 2 SURVEY OFFICE (USE ONLY)

PERSONNEL

REFERENCE NO. 4 A

SHEET 6 OF 20

NOTES RHOADES

DATE 6-7-18

ROUTE SR 281

H.C. O'DONNELL

WEATHER CLOUDY

COUNTY HENRY

R.C. TRENKA

TEMP. 65°

TOWNSHIP FLAT ROCK

SECTION 29

DWG BY JAMES

PID 102763

T 4 N R 6 E

TYPE MONUMENT MAG/WASHER

ON SURFACE - ~~BELOW~~ ON

OFFSET CL PAVEMENT 1.4' ~~LT~~ : RT

8.3' TO RT EDGE PAVEMENT


STATION: 75+18.31

HORIZ.DATUM: NAD83 2011


GEOID: NAVD88 2012A

GRID: NORTHING: 593130.768

EASTING: 1501280.770

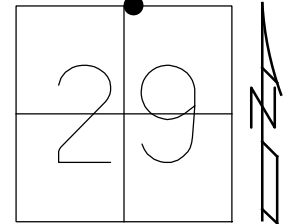

RECORD:
FD P.K.NAIL
1985
SET P.K./WASHER
6-8-95, KPM
FD MAG/WASHER
8-20-09, KPM
SET MAG/WASHER
10-19-09, KPM
FD MAG/WASHER
REFA4
6-7-18, JFO

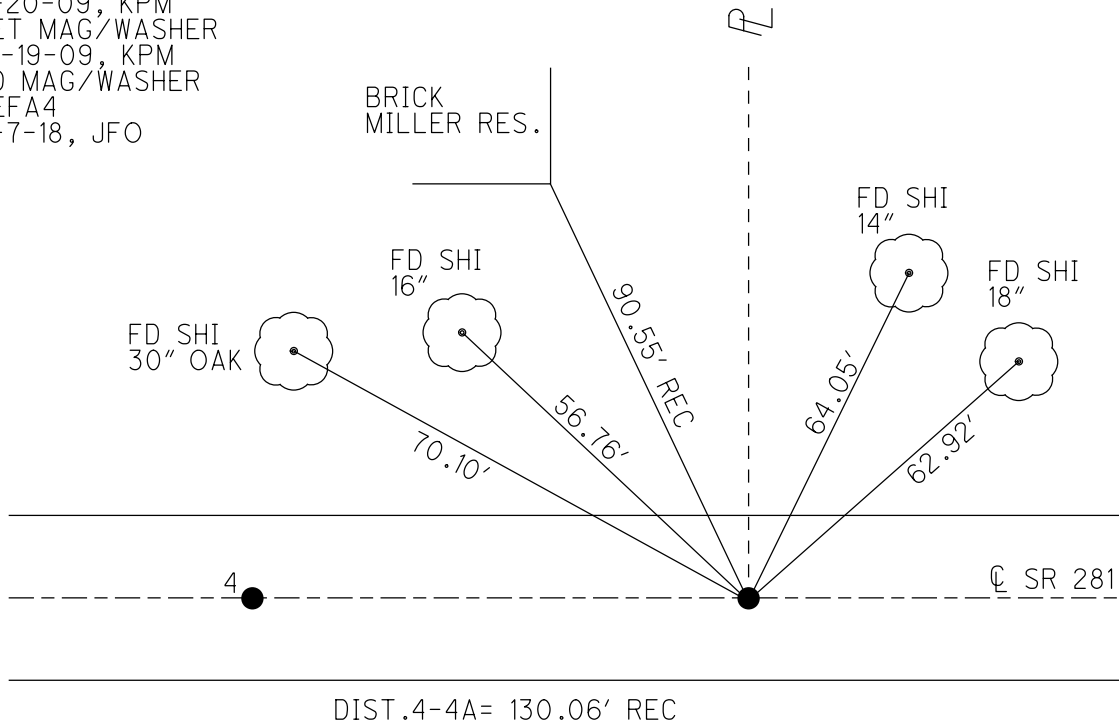

O.D.O.T. DISTRICT 2 SURVEY OFFICE (USE ONLY)

PERSONNEL

REFERENCE NO. 4 B

SHEET 7 OF 20

NOTES RHOADES

DATE 6-7-18

ROUTE SR 281

H.C. O'DONNELL

WEATHER CLOUDY

COUNTY HENRY

R.C. TRENKA

TEMP. 65°

TOWNSHIP FLAT ROCK

SECTION 29

DWG BY JAMES

PID 102763

T 4 N R 6 E

TYPE MONUMENT P.K. SHANK

ON SURFACE - ~~BELOW~~ ON

OFFSET CL PAVEMENT 4' ~~LT~~ : RT

6.6' TO RT EDGE PAVEMENT


STATION: 76+48.17

HORZ.DATUM: NAD83 2011

GEOID: NAVD88 2012A

GRID: NORTHING: 593126.832

EASTING: 1501410.527

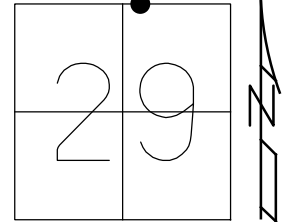

RECORD:

FD P.K.NAIL

1985

SET P.K./WASHER

6-8-95, KPM

FD P.K./WASHER

8-20-09, KPM


SET MAG/WASHER

10-19-09, KPM

FD P.K. SHANK

REFB4

6-7-18, JFO

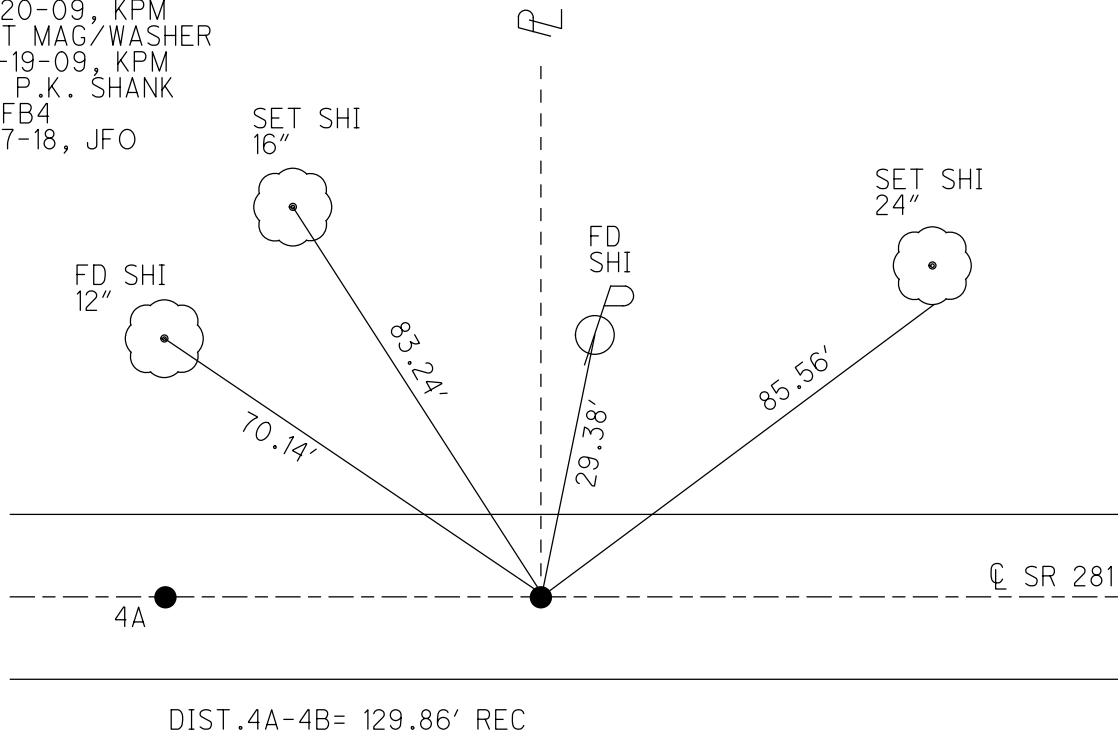

O.D.O.T. DISTRICT 2 SURVEY OFFICE (USE ONLY)

PERSONNEL

REFERENCE NO. 4 C

SHEET 8 OF 20

NOTES RHOADES

DATE 6-7-18

ROUTE SR 281

H.C. O'DONNELL

WEATHER CLOUDY

COUNTY HENRY

R.C. TRENKA

TEMP. 65°

TOWNSHIP FLAT ROCK

SECTION 29

DWG BY JAMES

PID 102763

T 4 N R 6 E

TYPE MONUMENT MAG/WASHER

ON SURFACE - ~~BELOW~~ ON

OFFSET CL PAVEMENT 5.4' ~~LT~~ : RT

5.0' TO RT EDGE PAVEMENT



STATION: 77+78.13

HORZ.DATUM: NAD83 2011

GEOID: NAVD88 2012A

GRID: NORTHING: 593122.885

EASTING: 1501540.408

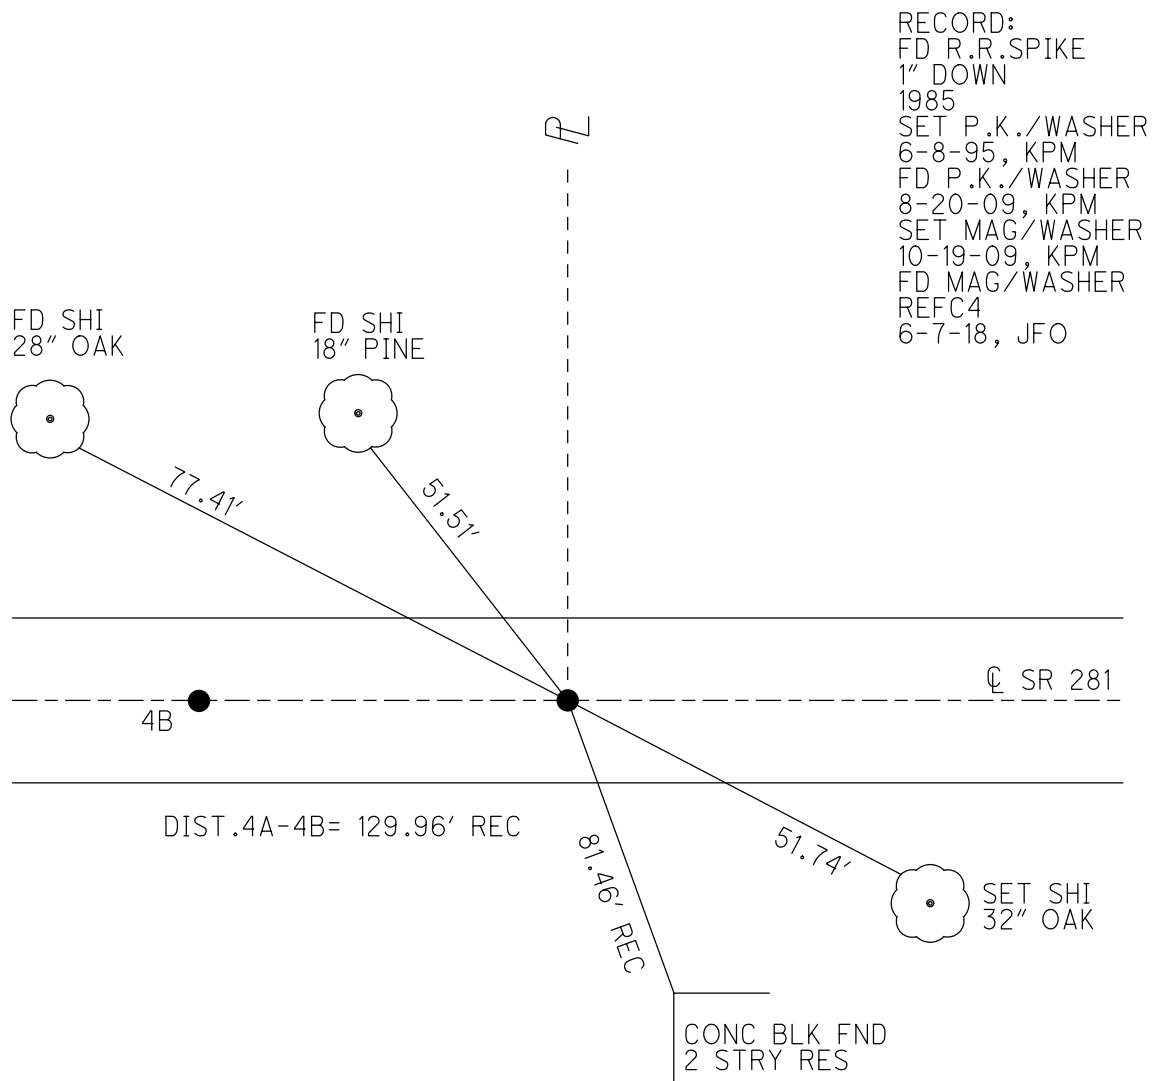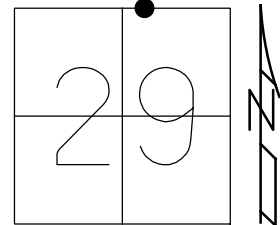

O.D.O.T. DISTRICT 2 SURVEY OFFICE (USE ONLY)

PERSONNEL

REFERENCE NO. 5

SHEET 9 OF 20

NOTES RHOADES

DATE 6/7/18

ROUTE SR 281

H.C. O'DONNELL

WEATHER CLOUDY

COUNTY HENRY

R.C. TRENKA

TEMP. 65°

TOWNSHIP FLAT ROCK

DWG BY NIESE PID 105662

SECTION 29

T 4 N R 6 E

TYPE MONUMENT MAG/WASHER

ON SURFACE - ~~BELOW~~ ON

OFFSET Q PAVEMENT ON LT : RT

9.8' TO LT EDGE PAVEMENT


STATION: 100+59.26

HORZ.DATUM: NAD83 2011


GEOID: NAVD88 2012A

GRID: NORTHING: 593056.696

EASTING: 1503820.722

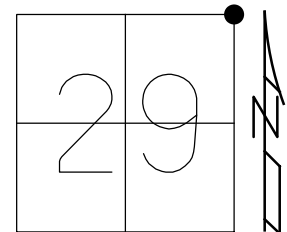

RECORD:
FD R.R.SPIKE
1.5" DOWN
1985
SET P.K./WASHER
8/28/95, KPM
FD P.K./WASHER
8/20/09, KPM
SET MAG/WASHER
10/19/09, KPM
FD MAG/WASHER
11/2/16, JFO
6/7/18, JFO
SET MAG/WASHER
NEWREF5
8/2/18, JFO
FD MAG/WASHER
1/10/19, JLL
4/14/21, JFO

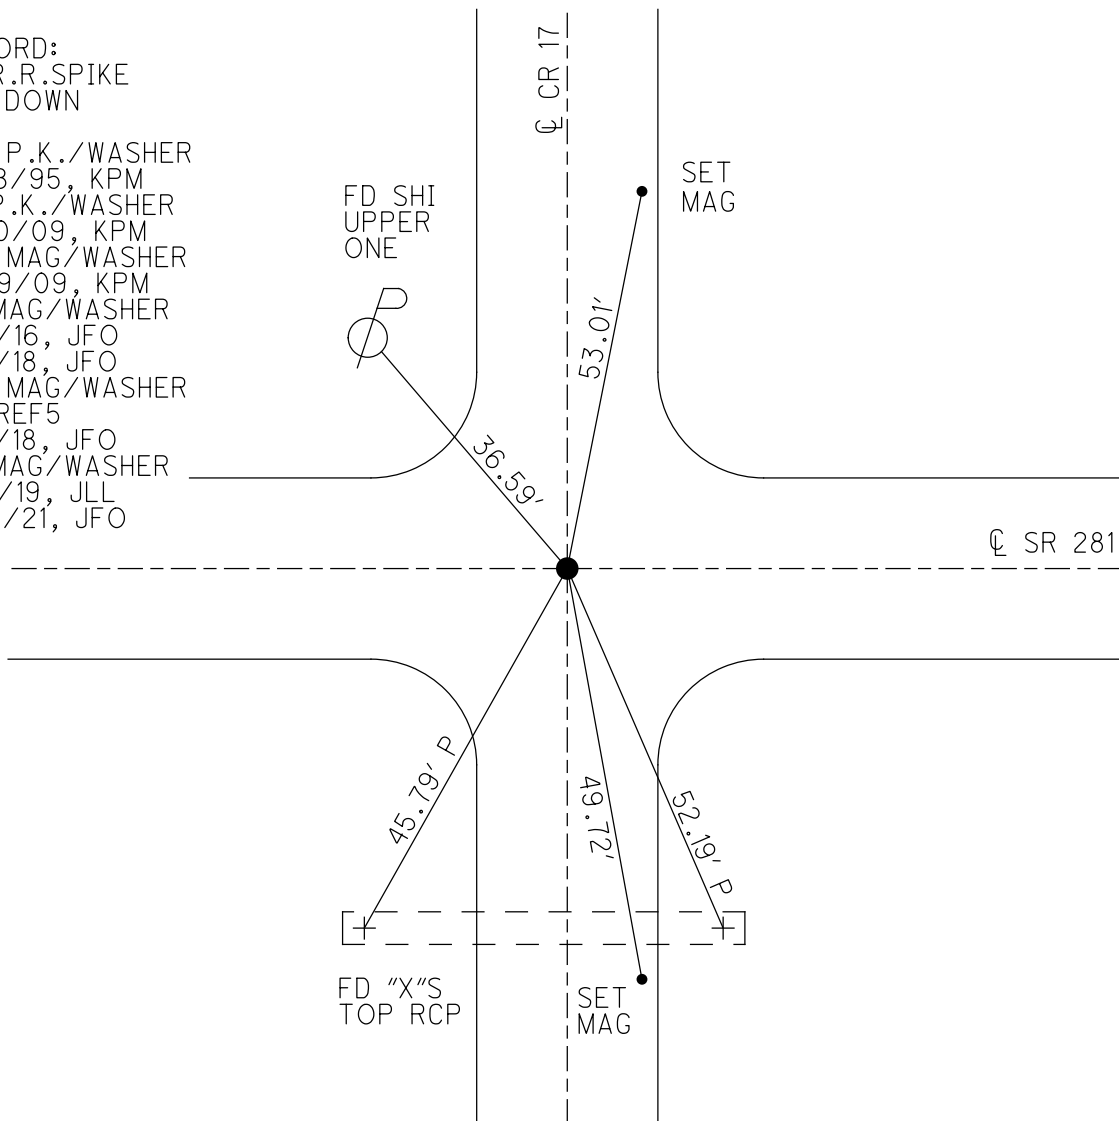

O.D.O.T. DISTRICT 2 SURVEY OFFICE (USE ONLY)

PERSONNEL

REFERENCE NO. 6

SHEET 10 OF 20

NOTES HAGEMeyer

DATE 6/7/18

ROUTE SR 281

H.C. LEU

WEATHER CLOUDY

COUNTY HENRY

R.C. HAGEMeyer

TEMP. 69°

TOWNSHIP FLAT ROCK

SECTION 28

DWG BY NIESE

PID 105662

T 4 N R 6 E

TYPE MONUMENT MAG/WASHER

ON SURFACE - ~~BELOW~~ ON

OFFSET CL PAVEMENT 3.2' LT : RT

7.0' TO RT EDGE PAVEMENT


STATION: 126+98.79

HORIZ.DATUM: NAD83 2011


GEOID: NAVD88 2012A

GRID: NORTHING: 593014.845

EASTING: 1506459.925

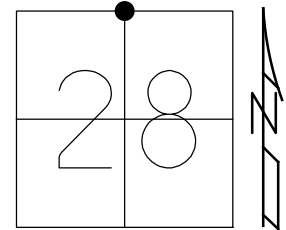

RECORD:
FD R.R.SPIKE
1985
SET P.K./WASHER
8/28/95, KPM
FD P.K./WASHER
8/20/09, KPM
SET MAG/WASHER
10/19/09, KPM
FD MAG/WASHER
11/2/16, JFO
SET MAG/WASHER
NEWREF6
8/6/18, JFO
FD MAG/WASHER
6/7/18, JLL
1/10/19, JLL
4/14/21, JFO

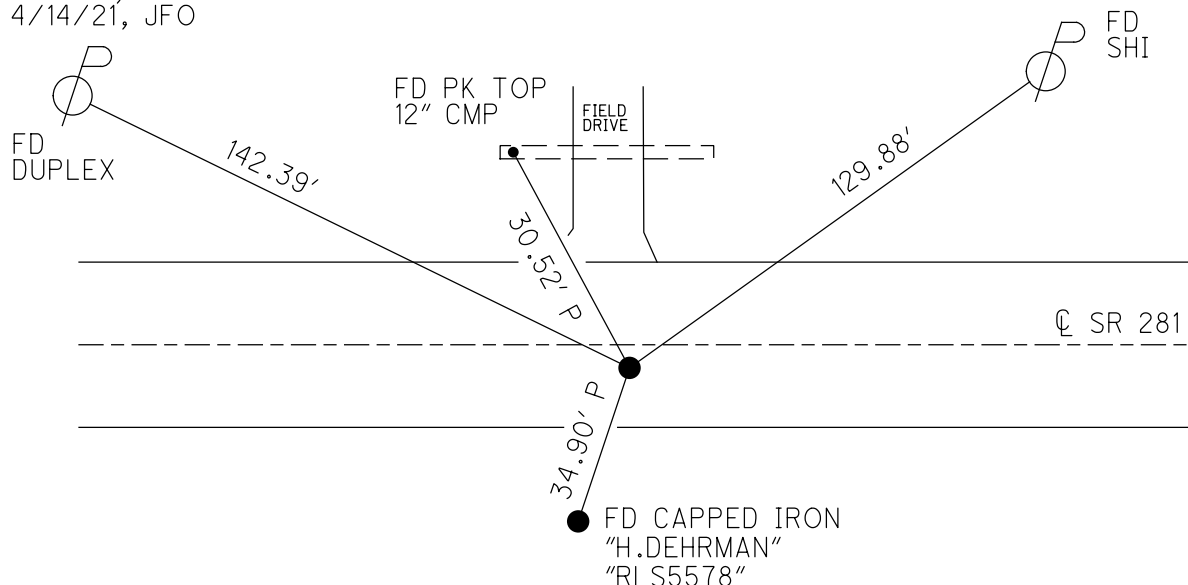

O.D.O.T. DISTRICT 2 SURVEY OFFICE (USE ONLY)

PERSONNEL

REFERENCE NO. 7

SHEET 11 OF 20

NOTES HAGEMEYER

DATE 6/7/18

ROUTE SR 281

H.C. LEU

WEATHER CLOUDY

COUNTY HENRY

R.C. HAGEMEYER

TEMP. 69°

TOWNSHIP FLAT ROCK

SECTION 28

DWG BY NIESE

PID 102763

T 4 N R 6 E

TYPE MONUMENT MAG/WASHER

ON SURFACE - ~~BELOW~~ ON

OFFSET CL PAVEMENT ON LT : RT

9.4' TO RT EDGE PAVEMENT



STATION: 153+27.69

HORZ.DATUM: NAD83 2011

GEOID: NAVD88 2012A

GRID: NORTHING: 593041.706

EASTING: 1509088.706

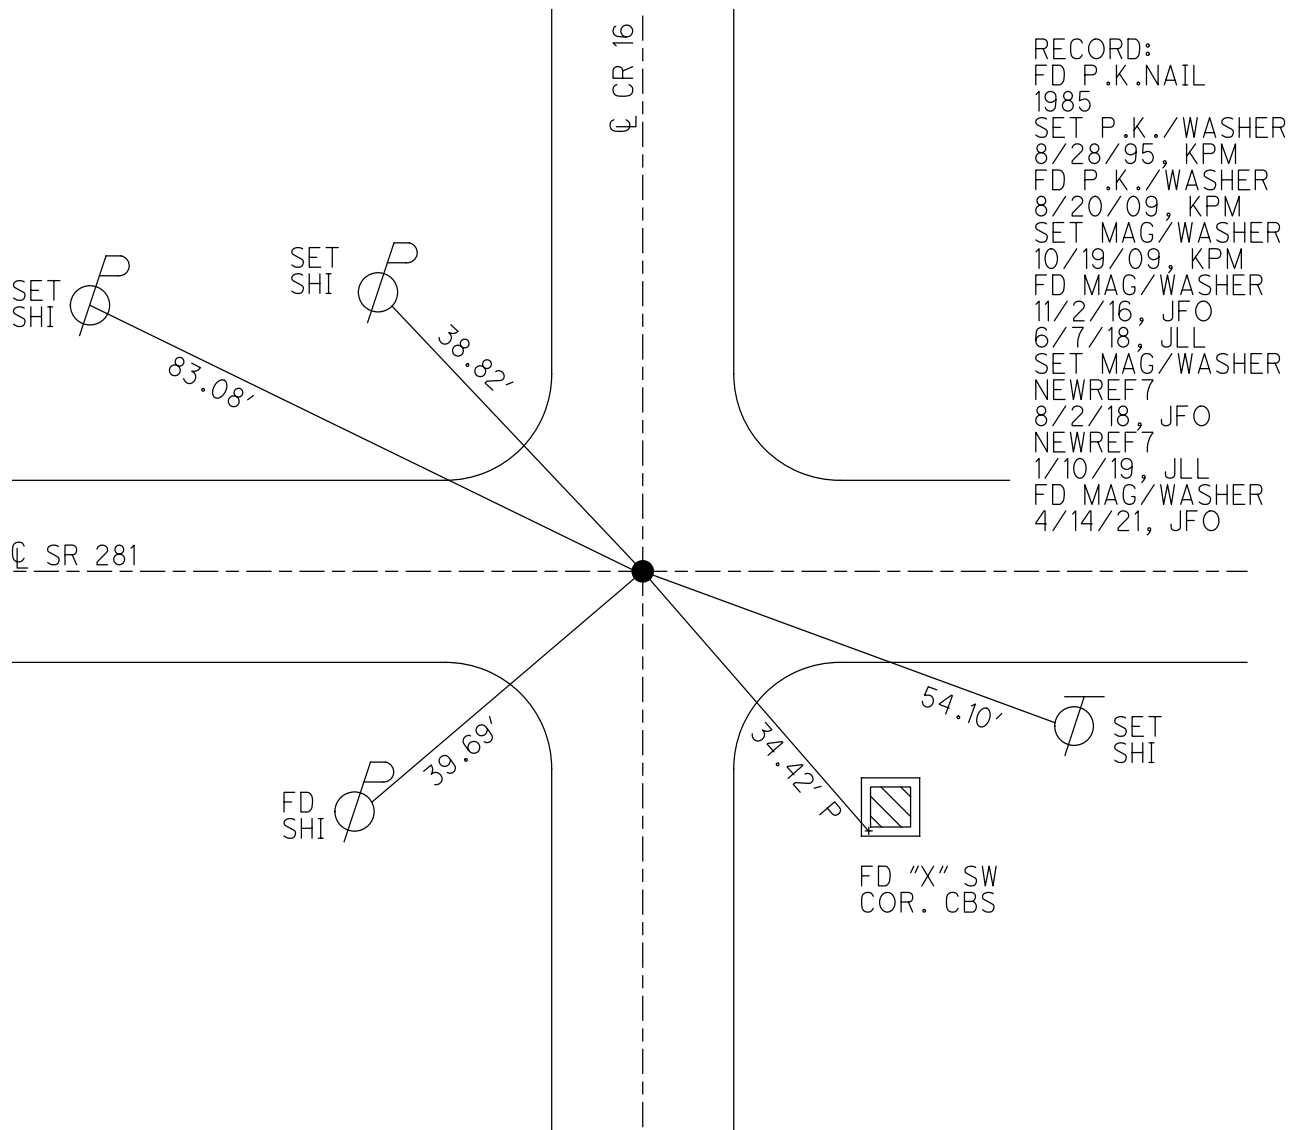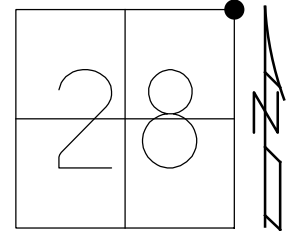

O.D.O.T. DISTRICT 2 SURVEY OFFICE (USE ONLY)

PERSONNEL

REFERENCE NO. 8

SHEET 12 OF 20

NOTES HAGEMEYER

DATE 6-7-18

ROUTE SR 281

H.C. LEU

WEATHER CLOUDY

COUNTY HENRY

R.C. HAGEMEYER

TEMP. 68°

TOWNSHIP FLAT ROCK

SECTION 27

DWG BY JAMES

PID 102763

T 4 N R 6 E

TYPE MONUMENT MAG/WASHER

ON SURFACE - ~~BELOW~~ ON

OFFSET Q PAVEMENT 5' ~~LT~~ : RT

4.8' TO RT EDGE PAVEMENT


STATION: 179+70.17

HORZ.DATUM: NAD83 2011

GEOID: NAVD88 2012A

GRID: NORTHING: 593009.989

EASTING: 1511730.975

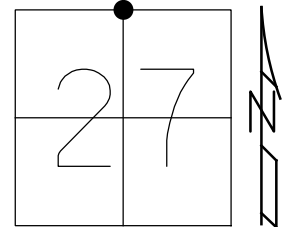

RECORD:

FD P.K./WASHER

1985

SET P.K./WASHER

8-28-95, KPM

FD P.K./WASHER

8-20-09, KPM

SET MAG/WASHER

10-19-09, KPM

FD MAG/WASHER


REF8

11-2-16, JFO

6-7-18, JLL

SET MAG/WASHER

1-10-19, JLL

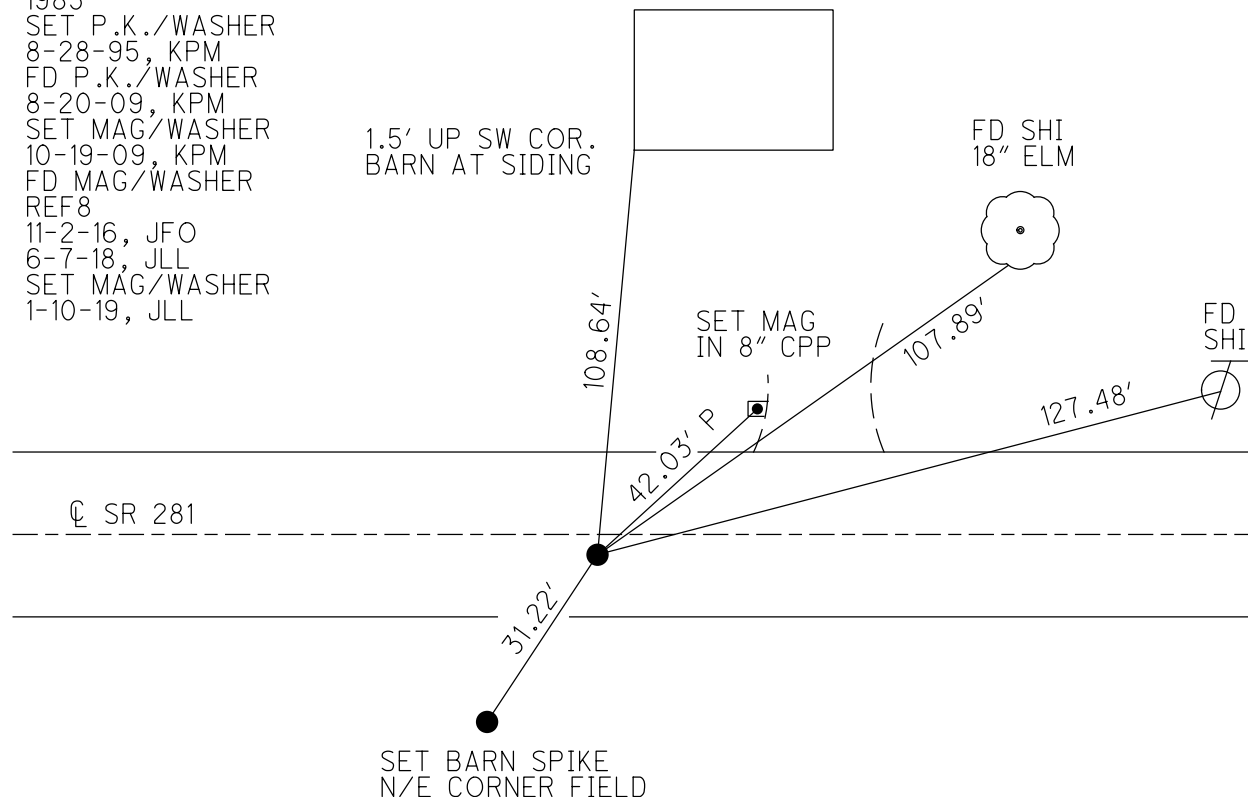

O.D.O.T. DISTRICT 2 SURVEY OFFICE (USE ONLY)

PERSONNEL

REFERENCE NO. 9

SHEET 13 OF 20

NOTES HAGEMEYER

DATE 6-7-18

ROUTE SR 281

H.C. LEU

WEATHER CLOUDY

COUNTY HENRY

R.C. HAGEMEYER

TEMP. 68°

TOWNSHIP FLAT ROCK

SECTION 27

DWG BY JAMES

PID 102763

T 4 N R 6 E

TYPE MONUMENT MAG/WASHER

ON SURFACE - ~~BELOW~~ ON

OFFSET CL PAVEMENT 5.0', 3.2' LT CR 15 ~~LT~~ : RT

5.3' TO RT EDGE PAVEMENT



STATION: 206+13.89

HORIZ.DATUM: NAD83 2011

GEOID: NAVD88 2012A

GRID: NORTHING: 592983.316

EASTING: 1514374.569

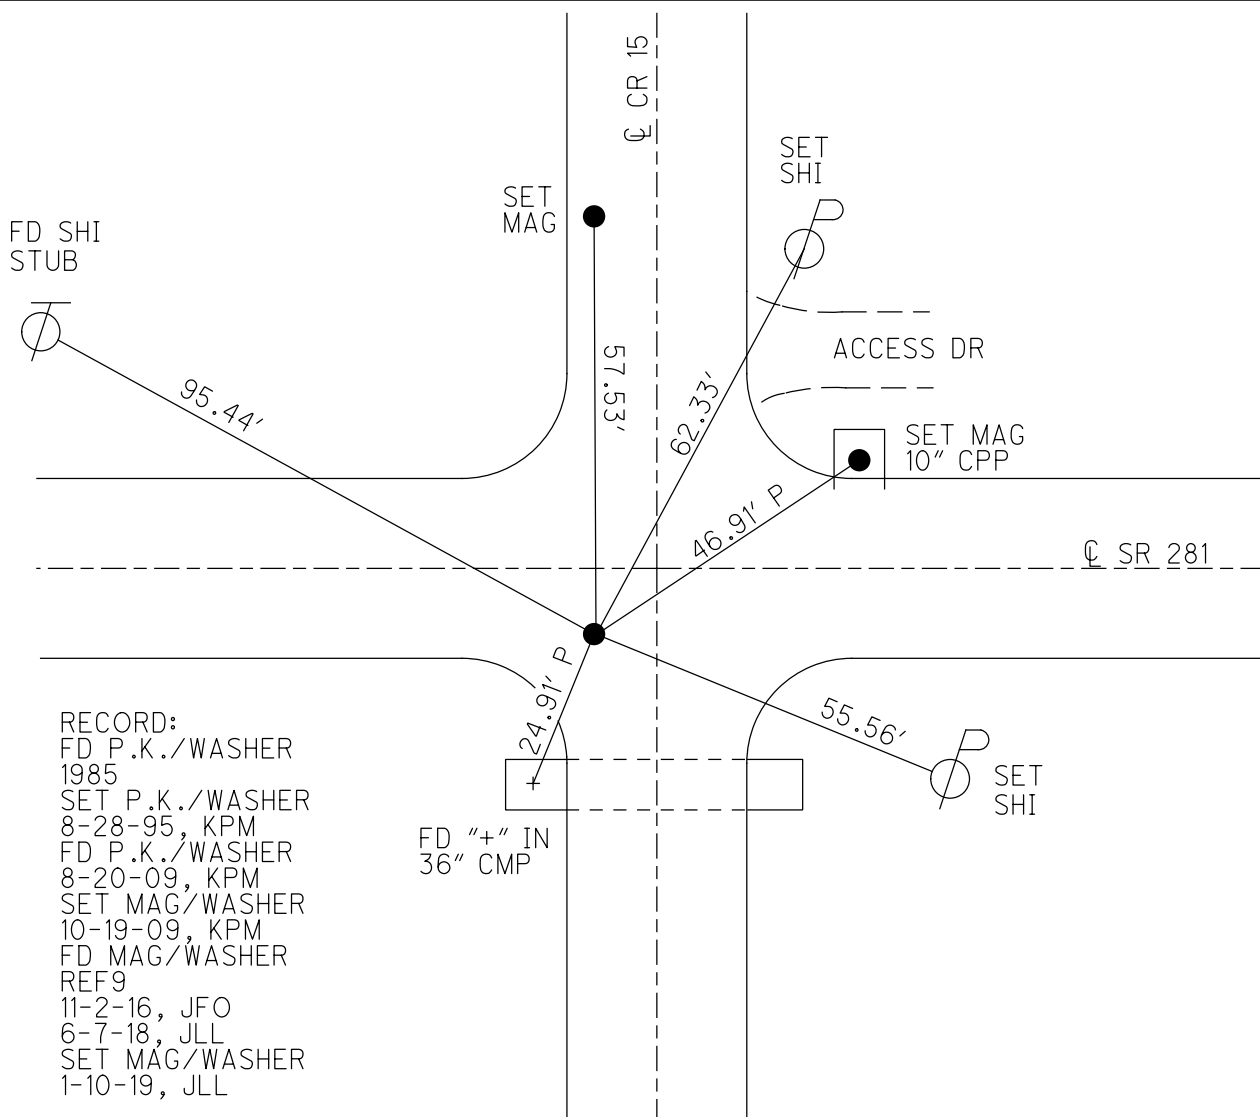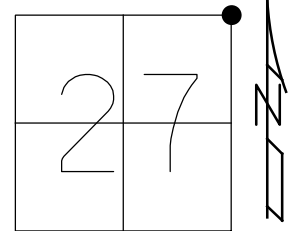


O.D.O.T. DISTRICT 2 SURVEY OFFICE (USE ONLY)


PERSONNEL _____ REFERENCE NO. 10 SHEET 14 OF 20
 NOTES HAGEMEYER DATE 6-7-18 ROUTE SR 281
 H.C. LEU WEATHER CLOUDY COUNTY HENRY
 R.C. HAGEMEYER TEMP. 64° TOWNSHIP FLAT ROCK
 DWG BY JAMES PID 102763 SECTION 26
 T 4 N R 6 E

TYPE MONUMENT MAG/WASHER
 ON SURFACE - ~~BELOW~~ ON
 OFFSET Q PAVEMENT 8.3' LT : RT
2.0' TO RT EDGE PAVEMENT
 STATION: 232+32.13

HORIZ.DATUM: NAD83 2011 GEOID: NAVD88 2012A
 GRID: NORTHING: 592940.514 EASTING: 1516992.456

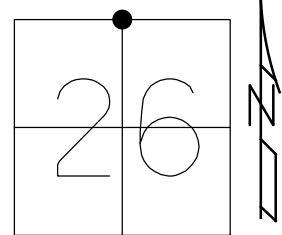

RECORD:
 FD P.K./WASHER
 1985
 SET P.K./WASHER
 8-28-95, KPM
 FD P.K./WASHER
 8-20-09, KPM
 SET MAG/WASHER
 10-26-09, KPM
 FD MAG/WASHER
 REF10
 11-2-16, JFO
 6-7-18, JLL
 SET MAG/WASHER
 1-10-18, JLL

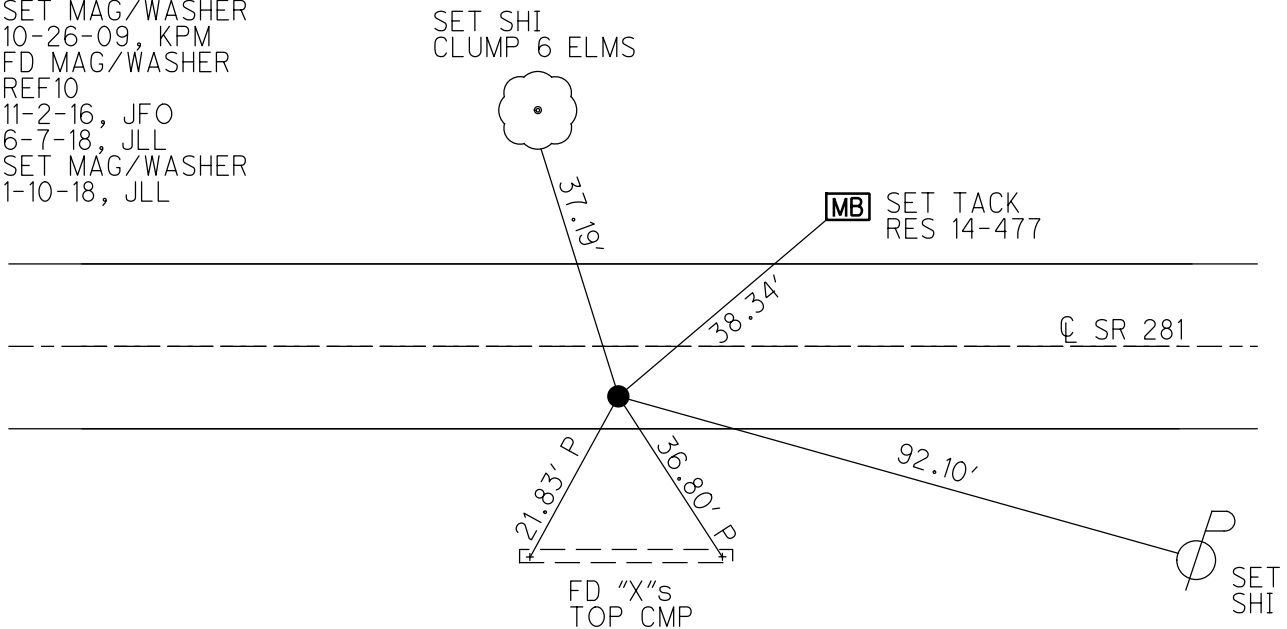

O.D.O.T. DISTRICT 2 SURVEY OFFICE (USE ONLY)

PERSONNEL

REFERENCE NO. 11

SHEET 15 OF 20

NOTES HAGEMEYER

DATE 6-7-18

ROUTE SR 281

H.C. LEU

WEATHER CLOUDY

COUNTY HENRY

R.C. HAGEMEYER

TEMP. 64°

TOWNSHIP FLAT ROCK

SECTION 26

DWG BY JAMES PID 102763

T 4 N R 6 E

TYPE MONUMENT MAG/WASHER

ON SURFACE - ~~BELOW~~ ON

OFFSET Q PAVEMENT 3.3', 5.5' L CR 14 LT : ~~RT~~

6.4' TO LT EDGE PAVEMENT



STATION: 258+49.04±

HORZ.DATUM: NAD83 2011

GEOID: NAVD88 2012A

GRID: NORTHING: 592929.156

EASTING: 1519609.719

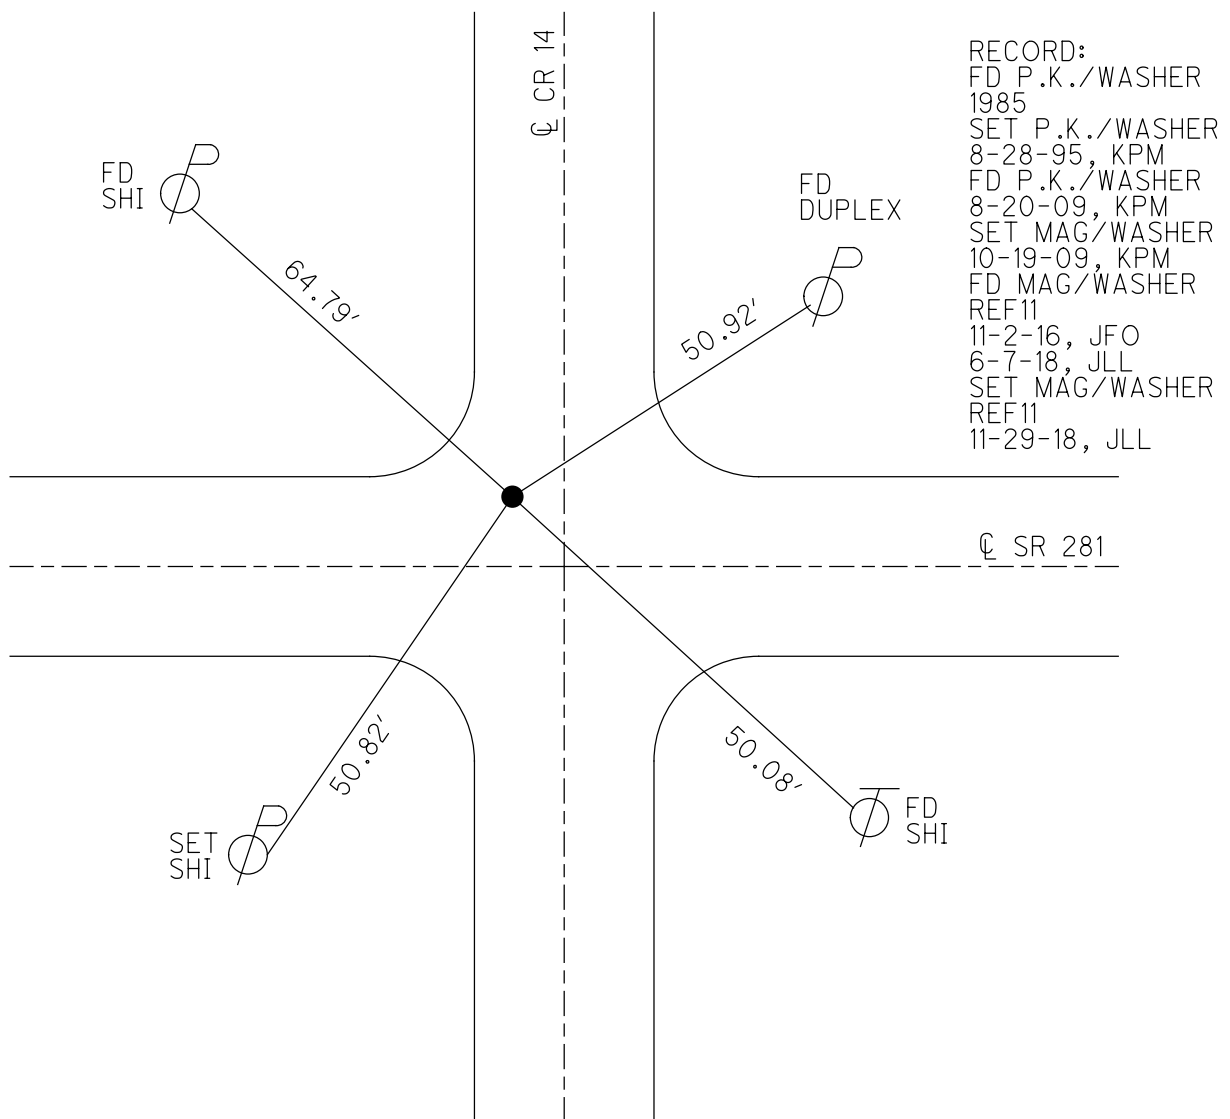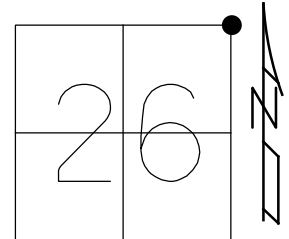

O.D.O.T. DISTRICT 2 SURVEY OFFICE (USE ONLY)

PERSONNEL

REFERENCE NO. 12

SHEET 16 OF 20

NOTES HAGEMEYER

DATE 6-7-18

ROUTE SR 281

H.C. LEU

WEATHER CLOUDY

COUNTY HENRY

R.C. HAGEMEYER

TEMP. 63°

TOWNSHIP FLAT ROCK

SECTION 25

DWG BY JAMES

PID 102763

T 4 N R 6 E

TYPE MONUMENT MAG/WASHER

ON SURFACE - ~~BELOW~~ ON

OFFSET CL PAVEMENT 1.4' ~~LT~~ : RT

8.6' TO RT EDGE PAVEMENT


STATION: 285+00.24

HORIZ.DATUM: NAD83 2011

GEOID: NAVD88 2012A

GRID: NORTHING: 592915.493

EASTING: 1522260.506

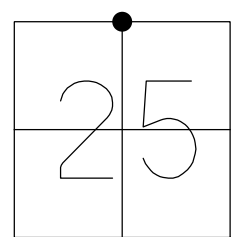

RECORD:

FD P.K./WASHER
1985

SET P.K./WASHER

8-28-95, KPM

FD P.K./WASHER

8-20-09, KPM

SET MAG/WASHER

10-26-09, KPM

FD MAG/WASHER


REF12

11-2-16, JFO

6-7-18, JLL

SET MAG/WASHER

11-16-18, JLL

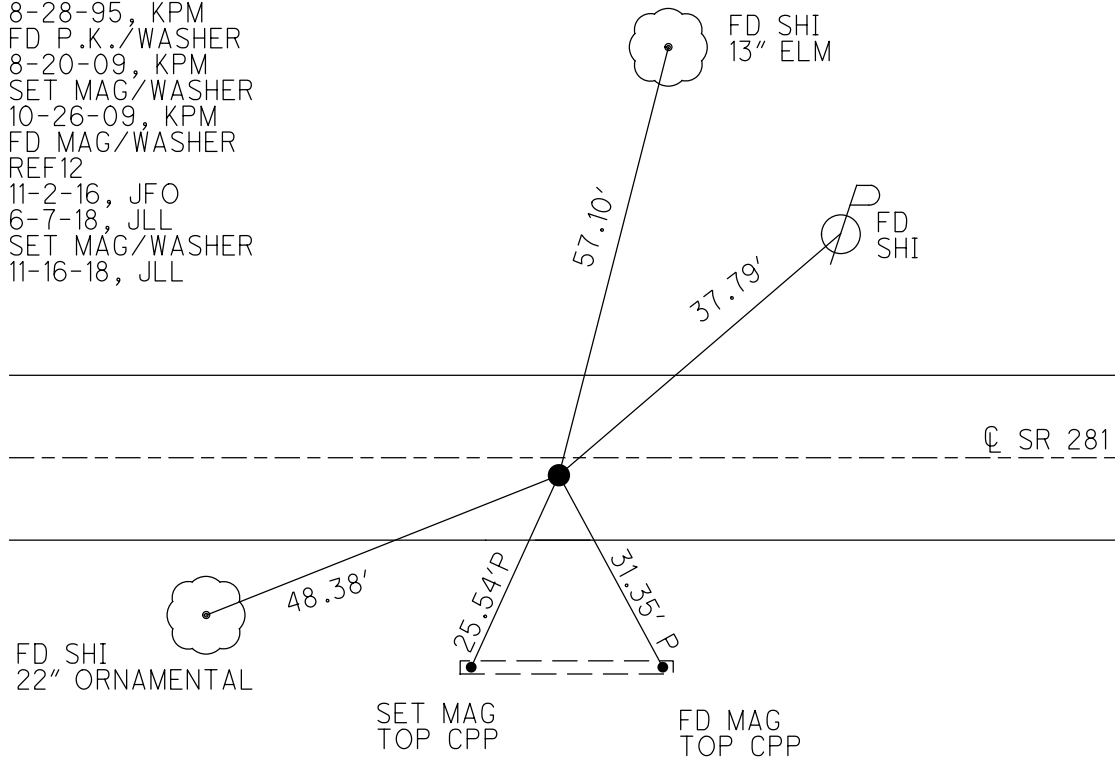

O.D.O.T. DISTRICT 2 SURVEY OFFICE (USE ONLY)

PERSONNEL

REFERENCE NO. 12 A

SHEET 17 OF 20

NOTES CANTERBURY

DATE 5-19-98

ROUTE SR 281

H.C. ROUSOS

WEATHER SUNNY

COUNTY HENRY

R.C. HUSS

TEMP. +80°

TOWNSHIP FLAT ROCK

SECTION 25

DWG BY JAMES PID 102763

T 4 N R 6 E

TYPE MONUMENT P.K./WASHER

ON SURFACE - ~~BELOW~~ ON

OFFSET Q PAVEMENT ON, 15.4' SR 108 LT : RT

- TO - EDGE PAVEMENT


STATION: 301+48.8

HORIZ.DATUM: NAD83 2011

GEOID: NAVD88 2012A


GRID: NORTHING: 592911.473

EASTING: 1523949.701

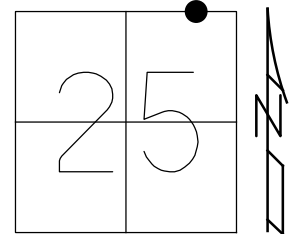

RECORD: P.I.
SR 108
STA 444+96.06
P.K./WASHER SET
9-17-92, MDB
FD P.K./WASHER
5-19-98, TMR
DNF
8-20-09, KPM
9/4/18, JFO
SET MAG/WASHER
REFA35
11/6/18, JLL

NOTE: REF 35A SR 108

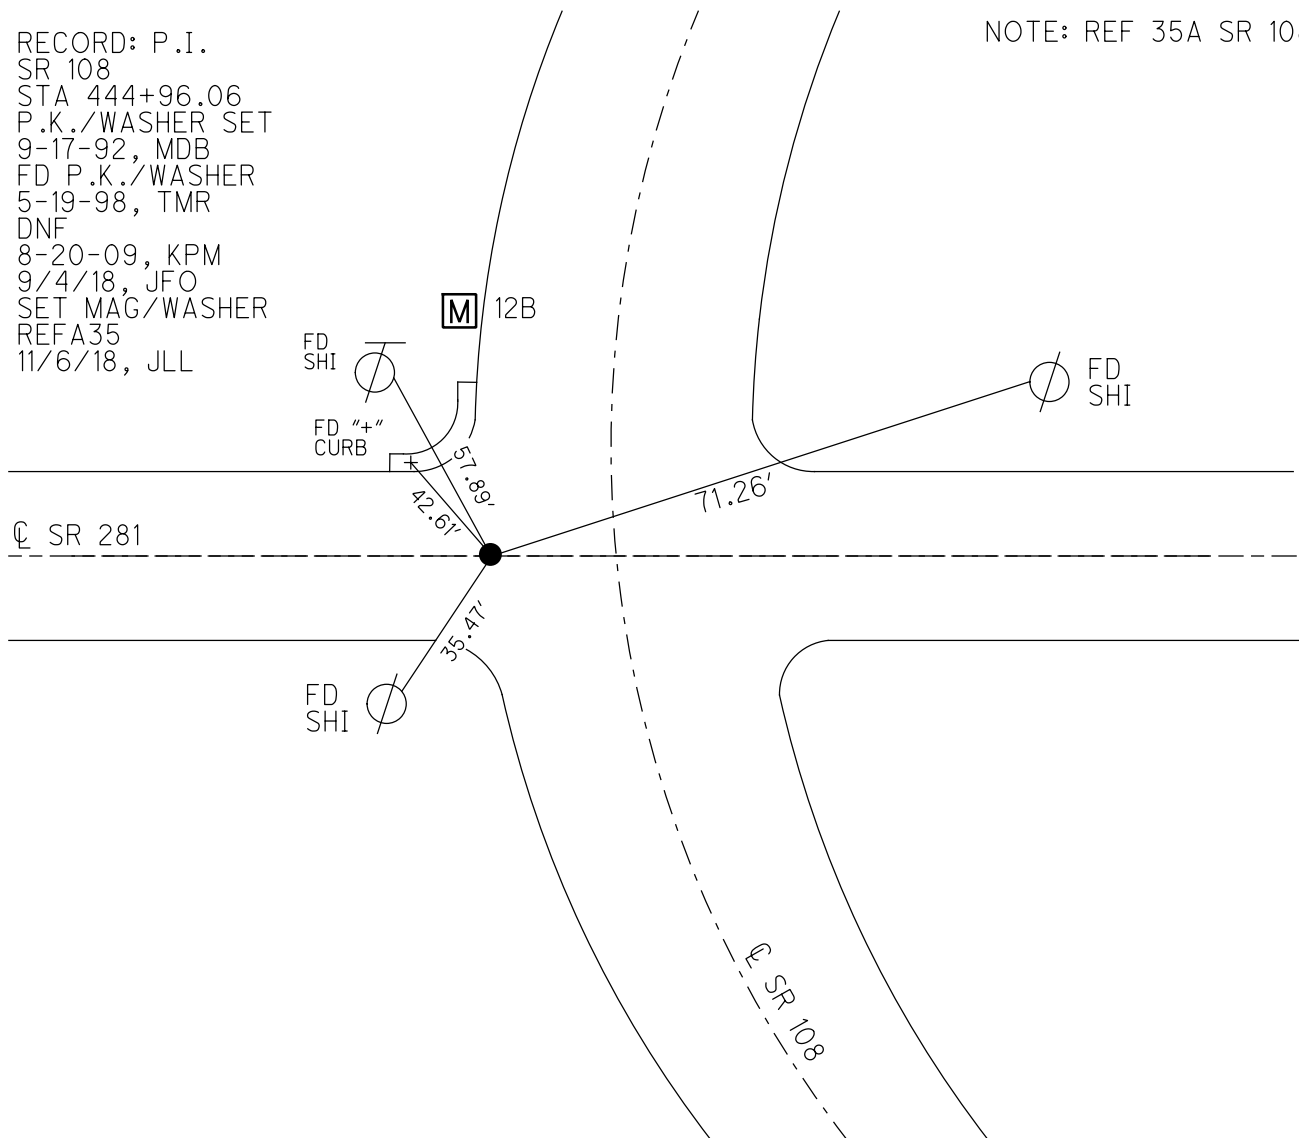

O.D.O.T. DISTRICT 2 SURVEY OFFICE (USE ONLY)

PERSONNEL

REFERENCE NO. 12 B

SHEET 18 OF 20

NOTES CANTERBURY

DATE 5-19-98

ROUTE SR 281

H.C. ROUSOS

WEATHER SUNNY

COUNTY HENRY

R.C. HUSS

TEMP. +80°

TOWNSHIP FLAT ROCK

SECTION 25

DWG BY JAMES

PID 102763

T 4 N R 6 E

TYPE MONUMENT MONBOX

ON SURFACE - ~~BELOW~~ ON

OFFSET CL PAVEMENT - LT : RT

- TO - EDGE PAVEMENT


STATION: 301+48.8

HORZ.DATUM: NAD83 2011

GEOID: NAVD88 2012A


GRID: NORTHING: 592978.643

EASTING: 1523934.676

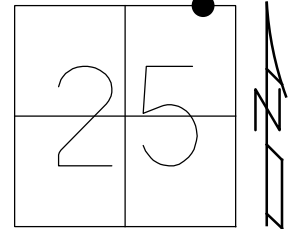



CONC.
BLDG

NOTE: REF 36 SR 108

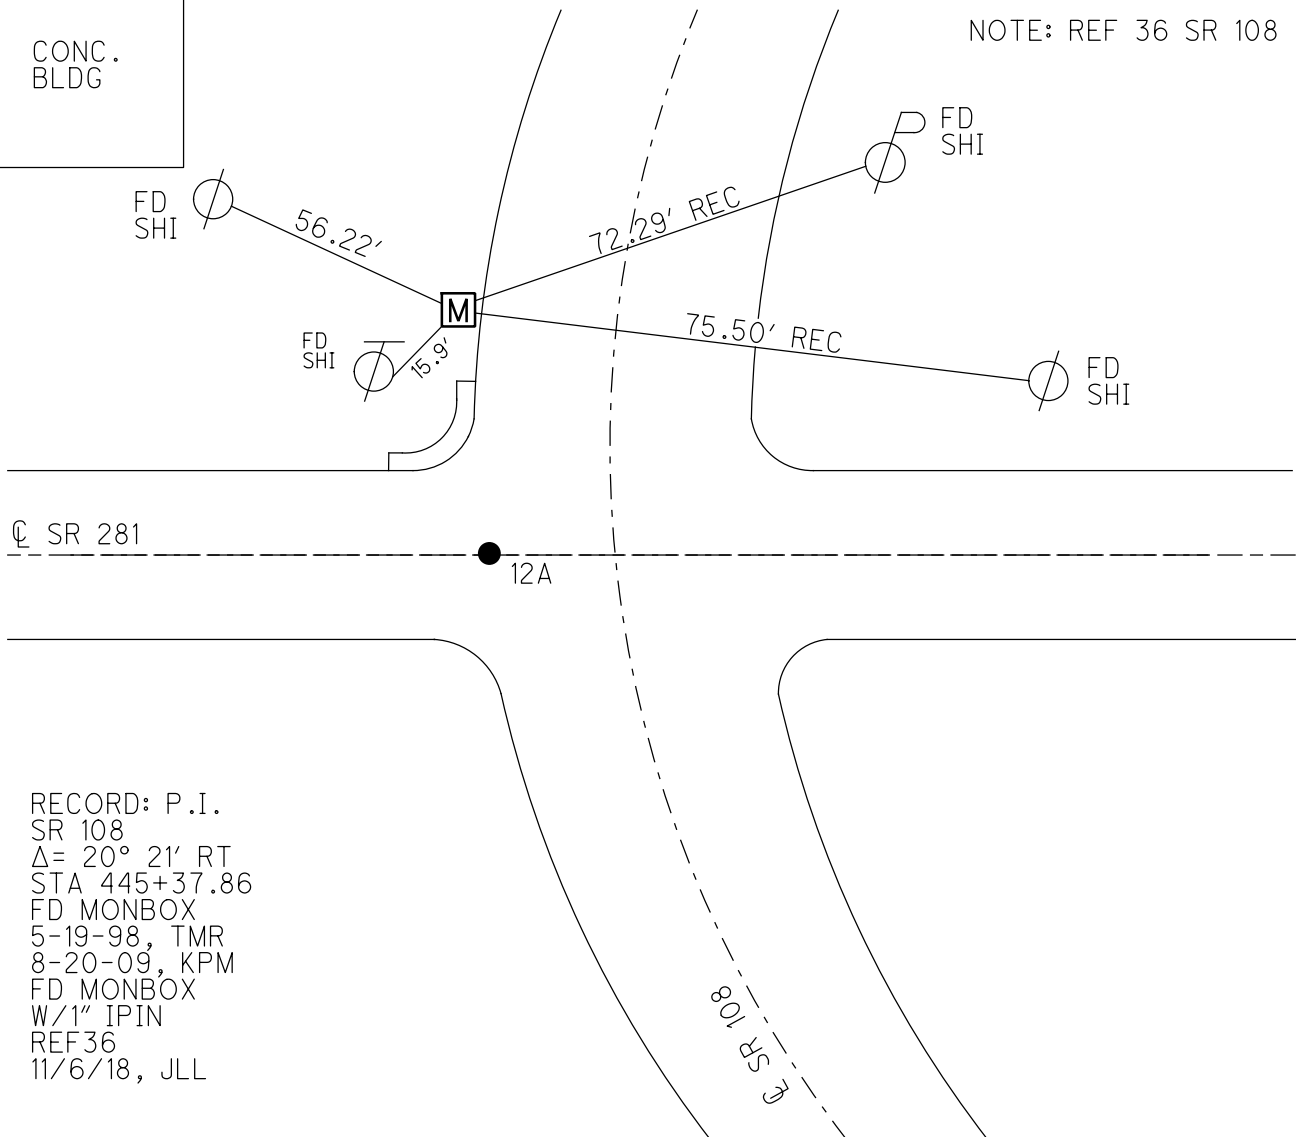

RECORD: P.I.
SR 108
 $\Delta = 20^\circ$ 21' RT
STA 445+37.86
FD MONBOX
5-19-98, TMR
8-20-09, KPM
FD MONBOX
W/1" IPIN
REF36
11/6/18, JLL

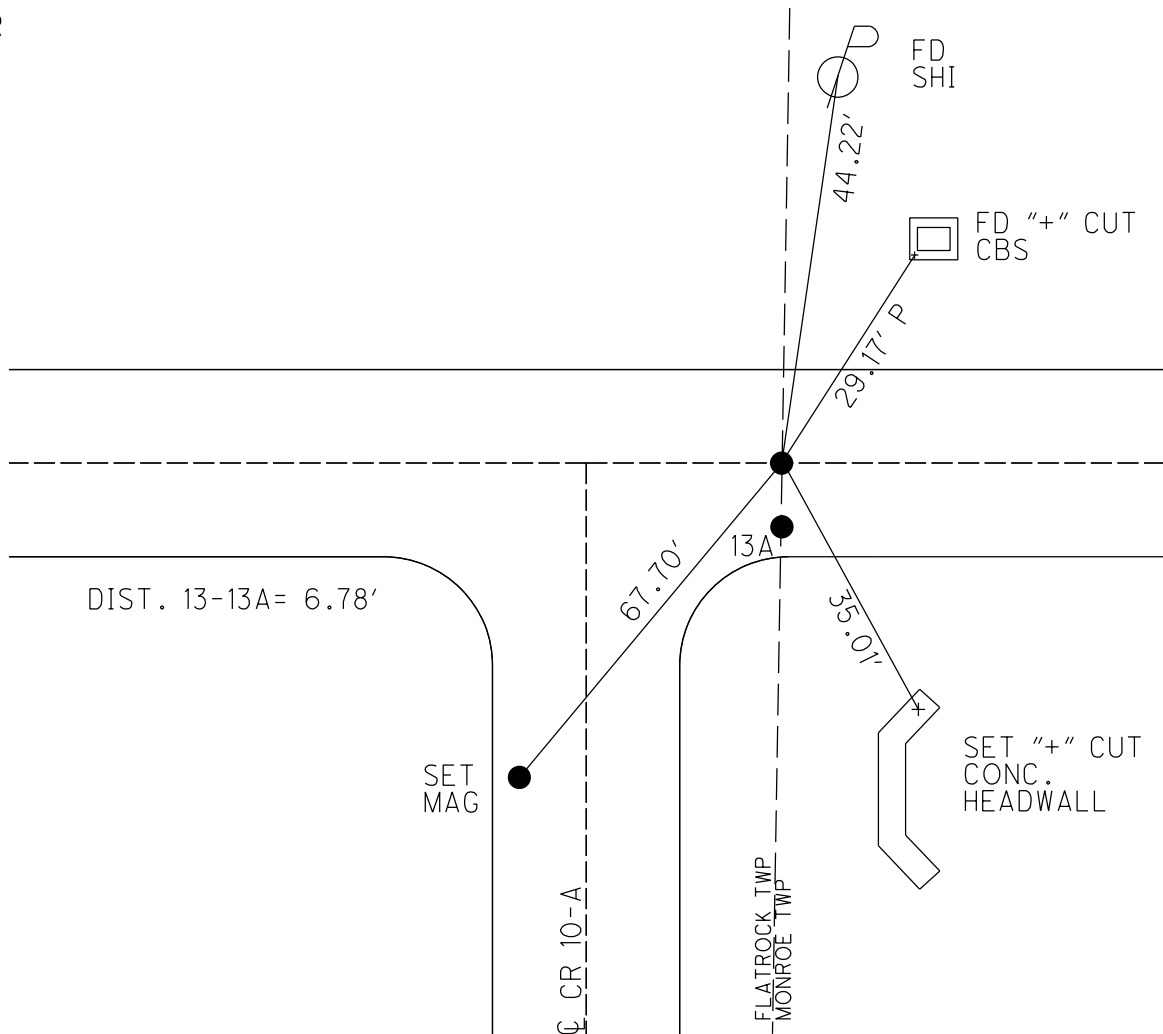

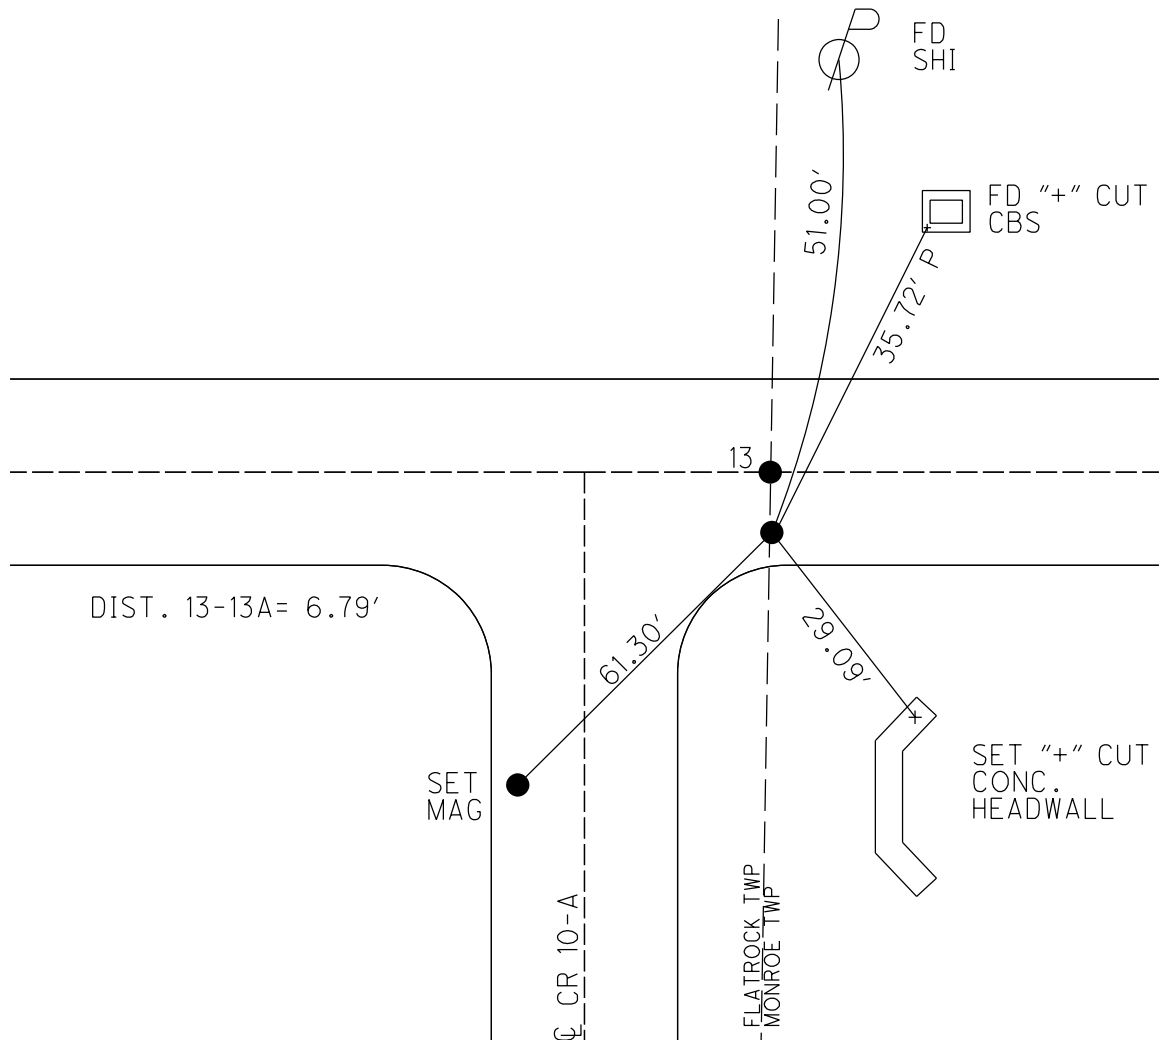

O.D.O.T. DISTRICT 2 SURVEY OFFICE (USE ONLY)

PERSONNEL

REFERENCE NO. 13 B

SHEET 1 OF 34

NOTES PRESTON-COLVIN

DATE 11/26/24

ROUTE SR 281

H.C. NEISE

WEATHER WINDY

COUNTY HENRY

R.C. PRESTON-COLVIN

TEMP. 40°

TOWNSHIP MONROE

SECTION 19

DWG BY PRESTON-COLVIN PID PAVING TRAIN

T 4 N R 7 E

TYPE MONUMENT MAG/WASHER

ON SURFACE - ~~BELOW~~ ON

OFFSET ℄ PAVEMENT 8.4' ~~LT~~ : RT

1.93' TO RT EDGE PAVEMENT

STATION: 324+54

HORIZ.DATUM: NAD83 2011


GEOID: 18

GRID: NORTHING: 592882.933


EASTING: 1526249.468

LDP: NORTHING: 449160.6

EASTING: 161502.6

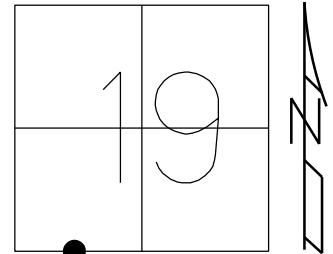

RECORD:
 STA 324+84.4
 1/4-1/4 SEC 19
 FD SM R.R. SPIKE
 1 1/2" DOWN
 8/18/98, MB
 SET P.K./WASHER
 9/28/98, MB
 FD SM.R.R.SPIKE
 5" DOWN
 REFB13
 9/4/18, JFO
 7/25/19, JMR
 FD SM RSPK
 2" DOWN
 REF13B
 7/2/24, TDN
 SET MAG/WASHER
 11/26/24, TDN

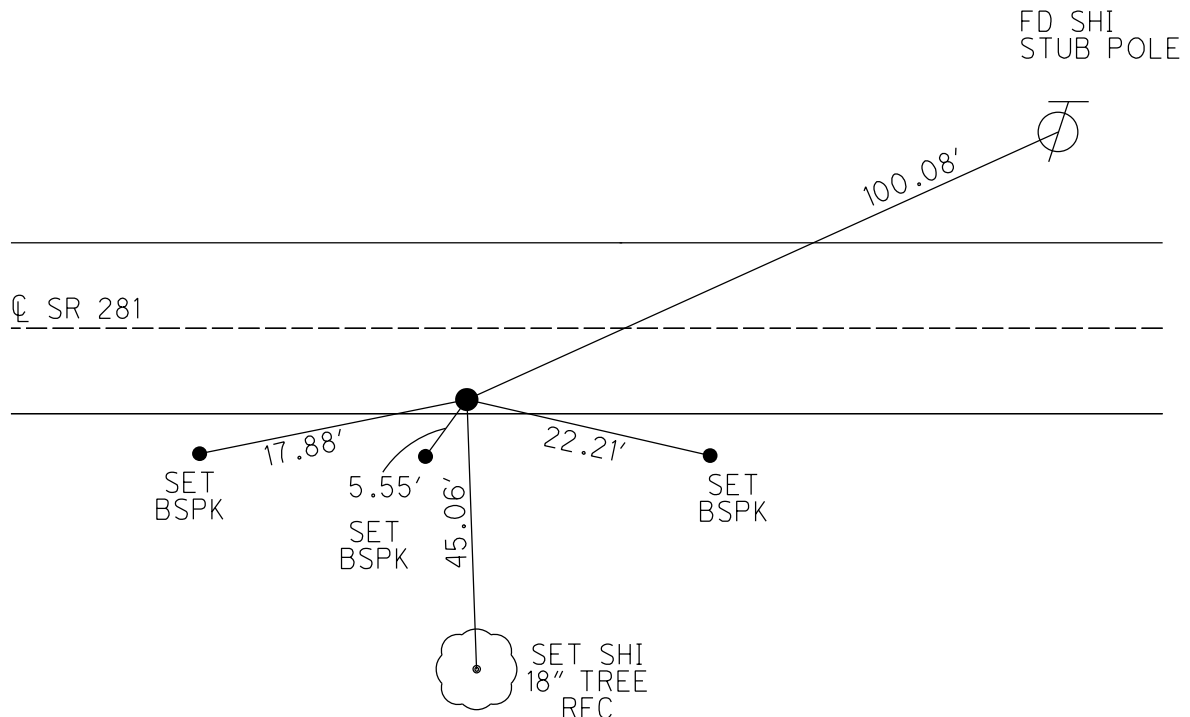

O.D.O.T. DISTRICT 2 SURVEY OFFICE (USE ONLY)

PERSONNEL

REFERENCE NO. 14

SHEET 2 OF 34

NOTES PRESTON-COLVIN

DATE 11/26/24

ROUTE SR 281

H.C. NEISE

WEATHER WINDY

COUNTY HENRY

R.C. PRESTON-COLVIN

TEMP. 40°

TOWNSHIP MONROE

SECTION 19

DWG BY PRESTON-COLVIN PID PAVING TRAIN

T 4 N R 7 E

TYPE MONUMENT P.K WASHER

ON SURFACE - ~~BELOW~~ ON

OFFSET CL PAVEMENT 7.8' ~~LT~~ : RT

2.9' TO RT EDGE PAVEMENT

STATION: 337+74

HORZ.DATUM: NAD83 2011


GEOID: 18

GRID: NORTHING: 592863.468


EASTING: 1527569.321

LDP: NORTHING: 449165.5

EASTING: 162822.7

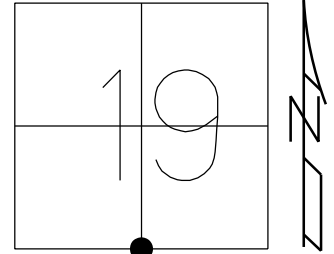

RECORD:
STA 338+04.5
FD SM.R.R.SPIKE
8/18/98, MB
SET P.K./WASHER
9/29/98, MB
FD P.K./WASHER
REF14
9/4/18, JFO
7/25/19, JMR
FD PK/WASHER
REF14
7/2/24, TDN
FD PK/WASHER
11/26/24, TDN

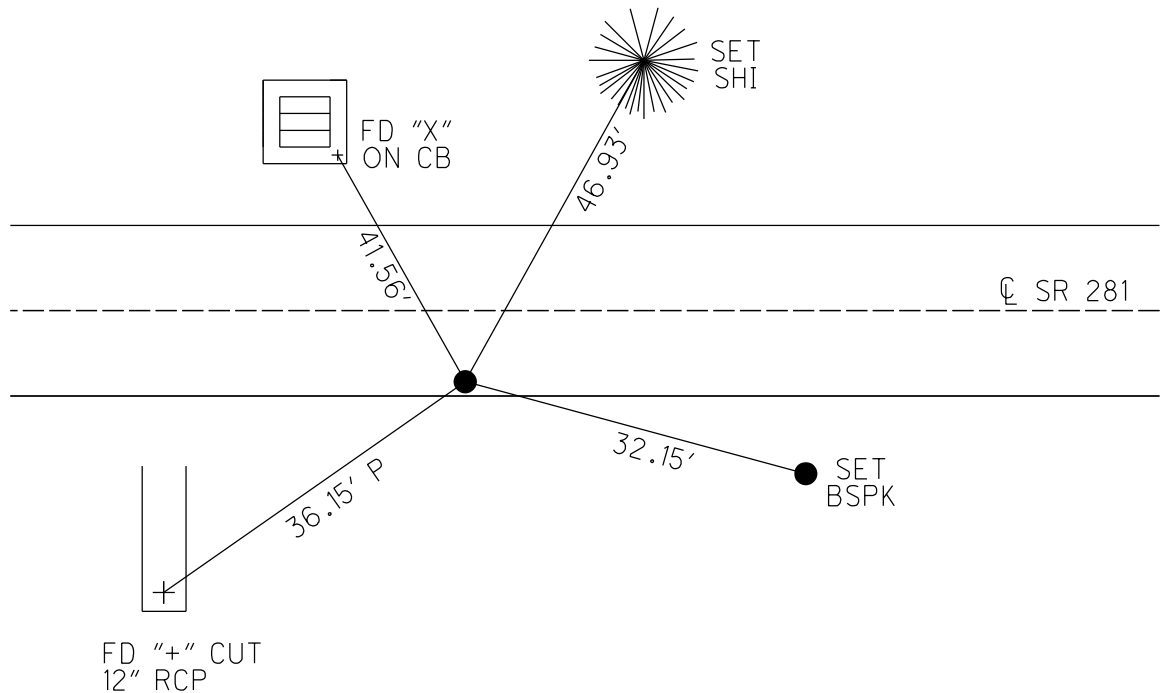

O.D.O.T. DISTRICT 2 SURVEY OFFICE (USE ONLY)

PERSONNEL

REFERENCE NO. 14 A

SHEET 3 OF 34

NOTES PRESTON-COLVIN

DATE 11/26/24

ROUTE SR 281

H.C. NEISE

WEATHER WINDY

COUNTY HENRY

R.C. PRESTON-COLVIN

TEMP. 40°

TOWNSHIP MONROE

DWG BY PRESTON-COLVIN PID PAVING TRAIN

SECTION 19

T 4 N R 7 E

TYPE MONUMENT P.K WASHER

ON SURFACE - ~~BELOW~~ ON

OFFSET CL PAVEMENT 6.5' ~~LT~~ : RT

4.1' TO RT EDGE PAVEMENT

STATION: 350+99

HORZ.DATUM: NAD83 2011


GEOID: 18

GRID: NORTHING: 592844.073


EASTING: 1528893.769

LDP: NORTHING: _____

EASTING: _____

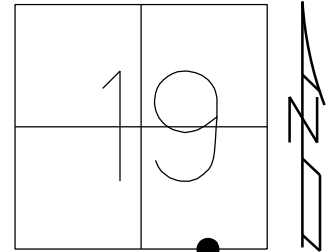

RECORD:
351+29.4
1/4-1/4 SEC 19
FD P.K./WASHER
REF A14
9/4/18, JFO
7/25/19, JMR
FD PK/WASHER
7/19/24, TDN
FD PK/WASHER
REF 14A
11/26/24, TDN

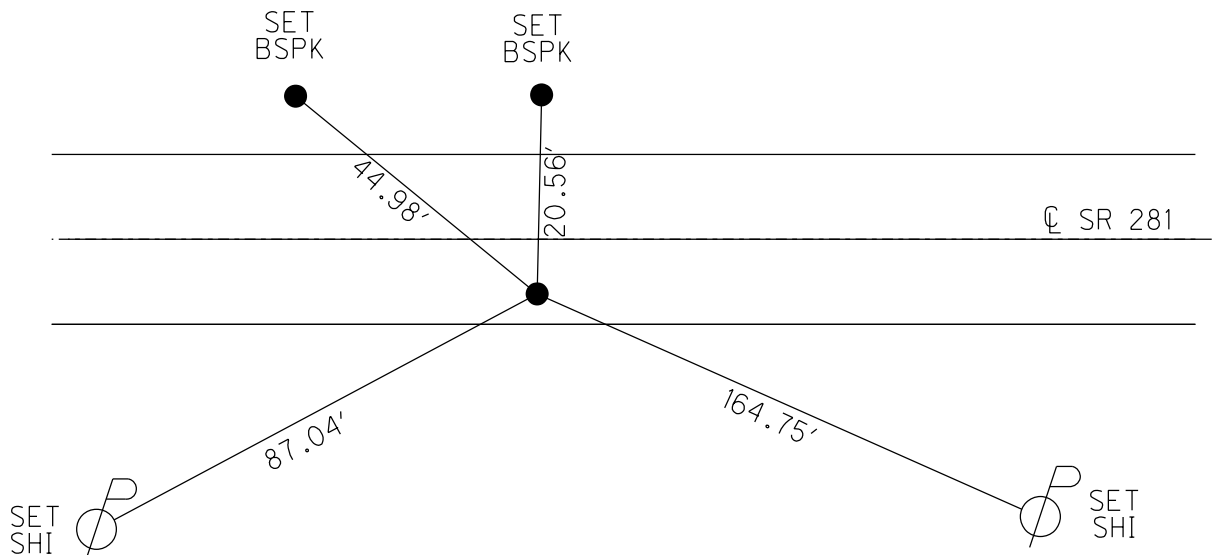

O.D.O.T. DISTRICT 2 SURVEY OFFICE (USE ONLY)

PERSONNEL

REFERENCE NO. 15

SHEET 4 OF 34

NOTES PRESTON-COLVIN

DATE 11/26/24

ROUTE SR 281

H.C. NEISE

WEATHER WINDY

COUNTY HENRY

R.C. PRESTON-COLVIN

TEMP. 40°

TOWNSHIP MONROE

SECTION 19

DWG BY PRESTON-COLVIN PID PAVING TRAIN

T 4 N R 7 E

TYPE MONUMENT LG RR SPIKE

~~ON SURFACE~~ - BELOW 2.5"

OFFSET $\odot$ PAVEMENT 5.4' ~~LT~~ : RT

- TO - EDGE PAVEMENT

STATION: 364+24

HORIZ.DATUM: NAD83 2011


GEOID: 18

GRID: NORTHING: 592825.025


EASTING: 1530281.756

LDP: NORTHING: 449175.6

EASTING: 165472.6

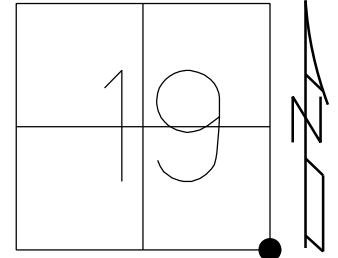

RECORD:
 STA 364+54.39
 FD SM.R.R.SPIKE
 8/18/98, MB
 SET P.K./WASHER
 9/28/98, MB
 FD LG.R.R.SPIKE
 REF15
 9/4/18, JFO
 7/25/19, JMR
 FD LG RR SPIKE
 2.5" DOWN
 REF15
 7/22/24, TDN
 FD LG RR SPIKE
 11/26/24, TDN

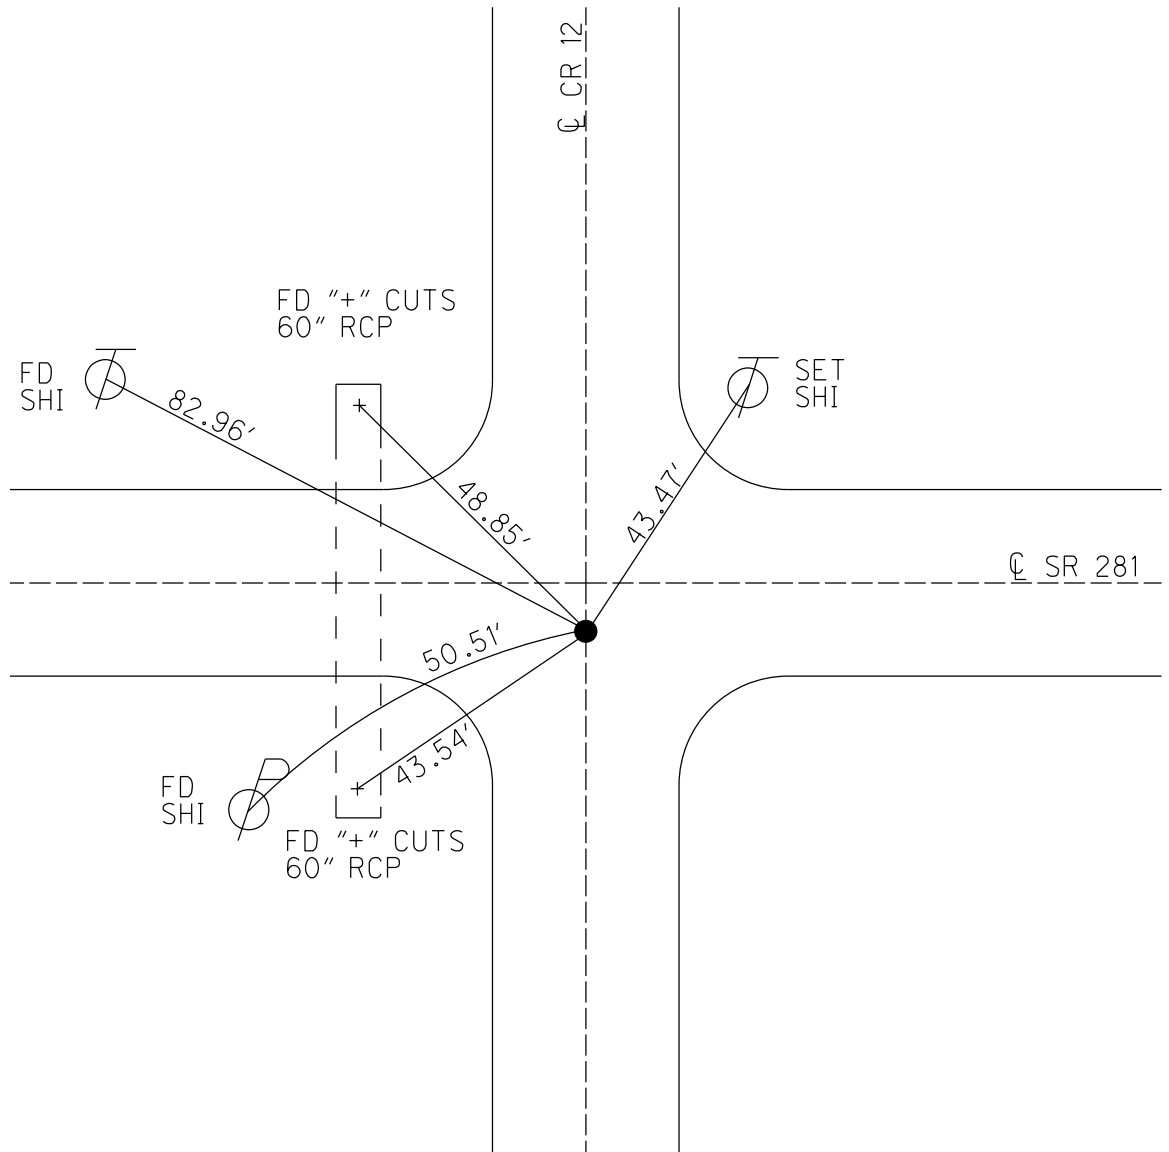

O.D.O.T. DISTRICT 2 SURVEY OFFICE (USE ONLY)

PERSONNEL

REFERENCE NO. 15 A

SHEET 5 OF 34

NOTES PRESTON-COLVIN

DATE 11/26/24

ROUTE SR 281

H.C. NEISE

WEATHER WINDY

COUNTY HENRY

R.C. PRESTON-COLVIN

TEMP. 40°

TOWNSHIP MONROE

SECTION 20

DWG BY PRESTON-COLVIN

PID PAVING TRAIN

T 4 N R 7 E

TYPE MONUMENT PK/WASHER

ON SURFACE - ~~BELOW~~ ON

OFFSET Q PAVEMENT 4.6' ~~LT~~ : RT

5.8' TO RT EDGE PAVEMENT

STATION: 377+38

HORIZ.DATUM: NAD83 2011


GEOID: 18

GRID: NORTHING: 592818.577

EASTING: 1531532.834


LDP: NORTHING: 449193.3

EASTING: 166786.7

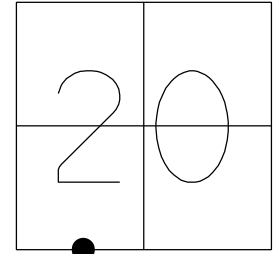

RECORD:

STA 377+69.10
1/4-1/4 PT SEC 20
FD SM.R.R.SPIKE
8/18/98, MB
SET P.K./WASHER
9/28/98, MB
FD P.K./WASHER
REFA15
9/4/18, JFO
7/25/19, JFO
FD PK/WASHER
REF15A
7/22/24, TDN
FD PK/WASHER
11/26/24, TDN

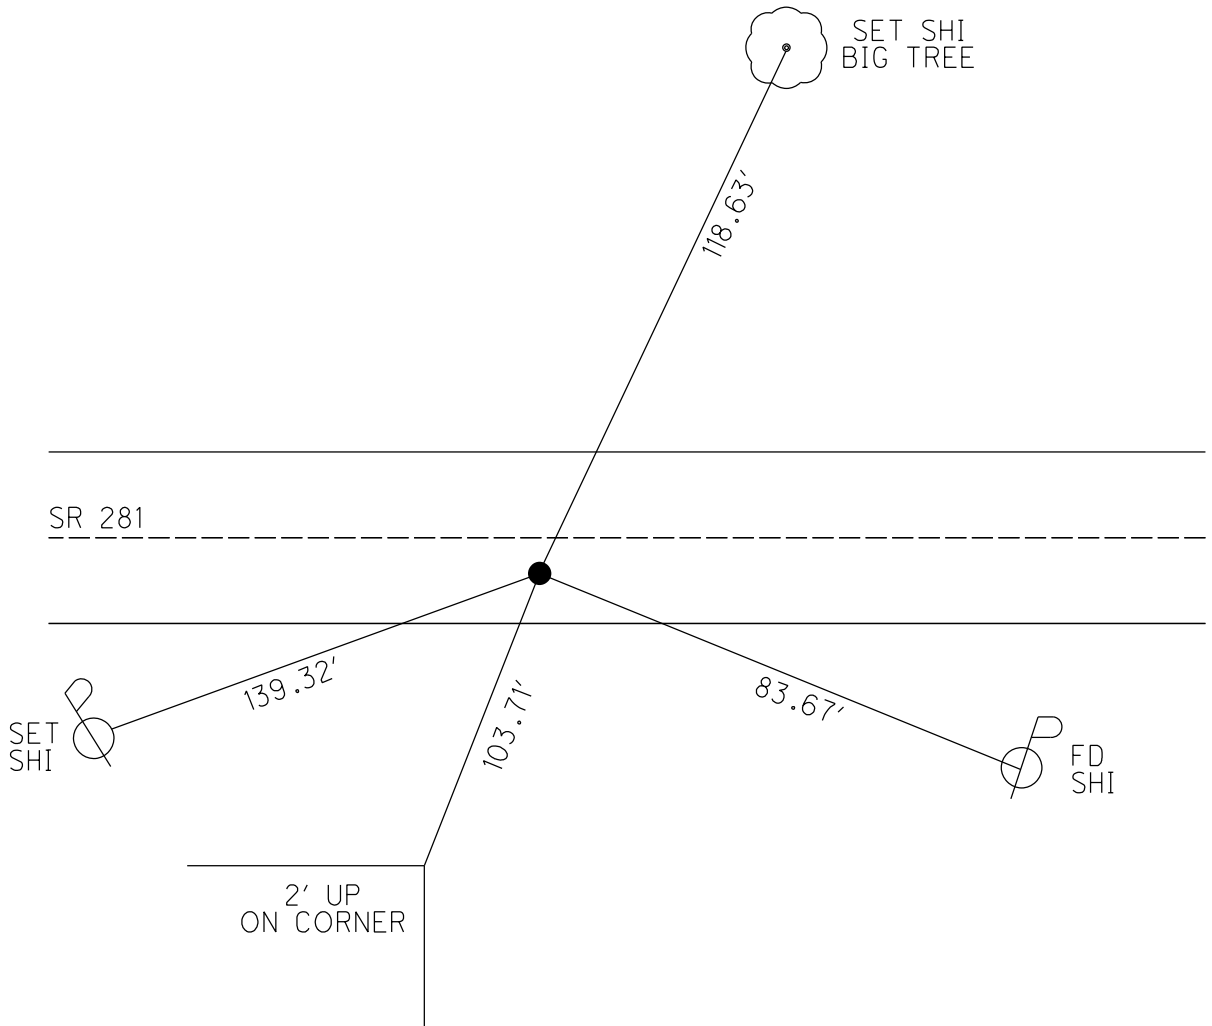

O.D.O.T. DISTRICT 2 SURVEY OFFICE (USE ONLY)

PERSONNEL

REFERENCE NO. 16

SHEET 6 OF 34

NOTES PRESTON-COLVIN

DATE 11/26/24

ROUTE SR 281

H.C. NEISE

WEATHER WINDY

COUNTY HENRY

R.C. PRESTON-COLVIN

TEMP. 40°

TOWNSHIP MONROE

DWG BY PRESTON-COLVIN

PID PAVING TRAIN

SECTION 20

T 4 N R 7 E

TYPE MONUMENT SHANK

ON SURFACE - ~~BELOW~~ ON

OFFSET Q PAVEMENT 2.7' ~~LT~~ : RT

8.4' TO RT EDGE PAVEMENT

STATION: 390+54

HORZ.DATUM: NAD83 2011


GEOID: 18

GRID: NORTHING: 592812.011


EASTING: 1532846.974

LDP: NORTHING: 449210.8

EASTING: 168100.8

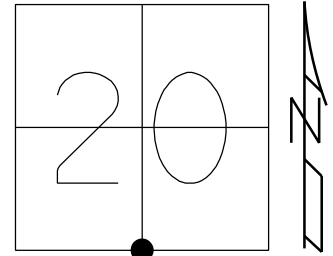

RECORD:
 STA 390+83.6
 FD SM.R.R.SPIKE
 8/18/98, MB
 SET P.K./WASHER
 9/28/98, MB
 FD P.K./WASHER
 REF16
 9/4/18, JFO
 7/26/19, JMR
 FD SHANK
 REF16
 7/22/24, TDN
 FD SHNAK
 11/26/24, TDN

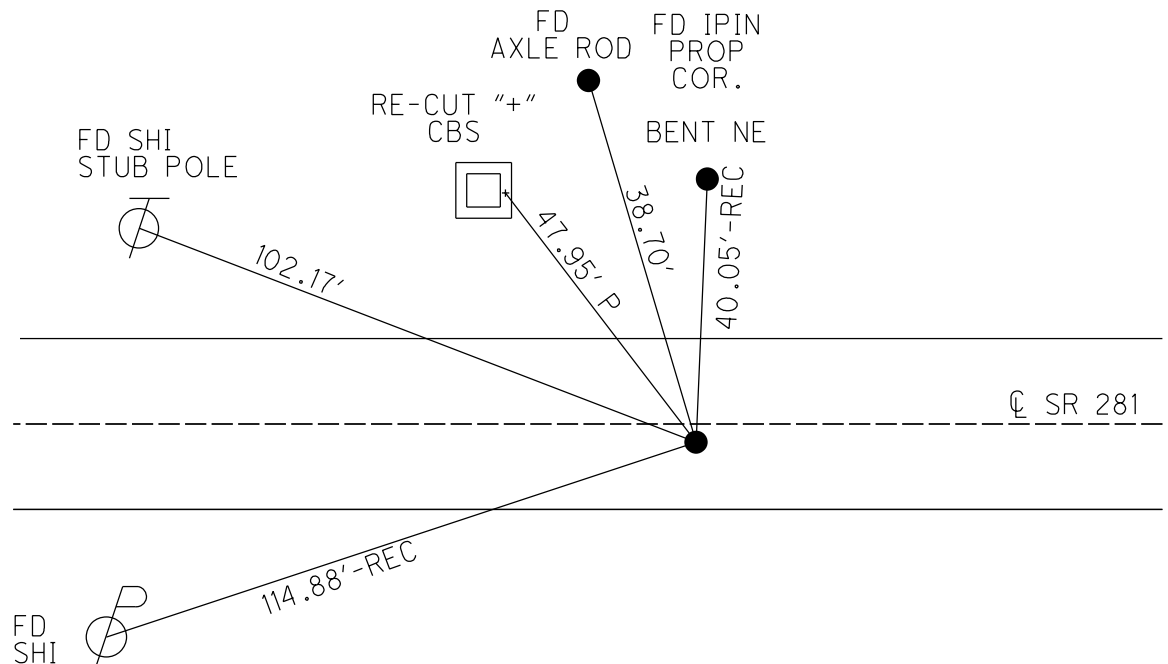

O.D.O.T. DISTRICT 2 SURVEY OFFICE (USE ONLY)

PERSONNEL

REFERENCE NO. 16 AA

SHEET 7 OF 34

NOTES PRESTON-COLVIN

DATE 11/26/24

ROUTE SR 281

H.C. NEISE

WEATHER WINDY

COUNTY HENRY

R.C. PRESTON-COLVIN

TEMP. 40°

TOWNSHIP MONROE

SECTION 20

DWG BY PRESTON-COLVIN PID PAVING TRAIN

T 4 N R 7 E

TYPE MONUMENT PK NAIL

ON SURFACE - ~~BELOW~~ ON

OFFSET ¢ PAVEMENT 4.4' ~~LT~~ : RT

6.9' TO RT EDGE PAVEMENT

STATION: 403+83

HORZ.DATUM: NAD83 2011


GEOID: 18

GRID: NORTHING: 592785.291

EASTING: 1534175.495


LDP: NORTHING: 449208.4

EASTING: 169429.7

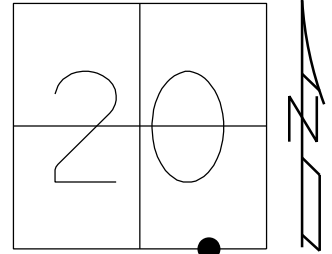

NOTE:
FD MAG NAIL
ORIGIN UNKNOWN
REFAA16
FD MAG NAIL
REF 16AA
7/22/24, TDN
FD MAG NAIL
11/26/24, TDN

DIST. 16AA-16A= 1.06'

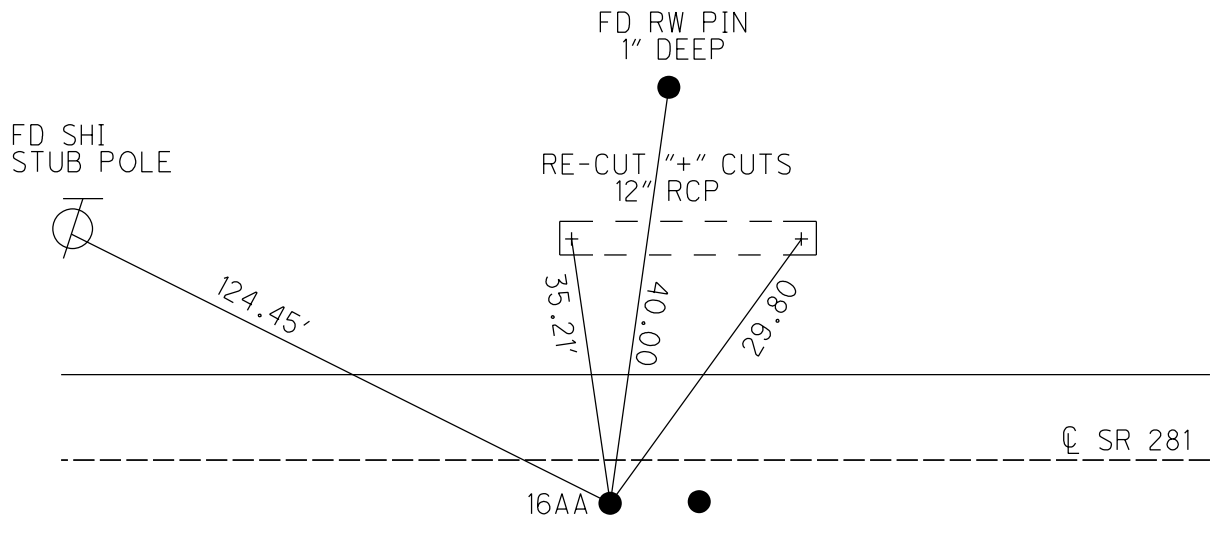

O.D.O.T. DISTRICT 2 SURVEY OFFICE (USE ONLY)

PERSONNEL

REFERENCE NO. 17

SHEET 8 OF 34

NOTES PRESTON-COLVIN

H.C. NEISE

R.C. PRESTON-COLVIN

DATE 11/26/24

WEATHER WINDY

TEMP. 40°

ROUTE SR 281

COUNTY HENRY

TOWNSHIP MONROE

SECTION 20

DWG BY PRESTON-COLVIN

PID PAVING TRAIN

T 4 N R 7 E

TYPE MONUMENT RR SPIKE

~~ON SURFACE~~ - BELOW 2"

OFFSET $\varnothing$ PAVEMENT 5.8' ~~LT~~ : RT

- TO - EDGE PAVEMENT

STATION: 417+12

HORIZ.DATUM: NAD83 2011


GEOID: 18

GRID: NORTHING: 592785.291


EASTING: 1534175.495

LDP: NORTHING: 449208.4

EASTING: 169429.7

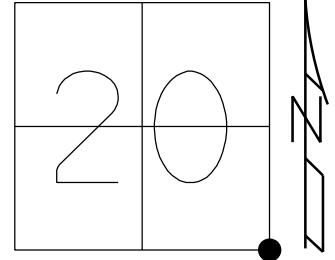

RECORD:
STA 417+41.3
FD SM.R.R.SPIKE
8/18/98, TMR
SET P.K./WASHER
9/28/98, MB
FD RR SPIKE
3" DOWN
REF17
9/4/18, JFO
7/25/19, JMR
FD RR SPIKE
2" DOWN
REF 17
7/22/24, TDN
FD RR SPIKE
2" DOWN
11/26/24, TDN

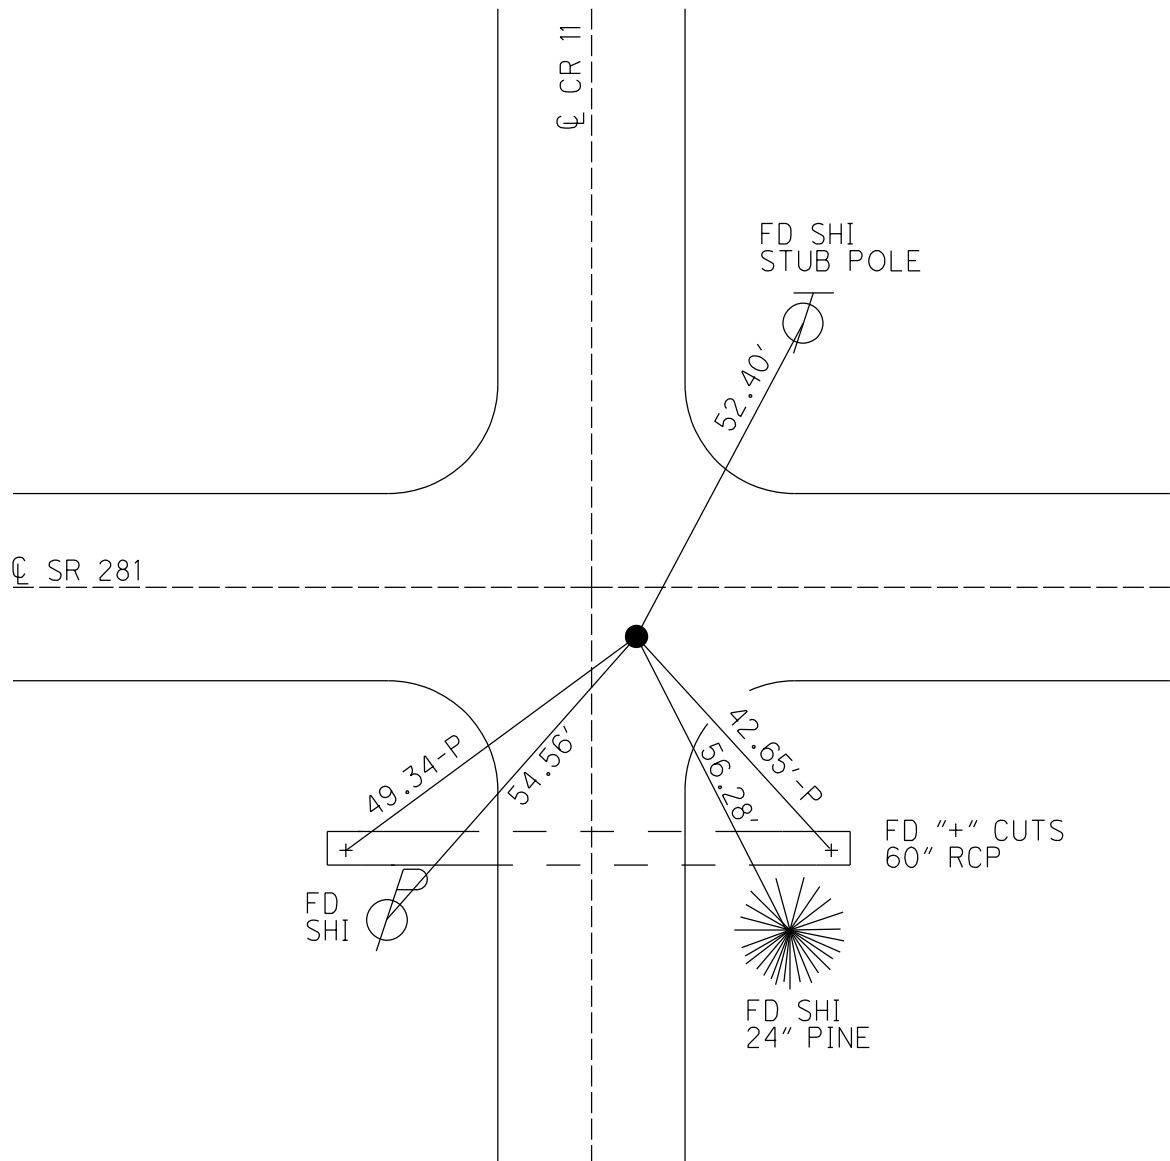

O.D.O.T. DISTRICT 2 SURVEY OFFICE (USE ONLY)

PERSONNEL

REFERENCE NO. 18

SHEET 9 OF 34

NOTES PRESTON-COLVIN

DATE 11/26/24

ROUTE SR 281

H.C. NEISE

WEATHER WINDY

COUNTY HENRY

R.C. PRESTON-COLVIN

TEMP. 40°

TOWNSHIP MONROE

SECTION 21

DWG BY PRESTON-COLVIN PID PAVING TRAIN

T 4 N R 7 E

TYPE MONUMENT SM RR SPIKE

~~ON SURFACE~~ - BELOW 2"

OFFSET CL PAVEMENT 5.3' ~~LT~~ : RT

5.4' TO RT EDGE PAVEMENT

STATION: 443+59

HORZ.DATUM: NAD83 2011


GEOID: 18

GRID: NORTHING: 592723.355


EASTING: 1538149.973

LDP: NORTHING: 449219.4

EASTING: 173404.9

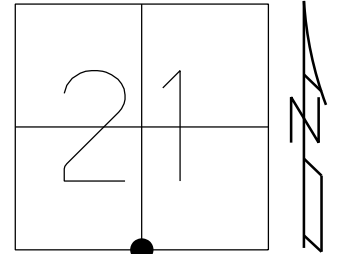

RECORD:
STA 443+87.93
FD SM.R.R.SPIKE
8/18/98, MB
SET P.K./WASHER
9/28/98, MB
FD P.K.NAIL
REF18
9/4/18, JFO
7/25/19, JMR
FD SM RSPK 2" DOWN
REF18
7/22/24, TDN
FD SM RSPK 2" DOWN
11/26/24, TDN

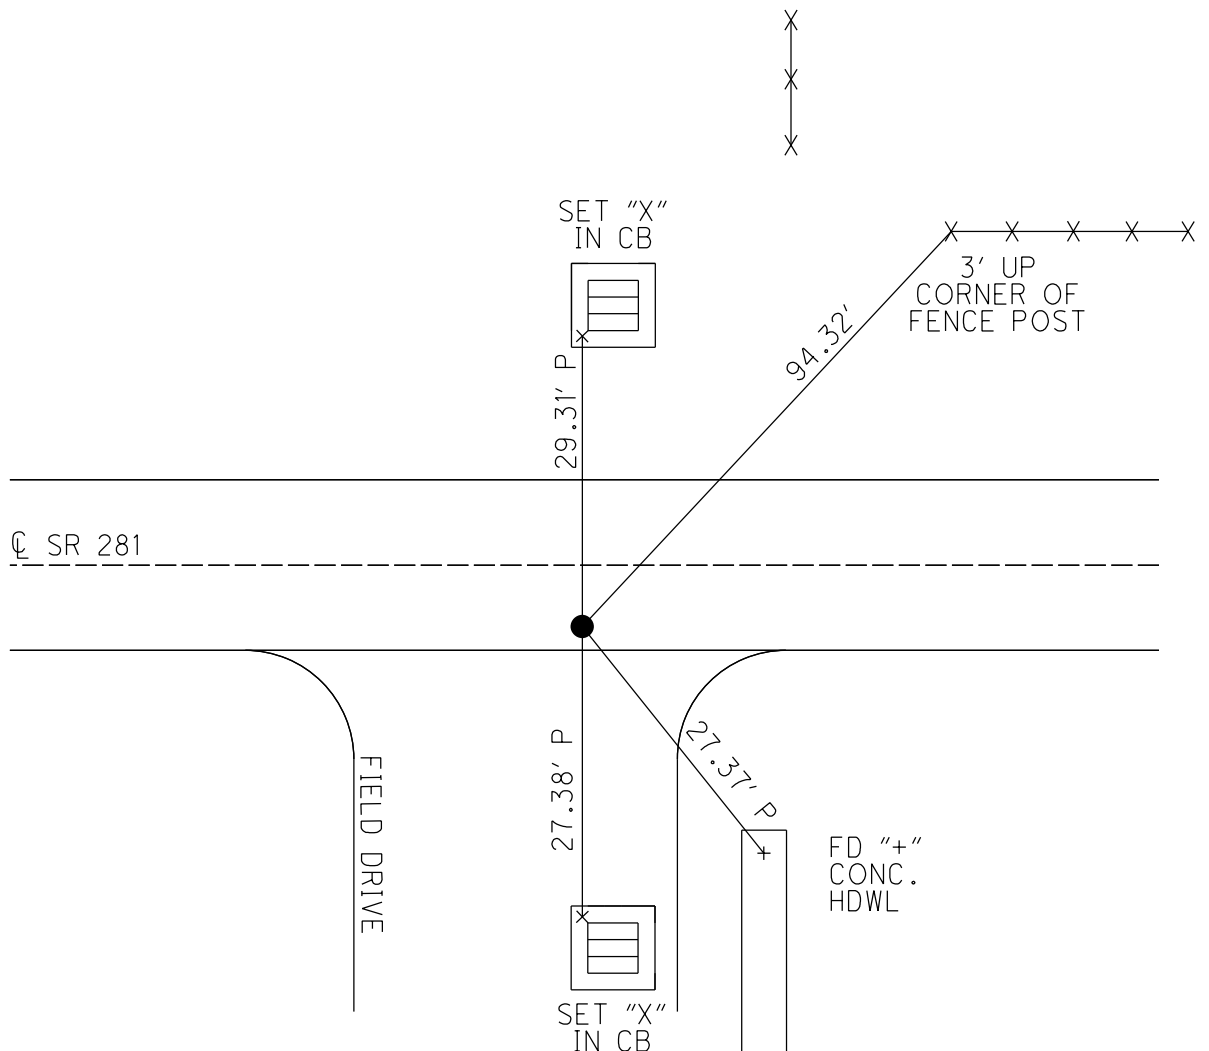

O.D.O.T. DISTRICT 2 SURVEY OFFICE (USE ONLY)

PERSONNEL

REFERENCE NO. 18 A

SHEET 10 OF 34

NOTES PRESTON-COLVIN

DATE 11/26/24

ROUTE SR 281

H.C. NEISE

WEATHER WINDY

COUNTY HENRY

R.C. PRESTON-COLVIN

TEMP. 40°

TOWNSHIP MONROE

SECTION 21

DWG BY PRESTON-COLVIN

PID PAVING TRAIN

T 4 N R 7 E

TYPE MONUMENT PK/WASHER

ON SURFACE - ~~BELOW~~ ON

OFFSET 5.4' TO RT ~~ET~~ : RT

5.4' TO RT EDGE PAVEMENT

STATION: 456+88

HORIZ.DATUM: NAD83 2011


GEOID: 18

GRID: NORTHING: 592702.295

EASTING: 1539478.421

LDP: NORTHING: 449222.7

EASTING: 174733.6

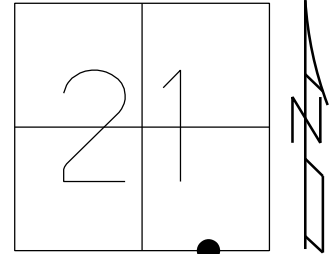

RECORD:
 STA 457+16.4
 1/4-1/4 POINT SEC 21
 FD SM.R.R.SPIKE
 8/18/98, MB
 SET P.K./WASHER
 9/28/98, MB
 FD P.K./WASHER
 REFA18
 9/4/18, JFO
 7/25/19, JMR
 FD PK/WASHER
 REF 18A
 7/22/24, TDN
 FD PK/WASHER
 11/26/24, TDN

CL SR 281

SET
SHI



10.74'

O.D.O.T. DISTRICT 2 SURVEY OFFICE (USE ONLY)

PERSONNEL

REFERENCE NO. 19

SHEET 11 OF 34

NOTES PRESTON-COLVIN

DATE 11/26/24

ROUTE SR 281

H.C. NEISE

WEATHER WINDY

COUNTY HENRY

R.C. PRESTON-COLVIN

TEMP. 40°

TOWNSHIP MONROE

SECTION 22

DWG BY PRESTON-COLVIN PID PAVING TRAIN

T 4 N R 7 E

TYPE MONUMENT SM RR SPIKE

ON SURFACE - ~~BELOW~~ 1.5"

OFFSET Q PAVEMENT 5.25' ~~LT~~ : RT

- TO - EDGE PAVEMENT

STATION: 470+16

HORIZ.DATUM: NAD83 2011


GEOID: 18

GRID: NORTHING: 592681.183


EASTING: 1540806.673


LDP: NORTHING: 449226

EASTING: 176062.2

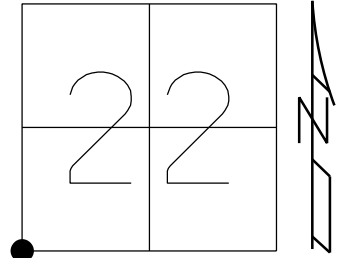

RECORD:
 STA 470+44.45
 FD SM.R.R.SPIKE
 8/18/98, MB
 SET P.K./WASHER
 9/28/98, CL
 FD RR SPIKE
 1 1/2" DOWN
 REF19
 9/6/18, JFO
 7/25/19, JMR
 FD RRSPK
 1 1/2" DOWN
 REF19
 7/22/24, TDN
 FD RRPSK
 11/26/24, TDN

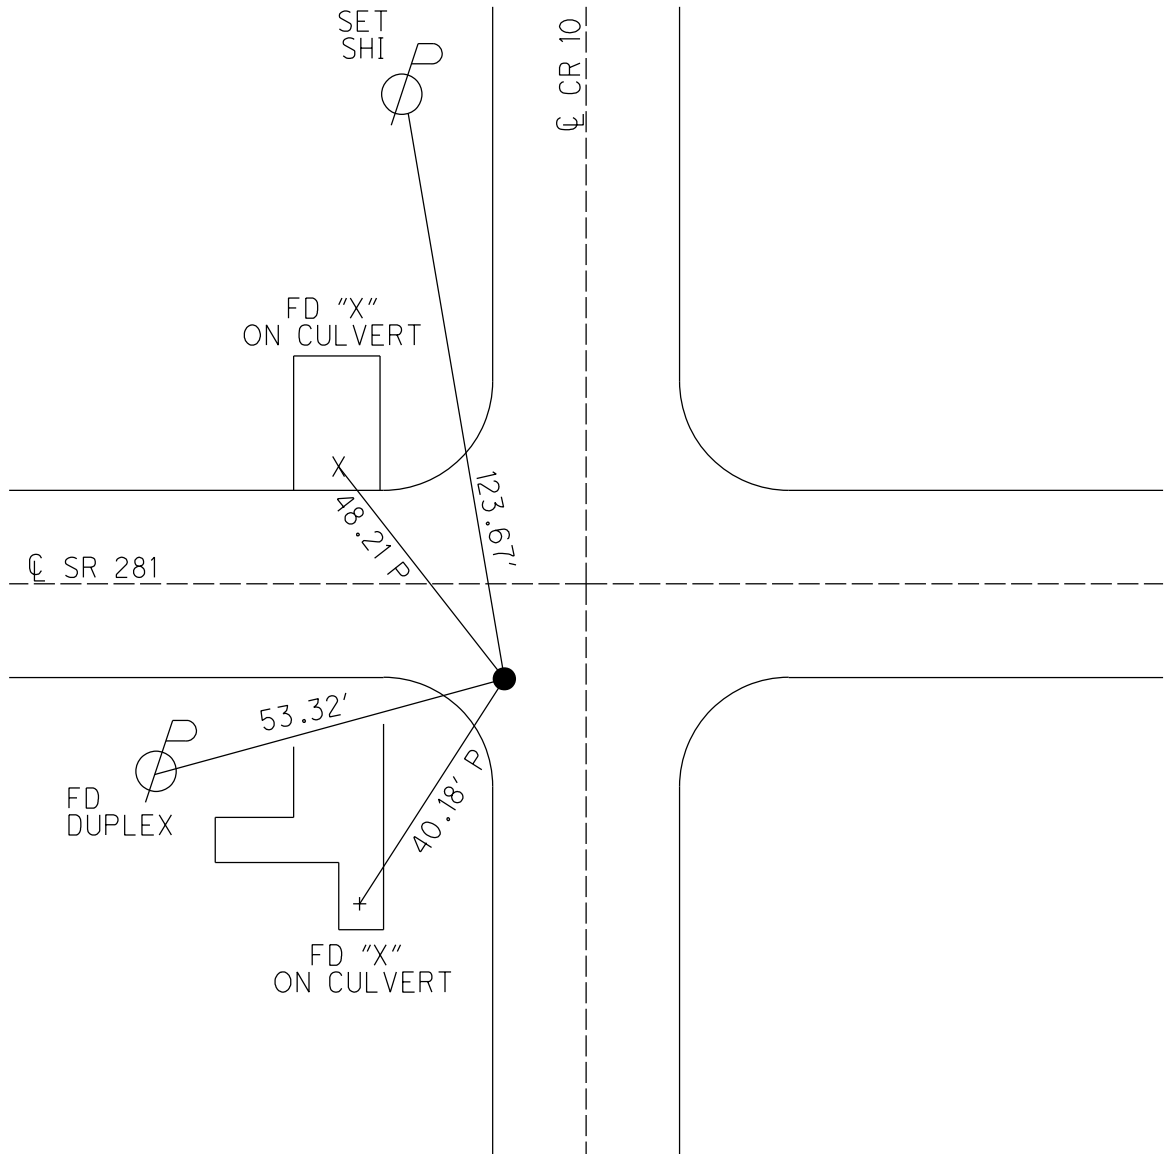

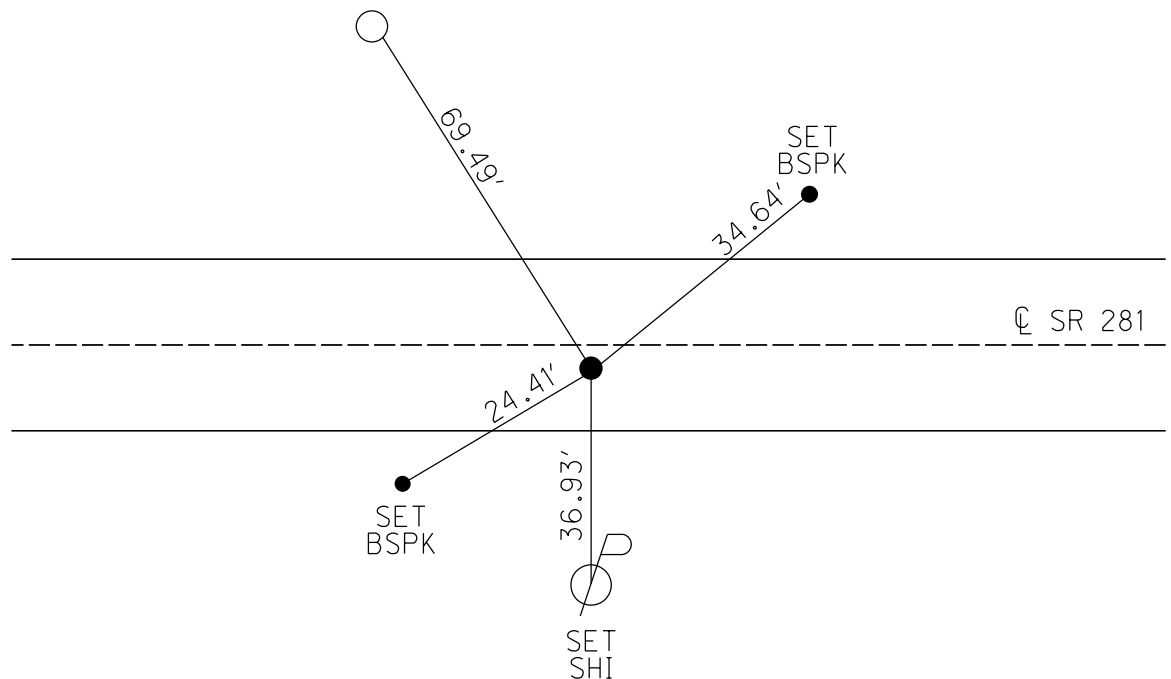

O.D.O.T. DISTRICT 2 SURVEY OFFICE (USE ONLY)

PERSONNEL

REFERENCE NO. 20

SHEET 11 OF 34

NOTES PRESTON-COLVIN

DATE 11/26/24

ROUTE SR 281

H.C. NEISE

WEATHER WINDY

COUNTY HENRY

R.C. PRESTON-COLVIN

TEMP. 40°

TOWNSHIP MONROE

SECTION 22

DWG BY PRESTON-COLVIN

PID PAVING TRAIN

T 4 N R 7 E

TYPE MONUMENT RSPK

~~ON SURFACE~~ - BELOW 1 1/2"

OFFSET $\angle$ PAVEMENT 4.0' ~~LT~~ : RT

6.7' TO RT EDGE PAVEMENT

STATION: 496+88.49

HORIZ.DATUM: NAD83 2011


GEOID: 18

GRID: NORTHING: 592670.827


EASTING: 1542131.201

LDP: NORTHING: 449239.9

EASTING: 177386.8

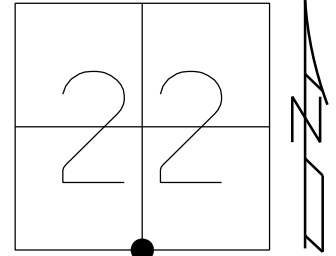

RECORD:
 STA 496+93.3
 FD SM.R.R.SPIKE
 8/18/98, MB
 SET P.K./WASHER
 9/29/98, MC
 FD P.K./WASHER
 REF20
 9/6/18, JFO
 7/25/19, JMR
 FD RSPK 1 1/2" DOWN
 REF20
 7/22/24, TDN
 FD RSPK 1 1/2" DOWN
 11/26/24, TDN

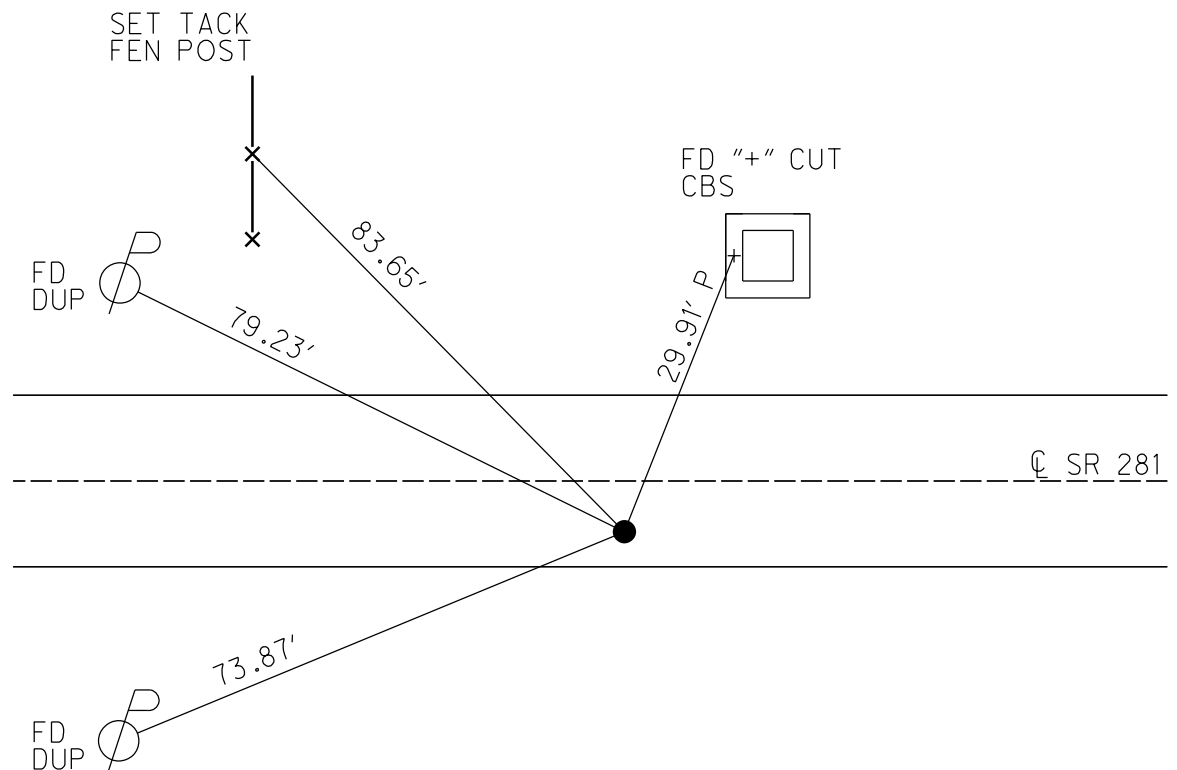

O.D.O.T. DISTRICT 2 SURVEY OFFICE (USE ONLY)

PERSONNEL

REFERENCE NO. 20 A

SHEET 14 OF 34

NOTES HUSS

DATE 8/18/98

ROUTE SR 281

H.C. BARNHISEL

WEATHER FAIR

COUNTY HENRY

R.C. ROUSOS

TEMP. 84°

TOWNSHIP MONROE

SECTION 22

DWG BY NIESE PID CHIP_2

T 4 N R 7 E

TYPE MONUMENT SM.R.R.SPIKE

ON SURFACE - ~~BELOW~~ ON


OFFSET 0.6' LT : RT

9.9' TO RT EDGE PAVEMENT

STATION: 509+89

HORIZ.DATUM: - GEOID: -

GRID: NORTHING: - EASTING: -

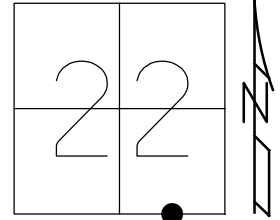

RECORD:

STA 510+16.87

1/4-1/4 SEC 22

FD SM.R.R.SPIKE


8/18/98, MB

SET P.K./WASHER

9/29/98, MRC

DNF

9/6/18, JFO

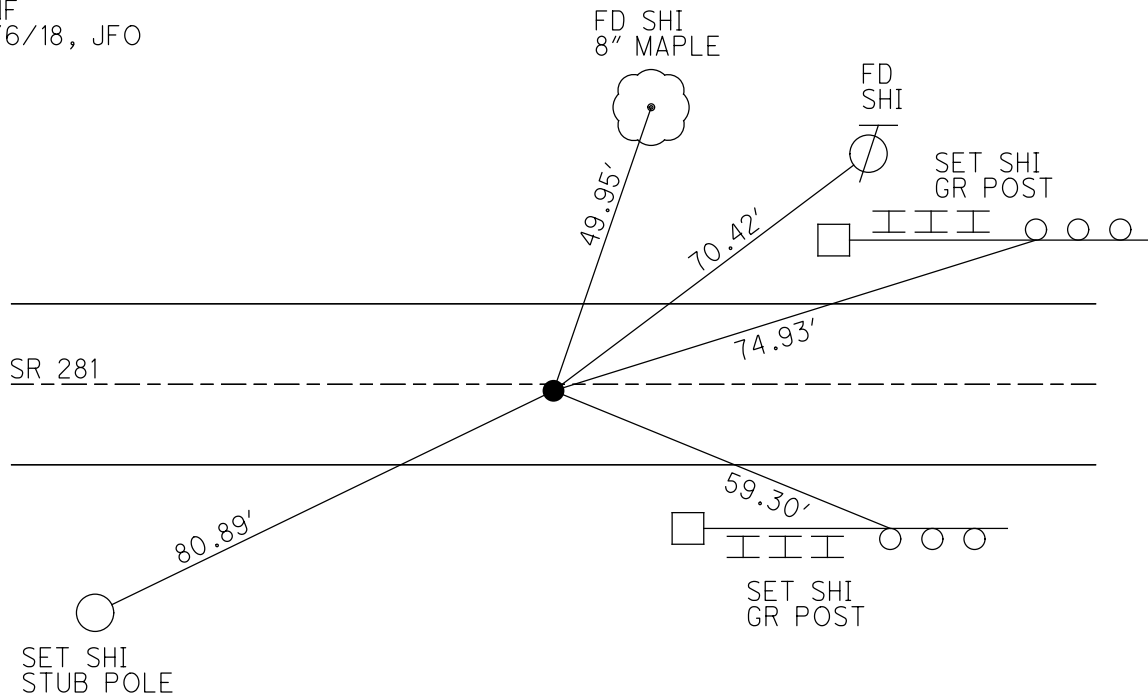

O.D.O.T. DISTRICT 2 SURVEY OFFICE (USE ONLY)

PERSONNEL

REFERENCE NO. 22

SHEET 15 OF 34

NOTES RHOADES

DATE 9/6/18

ROUTE SR 281

H.C. O'DONNELL

WEATHER FAIR

COUNTY HENRY

R.C. RHOADES

TEMP. 70°

TOWNSHIP MONROE

SECTION 23

DWG BY NIESE

PID PAVETRAIN

T 4 N R 7 E

TYPE MONUMENT R.R. SPIKE

~~ON SURFACE~~ - BELOW 1 1/2"

OFFSET CL PAVEMENT ON LT : RT

- TO - EDGE PAVEMENT 8.0' LT OF CL SR 109


STATION: 523+38

HORZ.DATUM: NAD83(2011)


GEOID: 2012A

GRID: NORTHING: 592634.363

EASTING: 1546102.887

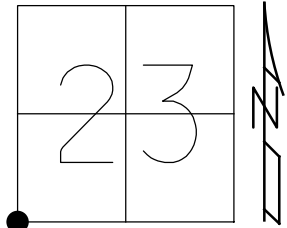

RECORD:
STA 523+41.55
FD P.K./WASHER
8/18/98, MB
SET P.K./WASHER
9/28/98, MB
FD R.R.SPIKE
REF22
9/6/18, JFO
7/25/19,
1/11/23, JMR

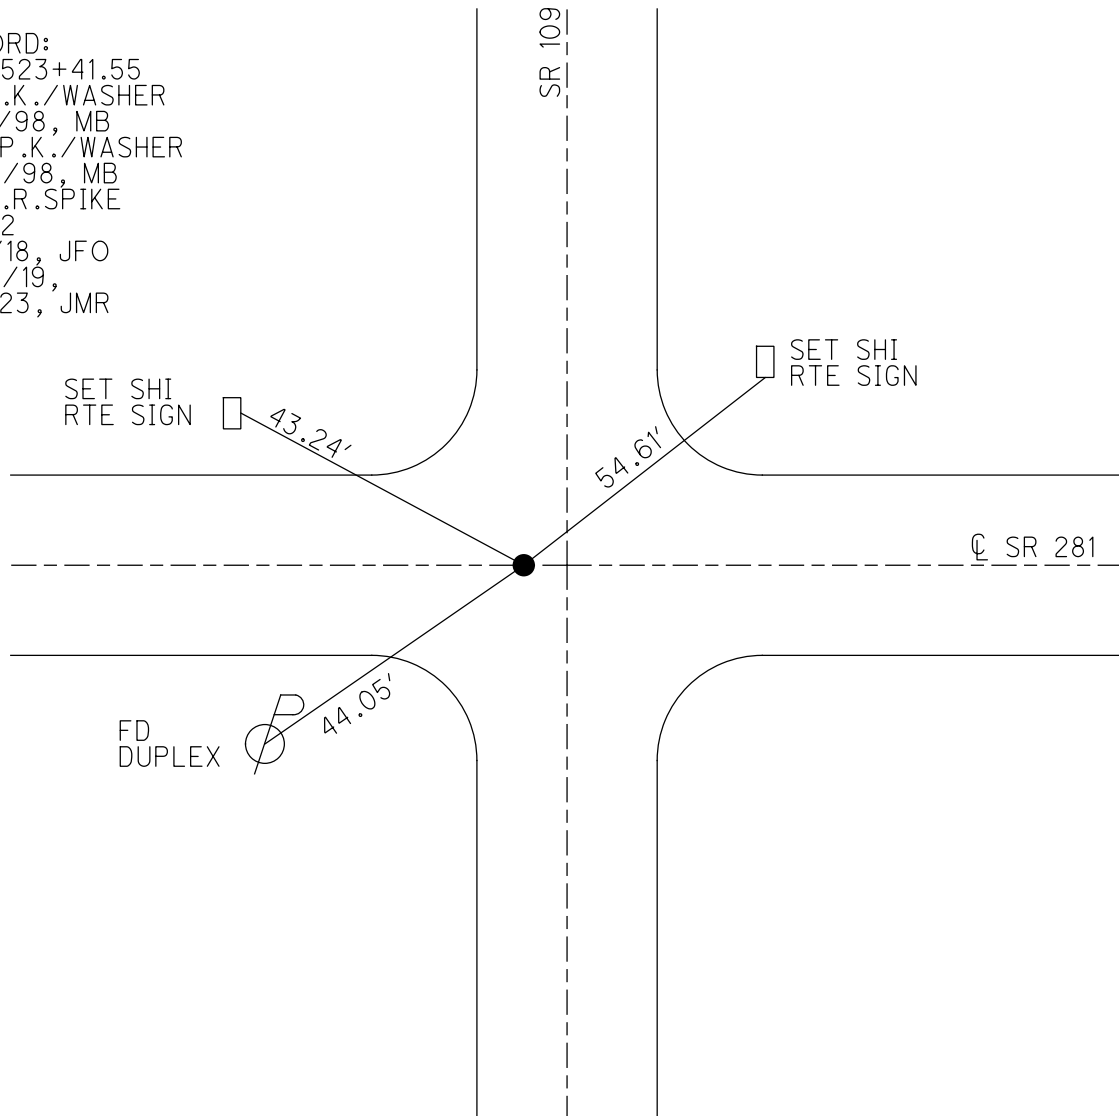

O.D.O.T. DISTRICT 2 SURVEY OFFICE (USE ONLY)

PERSONNEL

REFERENCE NO. 22 A

SHEET 16 OF 34

NOTES PRESTON-COLVIN

DATE 11/26/24

ROUTE SR 281

H.C. NEISE

WEATHER WINDY

COUNTY HENRY

R.C. PRESTON-COLVIN

TEMP. 40°

TOWNSHIP MONROE

SECTION 23

DWG BY PRESTON-COLVIN PID PAVING TRAIN

T 4 N R 7 E

TYPE MONUMENT PK NAIL

~~ON SURFACE~~ - BELOW ON

OFFSET CL PAVEMENT ON LT : RT

10.6' TO RT EDGE PAVEMENT

STATION: 549+61

HORIZ.DATUM: NAD83 2011


GEOID: 18

GRID: NORTHING: 592631.828


EASTING: 1548748.942

LDP: NORTHING: 449322.3

EASTING: 184004.7

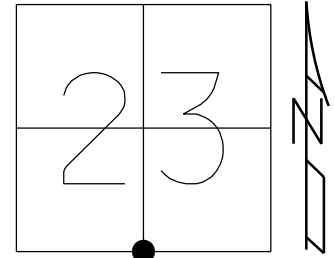

RECORD:
FD SM.R.R.SPIKE
5/28/98, MC
SET P.K./WASHER
10/1/98, MRC
FD P.K.NAIL
REFA22
9/6/18, JFO
7/25/19,
1/11/23, JMR
FD PK NAIL
REF22A
7/22/24, TDN
FD PK NAIL
11/26/24, TDN

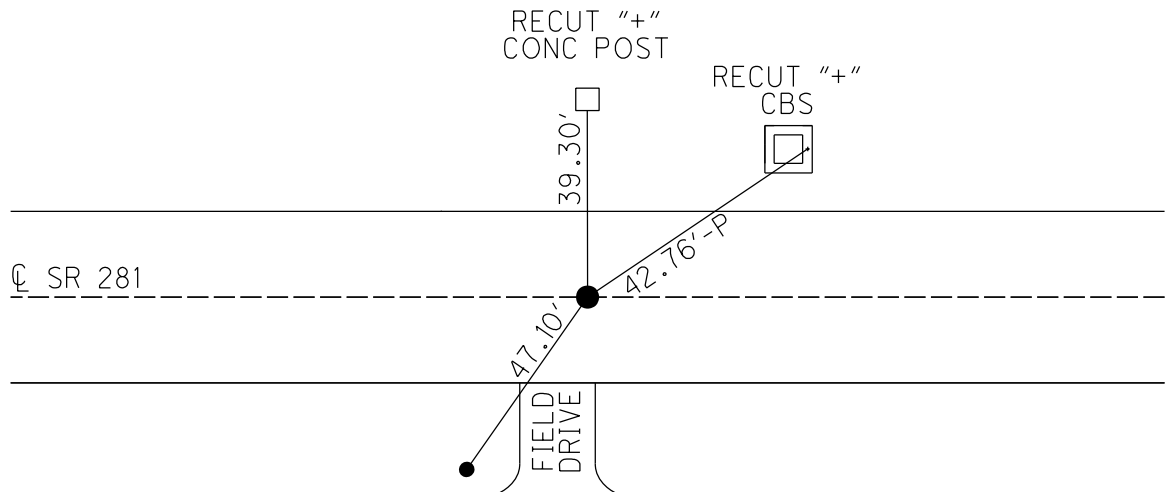

O.D.O.T. DISTRICT 2 SURVEY OFFICE (USE ONLY)

PERSONNEL

REFERENCE NO. 22 AB

SHEET 17 OF 34

NOTES PRESTON-COLVIN

DATE 11/26/24

ROUTE SR 281

H.C. NEISE

WEATHER WINDY

COUNTY HENRY

R.C. PRESTON-COLVIN

TEMP. 40°

TOWNSHIP MONROE

SECTION 24

DWG BY PRESTON-COLVIN

PID PAVING TRAIN

T 4 N R 7 E

TYPE MONUMENT PK NAIL

ON SURFACE - ~~BELOW~~ ON

OFFSET $\angle$ PAVEMENT 2.8' ~~LT~~ : RT

- TO - EDGE PAVEMENT

STATION: 576+06

HORIZ.DATUM: NAD83 2011


GEOID: 18

GRID: NORTHING: -

EASTING: -


LDP: NORTHING: 449350.8

EASTING: 186649.6

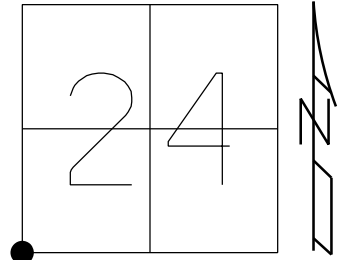

RECORD:
FD R.R.SPIKE,
SET BY COUNTY
OVER STONE
6/5/79
FD SM.R.R.SPIKE
5/28/98, MC
SET P.K./WASHER
10/1/98, MRC
FD P.K.NAIL
REF22AB
9/6/18, JFO
7/25/19,
1/11/23, JMR
FD PK NAIL
REF22AB
7/22/24, TDN
FD PK NAIL
11/26/24, TDN

SW CORNER OF SEC 24
P.I. OF $\angle$ SURVEY

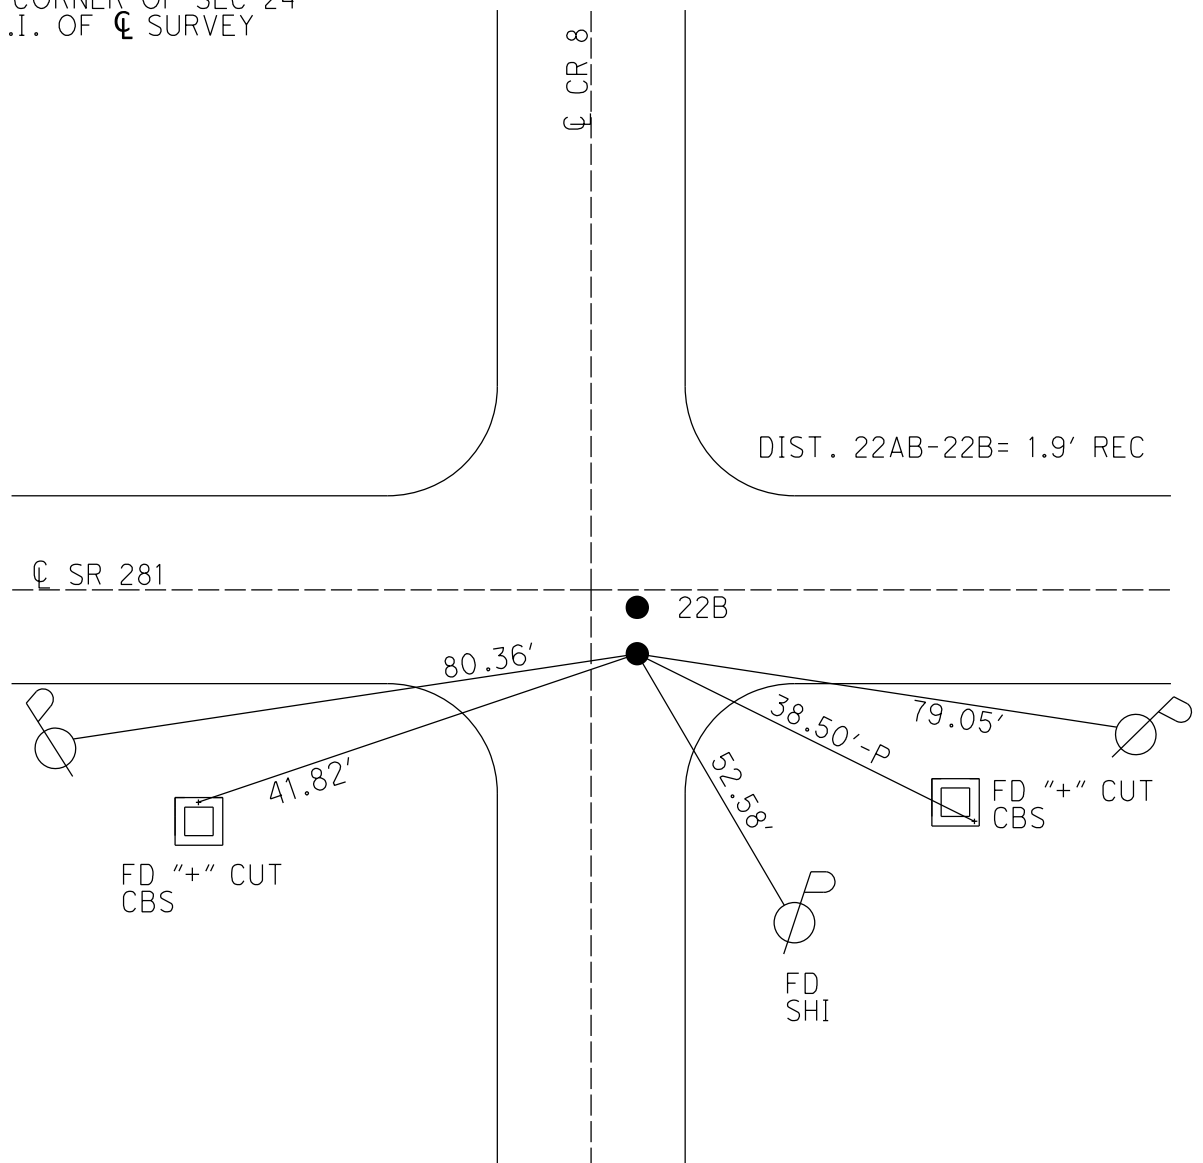

O.D.O.T. DISTRICT 2 SURVEY OFFICE (USE ONLY)

PERSONNEL

REFERENCE NO. 22 B

SHEET 18 OF 34

NOTES PRESTON-COLVIN

DATE 11/26/24

ROUTE SR 281

H.C. NEISE

WEATHER WINDY

COUNTY HENRY

R.C. PRESTON-COLVIN

TEMP. 40°

TOWNSHIP MONROE

SECTION 24

DWG BY PRESTON-COLVIN

PID PAVING TRAIN

T 4 N R 7 E

TYPE MONUMENT PK NAIL

ON SURFACE - ~~BELOW~~ ON

OFFSET ϕ PAVEMENT 1.0' ~~LT~~ : RT

- TO - EDGE PAVEMENT

STATION: 576+06

HORIZ.DATUM: NAD83 2011


GEOID: 18

GRID: NORTHING: 592611.755

EASTING: 1551393.702


LDP: NORTHING: 449352.7

EASTING: 186649.9

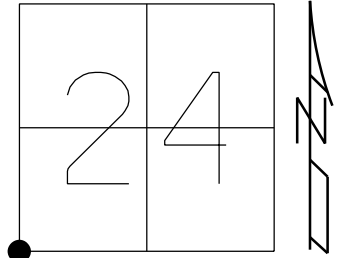


RECORD:
FD HARROW TOOTH
SQUARE SPIKE
BY COUNTY
6/5/79
FD SM.R.R. SPIKE
5/28/98, MC
SET P.K./WASHER
10/1/98, MRC
FD HARROW TOOTH
5" DOWN
REF22B
7/22/24, TDN

BELIEVED TO BE
ON ϕ CONSTRUCTION

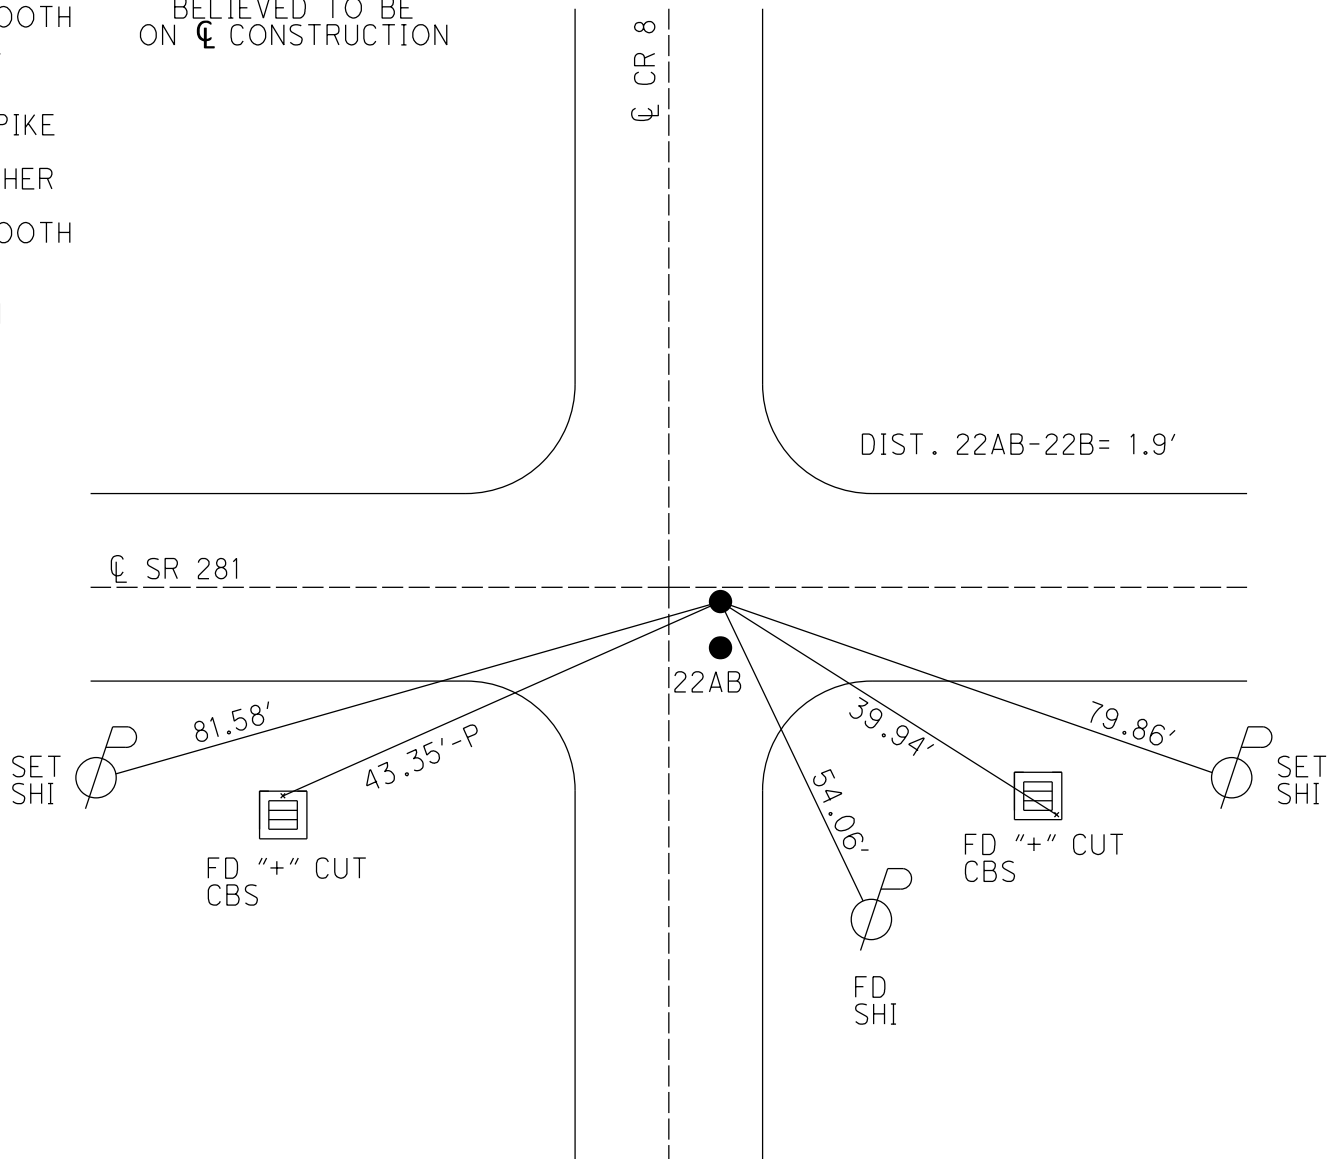


O.D.O.T. DISTRICT 2 SURVEY OFFICE (USE ONLY)

PERSONNEL	REFERENCE NO. <u>23</u>	SHEET <u>19</u> OF <u>34</u>
NOTES <u>PRESTON-COLVIN</u>	DATE <u>11/26/24</u>	ROUTE <u>SR 281</u>
H.C. <u>NEISE</u>	WEATHER <u>WINDY</u>	COUNTY <u>HENRY</u>
R.C. <u>PRESTON-COLVIN</u>	TEMP. <u>40°</u>	TOWNSHIP <u>MONROE</u>
		SECTION <u>24</u>
DWG BY <u>PRESTON-COLVIN</u>	PID <u>PAVING TRAIN</u>	T <u>4</u> N R <u>7</u> E
TYPE MONUMENT <u>SM RR SPIKE</u>		
ON SURFACE - BELOW <u>5.5" DOWN</u>		
OFFSET <u>CL</u> PAVEMENT <u>ON</u> LT : RT		
<u>10.4'</u> TO <u>RT</u> EDGE PAVEMENT		
STATION: <u>589+31</u>		
HORZ. DATUM: <u>NAD83 2011</u>		GEOID: <u>18</u>
GRID: NORTHING: <u>592604.447</u>		EASTING: <u>1552718.822</u>
LDP: NORTHING: <u>449367.7</u>		EASTING: <u>187974.8</u>

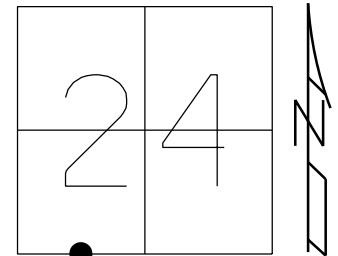

RECORD:
 1/4-1/4 COR SEC 24
 FD SM.R.R.SPIKE
 8/18/98, MC
 SET SM.R.R.SPIKE
 9/2/87, CL
 FD SM.R.R.SPIKE
 8/18/98, MC
 SET P.K./WASHER
 10/1/98, MRC
 FD P.K.SHANK
 REF23
 9/6/18, JFO
 7/25/19,
 1/11/23, JMR
 FD PK SHANK
 REF23
 7/23/24, TDN
 FD SM RRSPK
 NEW REF23
 5.5" DOWN
 11/26/24, TDN

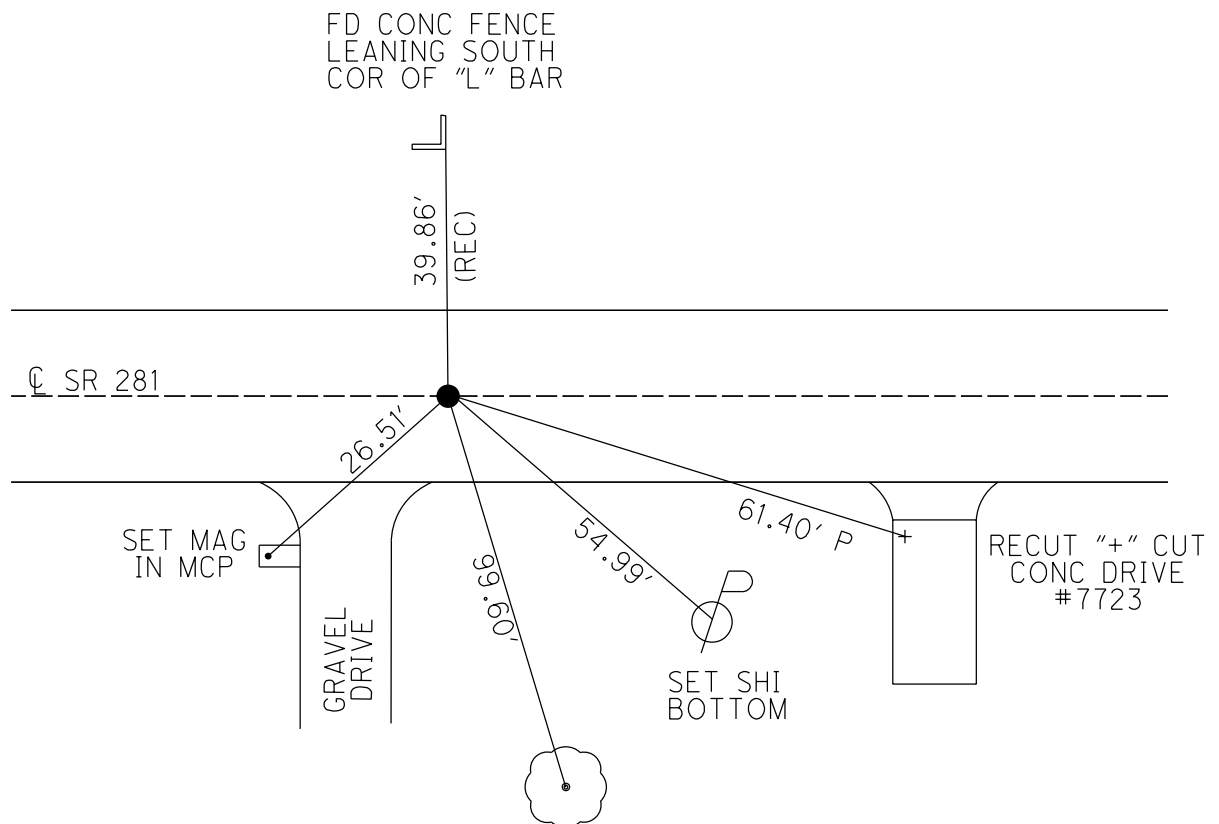

O.D.O.T. DISTRICT 2 SURVEY OFFICE (USE ONLY)

PERSONNEL

REFERENCE NO. 25

SHEET 20 OF 34

NOTES PRESTON-COLVIN

H.C. NEISE

R.C. PRESTON-COLVIN

DATE 11/26/24

WEATHER WINDY

TEMP. 40°

ROUTE SR 281

COUNTY HENRY

TOWNSHIP RICHFIELD

SECTION 19

DWG BY PRESTON-COLVIN PID PAVING TRAIN

T 4 N R 8 E

TYPE MONUMENT SM RR SPIKE

ON SURFACE - ~~BELOW~~ 3"

OFFSET $\angle$ PAVEMENT 3.9' ~~LT~~ : RT

- TO - EDGE PAVEMENT 11.7' W $\angle$ CR 7 S

STATION: 628+82

HORIZ.DATUM: NAD83 2011


GEOID: 18

GRID: NORTHING: 592526.089


EASTING: 1556668.797

LDP: NORTHING: 449361.9

EASTING: 191925.8

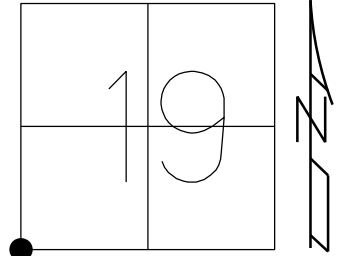

RECORD:
FD SM.R.R.SPIKE
8/18/98, MC
SET P.K./WASHER
10/1/98, MRC
FD SM.R.R.SPIKE
3" DOWN
REF25
9/6/18, JFO
7/25/19,
1/11/23, JMR
FD SM RRS
3" DOWN DAMAGED
7/24/24, TDN
FD SM RRS
3" DOWN
11/26/24, TDN

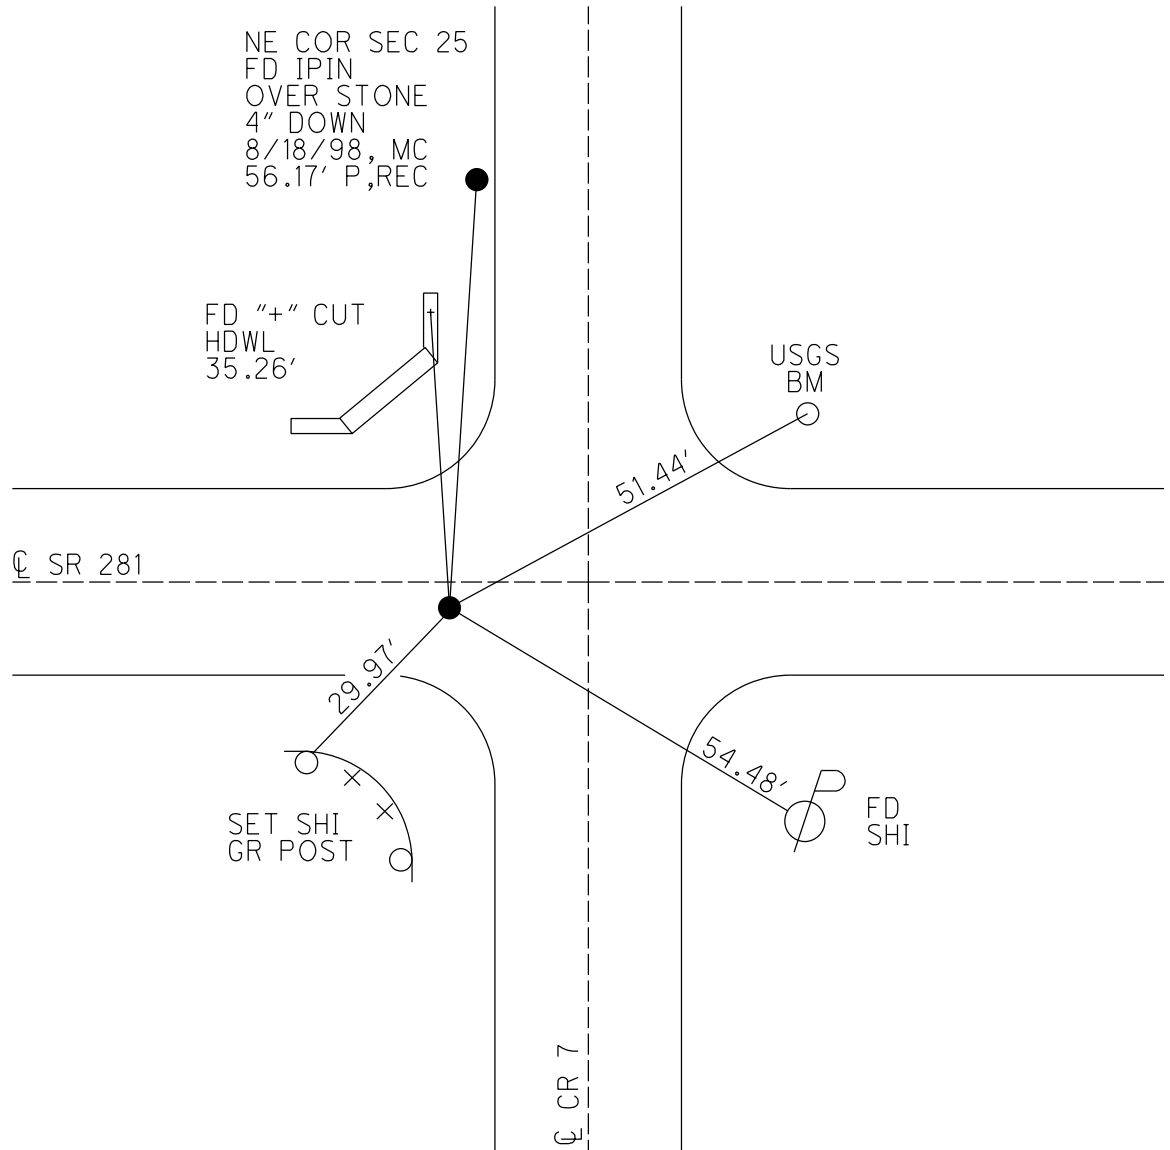

O.D.O.T. DISTRICT 2 SURVEY OFFICE (USE ONLY)

PERSONNEL

REFERENCE NO. 26

SHEET 21 OF 34

NOTES PRESTON-COLVIN

DATE 11/26/24

ROUTE SR 281

H.C. NEISE

WEATHER WINDY

COUNTY HENRY

R.C. PRESTON-COLVIN

TEMP. 40°

TOWNSHIP RICHFIELD

SECTION 19

DWG BY PRESTON-COLVIN PID PAVING TRAIN

T 4 N R 8 E

TYPE MONUMENT PK NAIL

ON SURFACE - ~~BELOW~~ ON

OFFSET CL PAVEMENT 1.8' ~~LT~~ : RT

8.2' TO RT EDGE PAVEMENT 11.7' W CL CR 7 S

STATION: 628+82

HORIZ.DATUM: NAD83 2011


GEOID: 18

GRID: NORTHING: 592526.089


EASTING: 1556668.797

LDP: NORTHING: 449383.8

EASTING: 194509.4

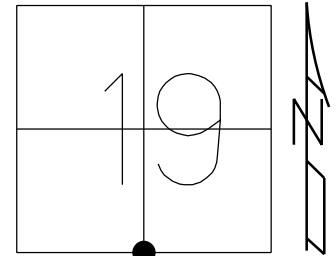

RECORD:
 SET SM.R.R.SPIKE
 9/2/87, CL
 FD SM.R.R.SPIKE
 ATOP R.R.SPIKE
 8/18/98, MC
 SET P.K./WASHER
 10/1/98, MRC
 FD P.K.NAIL
 REF26
 9/6/18, JFO
 7/25/19,
 1/11/23, JMR
 FD PK NAIL
 7/24/24, TDN
 PK PK WASHER
 11/26/24, TDN

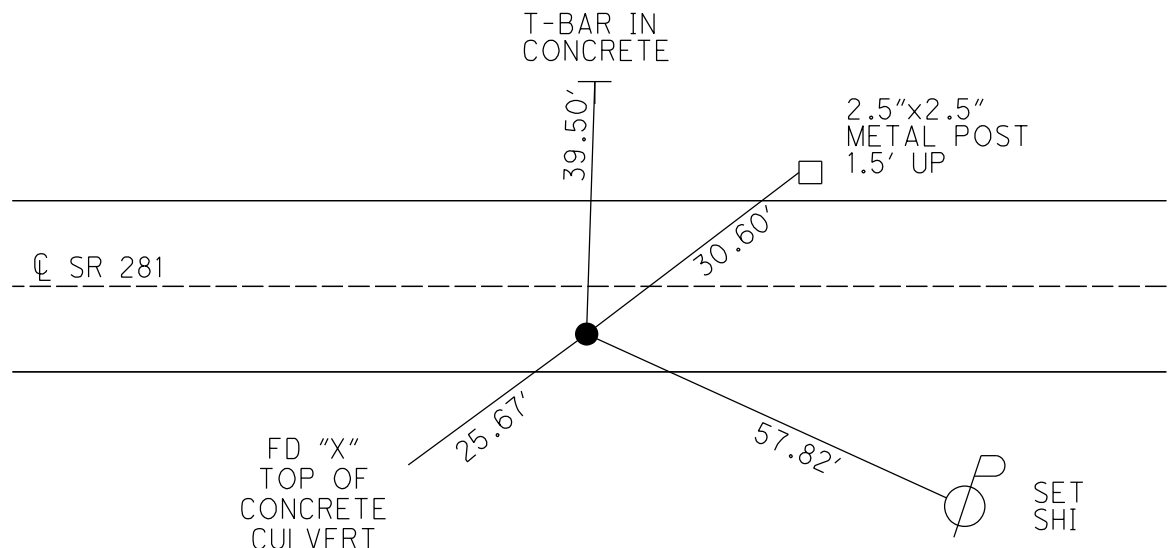

O.D.O.T. DISTRICT 2 SURVEY OFFICE (USE ONLY)

PERSONNEL

REFERENCE NO. 27

SHEET 22 OF 34

NOTES PRESTON-COLVIN

DATE 11/26/24

ROUTE SR 281

H.C. NEISE

WEATHER WINDY

COUNTY HENRY

R.C. PRESTON-COLVIN

TEMP. 40°

TOWNSHIP RICHFIELD

SECTION 19

DWG BY PRESTON-COLVIN PID PAVING TRAIN

T 4 N R 8 E

TYPE MONUMENT SM RR SPIKE

ON SURFACE - ~~BELOW~~ 3"

OFFSET Q PAVEMENT 4.8' ~~LT~~ : RT

- TO - EDGE PAVEMENT

STATION: 681+06

HORIZ.DATUM: NAD83 2011


GEOID: 18

GRID: NORTHING: 592470.611


EASTING: 1561893.334

LDP: NORTHING: 449402.4

EASTING: 194509.4

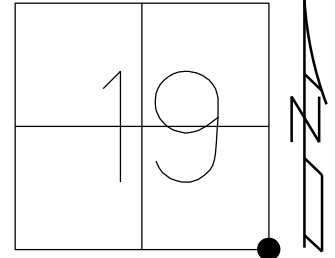

RECORD:
FD SM.R.R.SPIKE
ATOP SM.R.R.SPIKE
8/18/98, MC
SET P.K./WASHER
10/1/98, MRC
FD SM.R.R.SPIKE
3" DOWN
REF27
9/6/18, JFO
7/25/19,
1/11/23, JMR
FD SM RRS
REF27
3" DOWN
FD SM RRS
REF27
11/26/24, TDN

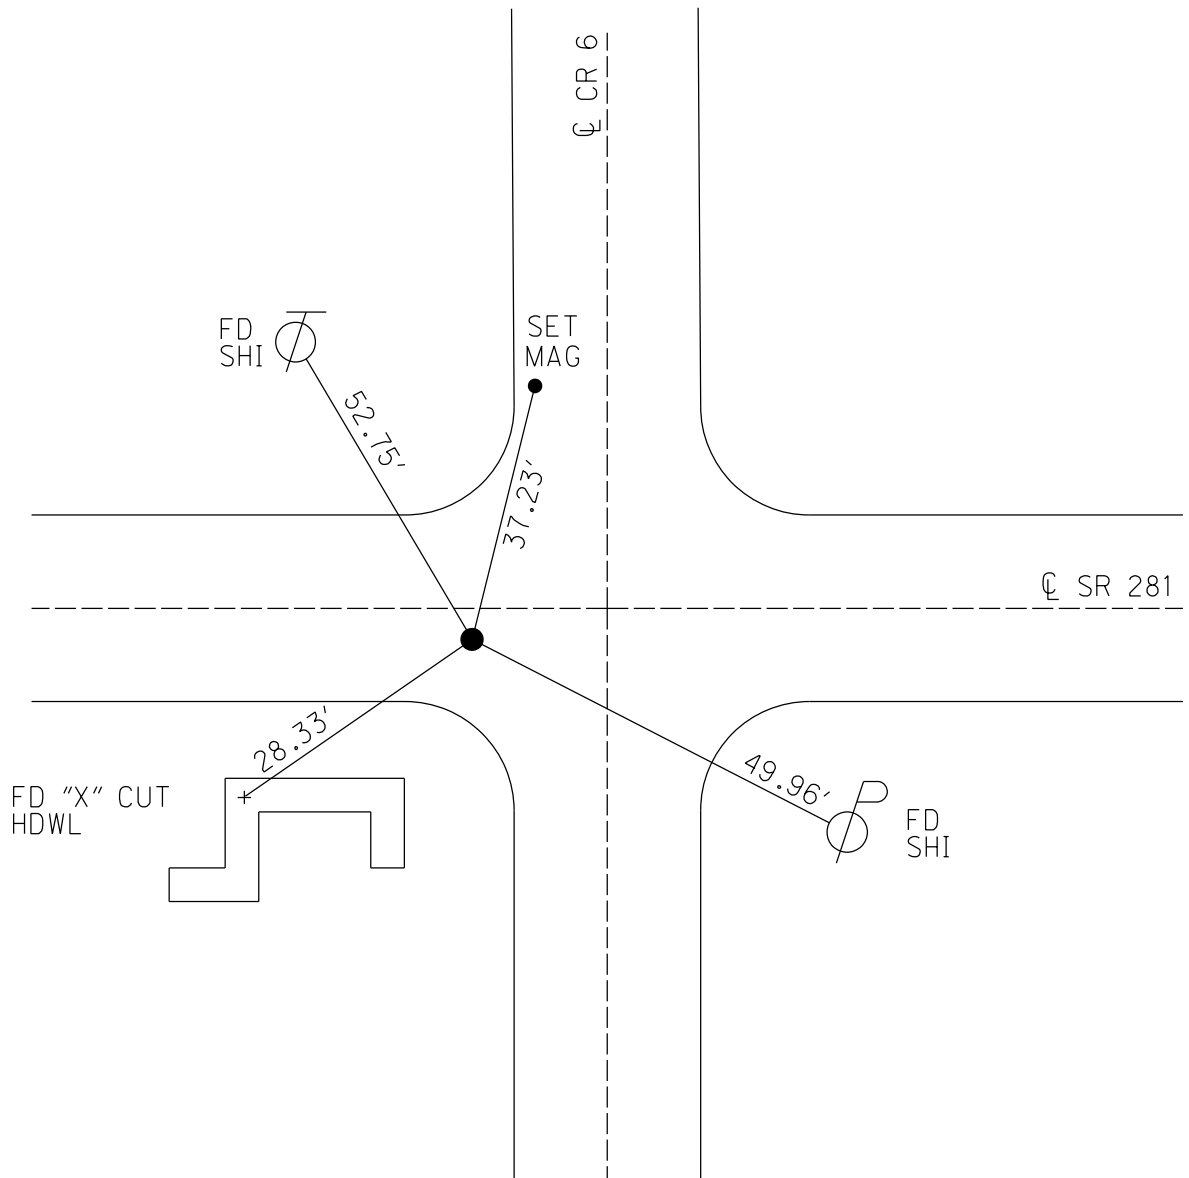

O.D.O.T. DISTRICT 2 SURVEY OFFICE (USE ONLY)

PERSONNEL

REFERENCE NO. 28

SHEET 23 OF 34

NOTES PRESTON-COLVIN

H.C. NEISE

R.C. PRESTON-COLVIN

DATE 11/26/24

WEATHER WINDY

TEMP. 40°

ROUTE SR 281

COUNTY HENRY

TOWNSHIP RICHFIELD

SECTION 20

DWG BY PRESTON-COLVIN PID PAVING TRAIN

T 4 N R 8 E

TYPE MONUMENT SHANK/WASHER

ON SURFACE - ~~BELOW~~ ON

OFFSET 1.7' ~~LT~~ : RT

- TO - EDGE PAVEMENT

STATION: 681+06

HORIZ.DATUM: NAD83 2011


GEOID: 18

GRID: NORTHING: 592460.657

EASTING: 1564562.113


LDP: NORTHING: 449402.4

EASTING: 197150.9

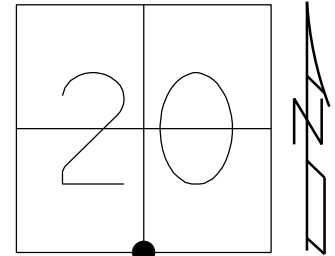

RECORD:
FD SM.R.R.SPIKE
ATOP P.K.NAIL
6/2/98, MC
SET P.K./WASHER
10/5/98, MRC
FD P.K./WASHER
REF20
9/6/18, JFO
7/25/19,
1/11/23, JMR
FD PK
REF28
7/24/24, TDN
FD SHANK/WASHER
11/26/24, TDN

CL SR 281

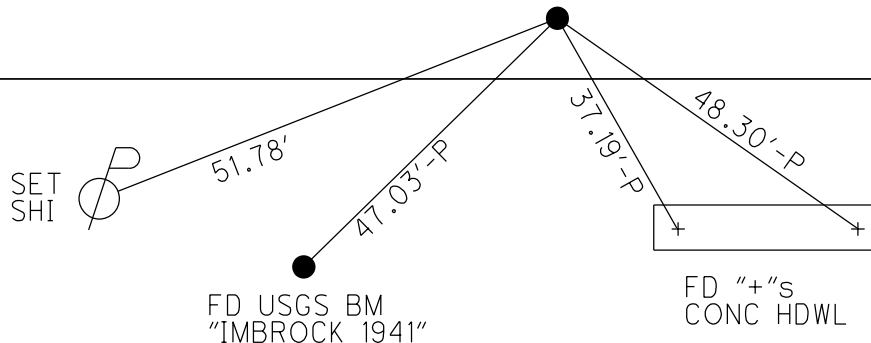

O.D.O.T. DISTRICT 2 SURVEY OFFICE (USE ONLY)

PERSONNEL

REFERENCE NO. 29

SHEET 24 OF 34

NOTES PRESTON-COLVIN

H.C. NEISE

R.C. PRESTON-COLVIN

DATE 11/26/24

WEATHER WINDY

TEMP. 40°

ROUTE SR 281

COUNTY HENRY

TOWNSHIP RICHFIELD

SECTION 20

DWG BY PRESTON-COLVIN

PID PAVING TRAIN

T 4 N R 8 E

TYPE MONUMENT SM RR SPIKE

~~ON SURFACE~~ - BELOW 3"

OFFSET ϕ PAVEMENT 2.0' ~~LT~~ : RT

- TO - EDGE PAVEMENT 5.2' W OF ϕ CR 5 N

STATION: 734+43

HORIZ.DATUM: NAD83 2011


GEOID: 18

GRID: NORTHING: 592440.193


EASTING: 1567230.169

LDP: NORTHING: 449469.9

EASTING: 202487.9

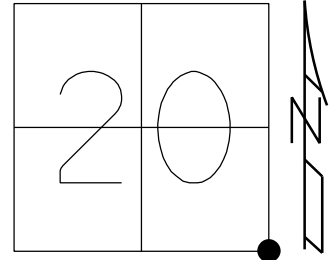

RECORD:
 SET SM.R.R.SPIKE
 9/2/87, CL
 FD SM.R.R.SPIKE
 6/2/98, MC
 SET P.K./WASHER
 10/5/98, MRC
 FD SM.R.R.SPIKE
 3" DOWN
 REF29
 9/6/18, JFO
 7/25/19,
 1/11/23, JMR
 FD SM RRSK
 REF29
 7/24/24, TDN
 FD SM RRSK
 11/26/24, TDN

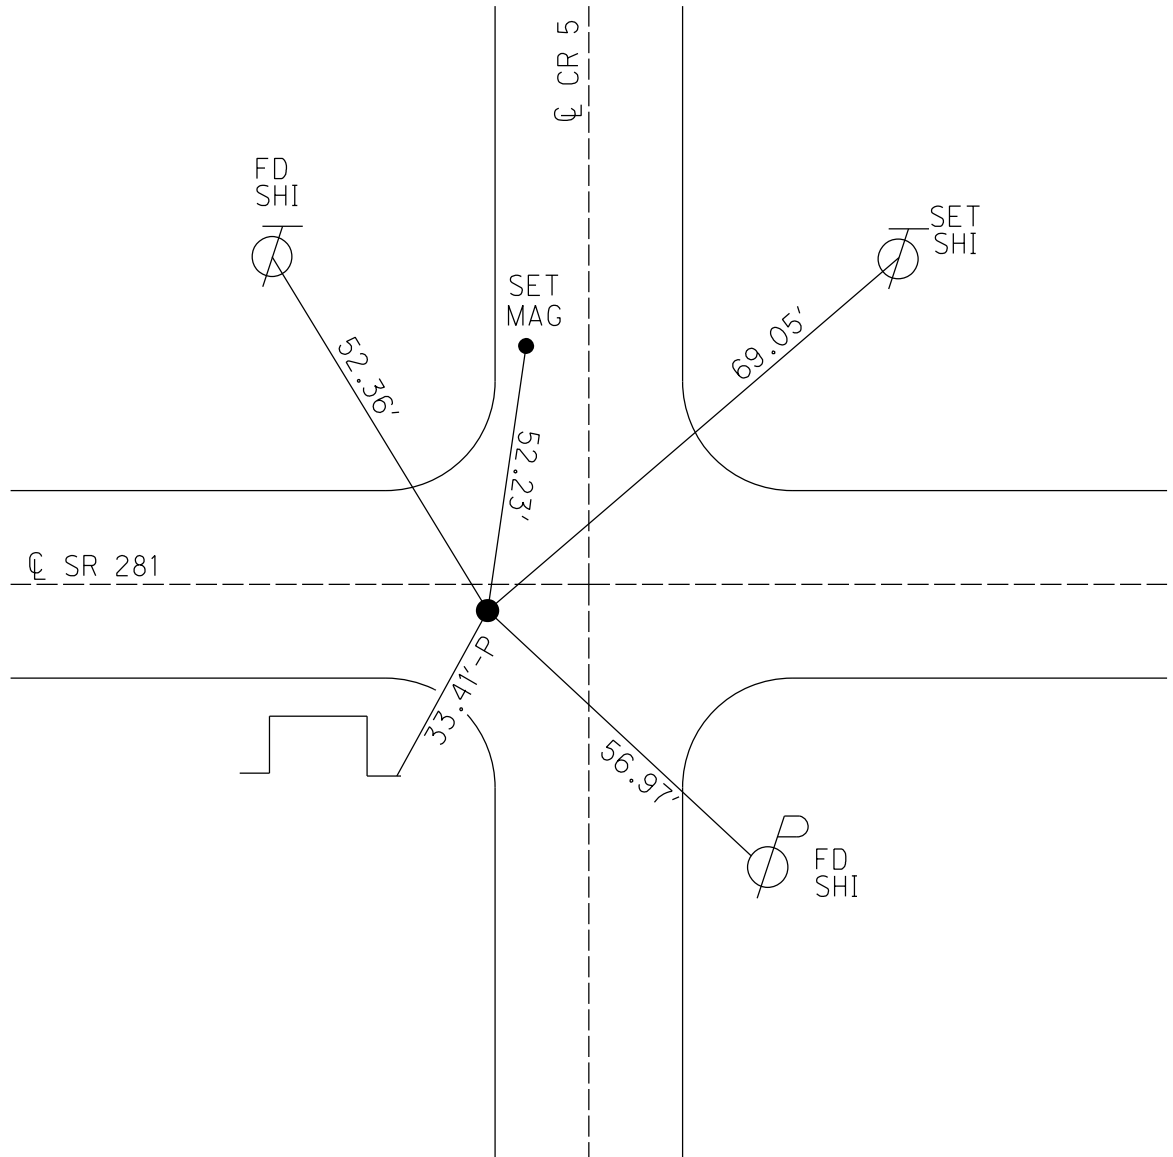

O.D.O.T. DISTRICT 2 SURVEY OFFICE (USE ONLY)

PERSONNEL

REFERENCE NO. 30

SHEET 25 OF 34

NOTES PRESTON-COLVIN

H.C. NEISE

R.C. PRESTON-COLVIN

DATE 11/26/24

WEATHER WINDY

TEMP. 40°

ROUTE SR 281

COUNTY HENRY

TOWNSHIP RICHFIELD

SECTION 21

DWG BY PRESTON-COLVIN

PID PAVING TRAIN

T 4 N R 8 E

TYPE MONUMENT SM RR SPIKE

~~ON SURFACE~~ - BELOW ON

OFFSET 6.1' TO RT PAVEMENT 4.0' ~~LT~~ : RT

STATION: 761+02

HORIZ.DATUM: NAD83 2011


GEOID: 18

GRID: NORTHING: 592440.193


EASTING: 1567230.169

LDP: NORTHING: 449469.9

EASTING: 202487.9

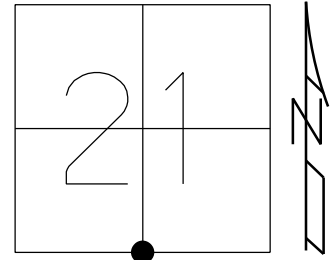

RECORD:
 SET SM.R.R.SPIKE
 9/2/87, CL
 FD SM.R.R.SPIKE
 6/2/98, MC
 SET P.K./WASHER
 10/5/98, MRC
 FD SM.R.R.SPIKE
 REF30
 9/7/18, JFO
 7/25/19,
 1/11/23, JMR
 FD SM RRS
 REF30
 7/24/24, JAM
 FD SM RRS
 11/26/24, TDN

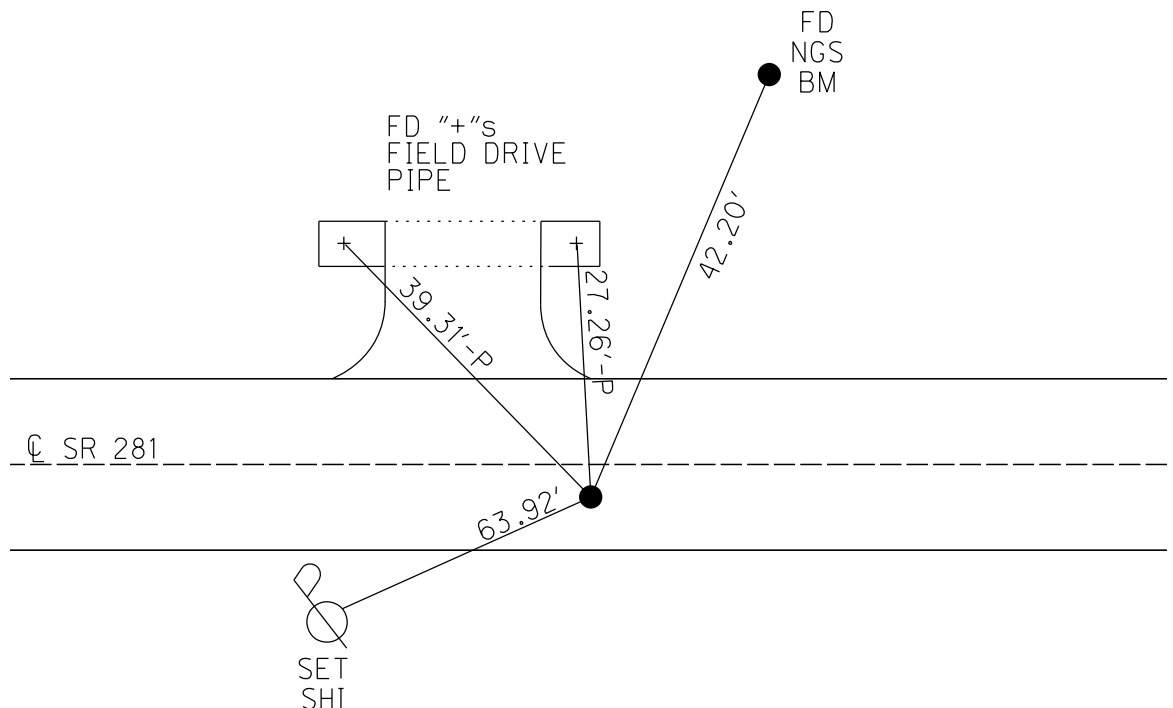

O.D.O.T. DISTRICT 2 SURVEY OFFICE (USE ONLY)

PERSONNEL

REFERENCE NO. 31

SHEET 26 OF 34

NOTES PRESTON-COLVIN

H.C. NEISE

R.C. PRESTON-COLVIN

DATE 11/26/24

WEATHER WINDY

TEMP. 40°

ROUTE SR 281

COUNTY HENRY

TOWNSHIP RICHFIELD

SECTION 28

DWG BY PRESTON-COLVIN PID PAVING TRAIN

T 4 N R 8 E

TYPE MONUMENT MAG/WASHER

~~ON SURFACE~~ - BELOW ON

OFFSET $\odot$ PAVEMENT 1.7' ~~LT~~ : RT

- TO - EDGE PAVEMENT

STATION: 787+93

HORZ.DATUM: NAD83 2011


GEOID: 18

GRID: NORTHING: 592437.952

EASTING: 1572551.483


LDP: NORTHING: 449565.4

EASTING: 207808.7

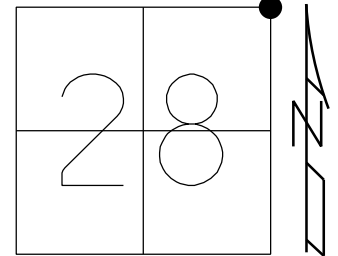

RECORD:
R.R.SPIKE SET
BY COUNTY ENG
FD MAG/WASHER
9/16/02, DCH
SET MAG/WASHER
11/21/02, MB
FD MAG/WASHER
7/11/12, MC
FD MAG/WASHER
REF17
5/10/17, JFO
SET MAG/WASHER
9/22/17, JFO
FD MAG/WASHER
1/11/23, JMR
FD MAG/WASHER
REF31
7/24/24, JAM
FD MAG/WASHER
11/26/24, TDN

NOT: REF 17 SR 65

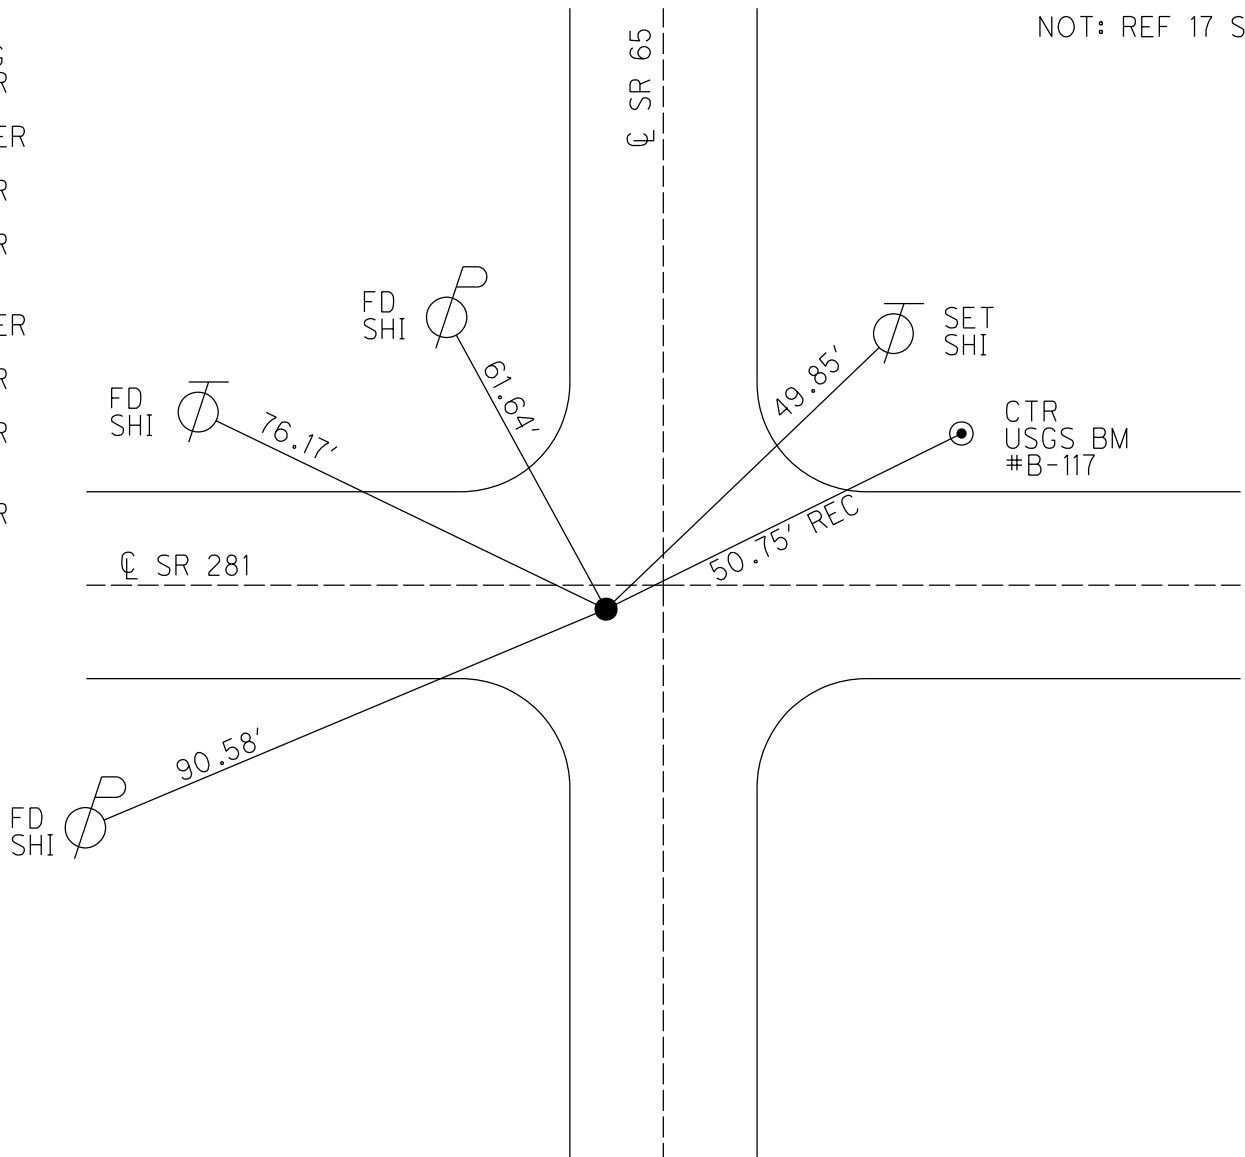

O.D.O.T. DISTRICT 2 SURVEY OFFICE (USE ONLY)

PERSONNEL

REFERENCE NO. 32

SHEET 27 OF 34

NOTES PRESTON-COLVIN

DATE 11/26/24

ROUTE SR 281

H.C. NEISE

WEATHER WINDY

COUNTY HENRY

R.C. PRESTON-COLVIN

TEMP. 40°

TOWNSHIP RICHFIELD

SECTION 27

DWG BY PRESTON-COLVIN PID PAVING TRAIN

T 4 N R 8 E

TYPE MONUMENT 5/8" IPIN

~~ON SURFACE~~ - BELOW 3"

OFFSET 7.7' TO RT EDGE PAVEMENT

STATION: 814+32

HORZ.DATUM: NAD83 2011


GEOID: 18

GRID: NORTHING: 592410.579

EASTING: 1575206.585

LDP: NORTHING: 449586.6


EASTING: 210464.2

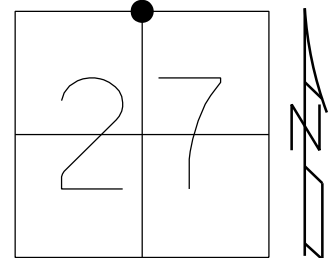

RECORD:
N¹/₄ COR SEC 27
CORNER LOST, RE-ESTABLISHED MIDWAY
BETWEEN NE&NW COR OF SEC 27
PLACED 5/8"x18" IPIN
P.K.'S 15' NE&NW
HENRY COUNTY, 1979

RECORD:
FD 5/8" IPIN
6" DOWN
LEANING SOUTH
6/2/98, MC
FD 5/8" IPIN
3" DOWN
9/7/18, JFO
7/25/19, JMR
FD 5/8" IPIN
3" DOWN
7/25/24, JAM

CL SR 281

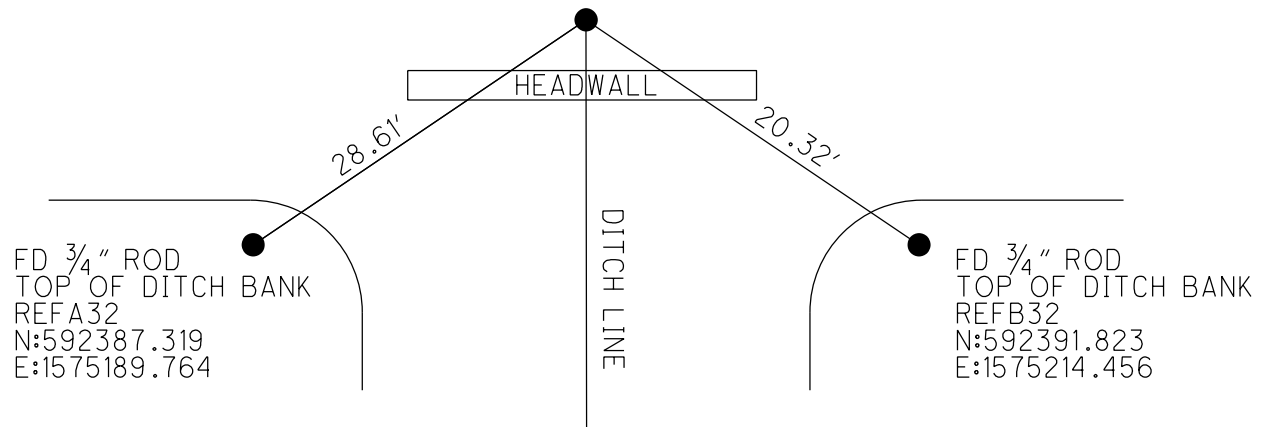

O.D.O.T. DISTRICT 2 SURVEY OFFICE (USE ONLY)

PERSONNEL

REFERENCE NO. 33

SHEET 28 OF 34

NOTES PRESTON-COLVIN

DATE 11/26/24

ROUTE SR 281

H.C. NEISE

WEATHER WINDY

COUNTY HENRY

R.C. PRESTON-COLVIN

TEMP. 40°

TOWNSHIP RICHFIELD

SECTION 26

DWG BY PRESTON-COLVIN PID PAVING TRAIN

T 4 N R 8 E

TYPE MONUMENT PK/WASHER

~~ON SURFACE~~ - BELOW ON

OFFSET ¢ PAVEMENT 5.2' ~~LT~~ : RT

4.5' TO RT EDGE PAVEMENT

STATION: 840+91

HORZ.DATUM: NAD83 2011


GEOID: 18

GRID: NORTHING: 592383.286


EASTING: 1577861.760

LDP: NORTHING: 449608.2

EASTING: 213119.6

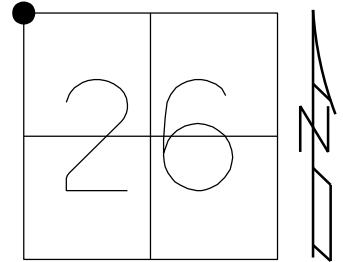

RECORD:
FD IPIN OVER STONE
REMOVED PIN & PLACED
RR SPK ON SURFACE
NW COR SEC 26
HENRY COUNTY, 1979
SET SM.R.R.SPIKE
10/28/89
FD SM.R.R.SPIKE
ATOP R.R.SPIKE
6/2/98, MC
SET P.K./WASHER
9/29/98, MRC
FD P.K./WASHER
REF33
9/7/18, JFO
7/25/19,
1/11/23, JMR
FD PK/WASHER
7/25/24, TDN
FD PK/WASHER
11/26/24, TDN

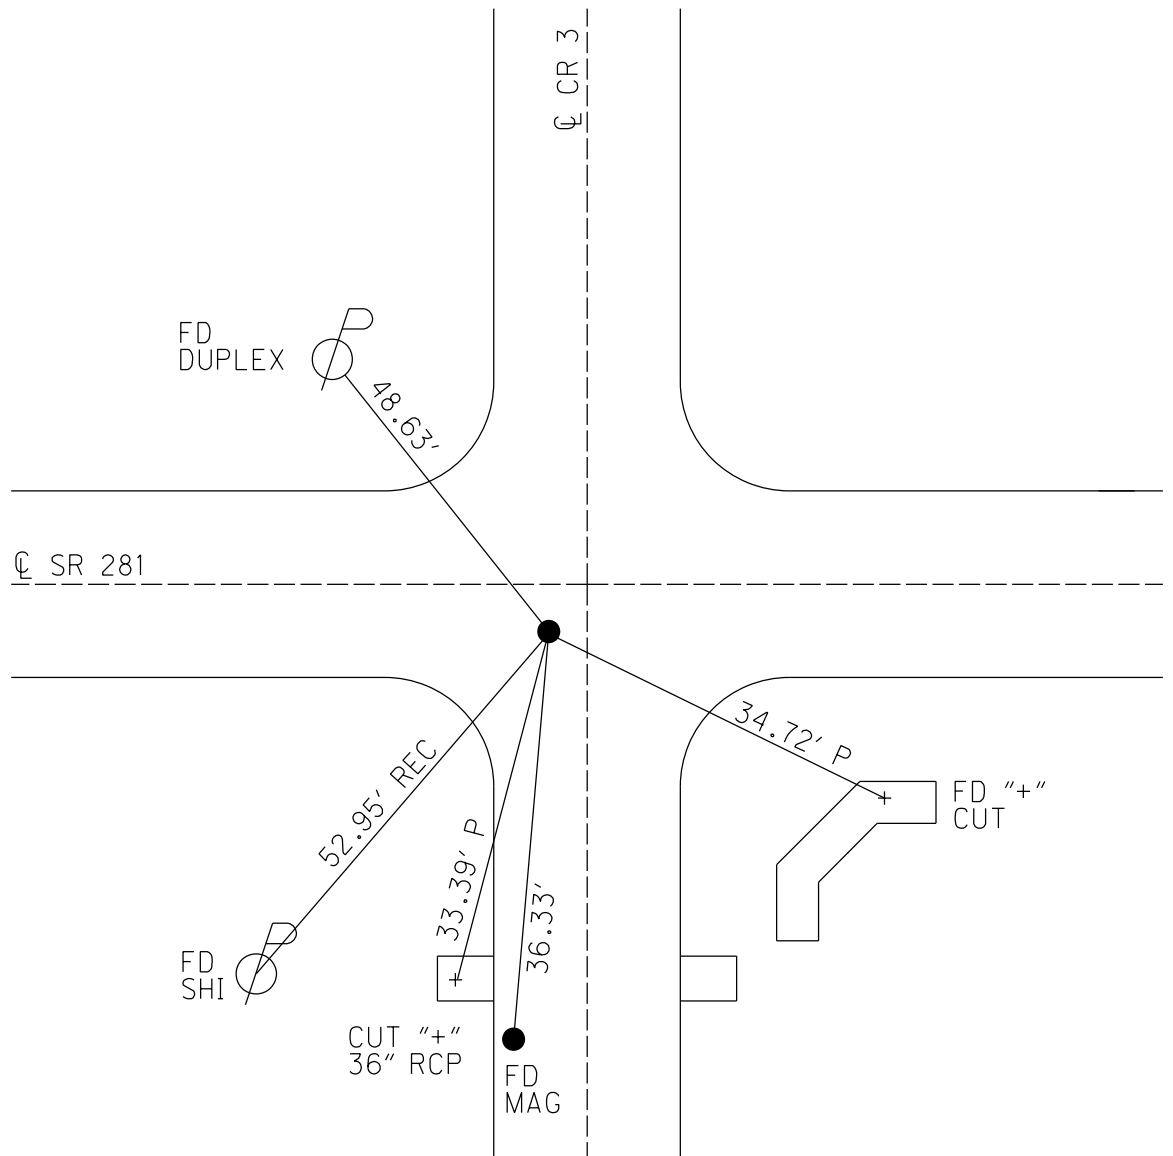

O.D.O.T. DISTRICT 2 SURVEY OFFICE (USE ONLY)

PERSONNEL

REFERENCE NO. 34

SHEET 29 OF 34

NOTES PRESTON-COLVIN

H.C. NEISE

R.C. PRESTON-COLVIN

DATE 11/26/24

WEATHER WINDY

TEMP. 40°

ROUTE SR 281

COUNTY HENRY

TOWNSHIP RICHFIELD

SECTION 26

DWG BY PRESTON-COLVIN PID PAVING TRAIN

T 4 N R 8 E

TYPE MONUMENT MAG/WASHER

~~ON SURFACE~~ - BELOW ON

OFFSET 7.9' ~~LT~~ : RT

2.9' TO RT EDGE PAVEMENT

STATION: 867+60

HORIZ.DATUM: NAD83 2011


GEOID: 18

GRID: NORTHING: 592370.588


EASTING: 1580527.030

LDP: NORTHING: -

EASTING: -

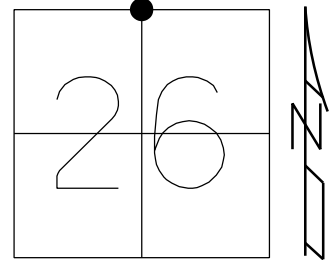

RECORD:
 N¹/₄ CORNER SEC 26
 FD IPIPE OVER STONE
 REMOVED PIPE AND PLACED
 RR SPIKE OVER STONE
 HENRY CO., 1979
 SET SM.R.R.SPIKE
 10/28/86
 FD SM.R.R.SPIKE
 ATOP R.R.SPIKE
 6/2/98, MC
 SET P.K./WASHER
 9/29/98, MRC
 FD SM.R.R.SPIKE
 REF34
 9/7/18, JFO
 7/25/19,
 1/11/23, JMR
 SET MAG/WASHER
 NEWREF34
 11/26/24, TDN
 SET BY GPS

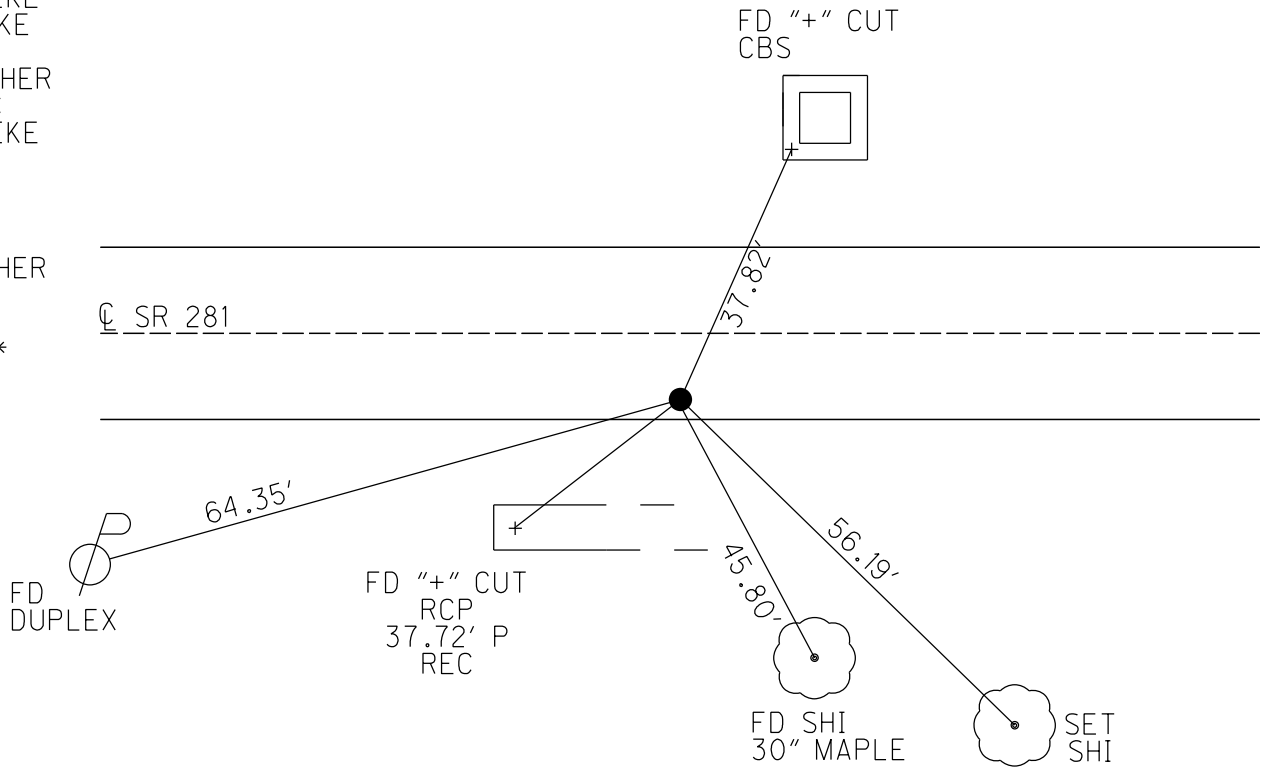

O.D.O.T. DISTRICT 2 SURVEY OFFICE (USE ONLY)

PERSONNEL

REFERENCE NO. 35

SHEET 30 OF 34

NOTES PRESTON-COLVIN

DATE 11/26/24

ROUTE SR 281

H.C. NEISE

WEATHER WINDY

COUNTY HENRY

R.C. PRESTON-COLVIN

TEMP. 40°

TOWNSHIP RICHFIELD

SECTION 25

DWG BY PRESTON-COLVIN

PID PAVING TRAIN

T 4 N R 8 E

TYPE MONUMENT RR SPIKE

~~ON SURFACE~~ - BELOW 1"

OFFSET $\angle$ PAVEMENT 10.0' ~~LT~~ : RT

ON TO RT EDGE PAVEMENT

STATION: 899+27

HORIZ.DATUM: NAD83 2011


GEOID: 18

GRID: NORTHING: 592359.117


EASTING: 1583189.767

LDP: NORTHING: 449681.8

EASTING: 218447.6

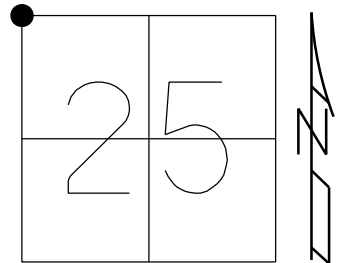

RECORD:
 SET SM.R.R.SPIKE
 10/28/86
 FD SM.R.R.SPIKE
 ATOP R.R.SPIKE
 6/2/98, MC
 SET P.K./WASHER
 9/29/98, MRC
 FD R.R.SPIKE
 1" DOWN
 REF35
 9/7/18, JFO
 7/25/19,
 1/11/23, JMR
 FD RRS 1" DOWN
 REF35
 7/25/24, TDN
 FD RRS 1" DOWN
 11/26/24, TDN

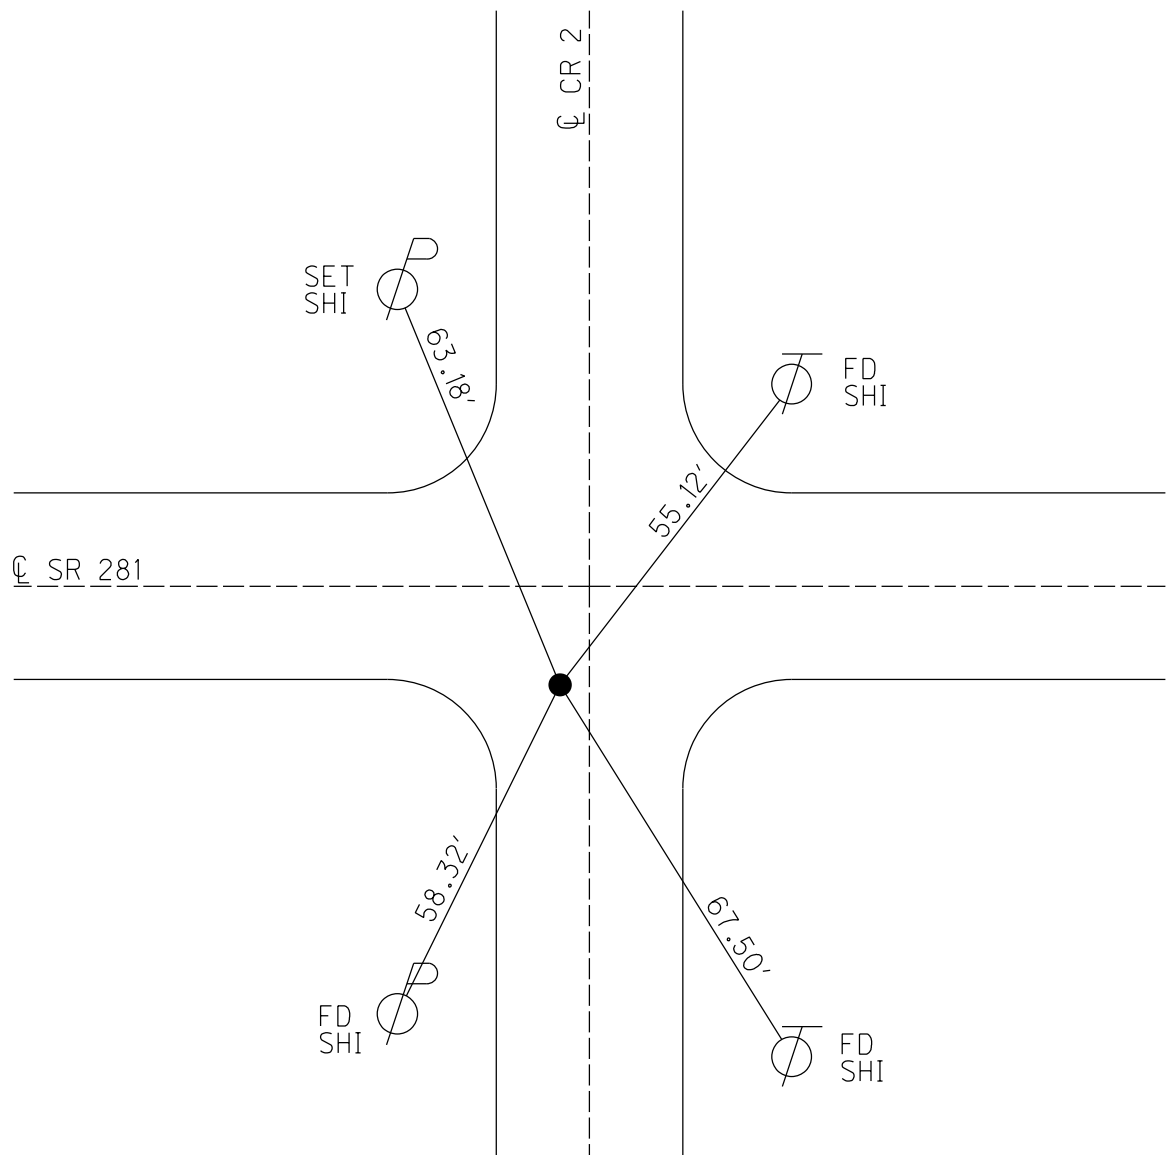

O.D.O.T. DISTRICT 2 SURVEY OFFICE (USE ONLY)

PERSONNEL

REFERENCE NO. 36

SHEET 31 OF 34

NOTES PRESTON-COLVIN

DATE 11/26/24

ROUTE SR 281

H.C. NEISE

WEATHER WINDY

COUNTY HENRY

R.C. PRESTON-COLVIN

TEMP. 40°

TOWNSHIP RICHFIELD

SECTION 25

DWG BY PRESTON-COLVIN PID PAVING TRAIN

T 4 N R 8 E

TYPE MONUMENT SM RR SPIKE

~~ON SURFACE~~ - BELOW 2"

OFFSET $\varnothing$ PAVEMENT 10.6' ~~LT~~ : RT

0.6' TO RT EDGE PAVEMENT

STATION: 920+83

HORIZ.DATUM: NAD83 2011


GEOID: 18

GRID: NORTHING: 592359.117


EASTING: 1583189.767

LDP: NORTHING: 449681.8

EASTING: 218447.6

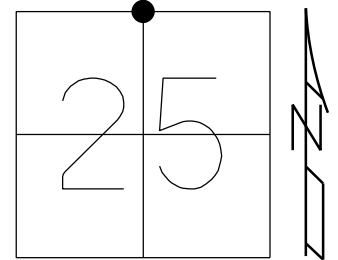

RECORD:
FD SM.R.R.SPIKE
ATOP R.R.SPIKE
6/2/98, MC
FD SM.R.R.SPIKE
2" DOWN
REF36
9/7/18, JFO
7/25/19,
1/11/23, JMR
FD SM RRS
REF36
7/25/24, JAM
FD SM RRS
11/26/24, TDN

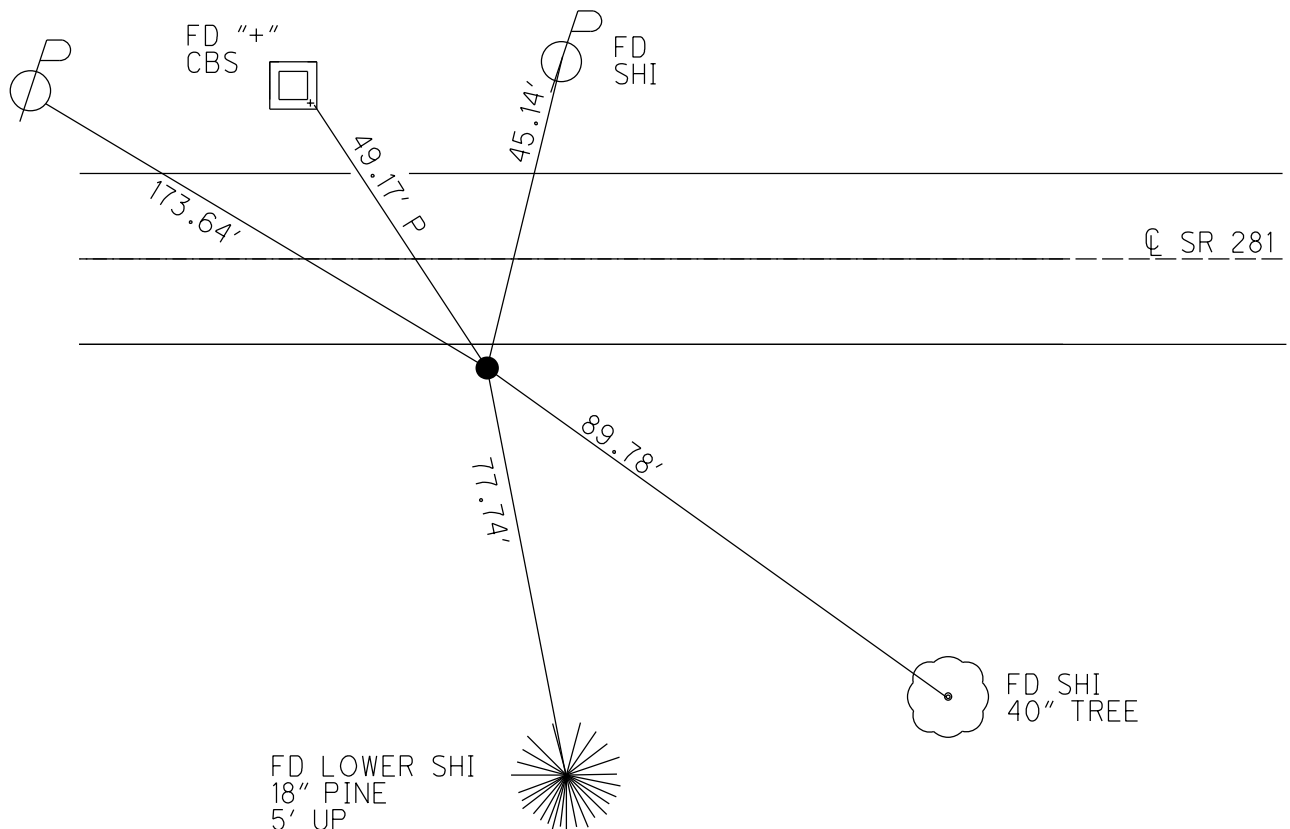

PERSONNEL

SHEET 32 OF 34

DATE 11/26/24

ROUTE SR 281

WEATHER WINDY

COUNTY HENRY

TEMP. 40°

TOWNSHIP RICHFIELDPID PAVING TRAIN

T 4 N R 8 F

ON SURFACE - BELOW 2"

OFFSET C PAVEMENT 11' ~~17'~~ : RT

0.3' TO RT EDGE PAVEMENT

STATION: 936+03.62

HORZ.DATUM: NAD83 2011


GEOID: 18

GRID: NORTHING: 592318.170


EASTING: 1587371.210

LDP: NORTHING: 449717.7

EASTING: 222629.4

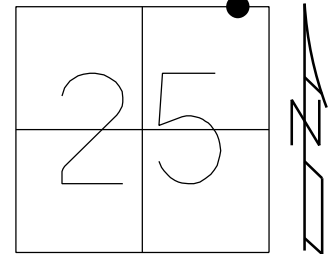

RECORD:
FD MONBOX
W/BOLT
SHOT TOP CTR LID
REFA36
9/7/18, JFO
7/25/19, JMR
FD MON BOX
REF36A
7/25/24, JAM

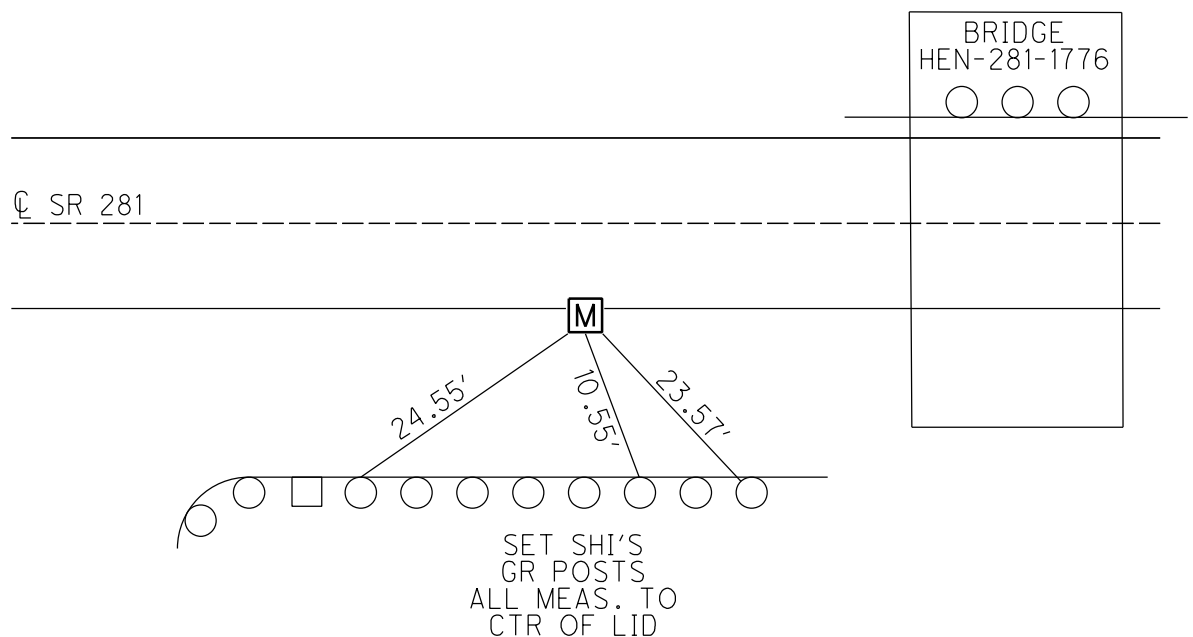

O.D.O.T. DISTRICT 2 SURVEY OFFICE (USE ONLY)

PERSONNEL

REFERENCE NO. 36B

SHEET 33 OF 34

NOTES PRESTON-COLVIN

DATE 11/26/24

ROUTE SR 281

H.C. NEISE

WEATHER WINDY

COUNTY HENRY

R.C. PRESTON-COLVIN

TEMP. 40°

TOWNSHIP RICHFIELD

SECTION 25

DWG BY PRESTON-COLVIN

PID PAVING TRAIN

T 4 N R 8 E

TYPE MONUMENT MONBOX

~~ON SURFACE~~ - BELOW ON

OFFSET $\varnothing$ PAVEMENT 9.5' ~~LT~~ : RT

0.9' TO RT EDGE PAVEMENT

STATION: 938+83.72

HORIZ.DATUM: NAD83 2011


GEOID: 18

GRID: NORTHING: 592316.625


EASTING: 1587651.079

LDP: NORTHING: 449717.7

EASTING: 222629.4

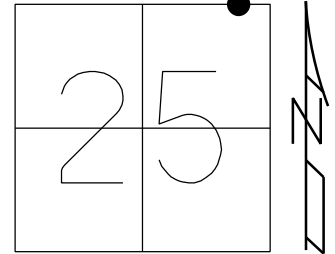

RECORD:
FD MONBOX
COVERED W/ASPHALT
SHOT CTR LID
REFB36
9/7/18, JFO
7/25/19, JMR
FD MON BOX
REF36B
7/25/24, JAM

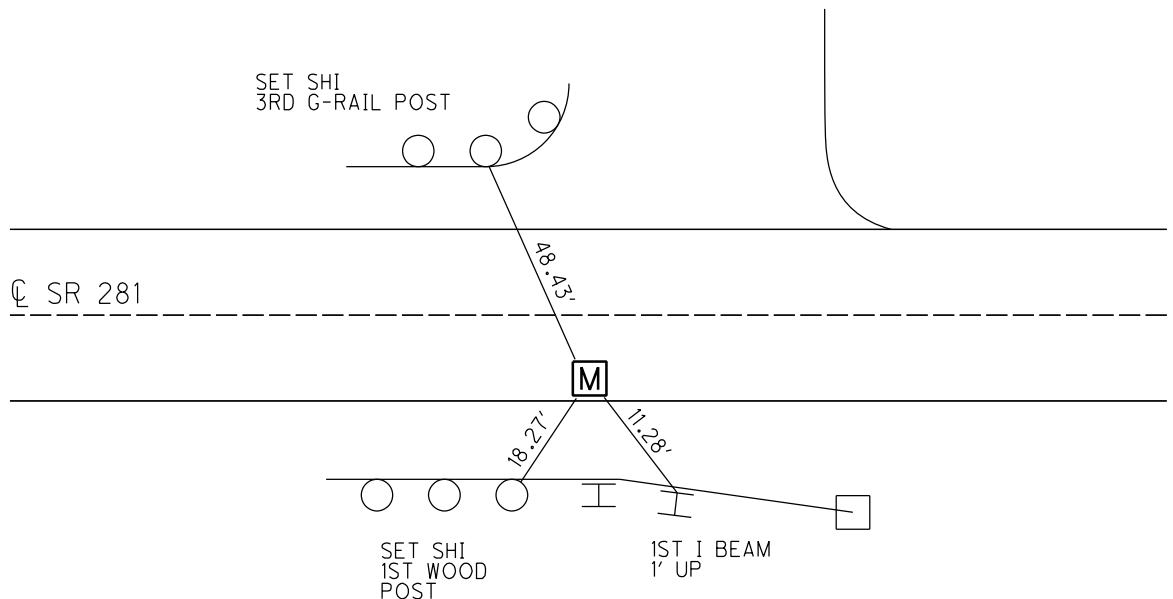

O.D.O.T. DISTRICT 2 SURVEY OFFICE (USE ONLY)

PERSONNEL

REFERENCE NO. 37

SHEET 34 OF 34

NOTES PRESTON-COLVIN

DATE 11/26/24

ROUTE SR 281

H.C. NEISE

WEATHER WINDY

COUNTY HENRY

R.C. PRESTON-COLVIN

TEMP. 40°

TOWNSHIP RICHFIELD

SECTION 25

DWG BY PRESTON-COLVIN PID PAVING TRAIN

T 4 N R 8 E

TYPE MONUMENT MAG/WASHER

~~ON SURFACE~~ - BELOW ON

OFFSET $\odot$ PAVEMENT - ~~LT~~ : RT

- TO - EDGE PAVEMENT

STATION: 947+59

HORIZ.DATUM: NAD83 2011


GEOID: 18

GRID: NORTHING: 592316.625

EASTING: 1587651.079

LDP: NORTHING: 449717.7

EASTING: 222629.4

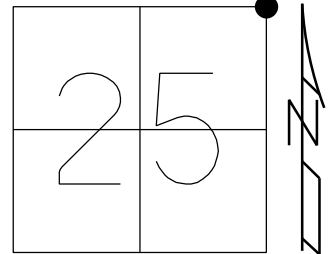

RECORD:
FD R.R.SPIKE
1/8/75, TOMSIC
FD SM.R.R.SPIKE
5/22/90, CL
7/2/12, DCH
SET MAG/WASHER
NEWREF1
9/24/12, DCH
FD MAG/WASHER
REF37
9/7/18, JFO
FD MAG/WASHER
REF37
7/25/24, JAM
FD MAG/WASHER
11/26/24, TDN

