

O.D.O.T. DISTRICT 2 SURVEY OFFICE (USE ONLY)

PERSONNEL

REFERENCE NO. 13 B

SHEET 1 OF 34

NOTES PRESTON-COLVIN

DATE 11/26/24

ROUTE SR 281

H.C. NEISE

WEATHER WINDY

COUNTY HENRY

R.C. PRESTON-COLVIN

TEMP. 40°

TOWNSHIP MONROE

SECTION 19

DWG BY PRESTON-COLVIN PID PAVING TRAIN

T 4 N R 7 E

TYPE MONUMENT MAG/WASHER

ON SURFACE - ~~BELOW~~ ON

OFFSET CL PAVEMENT 8.4' ~~LT~~ : RT

1.93' TO RT EDGE PAVEMENT

STATION: 324+54

HORIZ.DATUM: NAD83 2011


GEOID: 18

GRID: NORTHING: 592882.933


EASTING: 1526249.468

LDP: NORTHING: 449160.6

EASTING: 161502.6

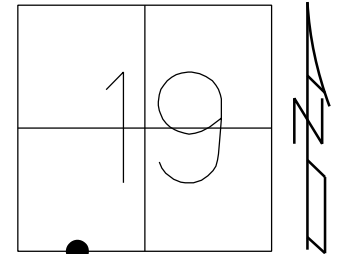

RECORD:
 STA 324+84.4
 1/4-1/4 SEC 19
 FD SM R.R. SPIKE
 1 1/2" DOWN
 8/18/98, MB
 SET P.K./WASHER
 9/28/98, MB
 FD SM.R.R.SPIKE
 5" DOWN
 REFB13
 9/4/18, JFO
 7/25/19, JMR
 FD SM RSPK
 2" DOWN
 REF13B
 7/2/24, TDN
 SET MAG/WASHER
 11/26/24, TDN

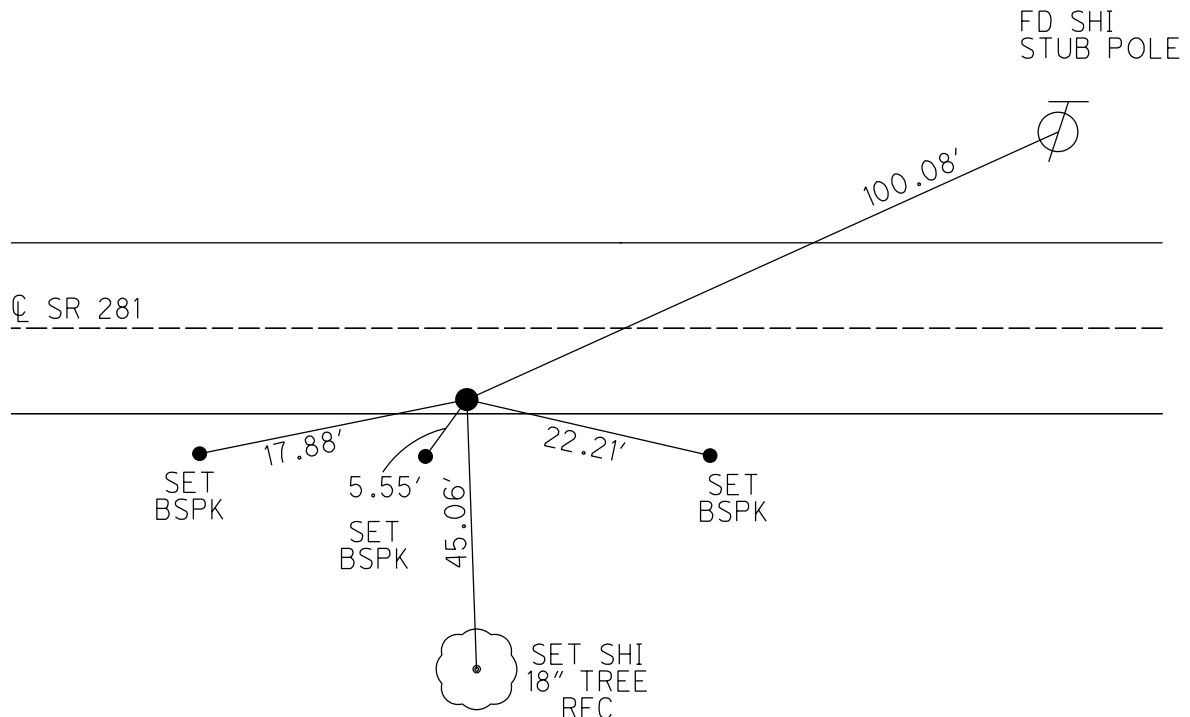

O.D.O.T. DISTRICT 2 SURVEY OFFICE (USE ONLY)

PERSONNEL

REFERENCE NO. 13 B

SHEET 1 OF 34

NOTES MILLER

DATE 9/4/18

ROUTE SR 281

H.C. O'DONNELL

WEATHER SUNNY

COUNTY HENRY

R.C. MILLER

TEMP. 74°

TOWNSHIP MONROE

SECTION 19

DWG BY NIESE PID CHIP_2

T 4 N R 7 E

TYPE MONUMENT SM.R.R. SPIKE

ON SURFACE - ~~BELOW~~ 5"

OFFSET Q PAVEMENT 8.4' ~~LT~~ : RT

1.93' TO RT EDGE PAVEMENT


STATION: 324+54

HORZ.DATUM: NAD83(2011)

GEOID: 2012A

GRID: NORTHING: 592882.933

EASTING: 1526249.468

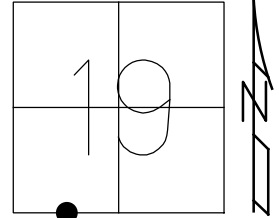

RECORD:

STA 324+84.4

1/4-1/4 SEC 19

FD SM R.R. SPIKE

1 1/2" DOWN

8/18/98, MB

SET P.K./WASHER

9/28/98, MB

FD SM.R.R.SPIKE


5" DOWN

REFB13

9/4/18, JFO

7/25/19, JMR

FD SHI
STUB POLE

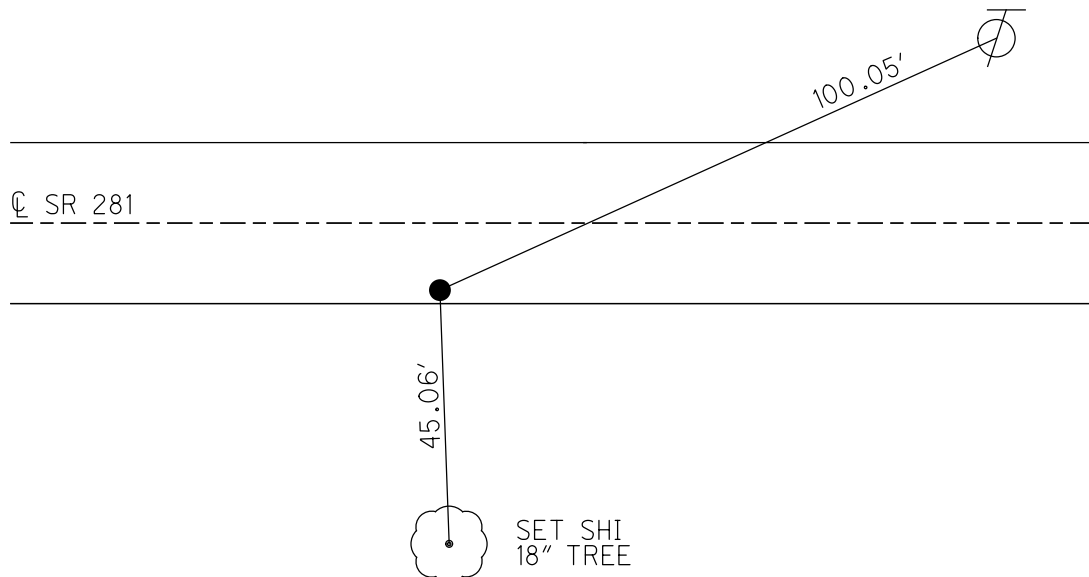

O.D.O.T. DISTRICT 2 SURVEY OFFICE

PERSONNEL

REFERENCE NO. 13-A

SHEET 3 OF 34

NOTES Huss

H.C. Barnhisel

R.C. Rousar

DATE 8.18.98

WEATHER FAIR

TEMP. 82°

ROUTE SR 281

COUNTY HENRY

TOWNSHIP MONROE

SECTION 19

T 4 N R 7 E


TYPE MONUMENT Sm RR' spike

ON SURFACE - BELOW 1 1/2' Below

LEFT- & PAV'T. - RIGHT 8.4 Rt


1.93 TO RT EDGE PAVEMENT

S.L.M. 9+889.03 (SLK); 324+54 (SLM)

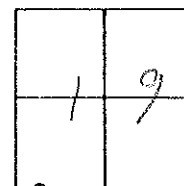

(Reset PK & WASHER
 9-28-98
 MB

RECORD:
 Sta 324+84.4
 1/4 - 1/4 Sec 19

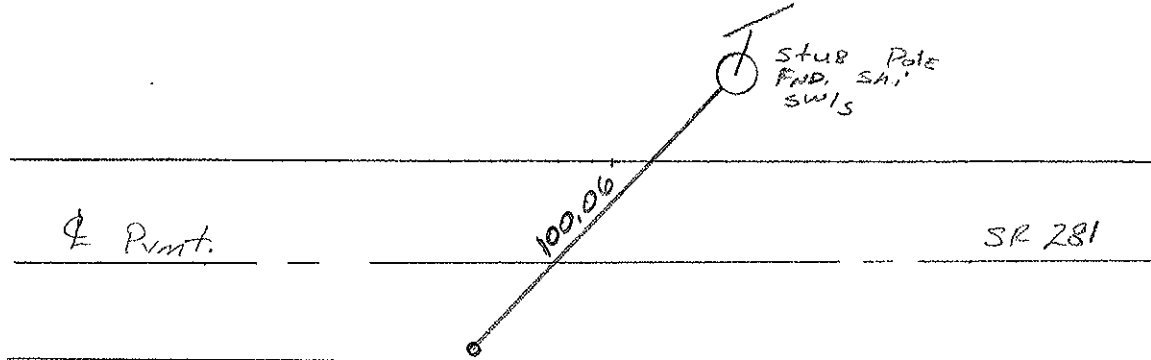

DRAWN BY JK

O.D.O.T. DISTRICT 2 SURVEY OFFICE

PERSONNEL

REFERENCE NO. 13-A

SHEET 3 OF

NOTES SACKMAN

H.C. BARNHISEL

R.C. LOEWRE

DATE 8-12-87

WEATHER Clear

TEMP. + 75

ROUTE SR 281

COUNTY HENRY

TOWNSHIP MONROE

SECTION 19

T4 N R 7 E

TYPE MONUMENT P.K. Nail

~~ON SURFACE~~ - BELOW 1 1/2"

~~LEFT- & PAV'T.~~ - RIGHT 8.6


1.3 TO RT EDGE PAVEMENT

S.L.M. 324 + 54


Set small RR spike

8-20-87

SKM

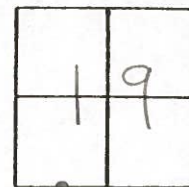

Record:
Sta 324+84.4
1/4-1/4 Sec 19

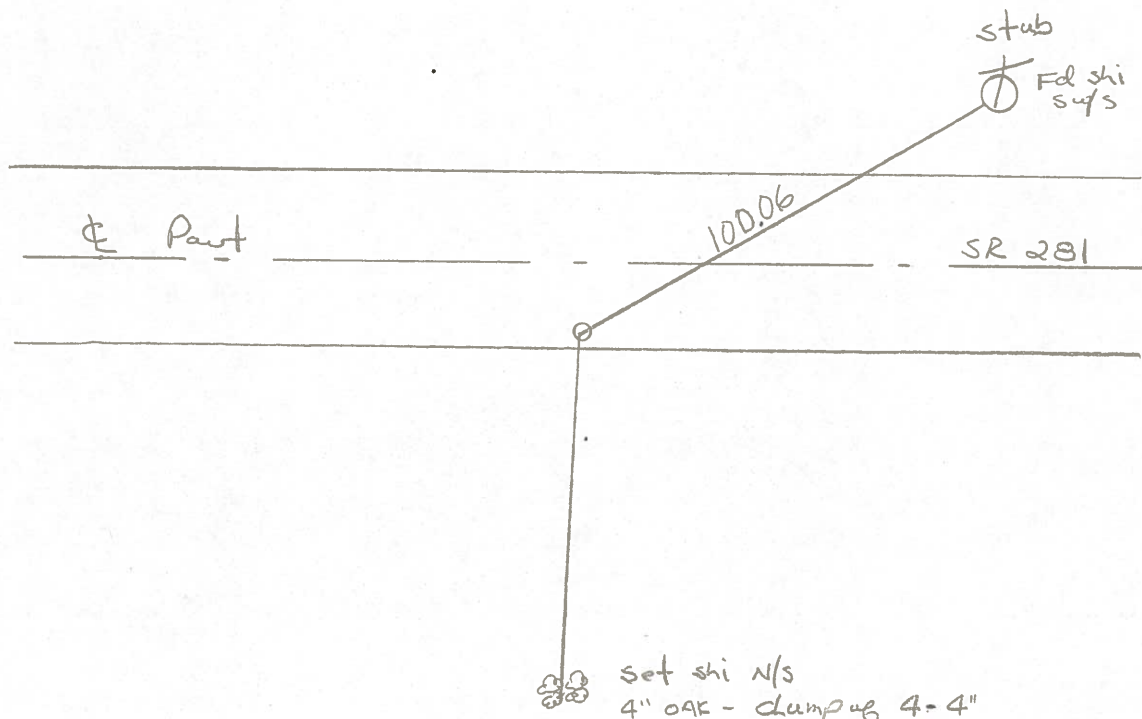


PERSONNEL	TITLE	PERSONNEL	TITLE
Tomsic			
Neuser			
Vanyo			
Granata			

COUNTY HENRY DATE Nov. 12, 1974

S. R. 281 WEATHER _____

SEC. MONROE TWP. TEMP. _____

DESCRIPTION _____ LEFT _____ CENTER LINE _____ RIGHT _____ JOB NO. _____

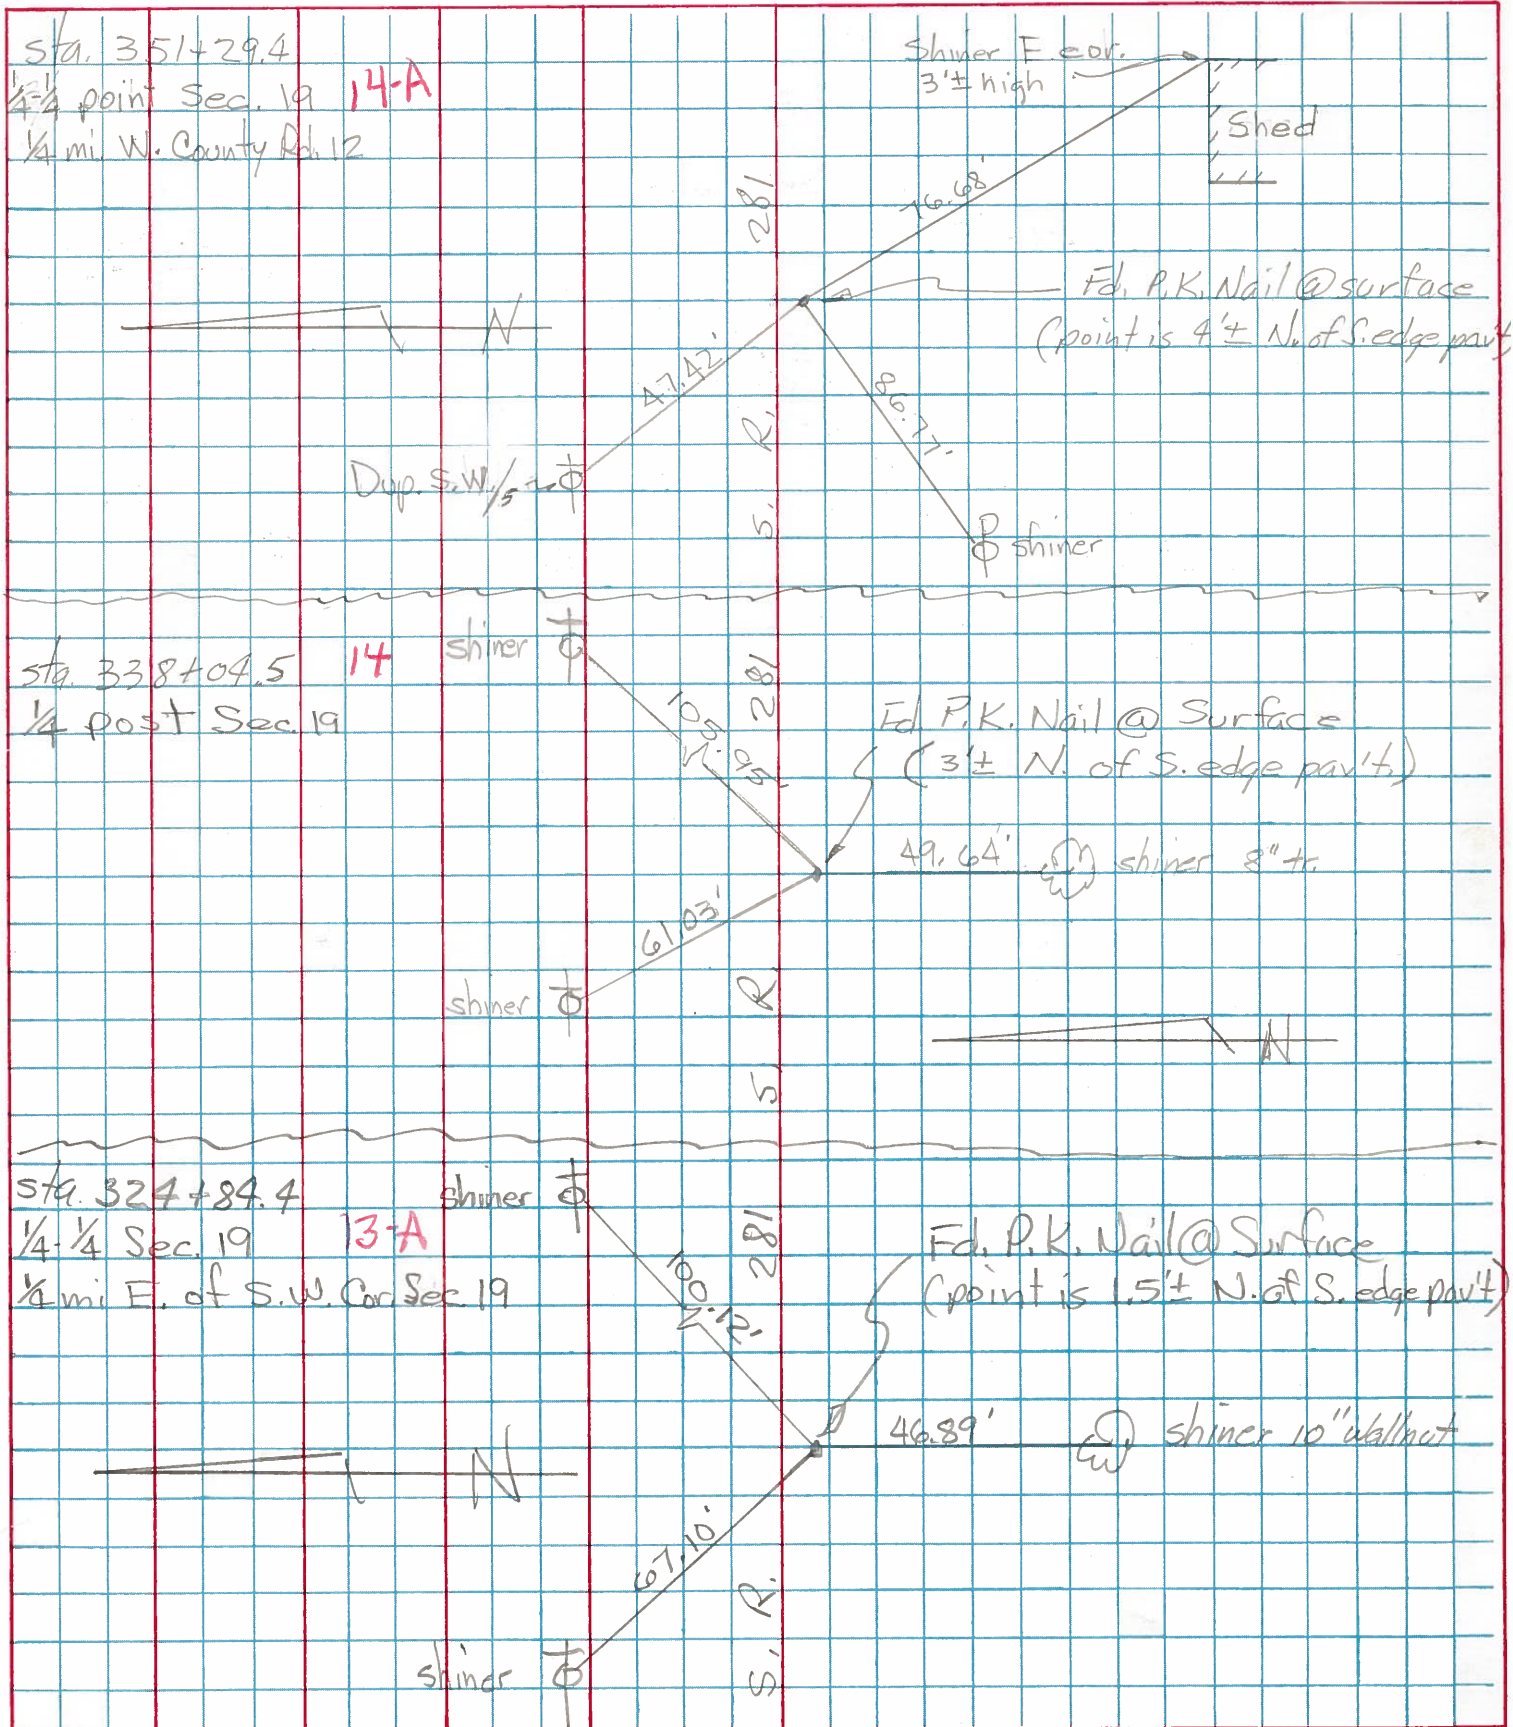

PERSONNEL

TITLE

PERSONNEL

TITLE

COUNTY Henry

DATE 11-29-57

S. R. #281

WEATHER

SEC. "J"

TEMP.

DESCRIPTION

LEFT

CENTER LINE

RIGHT

JOB NO.

#	DESCRIPTION	LEFT	CENTER LINE	RIGHT
#14	Sec. Cor. Sec. #19 Stone (Iron Bolt) R.R. Spk. Monroe Twp. (13)			28.0' S.E. To chiseled ⓧ on Hdwl. 74.59' S. To R.R. Spk. in E. side P.P. 57.19' N.W. To chiseled ⓧ on Hdwl. 39.52' Shi. in T. Pole N.
#15	Sec. Cor. Sec. #19 Stone (Iron Bolt) R.R. Spk. Flatrock Twp. (13)			33.80' S.E. To chiseled ⓧ on Hdwl. 81.26' S. To R.R. Spk. in E. side. P. Pole 53.27' N.W. To chiseled ⓧ on Hdwl. 32.80' Shi. in T. Pole N
#16	1/4-1/4 Cor. R.R. Spk. Bords E. S.W. Cor. Sec. 19 (13-A)			99.93' N.E. To valve in T. Pole 67.05' N.W. To 60° spk. T. Pole 47.07' S. To Shi. 8" Walnut
#17	1/4 Cor. Stone (Iron Bolt) (R.R. Spk.) (14)			58.15' 58.50' S.E. To 60° spk. in W. side 105.95' N.E. To Shi. in T. Pole 10" Apple 41.60' S. To 1" Gas Pipe 50.00' N. To 1" Gas Pipe 61.06' N.W. To 60° spk. in T. Pole
#18	1/4-1/4 Cor. Stone (R.R. Spk.) Bords. W. S.E. Cor. (14-A)			76.95' 77.00' S.E. To N.E. Cor. Conc. 73.80' Corn Crib. Foundation 73.95' S. To N.W. Cor. Conc. Corn Crib. Foundation 47.45' 47.53' N.W. To 60° spk. W. side T. Pole 86.81' S.W. To Shi. P. Pole
#19	S.E. Cor. Sec 19 R.R. Spk. (15)	80.14' 42.57' S.E. Shi. T.P. 46.02' S.W. Shi. P.P. 45.98'		80.38' S.W. To 60° spk. in N. Side 20" a 71.44' S.W. To " " " S.E. " 12" Plu. 48.47' N.E. To " " " S.E. " 10" Elm 39.97' Shi. in T.P. N.E. 42.24' clum 48.80' + N.W. Twp 60" conc. Ribs
#20	1/4 1/4 Cor. Stone Did not find any Trace of iron bolt 4' P. 11 (15-A)			96.50' N.E. To 60° spk. in Tel. Pole 73.50' N.E. To spk. in 12" Pear 60.50' N.W. To 60° spk. in Tel. Pole 82.52' S.E. Shi. in T. Pole