

O.D.O.T. DISTRICT 2 SURVEY OFFICE (USE ONLY)

PERSONNEL

REFERENCE NO. 18 A

SHEET 10 OF 34

NOTES PRESTON-COLVIN

DATE 11/26/24

ROUTE SR 281

H.C. NEISE

WEATHER WINDY

COUNTY HENRY

R.C. PRESTON-COLVIN

TEMP. 40°

TOWNSHIP MONROE

SECTION 21

DWG BY PRESTON-COLVIN

PID PAVING TRAIN

T 4 N R 7 E

TYPE MONUMENT PK/WASHER

ON SURFACE - ~~BELOW~~ ON

OFFSET CL PAVEMENT 5.0' ~~LT~~ : RT

5.4' TO RT EDGE PAVEMENT

STATION: 456+88

HORIZ.DATUM: NAD83 2011


GEOID: 18

GRID: NORTHING: 592702.295

EASTING: 1539478.421

LDP: NORTHING: 449222.7

EASTING: 174733.6

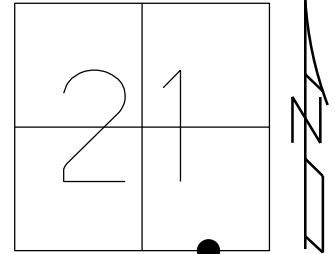

RECORD:
 STA 457+16.4
 1/4-1/4 POINT SEC 21
 FD SM.R.R.SPIKE
 8/18/98, MB
 SET P.K./WASHER
 9/28/98, MB
 FD P.K./WASHER
 REFA18
 9/4/18, JFO
 7/25/19, JMR
 FD PK/WASHER
 REF 18A
 7/22/24, TDN
 FD PK/WASHER
 11/26/24, TDN

CL SR 281

SET
SHI



10.74'

O.D.O.T. DISTRICT 2 SURVEY OFFICE (USE ONLY)

PERSONNEL

REFERENCE NO. 18 A

SHEET 10 OF 34

NOTES HUSS

DATE 8/18/98

ROUTE SR 281

H.C. BARNHISEL

WEATHER FAIR

COUNTY HENRY

R.C. ROUSOS

TEMP. 82°

TOWNSHIP MONROE

SECTION 21

DWG BY NIESE

PID CHIP_2

T 4 N R 7 E

TYPE MONUMENT SM.R.R.SPIKE

ON SURFACE - ~~BELOW~~ ON

OFFSET 5.0' LT : RT

5.4' TO RT EDGE PAVEMENT


STATION: 456+88

HORZ.DATUM: NAD83(2011)

GEOID: 2012A

GRID: NORTHING: 592702.295

EASTING: 1539478.421

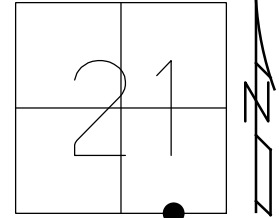

RECORD:

STA 457+16.4

1/4 - 1/4 POINT SEC 21

FD SM.R.R.SPIKE

8/18/98, MB

SET P.K./WASHER


9/28/98, MB

FD P.K./WASHER

REFA18

9/4/18, JFO

7/25/19, JMR

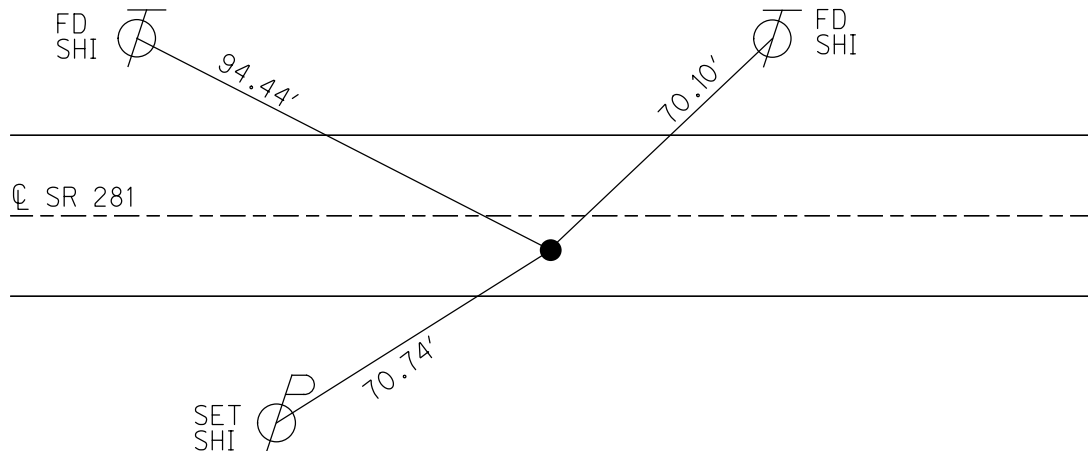

O.D.O.T. DISTRICT 2 SURVEY OFFICE

PERSONNEL

REFERENCE NO. 18-A

SHEET 12 OF 34

NOTES Huss

H.C. Barnhisel

R.C. Rouss

DATE 8-18-98

WEATHER Fair

TEMP. +82°F

ROUTE SR 281

COUNTY Henry

TOWNSHIP Monroe

SECTION 21

T 4 N R 7 E


TYPE MONUMENT Small RR spike

ON SURFACE - BELOW SURFACE

LEFT-CL PAV'T. - RIGHT 5.0' R+


5.4' TO R+ EDGE PAVEMENT

S.L.M. 13+935.98 SLK (Sta. 456+88 SLK)

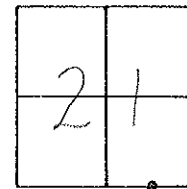

RECORD:
Sta. 457+16.4
Y4-Y4 Point Sec 21

RESET PK MASHER
9-28-98
MB

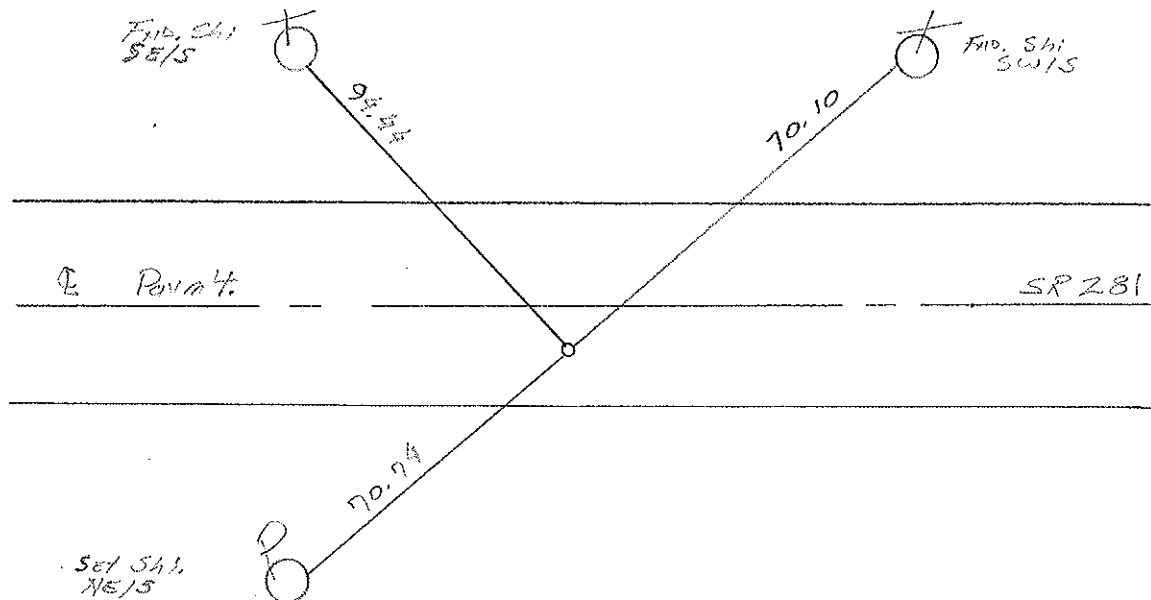

DRAWN BY TL

O.D.O.T. DISTRICT 2 SURVEY OFFICE

PERSONNEL

REFERENCE NO. 18-A

SHEET 12 OF

NOTES Sockman

H.C. BARNHISEL

R.C. LOEHRKE

DATE 8-12-87

WEATHER CLEAR

TEMP. +82

ROUTE SR 281

COUNTY HENRY

TOWNSHIP MONROE

SECTION 21

T. 4 N. R. 7 E.

TYPE MONUMENT P.K. Nail


~~ON SURFACE~~ - BELOW 1 1/2"

~~LEFT - & PAV'T.~~ - RIGHT 5.0

5.0 TO RT EDGE PAVEMENT

S.L.M. 456+88


Set Sm. RR
Spike
9-2-87

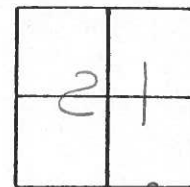

Record:

Sta. 457+16.4

1/4 - 1/4 Point Sec. 21

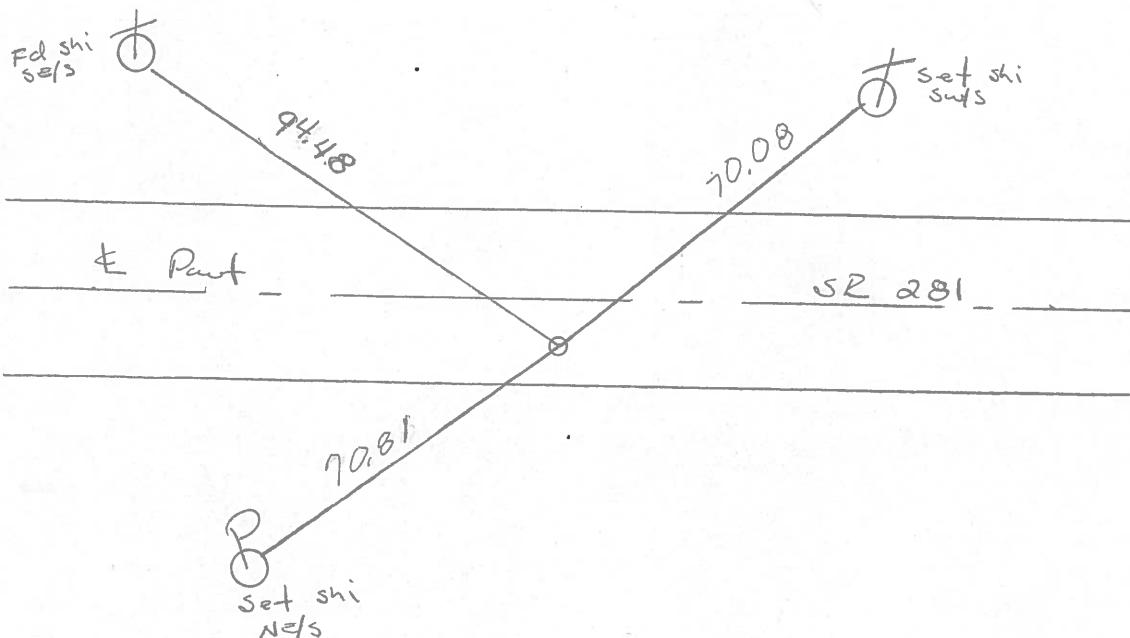

PERSONNEL

TITLE

PERSONNEL

TITLE

COUNTY HENRY

DATE Nov. 19, 1974

Tomsic

Neuser

Vanyo

Caranata

S. R. 281

WEATHER

SEC.

TEMP.

DESCRIPTION

LEFT

CENTER LINE

RIGHT

JOB NO.

Sta. 483+68.7 19-A

1/4-1/2 Sec. 22

1/4 mi. E. TWP. Rd. #10

4" Cut in face metal fence Post

Tele. Relay Sta.

Shiner Wood fence post.



281

68.45'

103.18'

36.9' Dup W 1/2

Fd. P.K. Nail @ S. f
(point is 4' ± S. & pav't)

Sta. 470+44.45

Dup. S.E. 1/4

Sec. Cor's 21, 22, 27 & 28


Township

Fd. P.K. Nail @ Surface

(point is 5.5' ± S. & 5.5' ± E. inter)

(Sec. 22)
(Sec. 21)

Rd. #10

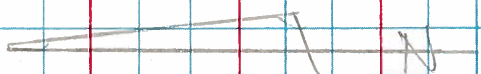(Sec. 27)
(Sec. 28)

40.76'

62.01'

281

S. R.

S. R.

Dup. S.W. 1/4

Dup. S.E. 1/4

Sta. 457+16.4

18-A

Shiner

1/4-1/2 point Sec. 21

1/4 mi. W. TWP. Rd. #10

Fd. P.K. Nail @ surface
(point is middle E.B.L.)

40.49'

Shiner Anchor Post



70.0'

94.57'

281

S. R.

S. R.

Shiner

PERSONNEL

TITLE

PERSONNEL

TITLE

COUNTY

Henry

DATE

11-29-57

S. R.

#281

WEATHER

10-24-60

SEC.

"J"

TEMP.

DESCRIPTION

LEFT

CENTER LINE

RIGHT

JOB NO.

#21

1/4 COR. Stone
R.R. SpK

(16)

39.46 S. Steel Anchor Post

67.46' N.E. To S.W. side T. Pole

45.0' N. To S. side 1" Gas Pipe

45.0' S. To N. " 1" " "

54.35' N.W. To 60' spk. in S.E. side Shi.

53.43' 24" Ash 30"

39.46 S. To iron A. Post

54.60' 53.28' N.E. To 60' spk intel. P.

71.40' 91' N. To 60' spk. in 16" Eln

44.90' 46.8' S. To 1" Gas pipe

59.20' S. To Witness stone

50.58' S.W. Shi. P. Pole

52

#23

Sec. COR. Stone
S.E. COR. Sec. 20
R.R. SpK.

(17)

(gone)

84.50' S.W. To 60' spk. in P. Pole

53.05' 66.75' N.W. To 60' " " T. Pole

84.50' S.E. To 60' in 12" Cotton wood

42.66' S.E. T8" E. end 54" conc. pipe } Plum

49.67' S.W. To "X" W. end 54" " " }

#24

1/4 COR. Stone
R.R. SpK.

(18)

Plum
Plum

27.44' S.E. To chiseled "X" on Hdwr

27.14' S. To chiseled "X" N.W. COR. C.

28.82' N. To chiseled "X" S.W. COR. C.

#25

1/4-1/4 COR.
R.R. SpK.

(18-A)

40.70' 40.78' S. To spk in COR. Post

67.62' S.W. To spk in Power Pole

70.30' N.E. To spk in Tel. Pole

94.73' 70' N.W. To spk in Tel. Pole

#26

Sec. COR. Sec. 21
R.R. SpK.

(19)

Plum

40.79' N.E. To Headless spk. E. side Tel. Pole

26.50' S.W. To X on N.E. COR.

Culvert.

34.80' 35.30' N.W. To X on S.E. COR.

Culvert.

31.45' S.W. To "X" on N.W. COR. Culvert.