


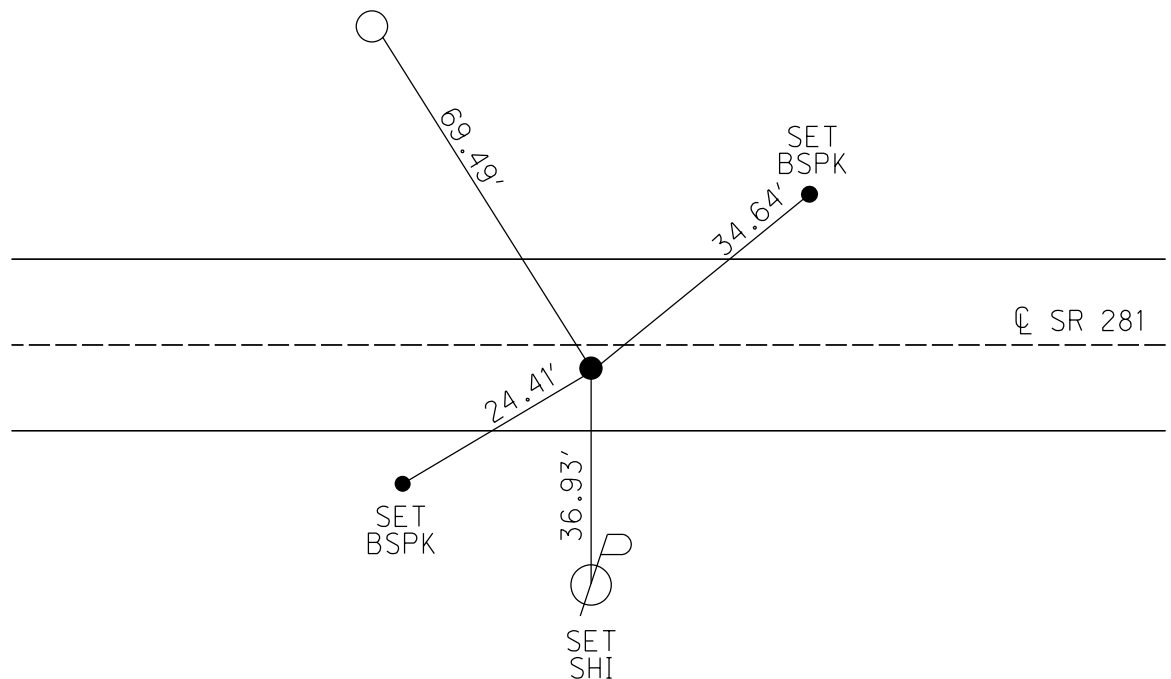

O.D.O.T. DISTRICT 2 SURVEY OFFICE (USE ONLY)

PERSONNEL

REFERENCE NO. 19 A

SHEET 12 OF 34

NOTES RHOADES

DATE 9/6/18

ROUTE SR 281

H.C. O'DONNELL

WEATHER FAIR

COUNTY HENRY

R.C. RHOADES

TEMP. 70°

TOWNSHIP MONROE

SECTION 22

DWG BY NIESE PID CHIP_2

T 4 N R 7 E

TYPE MONUMENT P.K.NAIL

ON SURFACE - ~~BELOW~~ ON

OFFSET CL PAVEMENT 4.3' ~~LT~~ : RT

6.4' TO RT EDGE PAVEMENT


STATION: 483+42

HORIZ.DATUM: NAD83(2011)

GEOID: 2012A

GRID: NORTHING: 592670.827

EASTING: 1542131.201

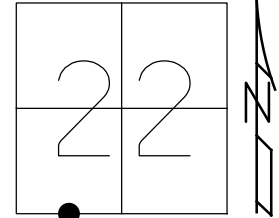

RECORD:

STA 483+68.7

1/4-1/4 SEC 22

FD SM.R.R.SPIKE

8/18/98, MB

SET P.K./WASHER

9/28/98, MRC


FD P.K.NAIL

REFA19

9/6/18, JFO

7/25/19, JMR

FD "+" CUT
2 1/2" UP
FEN POST
LEANING WEST

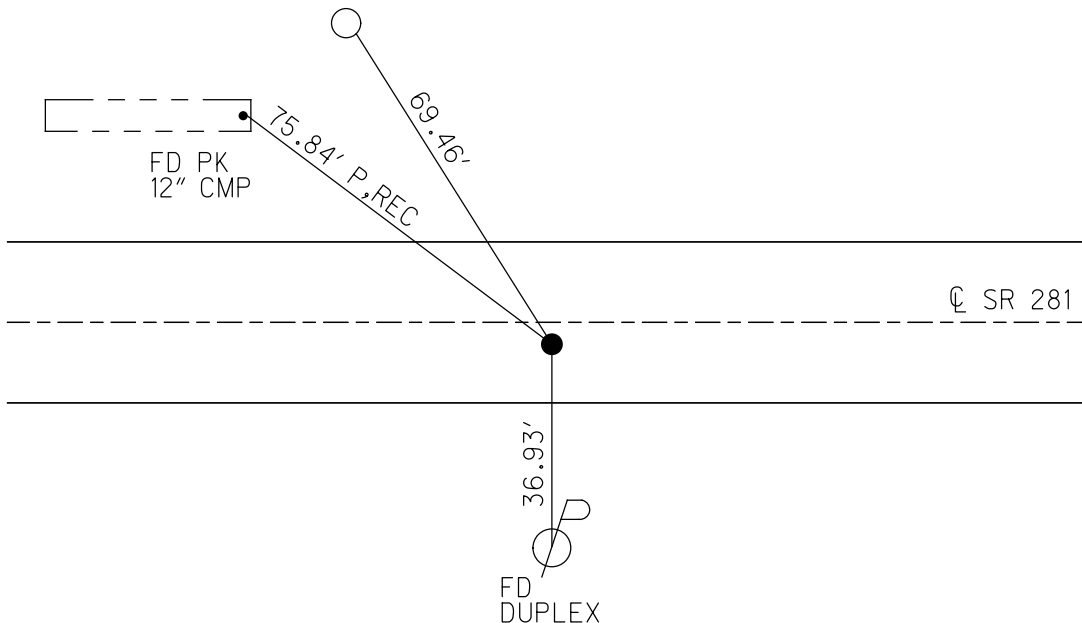

O.D.O.T. DISTRICT 2 SURVEY OFFICE

PERSONNEL

REFERENCE NO. 19-A

SHEET 14 OF 34

NOTES

H.C. Barnhisel

R.C. Rousos

DATE 8-18-98

WEATHER Fair

TEMP. +82°F

ROUTE SR 281

COUNTY Henry

TOWNSHIP Monroe

SECTION 22

T 4 N R 7 E


TYPE MONUMENT Small RR Spike

ON SURFACE - ~~BELOW~~ Surface

~~LEFT~~ - CL PAV'T. - RIGHT 4.3'


6.4' TO RT EDGE PAVEMENT

S.L.M. 14+744.82 slk (483+42 slm)

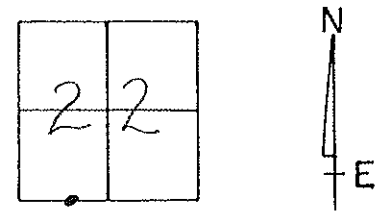

RECORD:
Sta. 483+68.7
1/4-1/4 Sec 22

(RESET PK & WASHER)
9-29-98
MRC

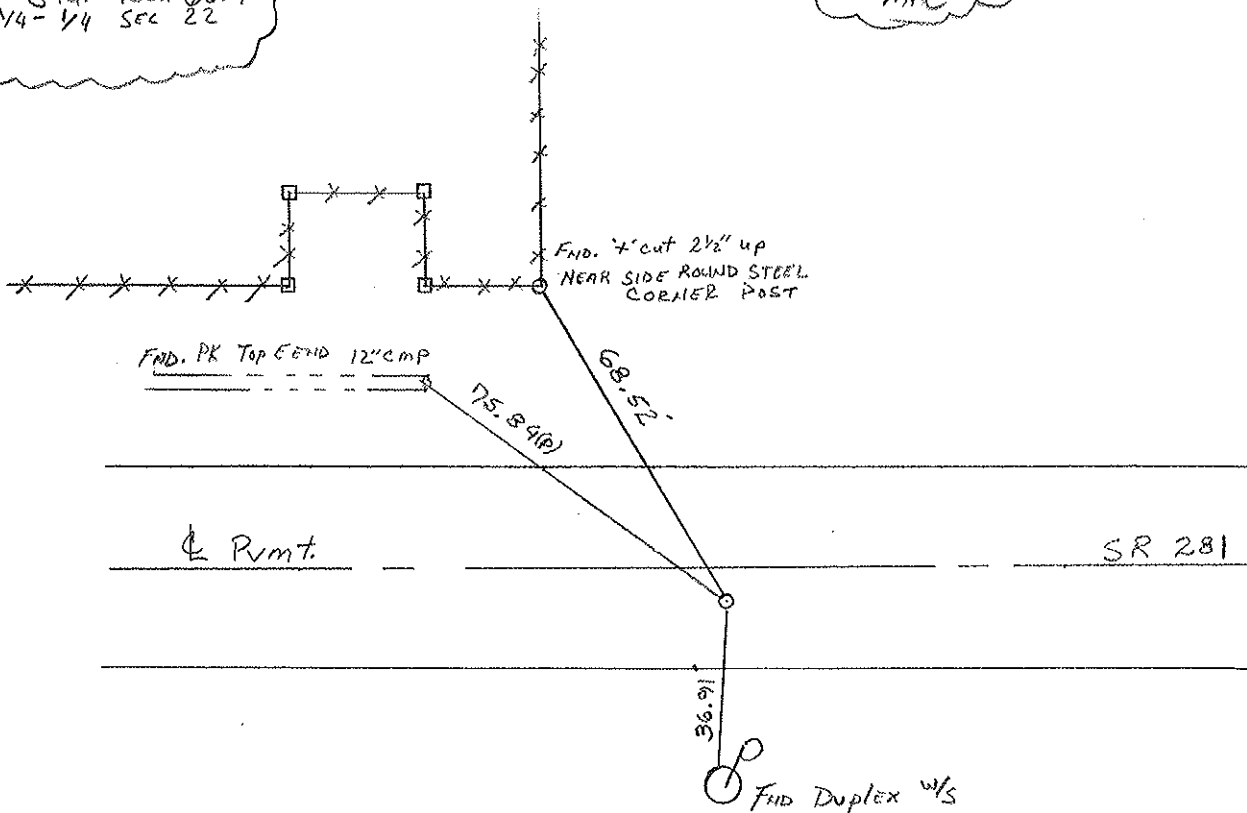

DRAWN By TR

O.D.O.T. DISTRICT 2 SURVEY OFFICE

PERSONNEL

REFERENCE NO. 19-A

SHEET 14 OF

NOTES See kman

H.C. BARNHISEL

DATE 8-12-87

ROUTE SR 281

R.C. LOEHKE

WEATHER CLEAR

COUNTY HENRY

TEMP. +82

TOWNSHIP MONROE

SECTION 22

T4 NR 7 E

TYPE MONUMENT P.K. Nail


ON SURFACE - BELOW 1 1/2"

LEFT - CL PAV'T. - RIGHT 3.9'


5.7 TO RT EDGE PAVEMENT

S.L.M. 483 + 42

Set Sm RR
Spike
92-87

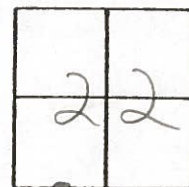

Record:
Sta. 483+68.7
1/4-1/4 Sec 22

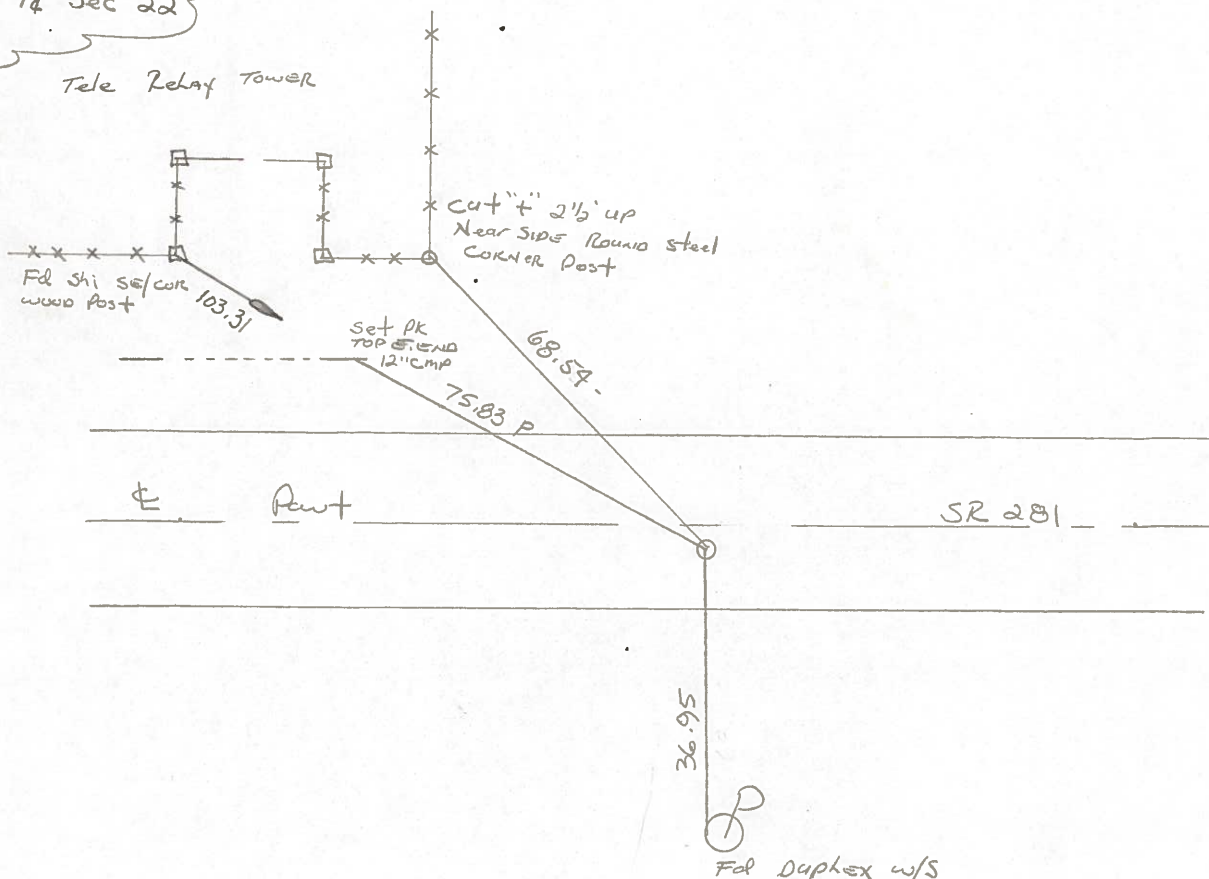

PERSONNEL TITLE PERSONNEL TITLE

COUNTY Henry

DATE 11-29-57

11-3-60

S. R. 281

WEATHER

SEC. "J"

TEMP.

DESCRIPTION

LEFT

CENTER LINE

RIGHT

JOB NO.

#27 1/4-1/4 COR.
Iron bolt
R.R. spk.

(19-A)

gone 52.00' N.E. spk. in 3rd F.P. E. of
COR. Post
gone 54.63' N. To spk in 1st F.P. N. of
COR. Post
39.55' S. To spk. in COR. Post
35.07' S. Shi. Pole
68.48' N.W. Steel Post (Bent)

#28 1/4 COR. stone
R.R. spk.

(20)

91.00' N.E. To spk. in Tel. Pole
71.04' N.W. To spk. in Tel. Pole
45.00' N. To 1" Gas Pipe
Plum 28.08 N.E. To S.W. COR. C.B. curb.

#29 1/4-1/4 COR.
R.R. spk.

(20-A)

33.72' S.E. To ⊗ on ctr. wing wall
34.24' S.S.W. To ⊗ on step of Abut.
41.85' N.E. To Shi. Tel. Pole
38.50' S.W. To W. end Abut.
102.65' E.S.E. To N.W. COR. Abut. wall

#30 Intersection S.R. #109 & 281
Boat spk.
S.E. COR. Sec. 22
R.R. spk.

(22)

41.78' N.E. To ⊗ on S. side Hdwl.
44.77' S.E. To ⊗ on N. side Hdwl.
63.30' N.W. To spk. in Tel. Pole
42.69' S.W. To spk. in Power Pole

#31 1/4 stone E