

O.D.O.T. DISTRICT 2 SURVEY OFFICE (USE ONLY)

PERSONNEL

REFERENCE NO. 25

SHEET 20 OF 34

NOTES PRESTON-COLVIN

DATE 11/26/24

ROUTE SR 281

H.C. NEISE

WEATHER WINDY

COUNTY HENRY

R.C. PRESTON-COLVIN

TEMP. 40°

TOWNSHIP RICHFIELD

SECTION 19

DWG BY PRESTON-COLVIN

PID PAVING TRAIN

T 4 N R 8 E

TYPE MONUMENT SM RR SPIKE

ON SURFACE - ~~BELOW~~ 3"

OFFSET $\angle$ PAVEMENT 3.9' ~~LT~~ : RT

- TO - EDGE PAVEMENT 11.7' W $\angle$ CR 7 S

STATION: 628+82

HORIZ.DATUM: NAD83 2011


GEOID: 18

GRID: NORTHING: 592526.089


EASTING: 1556668.797

LDP: NORTHING: 449361.9

EASTING: 191925.8

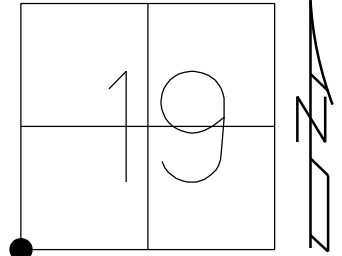

RECORD:
FD SM.R.R.SPIKE
8/18/98, MC
SET P.K./WASHER
10/1/98, MRC
FD SM.R.R.SPIKE
3" DOWN
REF25
9/6/18, JFO
7/25/19,
1/11/23, JMR
FD SM RRS
3" DOWN DAMAGED
7/24/24, TDN
FD SM RRS
3" DOWN
11/26/24, TDN

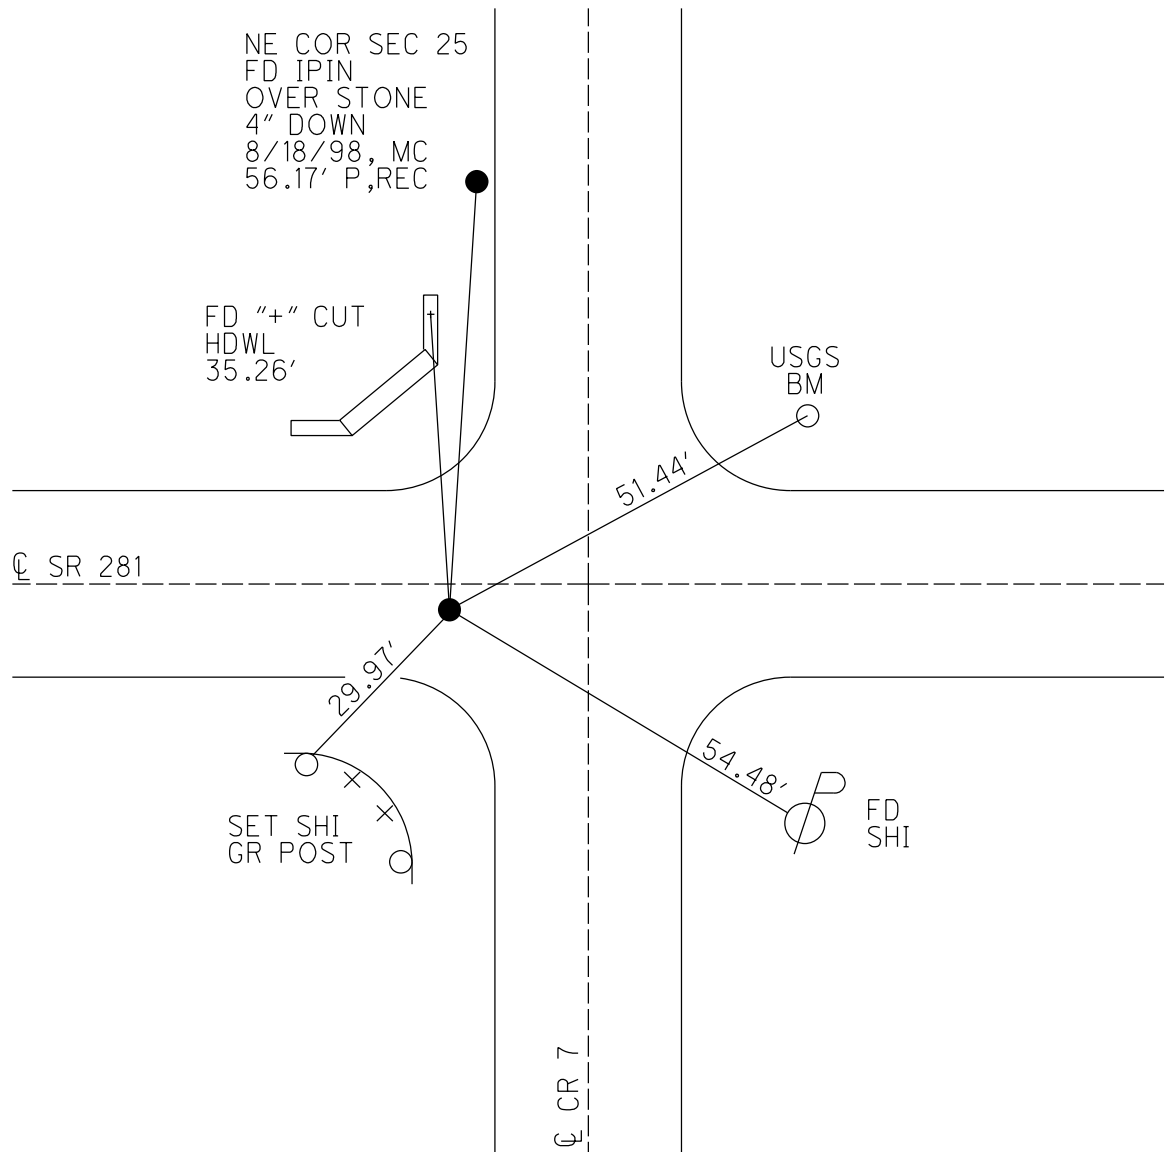

O.D.O.T. DISTRICT 2 SURVEY OFFICE (USE ONLY)

PERSONNEL

REFERENCE NO. 25

SHEET 20 OF 34

NOTES RHOADES

DATE 9/6/18

ROUTE SR 281

H.C. O'DONNELL

WEATHER CLOUDY

COUNTY HENRY

R.C. RHOADES

TEMP. 76°

TOWNSHIP RICHFIELD

DWG BY NIESE

PID PAVETRAIN

SECTION 19

T 4 N R 8 E

TYPE MONUMENT SM.R.R.SPIKE

~~ON SURFACE~~ - BELOW 3"

OFFSET CL PAVEMENT 3.9' ~~LT~~ : RT

- TO - EDGE PAVEMENT 11.7' W CL CR 7 S



STATION: 628+82

HORIZ.DATUM: NAD83(2011)

GEOID: 2012A

GRID: NORTHING: 592526.089

EASTING: 1556668.797

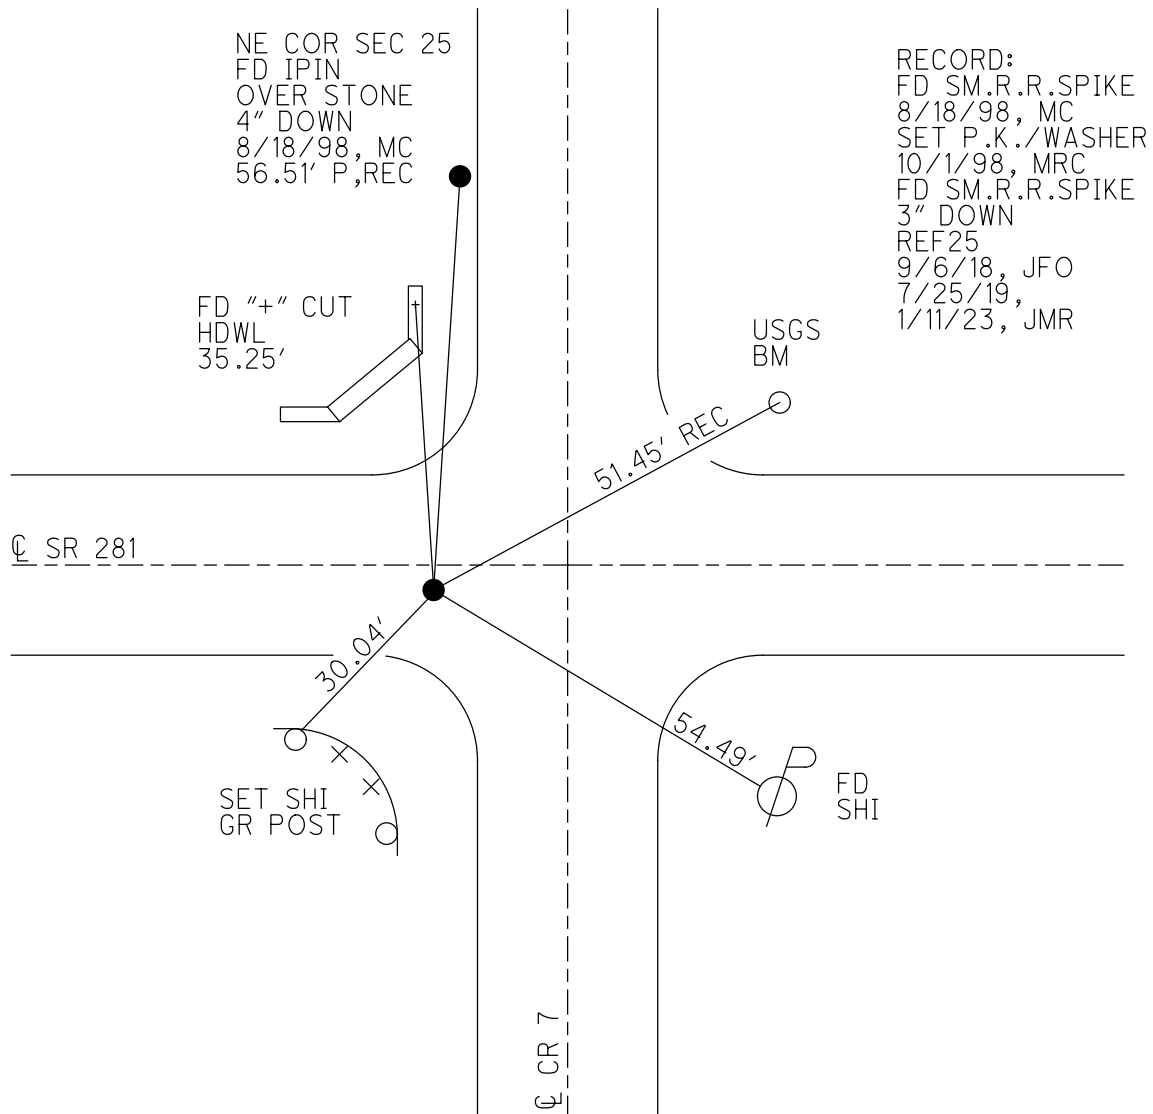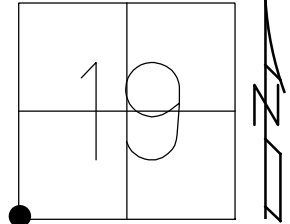

O.D.O.T. DISTRICT 2 SURVEY OFFICE (USE ONLY)

PERSONNEL

REFERENCE NO. 25

SHEET 20 OF 34

NOTES RHOADES

DATE 9/6/18

ROUTE SR 281

H.C. O'DONNELL

WEATHER CLOUDY

COUNTY HENRY

R.C. RHOADES

TEMP. 76°

TOWNSHIP RICHFIELD

DWG BY NIESE PID CHIP_2

SECTION 19

T 4 N R 8 E

TYPE MONUMENT SM.R.R.SPIKE

~~ON SURFACE~~ - BELOW 3"

OFFSET CL PAVEMENT 3.9' ~~LT~~ : RT

- TO - EDGE PAVEMENT 11.7' W CL CR 7 S



STATION: 628+82

HORIZ.DATUM: NAD83(2011)

GEOID: 2012A

GRID: NORTHING: 592526.089

EASTING: 1556668.797

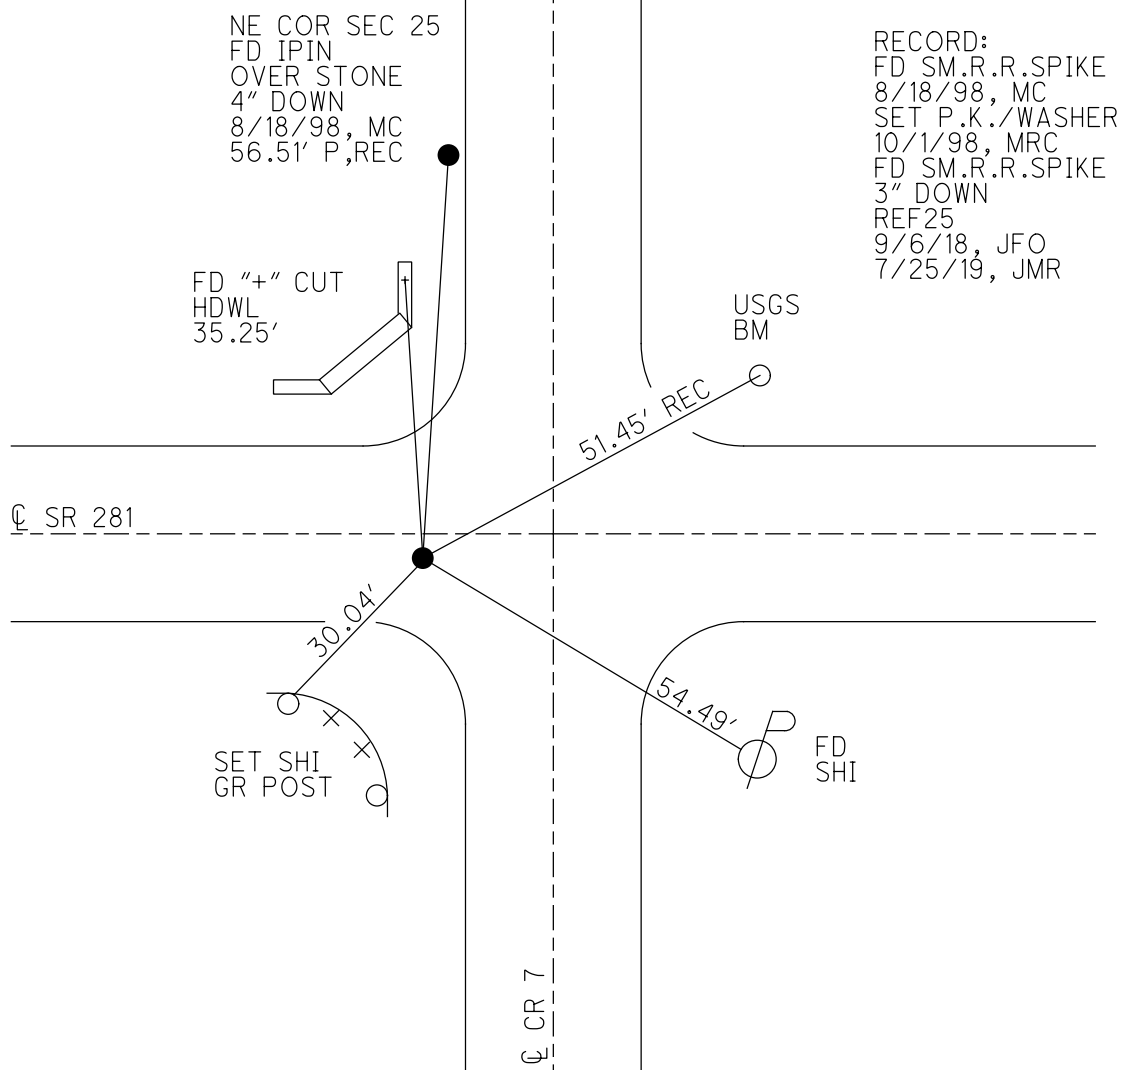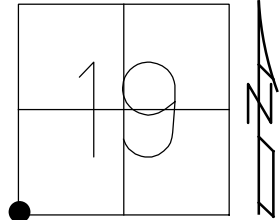

O.D.O.T. DISTRICT 2 SURVEY OFFICE

PERSONNEL

REFERENCE NO. 25

SHEET 21 OF 34

NOTES Canterbury

H.C. Rousos

R.C. Nutter

DATE 8-18-98

WEATHER Fair

TEMP. +84°F

ROUTE SR 281

COUNTY HENRY

TOWNSHIP Monroe/Richfield

SECTION

T4 N R 2 E

MONROE	Richfield
24	19
25	30
MONROE	Richfield




TYPE MONUMENT Small RR spk

ON SURFACE - BELOW SURFACE

~~LEFT~~ & PAV'T. - RIGHT 3.9 RT

TO EDGE PAVEMENT 11.7' w of & Pmnt. Co. Rd. 7 south

S.L.M. 19+164.25 GLM (Sta 628+82.36m)

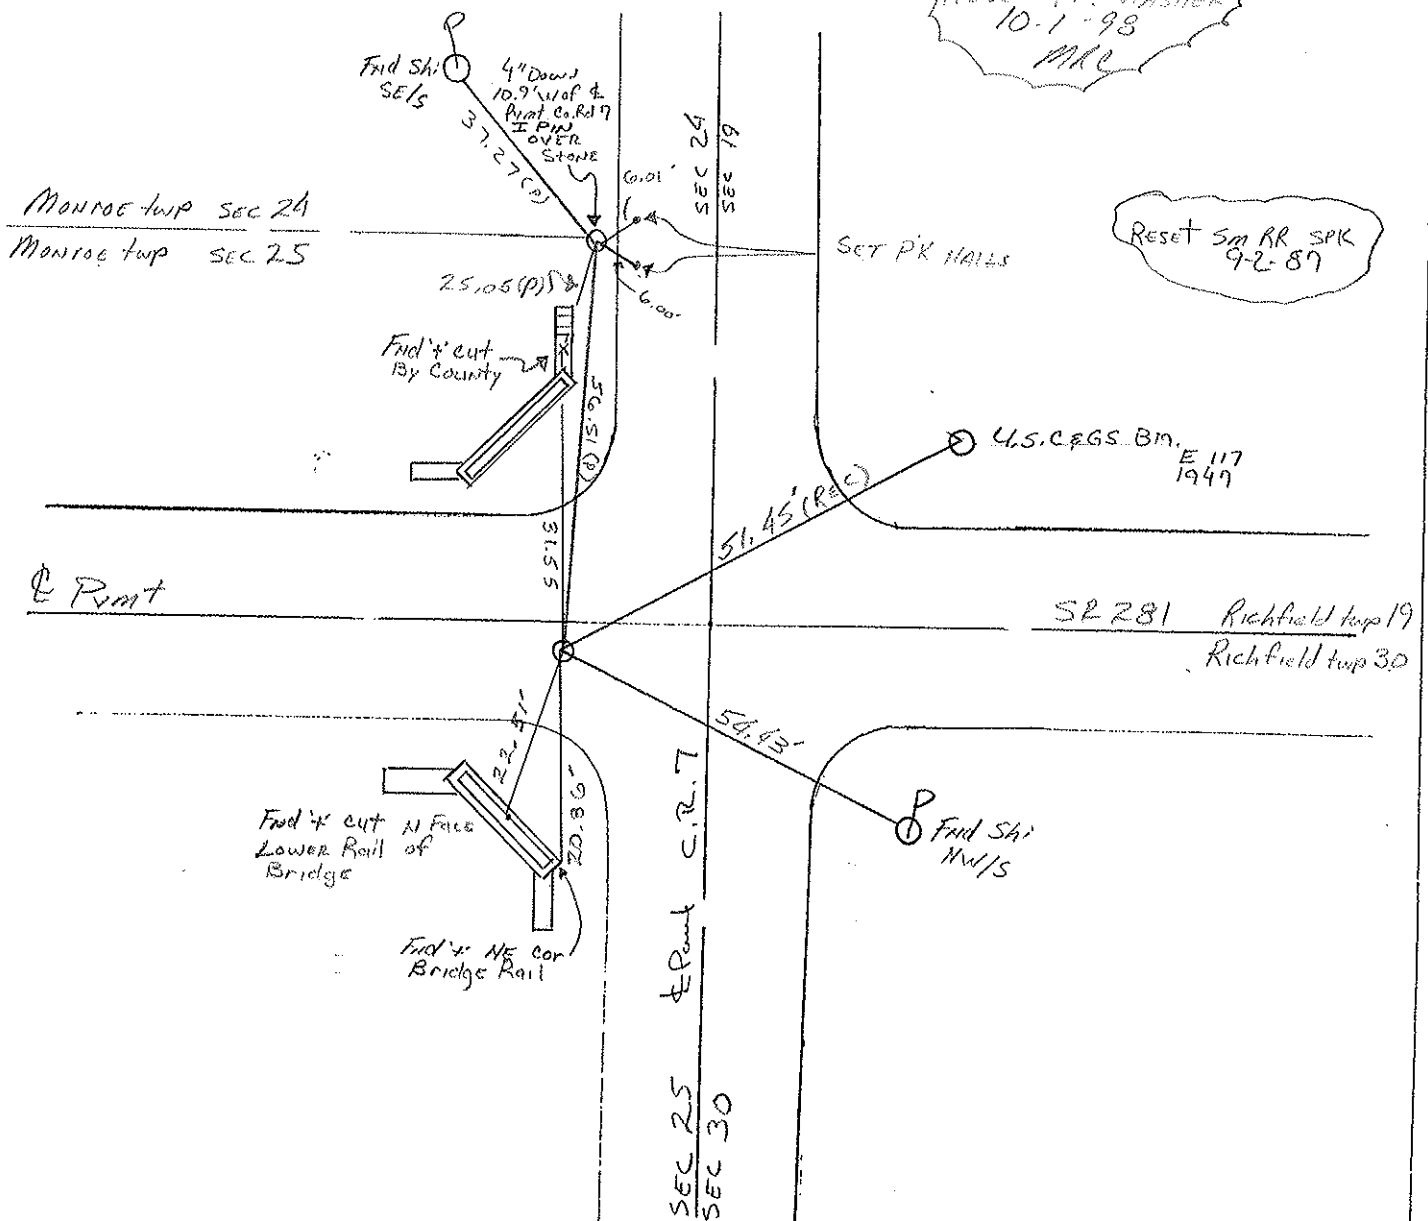

DRAWN BY JR

O.D.O.T. DISTRICT 2 SURVEY OFFICE

PERSONNEL

REFERENCE NO. 25

SHEET 21 OF

NOTES SOCK MAN

H.C. BARNHISEL

R.C. LOEHKE

DATE 8-13-87

WEATHER HAZY

TEMP. +73

ROUTE SR 281

COUNTY HENRY

TOWNSHIP MONROE

SECTION RICHFIELD

T4 N R 7 E

Reset Sm. RR Spikes
9-2-87

TYPE MONUMENT SMALL RR SPIKE / I. PIN OVER STONE

ON SURFACE - BELOW YES

LEFT- & PAV'T. - RIGHT 4.0


TO EDGE PAVEMENT 11.7' West of E. Point Co. Rd "7" South


S.L.M. 628+82

24	19
25	30



MONROE TWP RICHFIELD TWP

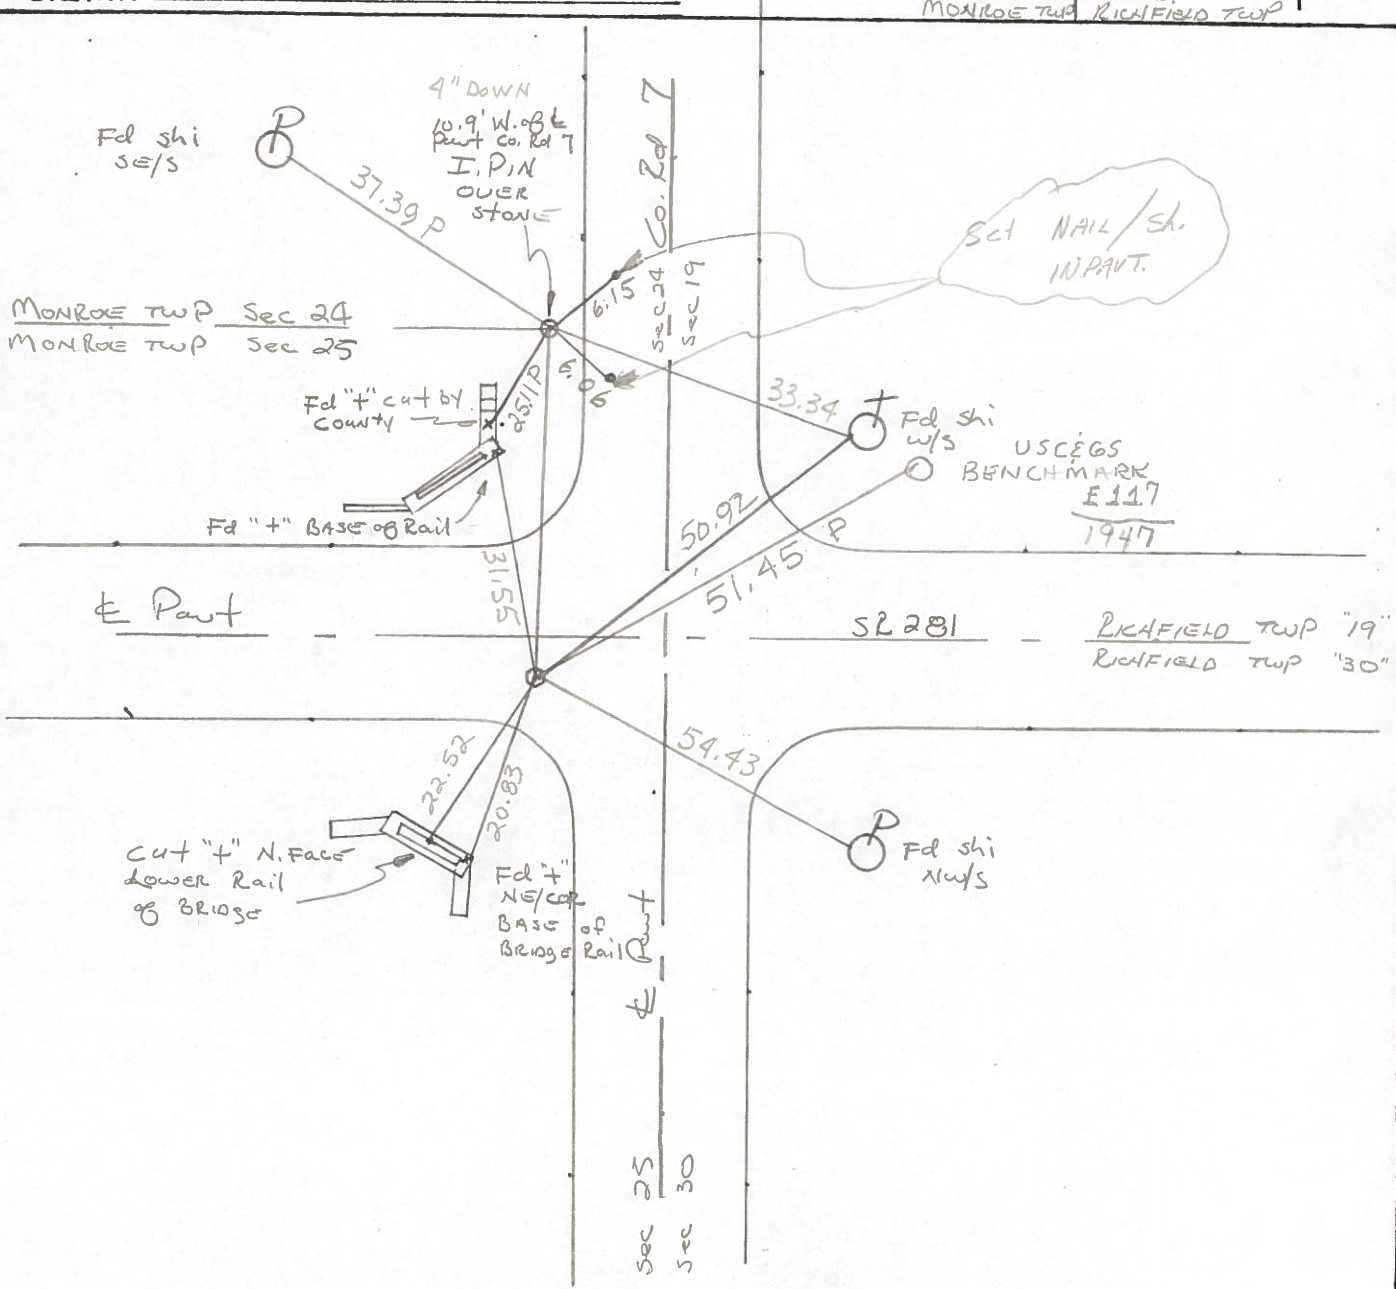

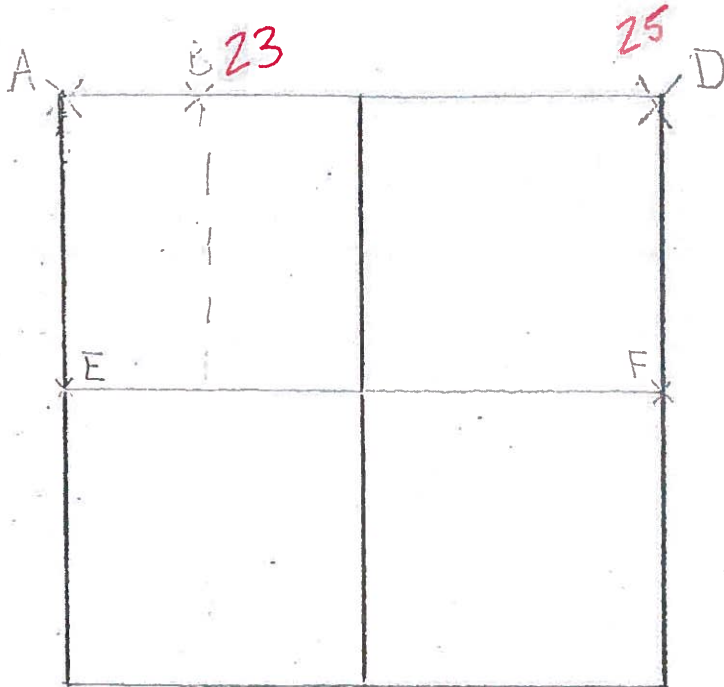COUNTY HENRY J.R. 2811 4 N . R 1 ETOWNSHIP MONROESECTION 25

6-6-79 R.W. J.J.G.M.

B- FOUND R.R. SPIKE ON C
 S.R. 281. SEARCHED FOR STONE
 BUT COULD NOT LOCATE. RESET
 R.R. SPIKE ON C S.R. 281

38.50' N. TO "N.E.S. S/S B T
 61.47' E.S.E. TO " " CONCRETE BRIDGE
 51.79' S.E. TO N.E.S. N/S D

6-6-79 R.W. G.M. J.J.

D- FOUND IRON PIN OVER STONE (10" x 10" x 9") 11" BELOW
 SHOULDER SURFACE. REMOVED IRON PIN AND SET 3/4"
 DIAMETER ALONG W/S OF STONE AND BENT TOP OF IRON
 PIN DIRECTLY OVER TOP CENTER OF STONE. IRON PIN
 6" BELOW SHOULDER SURFACE. P.K.'s SET 6' N.E. &
 S.E.

37.39' N.W. TO N.E.S. E/S D

33.16' E.S.E. TO N.E.S. W/S I

27.80' S.S.W. TO " " ON BASE CONCRETE BRIDGE WALL


56.16' S. TO RICHFIELD STONE

COUNTY HENRY

TOWNSHIP RICHFIELD

SECTION 30

SHEET 1 OF 2
T-4-N, R-8-E

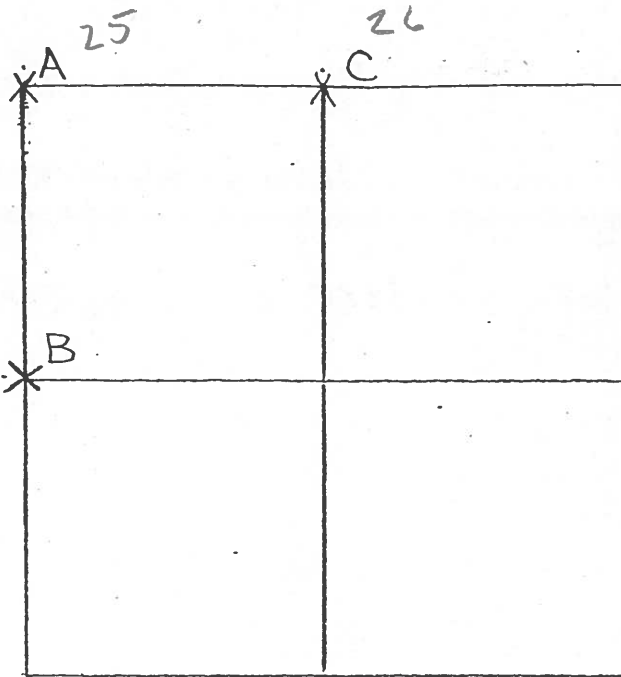

6-6-79 R.W., J.J., G.M.


A-- FOUND R.R. SPIKE OVER HIGH POINT OF STONE (7" x 8" x 11") 18" BELOW ROAD SURFACE. PLACED CENTER PUNCHED R.R. SPIKE ON SURFACE OVER HIGH POINT OF STONE. P.K.'S 6' S. & E. 31.55' N.N.W. TO "+" BASE CONC. BRIDGE WALL 50.86' N.N.E. TO SHINER $\frac{W}{S}$ $\frac{I}{P}$ 54.40' S.E. TO SHINER $\frac{W}{S}$ $\frac{I}{P}$ 20.79' S.W. TO "+" BASE CONC. BRIDGE WALL

6-25-79 R.W. G.M.


B-- FOUND STONE (15" x 19" x 20"). 16" BELOW ROAD SURFACE. PLACED CENTER PUNCHED R.R. SPIKE ON SURFACE OVER HIGH POINT OF STONE. P.K.'S SET 6' N.E. & S.E. STONE LOCATED 0.33' EAST OF WEST EDGE OF 18' PAVEMENT 30.61' E.S.E TO DUPLEX $\frac{W}{S}$ $\frac{I}{P}$ 37.82' S.E. TO "+" N.W. COR. CATCH BASIN (PLUMBED) 28.51' S.W. TO "+" END 8" DIA CONC. PIPE (PLUMBED) 43.12' NORTH TO EAST $\frac{1}{4}$ POST SEC. 25; MONROE TWP.

County Henry S.R. 281
 Township Richfield & Monroe
 Section NW Cor. Sec. 30 Richfield &
SE Cor. Sec. 24 Monroe
 T 4 N, R 8 E
 Personnel Smith

Date 5-18-1979
 Weather clear
 Temp. 78°

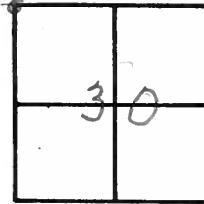

(25)

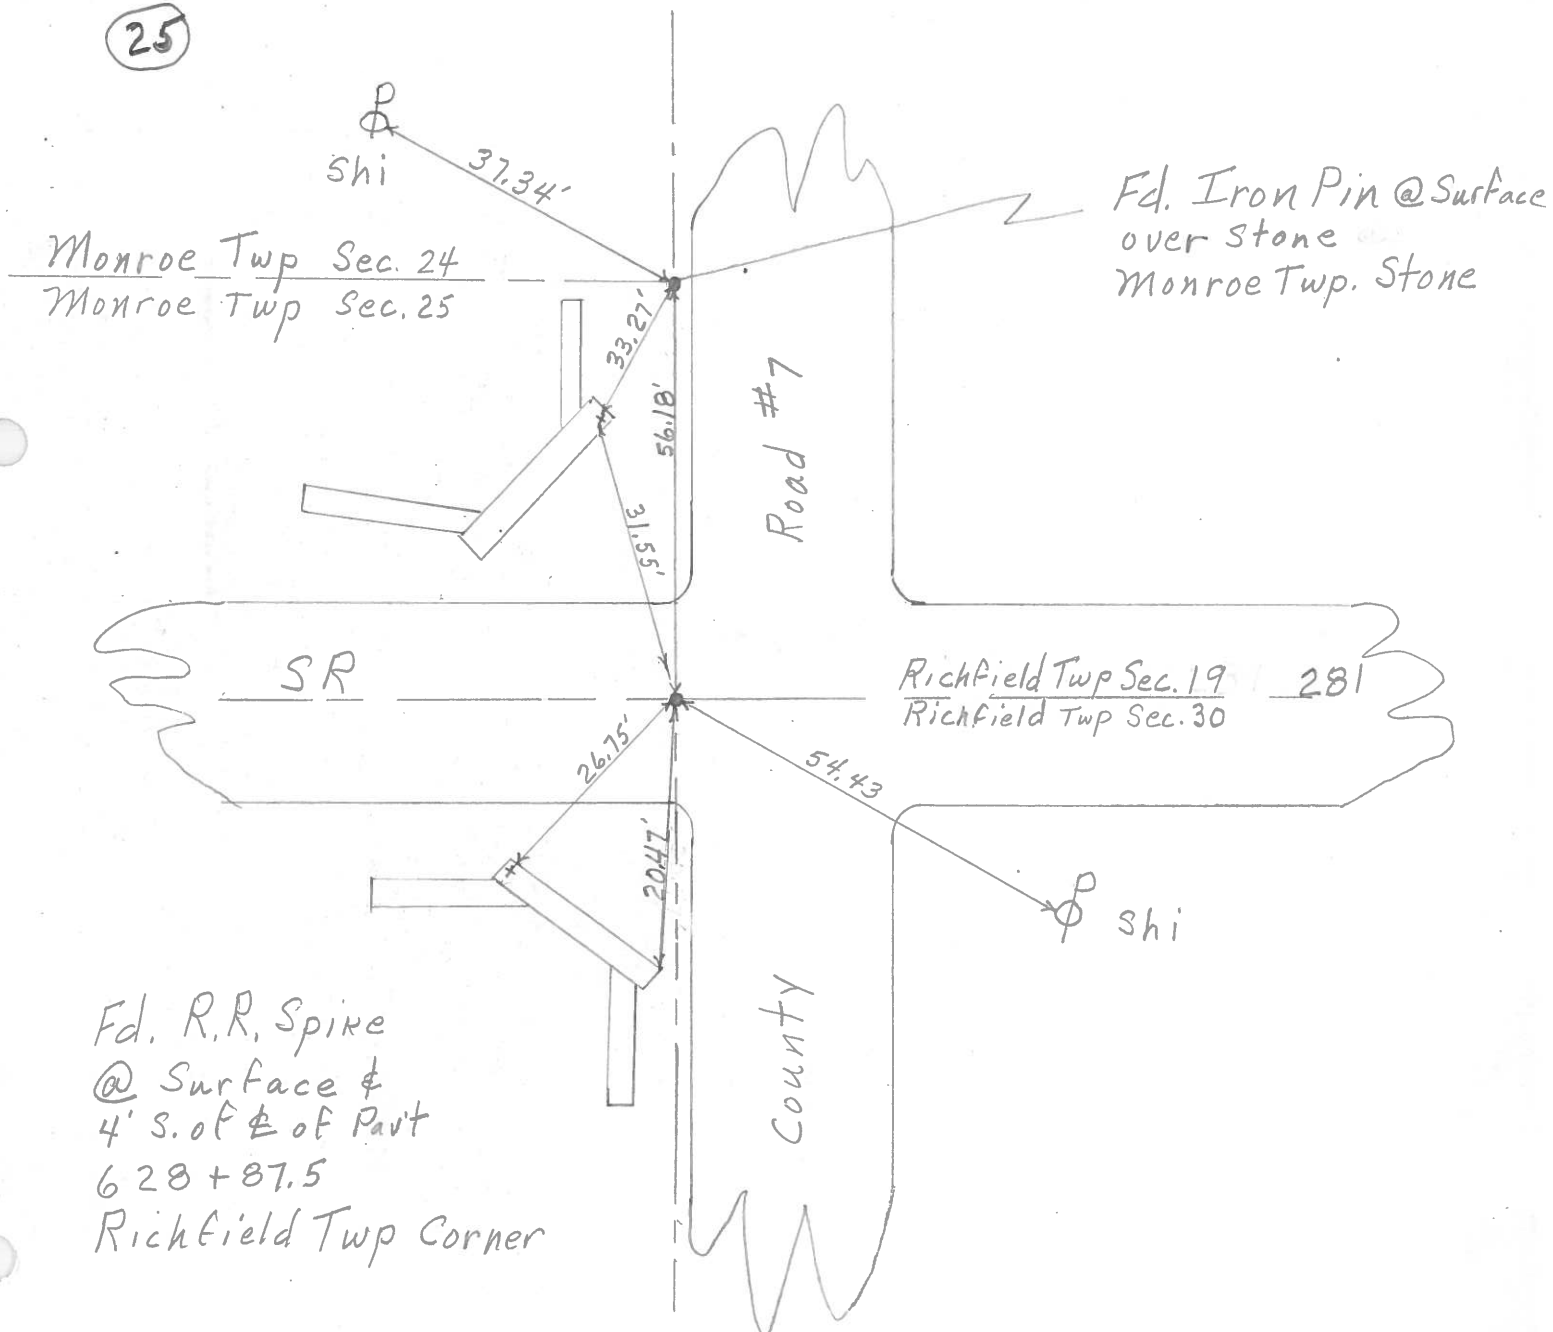

PERSONNEL TITLE PERSONNEL TITLE

COUNTY Henry DATE 19 April 77S. R. 281 WEATHER WindySEC. Monroe Twp. TEMP. 78°DESCRIPTION References to Control Points JOB NO. _____

LEFT

CENTER LINE

RIGHT

Ed. 1/2" Paint, Red over Stone
Sec. Line

(25)

RICHFIELD TWP.
MONROE TWP. E Co. Rd.

No. 7

shiner

chiseled "x" on base con. br. wall

chiseled "x" on base con. br. wall

SEC. LINE 24-25
MONROE TWP.
E SR 281

E SR 281

1/4 C.. 24-25
to N. edge put.
to S. edge put.
Monroe Twp.

PERSONNEL	TITLE	PERSONNEL	TITLE
Tomsic			
Neuser			
Granata			

COUNTY HENRY DATE Nov. 25, 1974

S. R. 281 WEATHER _____

SEC. RICHFIELD TWP. TEMP. _____

DESCRIPTION _____ LEFT _____ CENTER LINE _____ RIGHT _____ JOB NO. _____

