

O.D.O.T. DISTRICT 2 SURVEY OFFICE (USE ONLY)

PERSONNEL

REFERENCE NO. 27

SHEET 22 OF 34

NOTES PRESTON-COLVIN

DATE 11/26/24

ROUTE SR 281

H.C. NEISE

WEATHER WINDY

COUNTY HENRY

R.C. PRESTON-COLVIN

TEMP. 40°

TOWNSHIP RICHFIELD

SECTION 19

DWG BY PRESTON-COLVIN PID PAVING TRAIN

T 4 N R 8 E

TYPE MONUMENT SM RR SPIKE

ON SURFACE - ~~BELOW~~ 3"

OFFSET Q PAVEMENT 4.8' ~~LT~~ : RT

- TO - EDGE PAVEMENT

STATION: 681+06

HORIZ.DATUM: NAD83 2011


GEOID: 18

GRID: NORTHING: 592470.611


EASTING: 1561893.334

LDP: NORTHING: 449402.4

EASTING: 194509.4

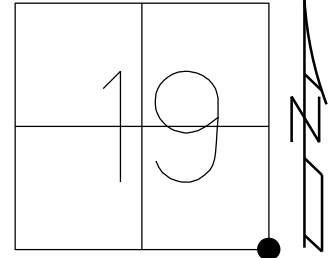

RECORD:
FD SM.R.R.SPIKE
ATOP SM.R.R.SPIKE
8/18/98, MC
SET P.K./WASHER
10/1/98, MRC
FD SM.R.R.SPIKE
3" DOWN
REF27
9/6/18, JFO
7/25/19,
1/11/23, JMR
FD SM RRS
REF27
3" DOWN
FD SM RRS
REF27
11/26/24, TDN

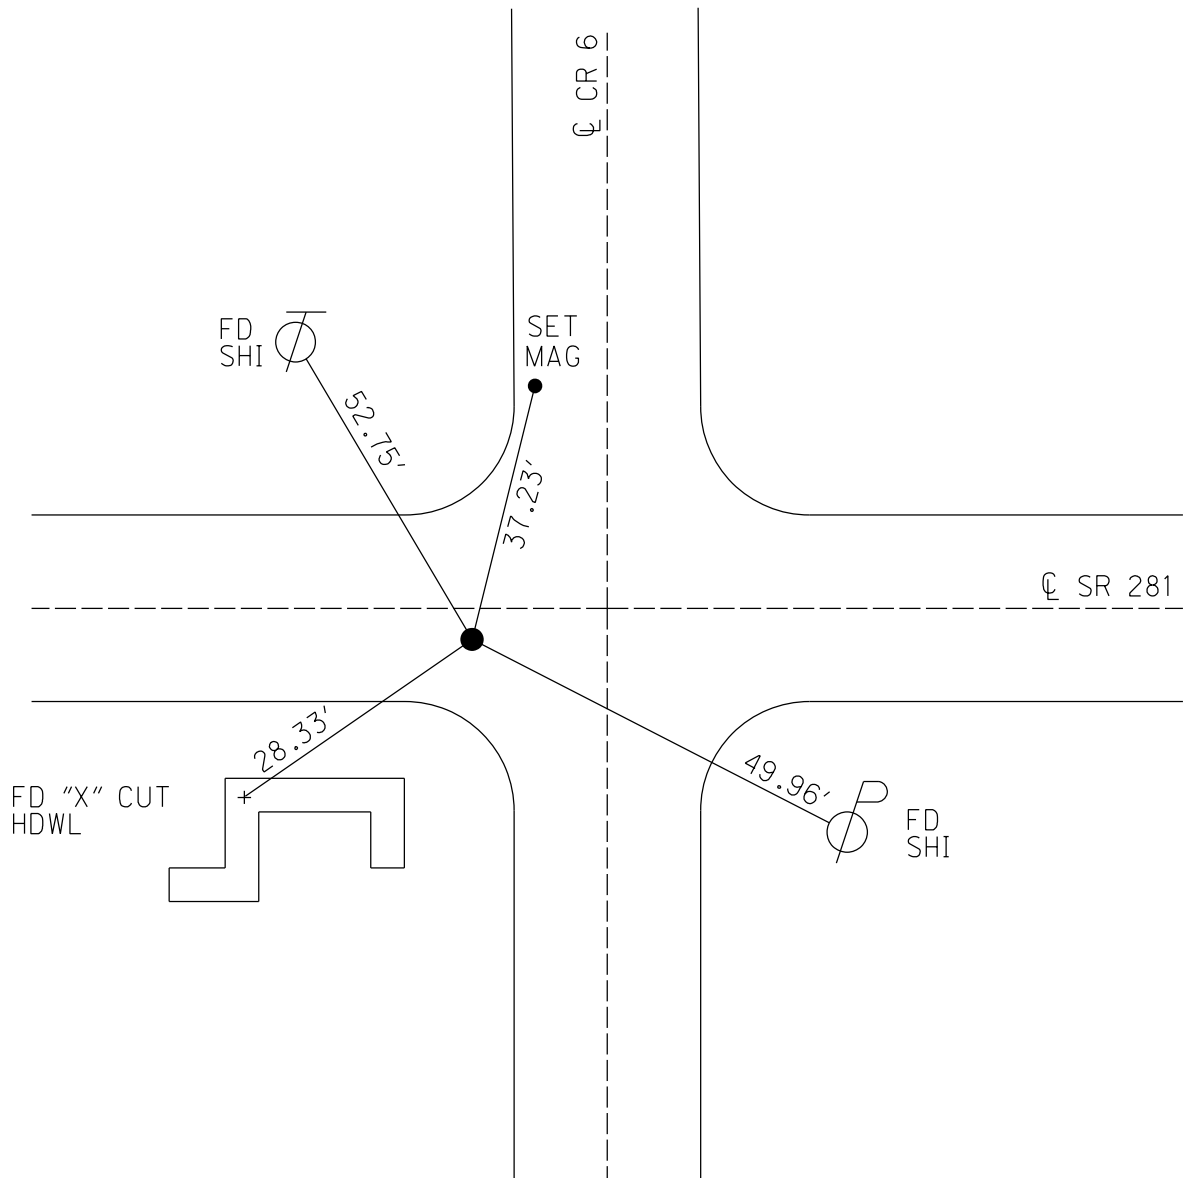

O.D.O.T. DISTRICT 2 SURVEY OFFICE (USE ONLY)

PERSONNEL

REFERENCE NO. 27

SHEET 22 OF 34

NOTES RHOADES

DATE 9/6/18

ROUTE SR 281

H.C. O'DONNELL

WEATHER CLOUDY

COUNTY HENRY

R.C. RHOADES

TEMP. 76°

TOWNSHIP RICHFIELD

SECTION 20

DWG BY NIESE

PID PAVETRAIN

T 4 N R 8 E

TYPE MONUMENT SM.R.R.SPIKE

~~ON SURFACE~~ - BELOW 3"

OFFSET CL PAVEMENT 4.8' ~~LT~~ : RT

- TO - EDGE PAVEMENT 9.5' W OF CL CR 6 N


STATION: 681+06

HORIZ.DATUM: NAD83(2011)


GEOID: 2012A

GRID: NORTHING: 592470.611

EASTING: 1561893.334

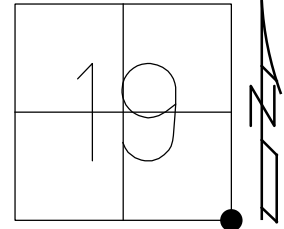

RECORD:
FD SM.R.R.SPIKE
ATOP SM.R.R.SPIKE
8/18/98, MC
SET P.K./WASHER
10/1/98, MRC
FD SM.R.R.SPIKE
3" DOWN
REF27
9/6/18, JFO
7/25/19,
1/11/23, JMR

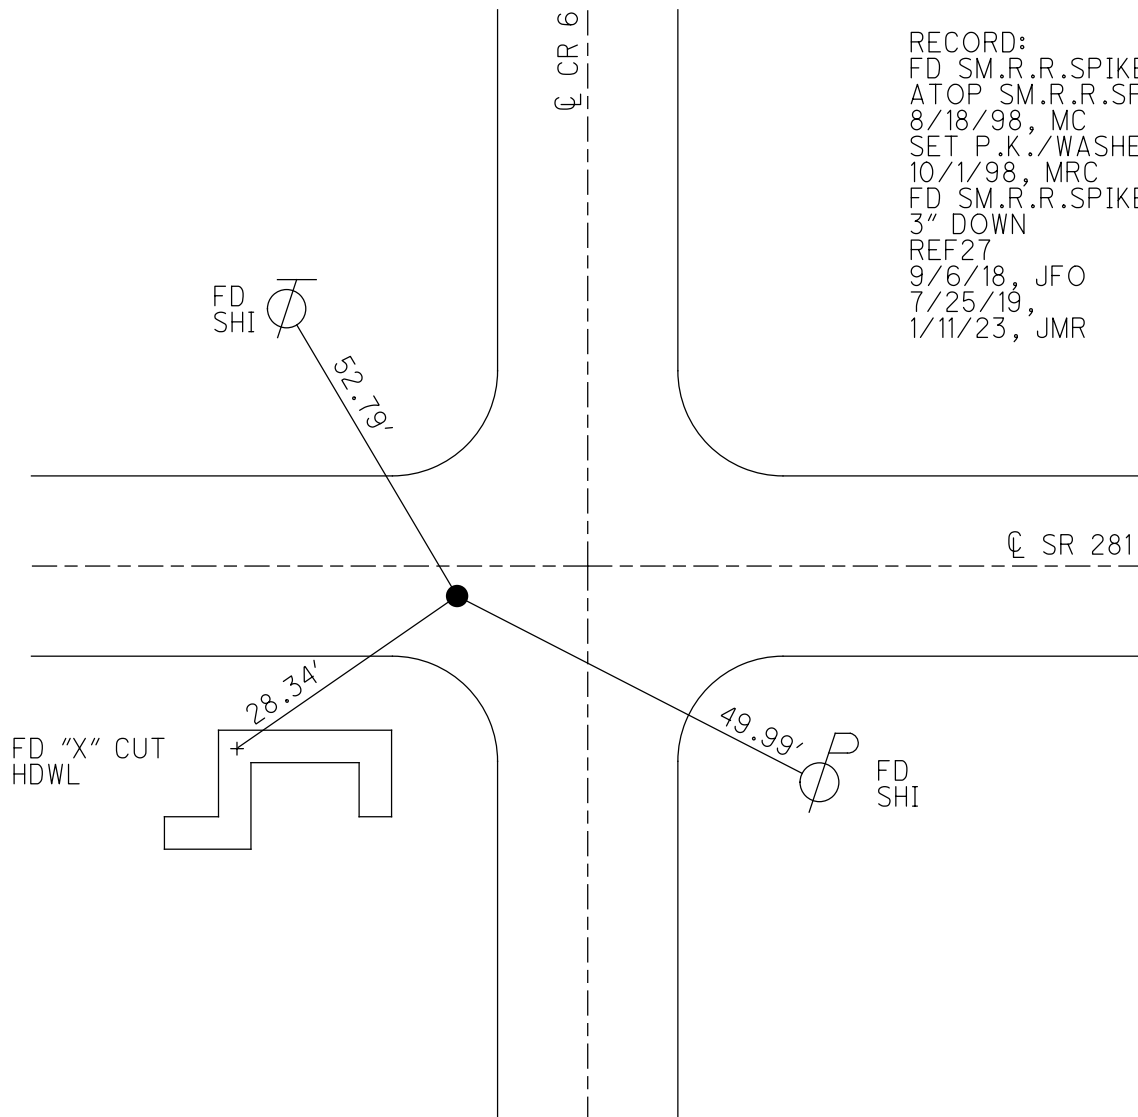

O.D.O.T. DISTRICT 2 SURVEY OFFICE (USE ONLY)

PERSONNEL

REFERENCE NO. 27

SHEET 22 OF 34

NOTES RHOADES

DATE 9/6/18

ROUTE SR 281

H.C. O'DONNELL

WEATHER CLOUDY

COUNTY HENRY

R.C. RHOADES

TEMP. 76°

TOWNSHIP RICHFIELD

SECTION 20

DWG BY NIESE

PID CHIP_2

T 4 N R 8 E

TYPE MONUMENT SM.R.R.SPIKE

~~ON SURFACE~~ - BELOW 3"

OFFSET CL PAVEMENT 4.8' ~~LT~~ : RT

- TO - EDGE PAVEMENT 9.5' W OF CL CR 6 N


STATION: 681+06

HORZ.DATUM: NAD83(2011)


GEOID: 2012A

GRID: NORTHING: 592470.611

EASTING: 1561893.334

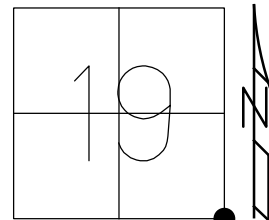

RECORD:
FD SM.R.R.SPIKE
ATOP SM.R.R.SPIKE
8/18/98, MC
SET P.K./WASHER
10/1/98, MRC
FD SM.R.R.SPIKE
3" DOWN
REF27
9/6/18, JFO
7/25/19, JMR

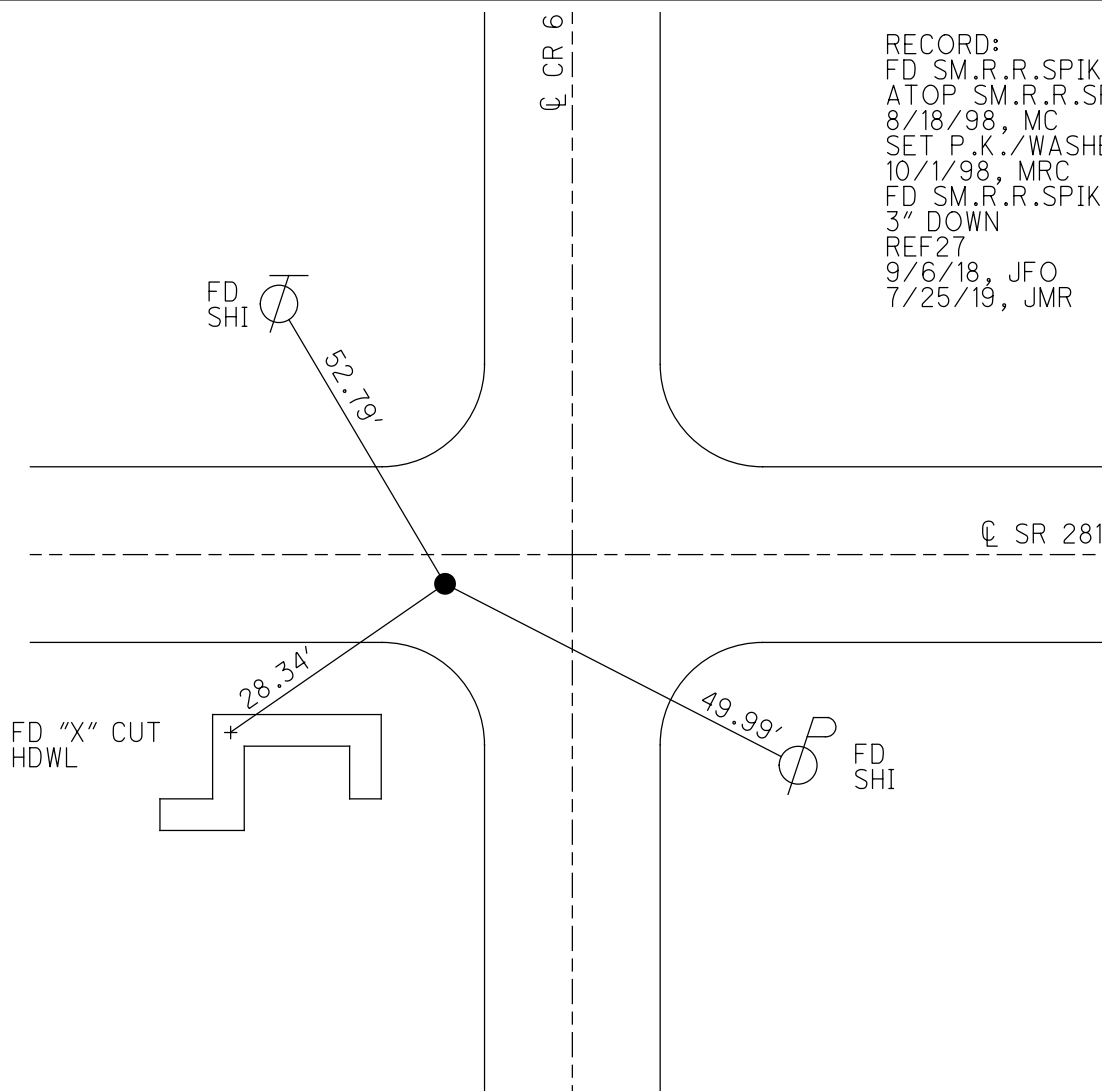

O.D.O.T. DISTRICT 2 SURVEY OFFICE

PERSONNEL

REFERENCE NO. 27

SHEET 23 OF 34

NOTES Conterbury

H.C. Rouss

R.C. Nutter

DATE 8-18-98

WEATHER Fair

TEMP. +84°F

ROUTE SR 281

COUNTY HENRY

TOWNSHIP Richfield

SECTION 20

T 4 E R 8 N

TYPE MONUMENTS Sm. RR SPK ATOP Sm. RR SPK

ON SURFACE - BELOW Surface

LEFT - CL PAV'T. - RIGHT 4.8' RT


TO EDGE PAVEMENT 95'w of CL Pmt Co. Rd 6 North

S.L. 20 + 757.75 SLK , 681+06

19	20
30	29



RESET PLAIN WASHER
10-1-98
MRC

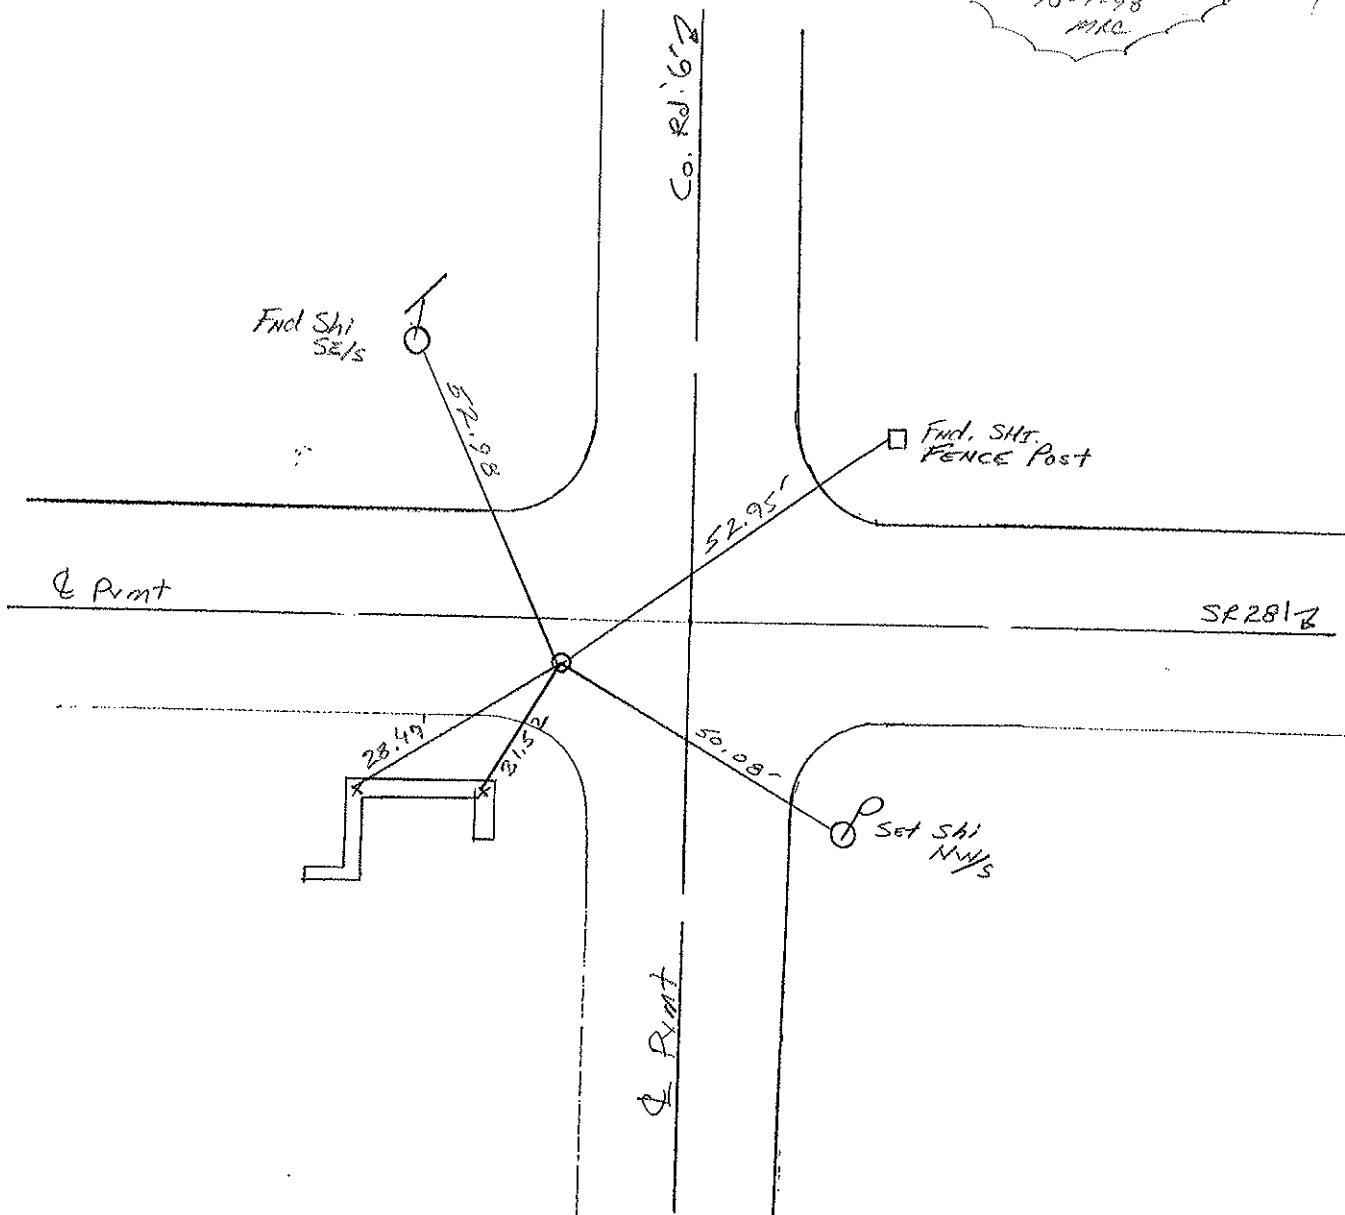

DRAWN BY TR

O.D.O.T. DISTRICT 2 SURVEY OFFICE

PERSONNEL

REFERENCE NO. 27

SHEET 23 OF

NOTES Sockman

H.C. BARNHISEL

R.C. LOENRKE

DATE 8-13-87

WEATHER HAZY

TEMP. +75

ROUTE SR 281

COUNTY HENRY

TOWNSHIP RICHFIELD

SECTION 20

T4 NR 8 E

TYPE MONUMENT SMALL RR SPIKE


ON SURFACE - ~~BELOW~~ YES

~~LEFT~~ - & PAN'T. - RIGHT 4.7

TO EDGE PAVEMENT 9.7' West of E. Post

S.L.M. 681 + 06 Co. Rd "6" /

19	20
30	29

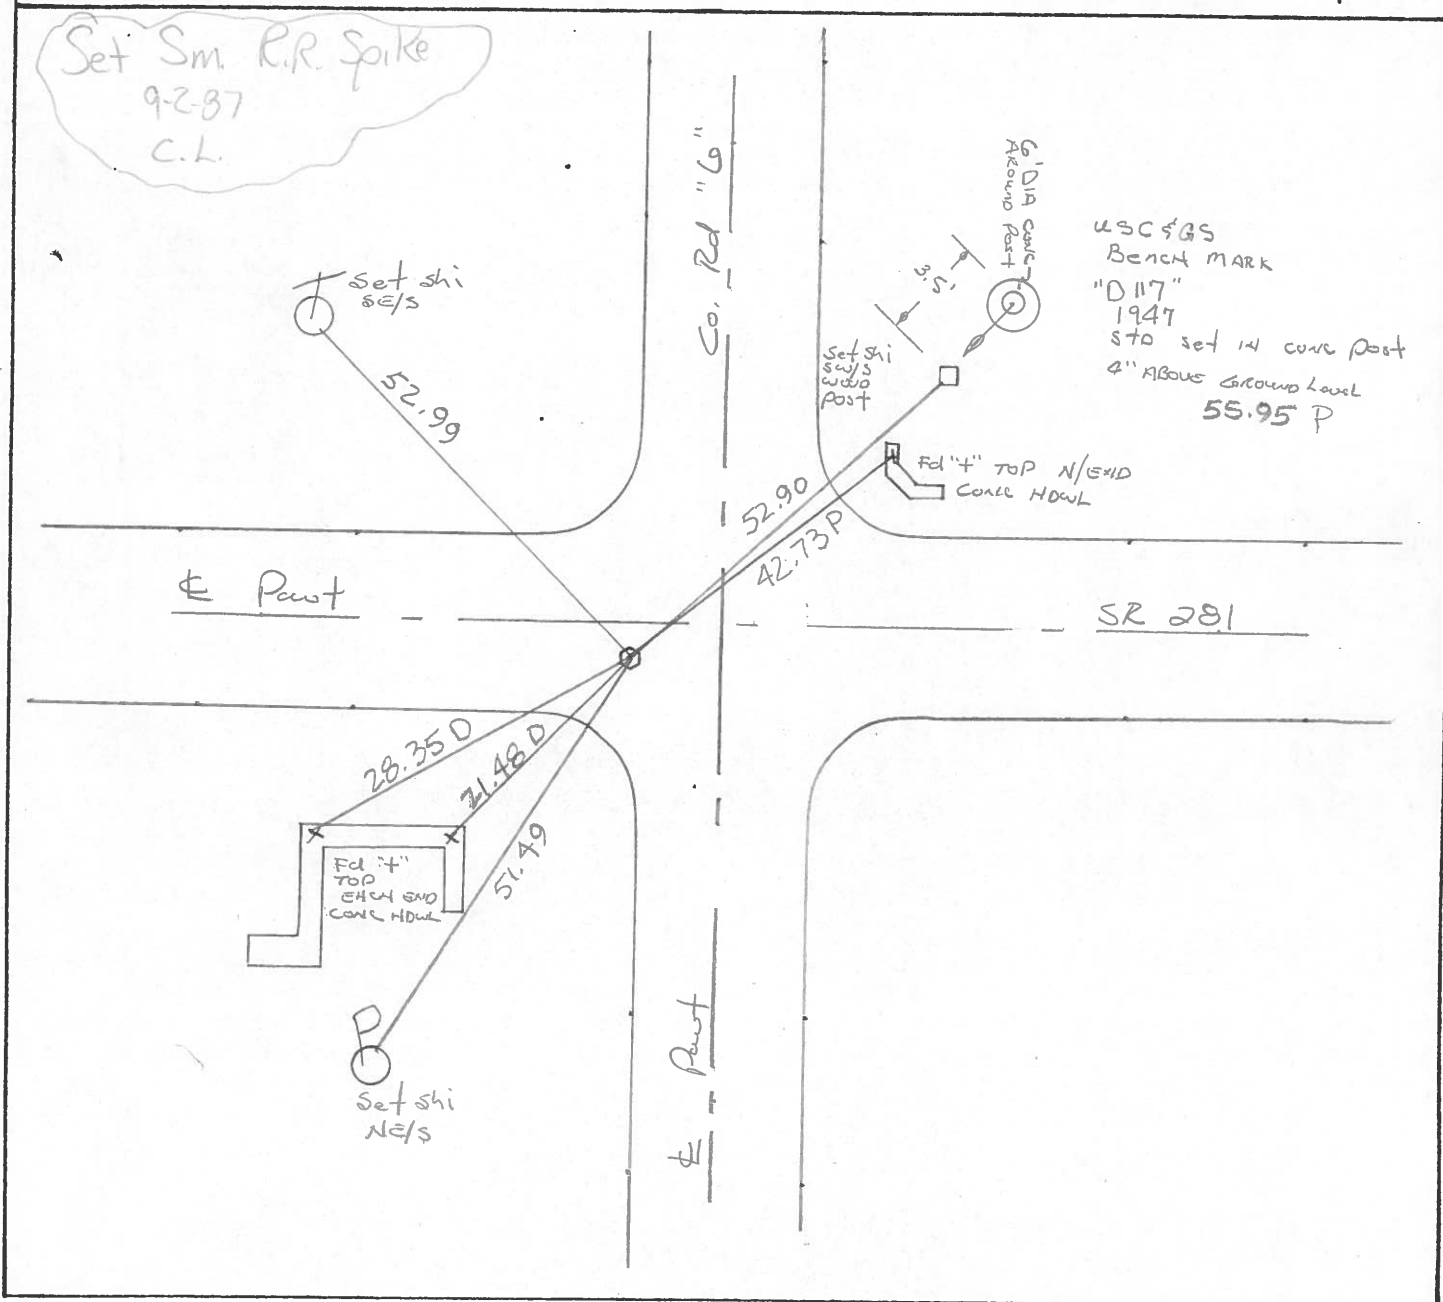


COUNTY HENRY S.R. 281

T 4 N , R 8 E

TOWNSHIP RICHFIELD

SECTION 29

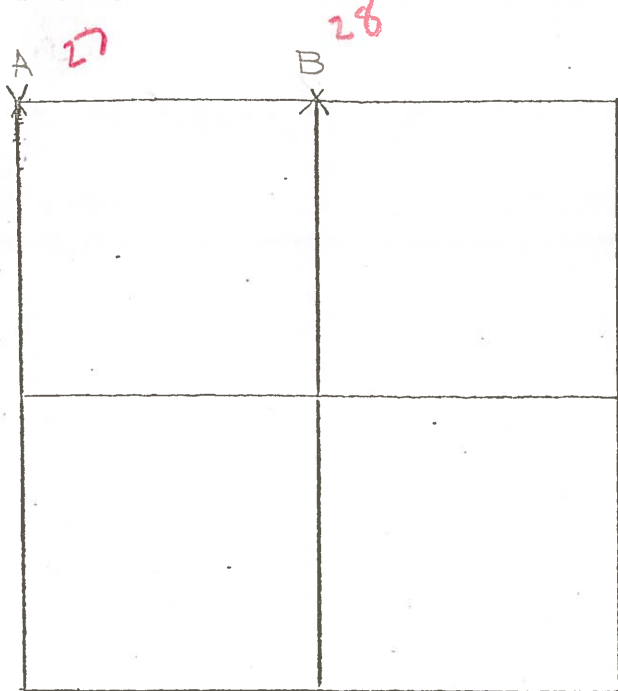

6-8-79 R.W., J.J., G.M.

A-- FOUND RAILROAD SPIKE OVER HIGH
POINT OF STONE (14" x 15" x 15") 17" BELOW
ROAD SURFACE. POINT FALLS IN GROOVE
IN TOP OF STONE. FOUND PIECES OF
BROKEN VITRIFIED PIPE OVER STONE.
PLACED CENTER PUNCHED R.R. SPIKE
ON SURFACE OVER HIGH POINT OF
STONE. P.K.'S 6' N. & E.

52.50' N.W. TO SHINER IN $\frac{SE}{S}$ $\perp$

52.89' N.E. TO SHINER IN $\frac{SW}{S}$ COR. FENCE POST

21.46' S.W. TO "+" EAST END CONC. HEADWALL

28.32' W.S.W. TO "+" WEST END CONC. HEADWALL

6-8-79 R.W., J.J., G.M.

B-- FOUND PR NAIL 0.10' NORTH AND 0.50' EAST OF STONE (5" x 7" x 24")
12" BELOW ROAD SURFACE. STONE IS LEANING TO THE SOUTH. REMOVED PR
AND PLACED CENTER PUNCHED R.R. SPIKE ON SURFACE OVER HIGH
POINT OF STONE. P.K.'S 6' S. & W.

STONE IS 8.0' NORTH OF SOUTH EDGE OF 18' PAVEMENT

87.09' N.N.W. TO SHINER $\frac{SE}{S}$ $\perp$

39.57' N.E. TO "+" WEST END CONC. HEADWALL

85.42' E.N.E. TO SHINER $\frac{SW}{S}$ $\perp$

48.28' E.S.E. TO "+" EAST END CONC. HEADWALL

51.55' S.S.E. TO SHINER $\frac{N}{S}$ $\perp$

47.22' S.S.W. TO CENTER U.S.G.S. BENCH MARK

Q.D.O.T. DISTRICT 2 SURVEY OFFICE

Sht. 5 of

County Henry S.R. 281

Date 5-22-1979

Township Richfield

Weather Clear

Section NE Corner Sec. 30

Temp. 65°


T4N, R8E

Personnel Burnside


Smith

Knappe

Mead

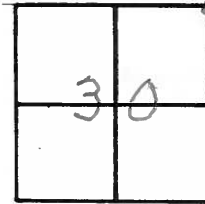

27

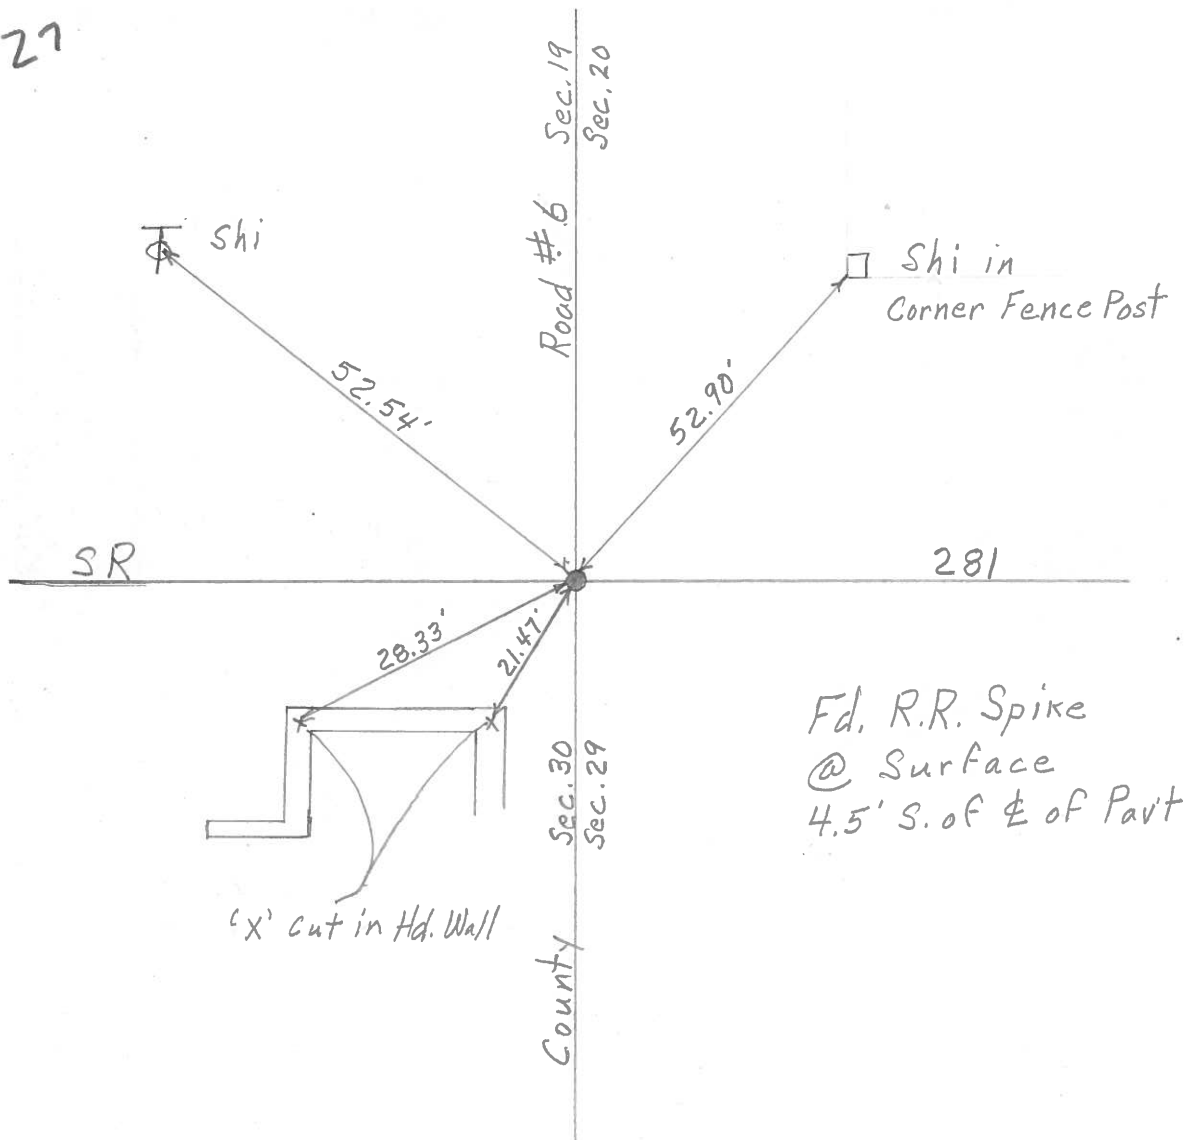

PERSONNEL TITLE PERSONNEL TITLE

StoneCOUNTY HenryDATE 19 April 77ES. R. 281WEATHER WarmCrewSEC. RICHFIELD TWP TEMP. 80°

DESCRIPTION

References to Control Points

JOB NO.

LEFT

CENTER LINE

RIGHT

F.d. RR Spk to Surface

(27)

Shiner's
Sence Post

52.93

E Co. Rd.

No. 62

52.63

21.50

Shiner's

dissected "f"
on top culvert wall

1/2 # 281

1/4 C.R. 19-30


to N. edge pt.
to S. edge pt.

COUNTY HENRY

SHEET 1 of 2
T 4 N 8 E

TOWNSHIP RICHFIELD

SECTION 29

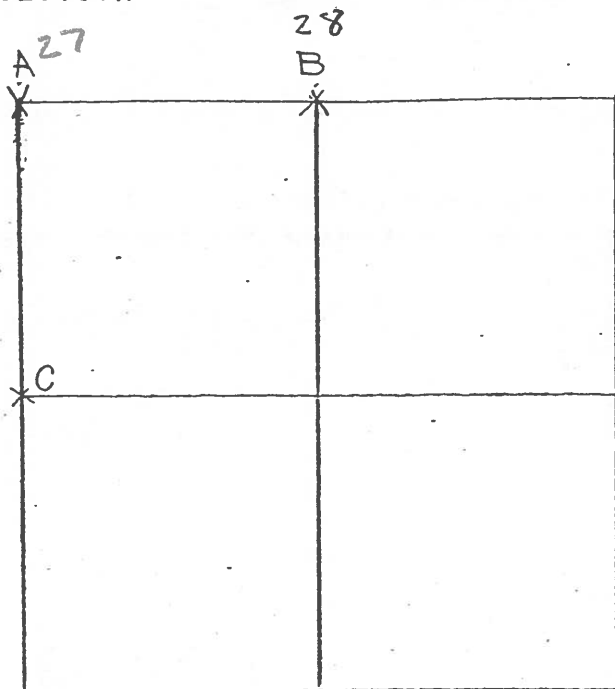

6-8-79 R.W, J.J, G.M.

A-- FOUND RAILROAD SPIKE OVER HIGH
POINT OF STONE (14" x 15" x 15") 17" BELOW
ROAD SURFACE. POINT FALLS IN GROOVE
IN TOP OF STONE. FOUND PIECES OF
BROKEN VITRIFIED PIPE OVER STONE.
PLACED CENTER PUNCHED R.R. SPIKE
ON SURFACE OVER HIGH POINT OF
STONE. P.K.'S 6' N. & E.

52.50' N.W. TO SHINER IN SE/S T

52.89' N.E. TO SHINER IN SW/S COR. FENCE POST

21.46' S.W. TO "+" EAST END CONC. HEADWALL

28.32' W.S.W. TO "+" WEST END CONC. HEADWALL

6-8-79 R.W, J.J, G.M.

B-- FOUND PK NAIL 0.10' NORTH AND 0.50' EAST OF STONE (5" x 7" x 24")
12" BELOW ROAD SURFACE. STONE IS LEANING TO THE SOUTH. REMOVED PK
AND PLACED CENTER PUNCHED R.R. SPIKE ON SURFACE OVER HIGH
POINT OF STONE. P.K.'S 6' S. & W.

STONE IS 8.0' NORTH OF SOUTH EDGE OF 18' PAVEMENT

87.09' N.N.W. TO SHINER SE/S T

39.57' N.E. TO "+" WEST END CONC. HEADWALL

85.42' E.N.E. TO SHINER SW/S T

48.28' E.S.E. TO "+" EAST END CONC. HEADWALL

51.55' S.S.E. TO SHINER N/S P

47.22' S.S.W. TO CENTER U.S.G.S. BENCH MARK

PERSONNEL	TITLE	PERSONNEL	TITLE	COUNTY	DATE
Tomsic				HENRY	Nov. 25, 1974
Neuser				S. R. 281	WEATHER
Granato				SEC. RICHFIELD TWP.	TEMP.

DESCRIPTION	LEFT	CENTER LINE	RIGHT	JOB NO.
-------------	------	-------------	-------	---------

