

O.D.O.T. DISTRICT 2 SURVEY OFFICE (USE ONLY)

PERSONNEL

REFERENCE NO. 29

SHEET 24 OF 34

NOTES PRESTON-COLVIN

H.C. NEISE

R.C. PRESTON-COLVIN

DATE 11/26/24

WEATHER WINDY

TEMP. 40°

ROUTE SR 281

COUNTY HENRY

TOWNSHIP RICHFIELD

SECTION 20

DWG BY PRESTON-COLVIN

PID PAVING TRAIN

T 4 N R 8 E

TYPE MONUMENT SM RR SPIKE

~~ON SURFACE~~ - BELOW 3"

OFFSET ϕ PAVEMENT 2.0' ~~LT~~ : RT

- TO - EDGE PAVEMENT 5.2' W OF ϕ CR 5 N

STATION: 734+43

HORZ.DATUM: NAD83 2011


GEOID: 18

GRID: NORTHING: 592440.193


EASTING: 1567230.169

LDP: NORTHING: 449469.9

EASTING: 202487.9

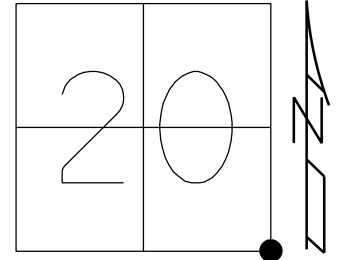

RECORD:
 SET SM.R.R.SPIKE
 9/2/87, CL
 FD SM.R.R.SPIKE
 6/2/98, MC
 SET P.K./WASHER
 10/5/98, MRC
 FD SM.R.R.SPIKE
 3" DOWN
 REF29
 9/6/18, JFO
 7/25/19,
 1/11/23, JMR
 FD SM RRSK
 REF29
 7/24/24, TDN
 FD SM RRSK
 11/26/24, TDN

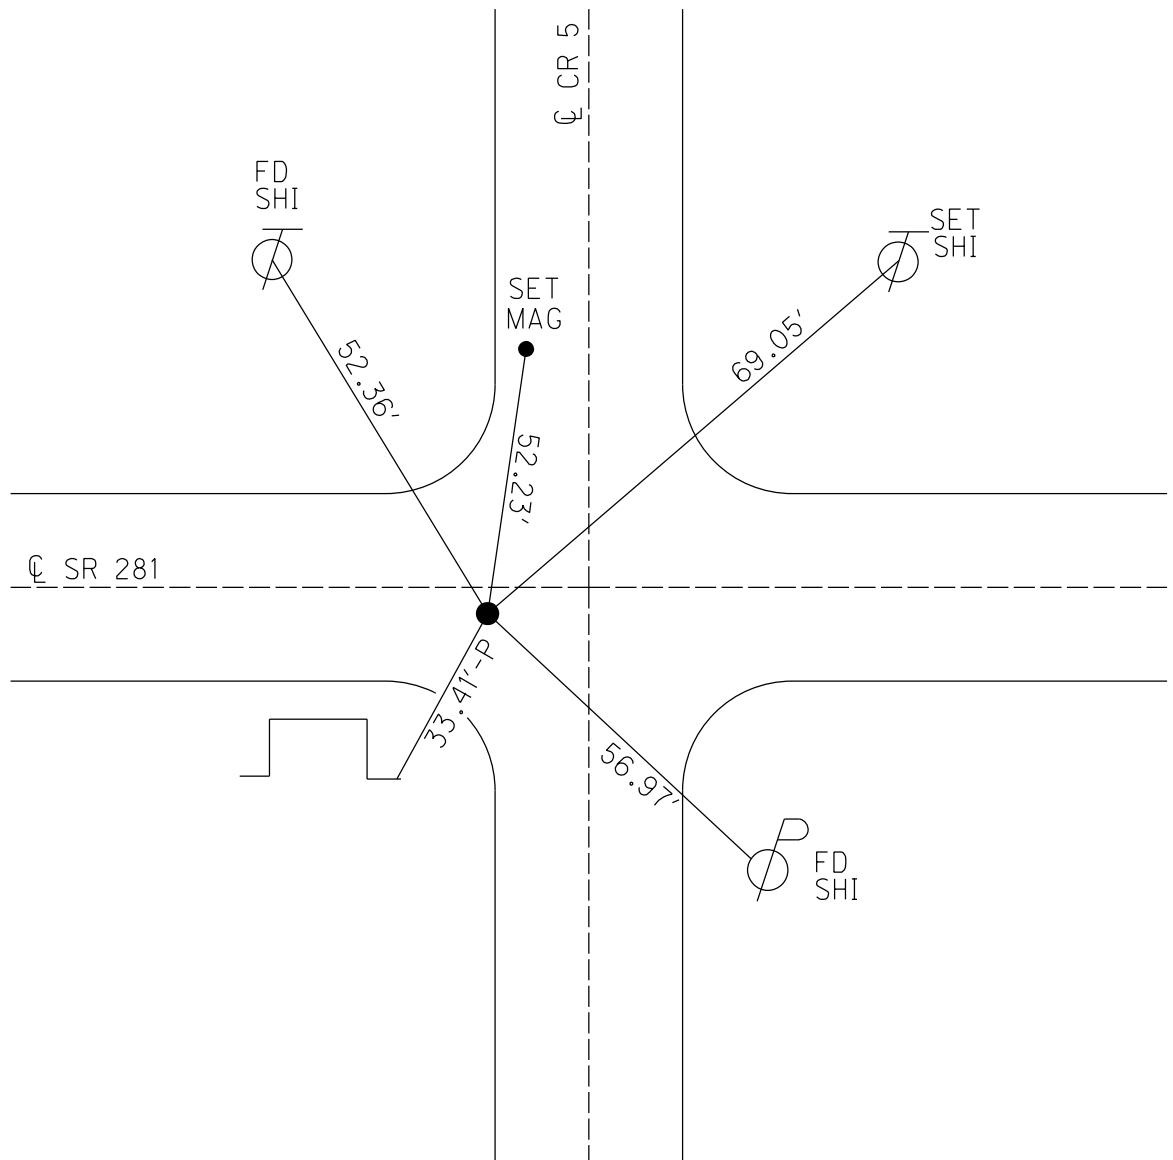

O.D.O.T. DISTRICT 2 SURVEY OFFICE (USE ONLY)

PERSONNEL

REFERENCE NO. 29

SHEET 24 OF 34

NOTES RHOADES

DATE 9/6/18

ROUTE SR 281

H.C. O'DONNELL

WEATHER CLOUDY

COUNTY HENRY

R.C. RHOADES

TEMP. 76°

TOWNSHIP RICHFIELD

SECTION 21

DWG BY NIESE

PID PAVETRAIN

T 4 N R 8 E

TYPE MONUMENT SM.R.R.SPIKE

~~ON SURFACE~~ - BELOW 3"

OFFSET CL PAVEMENT 2.0' ~~LT~~ : RT

- TO - EDGE PAVEMENT 5.2' W OF CL CR 5 N



STATION: 734+43

HORIZ.DATUM: NAD83(2011)

GEOID: 2012A

GRID: NORTHING: 592440.193

EASTING: 1567230.169

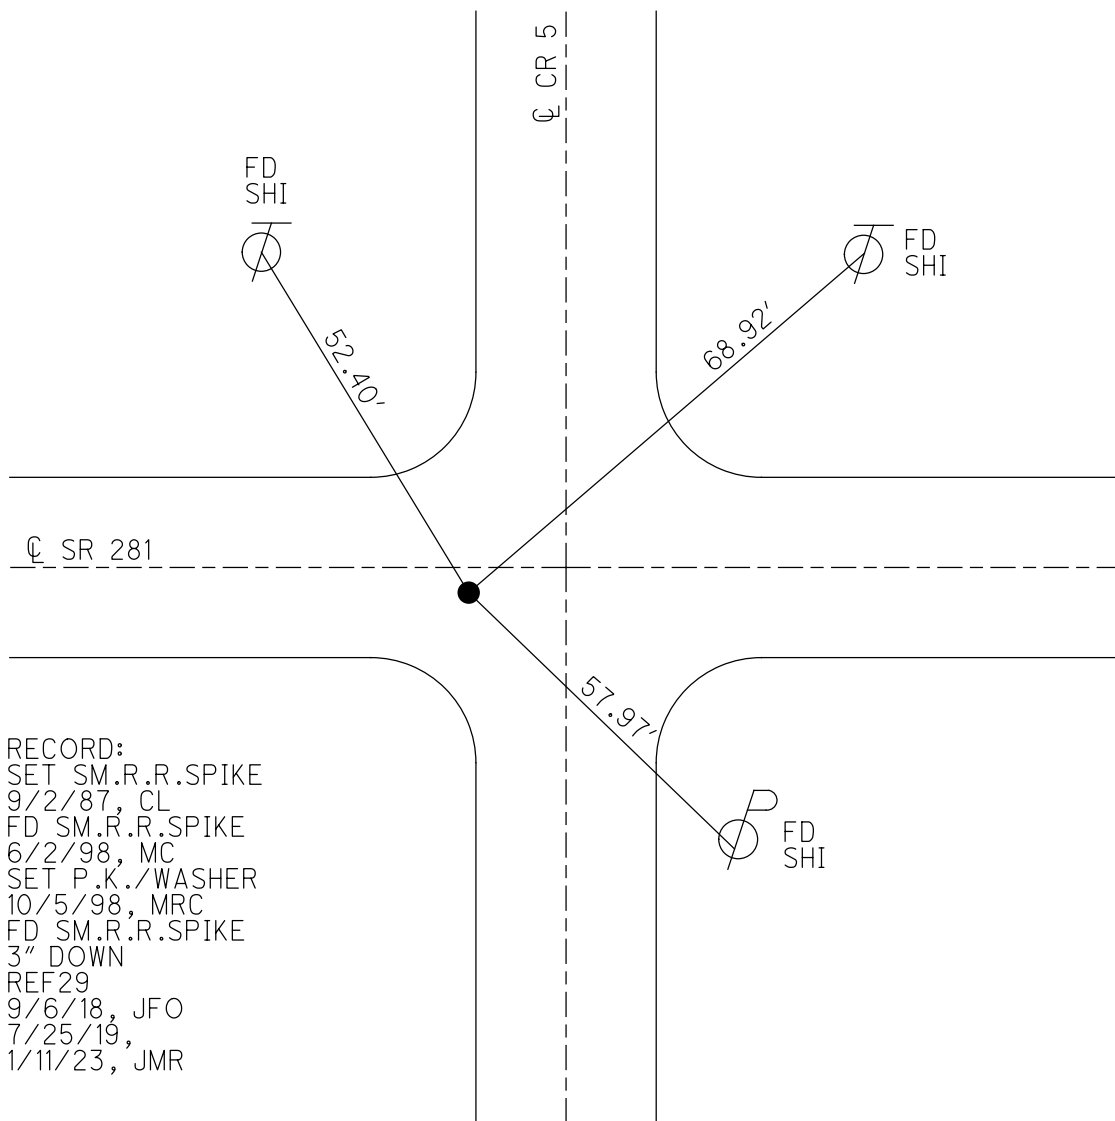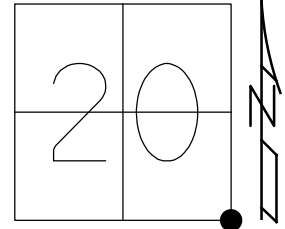

O.D.O.T. DISTRICT 2 SURVEY OFFICE (USE ONLY)

PERSONNEL

REFERENCE NO. 29

SHEET 24 OF 34

NOTES RHOADES

DATE 9/6/18

ROUTE SR 281

H.C. O'DONNELL

WEATHER CLOUDY

COUNTY HENRY

R.C. RHOADES

TEMP. 76°

TOWNSHIP RICHFIELD

SECTION 21

DWG BY NIESE

PID CHIP_2

T 4 N R 8 E

TYPE MONUMENT SM.R.R.SPIKE

~~ON SURFACE~~ - BELOW 3"

OFFSET CL PAVEMENT 2.0' ~~LT~~ : RT

- TO - EDGE PAVEMENT 5.2' W OF CL CR 5 N



STATION: 734+43

HORIZ.DATUM: NAD83(2011)

GEOID: 2012A

GRID: NORTHING: 592440.193

EASTING: 1567230.169

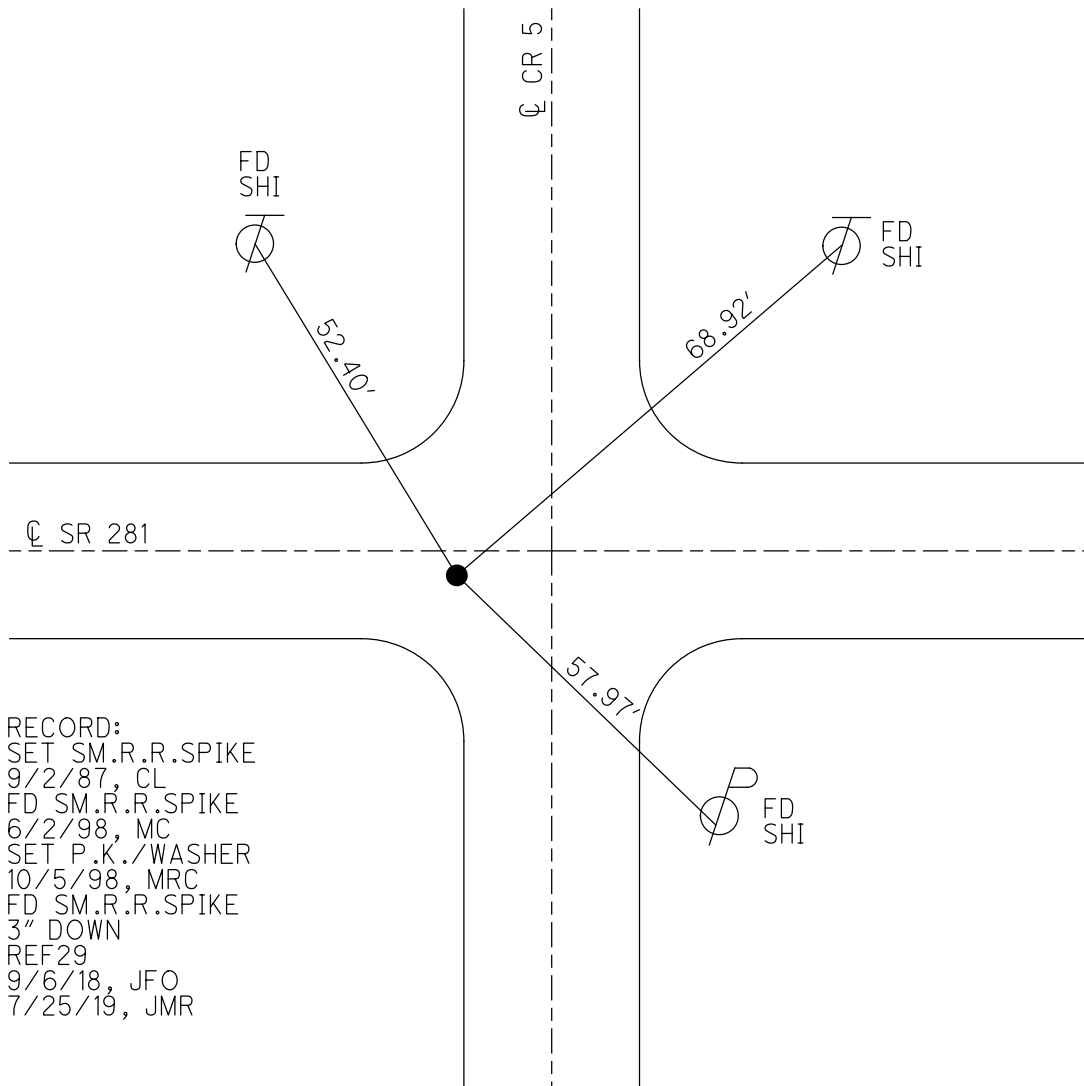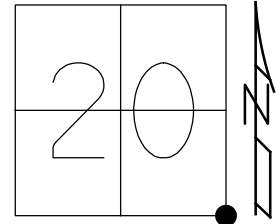

RECORD:
SET SM.R.R.SPIKE
9/2/87, CL
FD SM.R.R.SPIKE
6/2/98, MC
SET P.K./WASHER
10/5/98, MRC
FD SM.R.R.SPIKE
3" DOWN
REF29
9/6/18, JFO
7/25/19, JMR

O.D.O.T. DISTRICT 2 SURVEY OFFICE

PERSONNEL

REFERENCE NO. 29

SHEET 25 OF 34

NOTES Canterbury

H.C. Roush

R.C. Nutter

DATE 6-2-98

WEATHER Sunny

TEMP. +70°F

ROUTE SR 281

COUNTY HENRY

TOWNSHIP Richfield

SECTION 21

T 4 N R 8 E

TYPE MONUMENT Sm. RR spk

ON SURFACE - ~~BELOW~~ Surface

LEFT- & PAV'T. - RIGHT 2.0' RT

TO EDGE PAVEMENT 5.2' West of & Rmt Co. Rd. 5' North


S.L.M. 22+382.62 SLK, 734+413 SLK

20	21
29	28



RESET PK & WASHCOT
10-5-98
MRC

Sm. RR spk set
9-2-89
CL

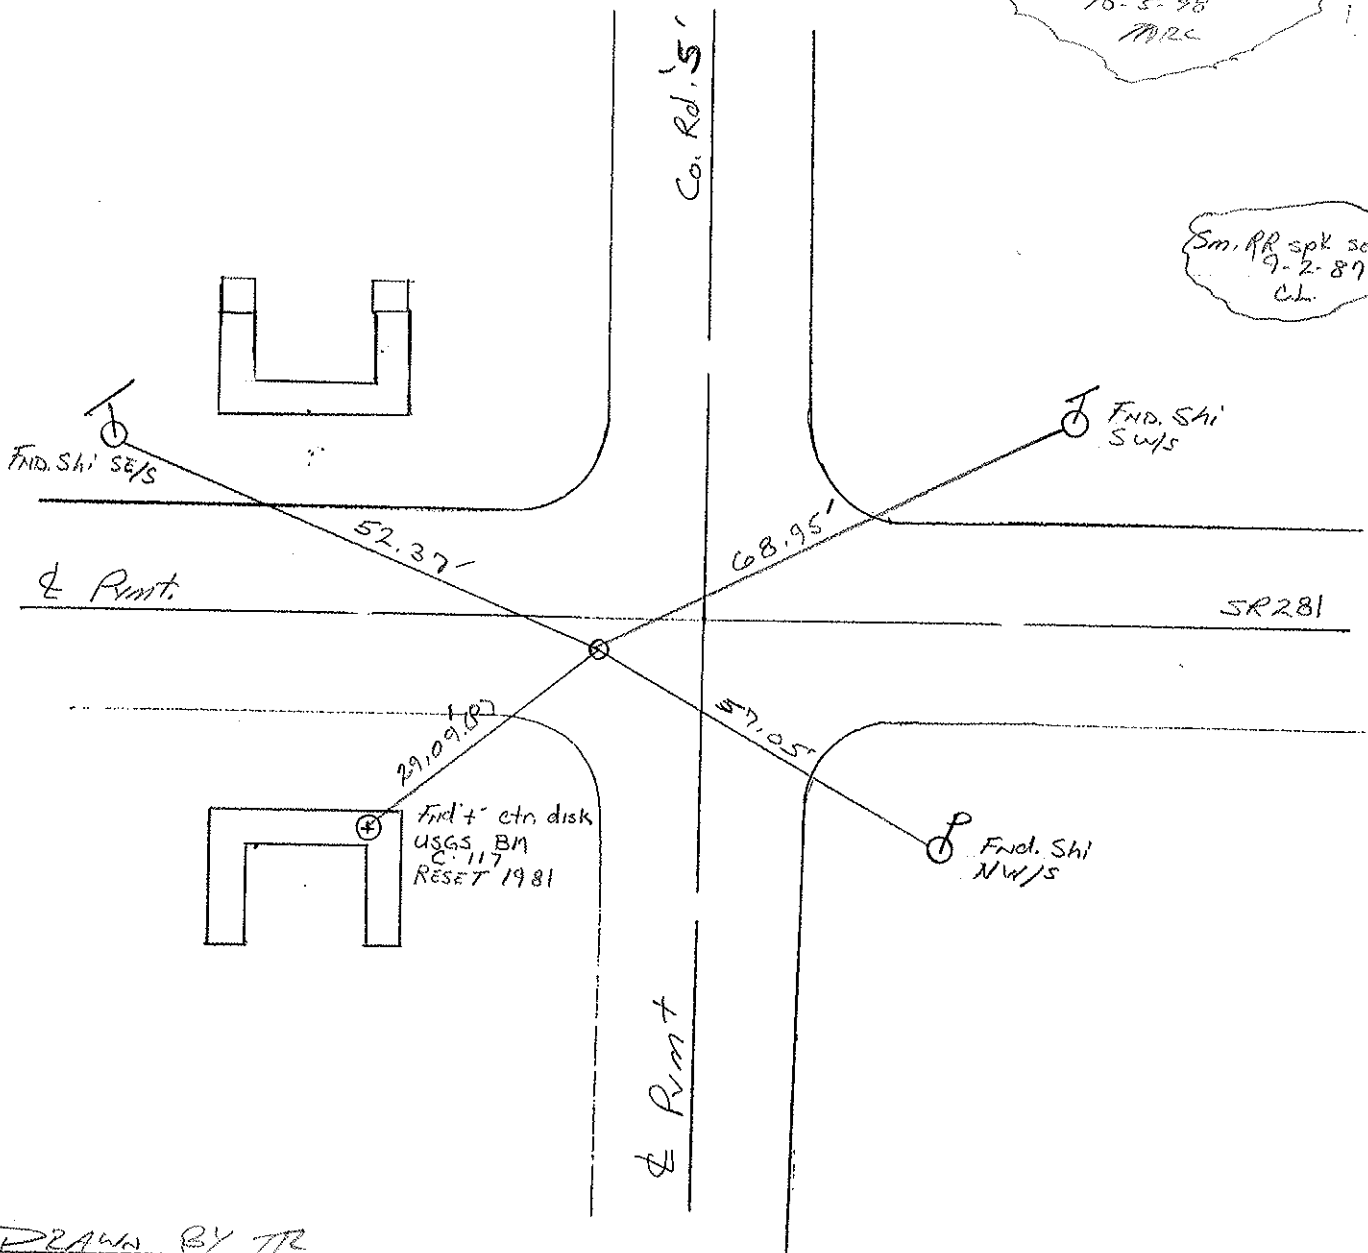

DRAWN BY TR

O.D.O.T. DISTRICT 2 SURVEY OFFICE

PERSONNEL

REFERENCE NO. 29

SHEET 25 OF

NOTES Sackman

H.C. BARNHISEL

R.C. LOEHRKE

DATE 8-13-87

WEATHER HAZY

TEMP. +75

ROUTE SR 281

COUNTY HENRY

TOWNSHIP RICHFIELD

SECTION 21

T. 4 N. R. 8 E.

TYPE MONUMENT SMALL RR SPIKE


ON SURFACE - BELOW YES


~~LEFT~~ & PAV'T. - RIGHT 1.8'

TO EDGE PAVEMENT 5.2' west of & Pavt

S.L.M. 734 + 43 Co. Rd "S" North

20	21
29	28

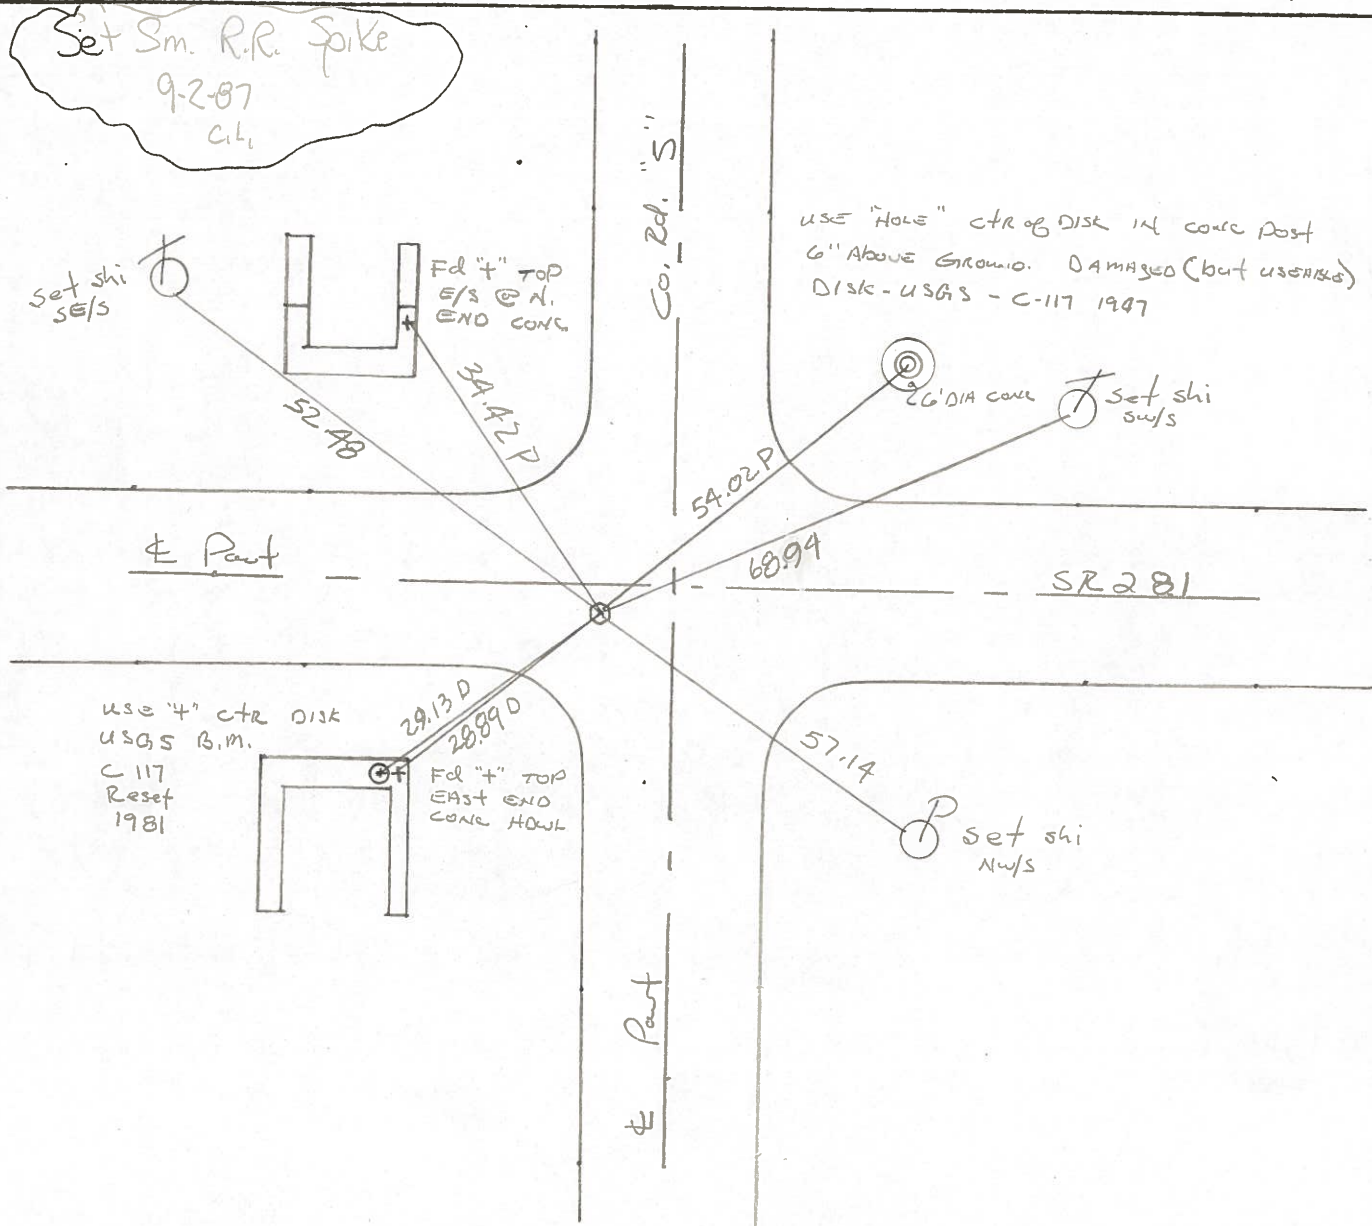

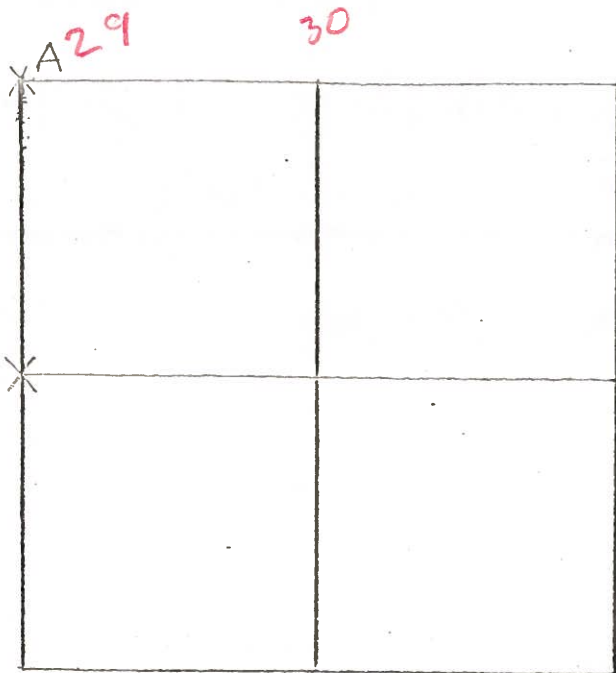COUNTY HENRY S.R. 281T 4 N , R 8 ETOWNSHIP RICHFIELDSECTION 28

6-8-79 R.W. J.J. G.M.

A-- FOUND RAILROAD SPIKE OVER WOOD
 STAKE IN CLAY TILE, OVER SMALL STONE
 OVER CORNER STONE (8" x 10" x 12") 32"
 BELOW ROAD SURFACE. RAILROAD SPIKE
 WAS 0.17' WEST AND 0.15' NORTH OF
 TOP CENTER OF STONE. REMOVED WOOD
 STAKE, TILE AND SMALL STONE. PLACED
 CENTER PUNCHED RAILROAD SPIKE ON

SURFACE OVER HIGH POINT OF STONE. P.K.'S 6' S. & E.

52.39' N.W. TO SHINER $\frac{SE}{S}$ $\downarrow$

34.60' N.W. TO "+" IN EAST CONC. HEADWALL

70.33' N.E. TO SHINER $\frac{SW}{S}$ $\downarrow$ 56.61' S.S.E. TO DUPLEX $\frac{NW}{S}$ $\downarrow$

28.89' S.W. TO "+" EAST END CONC. BRIDGE WALL

6-4-79

R.W. J.J. G.M.

C- FOUND RECORDED IRON PIN ($\frac{5}{8}$ " DIA) DRIVEN THRU
 FRACTURED STONE (4" x 8" x 15") 4" BELOW GROUND
 SURFACE. IRON PIN IS TRUE POINT. STONE IS LOCATED
 4.3' WEST OF WEST EDGE OF 18' PAVEMENT.

P.K.'S SET 10' S.E. & N.E



88.83' S.S.E. TO DUPLEX $\frac{NW}{S}$ $\downarrow$

8.18' S.W. TO "+" N. END CONCRETE HEADWALL


32.08' W.S.W TO DUPLEX $\frac{N}{S}$ $\downarrow$

County HENRY S.R. 281Date 5-22-79Township RICHFIELDWeather CLEARSection N.E. COR. SEC. 29Temp. +65°

T4N, R8E

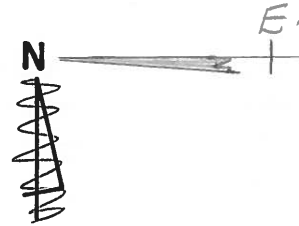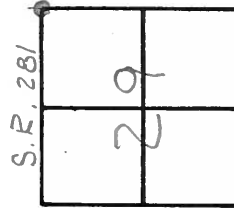Personnel BURNSIDESMITHKNAPEMEAD

29

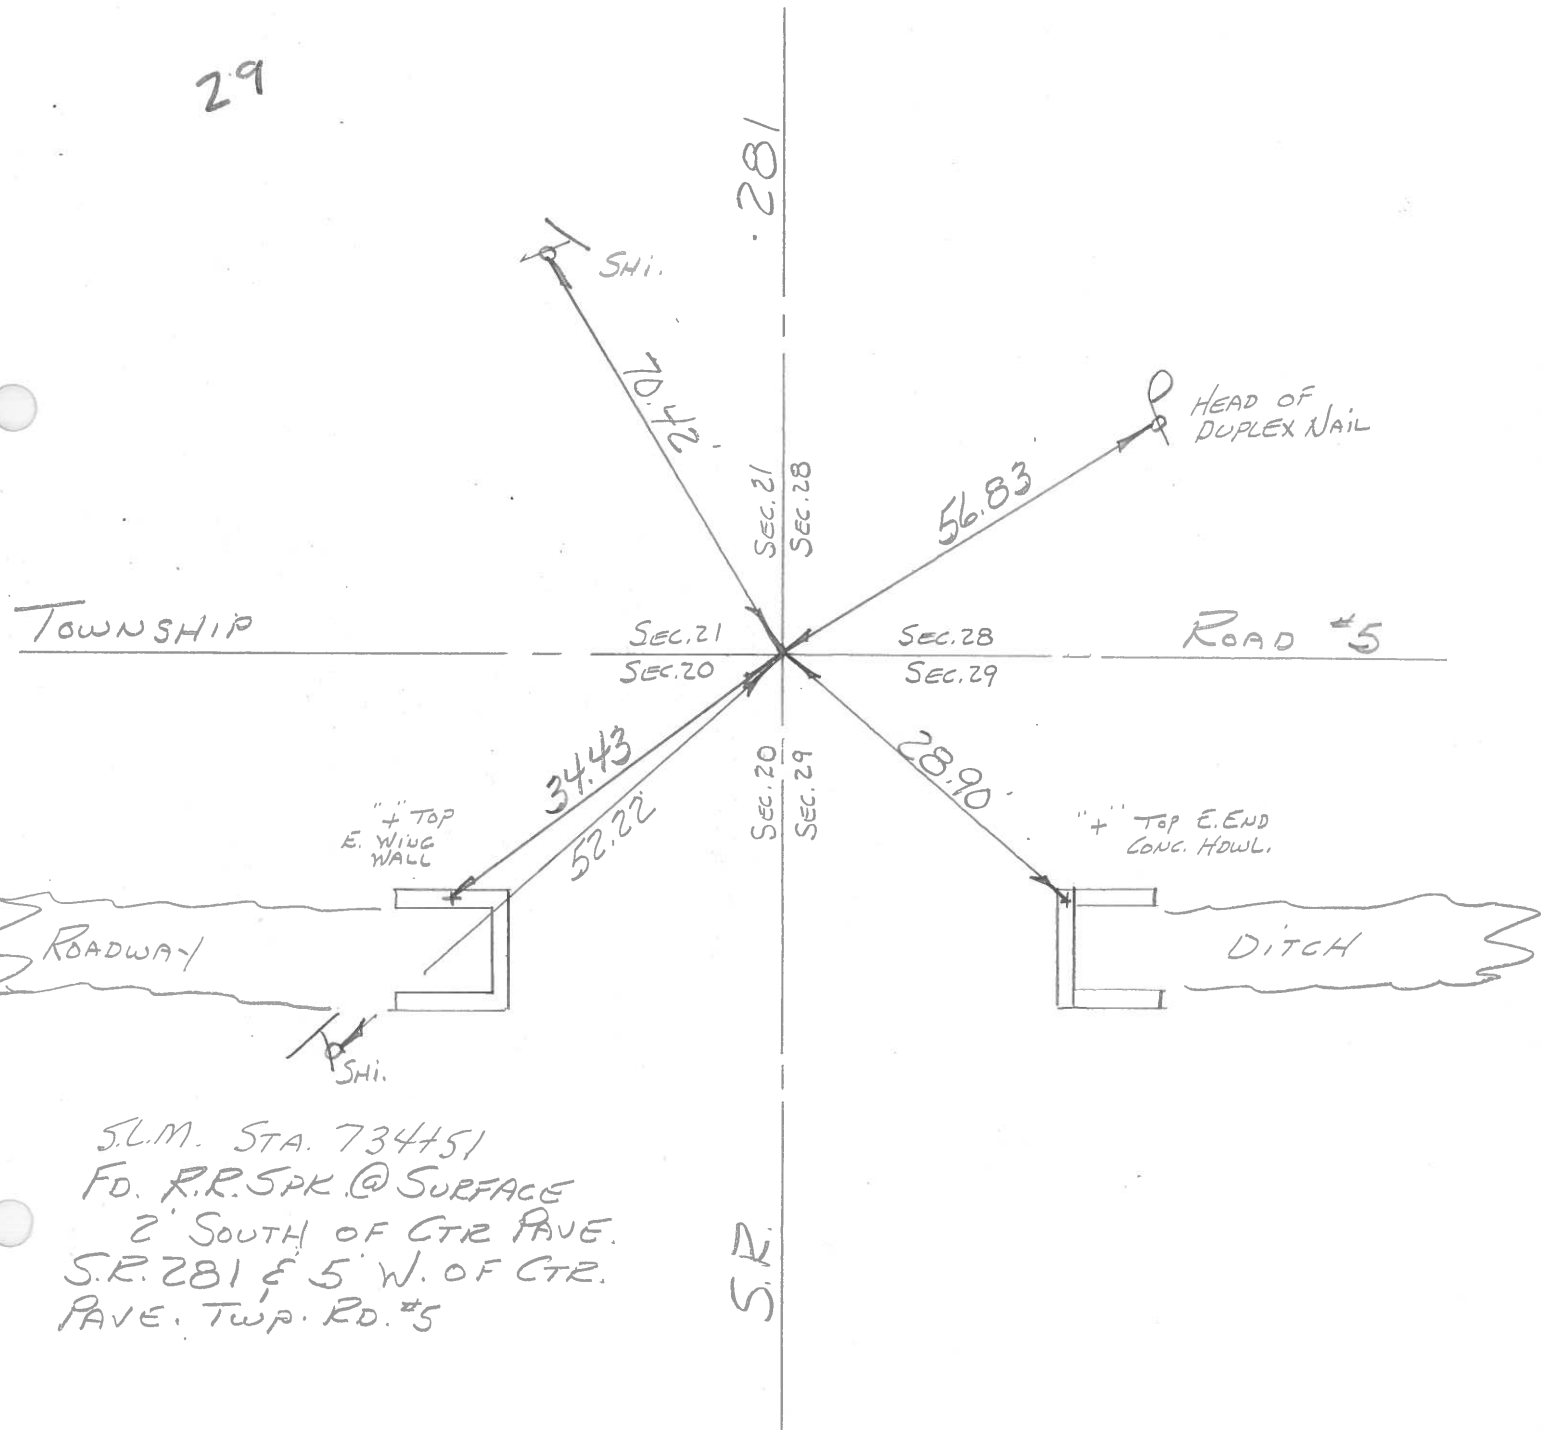

PERSONNEL	TITLE	PERSONNEL	TITLE	COUNTY	DATE
Tomsic				HENRY	Nov. 25, 1974
Nowser				S. R. 281	WEATHER
Granata				SEC. RICHFIELD TWP.	TEMP.

DESCRIPTION	LEFT	CENTER LINE	RIGHT	JOB NO.
-------------	------	-------------	-------	---------

